


Package 14 - Level 13

**Teeple Architects INC.**



Reviewed   
 Reviewed as noted   
 Revise and resubmit   
 Not Reviewed   
 Date: Aug 9/15  
 Reviewed by: MBannon

This review by Teeple Architects Inc. is for the sole purpose of ascertaining conformance with the general design concept. This review shall not mean that Teeple Architects Inc. approves the detailed design inherent in the shop drawings, responsibility for which shall remain with the Contractor submitting same, and such review shall not relieve the Contractor of the responsibility for errors or omissions in the shop drawings or of the responsibility for meeting all requirements of the Contract Documents. The Contractor is responsible for dimensions to be confirmed and correlated at the job site, for information that pertains solely to fabrication processes or to techniques of construction and installation, and for coordination of the work of all trades.

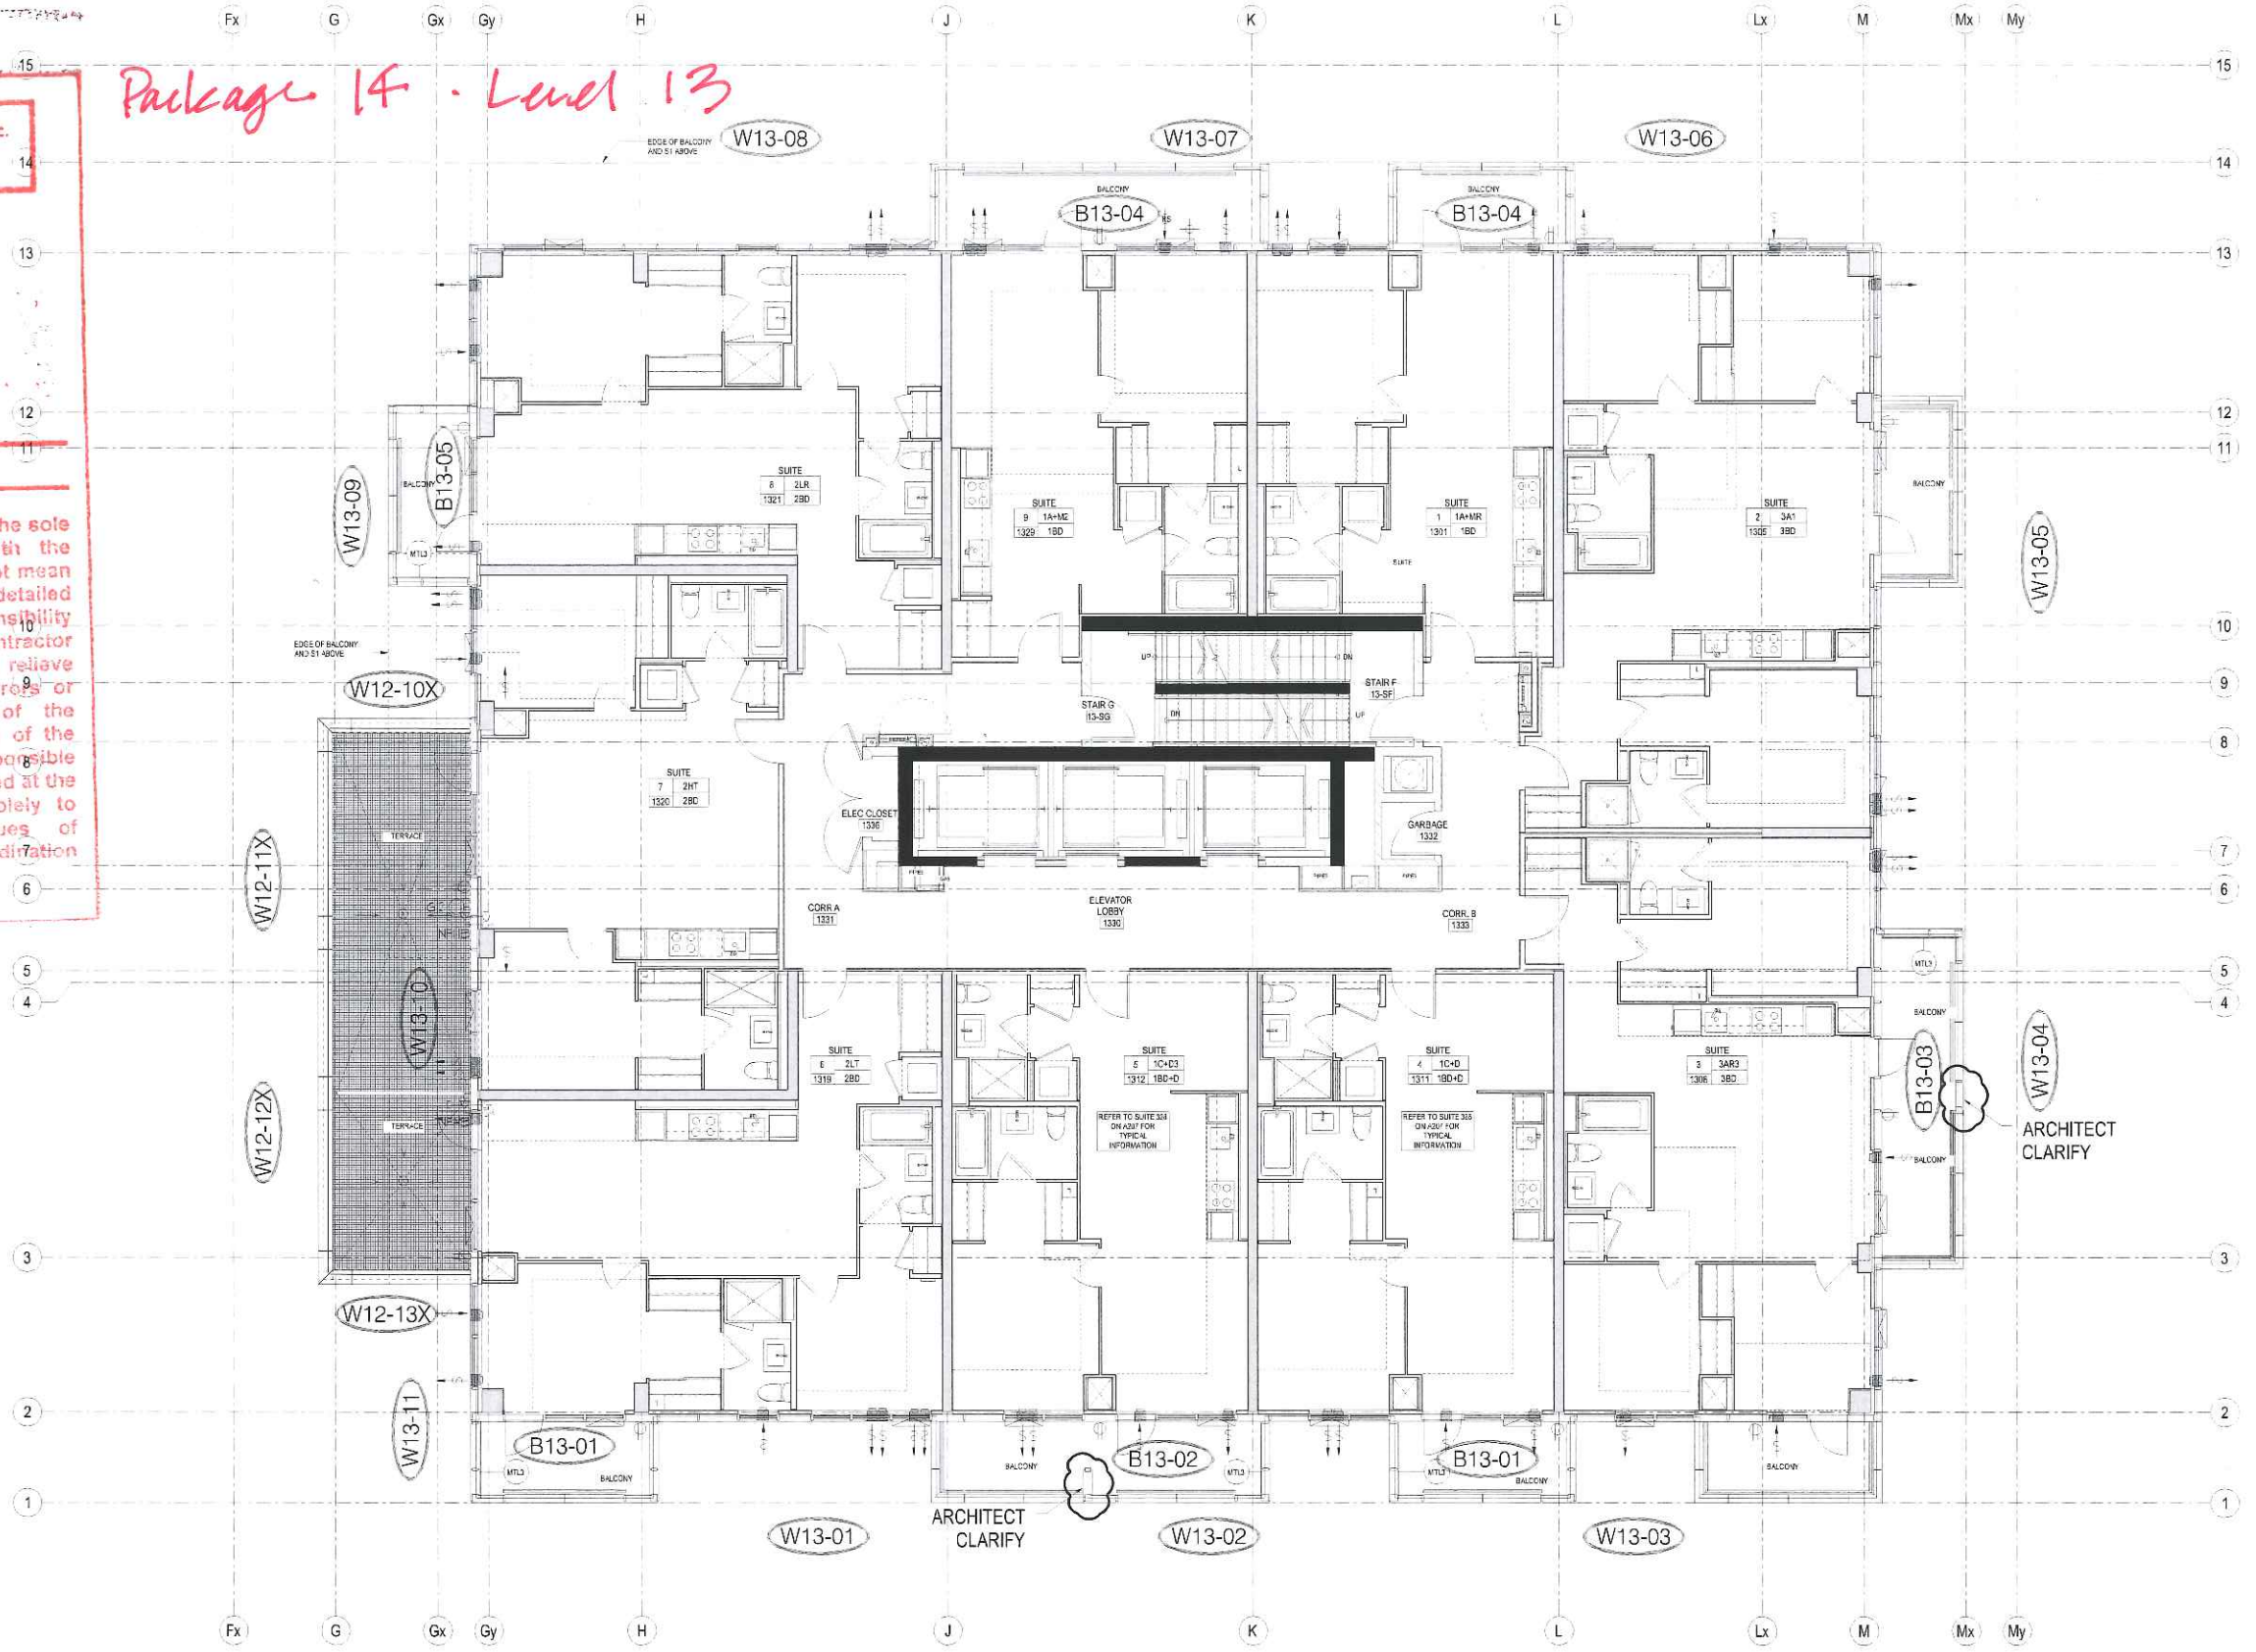

No.	REVISION	BY	DATE


PROJECT NAME:	SQ ALEXANDRA PARK - BLOCK11		
DRAWING TITLE:	13th FLOOR PLAN		
ARCHITECT:	TEEPLA ARCHITECTS		
CONTRACTOR:	TRIDEL		
SCALE:	N/T/S	DRAWN BY:	SC
DATE:	MARCH 4, 2015		
DRAWING No.			F13

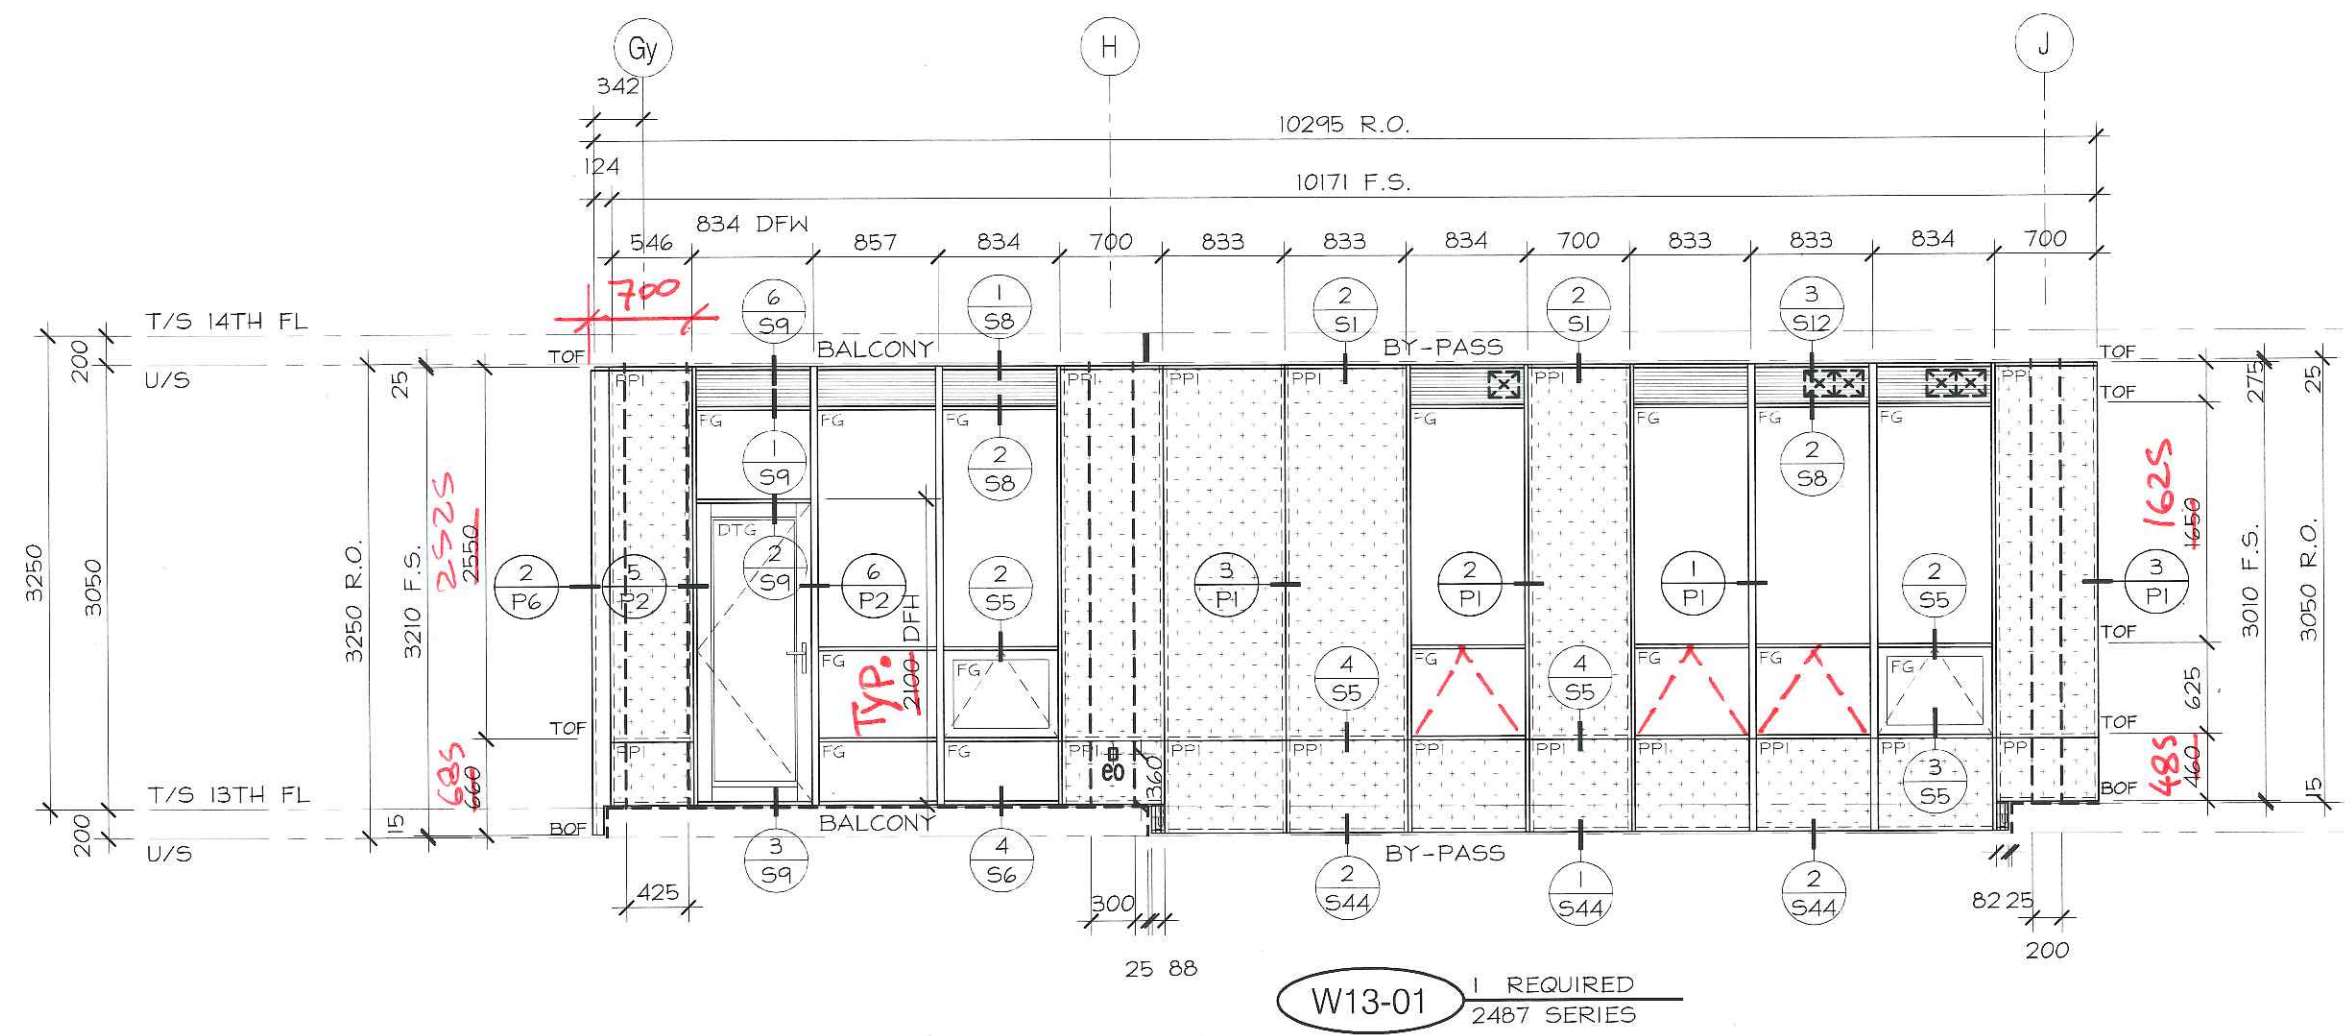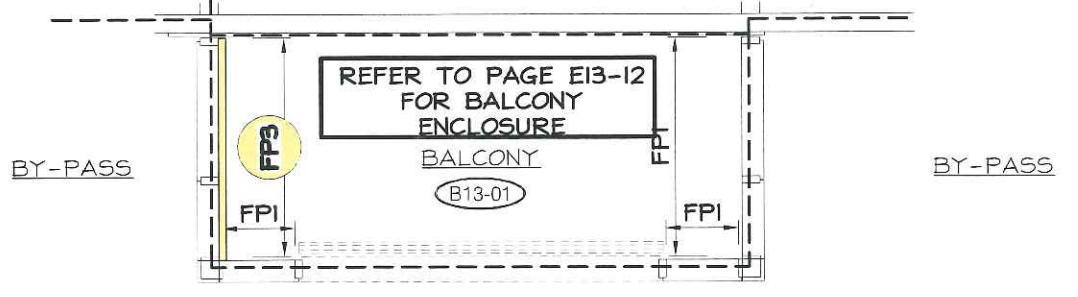


No.	REVISION	BY	DATE

PROJECT NAME:	SQ ALEXANDRA PARK - BLOCK11
DRAWING TITLE:	13th FLOOR ELEVATIONS
ARCHITECT:	TEEPLE ARCHITECTS
CONTRACTOR:	TRIDEL
SCALE:	1:50
DRAWN BY:	S.C.
DATE:	MARCH 4, 2015

DRAWING No.:  
**E13-1**


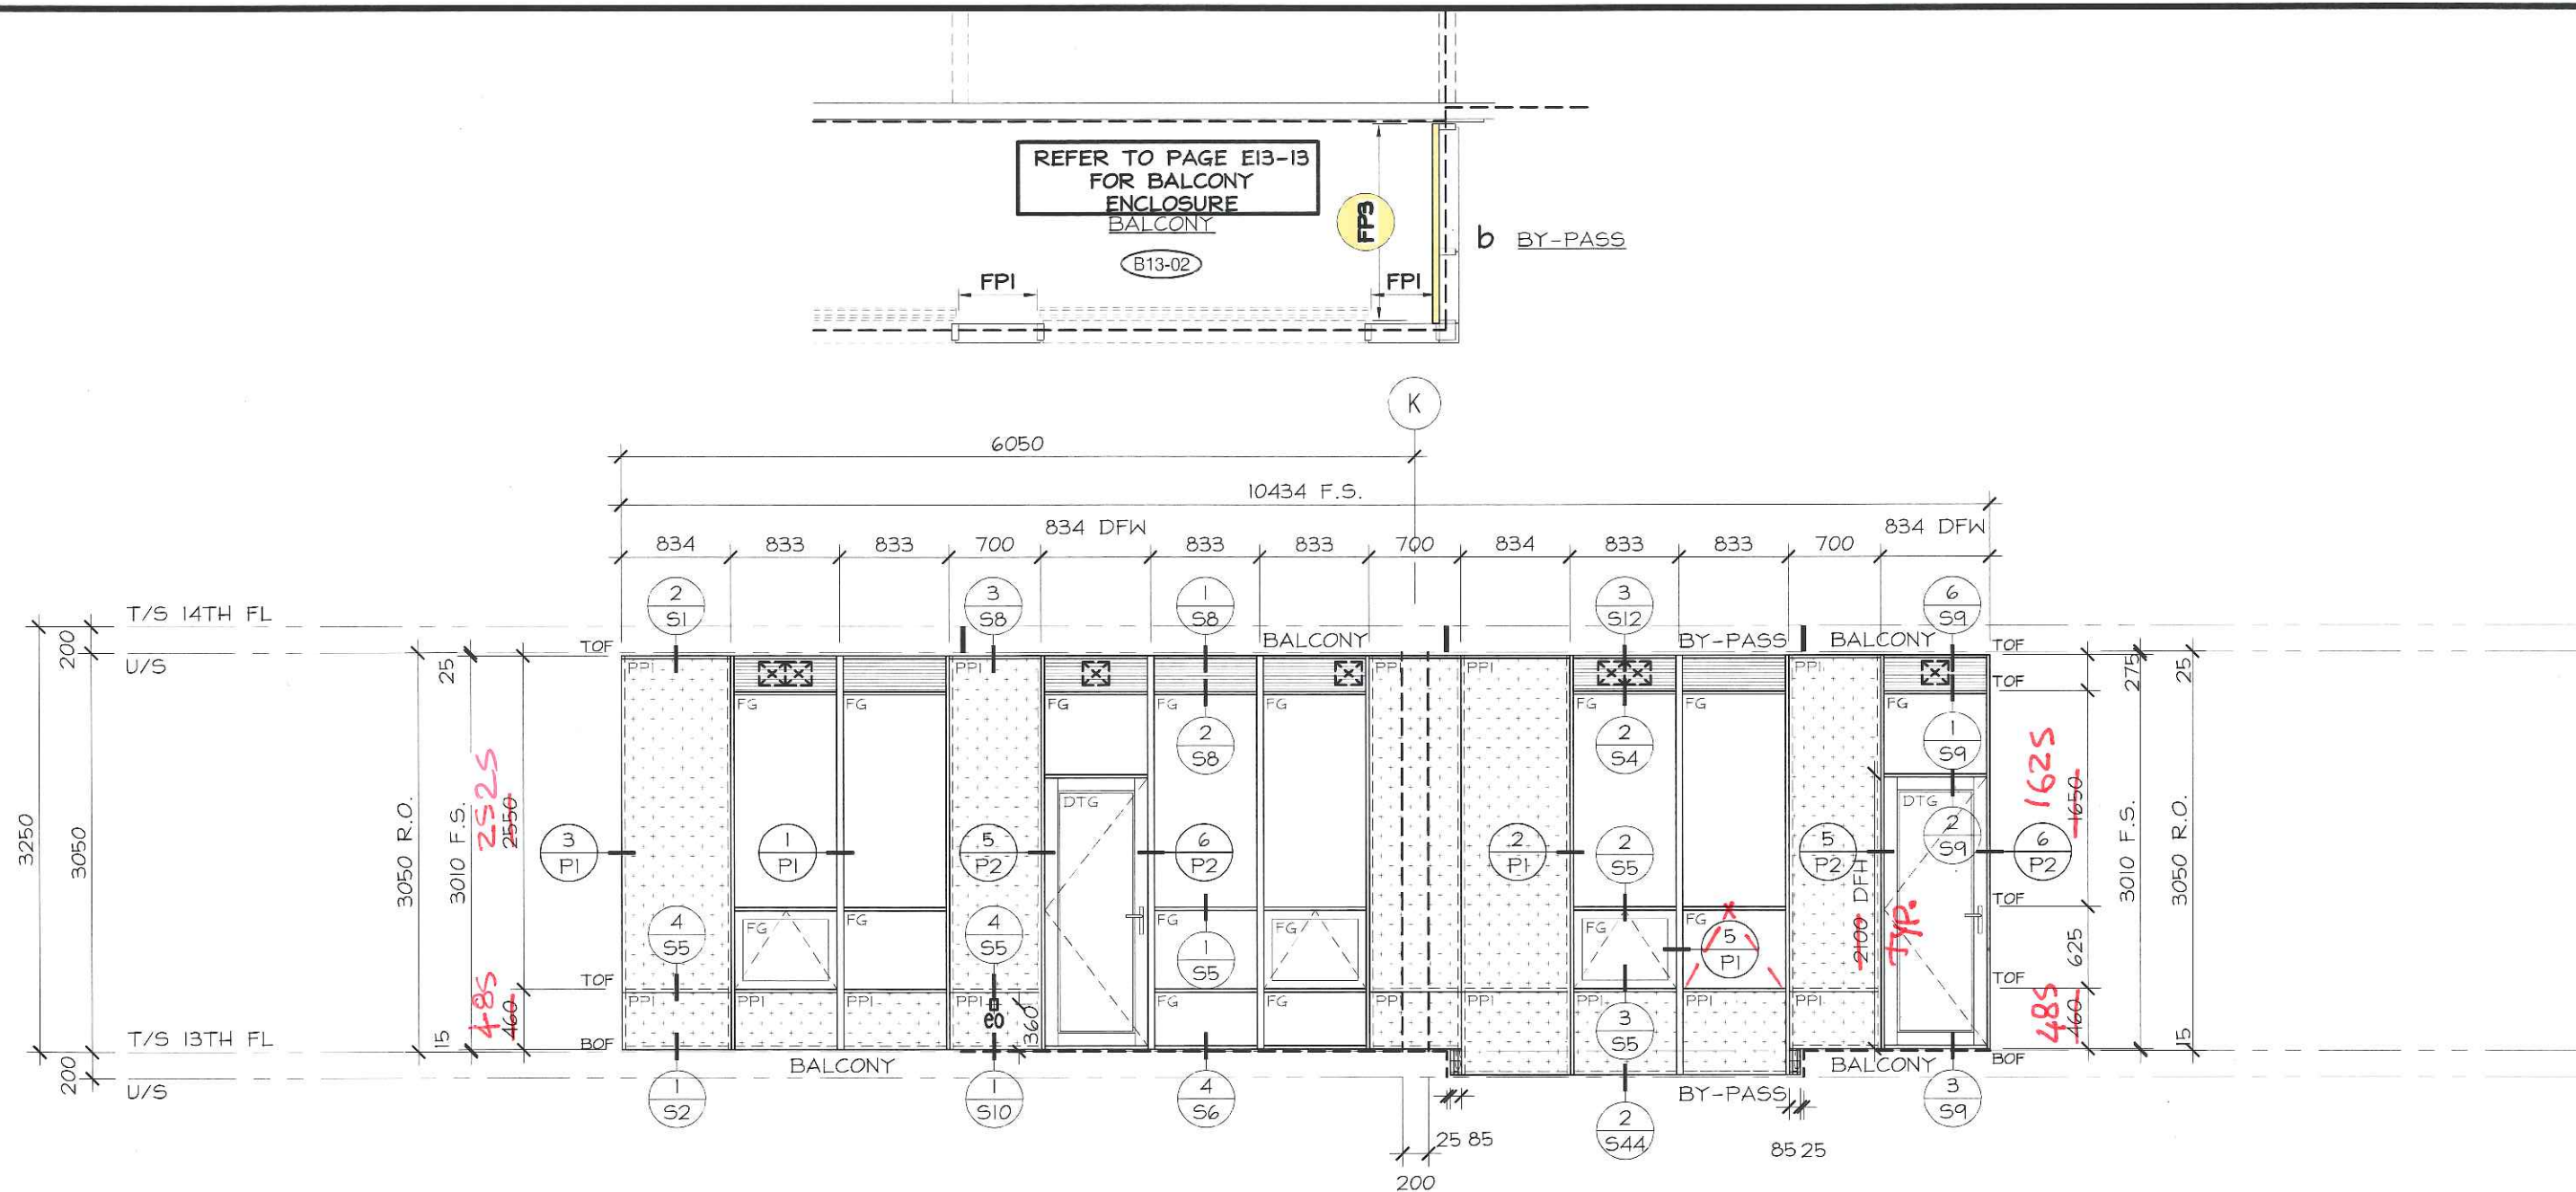


W13-02 1 REQUIRED  
2487 SERIES

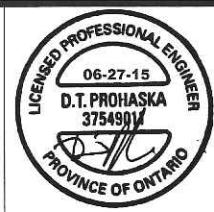

No.	REVISION	BY	DATE

PROJECT NAME: SQ ALEXANDRA PARK - BLOCK 11		DRAWING No.: <b>E13-2</b>
DRAWING TITLE: 13th FLOOR ELEVATIONS		
ARCHITECT: TEEPLE ARCHITECTS		DATE: MARCH 4, 2015
CONTRACTOR: TRIDEL		
SCALE: 1:50	DRAWN BY: S.C.	

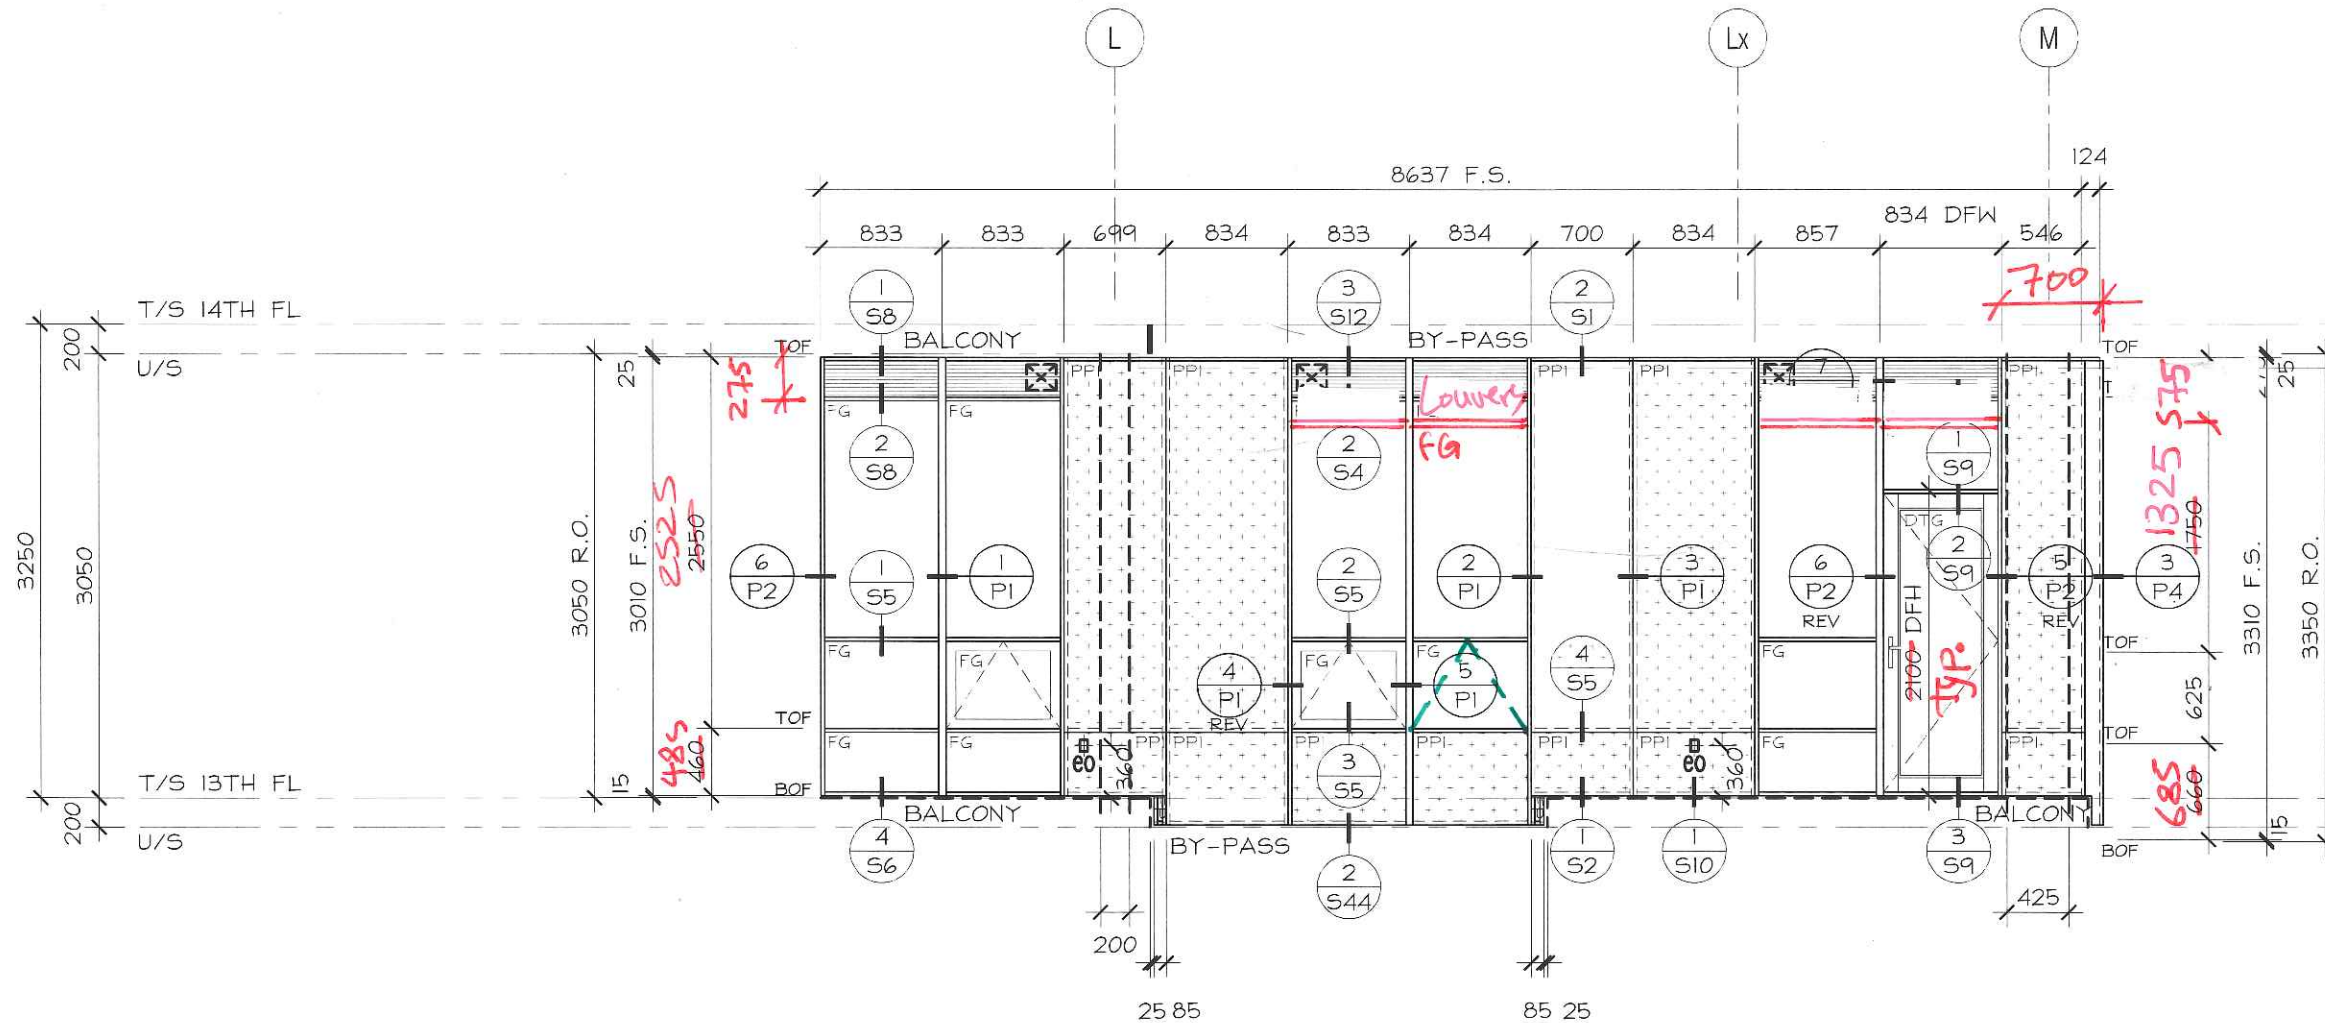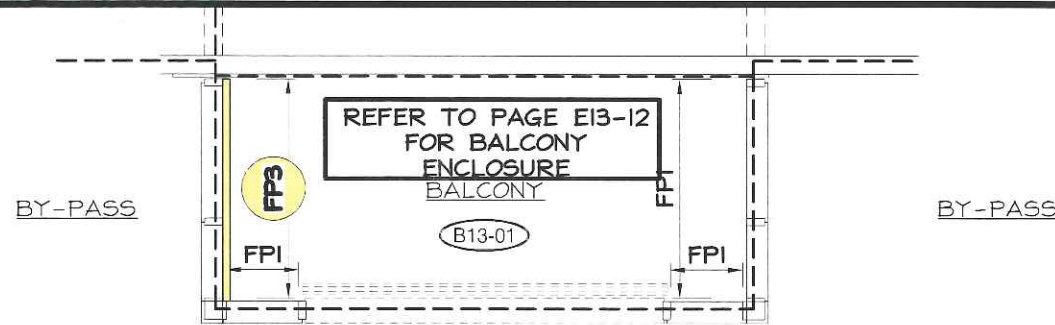

W13-03 1 REQUIRED  
2487 SERIES




No.	REVISION	BY	DATE

PROJECT NAME:	SQ ALEXANDRA PARK - BLOCK11		
DRAWING TITLE:	13th FLOOR ELEVATIONS		
ARCHITECT:	TEEPLE ARCHITECTS		
CONTRACTOR:	TRIDEL		
SCALE:	1:50	DRAWN BY:	S.C.
DATE:		MARCH 4, 2015	

DRAWING No.:  
**E13-3**



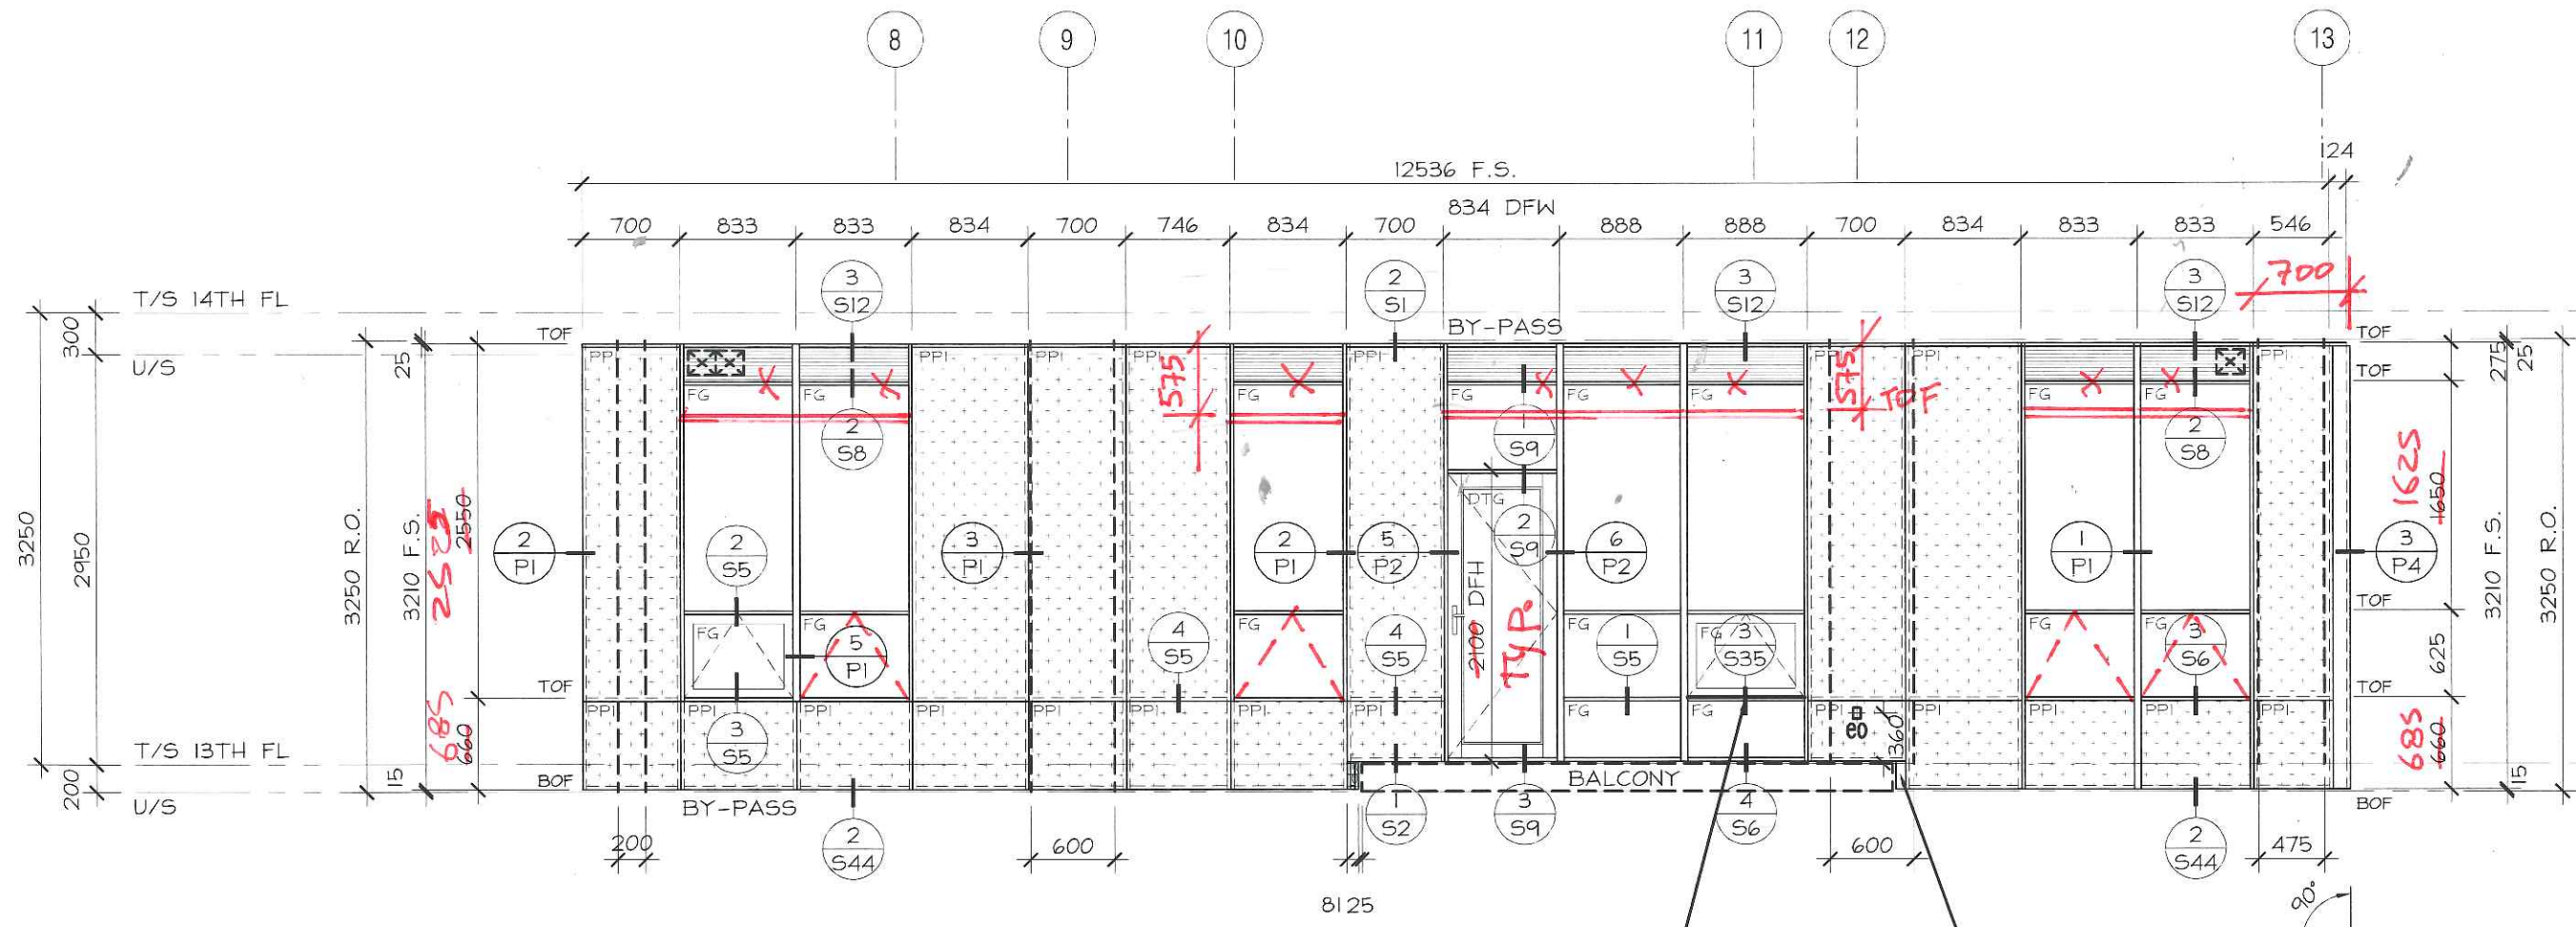



W13-05 1 REQUIRED 2487 SERIES TOE GUARD REQUIRED BREAK SHAPE FILLER ATTACHING TO VERTICAL MULLION



No.	REVISION	BY	DATE

PROJECT NAME:	SQ ALEXANDRA PARK - BLOCK11
DRAWING TITLE:	13th FLOOR ELEVATIONS
ARCHITECT:	TEEPLE ARCHITECTS
CONTRACTOR:	TRIDEL
SCALE:	1:50
DRAWN BY:	S.C.
DATE:	MARCH 4, 2015

DRAWING No.: E13-5

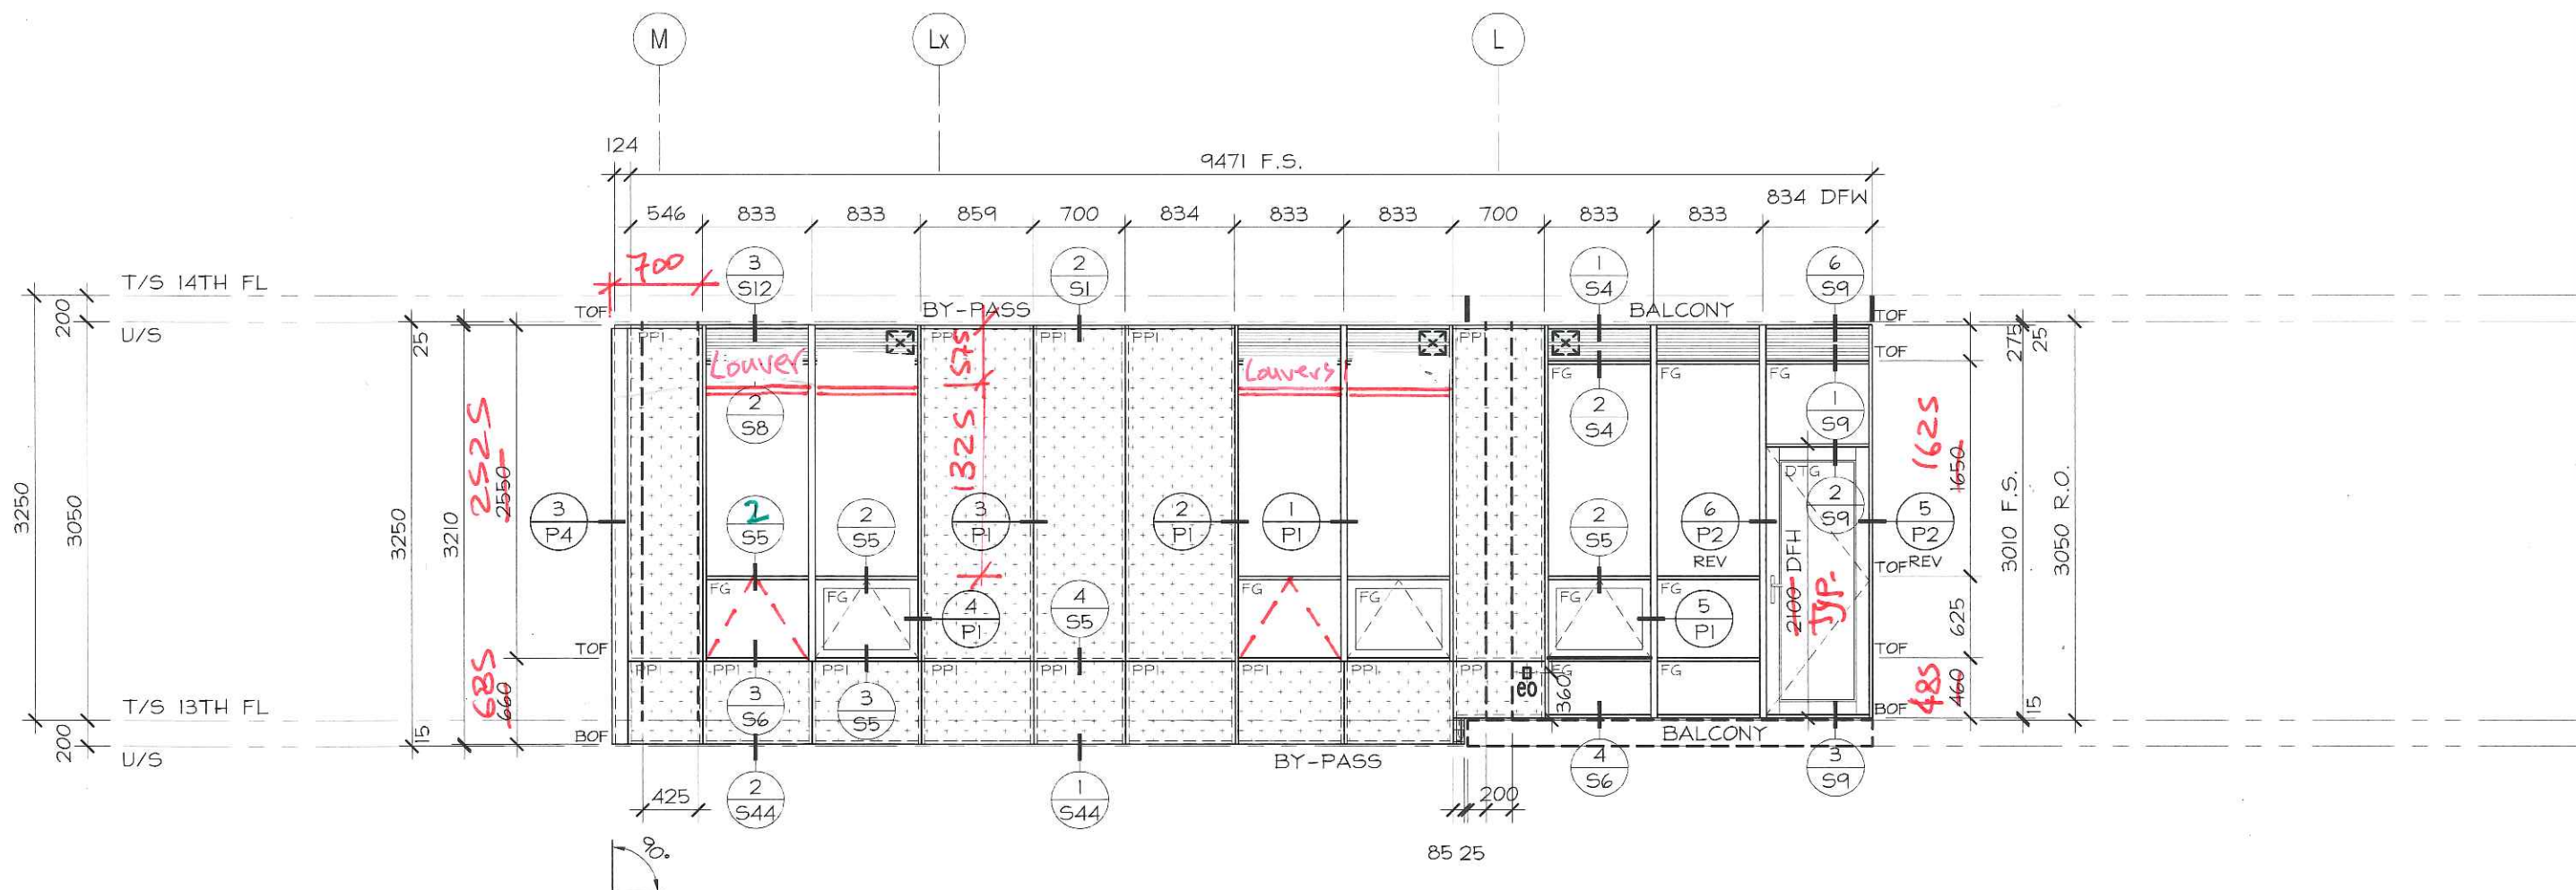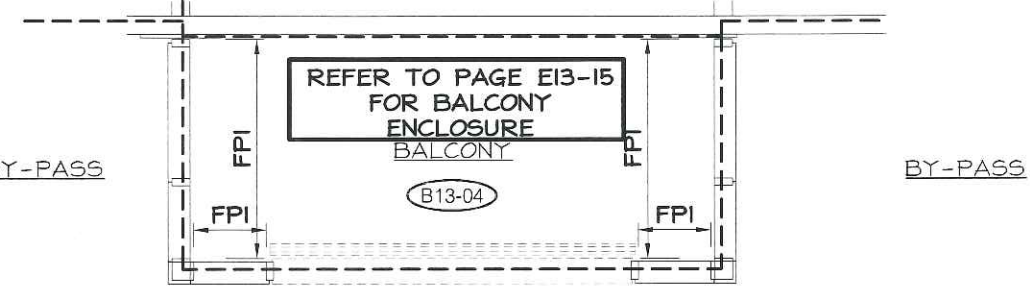


W13-06 | REQUIRED  
2487 SERIES



No.	REVISION	BY	DATE

PROJECT NAME: SQ ALEXANDRA PARK - BLOCK11		DRAWING No.: <b>E13-6</b>
DRAWING TITLE: 13th FLOOR ELEVATIONS		
ARCHITECT: TEEPLE ARCHITECTS		DATE: MARCH 4, 2015
CONTRACTOR: TRIDEL		
SCALE: 1:50	DRAWN BY: S.C.	

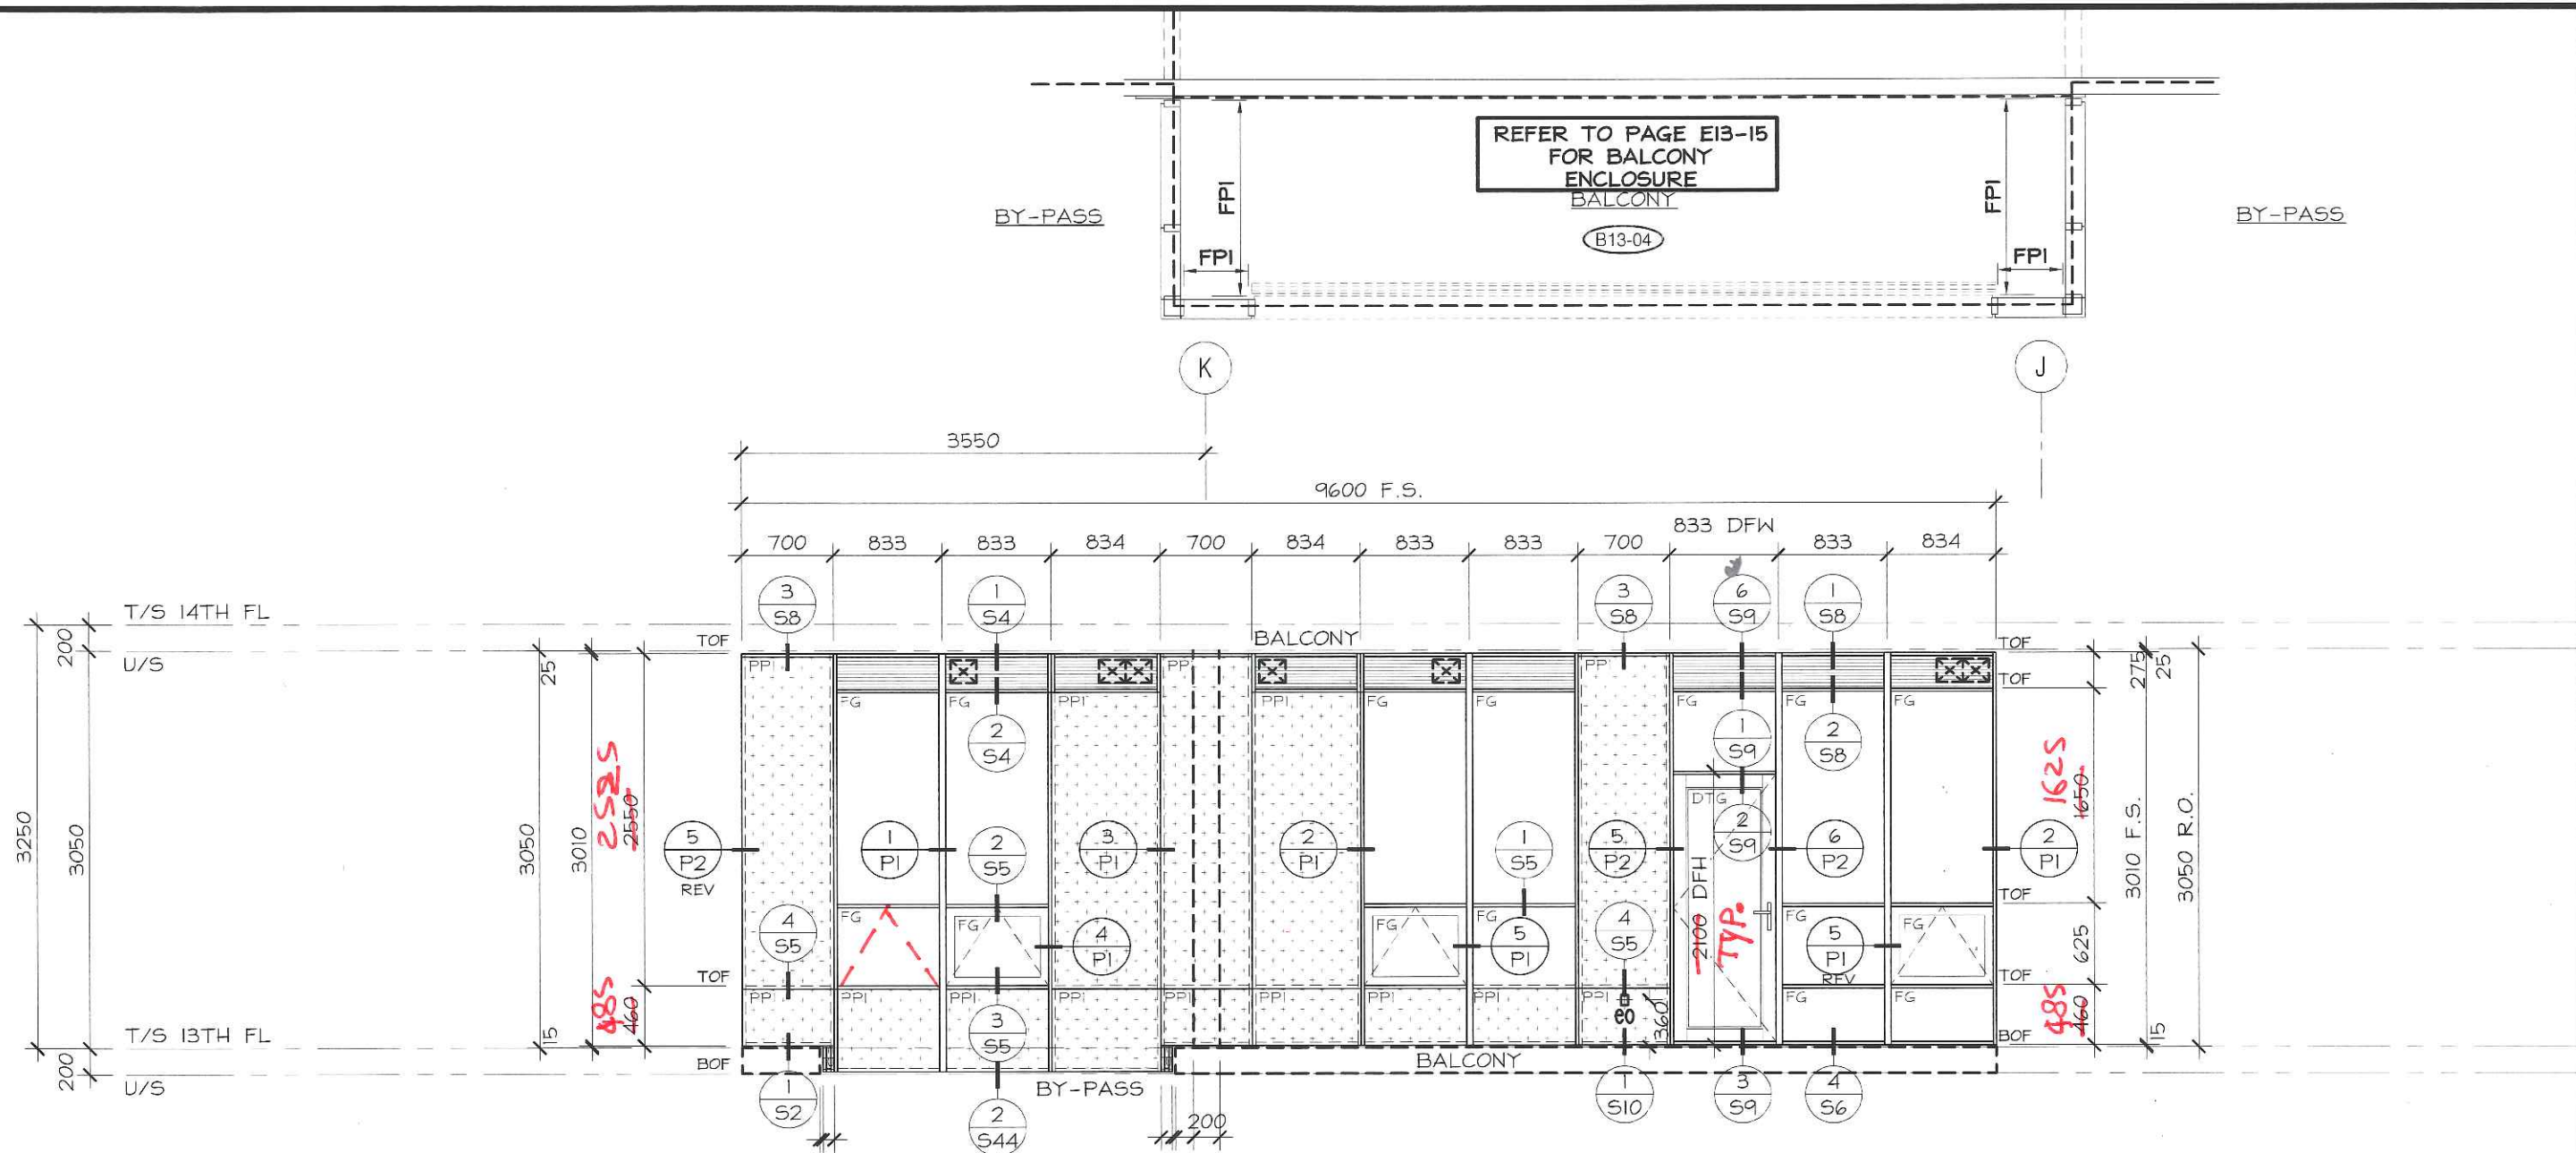


W13-07 1 REQUIRED  
2487 SERIES



No.	REVISION	BY	DATE


PROJECT NAME: SQ ALEXANDRA PARK - BLOCK 11  
 DRAWING TITLE: 13th FLOOR ELEVATIONS  
 ARCHITECT: TEEPLE ARCHITECTS  
 CONTRACTOR: TRIDEL  
 SCALE: 1:50  
 DRAWN BY: S.C.  
 DATE: MARCH 4, 2015

DRAWING No.:  
**E13-7**

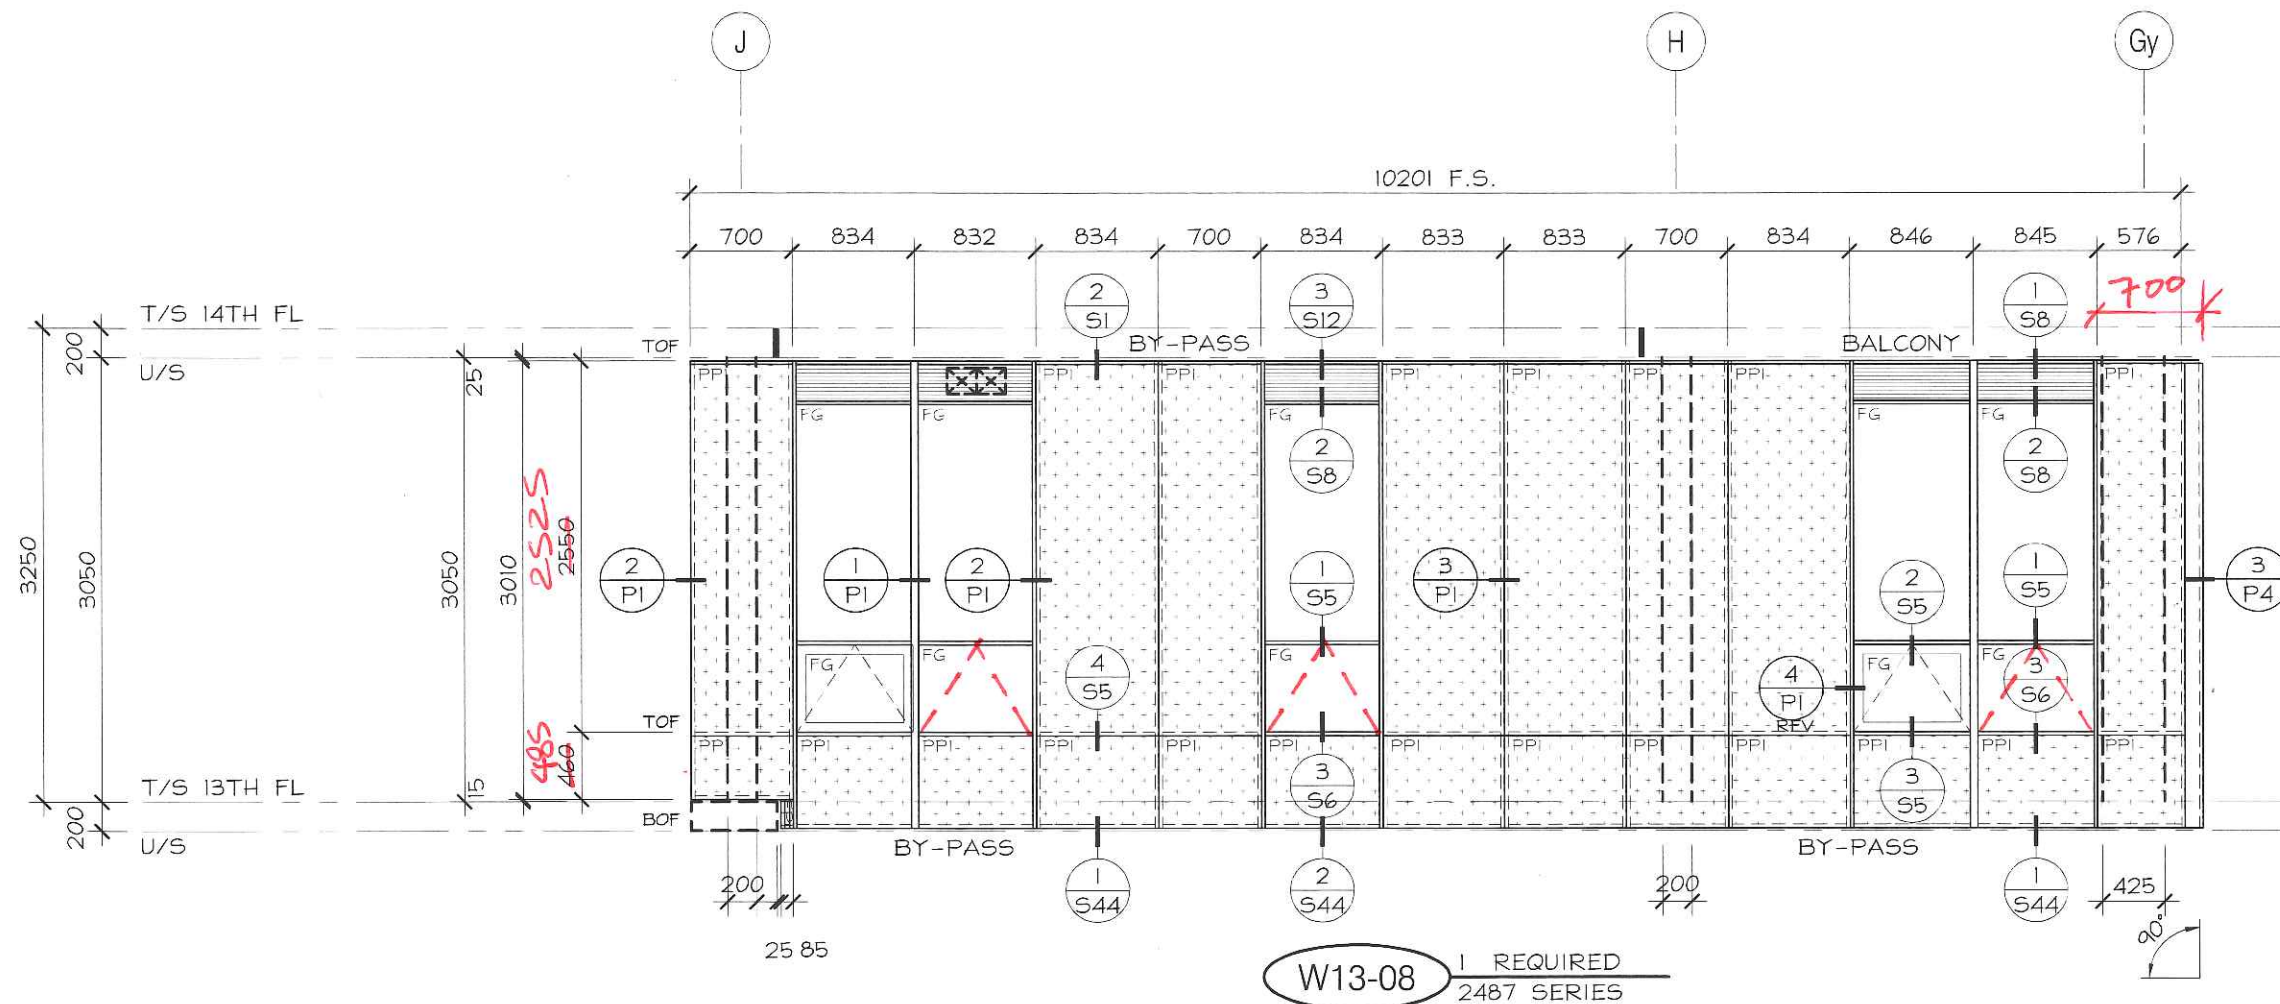


No.	REVISION	BY	DATE

PROJECT NAME: SQ ALEXANDRA PARK - BLOCK 11		DRAWING No.: E13-8
DRAWING TITLE: 13th FLOOR ELEVATIONS		
ARCHITECT: TEEPLE ARCHITECTS		DRAWN BY: S.C.
CONTRACTOR: TRIDEL		
SCALE: 1:50	DATE: MARCH 4, 2015	

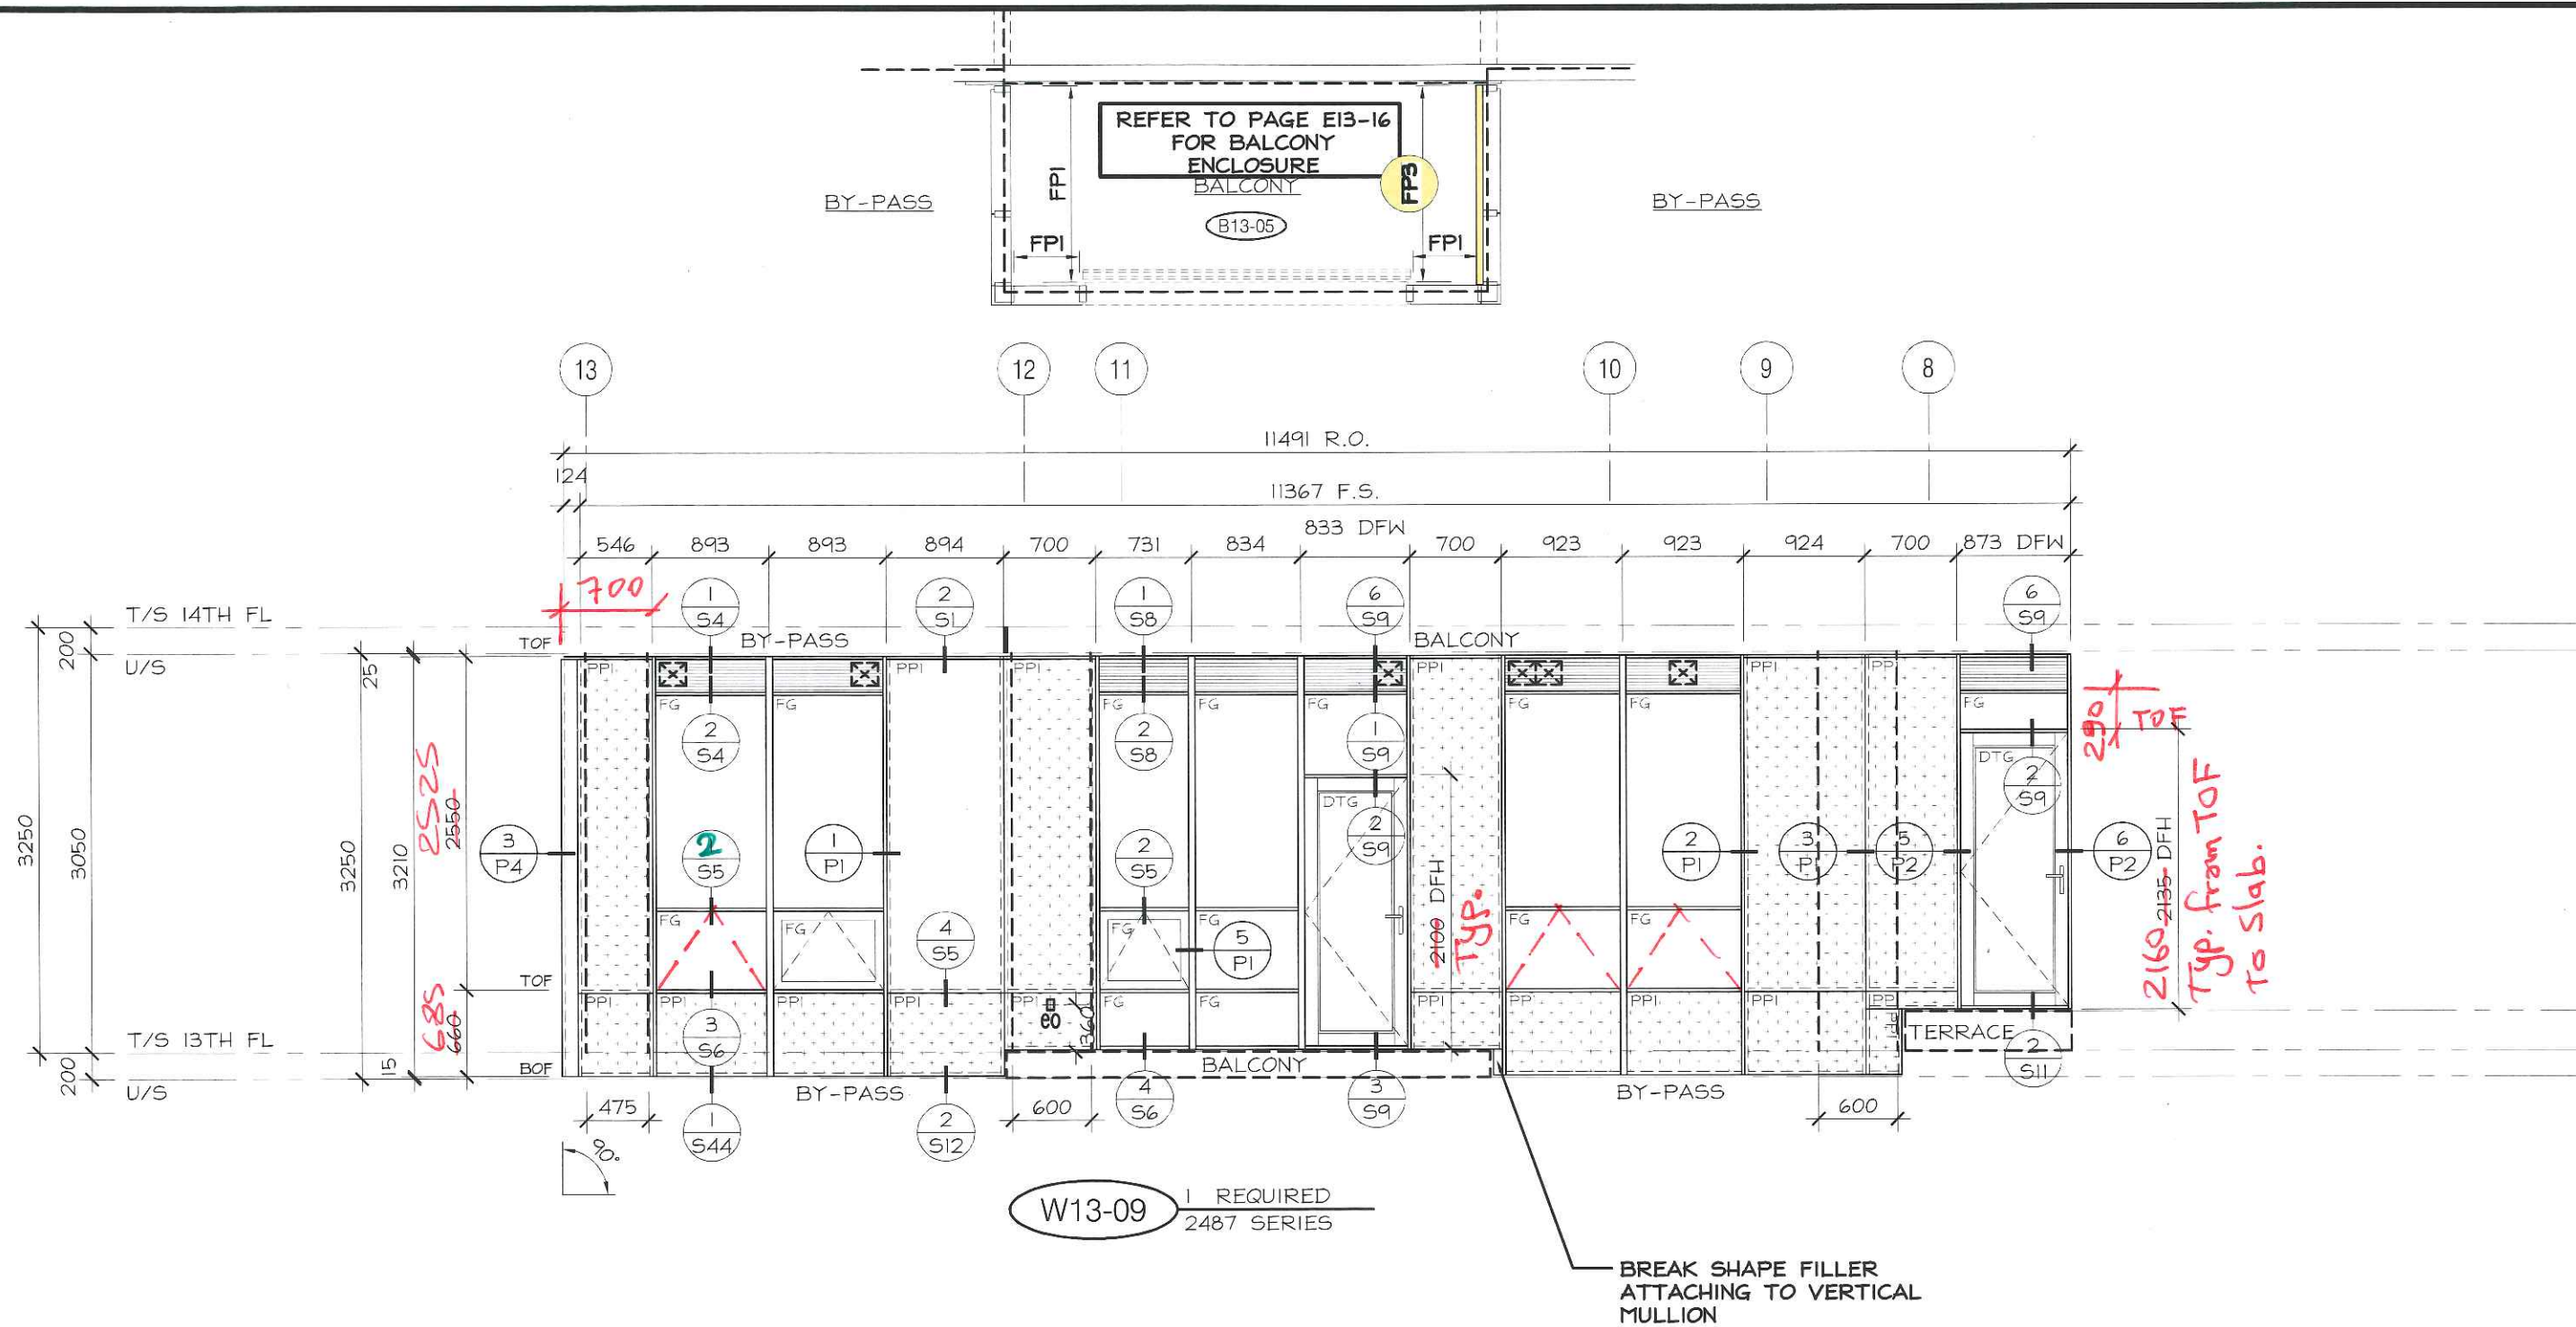

No.	REVISION	BY	DATE

PROJECT NAME:	SQ ALEXANDRA PARK - BLOCK 11		
DRAWING TITLE:	13th FLOOR ELEVATIONS		
ARCHITECT:	TEEPLE ARCHITECTS		
CONTRACTOR:	TRIDEL		
SCALE:	1:50	DRAWN BY:	S.C.
DATE:	MARCH 4, 2015		
DRAWING No.:	E13-9		

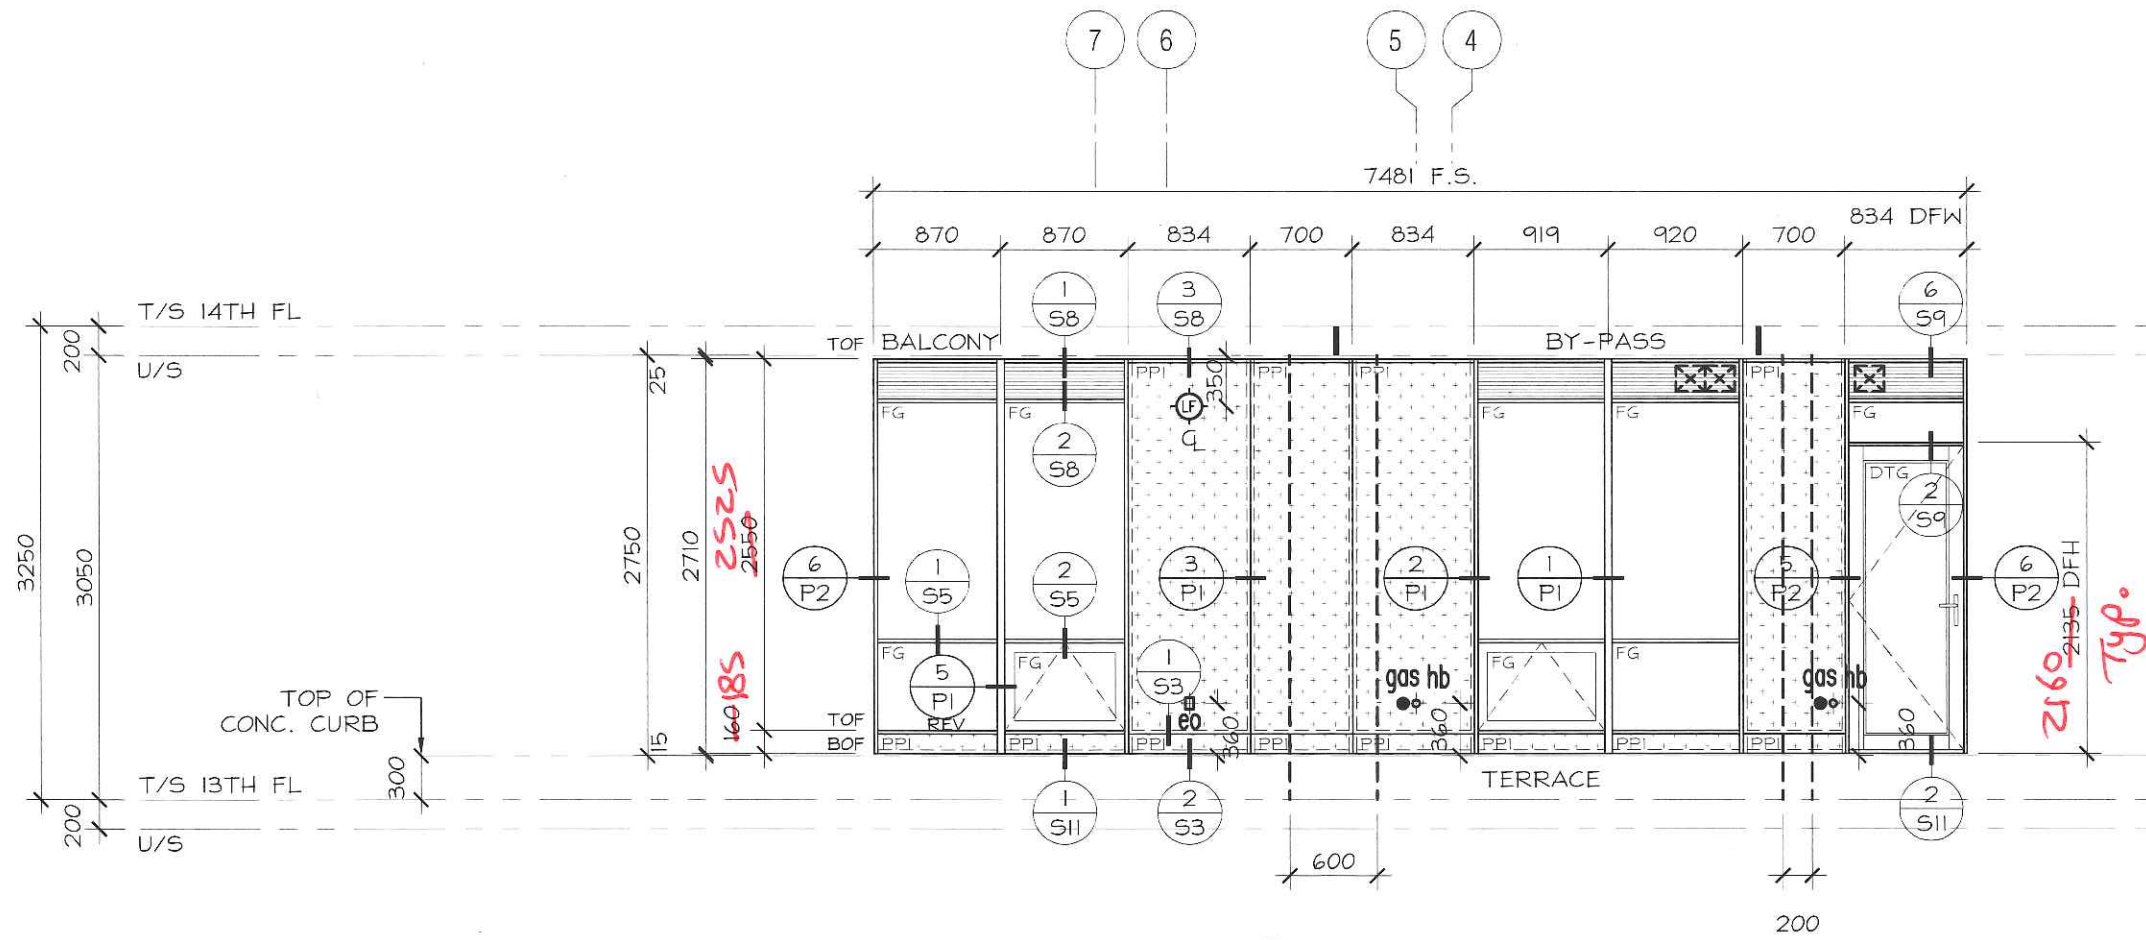


W13-10 1 REQUIRED  
2487 SERIES



No.	REVISION	BY	DATE



PROJECT NAME: SQ ALEXANDRA PARK - BLOCK11		DRAWING No.: <b>E13-10</b>
DRAWING TITLE: 13th FLOOR ELEVATIONS		
ARCHITECT: TEEPLE ARCHITECTS		SCALE: 1:50
CONTRACTOR: TRIDEL		
DRAWN BY: S.C.	DATE: MARCH 4, 2015	

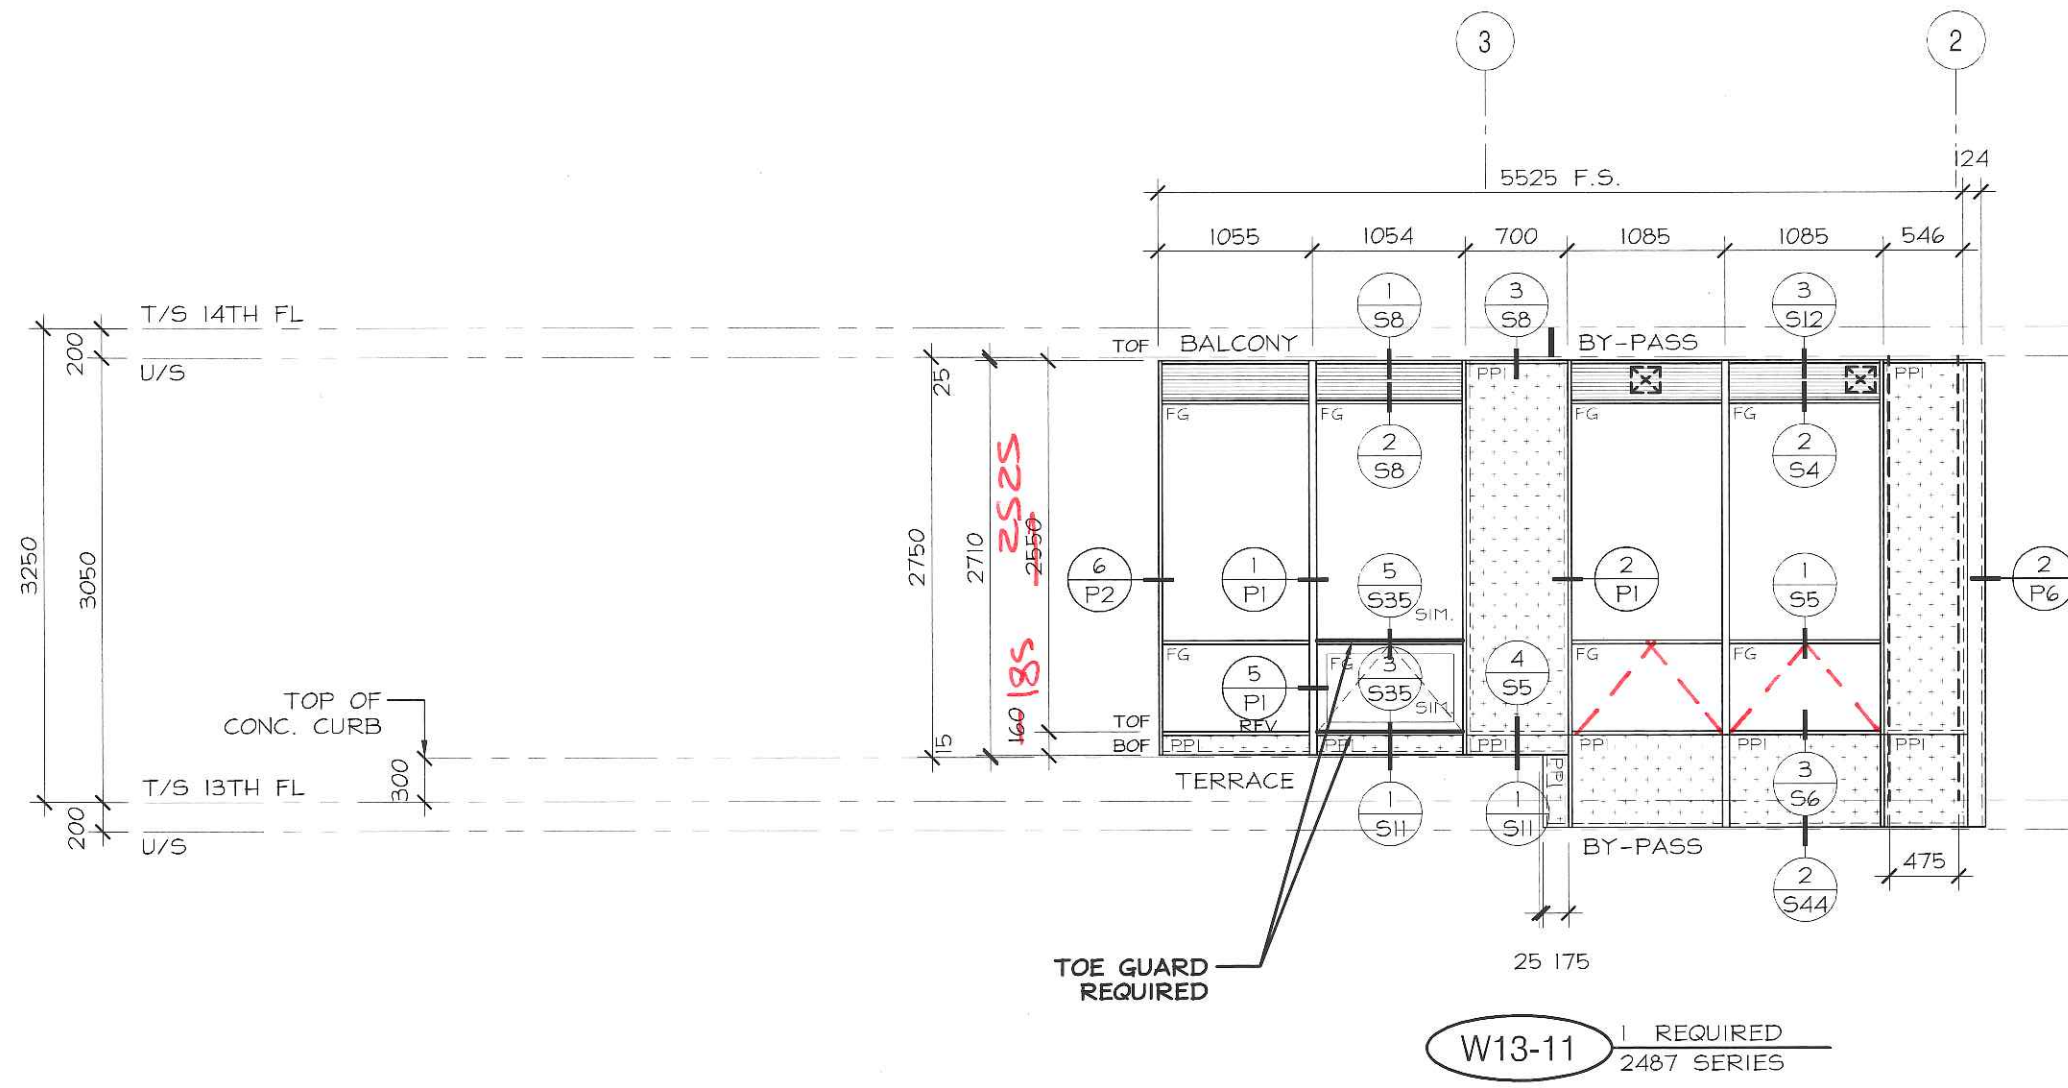

No.	REVISION	BY	DATE

PROJECT NAME: SQ ALEXANDRA PARK - BLOCK11		DRAWING No.:	
DRAWING TITLE: 13th FLOOR ELEVATIONS		E13-11	
ARCHITECT: TEEPLE ARCHITECTS		DRAWN BY: S.C.	
CONTRACTOR: TRIDEL		DATE: MARCH 4, 2015	
SCALE: 1:50			

FOR ALUMINUM BALCONY  
 & TERRACE RAILINGS  
 REFER TO TORO  
 ALUMINUM RAILING SHOP  
 DRAWINGS

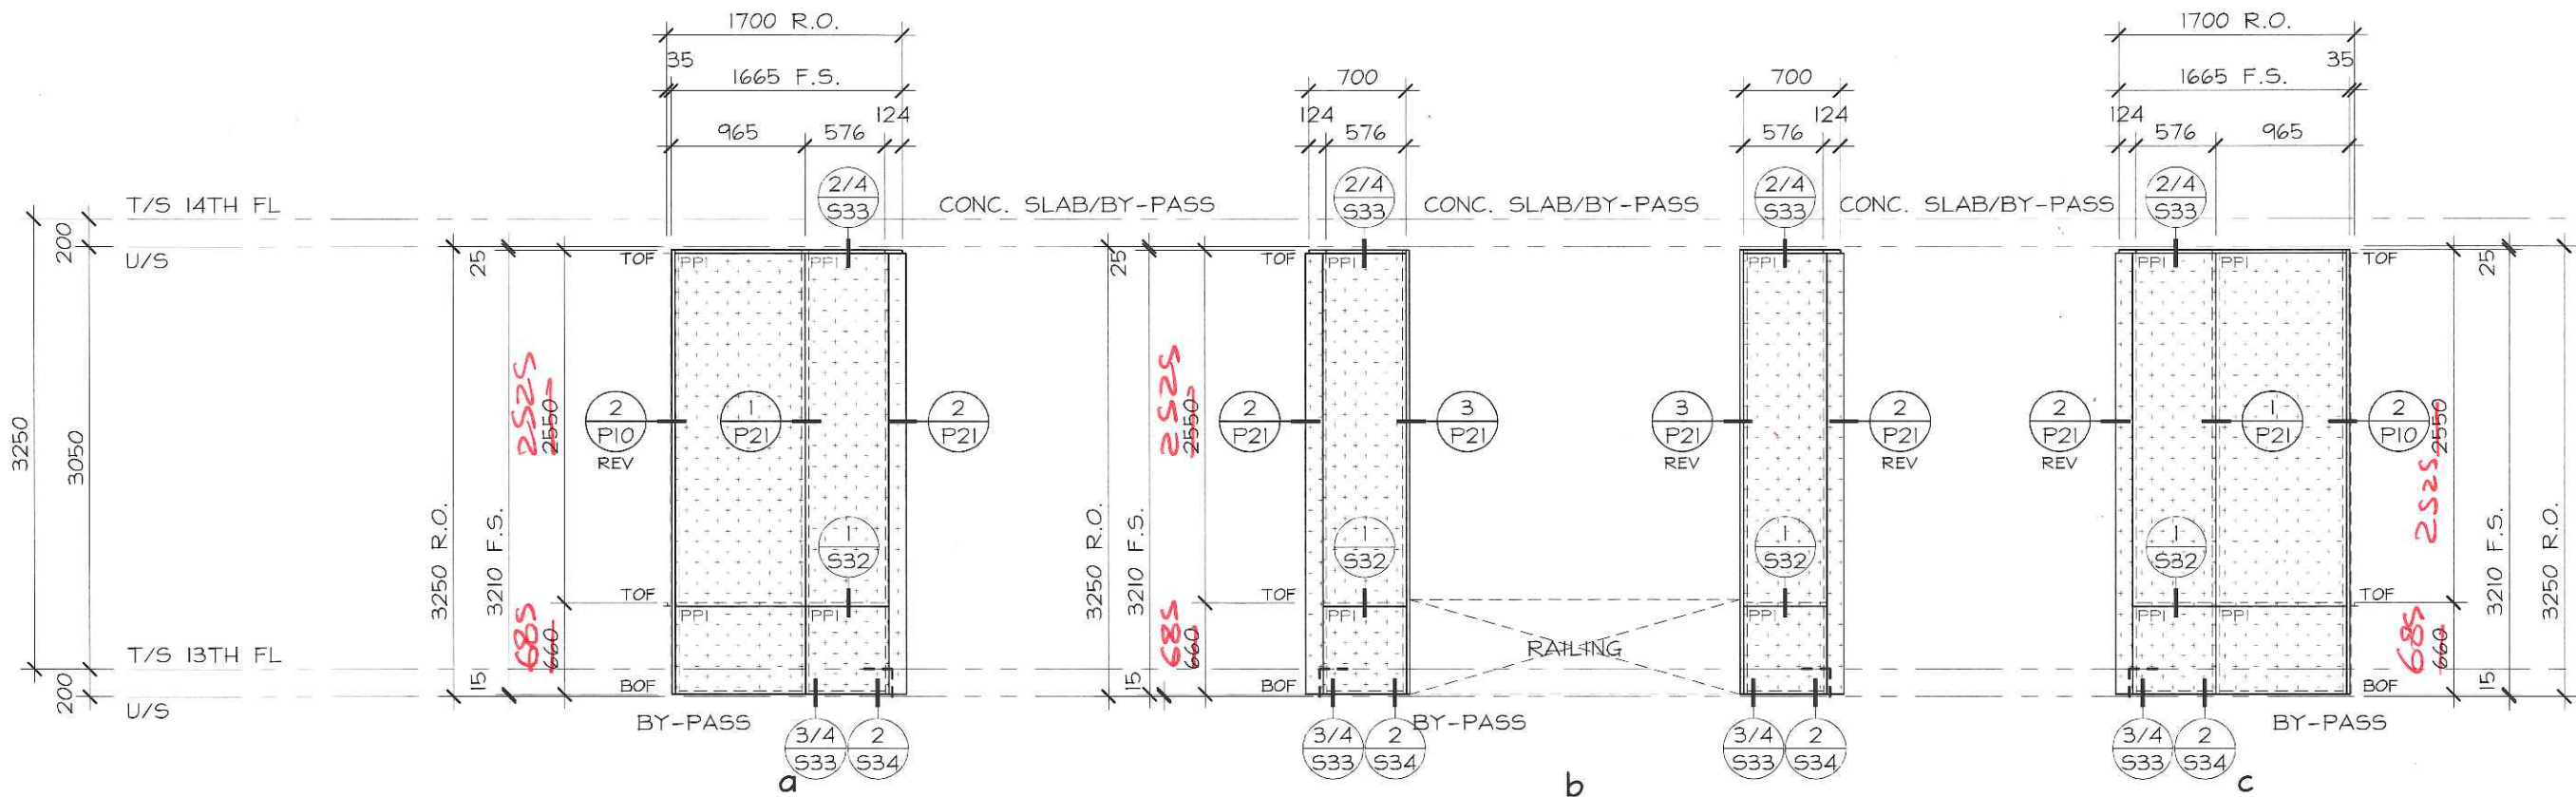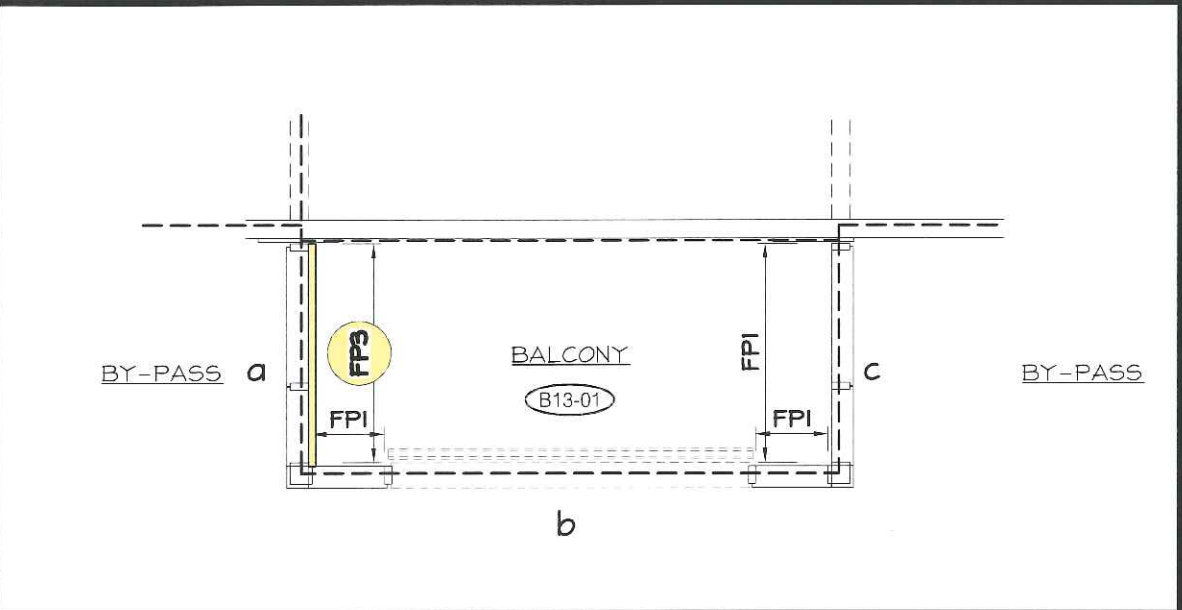



**B13-01** 2 REQUIRED  
 2487 SERIES  
 EXT. FINISH: PPG ACRYNAR PLATINUM UCFX11185  
 INT. FINISH: PPG ACRYNAR PLATINUM UCFX11185  
 a INT. FINISH: PPG ACRYNAR T.B.D.



No.	REVISION	BY	DATE


PROJECT NAME:	SQ ALEXANDRA PARK - BLOCK11		
DRAWING TITLE:	13th FLOOR ELEVATIONS		
ARCHITECT:	TEEPLE ARCHITECTS		
CONTRACTOR:	TRIDEL		
SCALE:	1:50	DRAWN BY:	S.C.
DATE:	MARCH 4, 2015		
DRAWING No.:	E13-12		

FOR ALUMINUM BALCONY & TERRACE RAILINGS REFER TO TORO ALUMINUM RAILING SHOP DRAWINGS

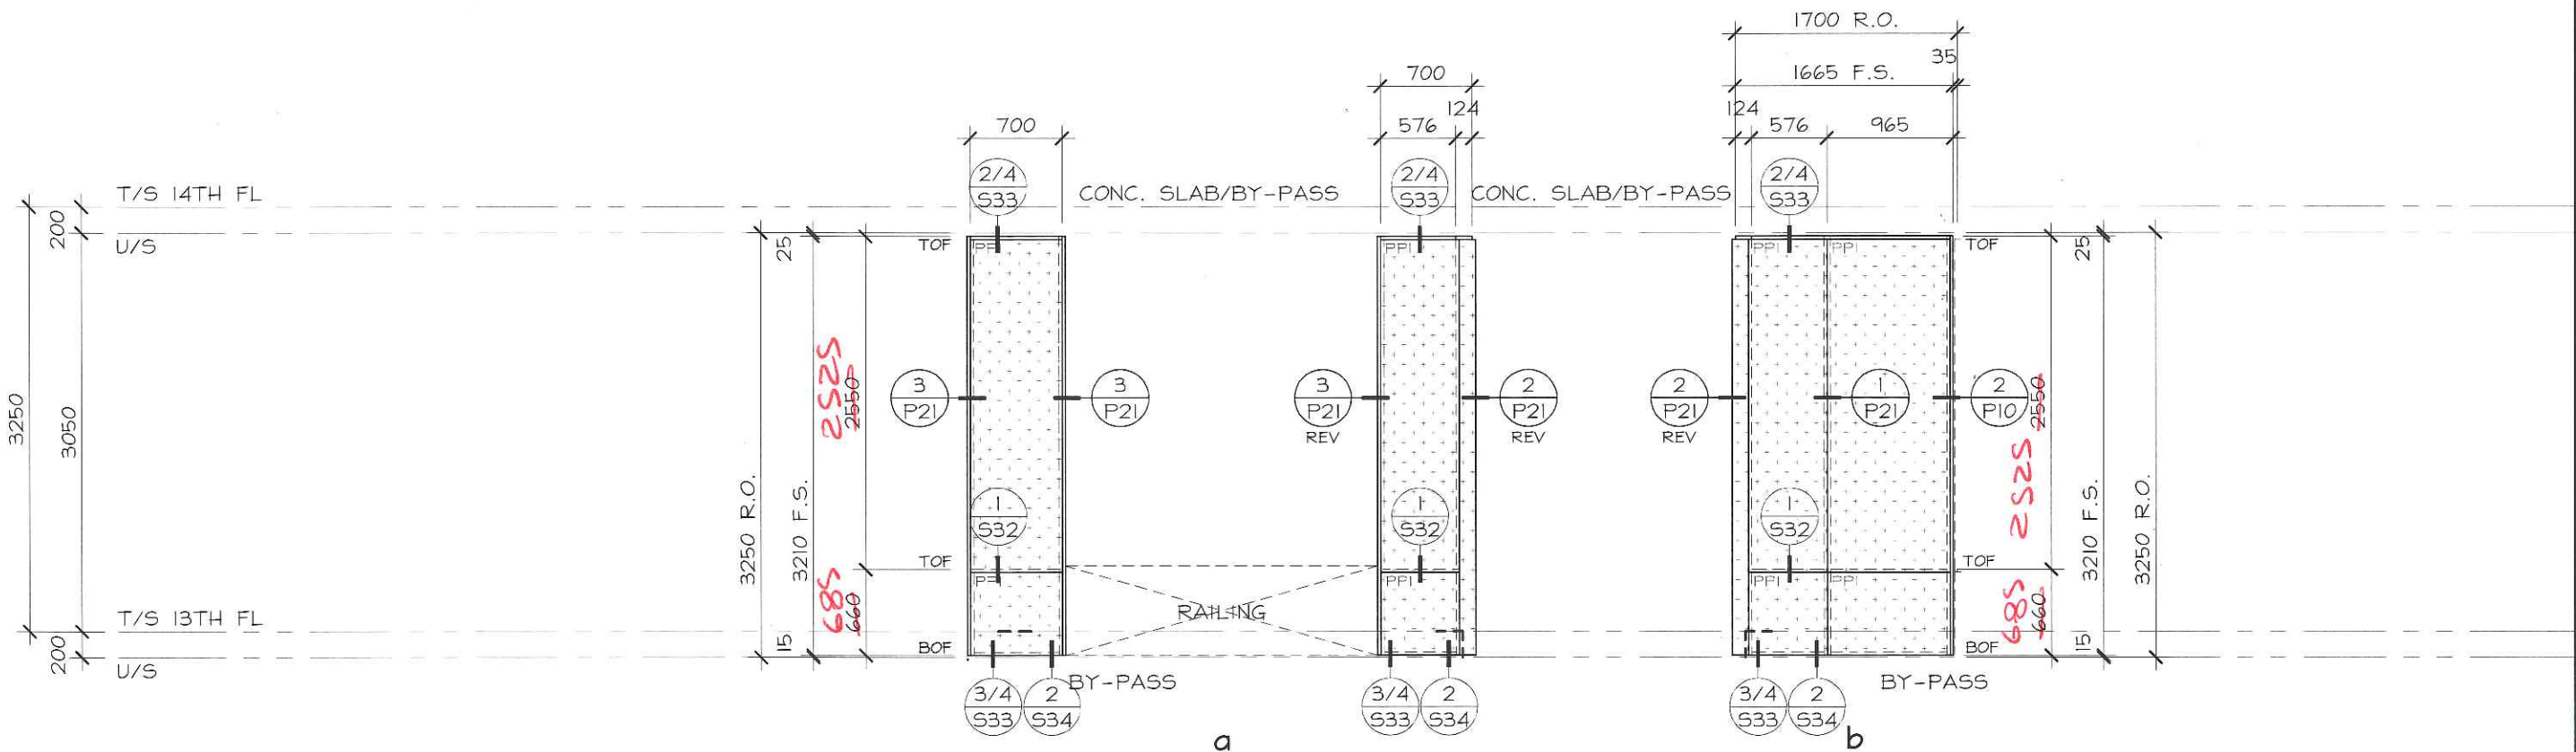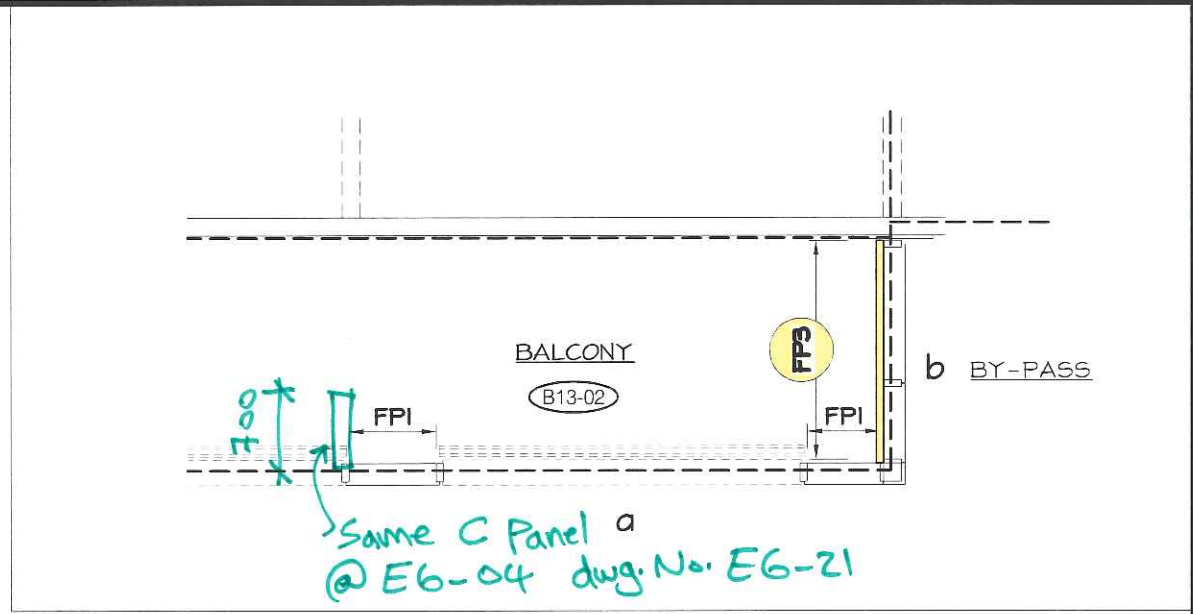

B13-02



1 REQUIRED  
 2487 SERIES  
 EXT. FINISH: PPG ACRYNAR PLATINUM UCFXIII85  
 INT. FINISH: PPG ACRYNAR PLATINUM UCFXIII85  
 INT. FINISH: PPG ACRYNAR T.B.D.

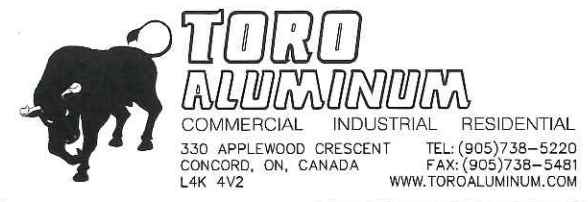

No.	REVISION	BY	DATE

PROJECT NAME: SQ ALEXANDRA PARK - BLOCK11		DRAWING No.: E13-13
DRAWING TITLE: 13th FLOOR ELEVATIONS		
ARCHITECT: TEEPLE ARCHITECTS		DATE: MARCH 4, 2015
CONTRACTOR: TRIDEL		
SCALE: 1:50	DRAWN BY: S.C.	

FOR ALUMINUM BALCONY & TERRACE RAILINGS REFER TO TORO ALUMINUM RAILING SHOP DRAWINGS

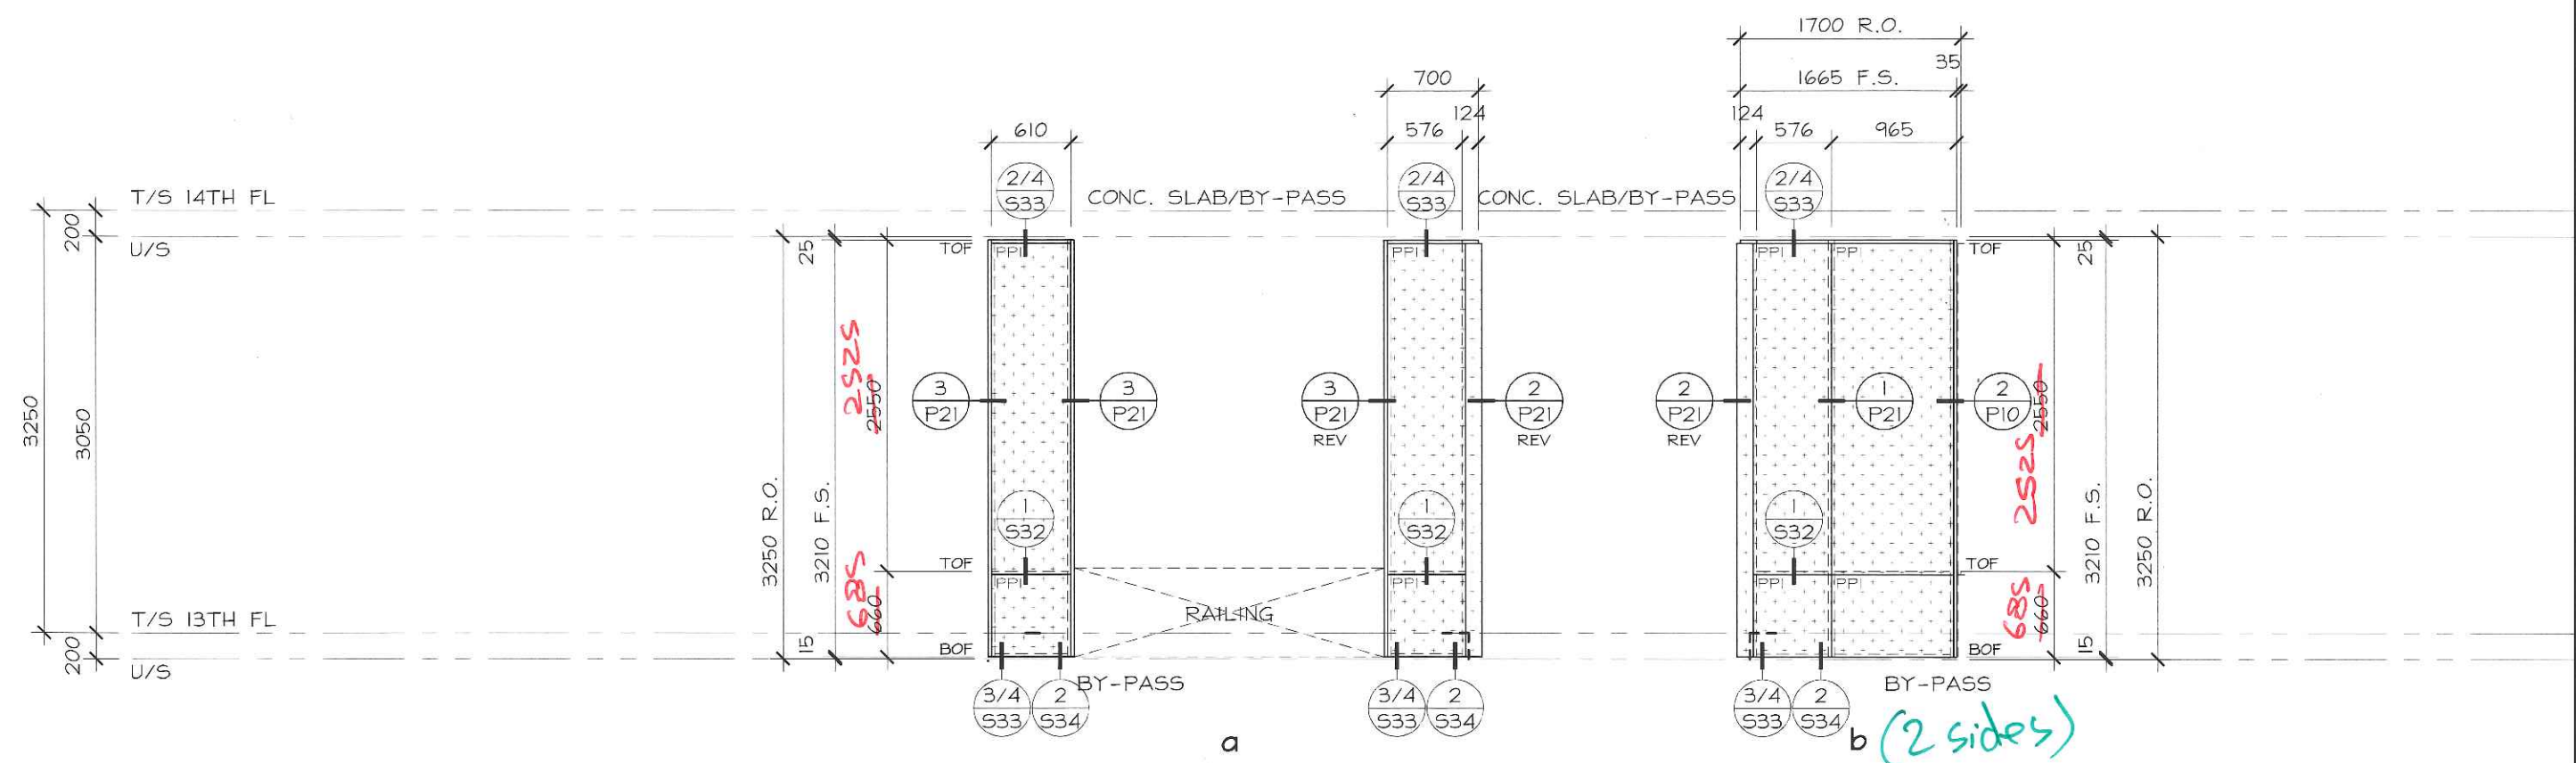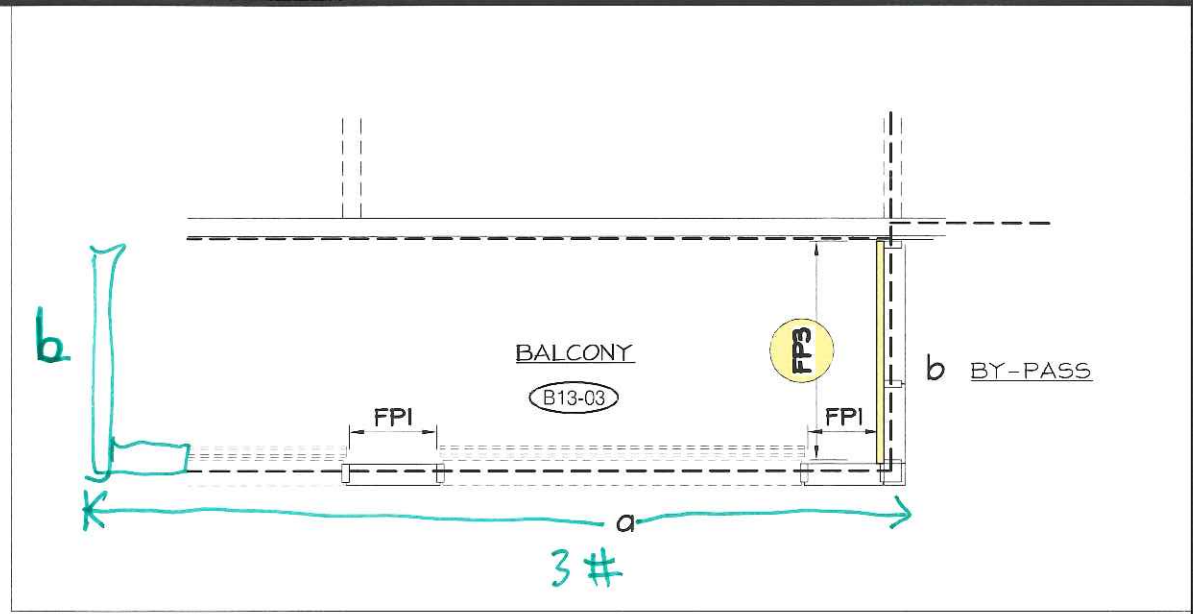



**B13-03** 1 REQUIRED  
 2487 SERIES  
 EXT. FINISH: PPG ACRYNAR PLATINUM UCFXIII85  
 INT. FINISH: PPG ACRYNAR PLATINUM UCFXIII85  
**b** INT. FINISH: PPG ACRYNAR T.B.D.




No.	REVISION	BY	DATE

PROJECT NAME: SQ ALEXANDRA PARK - BLOCK11		DRAWING No.: E13-14
DRAWING TITLE: 13th FLOOR ELEVATIONS		
ARCHITECT: TEEPLE ARCHITECTS		DATE: MARCH 4, 2015
CONTRACTOR: TRIDEL		
SCALE: 1:50	DRAWN BY: S.C.	

FOR ALUMINUM BALCONY  
 & TERRACE RAILINGS  
 REFER TO TORO  
 ALUMINUM RAILING SHOP  
 DRAWINGS

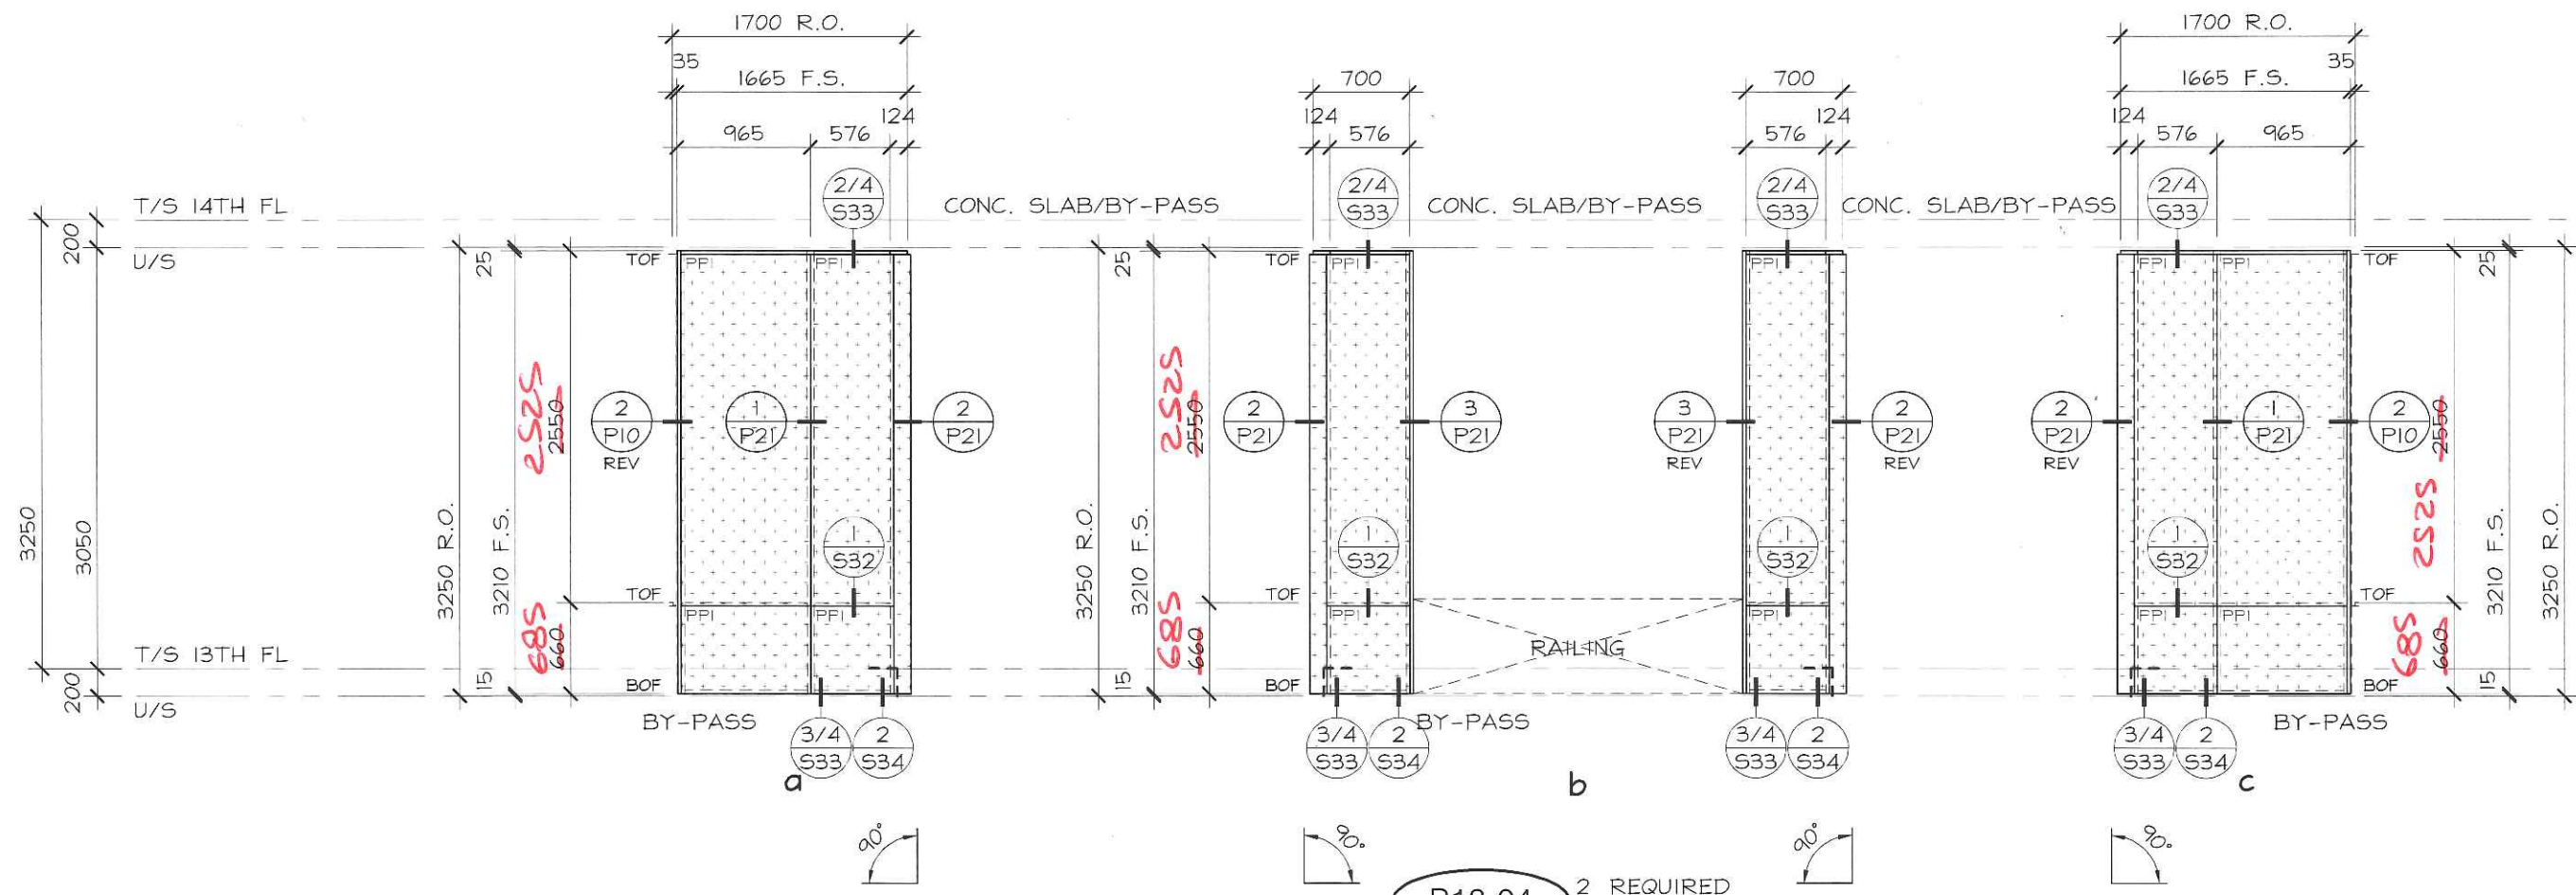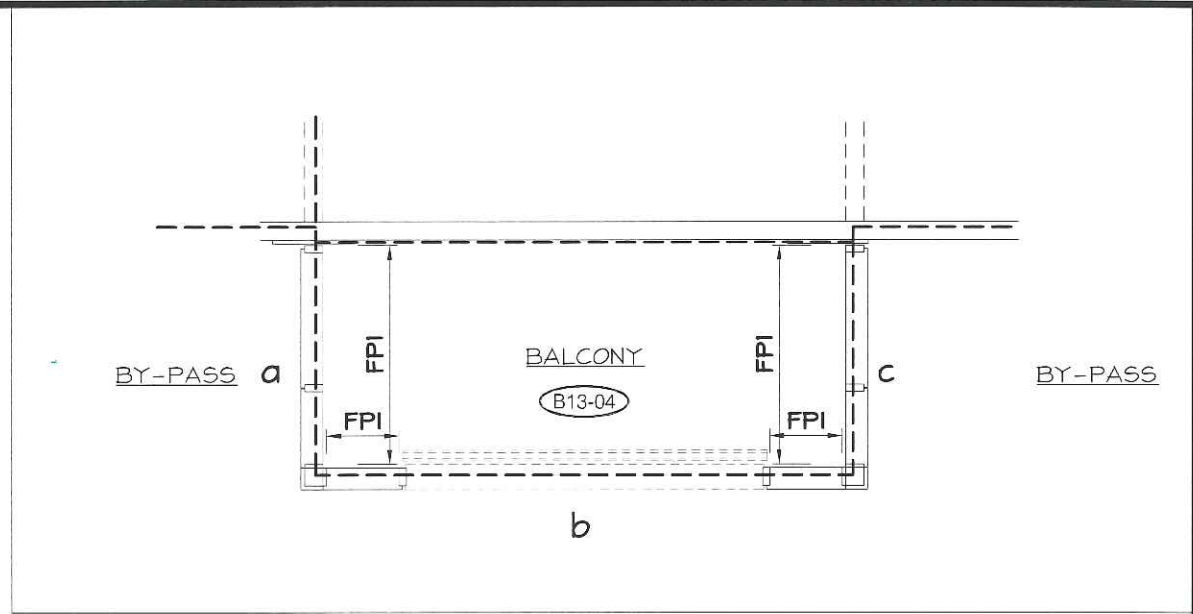



**B13-04** 2 REQUIRED  
 2487 SERIES  
 EXT. FINISH: PPG ACRYNAR PLATINUM UCFXIII85  
 INT. FINISH: PPG ACRYNAR PLATINUM UCFXIII85

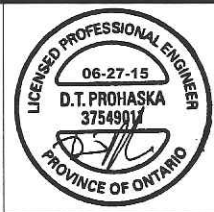

No.	REVISION	BY	DATE

PROJECT NAME:	SQ ALEXANDRA PARK - BLOCK11		
DRAWING TITLE:	13th FLOOR ELEVATIONS		
ARCHITECT:	TEEPLE ARCHITECTS		DRAWING No.:
CONTRACTOR:	TRIDEL		E13-15
SCALE:	1:50	DRAWN BY:	S.C.
DATE:	MARCH 4, 2015		

FOR ALUMINUM BALCONY  
& TERRACE RAILINGS  
REFER TO TORO  
ALUMINUM RAILING SHOP  
DRAWINGS

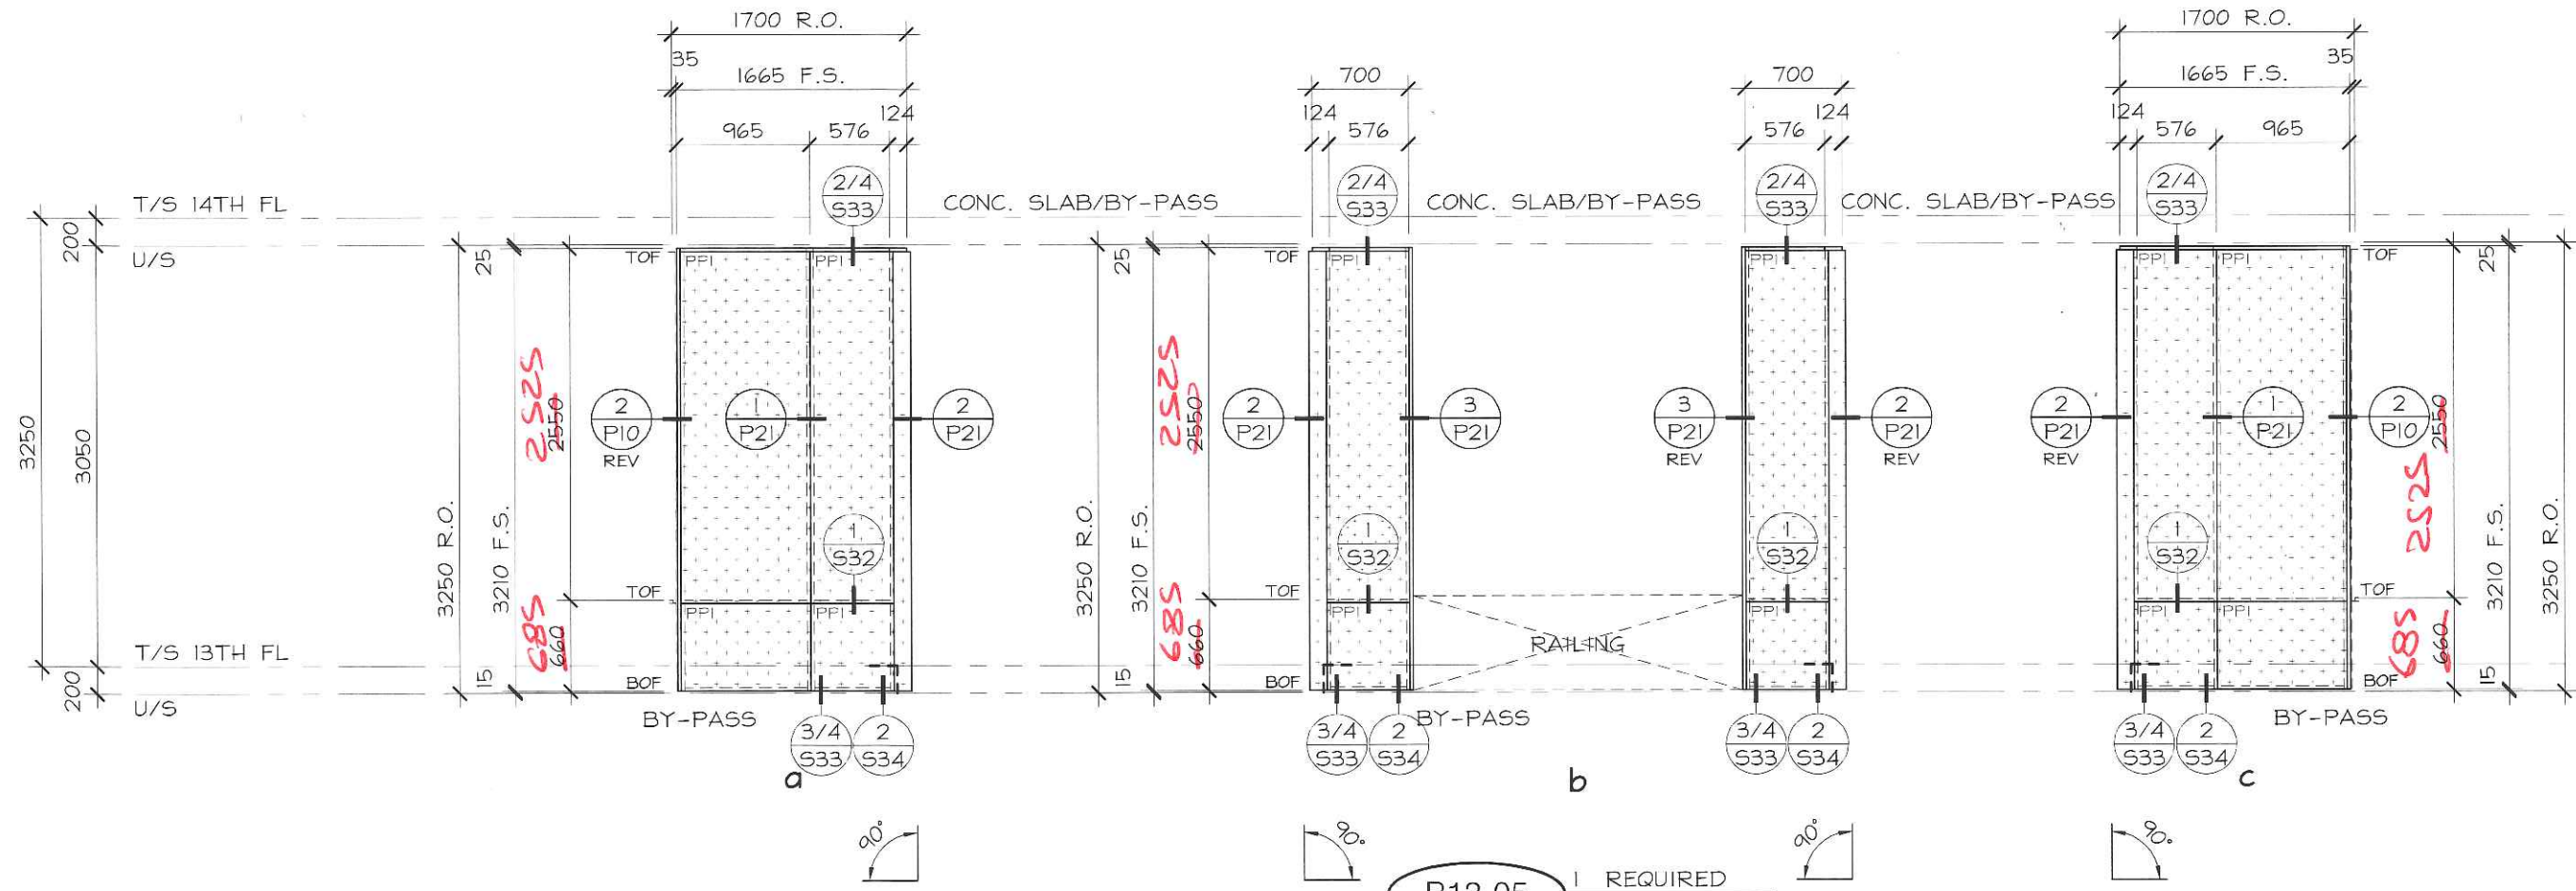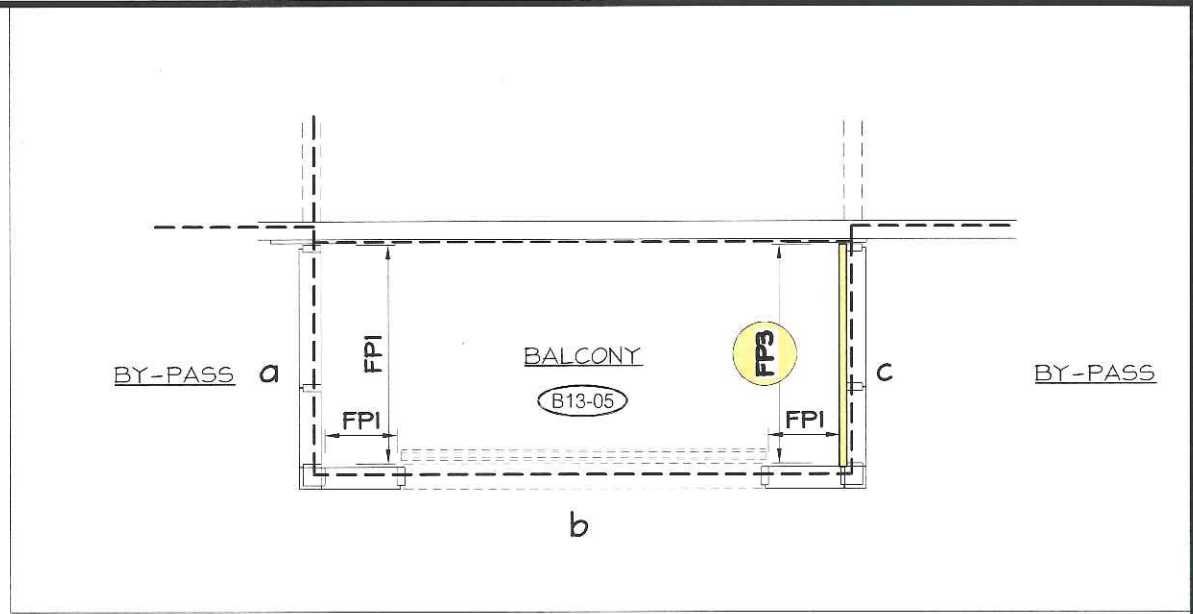

**B13-05** 1 REQUIRED  
2487 SERIES  
EXT. FINISH: PPG ACRYNAR PLATINUM UCFX11185  
INT. FINISH: PPG ACRYNAR PLATINUM UCFX11185  
c INT. FINISH: PPG ACRYNAR T.B.D.



No.	REVISION	BY	DATE

PROJECT NAME:	SQ ALEXANDRA PARK - BLOCK11		
DRAWING TITLE:	13th FLOOR ELEVATIONS		
ARCHITECT:	TEEPLE ARCHITECTS		
CONTRACTOR:	TRIDEL		
SCALE:	1:50	DRAWN BY:	S.C.
DATE:	MARCH 4, 2015		
DRAWING No.:	E13-16		