

Teeple Architects INC.

Package 3 - Level 2

- Review
- parapet heights
 - revised bottom of wall dimensions at 350mm curbs.
 - operable windows.

Reviewed

Reviewed as noted

Revise and resubmit

Not Reviewed

Date:


Aug 9/15

Reviewed by:

W. Bann

This review by Teeple Architects Inc. is for the sole purpose of ascertaining conformance with the general design concept. This review shall not mean that Teeple Architects Inc. approves the detailed design inherent in the shop drawings, responsibility for which shall remain with the Contractor submitting same. ARCHITECT CONC COLUMN BE SET BACK (SEE DETAIL) THE CONTRACTOR TO BE RESPONSIBLE FOR ANY OMISSIONS IN THE SHOP DRAWING OR FOR THE RESPONSIBILITY FOR MEETING ALL REQUIREMENTS OF THE CONTRACT DOCUMENTS. THE CONTRACTOR IS RESPONSIBLE FOR DIMENSIONS TO BE CONFIRMED AT THE JOB SITE, FOR INFORMATION RELATED TO FABRICATION PROCESSES OR TO TECHNICAL OF CONSTRUCTION AND INSTALLATION, AND FOR COORDINATION OF THE WORK OF ALL TRADES.


PLEASE SUBMIT ADDITIONAL DETAIL AS REQUESTED ON E2-1

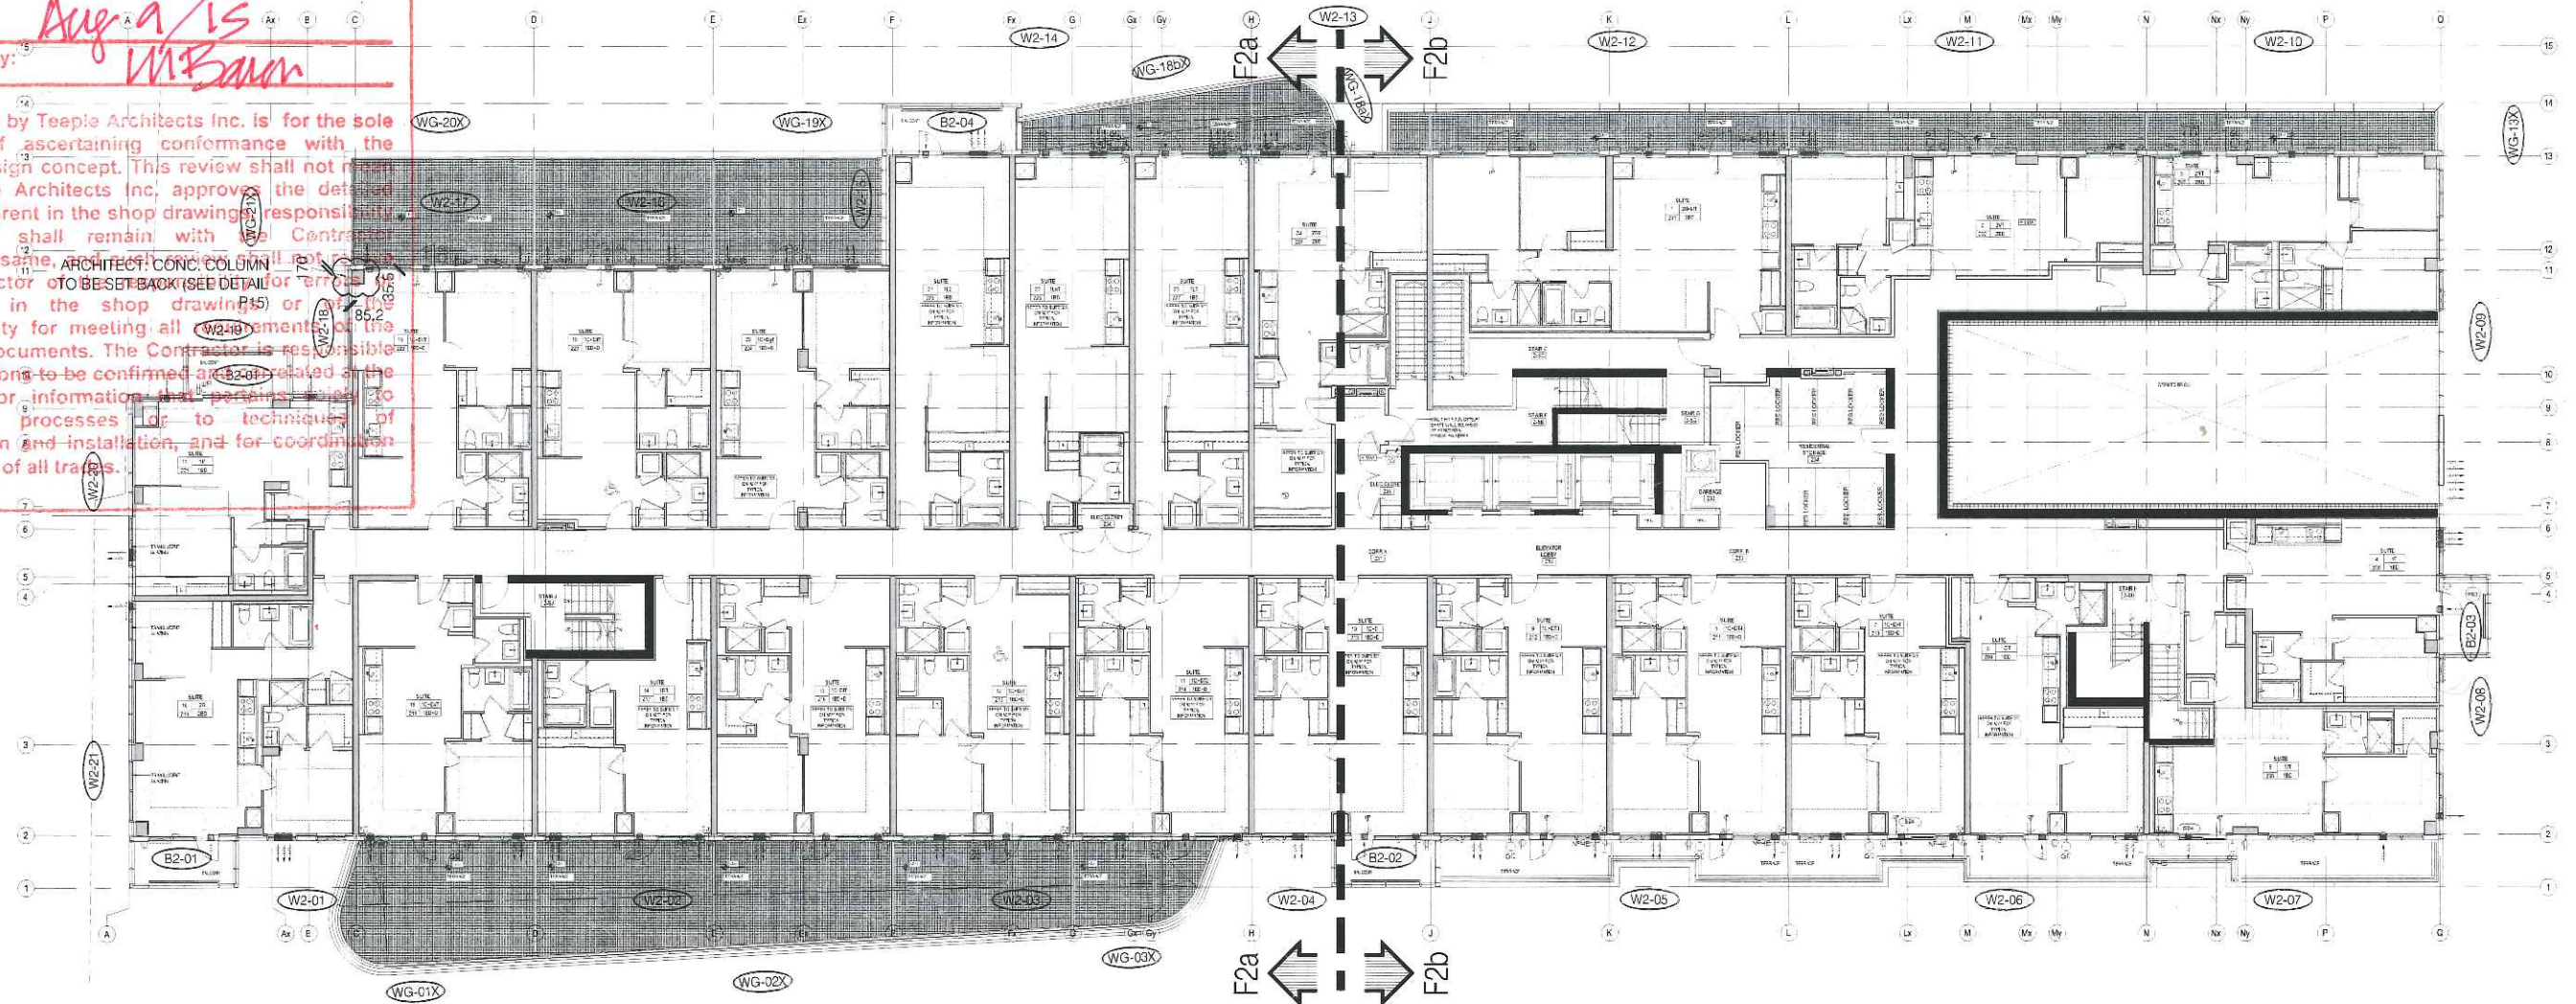

No.	REVISION	BY	DATE

PROJECT NAME	SQ ALEXANDRA PARK - BLOCK 11
DRAWING TITLE	2nd FLOOR KEY PLAN
ARCHITECT	TEEPLA ARCHITECTS
CONTRACTOR	TRIDEL
SCALE	N/T/S
DRAWN BY	S.C.
DATE	MARCH 4, 2015

DRAWING No. F2

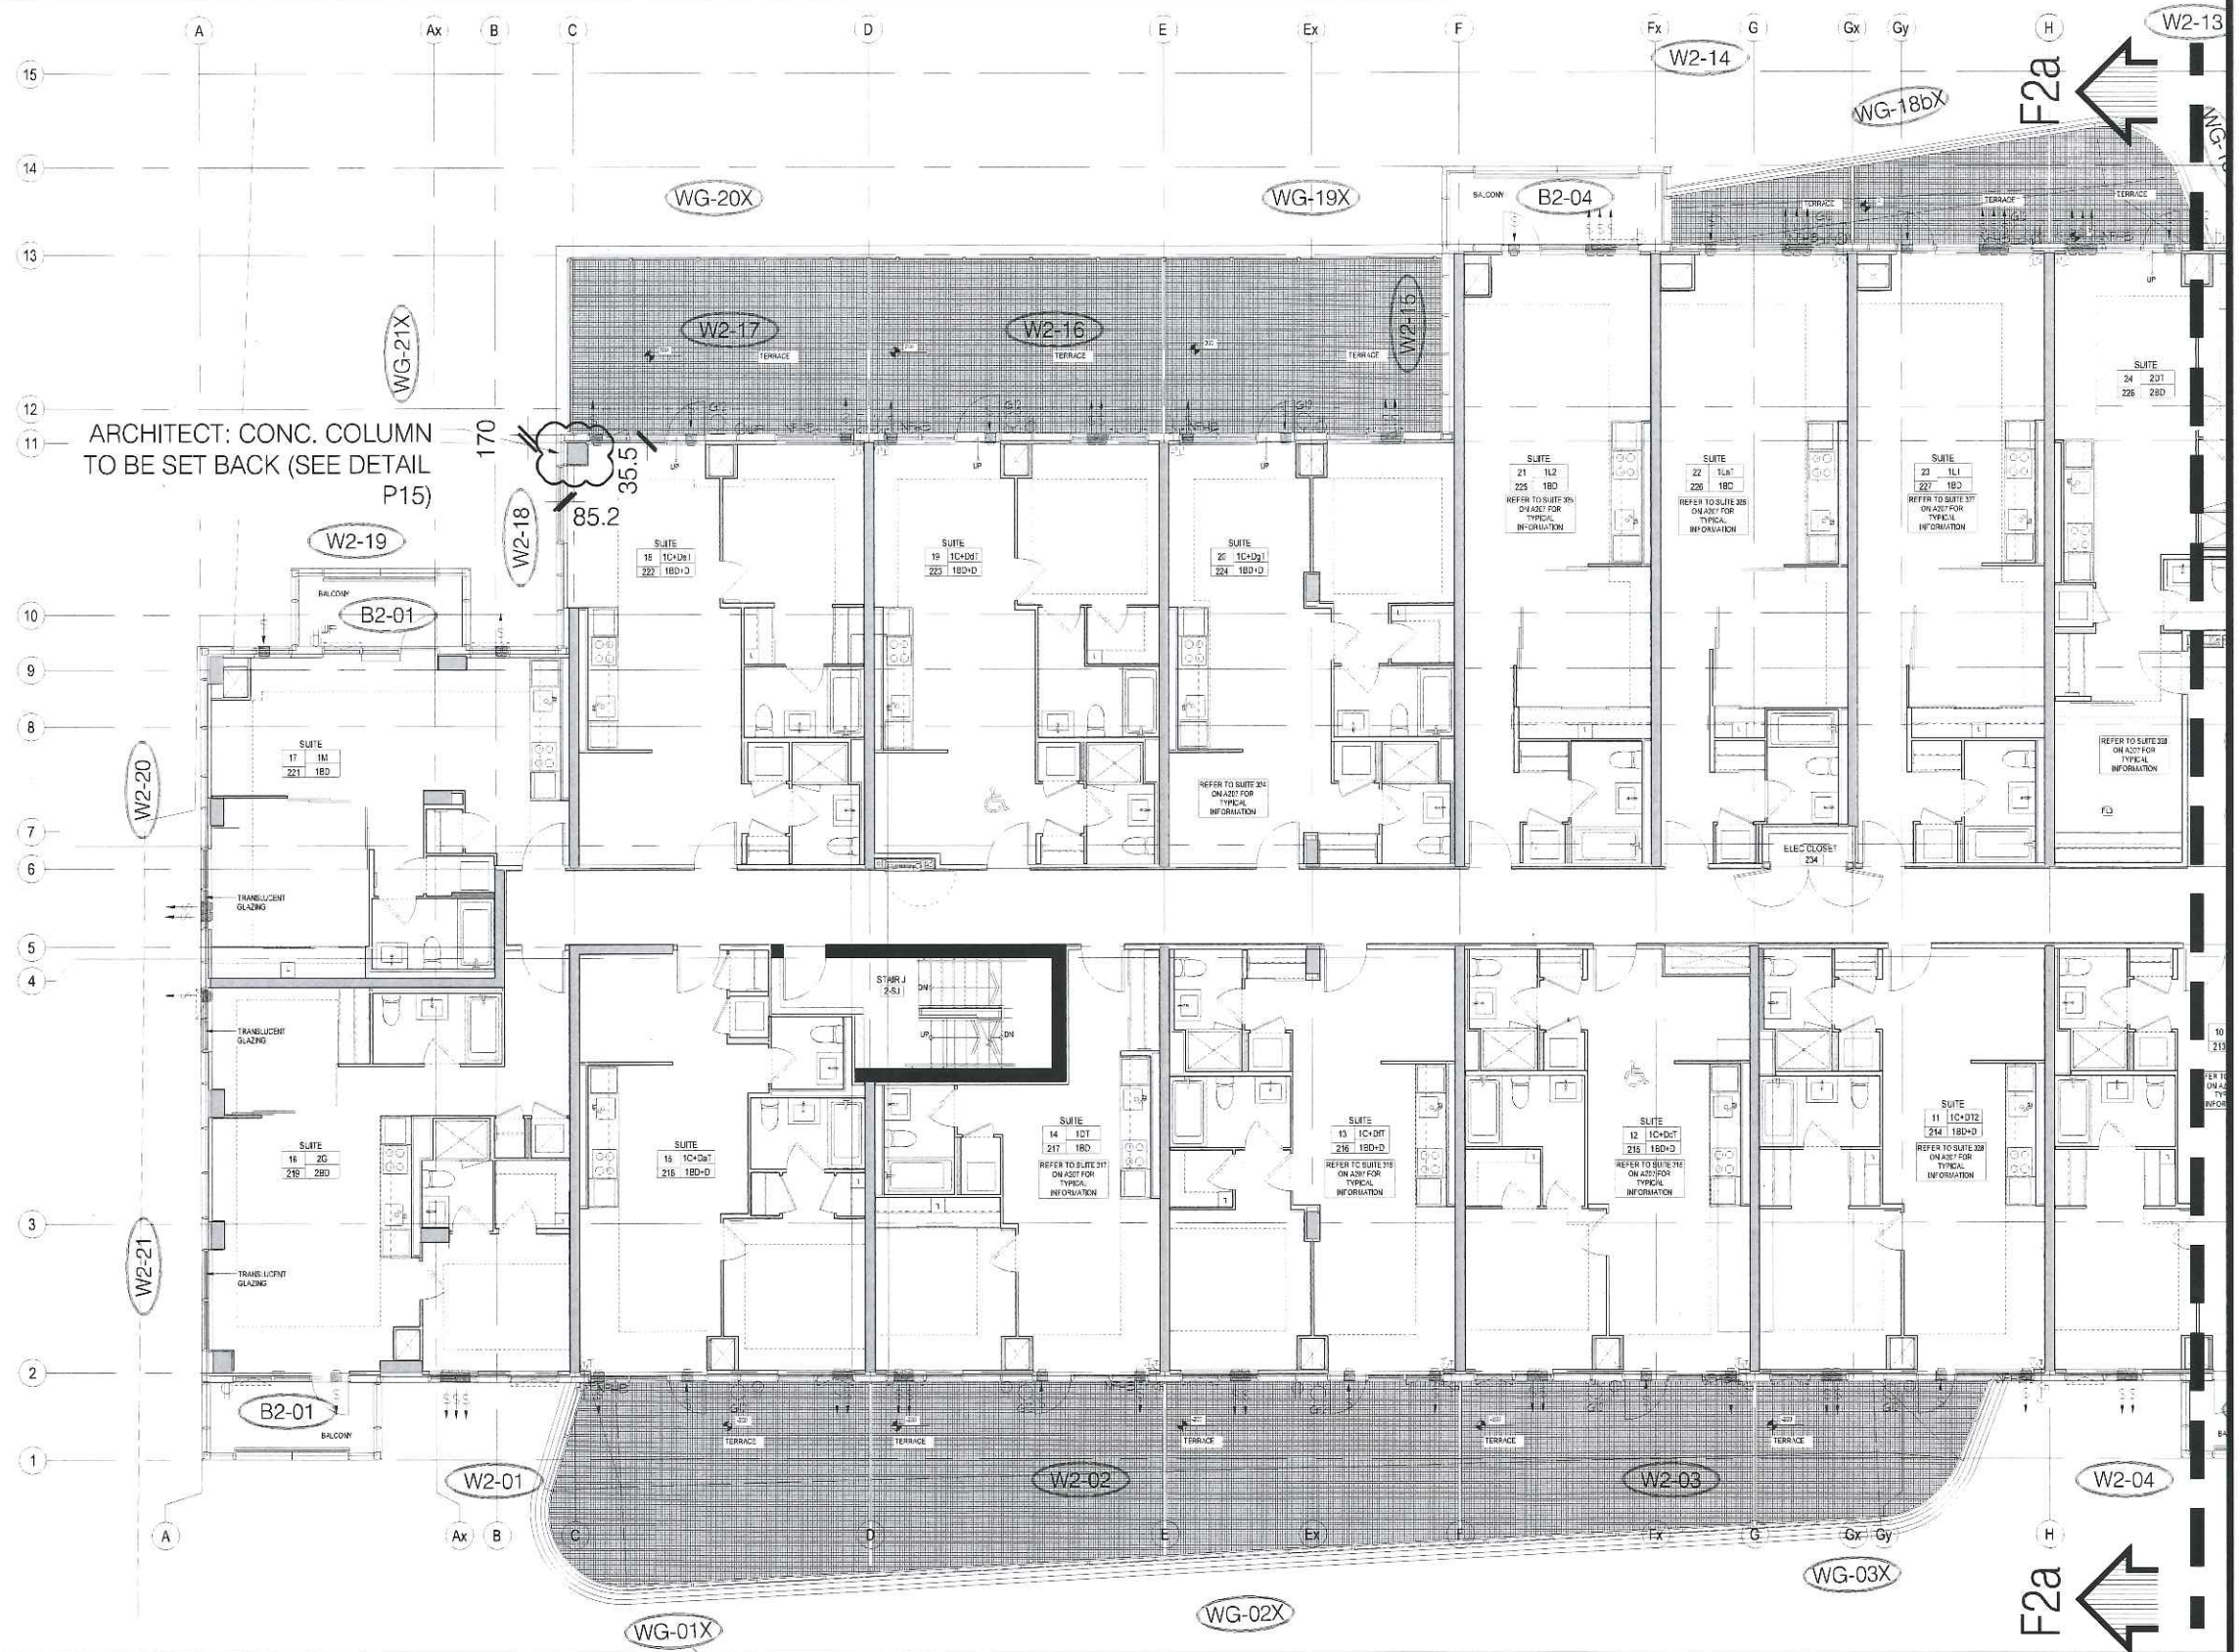

PROJECT NAME: SQ ALEXANDRA PARK - BLOCK 11

DRAWING TITLE: 2nd FLOOR PARTIAL PLAN

ARCHITECT: TEEPLE ARCHITECTS


CONTRACTOR: TRIDEL

DRAWING No.

F2a

No.	REVISION	B.Y.	DATE	SCALE	N/T/S	DRAWN BY	DATE

SCALE: N/T/S DRAWN BY: S.C. DATE: MARCH 4, 2005

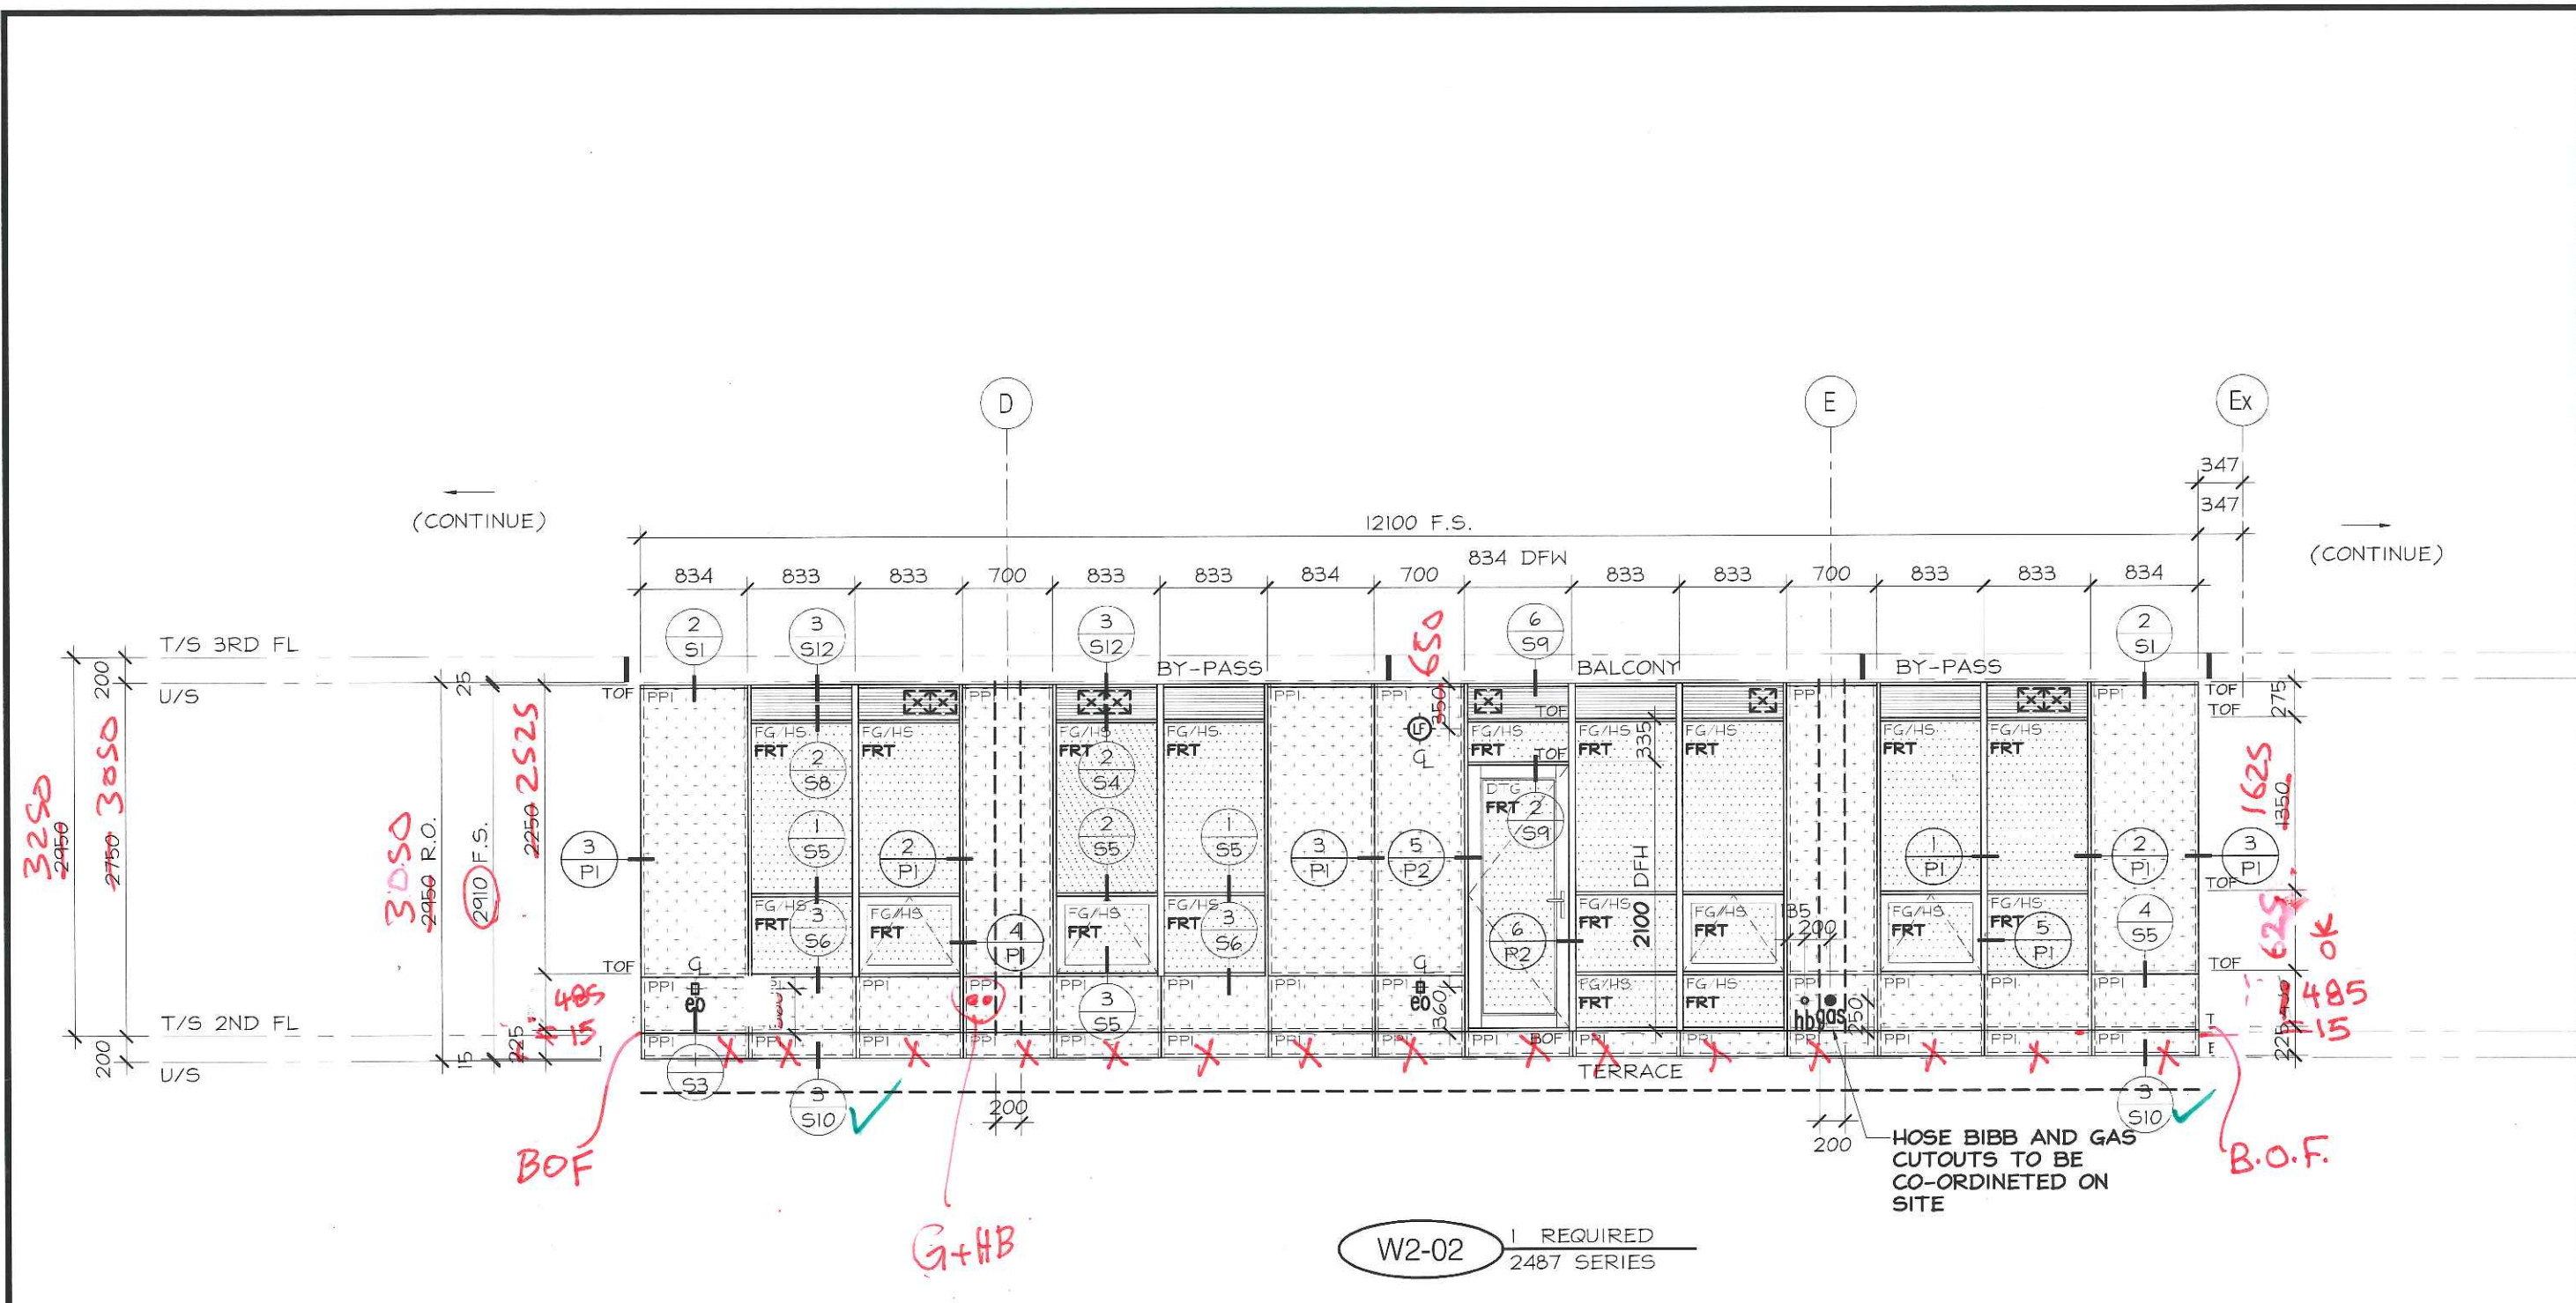


TORO ALUMINUM
 COMMERCIAL INDUSTRIAL RESIDENTIAL
 330 APPLEWOOD CRESCENT TEL: (905) 738-5220
 CONCORD, ON, CANADA FAX: (905) 738-5481
 L4K 4V2 WWW.TOROALUMINUM.COM

LICENSED PROFESSIONAL ENGINEER
 06-27-15
 D.T. PROHASKA
 3754901
 PROVINCE OF ONTARIO

No.	REVISION	BY	DATE

PROJECT NAME: SQ ALEXANDRA PARK - BLOCK 11		DRAWING No.: E2-2
DRAWING TITLE: 2nd FLOOR ELEVATIONS		
ARCHITECT: TEEPLE ARCHITECTS		DATE: MARCH 4, 2015
CONTRACTOR: TRIDEL		
SCALE: 1:50	DRAWN BY: S.C.	

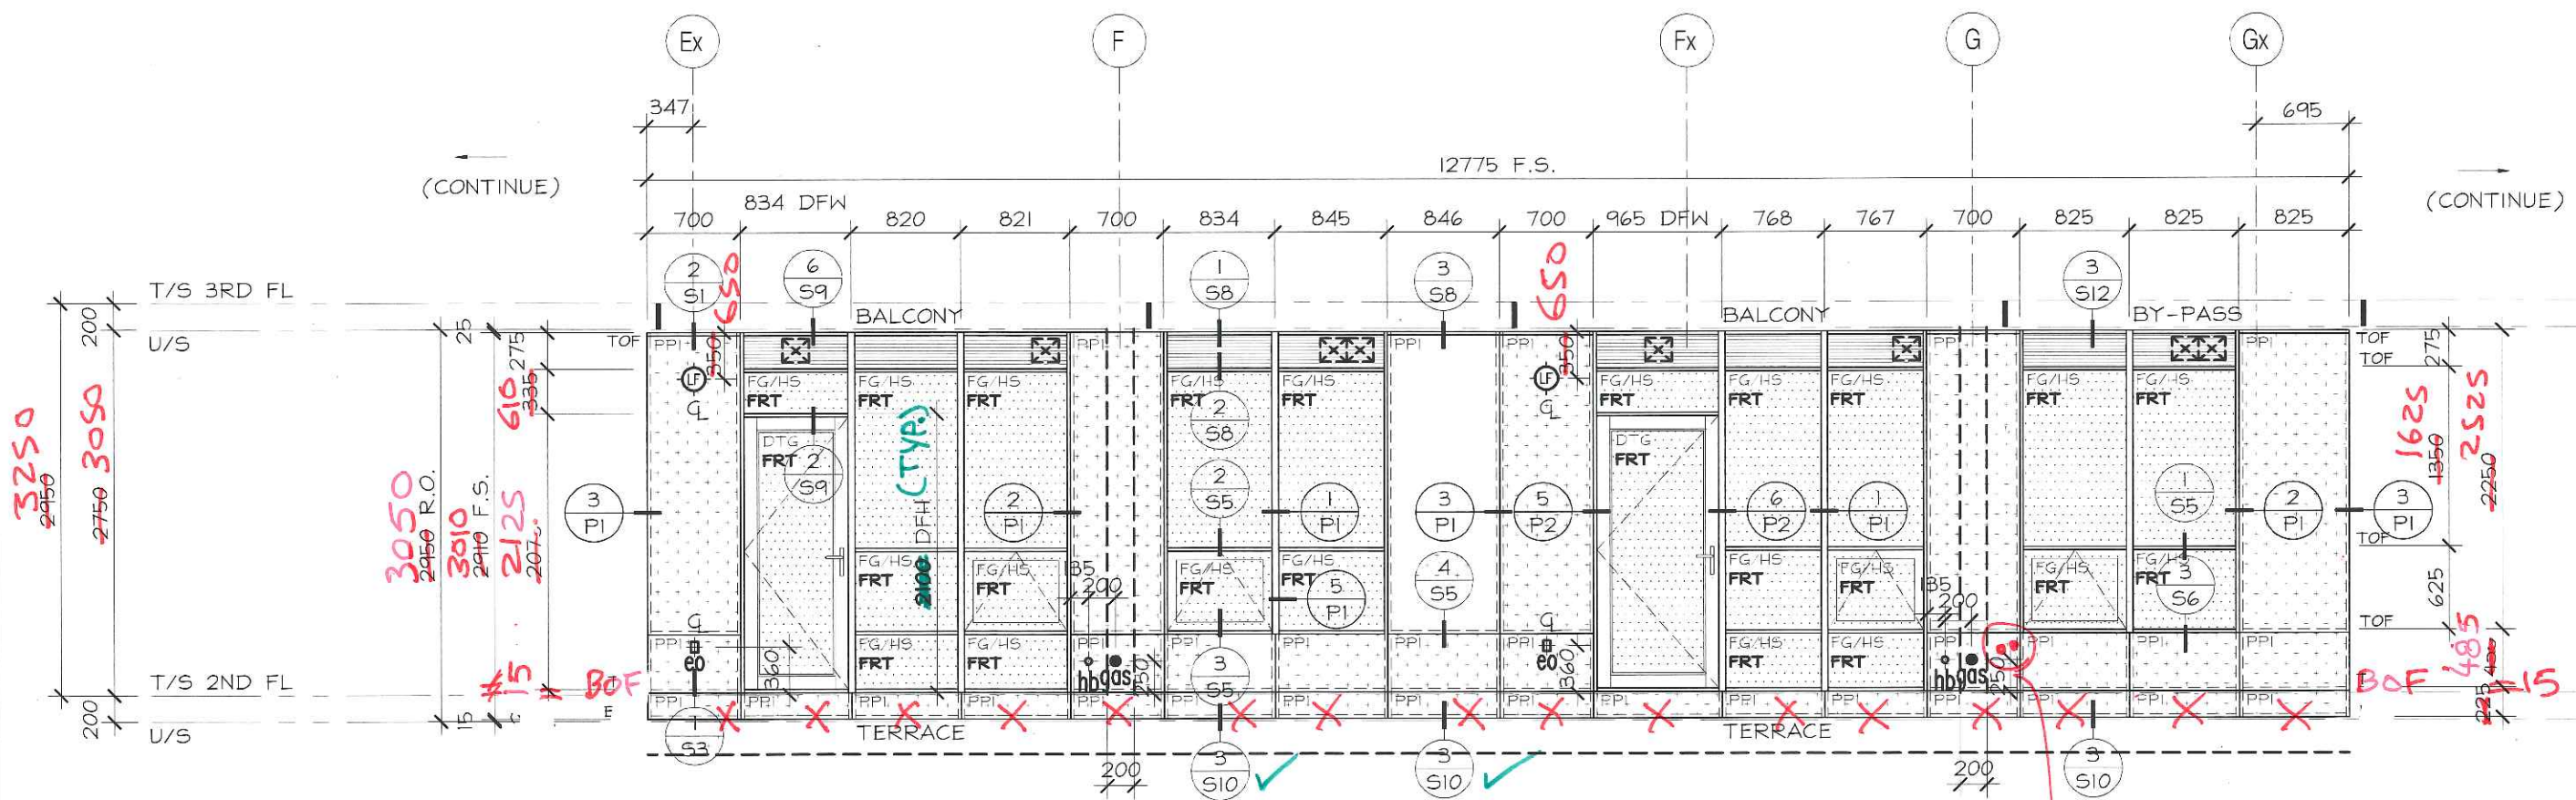

W2-03 I REQUIRED
2487 SERIES

hb+gas
to move from other
side of unit


TORO ALUMINUM
COMMERCIAL INDUSTRIAL RESIDENTIAL
330 APPLEWOOD CRESCENT TEL: (905) 738-5220
CONCORD, ON, CANADA FAX: (905) 738-5481
L4K 4V2 WWW.TOROALUMINUM.COM

LICENSED PROFESSIONAL ENGINEER
06-27-15
D.T. PROHASKA
37549014
PROVINCE OF ONTARIO

No.	REVISION	BY	DATE

PROJECT NAME:	SQ ALEXANDRA PARK - BLOCK 11
DRAWING TITLE:	2nd FLOOR ELEVATIONS
ARCHITECT:	TEEPLE ARCHITECTS
CONTRACTOR:	TRIDEL
SCALE:	1:50
DRAWN BY:	S.C.
DATE:	MARCH 4, 2015

DRAWING No.:
E2-3

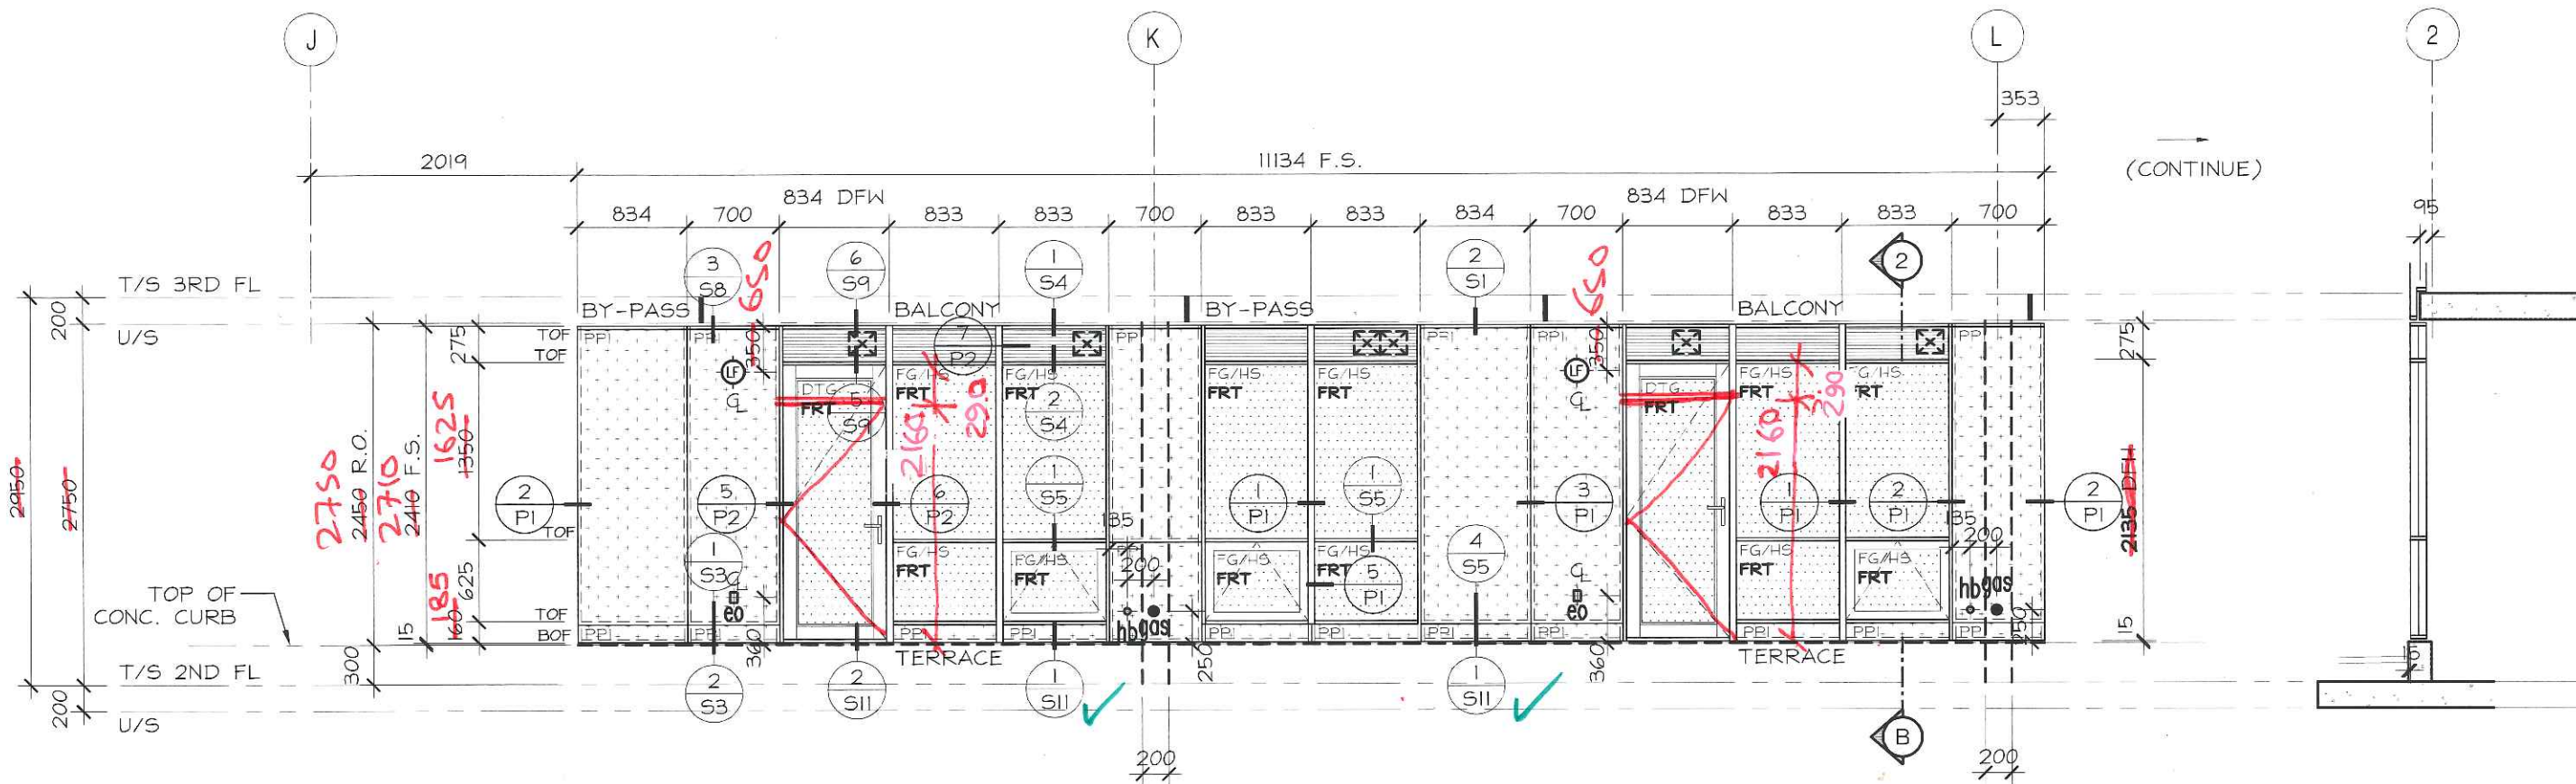

(CONTINUE)

2-B
CROSS SECTION
ARCH. REF. 2/A402

W2-05 1 REQUIRED
2487 SERIES

TORO ALUMINUM
 COMMERCIAL INDUSTRIAL RESIDENTIAL
 330 APPLEWOOD CRESCENT TEL: (905) 738-5220
 CONCORD, ON, CANADA FAX: (905) 738-5481
 L4K 4V2 WWW.TOROALUMINUM.COM


06-27-15
 LICENSED PROFESSIONAL ENGINEER
 D.T. PROHASKA
 3754991
 PROVINCE OF ONTARIO

No.	REVISION	BY	DATE

PROJECT NAME: SQ ALEXANDRA PARK - BLOCK 11
 DRAWING TITLE: 2nd FLOOR ELEVATIONS
 ARCHITECT: TEEPLE ARCHITECTS
 CONTRACTOR: TRIDEL
 SCALE: 1:50
 DRAWN BY: S.C.
 DATE: MARCH 4, 2015

DRAWING No.:
E2-5

Flow to floor increased.

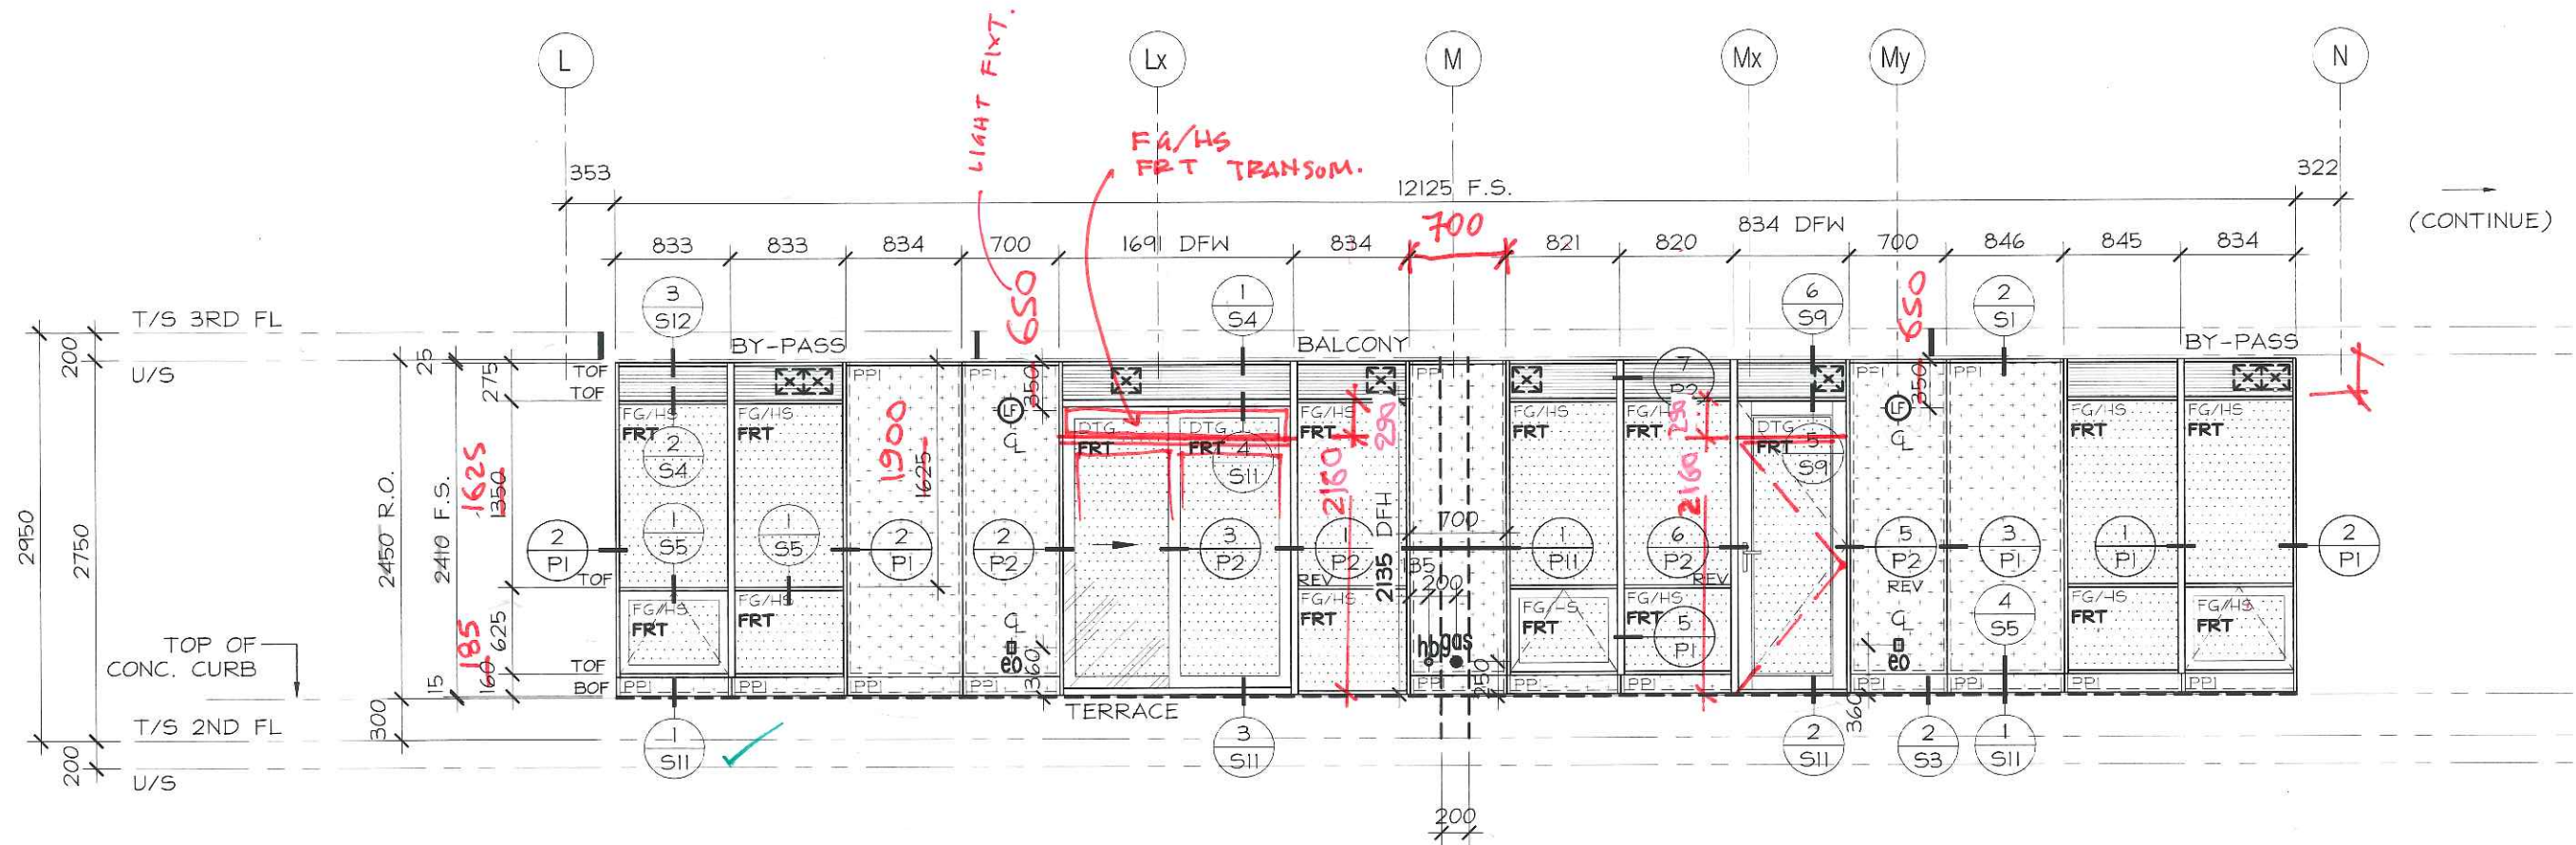


W2-06 REQUIRED 2487 SERIES



No.	REVISION	BY	DATE

PROJECT NAME:	SQ ALEXANDRA PARK - BLOCK11		
DRAWING TITLE:	2nd FLOOR ELEVATIONS		
ARCHITECT:	TEEPLE ARCHITECTS		
CONTRACTOR:	TRIDEL		
SCALE:	1:50	DRAWN BY:	S.C.
DATE:	MARCH 4, 2015		

DRAWING No.: E2-6

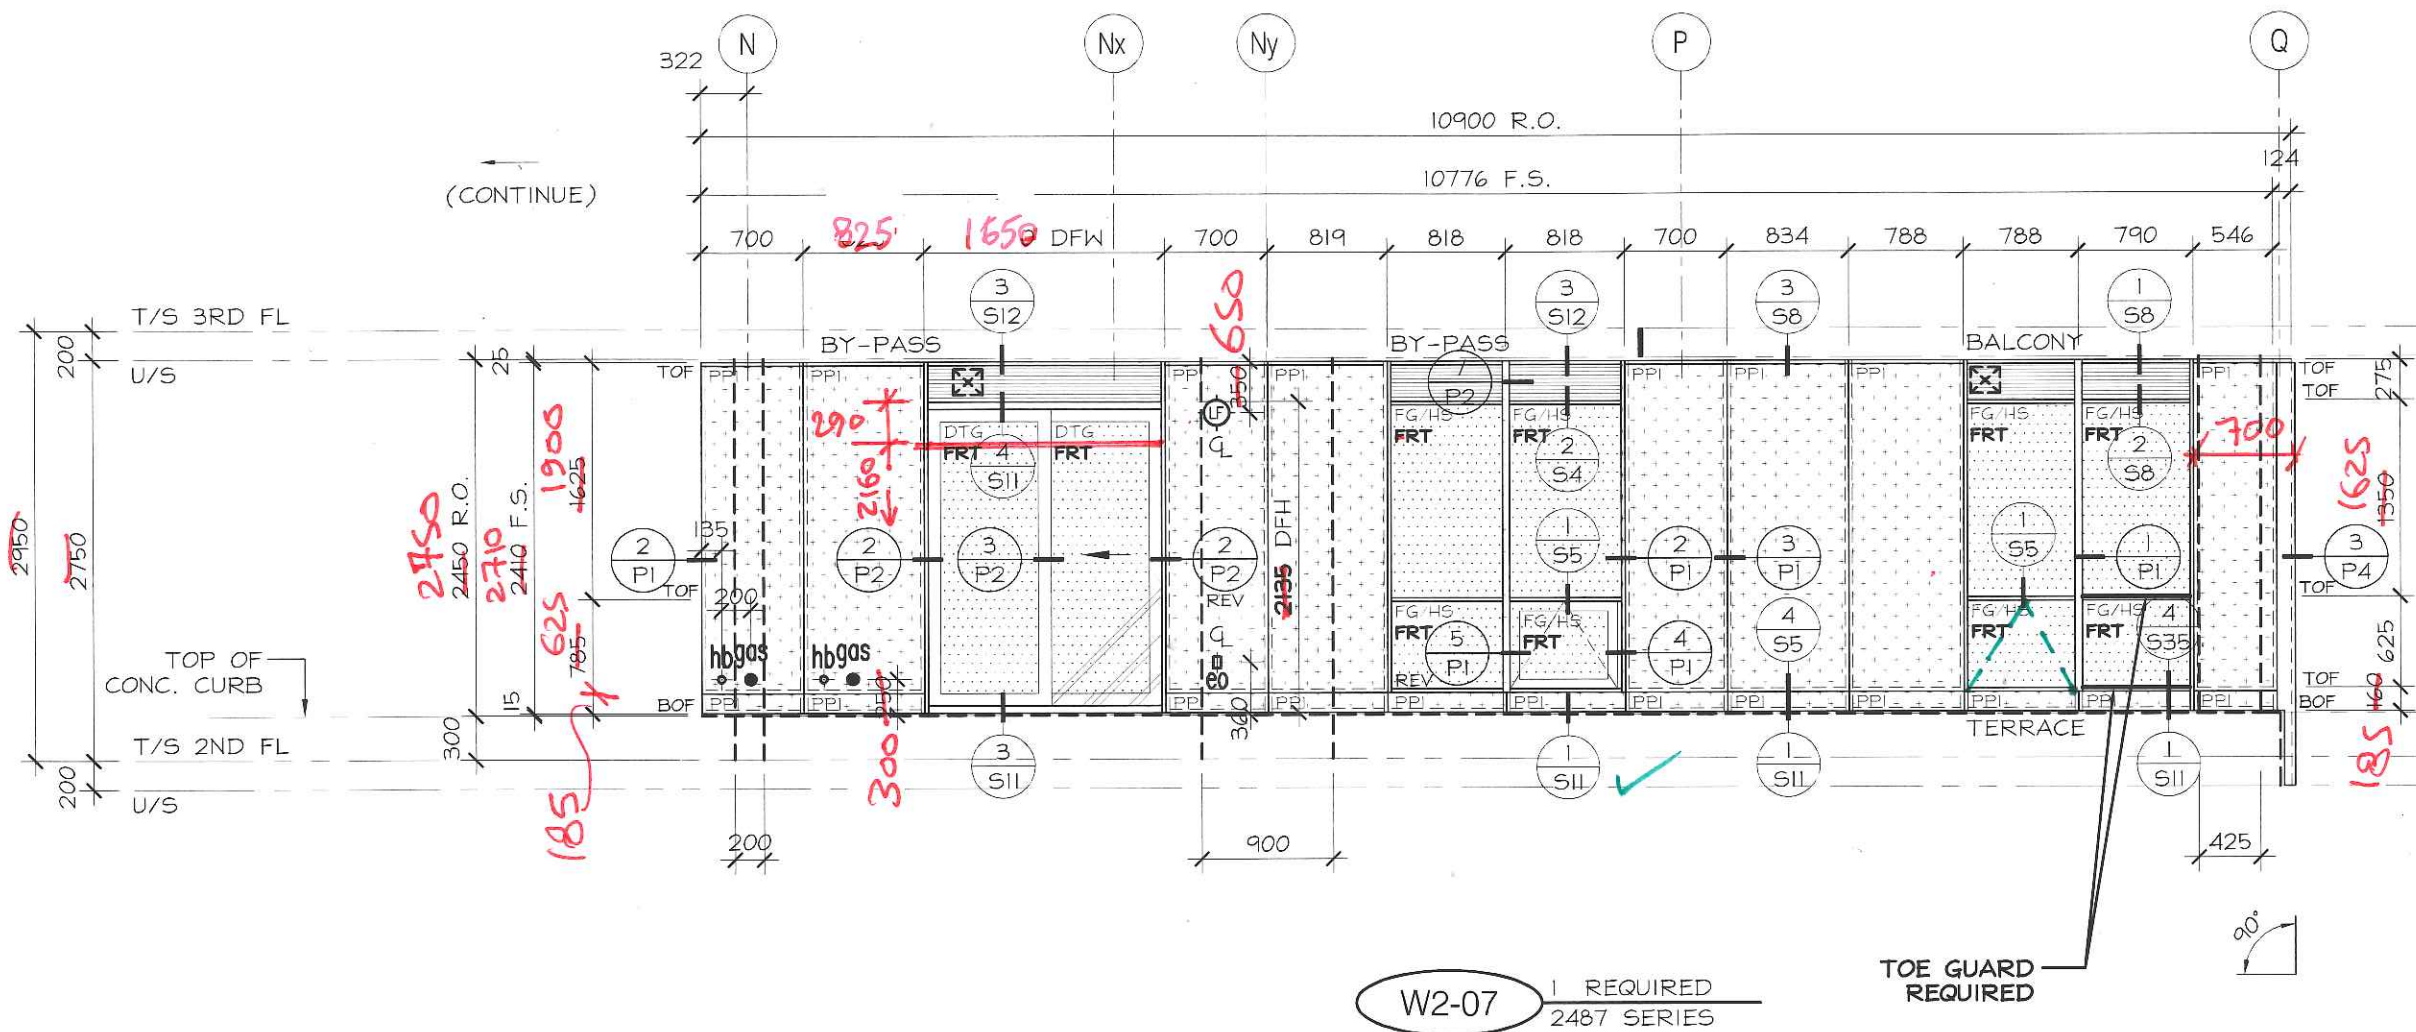


No.	REVISION	BY	DATE

PROJECT NAME: SQ ALEXANDRA PARK - BLOCK11
 DRAWING TITLE: 2nd FLOOR ELEVATIONS
 ARCHITECT: TEEPLE ARCHITECTS
 CONTRACTOR: TRIDEL
 SCALE: 1:50
 DRAWN BY: S.C.
 DATE: MARCH 4, 2015

DRAWING No.: E2-7

(CONTINUE)

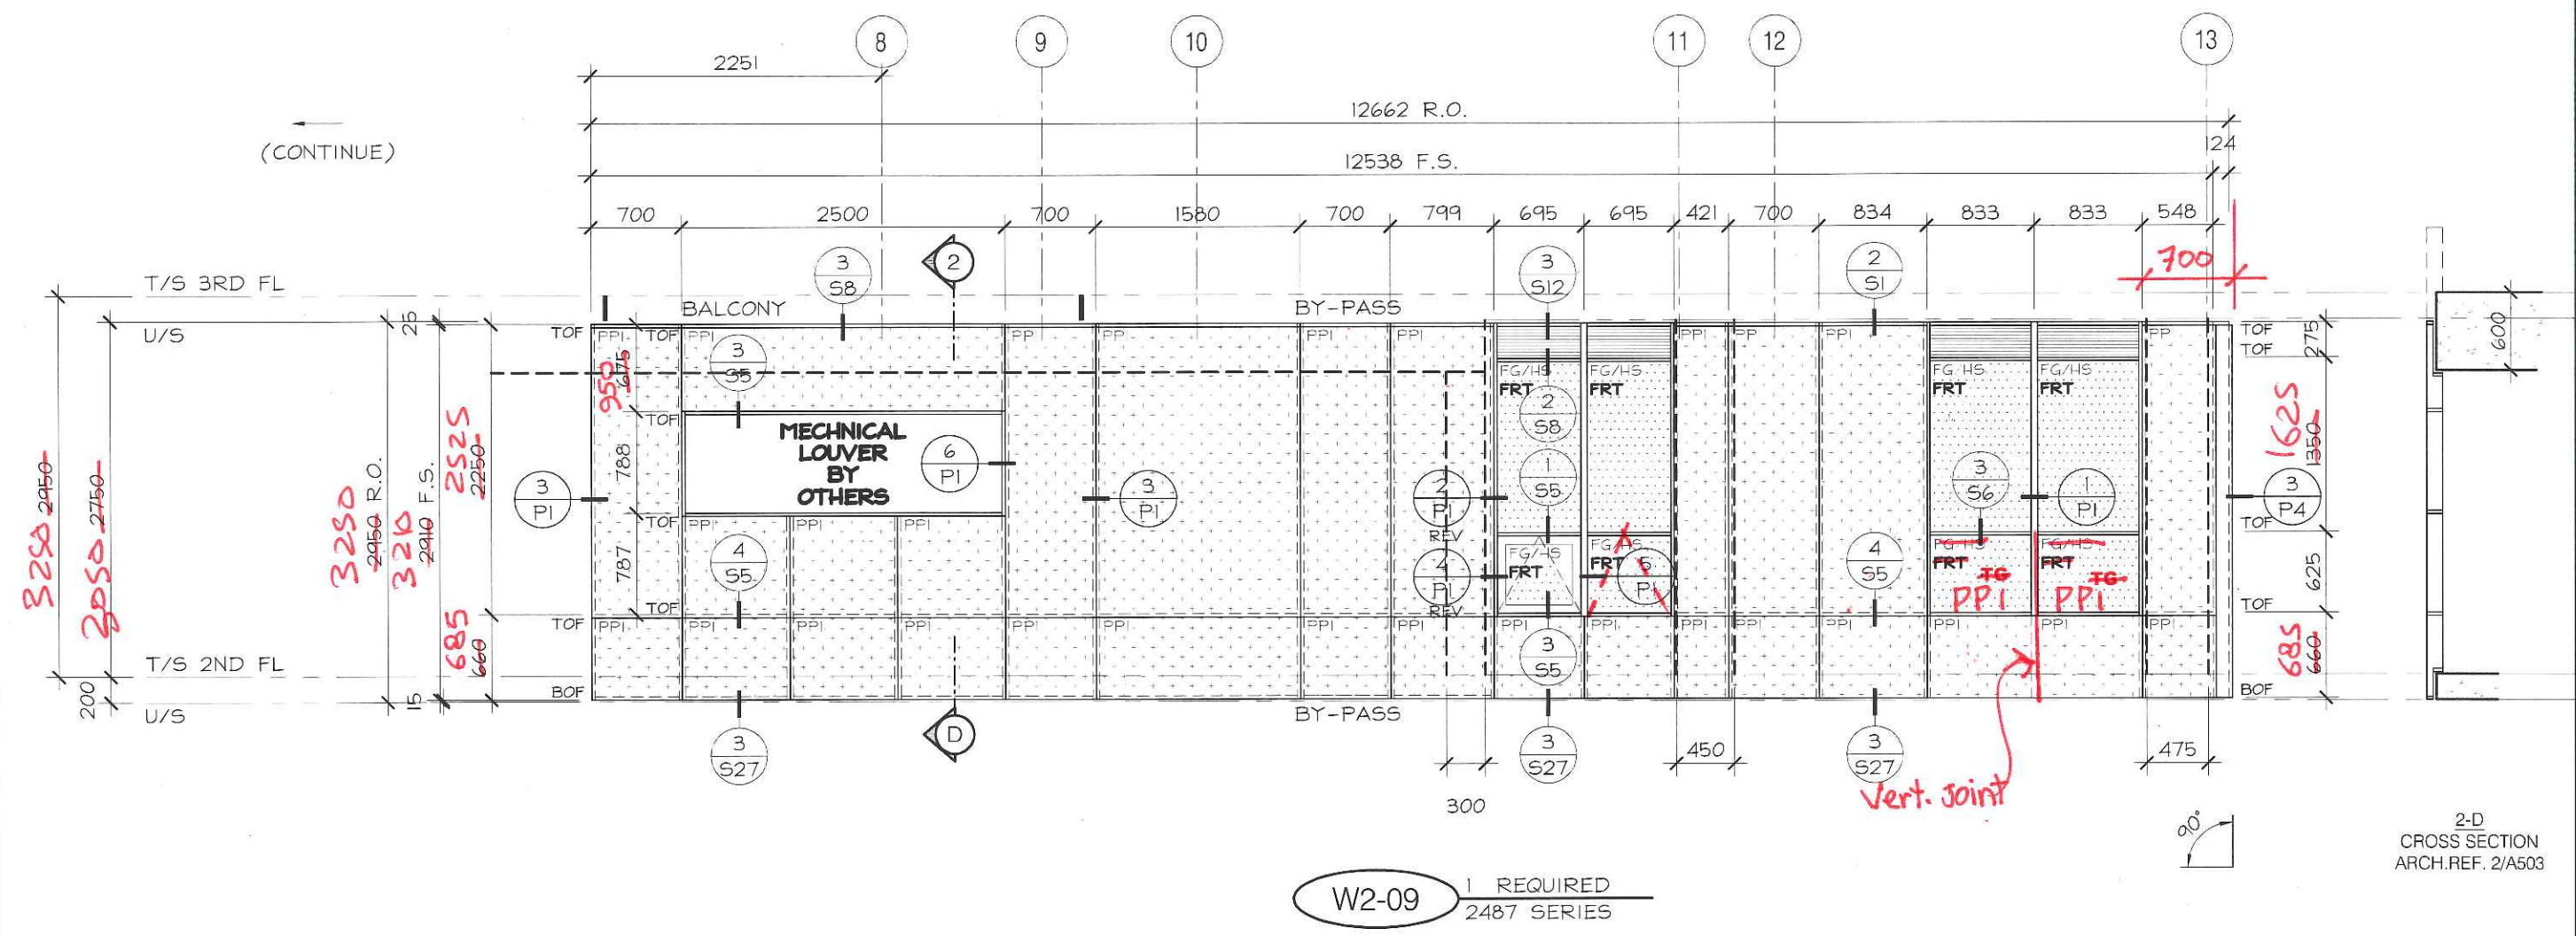


2-D
CROSS SECTION
ARCH. REF. 2/A503



No.	REVISION	BY	DATE


PROJECT NAME: SQ ALEXANDRA PARK - BLOCK11
DRAWING TITLE: 2nd FLOOR ELEVATIONS
ARCHITECT: TEEPLE ARCHITECTS
CONTRACTOR: TRIDEL
SCALE: 1:50
DRAWN BY: S.C.
DATE: MARCH 4, 2015

DRAWING No.:
E2-9

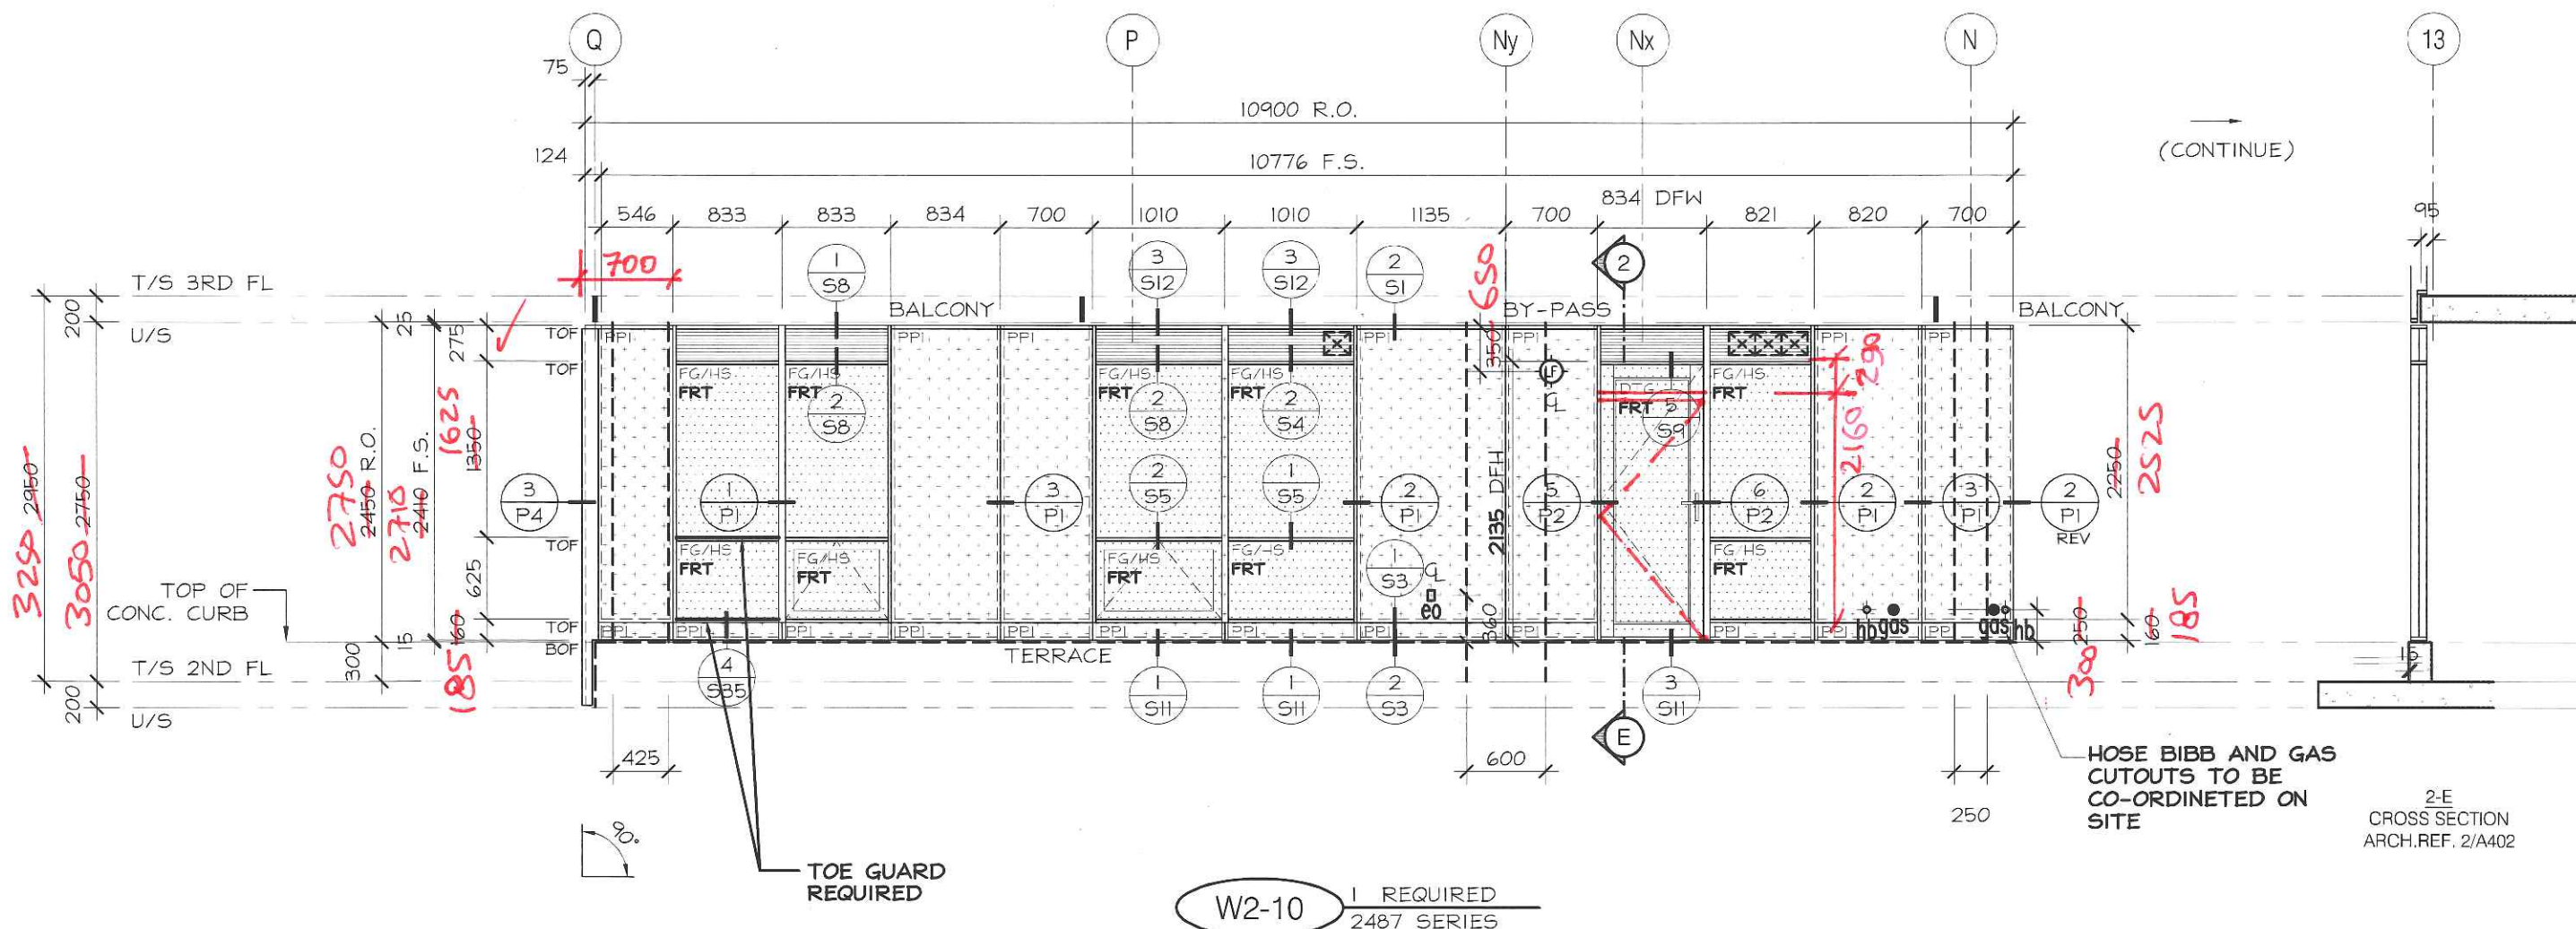


(CONTINUE)

2-E
CROSS SECTION
ARCH. REF. 2/A402

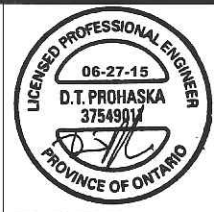

No.	REVISION	BY	DATE

PROJECT NAME: SQ ALEXANDRA PARK - BLOCK 11		DRAWING No.: E2-10
DRAWING TITLE: 2nd FLOOR ELEVATIONS		
ARCHITECT: TEEPLE ARCHITECTS		DATE: MARCH 4, 2015
CONTRACTOR: TRIDEL		
SCALE: 1:50	DRAWN BY: S.C.	

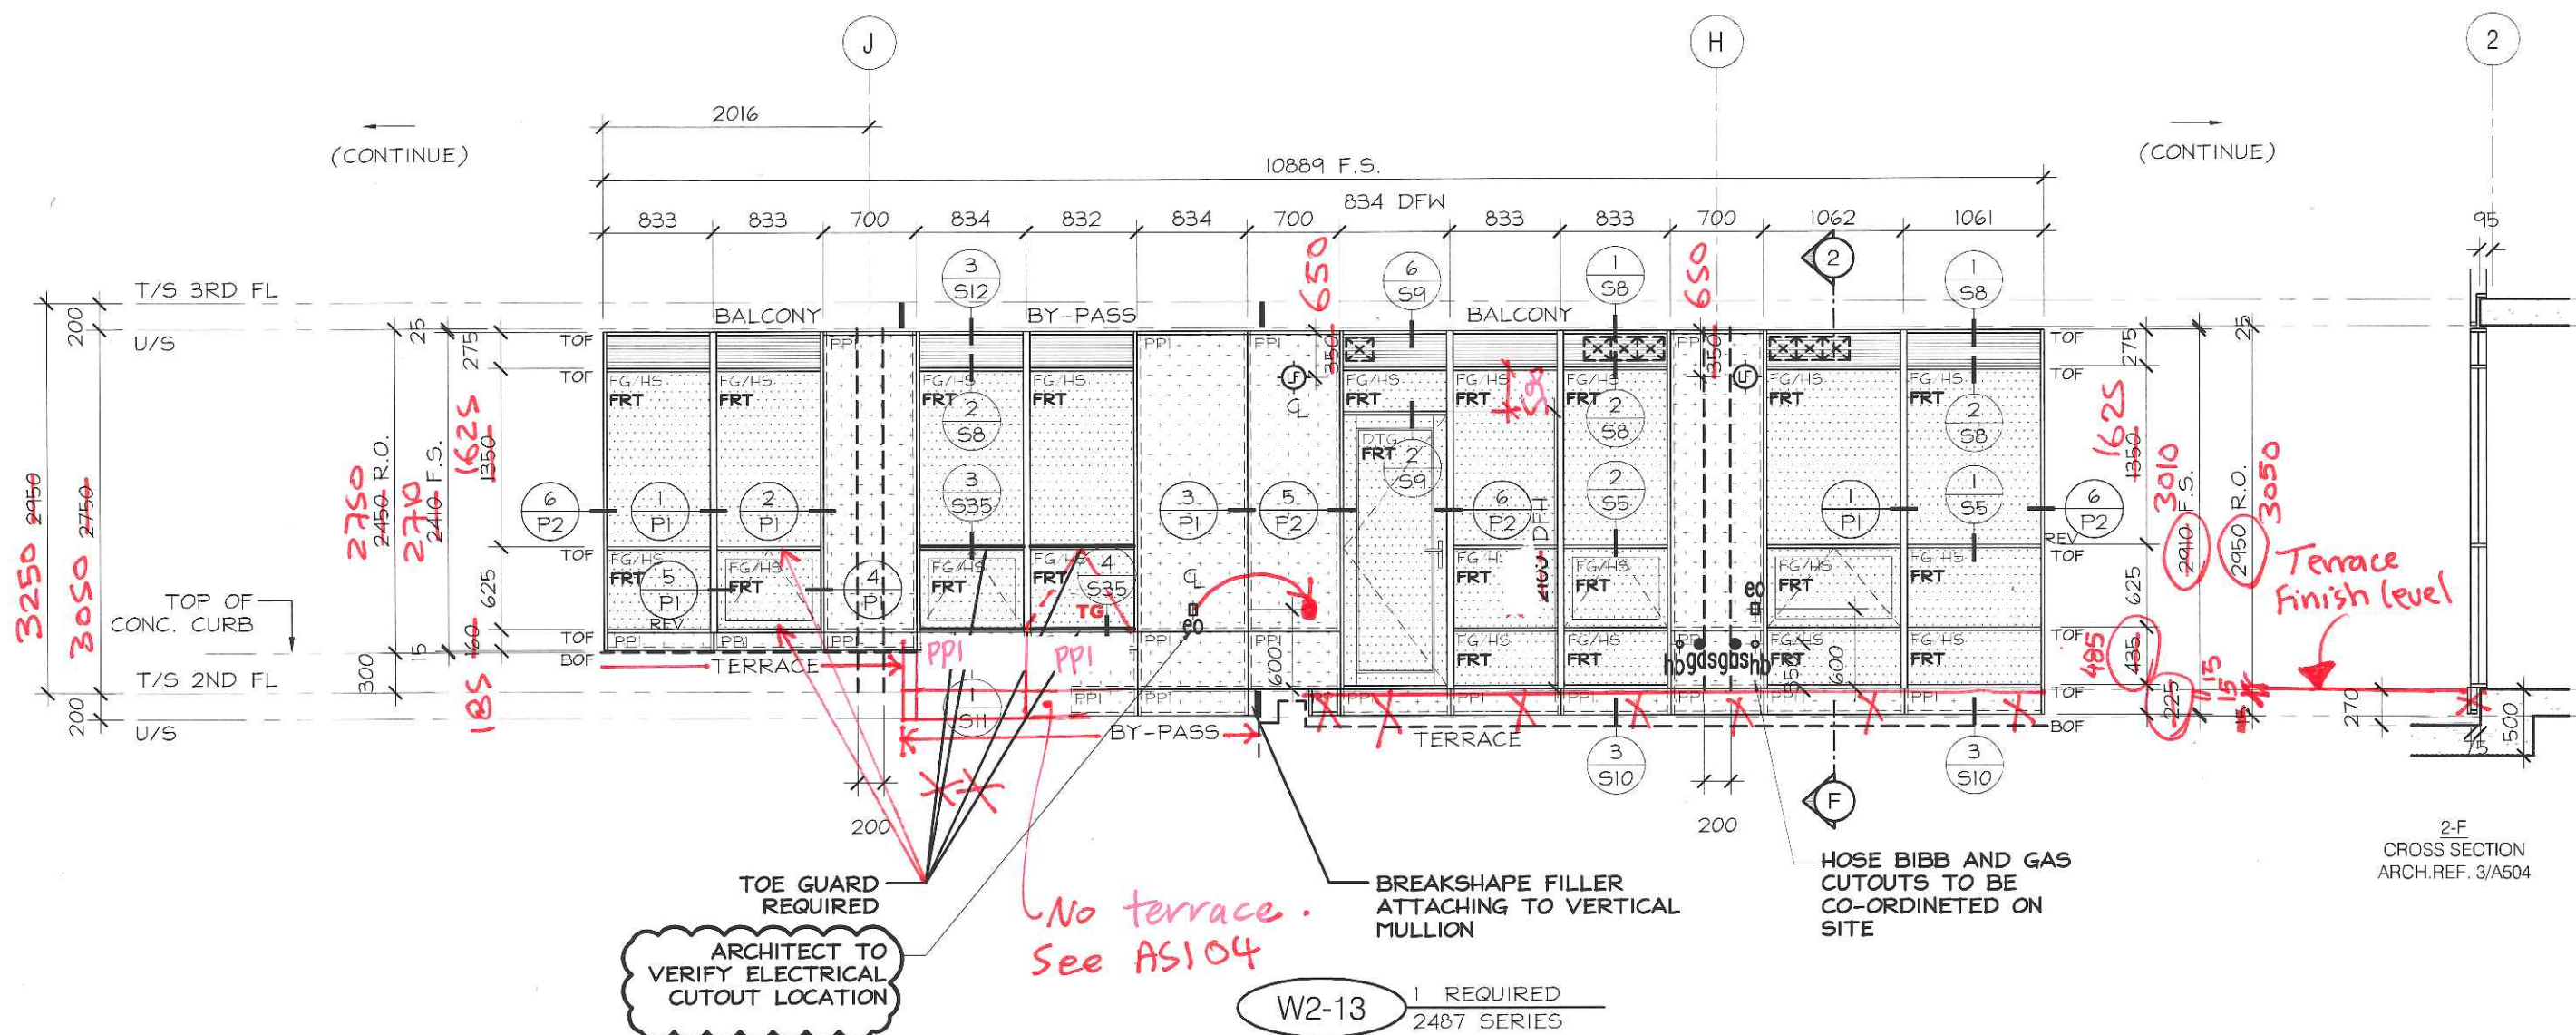


2-F
CROSS SECTION
ARCH. REF. 3/A504




No.	REVISION	BY	DATE

PROJECT NAME: SQ ALEXANDRA PARK - BLOCK 11
 DRAWING TITLE: 2nd FLOOR ELEVATIONS
 ARCHITECT: TEEPLE ARCHITECTS
 CONTRACTOR: TRIDEL
 SCALE: 1:50
 DRAWN BY: S.C.
 DATE: MARCH 4, 2015

DRAWING No.:
E2-13

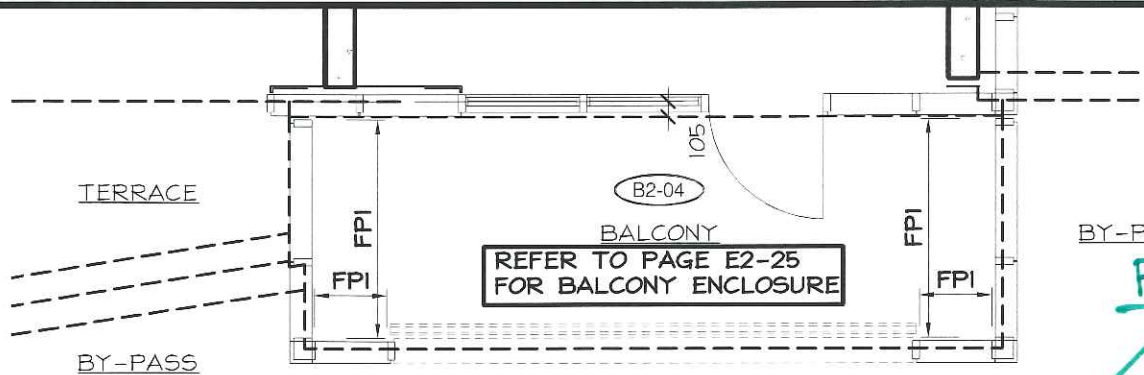


PROBLEM.
 THIS DIM IS 347 IN DETAIL S/PS. THE DETAIL IS CORRECT.

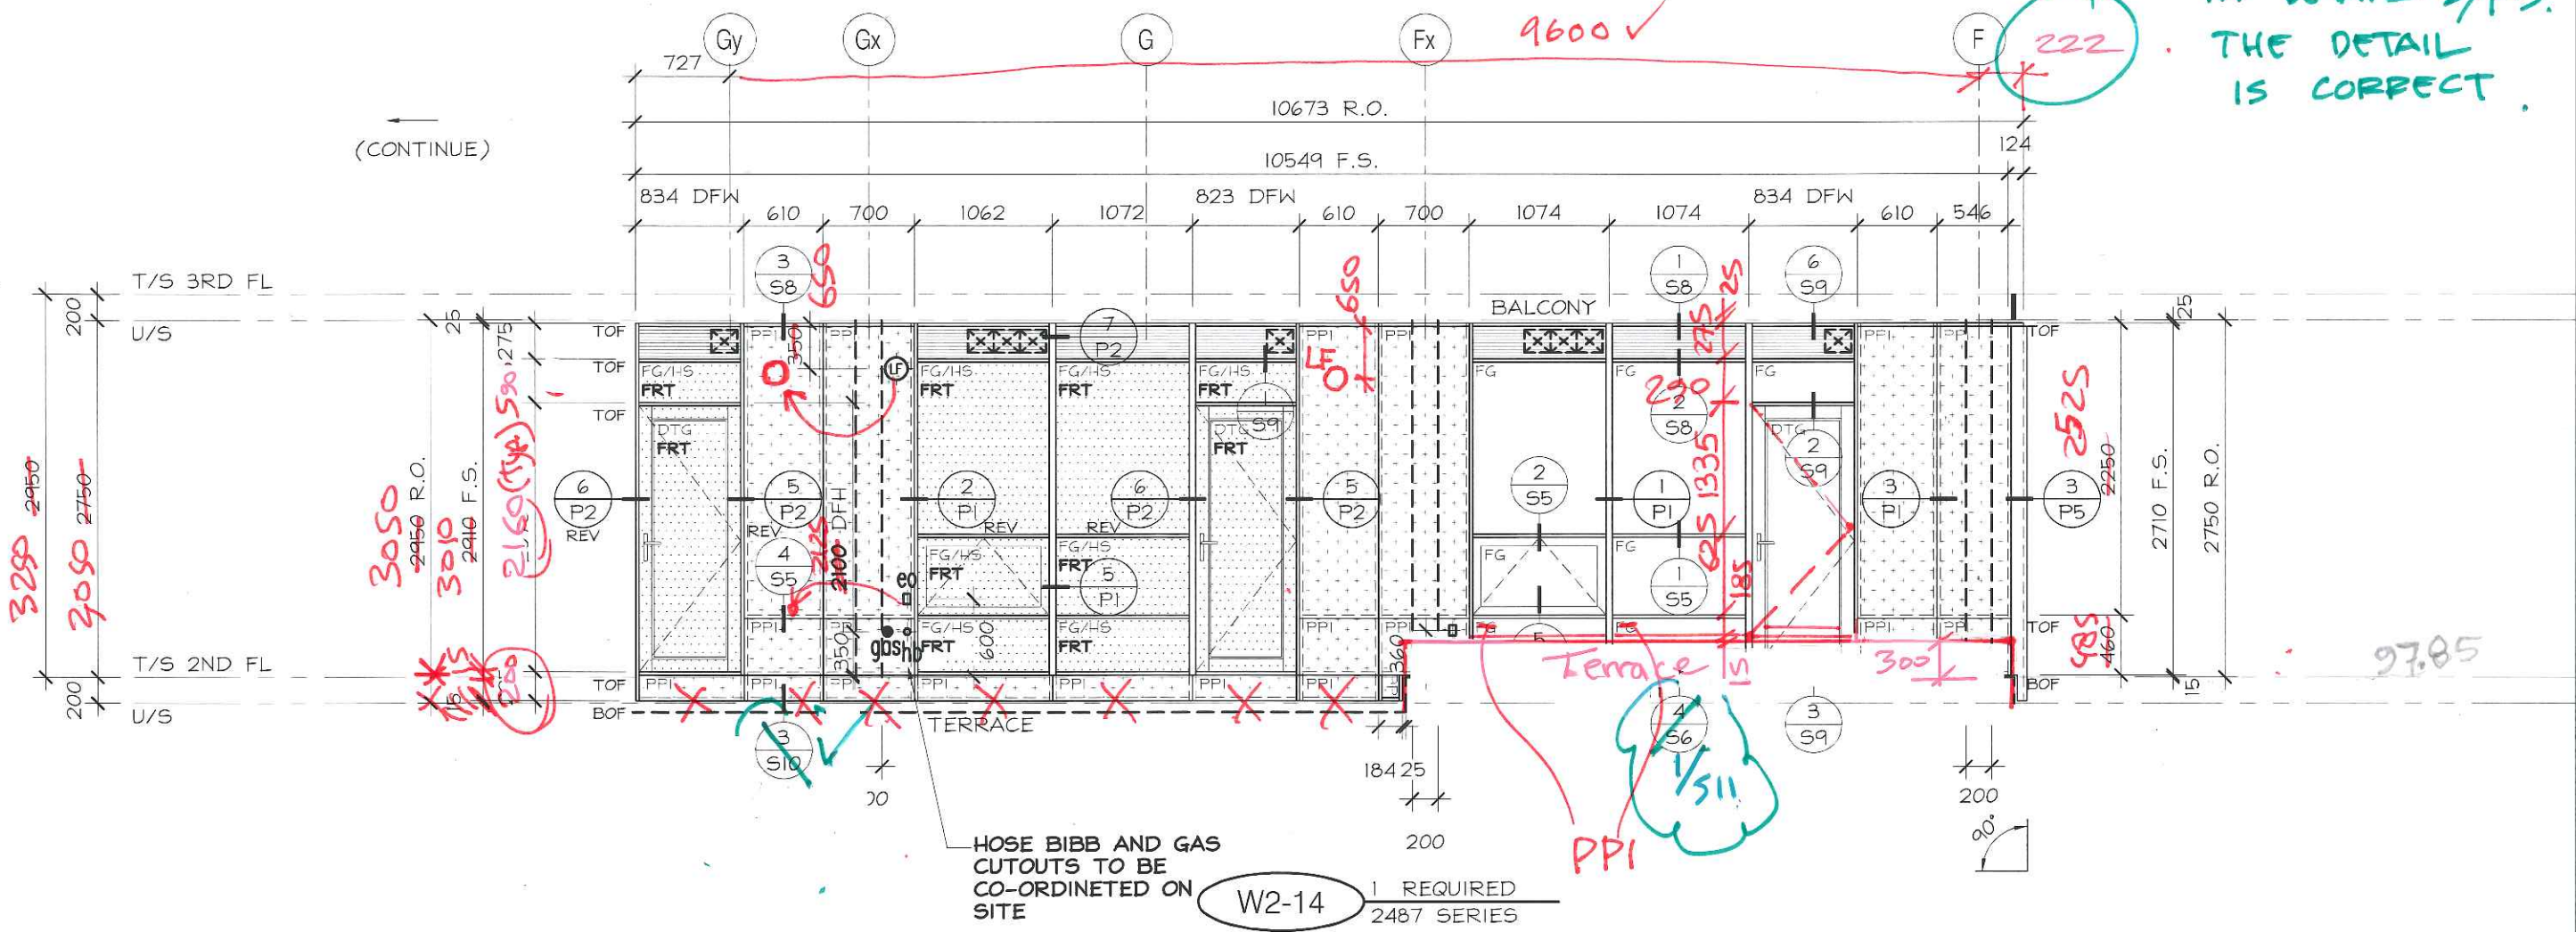

No.	REVISION	BY	DATE

PROJECT NAME:	SQ ALEXANDRA PARK - BLOCK11		
DRAWING TITLE:	2nd FLOOR ELEVATIONS		
ARCHITECT:	TEEPLE ARCHITECTS		DRAWING No.:
CONTRACTOR:	TRIDEL		E2-14
SCALE:	1:50	DRAWN BY:	S.C.
DATE:	MARCH 4, 2015		


(CONTINUE)

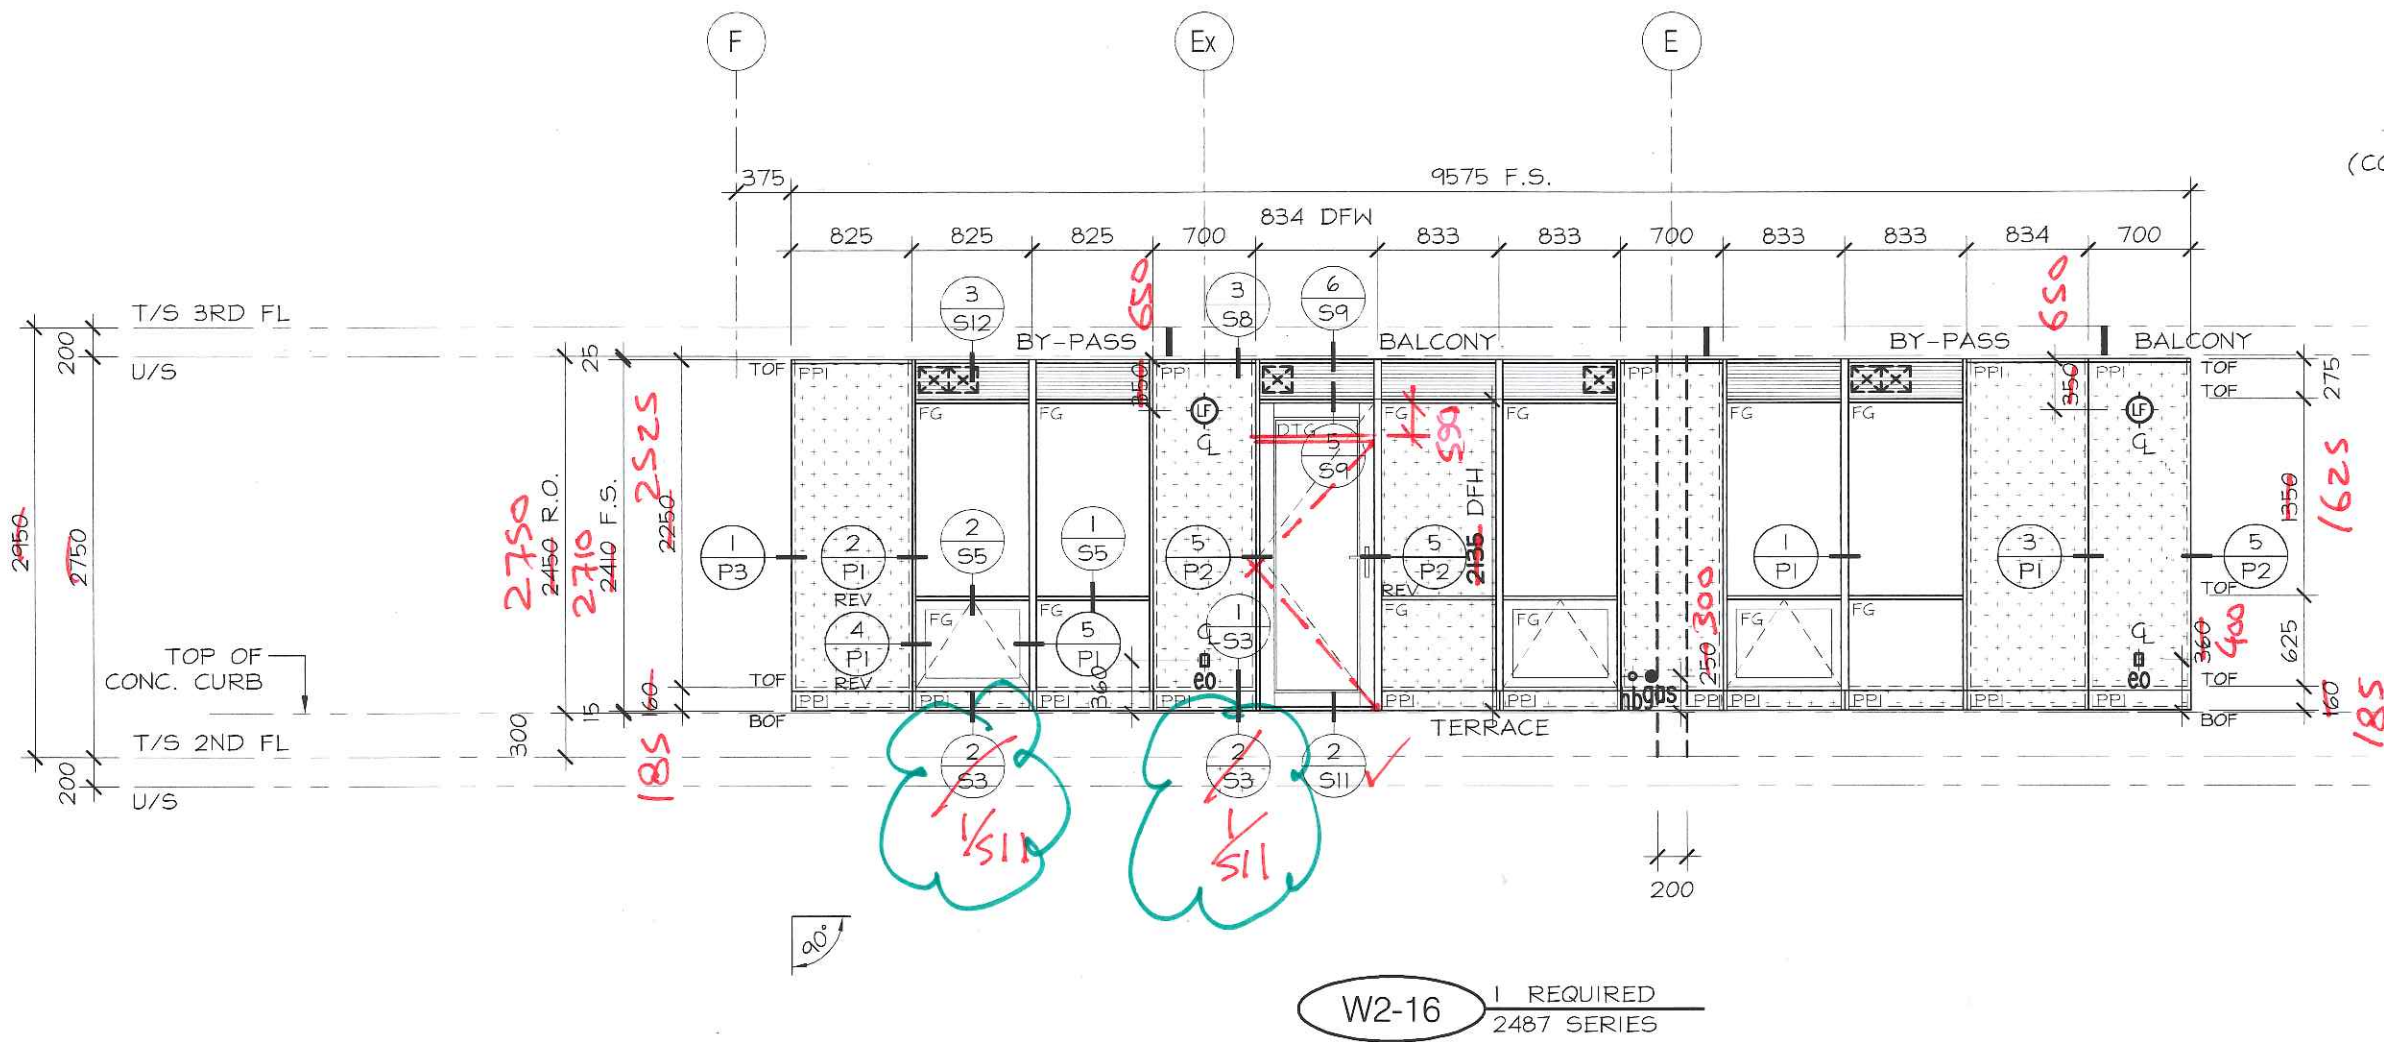

No.	REVISION	BY	DATE

PROJECT NAME: SQ ALEXANDRA PARK - BLOCK11
 DRAWING TITLE: 2nd FLOOR ELEVATIONS
 ARCHITECT: TEEPLE ARCHITECTS
 CONTRACTOR: TRIDEL
 SCALE: 1:50
 DRAWN BY: S.C.
 DATE: MARCH 4, 2015


DRAWING No.: E2-16

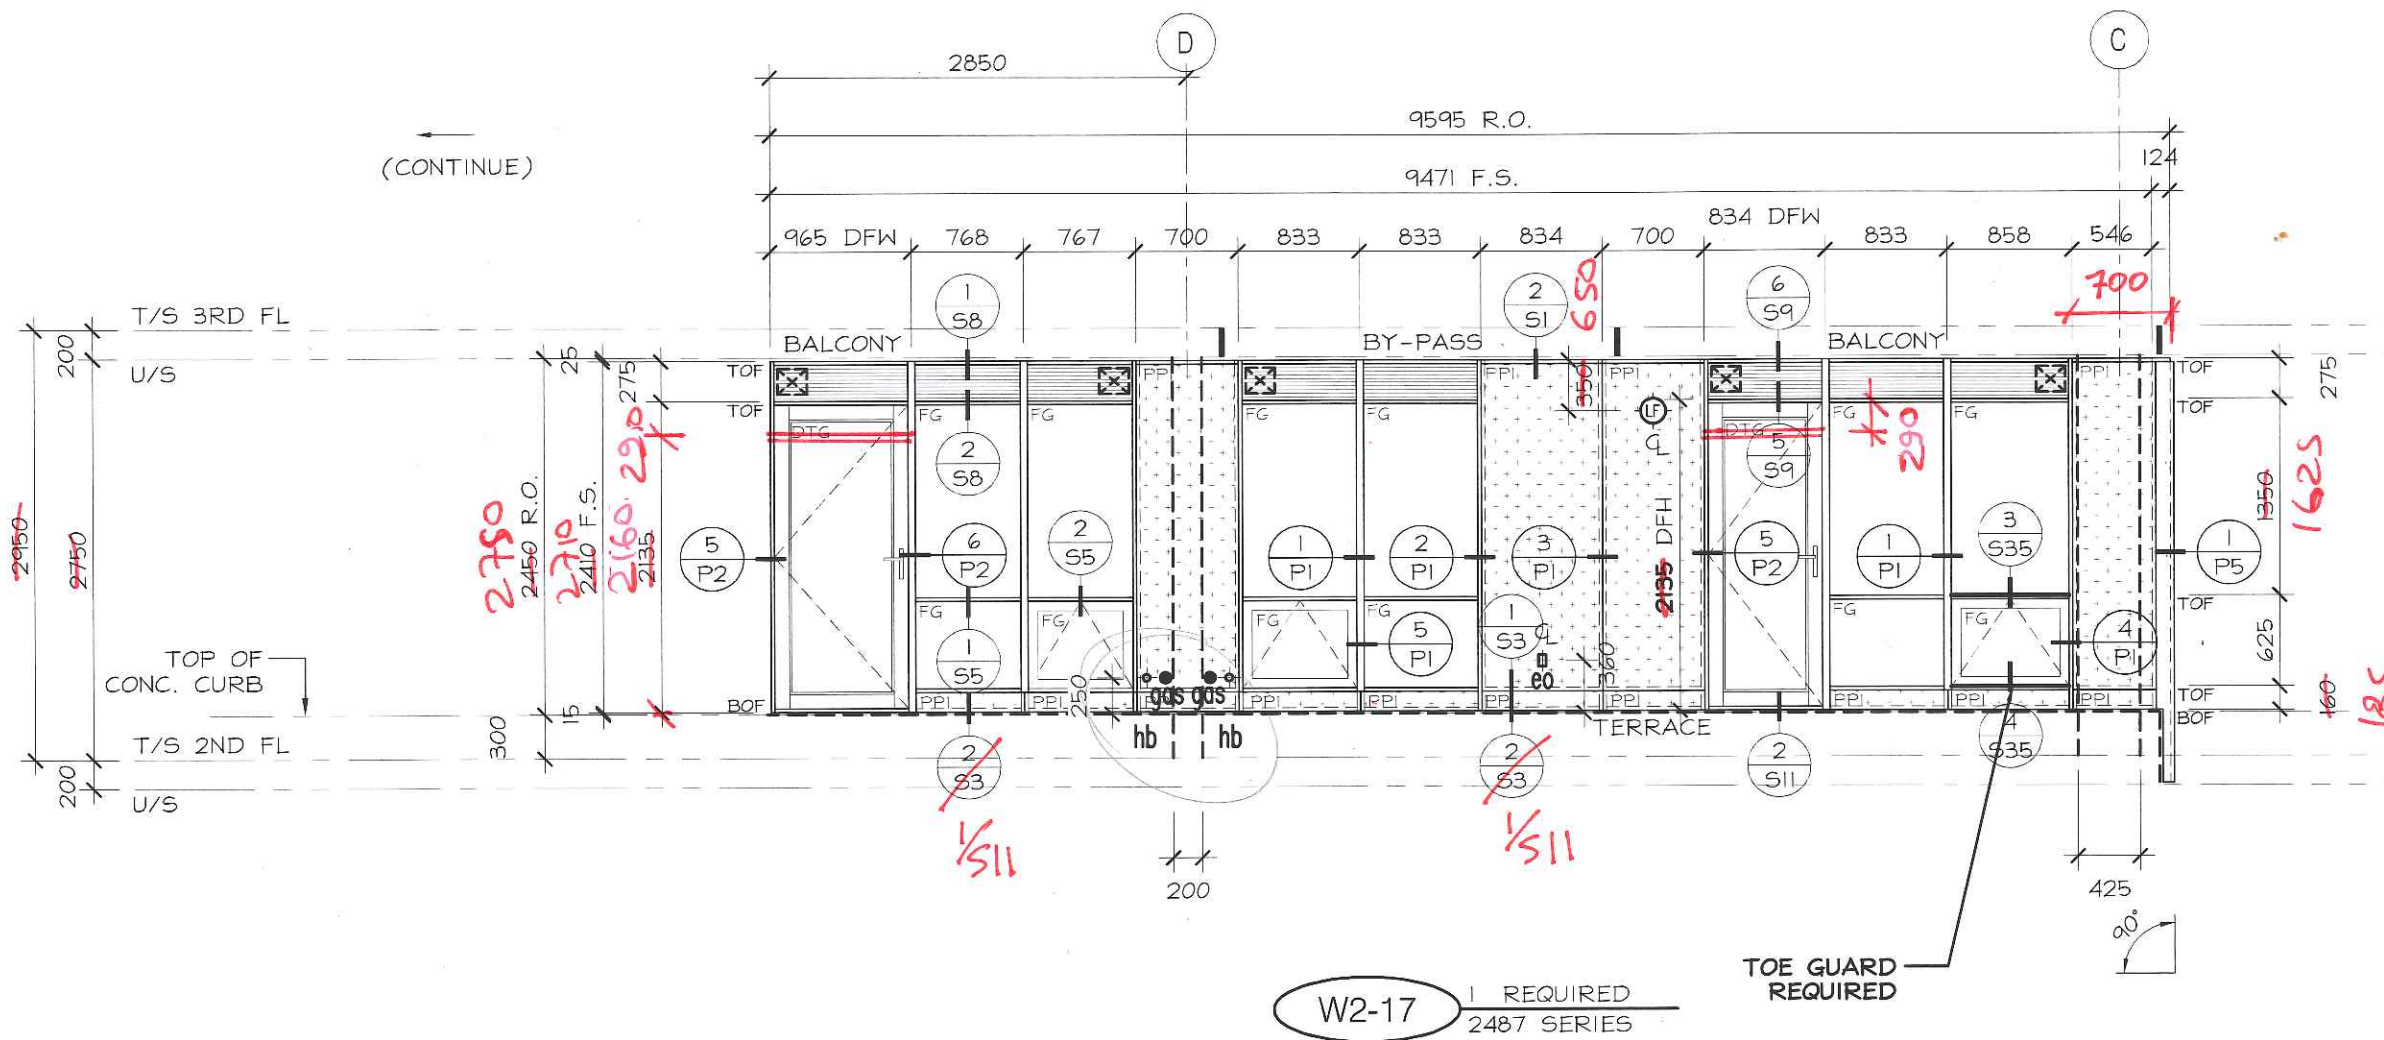

No.	REVISION	BY	DATE

PROJECT NAME: SQ ALEXANDRA PARK - BLOCK11
 DRAWING TITLE: 2nd FLOOR ELEVATIONS
 ARCHITECT: TEEPLE ARCHITECTS
 CONTRACTOR: TRIDEL
 SCALE: 1:50
 DRAWN BY: S.C.
 DATE: MARCH 4, 2015

DRAWING No.:
E2-17

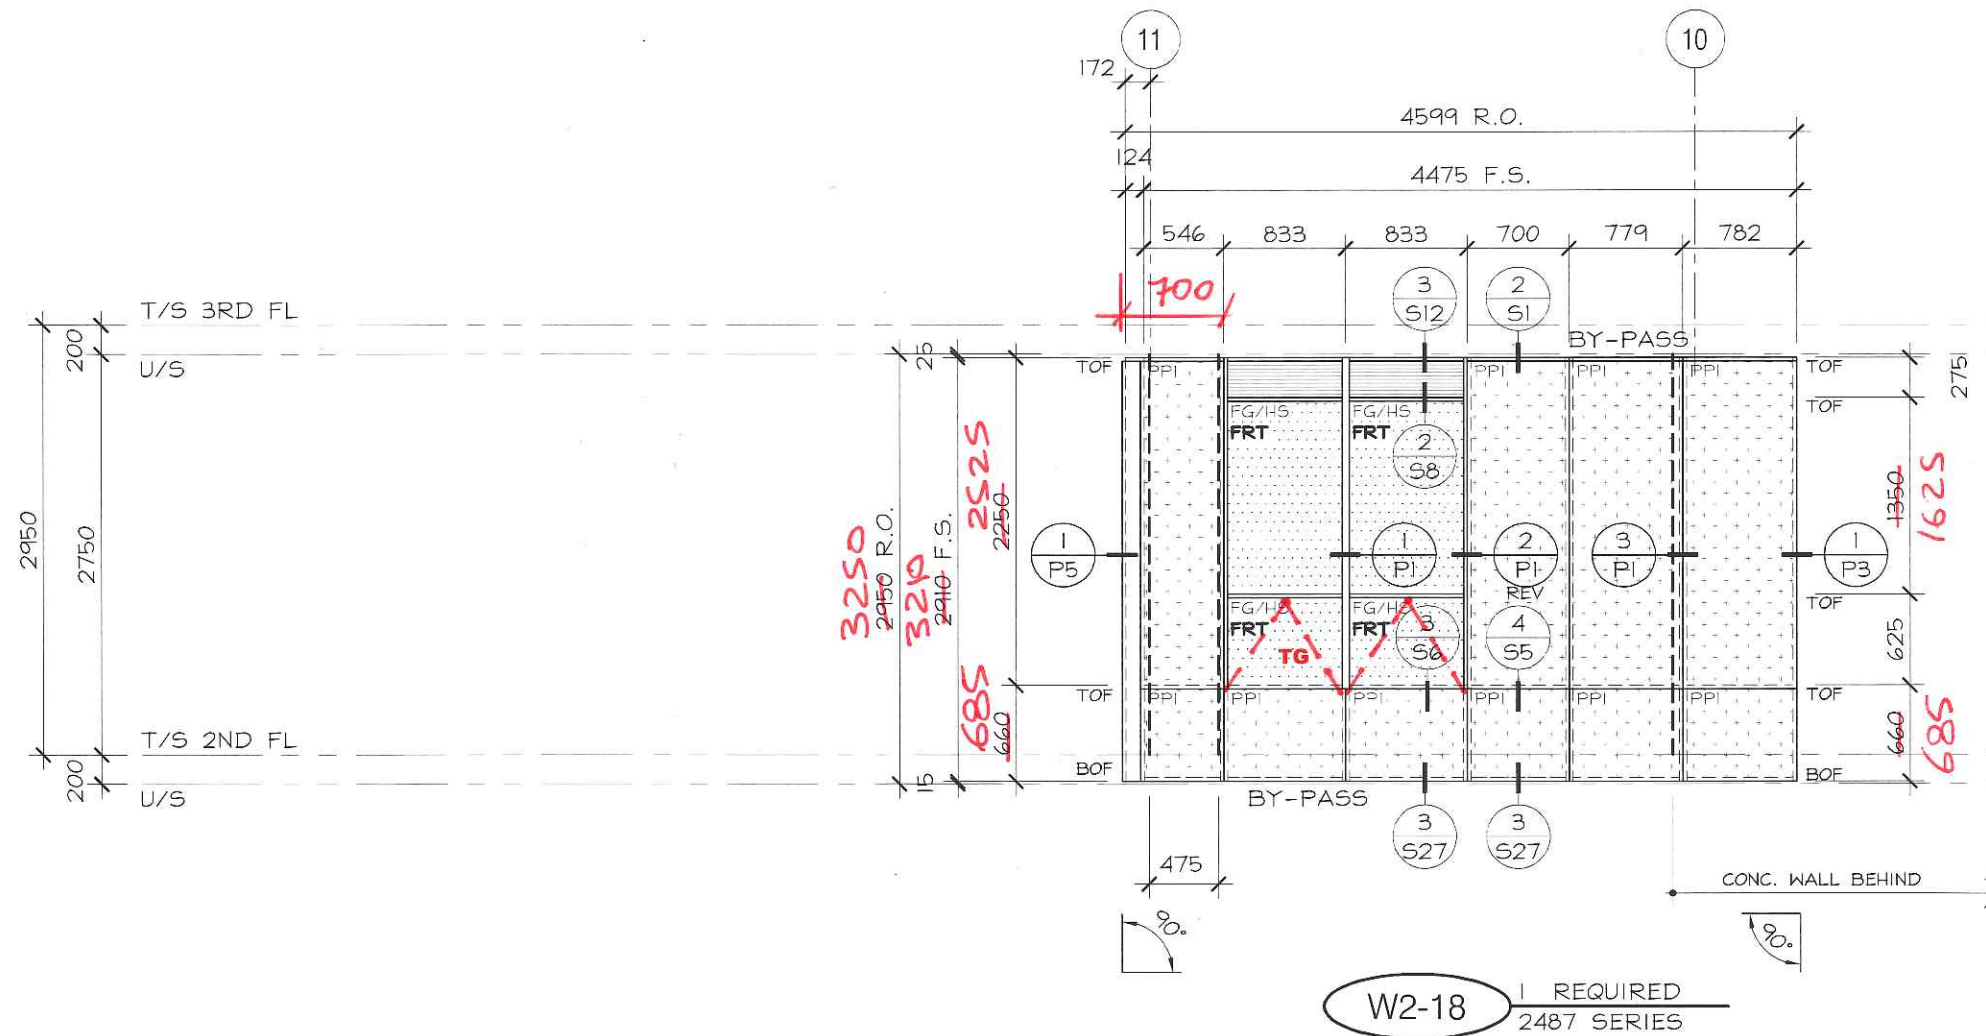

No.	REVISION	BY	DATE

PROJECT NAME: SQ ALEXANDRA PARK - BLOCK11		DRAWING No.: E2-18
DRAWING TITLE: 2nd FLOOR ELEVATIONS		
ARCHITECT: TEEPLE ARCHITECTS		DATE: MARCH 4, 2015
CONTRACTOR: TRIDEL		
SCALE: 1:50	DRAWN BY: S.C.	


REFER TO PAGE E2-22
FOR BALCONY ENCLOSURE

BY-PASS

BALCONY

B2-01

BY-PASS

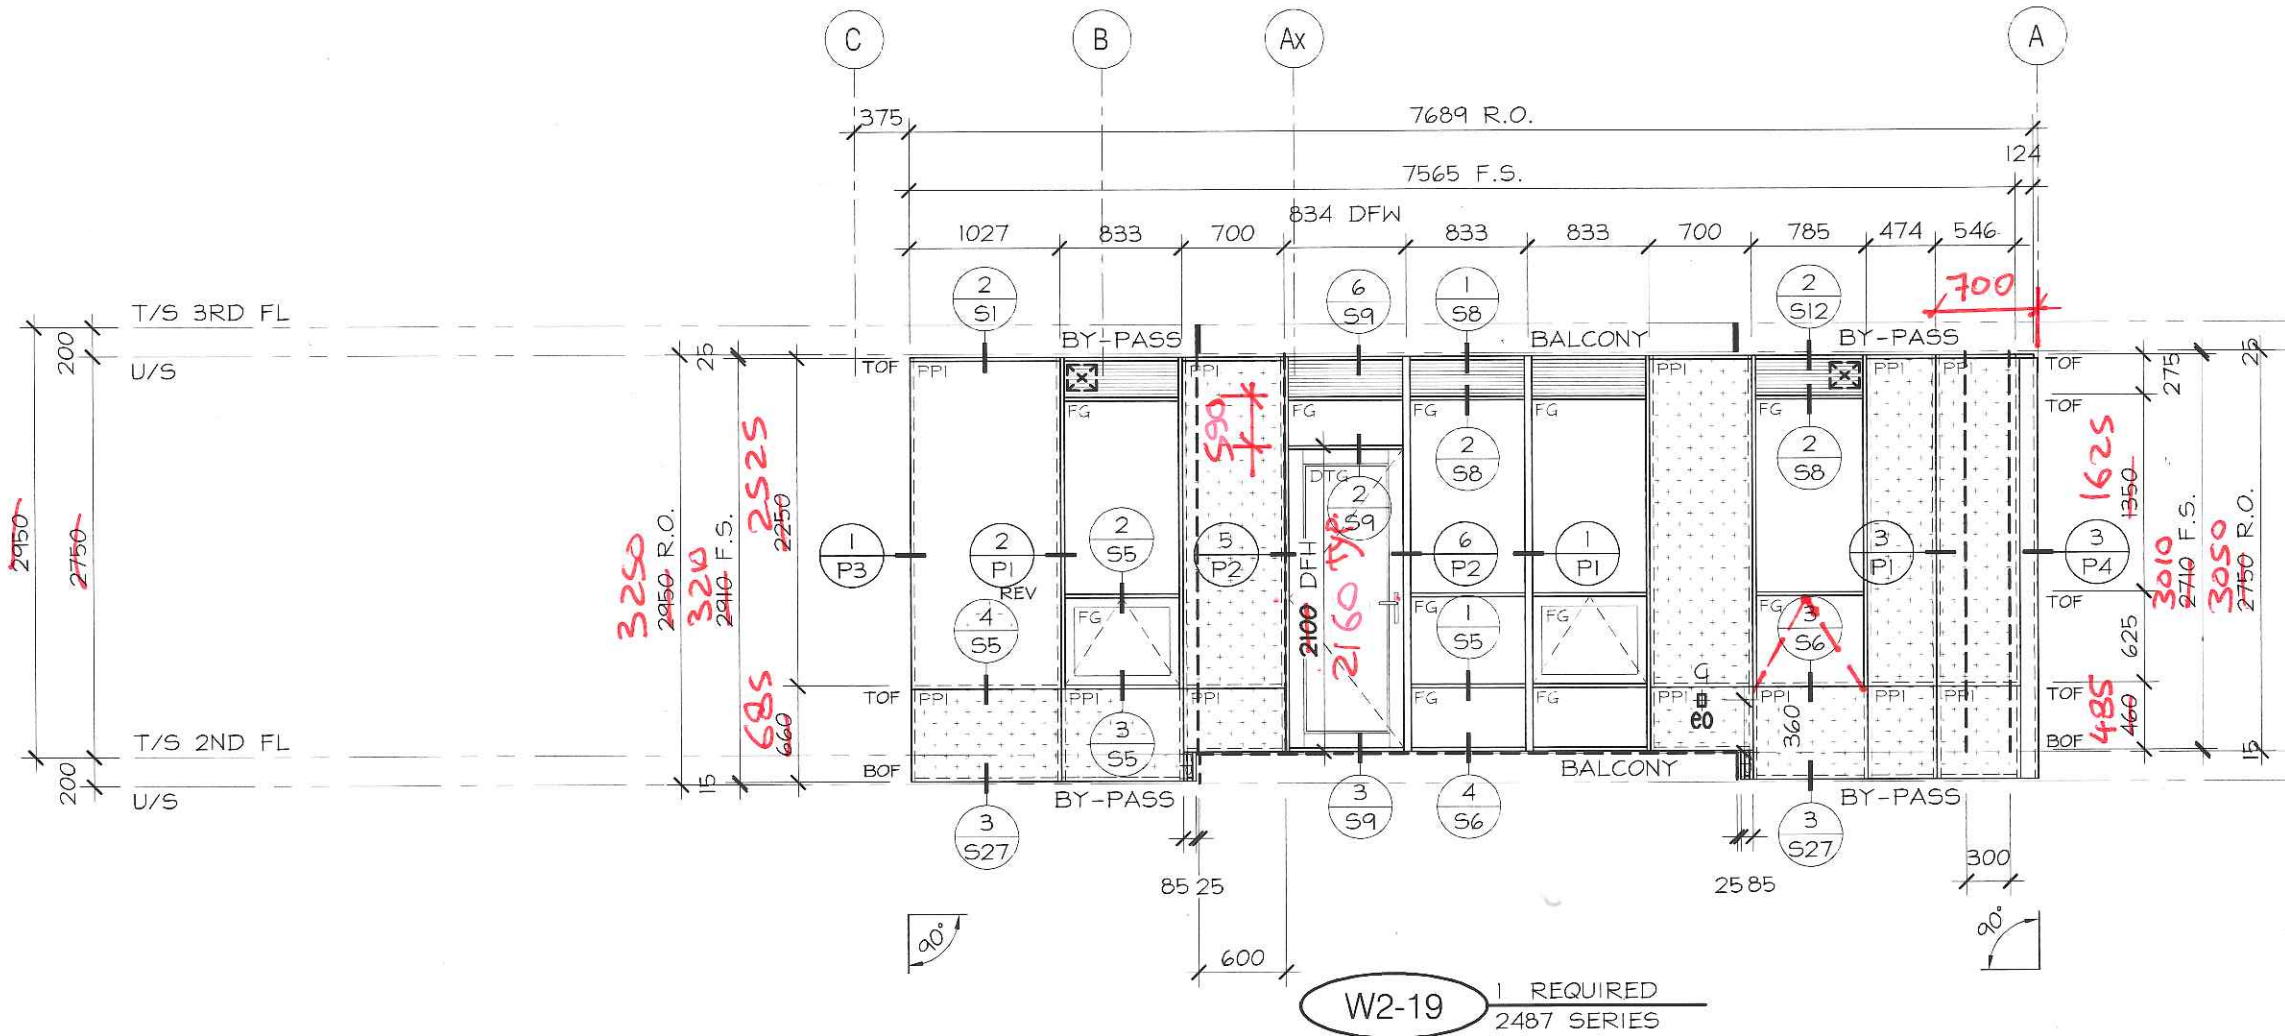

W2-19 1 REQUIRED
2487 SERIES


TORO ALUMINUM
 COMMERCIAL INDUSTRIAL RESIDENTIAL
 330 APPLEWOOD CRESCENT TEL: (905) 738-5220
 CONCORD, ON, CANADA FAX: (905) 738-5481
 L4K 4V2 WWW.TOROALUMINUM.COM

LICENSED PROFESSIONAL ENGINEER
 06-27-15
 D.T. PROHASKA
 37549614
 PROVINCE OF ONTARIO

No.	REVISION	BY	DATE

PROJECT NAME:	SQ ALEXANDRA PARK - BLOCK11
DRAWING TITLE:	2nd FLOOR ELEVATIONS
ARCHITECT:	TEEPLE ARCHITECTS.
CONTRACTOR:	TRIDEL
SCALE:	1:50
DRAWN BY:	S.C.
DATE:	MARCH 4, 2015


DRAWING No.:
E2-19

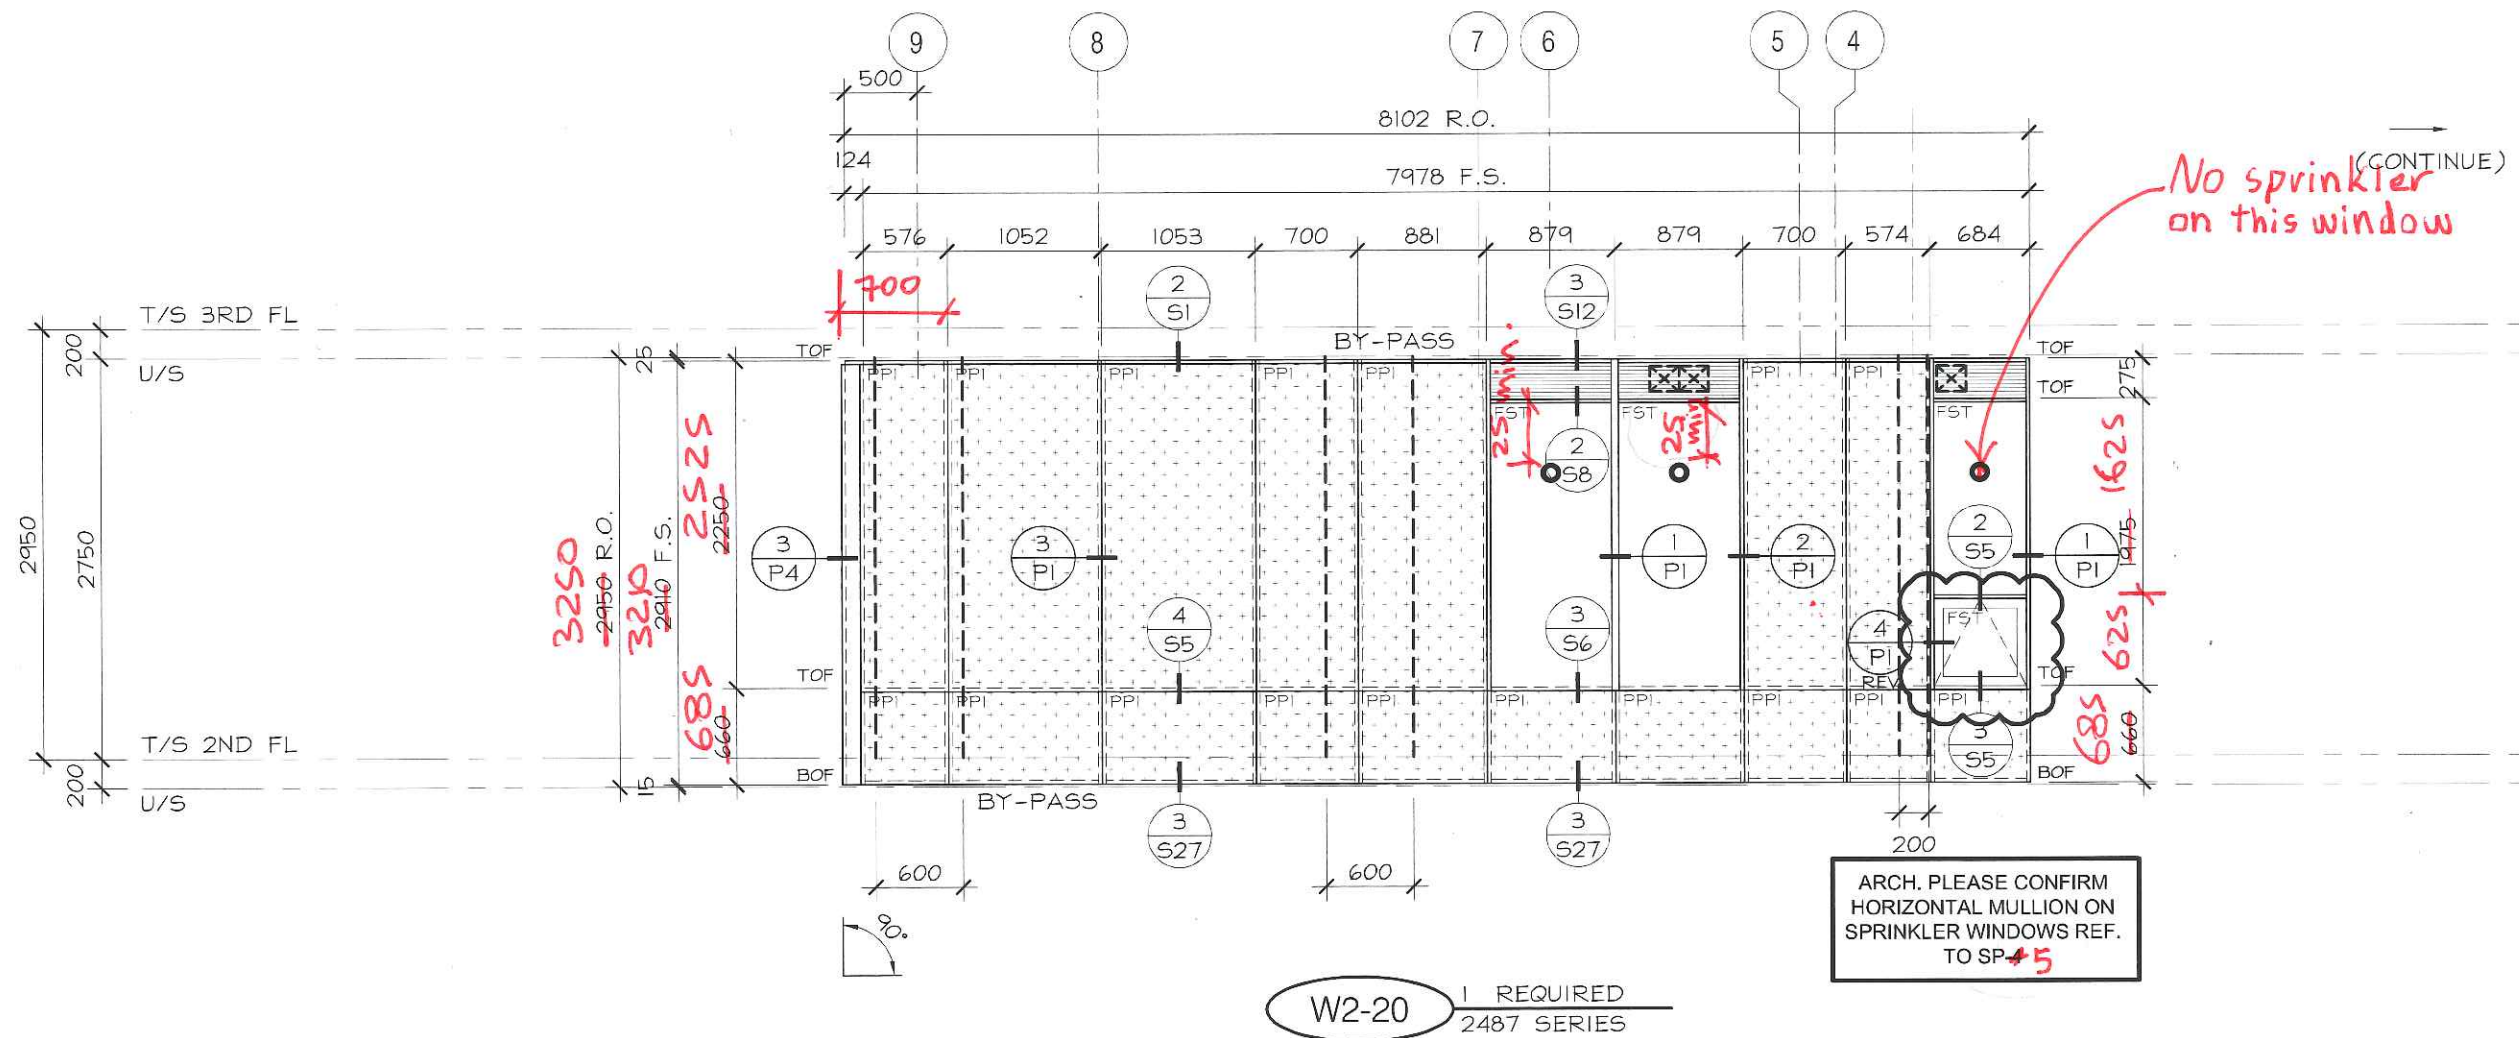

No.	REVISION	BY	DATE

PROJECT NAME:	SQ ALEXANDRA PARK - BLOCK11		
DRAWING TITLE:	2nd FLOOR ELEVATIONS		
ARCHITECT:	TEEPLE ARCHITECTS		
CONTRACTOR:	TRIDEL		
SCALE:	1:50	DRAWN BY:	S.C.
DATE:	MARCH 4, 2015		



DRAWING No.:
E2-20

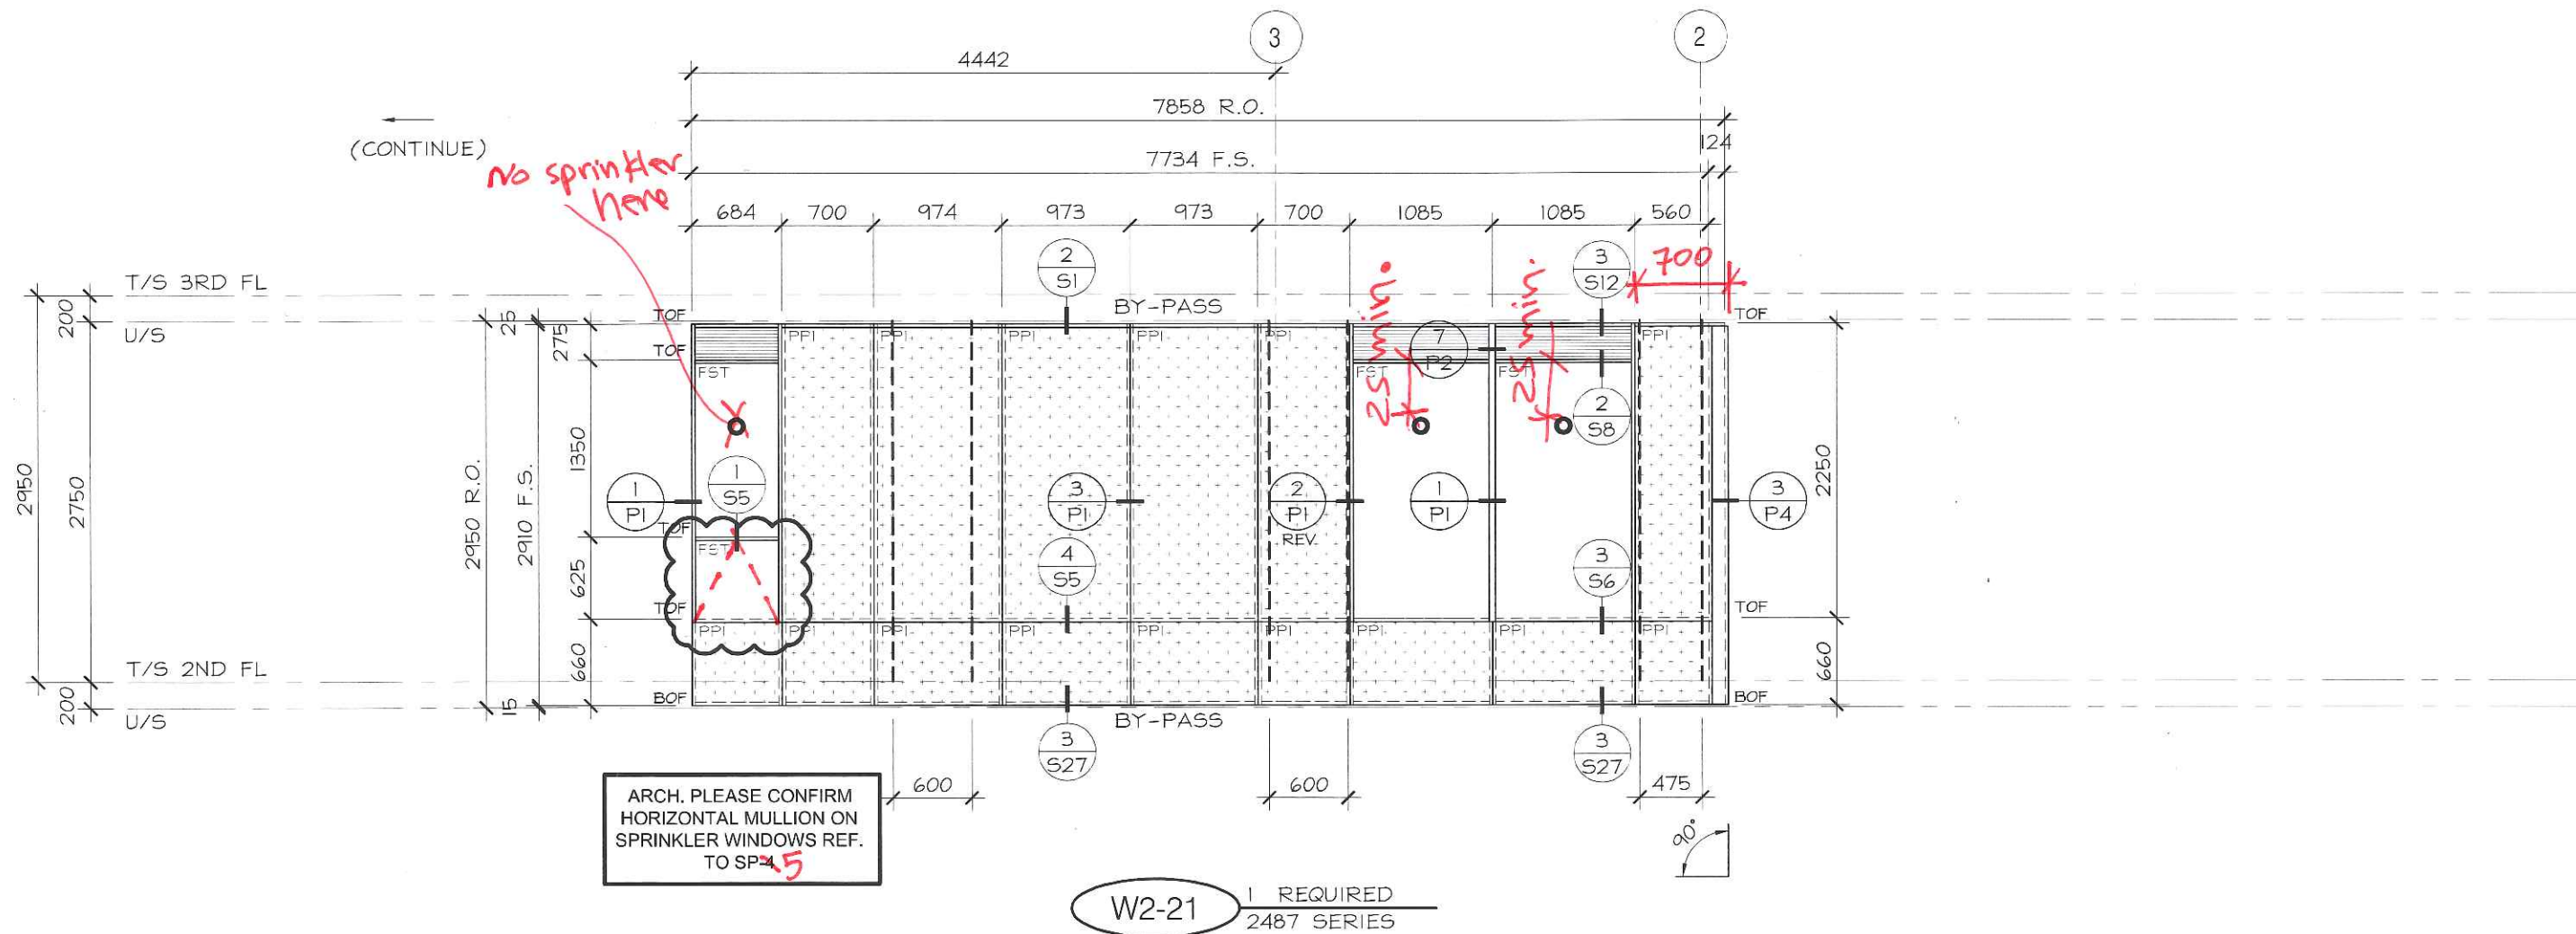

No.	REVISION	BY	DATE

PROJECT NAME: SQ ALEXANDRA PARK - BLOCK11		DRAWING No.: E2-21
DRAWING TITLE: 2nd FLOOR ELEVATIONS		
ARCHITECT: TEEPLE ARCHITECTS		SCALE: 1:50
CONTRACTOR: TRIDEL		
DRAWN BY: S.C.		DATE: MARCH 4, 2015

FOR ALUMINUM BALCONY
 & TERRACE RAILINGS
 REFER TO TORO
 ALUMINUM RAILING SHOP
 DRAWINGS

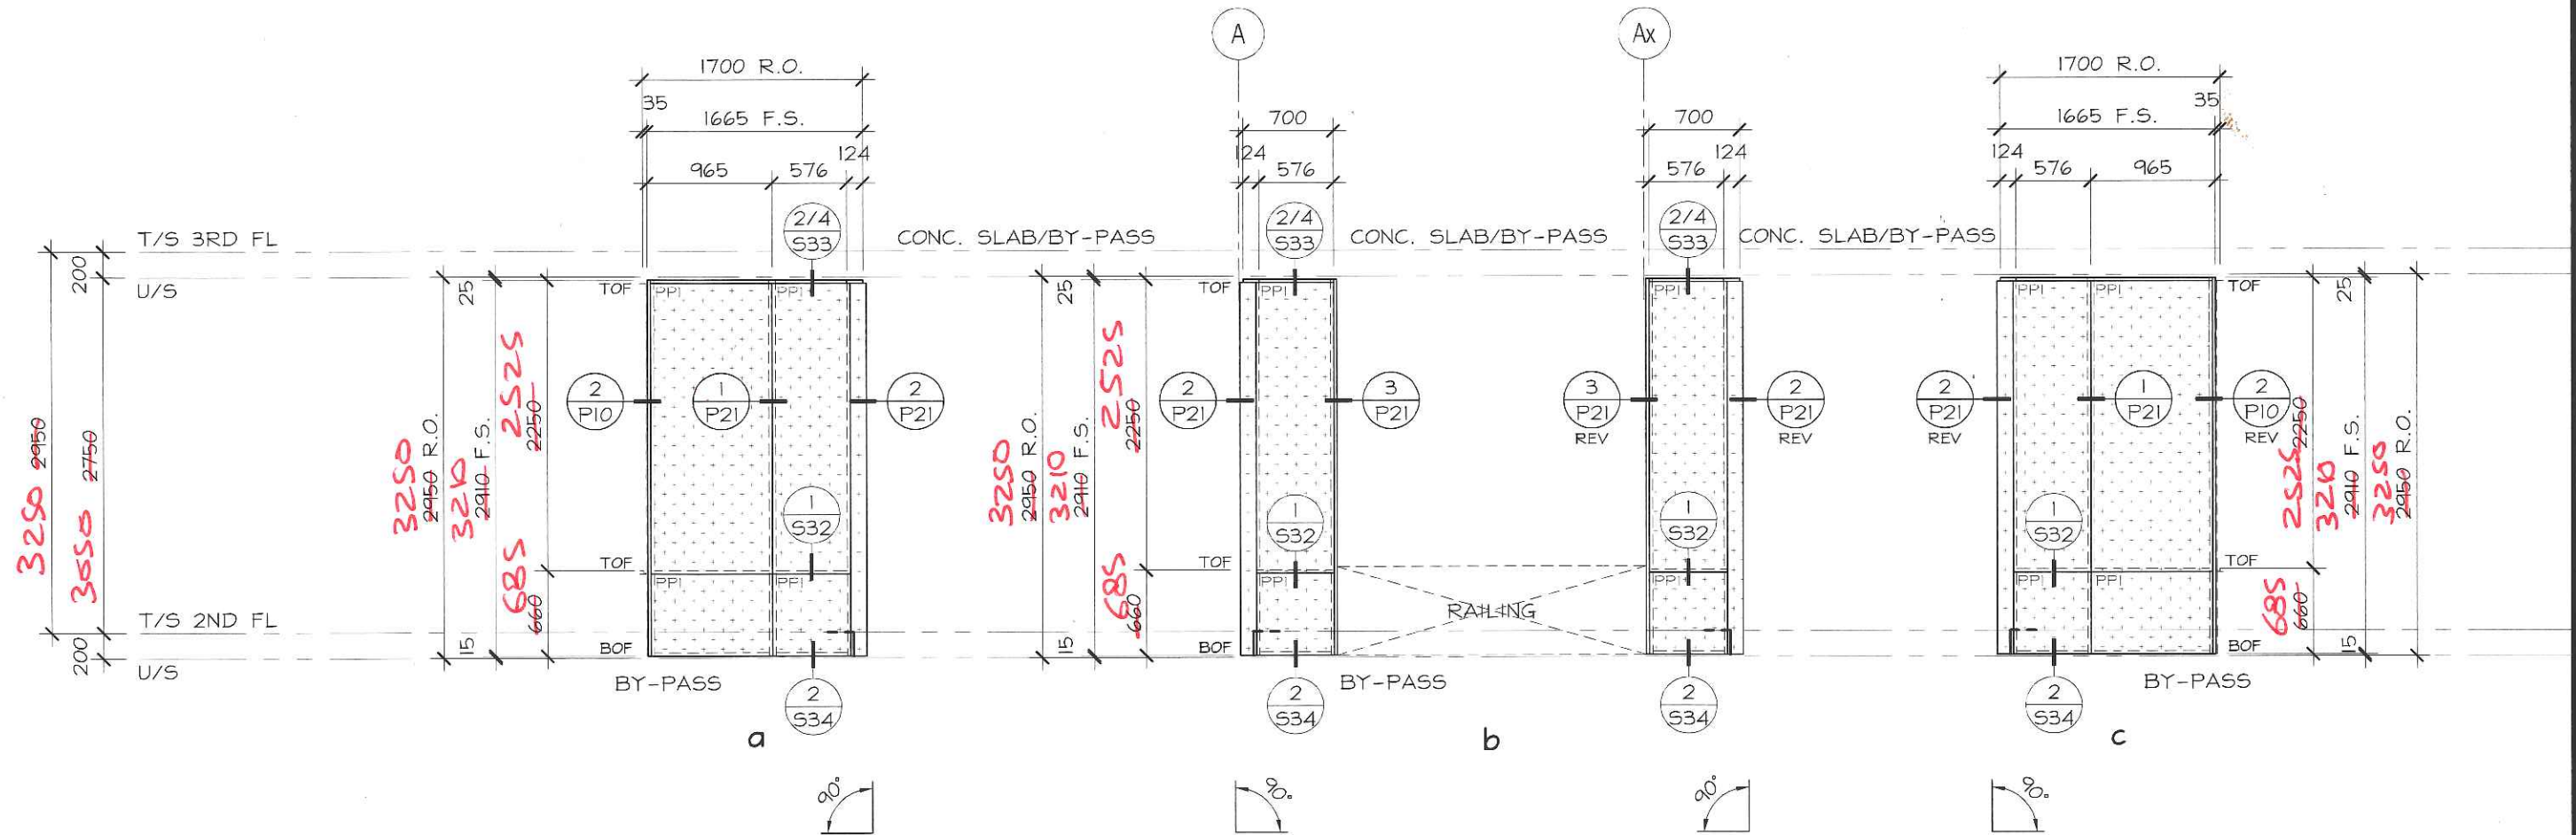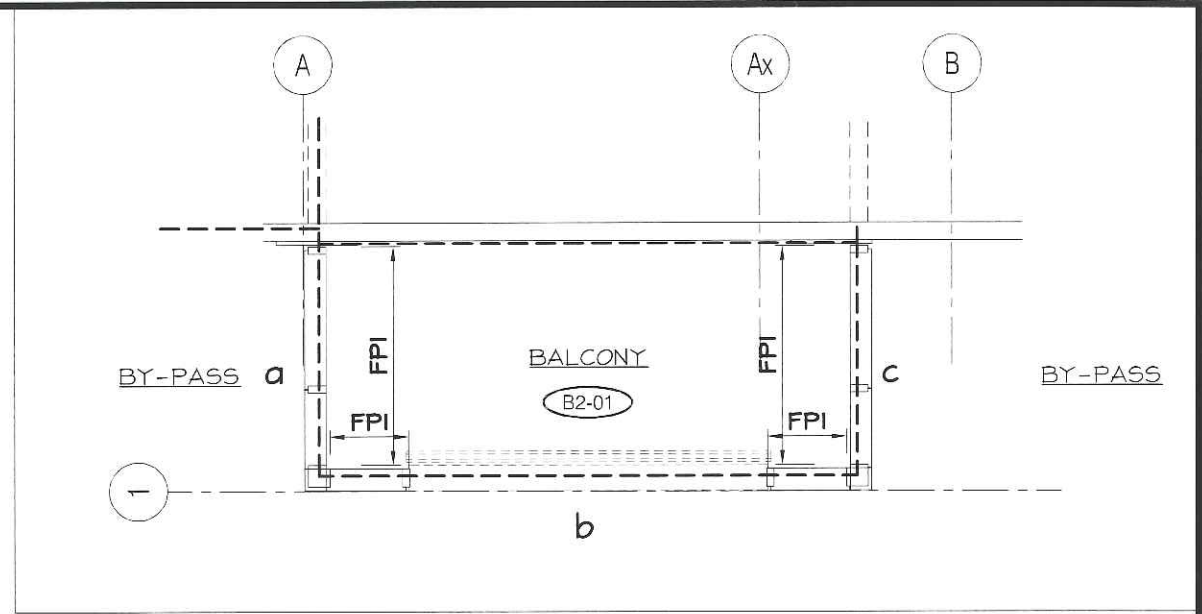

B2-01 2 REQUIRED
 2487 SERIES
 EXT. FINISH: PPG ACRYNAR PLATINUM UCFX11185
 INT. FINISH: PPG ACRYNAR PLATINUM UCFX11185





No.	REVISION	BY	DATE

PROJECT NAME:	SQ ALEXANDRA PARK - BLOCK11
DRAWING TITLE:	2nd FLOOR ELEVATIONS
ARCHITECT:	TEEPLE ARCHITECTS
CONTRACTOR:	TRIDEL
SCALE:	1:50
DRAWN BY:	S.C.
DATE:	MARCH 4, 2015

DRAWING No.:
E2-22

FOR ALUMINUM BALCONY
& TERRACE RAILINGS
REFER TO TORO
ALUMINUM RAILING SHOP
DRAWINGS

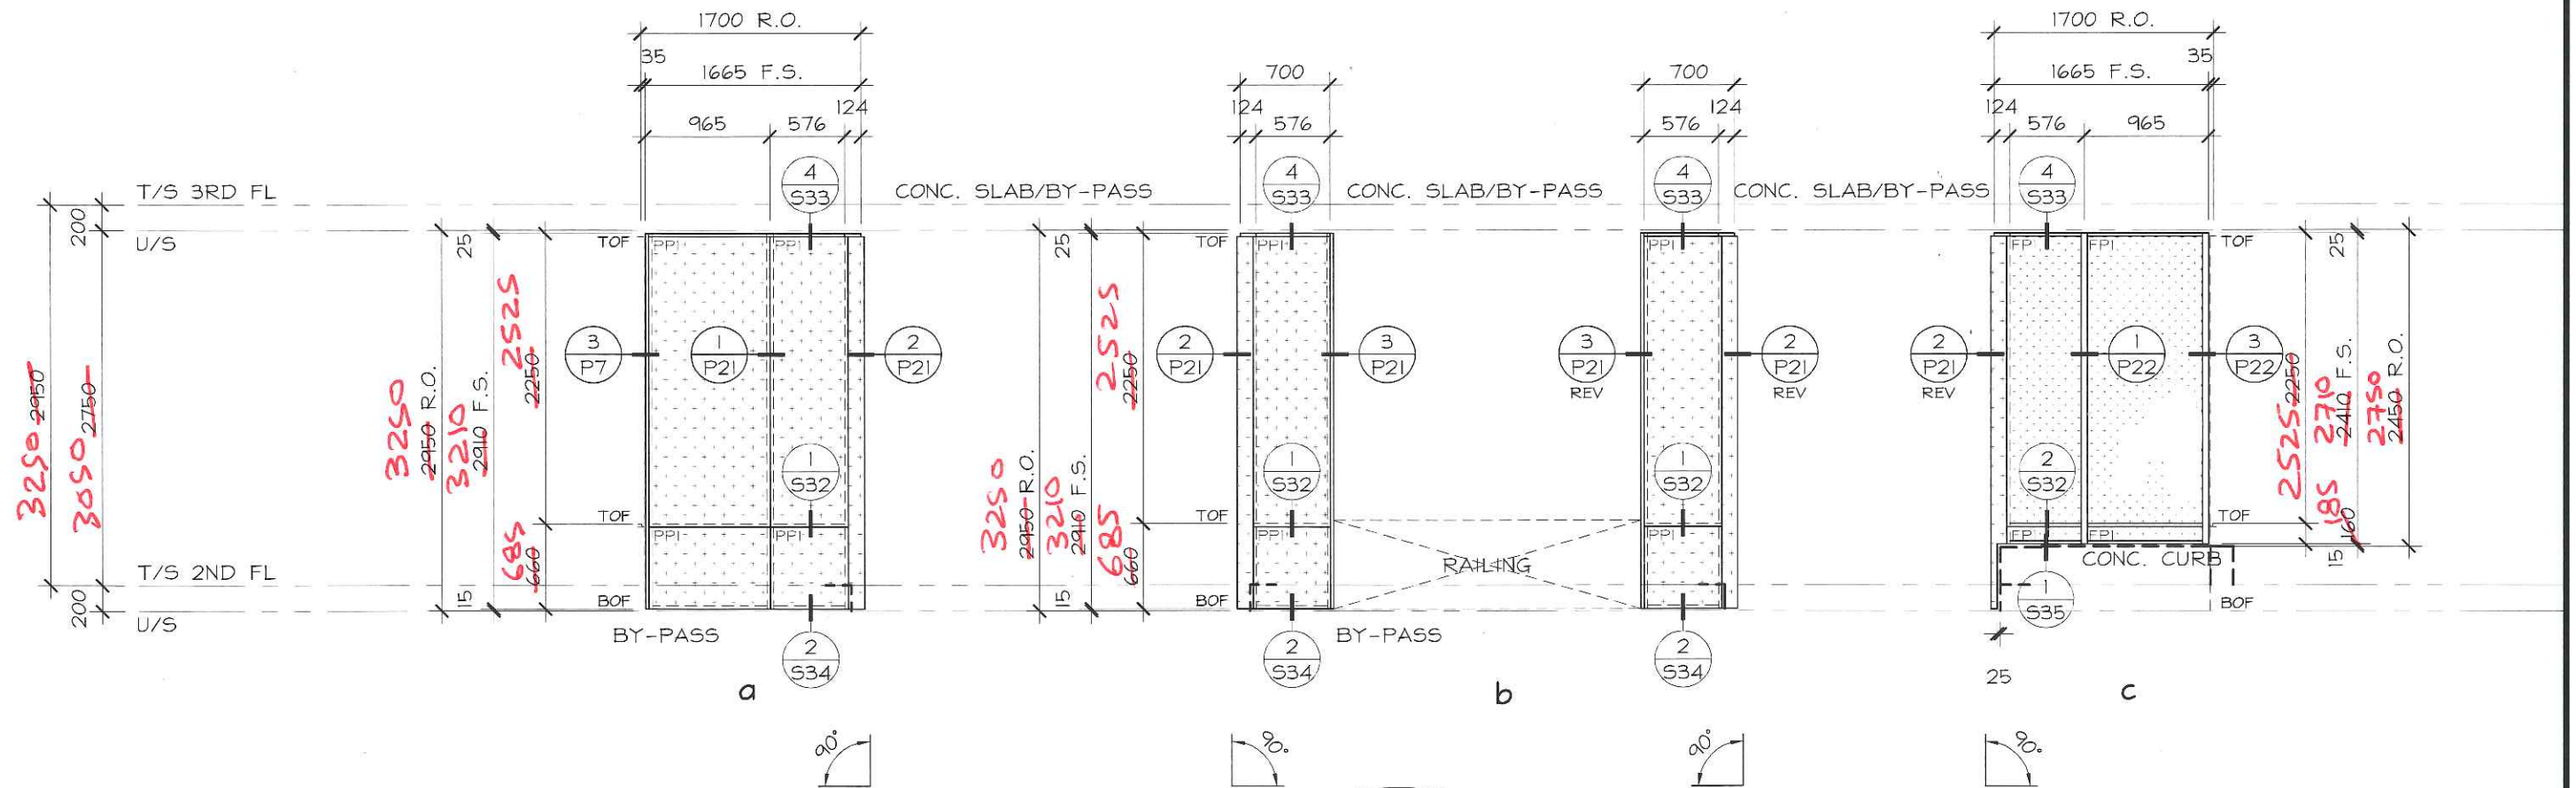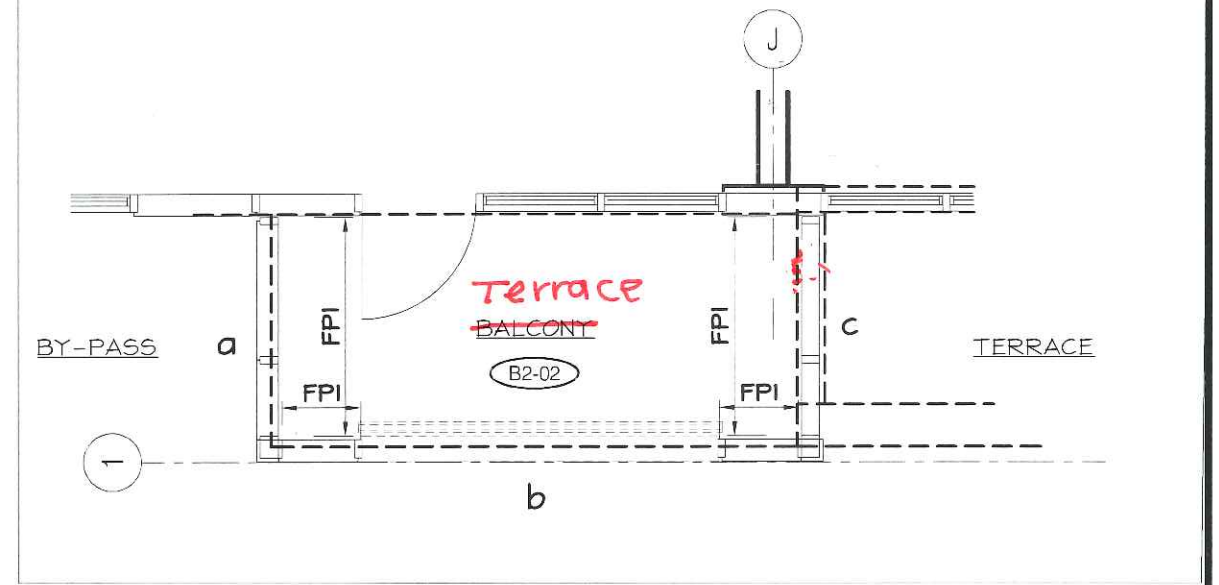



B2-02 1 REQUIRED
2487 SERIES
EXT. FINISH: PPG ACRYNAR PLATINUM UCFXIII85
INT. FINISH: PPG ACRYNAR PLATINUM UCFXIII85



No.	REVISION	BY	DATE

PROJECT NAME:	SQ ALEXANDRA PARK - BLOCK 11		
DRAWING TITLE:	2nd FLOOR ELEVATIONS		
ARCHITECT:	TEEPLE ARCHITECTS		
CONTRACTOR:	TRIDEL		
SCALE:	1:50	DRAWN BY:	S.C.
DATE:	MARCH 4, 2015		
DRAWING No.:	E2-23		

FOR ALUMINUM BALCONY
& TERRACE RAILINGS
REFER TO TORO
ALUMINUM RAILING SHOP
DRAWINGS

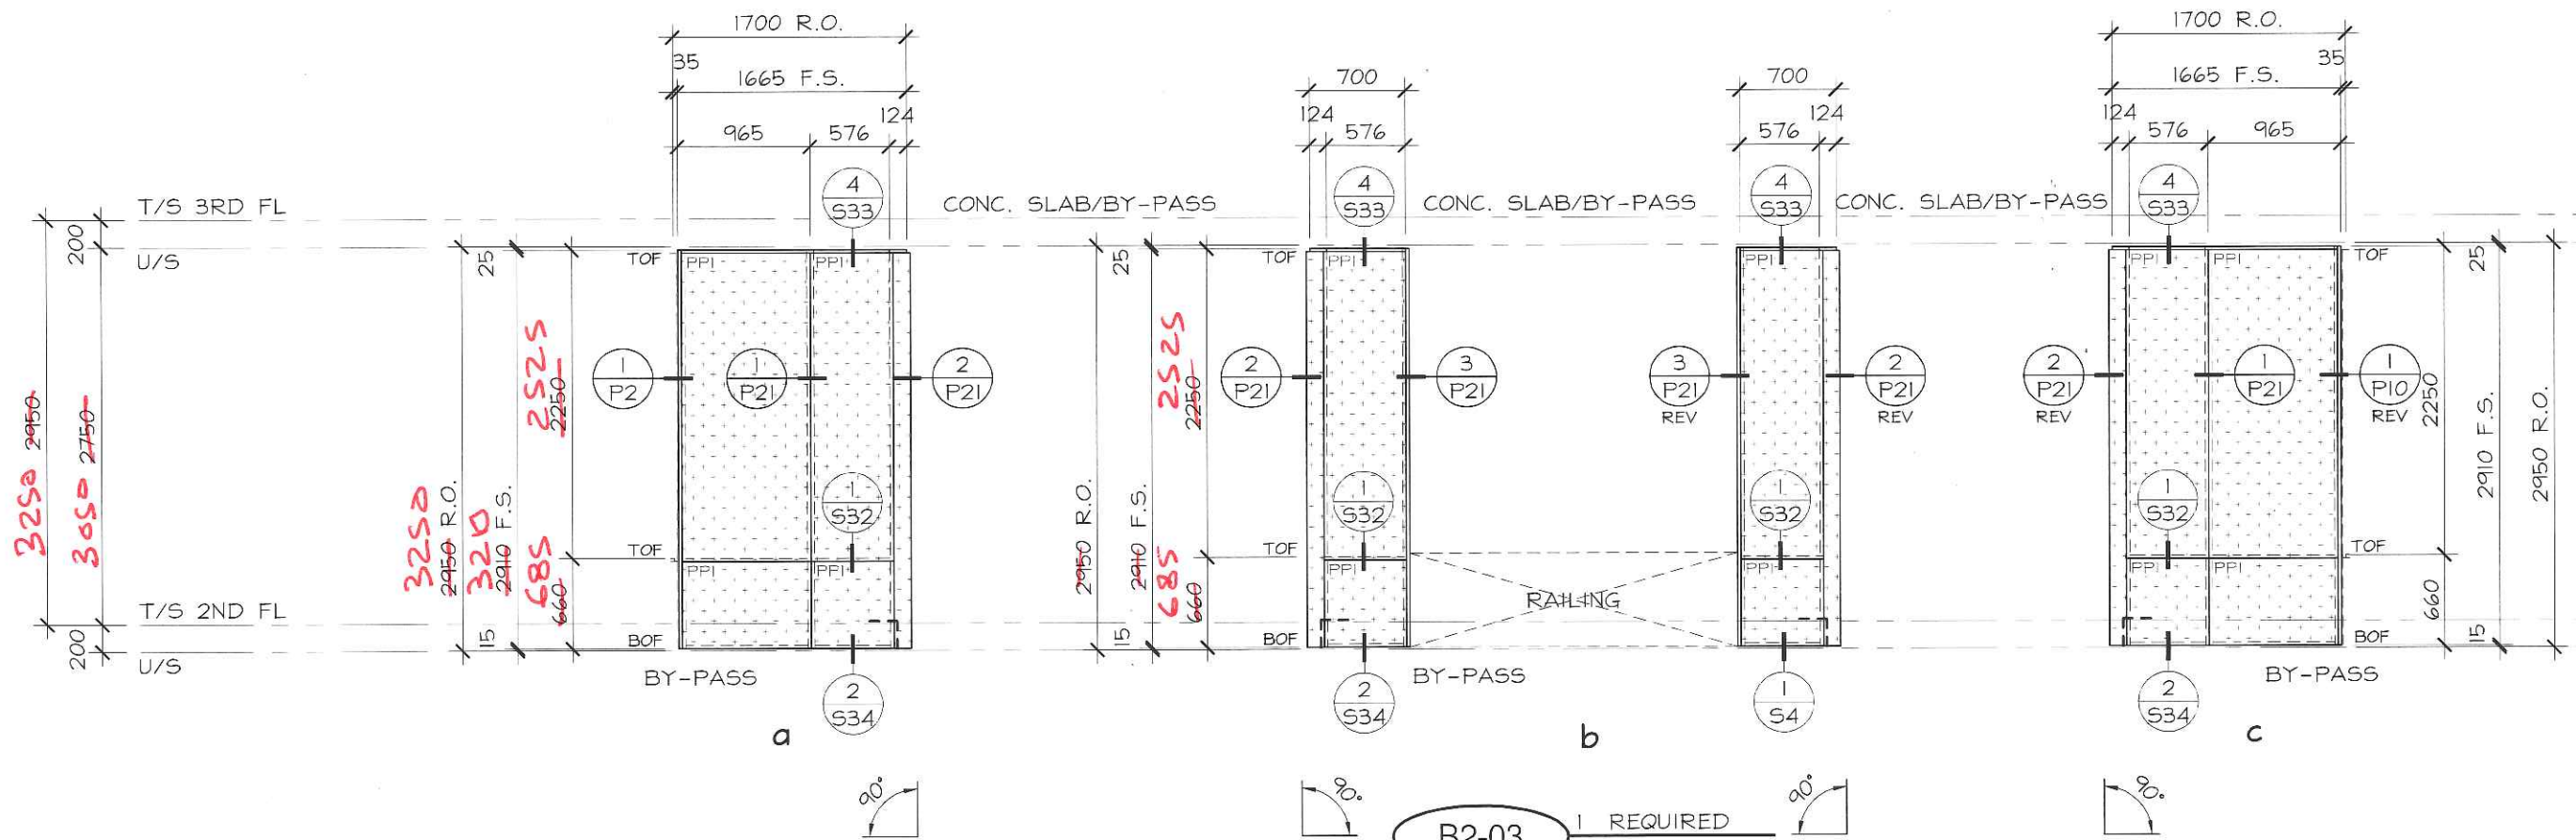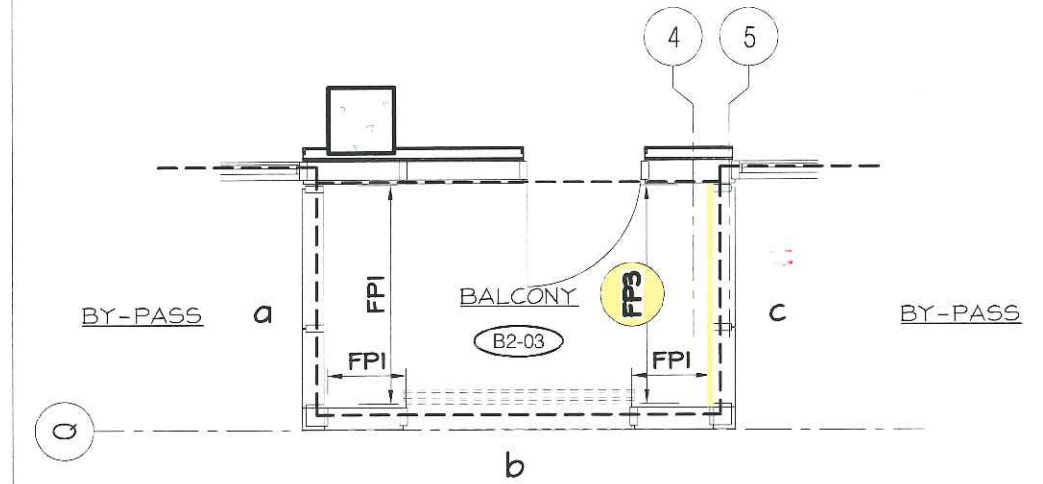

B2-03 1 REQUIRED
2487 SERIES
EXT. FINISH: PPG ACRYNAR PLATINUM UCFXIII85
INT. FINISH: PPG ACRYNAR PLATINUM UCFXIII85
C INT. FINISH: PPG ACRYNAR T.B.D.





No.	REVISION	BY	DATE

PROJECT NAME:	SQ ALEXANDRA PARK - BLOCK11
DRAWING TITLE:	2nd FLOOR ELEVATIONS
ARCHITECT:	TEEPLE ARCHITECTS
CONTRACTOR:	TRIDEL
SCALE:	1:50
DRAWN BY:	S.C.
DATE:	MARCH 4, 2015

DRAWING No.:
E2-24

FOR ALUMINUM BALCONY
& TERRACE RAILINGS
REFER TO TORO
ALUMINUM RAILING SHOP
DRAWINGS

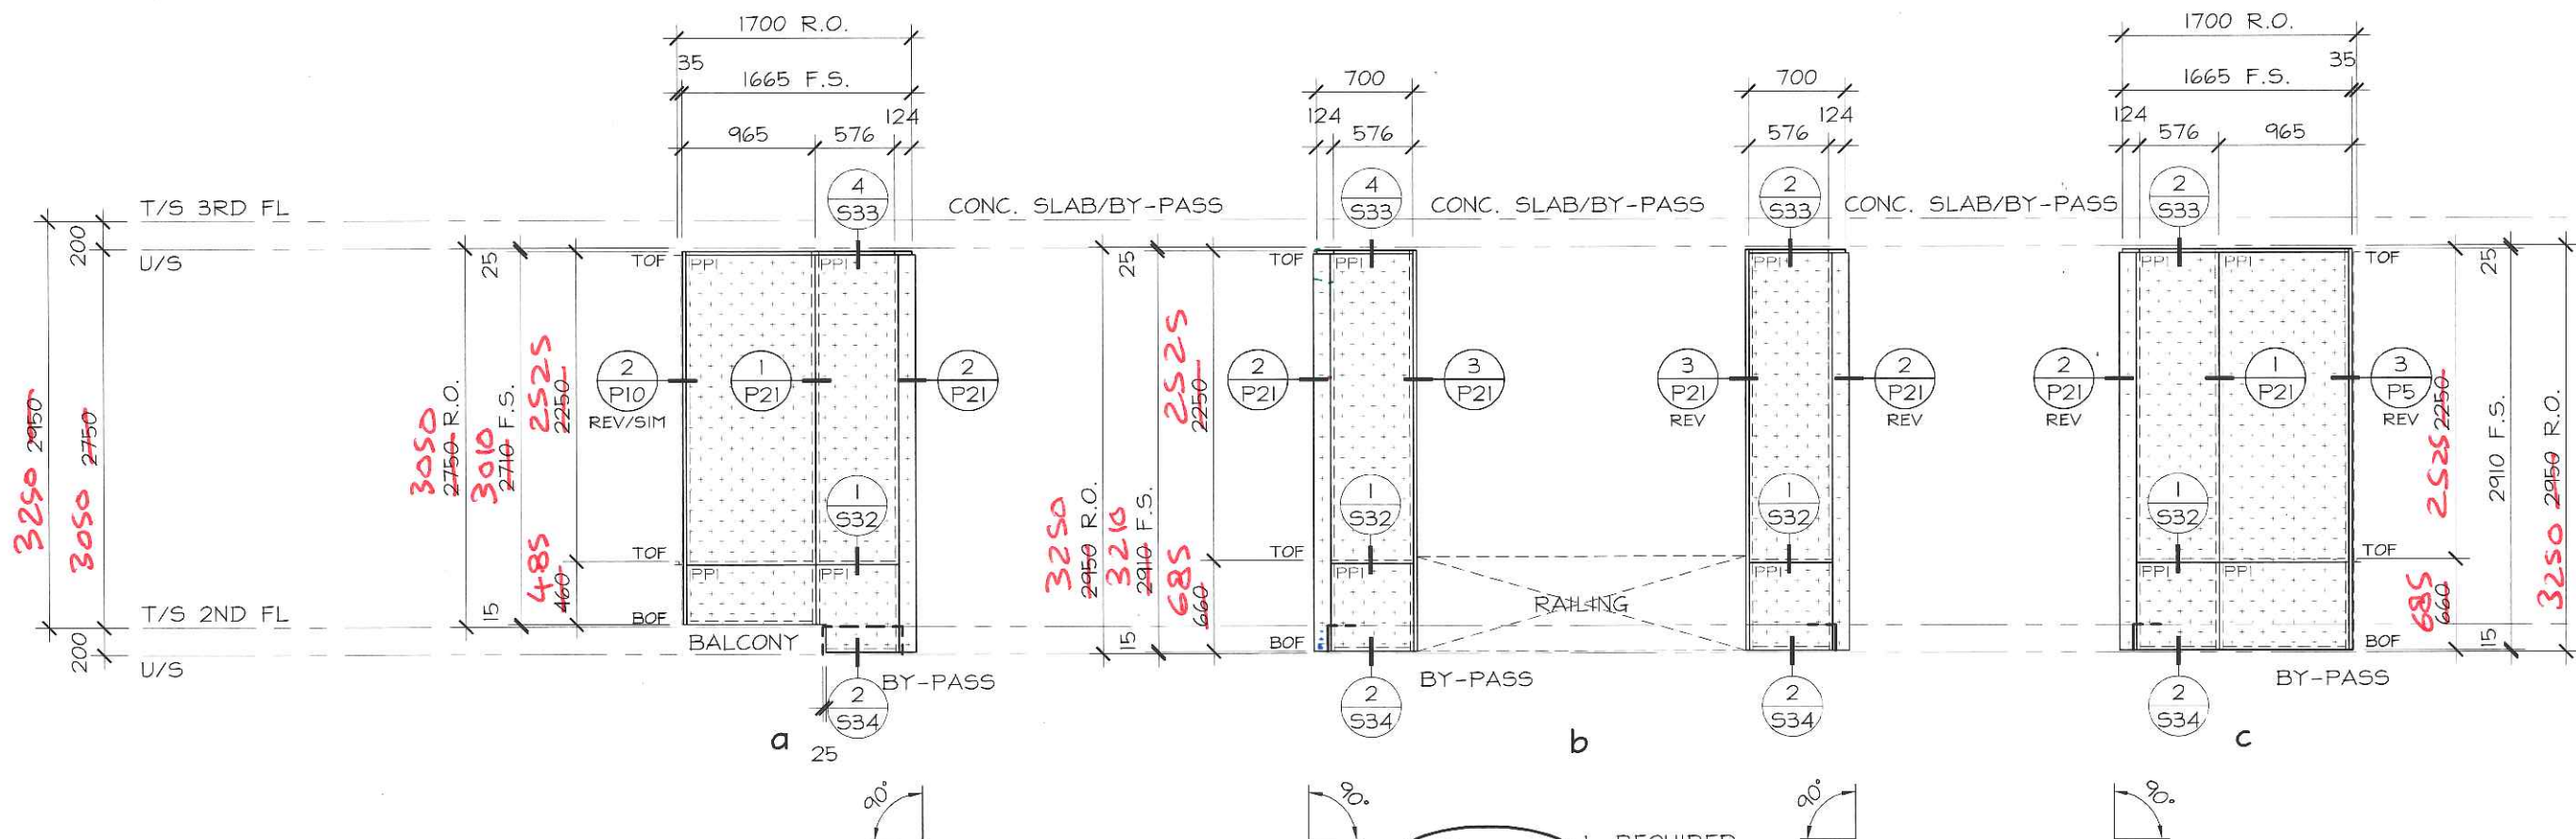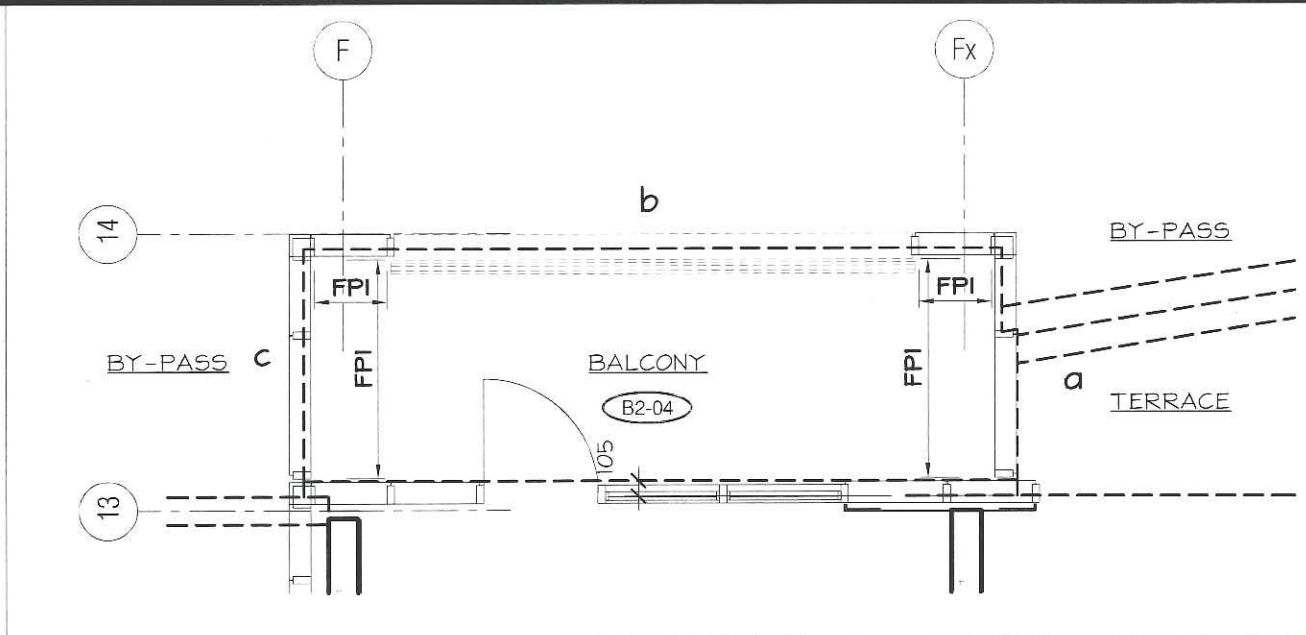

B2-04 1 REQUIRED
2487 SERIES
EXT. FINISH: PPG ACRYNAR PLATINUM UCFX11185
INT. FINISH: PPG ACRYNAR PLATINUM UCFX11185



No.	REVISION	BY	DATE

PROJECT NAME:	SQ ALEXANDRA PARK - BLOCK11		
DRAWING TITLE:	2nd FLOOR ELEVATIONS		
ARCHITECT:	TEEPLE ARCHITECTS		
CONTRACTOR:	TRIDEL		
SCALE:	1:50	DRAWN BY:	S.C.
DATE:	MARCH 4, 2015		
DRAWING No.:	E2-25		