

REVIEWED ()
 REVIEWED AS NOTED (X)
 REVISE AND RESUBMIT ()
 NOT REVIEWED ()
 DATE: 2015-10-19
 REVIEWED BY: TC

This review by Teple Architects Inc. is for the sole purpose of ascertaining conformance with the general design concept for architectural features only, and does not in any way constitute review of the design of engineering elements which form part of the contract documents prepared by others. This review shall not mean that Teple Architects Inc. approves the detailed design inherent in the shop drawings, responsibility for which shall remain with the Contractor submitting same, and such review shall not relieve the Contractor of the responsibility for errors or omissions in the shop drawings or of the responsibility for meeting all requirements of the Contract Documents. The Contractor is responsible for dimensions to be confirmed and correlated at the job site, for information that pertains solely to fabrication processes or to techniques of construction and installation, and for coordination of the work of all trades.

GENERAL SPECIFICATIONS

- 1.0 THESE DRAWINGS ARE FOR PERMIT, AND FOR PRICING, AND MUST BE ADHERED TO FOR INSTALLATION. IF CONTRACTOR WISHES TO ALTER DRAWINGS, THEN HE IS RESPONSIBLE FOR OBTAINING RE-APPROVALS.
- 2.0 CONTRACTOR TO SUPPLY AND INSTALL A COMPLETE AND FULLY OPERATIONAL AUTOMATIC SPRINKLER SYSTEM AS SHOWN ON THE DRAWINGS AND AS INDICATED IN THE SPECIFICATIONS AND CONFORMING TO N.F.P.A. REQUIREMENTS, O.B.C. REQUIREMENTS AND THE REQUIREMENTS OF THE LOCAL AUTHORITIES.
- 3.0 UPON COMPLETION OF THE INSTALLATION, THE CONTRACTOR SHALL TEST THE SYSTEM AND SUBMIT TO THE ENGINEER COMPLETED CONTRACTORS TEST CERTIFICATES STATING THAT THE SYSTEMS HAVE BEEN INSTALLED, TESTED AND APPROVED BY THE AUTHORITIES HAVING JURISDICTION IN ACCORDANCE WITH N.F.P.A.#13, LATEST OR APPLICABLE EDITION.
- 4.0 ALL WORK SHALL BE DONE IN ACCORDANCE WITH ALL CODES, STANDARDS BY-LAWS AND AUTHORITIES HAVING JURISDICTION.
- 5.0 SYSTEMS TO BE INSTALLED AS PER N.F.P.A. STANDARDS, AND LOCAL AUTHORITIES
- 6.0 SPRINKLER CONTRACTOR TO CO-ORDINATE INSTALLATION WITH EXISTING SITE CONDITIONS AND ACCEPT RESPONSIBILITY FOR AND COST OF MAKING ADJUSTMENTS TO PIPING TO AVOID INTERFERENCE WITH MECHANICAL, ELECTRICAL AND OTHER BUILDING COMPONENTS.
- 7.0 SPRINKLER CONTRACTOR TO INCLUDE FOR OFFSETS IN SPRINKLER PIPING AND MUST SUPPLY AND INSTALL TRAPEZE HANGERS WHERE REQUIRED. HANGERS FOR MAINS TO BE INSTALLED AT PANEL POINTS OF JOISTS.
- * 8.0 ALL SPRINKLER VALVES TO BE SUPERVISED, AND U.L.C. LISTED.
- * 9.0 SPRINKLER CONTRACTOR TO ALLOW FOR ADDITIONAL PRESSURE SWITCHES WHERE REQUIRED FOR ALARM SYSTEM.
- 10.0 CONTRACTOR TO ALLOW IN PRICE FOR SUFFICIENT PIPE AND FITTINGS TO INSTALL PENDENT SPRINKLERS WITHIN A 5 FT. RADIUS OF THE LOCATION SHOWN ON DRAWINGS.
- 11.0 ALL MATERIALS USED IN THE INSTALLATION OF THE SPRINKLER SYSTEM SHALL BE CANADIAN MADE, UNLESS SPECIFICALLY APPROVED IN WRITING PRIOR TO INSTALLATION BY THE ARCHITECTS AND/OR ENGINEERS RESPONSIBLE FOR THE SYSTEM DESIGN.
- 12.0 ALL SPRINKLER EQUIPMENT SHALL BE OF ONE MANUFACTURER FROM THE FOLLOWING: GRINNELL, VIKING, CENTRAL, RELIABLE OR APPROVED EQUAL. ALL SHALL BE U.L.C. LISTED FOR THEIR SPECIFIC APPLICATION.
- 13.0 DRAWINGS ARE NOT TO BE SCALED.
- 14.0 THESE DRAWINGS ARE THE PROPERTY OF THE ENGINEERS AND SHALL NOT BE ALTERED WITHOUT APPROVAL. DRAWINGS SHALL BE RETURNED UPON REQUEST.
- 15.0 SPRINKLER HEADS SHALL BE U.L.C. LISTED AND SHALL BE THE TYPE AND TEMPERATURE RATING SPECIFIED ON THE DRAWINGS.
- 16.0 PROVIDE SPARE SPRINKLER HEADS AND WRENCH IN A METAL CABINET, MOUNTED ON THE WALL NEAR THE MAIN SPRINKLER VALVE HEADER. AMOUNT AS PER N.F.P.A. STANDARD # 13 LATEST OR APPLICABLE EDITION.
- 17.0 SPRINKLERS OF SUITABLE TEMPERATURE RATING SHALL BE INSTALLED NEAR HEATING EQUIPMENT AS SPECIFIED IN N.F.P.A. STANDARD # 13 LATEST OR APPLICABLE EDITION.

- 18.0 PROVIDE ALL NECESSARY TRIM REQUIRED FOR ALARM CHECK VALVES TO COMPLY WITH APPLICABLE CODES AND REQUIREMENTS.
- 19.0 PENDENT SPRINKLERS INSTALLED WHERE SUSPENDED CEILING TILES OR DRYWALL OCCUR ARE TO BE EQUIPPED WITH TWO PIECE ESCUTCHEONS. (WHERE APPLICABLE)
- 20.0 THE CONTRACTOR SHALL BE RESPONSIBLE FOR THE INSTALLATION OF THE FIRE PROTECTION SYSTEMS AND FOR CO-ORDINATION WITH ALL SITE CONDITIONS. BEFORE COMMENCING WORK, EXAMINE THE SITE AND THE EXISTING CONDITIONS AND REPORT IMMEDIATELY TO THE ENGINEER ANY DEFECT OR INTERFERENCE AFFECTING THE COMPLETION OF THE WORK OR THE GUARANTEE OF THIS CONTRACTOR.
- 21.0 CONTRACTOR MUST CHECK AND VERIFY ALL DIMENSIONS AND CONDITIONS ON THE JOB AND REPORT DISCREPANCIES TO THE ENGINEER BEFORE PROCEEDING WITH THE WORK.
- * 22.0 PROVIDE FLOW ALARM DEVICES, SUPERVISORY SWITCHES AND PRESSURE SWITCHES WHERE SHOWN ON DRAWINGS. WIRING TO ANNUNCIATOR SHALL BE BY ANY MAJOR ELECTRICAL CONTRACTOR. PROVIDE NECESSARY SIGNS WHERE REQUIRED BY THE LOCAL FIRE AUTHORITIES.
- 23.0 PROVIDE SHOP DRAWINGS FOR THE FOLLOWING:
 - * A) - SPRINKLER HEADS
 - * B) - ALARM VALVE AND TRIM
 - * C) - SUPERVISORY DEVICES
 - * D) - HANGERS
 - * E) - FLOW SWITCHES
- 24.0 A COPY OF N.F.P.A. STANDARD # 25 IS TO BE PROVIDED AND LEFT IN A VISIBLE LOCATION IN THE SPRINKLER ROOM.
- 25.0 DIMENSIONS AND/OR MEASUREMENTS INDICATED ON THE DRAWINGS ARE TO BE VERIFIED AT SITE AND ANY MAJOR DISCREPANCIES TO BE REPORTED PRIOR TO FABRICATION AND INSTALLATION. (IF APPLICABLE)
- 26.0 EXACT LOCATION AND ELEVATION OF MAINS TO BE DETERMINED BY CONTRACTOR TO SUIT SITE CONDITIONS.
- 27.0 CONTRACTOR TO CO-ORDINATE LOCATION OF SPRINKLERS WITH RESPECT TO SURFACE MOUNTED LIGHT FIXTURES AND MAINTAIN MINIMUM CLEARANCE AS REQUIRED BY NFPA 13 TO AVOID ANY OBSTRUCTION TO SPRAY PATTERN OF SPRINKLERS.
- 28.0 CONTRACTOR TO PROVIDE NECESSARY HANGERS AND ASSEMBLY TO COMPLY WITH THE FOLLOWING:
 - A) UNSUPPORTED LENGTH BETWEEN END SPRINKLER AND LAST HANGER SHALL NOT EXCEED 36 INCHES FOR 1" DIA. PIPE, 48" FOR 1 1/4" DIA PIPE AND 60" FOR 1 1/2" DIA. PIPE OR LARGER. NOTE: WHEN PRESSURE EXCEEDS 100 PSI, REFER TO NFPA STANDARD # 13
 - B) THE LENGTH OF AN UNSUPPORTED ARM-OVER TO A SPRINKLER SHALL NOT EXCEED 24". NOTE: WHEN PRESSURE EXCEEDS 100 PSI, REFER TO NFPA STANDARD # 13
- 29.0 MINIMUM WALL THICKNESS OF SPRINKLER PIPING TO BE EQUIVALENT TO SCHEDULE 10S.
- 30.0 CONTRACTOR TO INCLUDE FOR AN ADDITIONAL 20 SPRINKLERS FOR BELOW OBSTRUCTIONS ETC.
- 31.0 SPRINKLERS IN LIGHT HAZARD OCCUPANCIES (ie OFFICES, SCHOOLS ETC.) TO BE QUICK RESPONSE TYPE.
- * 32.0 SPRINKLER SYSTEM TO BE SEISMICALLY RESTRAINED TO ONTARIO BUILDING CODE AND NFPA #13 REQUIREMENTS.
- 33.0 CONTRACTOR TO PROVIDE ADEQUATE DRAINS AS REQUIRED BY N.F.P.A.#13 AND DISCHARGE TO A LOCATION TO SUIT SITE CONDITIONS.
- 34.0 ELECTRIC FIRE PUMP AND JOCKEY PUMP TO BE INSTALLED IN ACCORDANCE WITH NFPA STANDARD #20 AND O.B.C. AND BE IN COMPLIANCE WITH THE REQUIREMENT OF LOCAL AUTHORITIES.

* DENOTES * IF APPLICABLE *

PS	DESCRIPTION	LOCATION
PS-1	LOW PRESSURE MONITOR SWITCH	SPRINKLER ROOM
PS-2	PRESSURE SWITCH FOR P-1 PARKING DRY SPR. SYSTEM	SPRINKLER ROOM
PS-3	PRESSURE SWITCH FOR P-2 PARKING DRY SPR. SYSTEM	SPRINKLER ROOM
PS-4	PRESSURE SWITCH FOR JOCKEY PUMP	SPRINKLER ROOM
PS-5	PRESSURE SWITCH FOR FIRE PUMP	SPRINKLER ROOM
PS-6	PRESSURE SWITCH FOR COMBINATION FEED MAIN	SPRINKLER ROOM
LAPS-1	LOW AIR PRESSURE SWITCH	SPRINKLER ROOM
LAPS-2	LOW AIR PRESSURE SWITCH	SPRINKLER ROOM

ZONE	DESCRIPTION	LOCATION
FS-21	SPR. SYSTEM ON GROUND LEVEL	GARAGE ROOM (170)
FS-22	SPR. SYSTEM IN GARAGE ROOM	GARAGE ROOM (170)
FS-23	SPR. RISER IN GARAGE CHUTE	GARAGE ROOM (170)
FS-24	SPR. SYSTEM IN TOWNHOUSE AT NORTHEAST CORNER	GARAGE ROOM (170)
FS-25	SPR. SYSTEM ON 2ND LEVEL	2ND LEVEL (STAR G)
FS-26	SPR. SYSTEM ON 3RD LEVEL	3RD LEVEL (STAR F)
FS-27	SPR. SYSTEM ON 4TH LEVEL	4TH LEVEL (STAR G)
FS-28	SPR. SYSTEM ON 5TH LEVEL	5TH LEVEL (STAR F)
FS-29	SPR. SYSTEM ON 6TH LEVEL	6TH LEVEL (STAR G)
FS-30	SPR. SYSTEM ON 7TH LEVEL	7TH LEVEL (STAR F)
FS-31	SPR. SYSTEM ON 8TH LEVEL	8TH LEVEL (STAR G)
FS-32	SPR. SYSTEM ON 9TH LEVEL	9TH LEVEL (STAR F)
FS-33	SPR. SYSTEM ON 10TH LEVEL	10TH LEVEL (STAR G)
FS-34	SPR. SYSTEM ON 11TH LEVEL	11TH LEVEL (STAR F)
FS-35	SPR. SYSTEM ON 12TH LEVEL	12TH LEVEL (STAR G)
FS-36	SPR. SYSTEM ON 13TH LEVEL	13TH LEVEL (STAR F)
FS-37	SPR. SYSTEM ON 14TH LEVEL	14TH LEVEL (STAR G)
FS-38	SPR. SYSTEM ON MECH. PENHOUSE	PENHOUSE
FS-39	SPR. SYSTEM IN MECH. P.H. ON 9TH FL.	MECH. RM ON 9TH FL.
FS-41	WIN. SPR.'S ON P1	STAFF ROOM ON P1
FS-42	WIN. SPR.'S ON P2	STAFF ROOM ON P1
FS-43	WIN. SPR.'S ON GR. FL.	CORRIDOR ON GR. FL.
FS-44	WIN. SPR.'S ON 2ND FL.	2ND FL (STAR J)
FS-45	WIN. SPR.'S ON 3RD FL.	3RD FL (STAR J)
FS-46	WIN. SPR.'S ON 4TH FL.	4TH FL (STAR J)

ZONE	DESCRIPTION	LOCATION
SV-1	INCOMING FIRE MAIN ISOLATION	SPRINKLER ROOM
SV-2	INCOMING FIRE MAIN ISOLATION	SPRINKLER ROOM
SV-3	DRY SPR. SYSTEM HEADER MAIN ISOLATION	SPRINKLER ROOM
SV-4	P-1 PARKING DRY SPR. SYSTEM	SPRINKLER ROOM
SV-5	P-2 PARKING DRY SPR. SYSTEM	SPRINKLER ROOM
SV-6	FIRE PUMP BY-PASS	SPRINKLER ROOM
SV-7	FIRE PUMP SECTION	SPRINKLER ROOM
SV-8	FIRE PUMP SECTION	SPRINKLER ROOM
SV-9	FIRE PUMP TEST HEADER	SPRINKLER ROOM
SV-10	FIRE PUMP TEST HEADER	SPRINKLER ROOM
SV-11	FIRE STANDPIPE RISER-P1	P-1 PARKING GARAGE
SV-12	FIRE STANDPIPE RISER-P2	P-1 PARKING GARAGE
SV-13	FIRE STANDPIPE RISER-4 & P3	P-1 PARKING GARAGE
SV-14	FIRE STANDPIPE RISER-1	P-1 PARKING GARAGE
SV-15	FSP & SPR. COMBINATION RISER (FSP-2)	P-1 PARKING GARAGE
SV-16	FIRE STANDPIPE RISER-3	P-1 PARKING GARAGE
SV-20	SPR. RISER ISOLATION	GARAGE ROOM (170)
SV-21	SPR. SYSTEM ON GROUND LEVEL	GARAGE ROOM (170)
SV-22	SPR. SYSTEM IN GARAGE ROOM	GARAGE ROOM (170)
SV-23	SPR. RISER IN GARAGE CHUTE	GARAGE ROOM (170)
SV-24	SPR. SYSTEM IN TOWNHOUSE AT NORTHEAST CORNER	GARAGE ROOM (170)
SV-25	SPR. SYSTEM ON 2ND LEVEL	2ND LEVEL (STAR G)
SV-26	SPR. SYSTEM ON 3RD LEVEL	3RD LEVEL (STAR F)
SV-27	SPR. SYSTEM ON 4TH LEVEL	4TH LEVEL (STAR G)
SV-28	SPR. SYSTEM ON 5TH LEVEL	5TH LEVEL (STAR F)
SV-29	SPR. SYSTEM ON 6TH LEVEL	6TH LEVEL (STAR G)
SV-30	SPR. SYSTEM ON 7TH LEVEL	7TH LEVEL (STAR F)
SV-31	SPR. SYSTEM ON 8TH LEVEL	8TH LEVEL (STAR G)
SV-32	SPR. SYSTEM ON 9TH LEVEL	9TH LEVEL (STAR F)
SV-33	SPR. SYSTEM ON 10TH LEVEL	10TH LEVEL (STAR G)
SV-34	SPR. SYSTEM ON 11TH LEVEL	11TH LEVEL (STAR F)
SV-35	SPR. SYSTEM ON 12TH LEVEL	12TH LEVEL (STAR G)
SV-36	SPR. SYSTEM ON 13TH LEVEL	13TH LEVEL (STAR F)
SV-37	SPR. SYSTEM ON 14TH LEVEL	14TH LEVEL (STAR G)
SV-38	SPR. SYSTEM ON MECH. PENHOUSE	PENHOUSE
SV-39	SPR. SYSTEM IN MECH. P.H. ON 9TH FL.	MECH. RM ON 9TH FL.
SV-41	WIN. SPR.'S ON P1	STAFF ROOM ON P1
SV-42	WIN. SPR.'S ON P2	STAFF ROOM ON P1
SV-43	WIN. SPR.'S ON GR. FL.	CORRIDOR ON GR. FL.
SV-44	WIN. SPR.'S ON 2ND FL.	2ND FL (STAR J)
SV-45	WIN. SPR.'S ON 3RD FL.	3RD FL (STAR J)
SV-46	WIN. SPR.'S ON 4TH FL.	4TH FL (STAR J)

PUMP NO.	GPM	HEAD	HP	V./-/A	RPM	MAKE
FIRE PUMP	500 GPM	96 PSI	60 HP	575/3/60	3560 RPM	ARMSTRONG
JOCKEY PUMP	10 GPM	100 PSI	1 HP	575/3/60	3600 RPM	ARMSTRONG



NOTE: ELECTRICAL SPECIFICATIONS FOR FIRE PUMP TO BE CONFIRMED BY ELECTRICAL CONSULTANT.

ALL CHECK VALVES, BACKFLOW PREVENTERS, DOUBLE CHECK VALVE ASSEMBLIES AND ELBOWS AND TEES WITH CENTERLINE PLANE PARALLEL TO PUMP SHAFT SHALL BE INSTALLED AT A MINIMUM DISTANCE OF 10 TIMES THE SUCTION PIPE DIAMETER BETWEEN THE FLANGE OF THE PUMP SUCTION INTAKE AND THE FLANGE OF THE DEVICE, ELBOW OR TEE.

ELBOWS WITH A CENTERLINE PLANE PERPENDICULAR TO THE PUMP SHAFT SHALL BE PERMITTED AT ANY LOCATION IN THE PUMP SUCTION INTAKE.

WHERE THE SUCTION PIPE AND PUMP SUCTION FLANGE ARE NOT THE SAME SIZE, THEY SHALL BE CONNECTED WITH AN ECCENTRIC TAPERED REDUCER OR INCREASER INSTALLED IN SUCH A WAY TO AVOID AIR POCKETS.

* ALL SHUT OFF VALVES WITHIN 50 FT. OF THE PUMP SUCTION FLANGE TO BE O.S.&Y. TYPE.

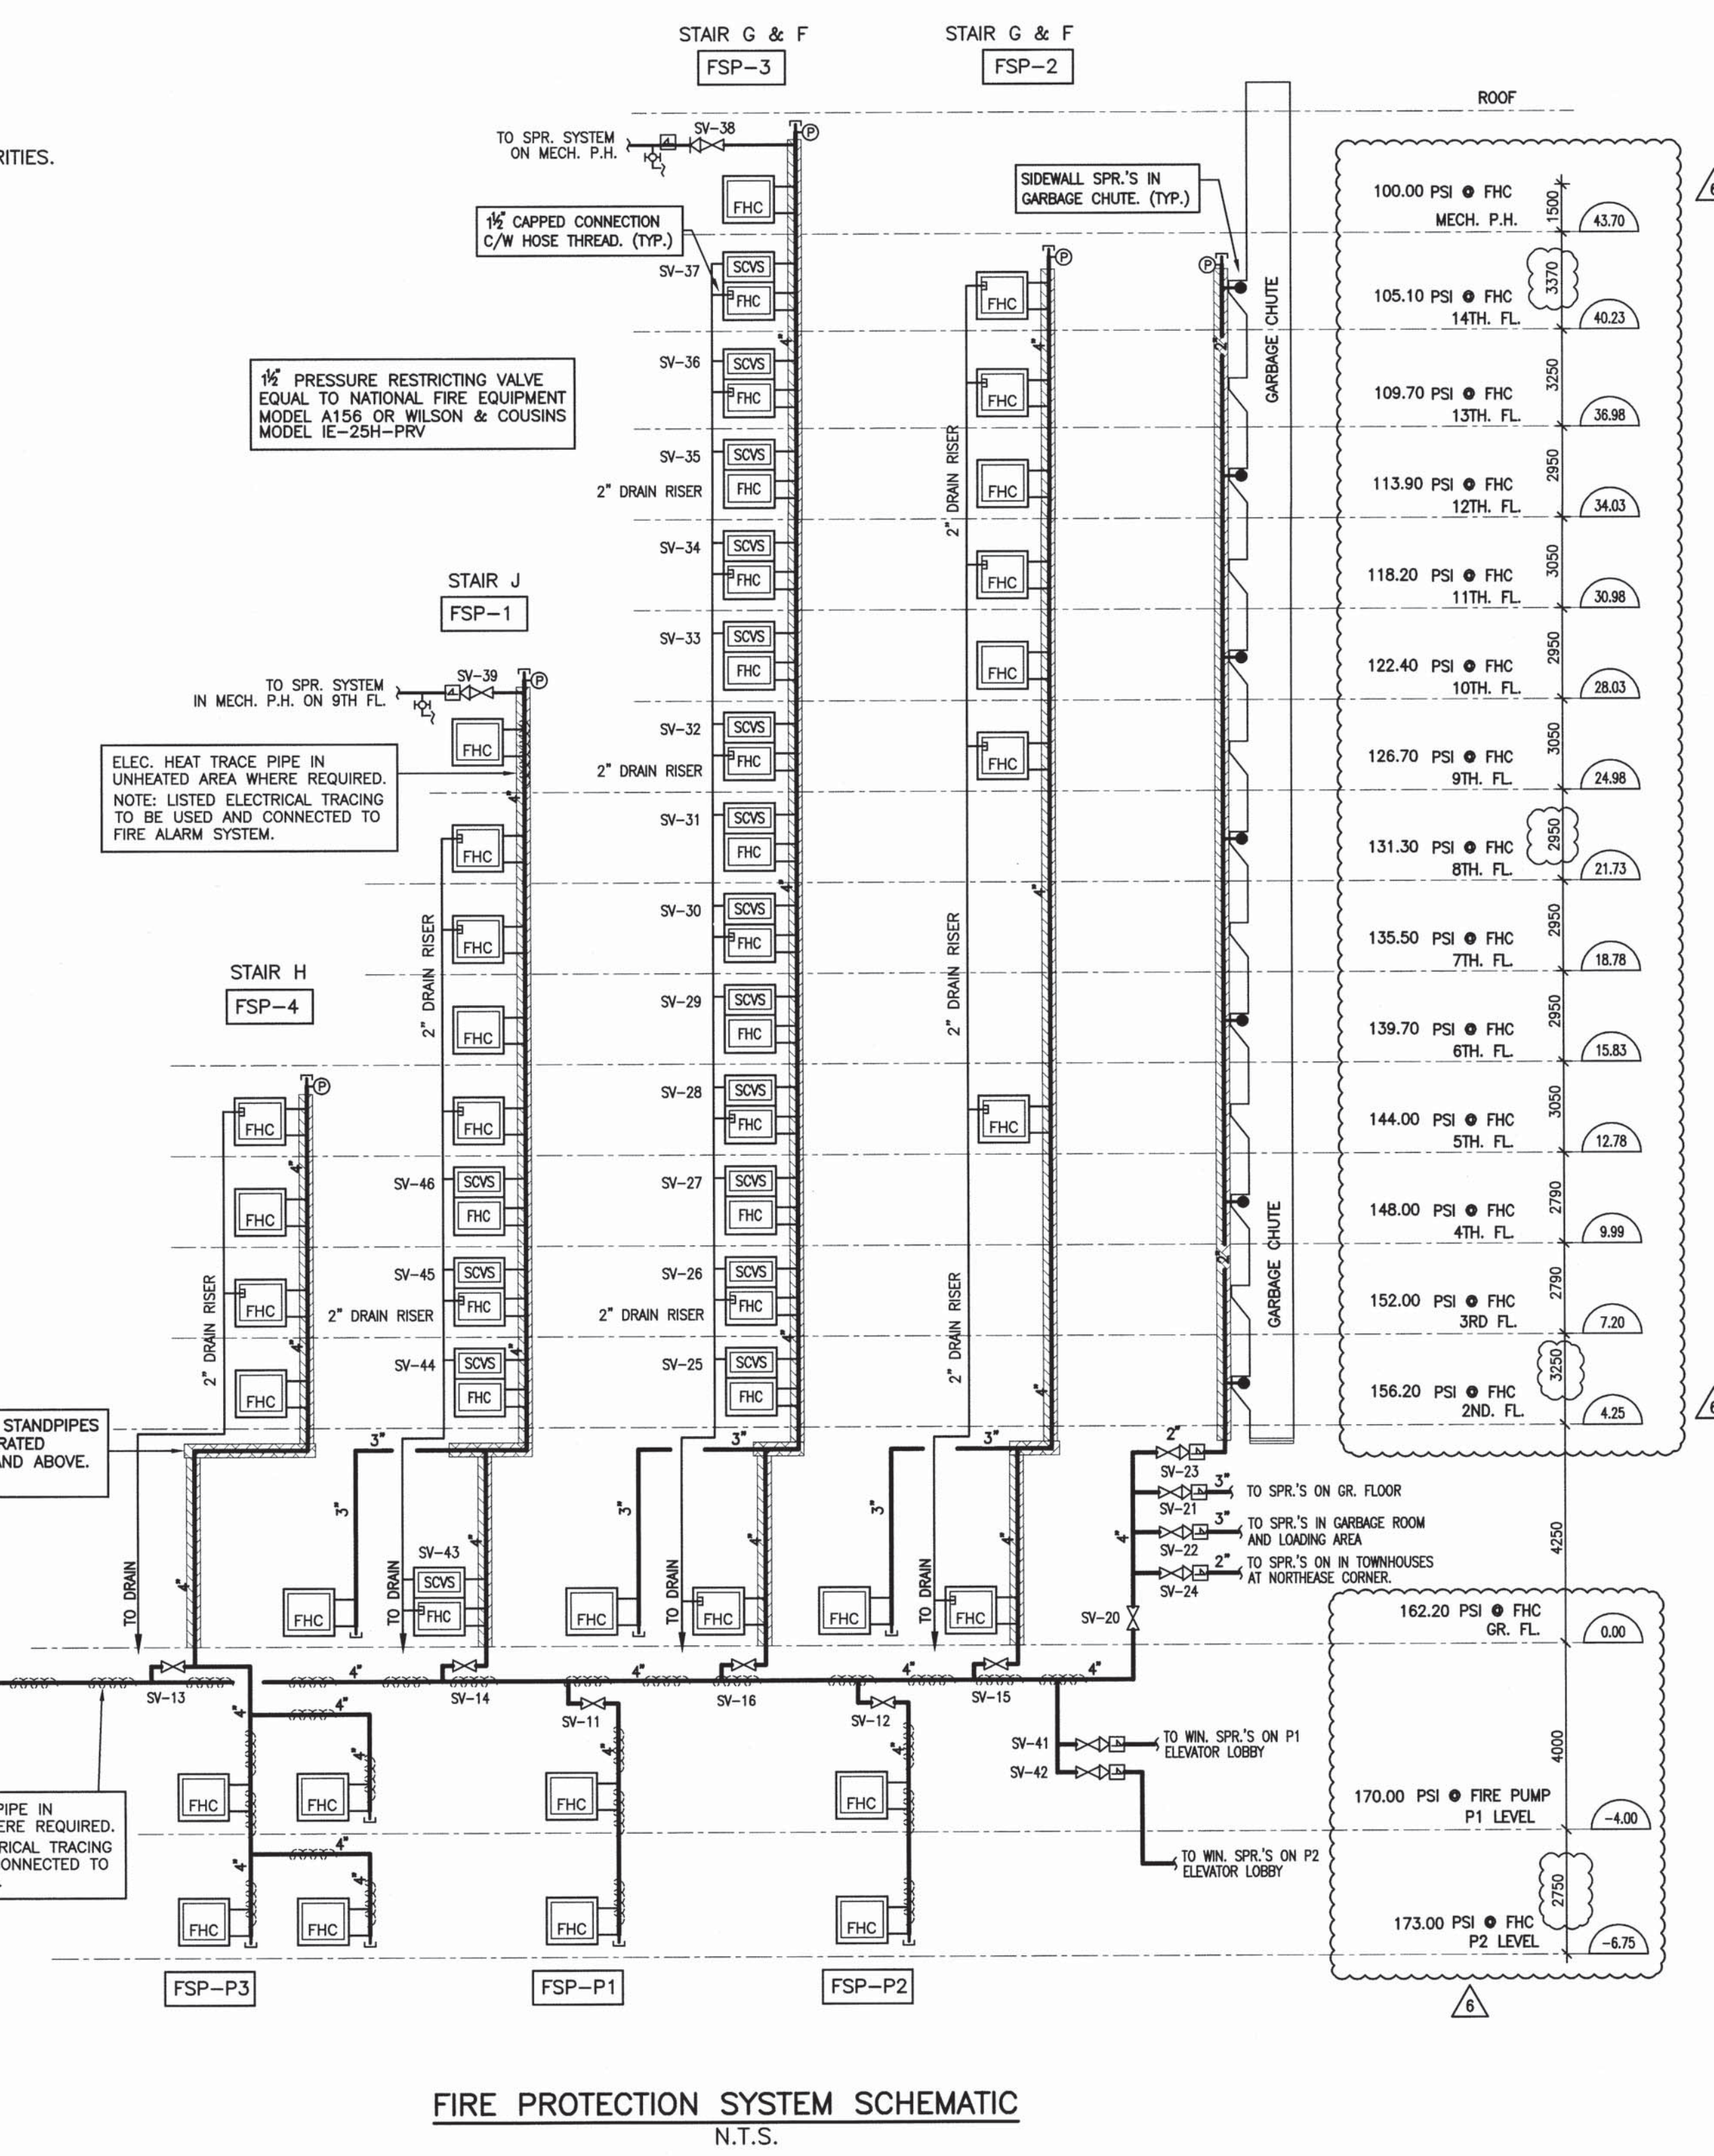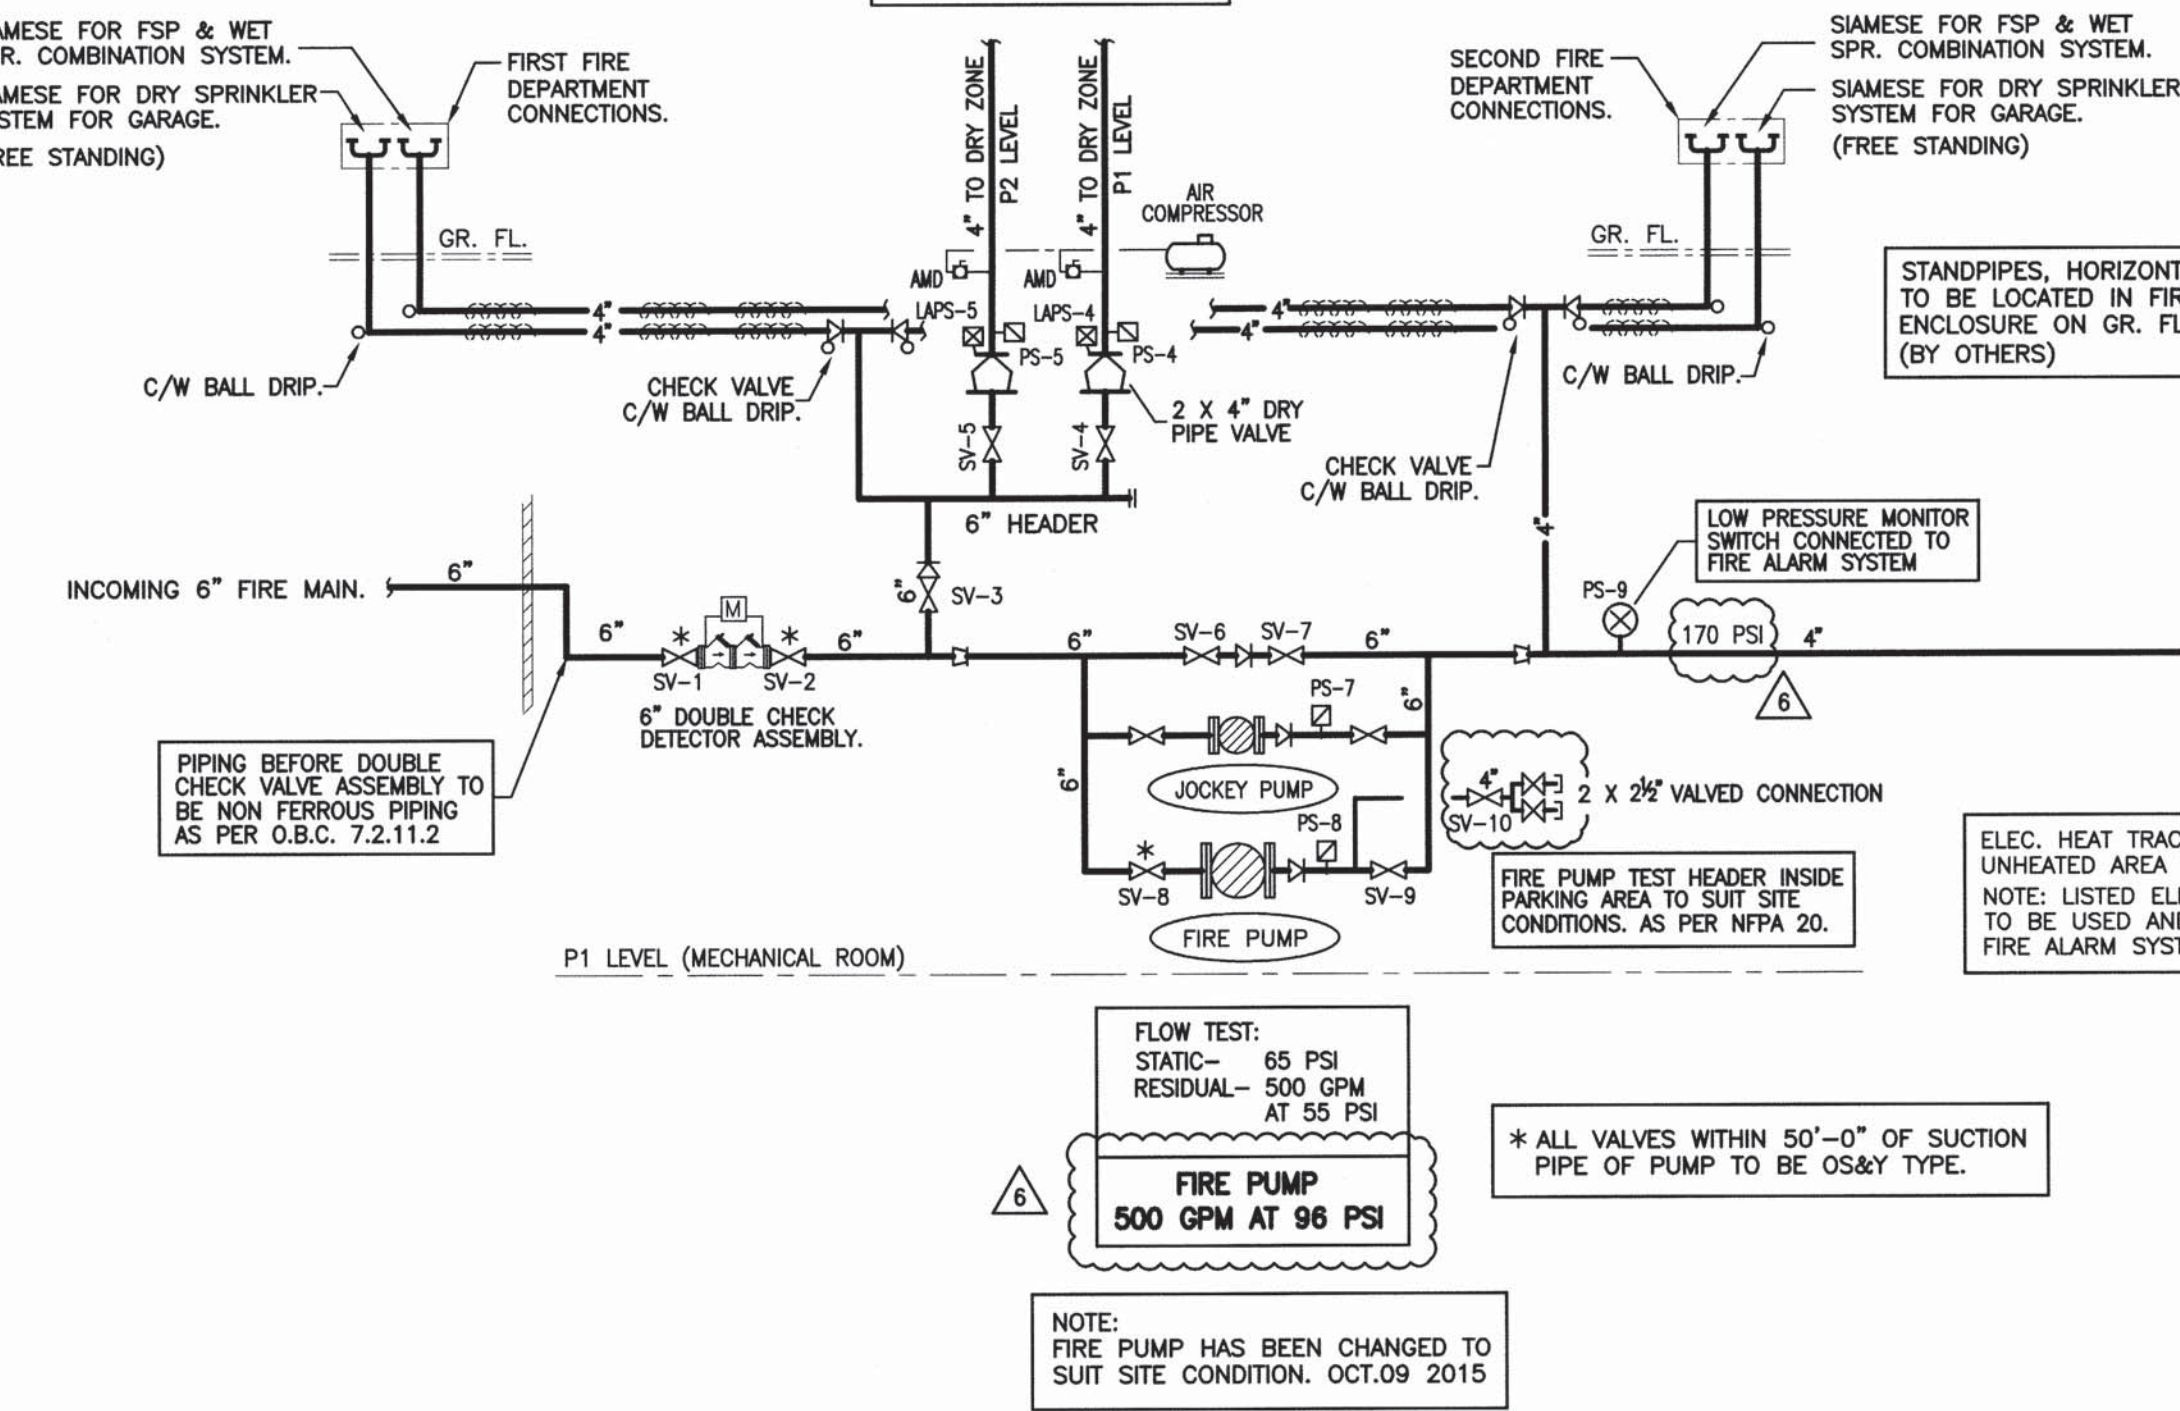

FIRE PROTECTION SYSTEM SCHEMATIC N.T.S.

NO.	DESCRIPTION	DATE
1.	ISSUED FOR REVIEW & PERMIT.	JULY 30 2014
2.	RE-ISSUED FOR PERMIT.	AUG. 15 2014
3.	REVISED LAYOUT AS PER TEPLA ARCHITECTS COMMENTS DATED IN JUN.08, 2015	JUN. 08 2015
6.	REVISED FIRE PUMP SIZE TO SUIT SITE CONDITION.	OCT. 06 2015

NOTES

--- THIS DRAWING ASSOCIATED CALCULATIONS AND SPECIFICATIONS ARE THE PROPERTY OF THE DESIGNER AND MUST BE RETURNED AT THE COMPLETION OF THE WORK OR UPON REQUEST.

--- THE SPRINKLER SYSTEM IS TO BE INSTALLED AS PER N.F.P.A. STANDARD # 13 AND O.B.C. STANDARDS.

--- CONTRACTOR TO INCLUDE FOR OFFSETS IN BRANCH LINES AND MAINS WHERE REQUIRED.

--- ALL MATERIALS TO BE U.L.C. LISTED AND APPROVED BY LOCAL AUTHORITIES.

--- UNDERGROUND WATERMAIN TO BE INSTALLED ACCORDING TO LOCAL AUTHORITIES AND INSURANCE CO. STANDARDS.

--- (IF APPLICABLE)

--- INSTALL HIGH TEMPERATURE HEADS WHERE REQUIRED AS PER N.F.P.A. STANDARD # 13.

--- ALL BRANCH LINE DIMENSIONS TO BE REPORTED TO THE DESIGNER PRIOR TO FABRICATION AND INSTALLATION.

--- ALL OTHER BRANCH LINE MEASUREMENTS ARE GIVEN AS CENTER LINE DIMENSIONS, (TYPE WALL PIPE)

--- DENOTES DISTANCE IN INCHES FROM CENTER LINE OF PIPE TO UNDERSIDE OF CEILING.

--- IN DENOTES RISER WIPPLE.

--- IN DENOTES DOWN.

--- PRESSURE MONITORING SWITCHES TO BE CONNECTED TO FIRE ALARM SYSTEM, (IF A.S. IS INSTALLED).

--- CONTRACTOR TO VISIT SITE TO DETERMINE EXACT LOCATION AND ELEVATION OF MAINS TO BE INSTALLED AS INDICATED ON DRAWINGS. ANY MAJOR DISCREPANCIES TO BE REPORTED TO THE DESIGNER PRIOR TO FABRICATION AND INSTALLATION.

OWNER (OR OTHERS) TO PROVIDE ADEQUATE HEAT IN ALL AREAS OF BUILDING SUBJECT TO FREEZING THAT ARE PROTECTED BY A WET TYPE SPRINKLER SYSTEM.

ALL GLASS BULB TYPE SPRINKLERS TO BE OF RECENT ISSUE. MANUFACTURE DATE OF AT LEAST YEAR 2013.

DESIGN CRITERIA

NORTH

STAMP

TRIDEL

4800 DUFFERIN STREET TORONTO ONTARIO

PROJECT

SQ ALEXANDRA PARK BLOCK 11

38 CAMERON ST. TORONTO

DWG TITLE

SPECIFICATIONS SCHEMATIC & DETAILS SPRINKLER & STANDPIPE SYSTEM

DATE

JULY 2014

SCALE

DWN BY

H.W.

ISSUED FOR REVISION NO.





PROJECT NO.

14-10224

DWG NO.


SP-1

OF 16

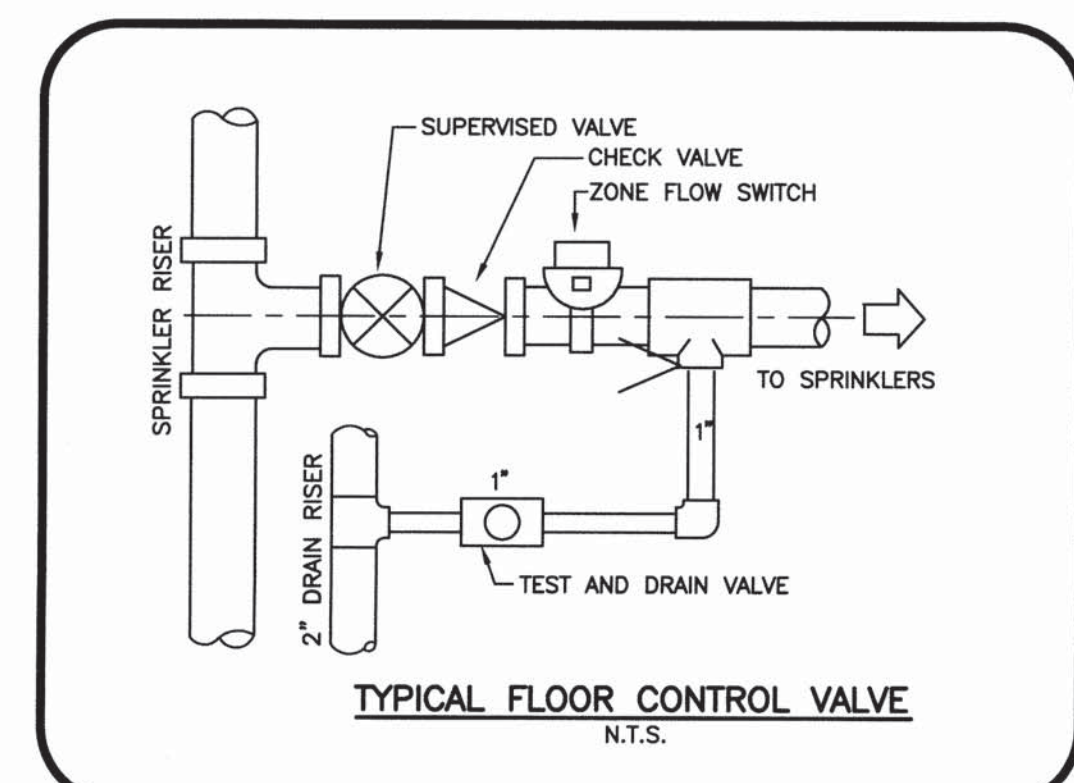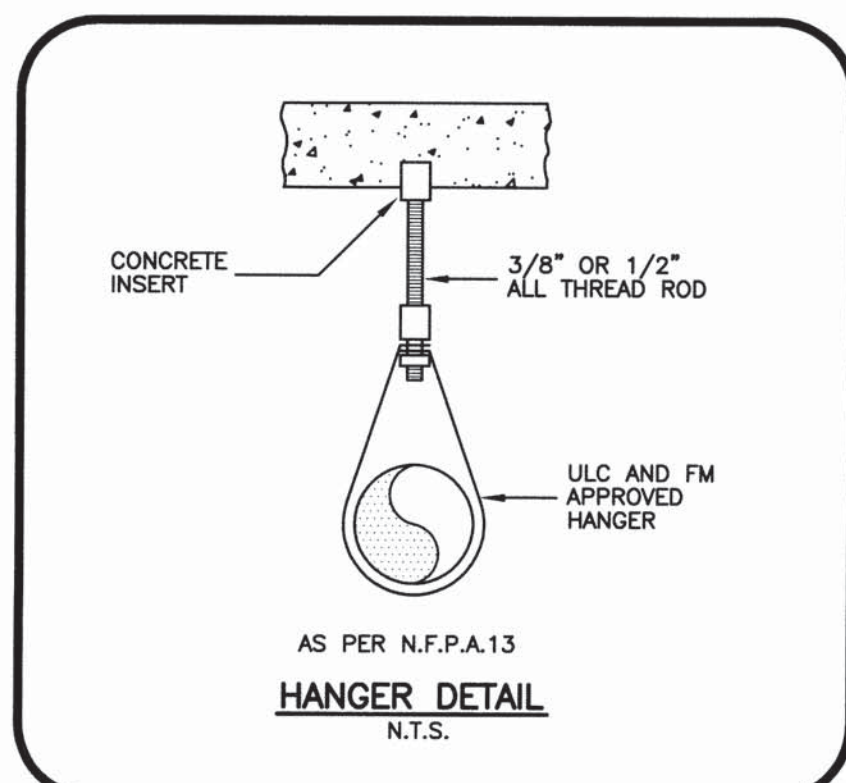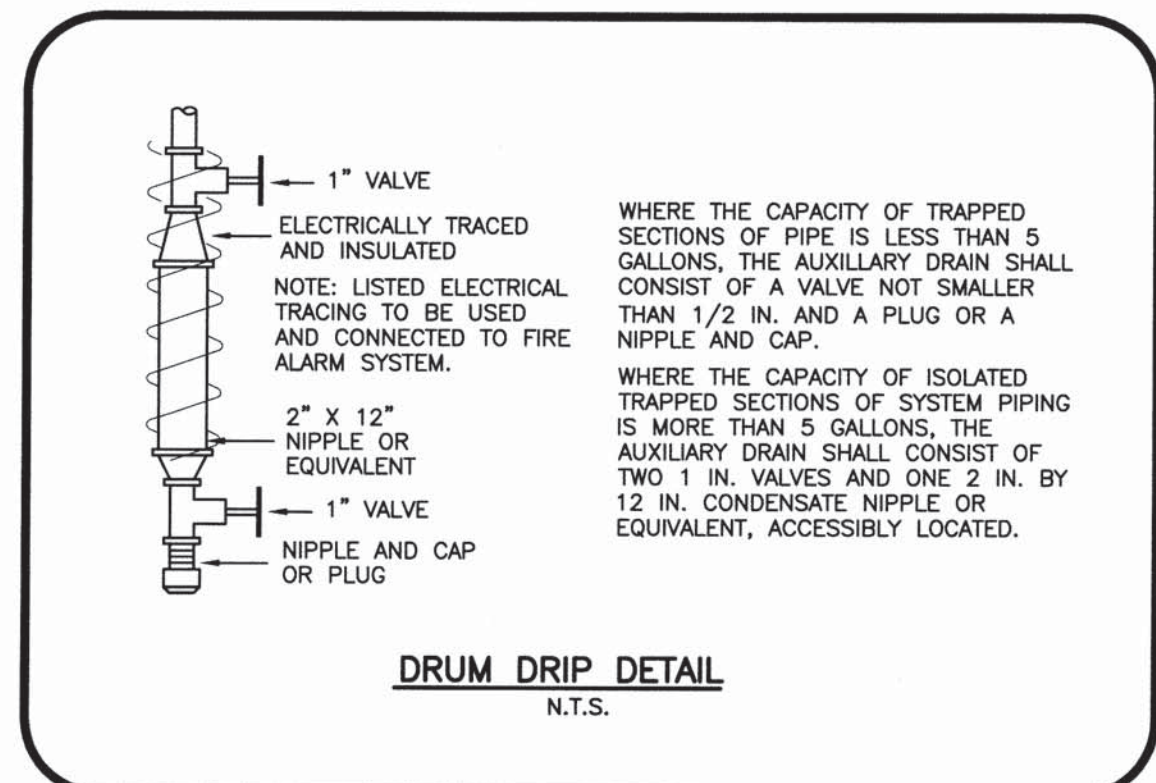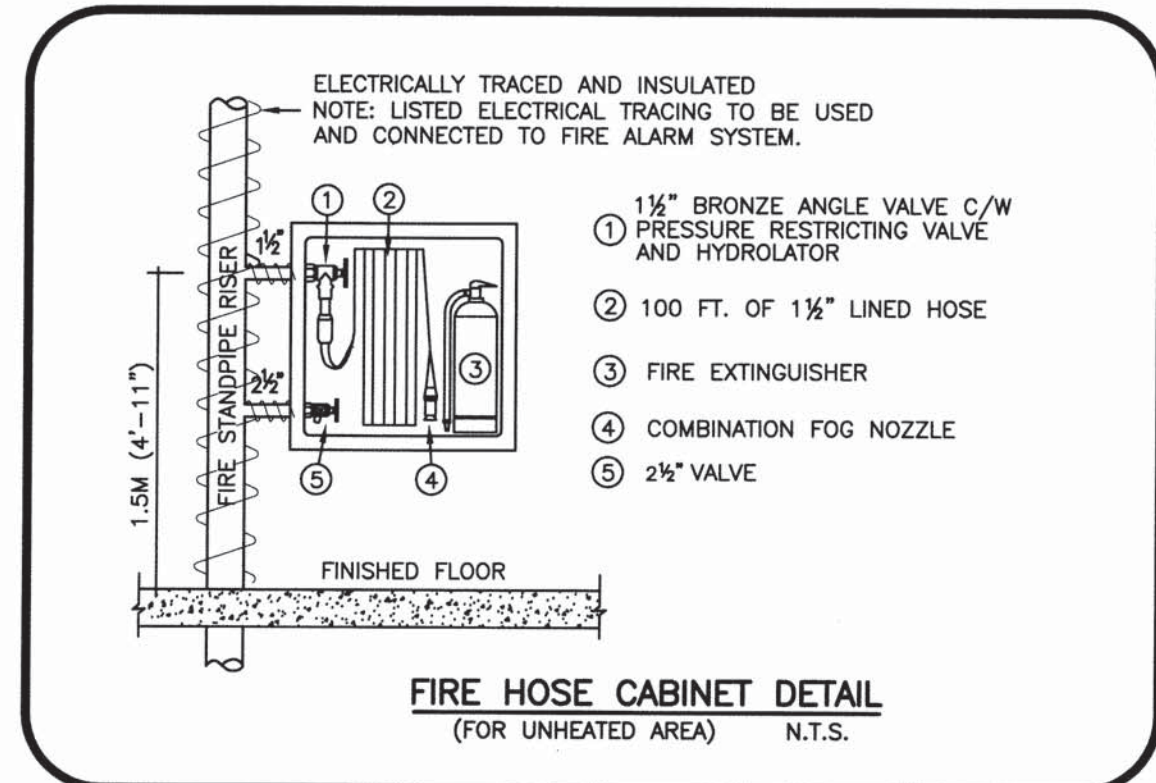

NOTE 1:
PROVIDE DRUM DRIPS ON DRY SYSTEM PIPING AT LOW POINTS AND AT ANY POINT WHERE PIPING IS TRAPPED. REFER TO DETAIL DRAWINGS.

NOTE 2:
FIRE STANDPIPE TO BE ELECTRICALLY TRACED AND INSULATED IN UNHEATED AREA.

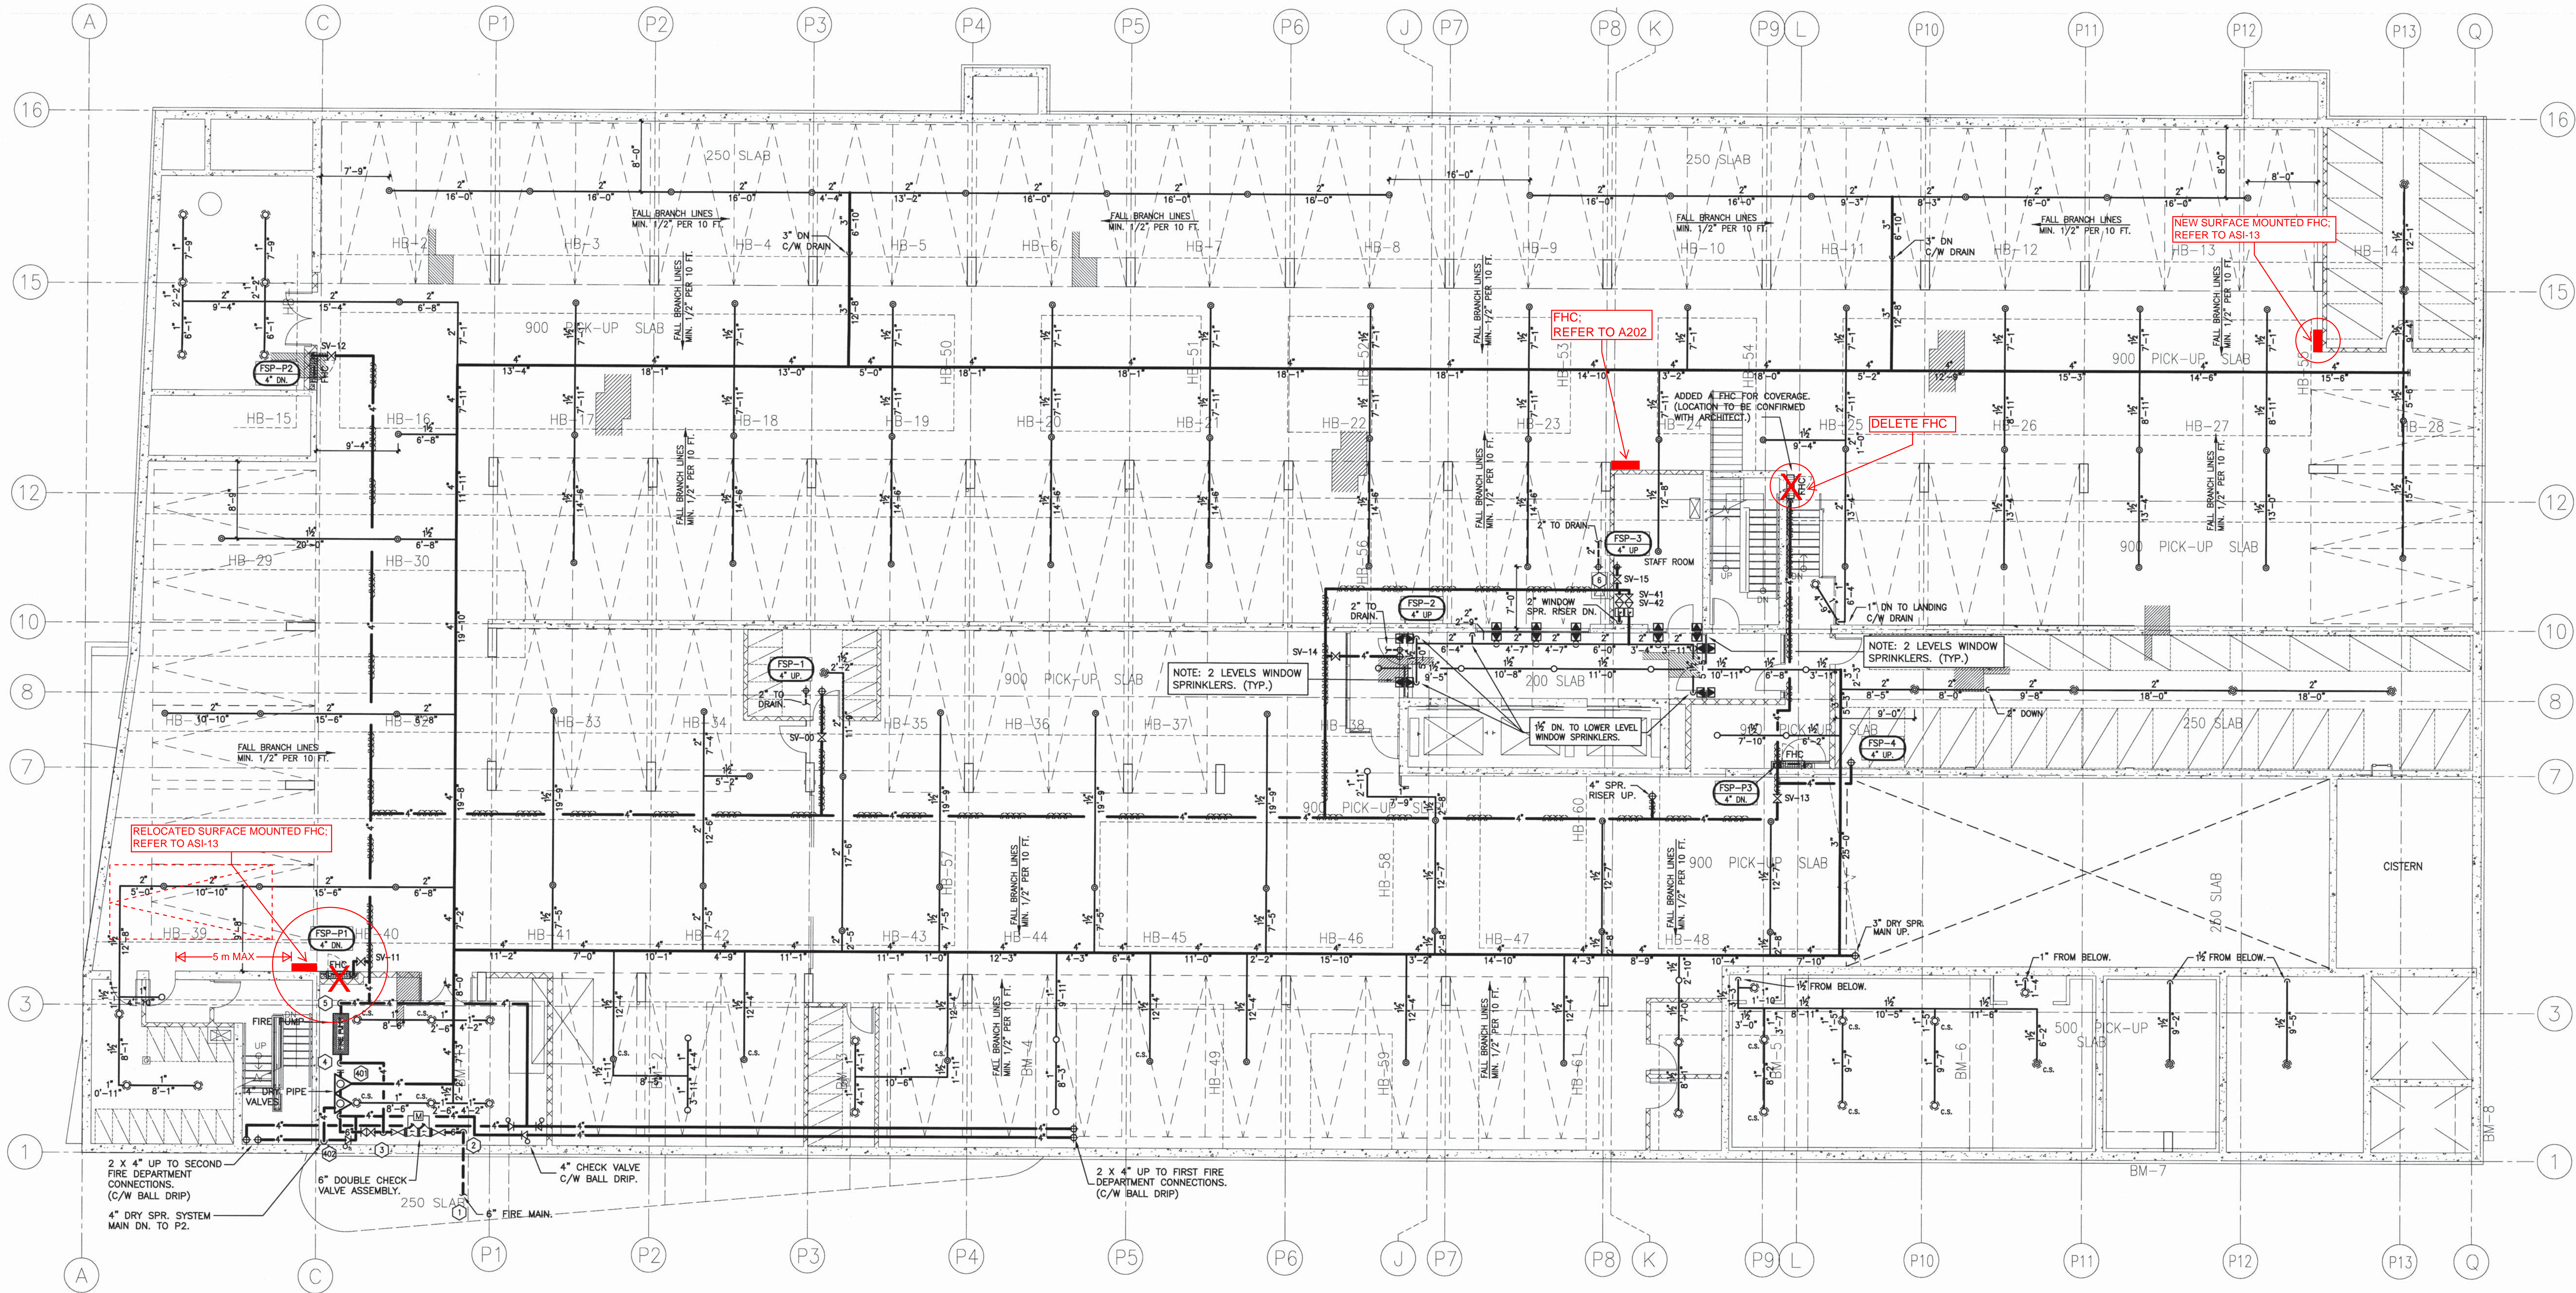

REVISIONS	DATE
2. RE-ISSUED FOR PERMIT.	AUG. 15 2014
3. REVISED LAYOUT AS PER TEEPLE ARCHITECTS COMMENTS DATED IN JUN.08, 2015	JUN. 08 2014
4. ISSUED FOR CONSTRUCTION	JUL. 03 2015

NOTES

--- THE DRAWING ASSOCIATED CALCULATIONS AND SPECIFICATIONS ARE THE PROPERTY OF THE DESIGNER AND MUST BE REVIEWED AT THE COMPLETION OF THE WORK OR UPON REQUEST.

--- THE SPRINKLER SYSTEM IS TO BE INSTALLED AS PER N.F.P.A. STANDARD # 13 AND O.B.C. STANDARDS.

--- CONTRACTOR TO INCLUDE FOR OFFSETS IN BRANCH LINES AND MAINS WHERE REQUIRED.

--- ALL MATERIALS TO BE U.L.C. LISTED AND APPROVED BY LOCAL AUTHORITIES.

--- UNDERGROUND WATERMAIN TO BE INSTALLED ACCORDING TO LOCAL AUTHORITIES AND INSURANCE CO. STANDARDS.

--- INSTALL HIGH TEMPERATURE HEADS WHERE REQUIRED AS PER N.F.P.A. STANDARD # 13.

--- ALL INTERIOR GRID BRANCH LINE MEASUREMENTS ARE GIVEN AS CENTER LINE TO CENTER LINE DIMENSIONS. (80X10 PIPE)

--- ALL OTHER BRANCH LINE MEASUREMENTS ARE GIVEN AS CENTER LINE TO CENTER LINE DIMENSIONS (80X40 PIPE)

--- ALL MAIN MEASUREMENTS ARE GIVEN AS CENTER LINE TO CENTER LINE DIMENSIONS. (TRIN WALL PIPE)

--- (D) DENOTES DISTANCE IN INCHES FROM CENTER LINE OF PIPE TO UNDERSIDE OF CEILING.

--- RN DENOTES RISER NIPPLE.

--- DN DENOTES DOWN.

--- ALL SUPERVISED VALVES/FLOW (PRESSURE) SWITCHES AND LOW PRESSURE MONITORING SWITCHES TO BE CONNECTED TO FIRE ALARM SYSTEM. (IF F.A.S. IS INSTALLED)


--- CONTRACTOR TO VISIT SITE TO DETERMINE EXACT LOCATION AND ELEVATION OF MAINS TO BE INSTALLED AS INDICATED ON DRAWING. MAINS DISCREPANCIES TO BE REPORTED TO THE DESIGNER PRIOR TO FABRICATION AND INSTALLATION.

OWNER (OR OTHERS) TO PROVIDE ADEQUATE HEAT IN ALL AREAS OF BUILDING SUBJECT TO FREEZING THAT ARE PROTECTED BY A WET TYPE SPRINKLER SYSTEM.

ALL GLASS BULB TYPE SPRINKLERS TO BE OF RECENT ISSUE. MANUFACTURE DATE OF AT LEAST YEAR 2013.

S/R=STANDARD RESPONSE Q/R=QUICK RESPONSE C/W GUARD C.S. CANDLE STICK	
⊙	3/4" 155F EXTENDED COVERAGE UPRIGHT (K=14) S/R 99
○	1/2" 155F STANDARD COVERAGE UPRIGHT (K=5.6) S/R 43
◀	3/4" 175F SW-20 EXTENDED COVERAGE SIDEWALL (K=11.2) S/R --
◻	WINDOW SPRINKLER (K=5.6) 18
▣	FIRE HOSE CABINET - 100 FT OF 1/2" LINED HOSE C/W COMBINATION FOG NOZZLE 4

DESIGN CRITERIA
PARKING GARAGE, LOCKERS ROOM, STORAGE:
SPRINKLER DRY SYSTEM DESIGNED FOR ORDINARY HAZARD GROUP 1.
0.15 GPM PER SQ.FT. OVER 1950 SQ.FT. PLUS 250 GPM FOR HOSES.
AS PER NFPA 13.

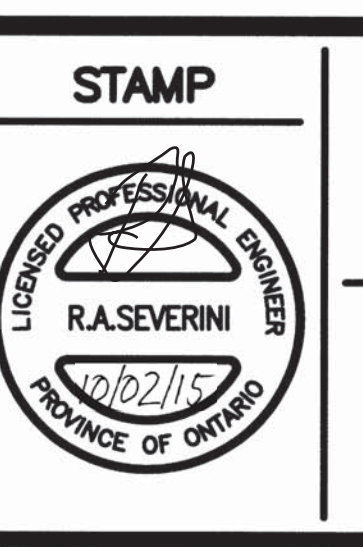


STAMP

REGISTERED PROFESSIONAL ENGINEER
R. SEVERINI
PROVINCE OF ONTARIO

TRIDEL
4800 DUFFERIN STREET
TORONTO ONTARIO

PROJECT	DATE	PROJECT NO.
SQ ALEXANDRA PARK BLOCK 11 38 CAMERON ST. TORONTO	JULY 2014	14-10224
DWG TITLE	SCALE	DWG NO.
PARKING LEVEL 1 SPRINKLER & STANDPIPE SYSTEM	1:100	SP-3
DWN BY	ISSUED FOR REVISION NO.	OF 16
H.W.		

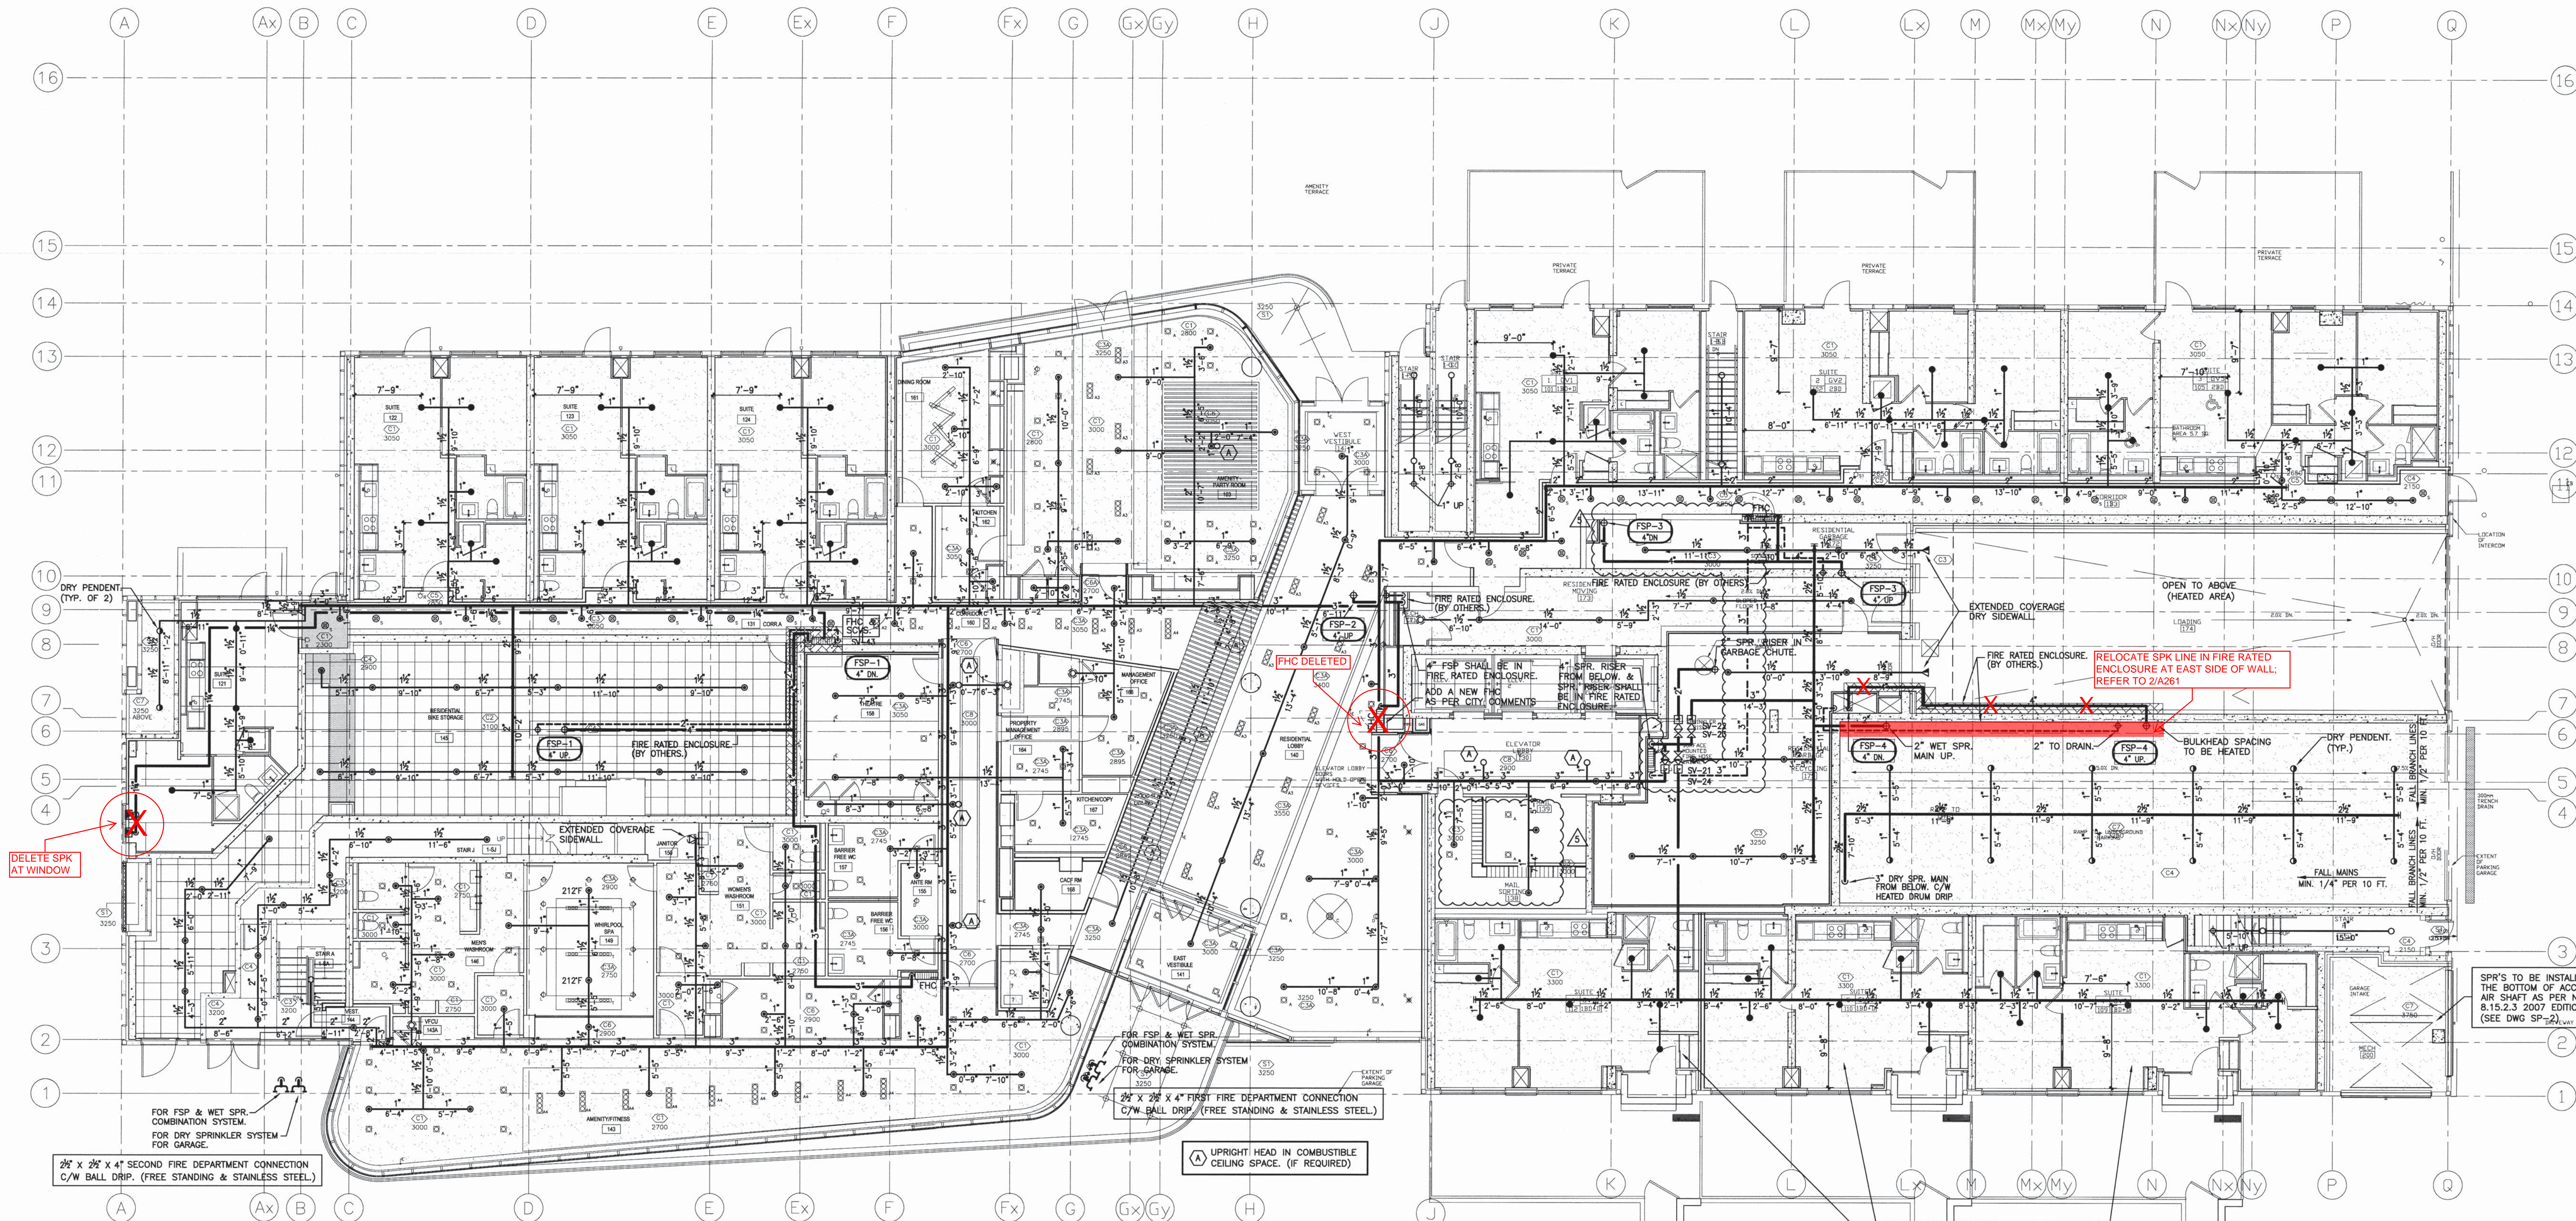

FOR FSP & WET SPR. COMBINATION SYSTEM. FOR DRY SPRINKLER SYSTEM FOR GARAGE.

2 1/2" x 2 1/2" x 4" SECOND FIRE DEPARTMENT CONNECTION C/W BALL DRIP. (FREE STANDING & STAINLESS STEEL)

FOR FSP & WET SPR. COMBINATION SYSTEM. FOR DRY SPRINKLER SYSTEM FOR GARAGE.

2 1/2" x 2 1/2" x 4" FIRST FIRE DEPARTMENT CONNECTION C/W BALL DRIP. (FREE STANDING & STAINLESS STEEL)

UPRIGHT HEAD IN COMBUSTIBLE CEILING SPACE. (IF REQUIRED)

EXISTING FIRE HYDRANT TO REMAIN.

NO.	REVISIONS	DATE
2.	RE-ISSUED FOR PERMIT.	AUG. 15 2014
3.	REVISED LAYOUT AS PER TEEPLE ARCHITECTS COMMENTS DATED IN APR. 23, 2015	APR. 23 2015
4.	REVISED LAYOUT AS PER TEEPLE ARCHITECTS COMMENTS DATED IN JUN. 08, 2015	JUN. 08 2015
5.	ADDED NEW FHC & REVISED SPRINKLER LAYOUT AS PER NEW ARCH. ADD4 DATED: 2015-07-08.	JUL. 20 2015
6.	ISSUED FOR CONSTRUCTION.	OCT. 2 2015

NOTES

--- THIS DRAWING ASSOCIATED CALCULATIONS AND SPECIFICATIONS ARE THE PROPERTY OF THE DESIGNER AND MUST BE RETURNED AT THE COMPLETION OF THE WORK OR UPON REQUEST.

--- DIMENSIONS TAKE PRECEDENCE OVER SCALE.

--- THE SPRINKLER SYSTEM IS TO BE INSTALLED AS PER N.F.P.A. STANDARD # 13 AND O.B.C. STANDARDS.

--- CONTRACTOR TO INCLUDE FOR OFFSETS IN BRANCH LINES AND MAINS WHERE REQUIRED.

--- ALL MATERIALS TO BE U.L.C. LISTED AND APPROVED BY LOCAL AUTHORITIES.

--- UNDERGROUND WATERMAIN TO BE INSTALLED ACCORDING TO LOCAL AUTHORITIES AND INSURANCE CO. STANDARDS. (IF APPLICABLE)

--- INSTALL HIGH TEMPERATURE HEADS WHERE REQUIRED AS PER N.F.P.A. STANDARD # 13.

--- ALL INTERIOR GRID BRANCH LINE MEASUREMENTS ARE GIVEN AS CENTER LINE TO CENTER LINE DIMENSIONS.

--- ALL OTHER BRANCH LINE MEASUREMENTS ARE GIVEN AS CENTER LINE TO CENTER LINE DIMENSIONS (O.C.K. TO PIPE).

--- CENTER LINE TO CENTER LINE DIMENSIONS (O.C.K. TO PIPE)

--- ALL MAIN MEASUREMENTS ARE GIVEN AS CENTER LINE TO CENTER LINE DIMENSIONS. (THIN WALL PIPE)

--- DENOTES DISTANCE IN INCHES FROM CENTER LINE OF PIPE TO UNDERSIDE OF CEILING.

--- RN DENOTES RISER NIPPLE.

--- ON DENOTES DOWN.

--- ALL SUPERVED VALVES/FLOW (PRESSURE) SWITCHES AND LOW PRESSURE MONITORING SWITCHES TO BE CONNECTED TO FIRE ALARM SYSTEM (IF A.S. IS INSTALLED)

--- CONTRACTOR TO VISIT SITE TO DETERMINE EXACT LOCATION AND ELEVATION OF MAINS (TO BE INSTALLED) AS INDICATED ON DRAWINGS. ANY MAJOR DISCREPANCIES TO BE REPORTED TO THE DESIGNER PRIOR TO FABRICATION AND INSTALLATION.


OWNER (OR OTHERS) TO PROVIDE ADEQUATE HEAT IN ALL AREAS OF BUILDING SUBJECT TO FREEZING THAT ARE PROTECTED BY A WET TYPE SPRINKLER SYSTEM.

ALL GLASS BULB TYPE SPRINKLERS TO BE OF RECENT ISSUE. MANUFACTURE DATE OF AT LEAST YEAR 2013.

S/R=STANDARD RESPONSE Q/R=QUICK RESPONSE C/W GUARD		
2 1/2" (C)	1/2" 212F STANDARD COVERAGE CONCEALED PENDENT (K=5.6) Q/R	00
(C)	1/2" 155F STANDARD COVERAGE CONCEALED PENDENT (K=5.6) Q/R	00
(C)	1/2" 155F STANDARD COVERAGE UPRIGHT (K=5.6) Q/R	00
(C)	1/2" 155F RESIDENTIAL CONCEALED PENDENT (K=4.9)	00
(C)	STANDARD COVERAGE DRY SIDEWALL (K=5.6) Q/R	00
(C)	STANDARD COVERAGE DRY PENDENT (K=5.6) Q/R	00
(C)	WINDOW SPRINKLER (K=5.6)	00
(C)	FIRE HOSE RACK - 100 FT OF 1 1/2" LINED HOSE C/W COMBINATION FOG NOZZLE	00

DESIGN CRITERIA

PARKING GARAGE, LOCKERS ROOM, STORAGE: SPRINKLER DRY SYSTEM DESIGNED FOR ORDINARY HAZARD GROUP 1, 0.15 GPM PER SQ.FT. OVER 1950 SQ.FT. PLUS 250 GPM FOR HOSES. AS PER NFPA 13.

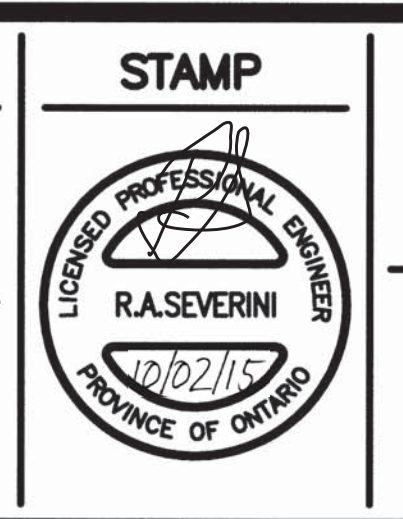

TRIDEL
4800 DUFFERIN STREET
TORONTO ONTARIO

PROJECT	DATE	PROJECT NO.
SQ ALEXANDRA PARK BLOCK 11 38 CAMERON ST. TORONTO	JULY 2014	14-10224
DWG TITLE	SCALE	DWG NO.
GROUND FLOOR SPRINKLER & STANDPIPE SYSTEM	1:100	SP-4
ISSUED FOR REVISION NO.	DWN BY	OF 16
	H.W.	

IF SPRINKLER CONTRACTOR USES PLASTIC PIPING THEN THE FOLLOWING IS APPLICABLE.
NOTE: CONTRACTOR TO INSTALL PLASTIC PIPING AS PER MANUFACTURE'S SPECIFICATIONS INCLUDING EXPANSION LOOP.

O.B.C. SECTION 3.2.5.14 COMBUSTIBLE SPRINKLER PIPING

- (1) COMBUSTIBLE SPRINKLER PIPING SHALL BE USED ONLY FOR WET SYSTEMS IN RESIDENTIAL OCCUPANCIES AND OTHER LIGHT HAZARD OCCUPANCIES. (SEE APPENDIX A.)
- (2) COMBUSTIBLE SPRINKLER PIPING SHALL MEET THE REQUIREMENTS OF ULC/ORD-199P-M, "COMBUSTIBLE PIPING FOR SPRINKLER SYSTEMS".
- (3) COMBUSTIBLE SPRINKLER PIPING SHALL BE SEPARATED FROM THE AREA SERVED BY THE SPRINKLER SYSTEM AND FROM ANY OTHER FIRE COMPARTMENT BY CEILINGS, WALLS, OR SOFFITS CONSISTING AS A MINIMUM,
 - (A) LATH AND PLASTER,
 - (B) GYPSUM BOARD NOT LESS THAN 9.5 MM (3/8 IN) THICK
 - (C) PLYWOOD NOT LESS THAN 13 MM (1/2 IN) THICK OR
 - (D) A SUSPENDED MEMBRANE CEILING WITH
 - (i) STEEL SUSPENSION GRID, AND
 - (ii) LATH-IN PANELS OR TILES HAVING A MASS NOT LESS THAN 1.7 KG/SQUARE METRE (0.35 LB/SQUARE FOOT)
- (4) IF COMBUSTIBLE SPRINKLER PIPING IS LOCATED ABOVE A CEILING, AN OPENING THROUGH THE CEILING THAT IS NOT PROTECTED IN CONFORMANCE WITH SENTENCE (3) SHALL BE LOCATED SO THAT THE DISTANCE BETWEEN THE EDGE OF THE OPENING AND THE NEAREST SPRINKLER IS NOT MORE THAN 300 MM (11 3/4").
- (5) THE PROTECTION REQUIRED BY SENTENCES (3) AND (4) IS PERMITTED TO BE WAIVED WHERE COMBUSTIBLE SPRINKLER PIPING HAS BEEN TESTED IN CONFORMANCE WITH ULC/ORD-C199P-M, "COMBUSTIBLE PIPING FOR SPRINKLER SYSTEMS", AND HAS BEEN SHOWN TO MEET THE REQUIREMENTS IN THAT DOCUMENT WITHOUT ADDITIONAL PROTECTION.

GENERAL NOTES

- NOTE 1:
IN BUILDINGS SPRINKLERED IN ACCORDANCE WITH NFPA 13, CLOSETS LESS THAN 12 SQ.FT. IN AREA IN INDIVIDUAL DWELLING UNITS SHALL NOT BE REQUIRED TO BE SPRINKLERED. CLOSETS THAT CONTAIN EQUIPMENT SUCH AS WASHERS, DRYERS, FURNACES, OR WATER HEATERS SHALL BE SPRINKLERED REGARDLESS OF SIZE.
AS PER NFPA-13 (2007) CLAUSE 21.20.19.2.1
- NOTE 2:
SPRINKLERS SHALL NOT BE REQUIRED IN BATHROOMS THAT ARE LOCATED WITHIN DWELLING UNITS, THAT DO NOT EXCEED 55 SQ.FT. IN AREA, AND THAT HAVE WALLS AND CEILING OF NONCOMBUSTIBLE OR LIMITED-COMBUSTIBLE MATERIALS WITH A 15-MINUTE THERMAL BARRIER RATING, INCLUDING THE WALLS AND CEILING BEHIND ANY SHOWER ENCLOSURE OR TUB.
AS PER NFPA-13 (2007) CLAUSE 8.15.8.1.1
- NOTE 3:
WHERE SIDEWALL SPRINKLER IS INSTALLED AT SOFFIT (BULKHEAD) EXCEEDING MORE THAN 8" IN WIDTH, PENDENT SPRINKLERS SHALL BE INSTALLED UNDER THE SOFFIT (BULKHEAD).
- NOTE 4:
RESIDENTIAL SIDEWALL SPRINKLERS SHALL BE PERMITTED TO BE INSTALLED IN THE FACE OF A SOFFIT LOCATED DIRECTLY OVER CABINETS WITHOUT REQUIRING ADDITIONAL SPRINKLERS BELOW THE SOFFIT OR CABINETS WHERE THE SOFFIT DOES NOT PROJECT HORIZONTALLY MORE THAN 12" FROM THE WALL.
- NOTE 5:
IF CPVC PIPE IS USED, CONTRACTOR TO PROVIDE "EXPANSION OFFSET LOOP" ON STRAIGHT RUNS EXCEEDING 100 FT IN LENGTH.
- NOTE 6:
ANY FIRE STOPPING, ACOUSTIC SEALANT AND MATERIALS USED IN THIS PROJECT WHICH COME IN CONTACT WITH CPVC SPRINKLER PIPING IS TO BE COMPATIBLE WITH CPVC PIPING.
- NOTE 7:
SPRINKLERS TO BE A MINIMUM 3'-0" FROM EDGE OF ALL SURFACE MOUNTED LIGHT FIXTURE.

SPRINKLER LAYOUT BASED ON BULKHEADS BEING MAXIMUM 12" DEEP. ADDITIONAL SIDEWALL SPRINKLERS MAY BE REQUIRED IF BULKHEAD DEPTH EXCEEDS 12".


PROTECTION AREA PER RESIDENTIAL CONCEALED PENDENT SPRINKLER SHALL NOT EXCEED 300 SQ.FT. MAX. SPACING IS 20 FT. PROTECTION AREA PER RESIDENTIAL CONCEALED SIDEWALL SPRINKLER SHALL NOT EXCEED 256 SQ.FT. (16 FT. X 16 FT.)

CONTRACTOR SHALL COORDINATE WITH LIGHTING, DIFFUSER & INTERIOR DESIGN DRAWINGS PRIOR TO INSTALLATION OF SPRINKLER SYSTEM.


THE HEIGHT OF THE BULKHEAD NOT TO EXCEED 12" AS PER ARCHITECTURAL DRAWING.

SPRINKLER CONTROL VALVE STATION

- 1 STANDARD SHUT OFF VALVE
 - 2 2" CHECK VALVE
 - 3 FLOW SWITCH
 - 4 4" DRAIN GLOBE VALVE
 - 5 1" INSPECTOR TEST VALVE SIGHT GLASS
 - 6 UNION WITH CORROSION RESISTANT ORIFICE GIVING FLOW EQUIVALENT TO SMALLEST SPRINKLER ORIFICE IN SYSTEM.
 - 7 1/2" RELIEF VALVE (SET AT 175 PSI)
- WHERE AUXILIARY AIR RESERVOIRS ARE INSTALLED TO ABSORB PRESSURE INCREASES, A RELIEF VALVE SHALL BE NOT REQUIRED.
- FLOW SWITCH & SHUT OFF VALVE OR PRV TO BE SUPERVISED AND CONNECTED TO FIRE ALARM SYSTEM.

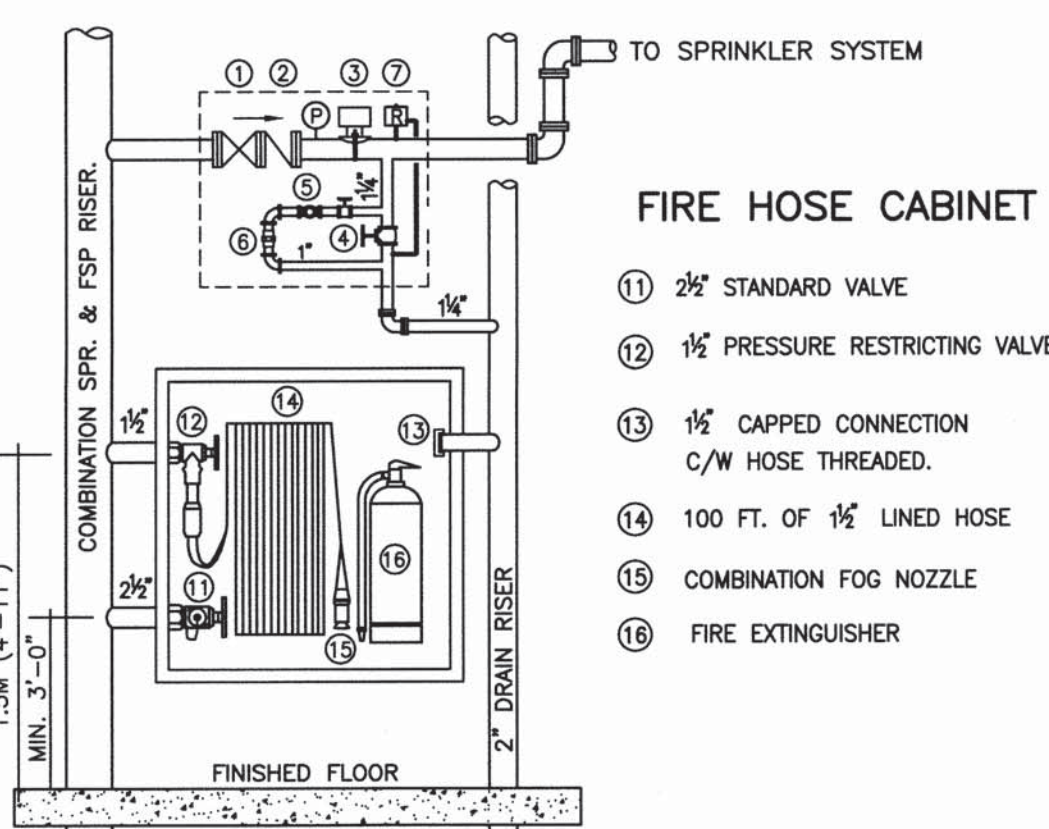

FIRE HOSE CABINET AND SPRINKLER CONTROL VALVE STATION DETAIL
N.T.S.

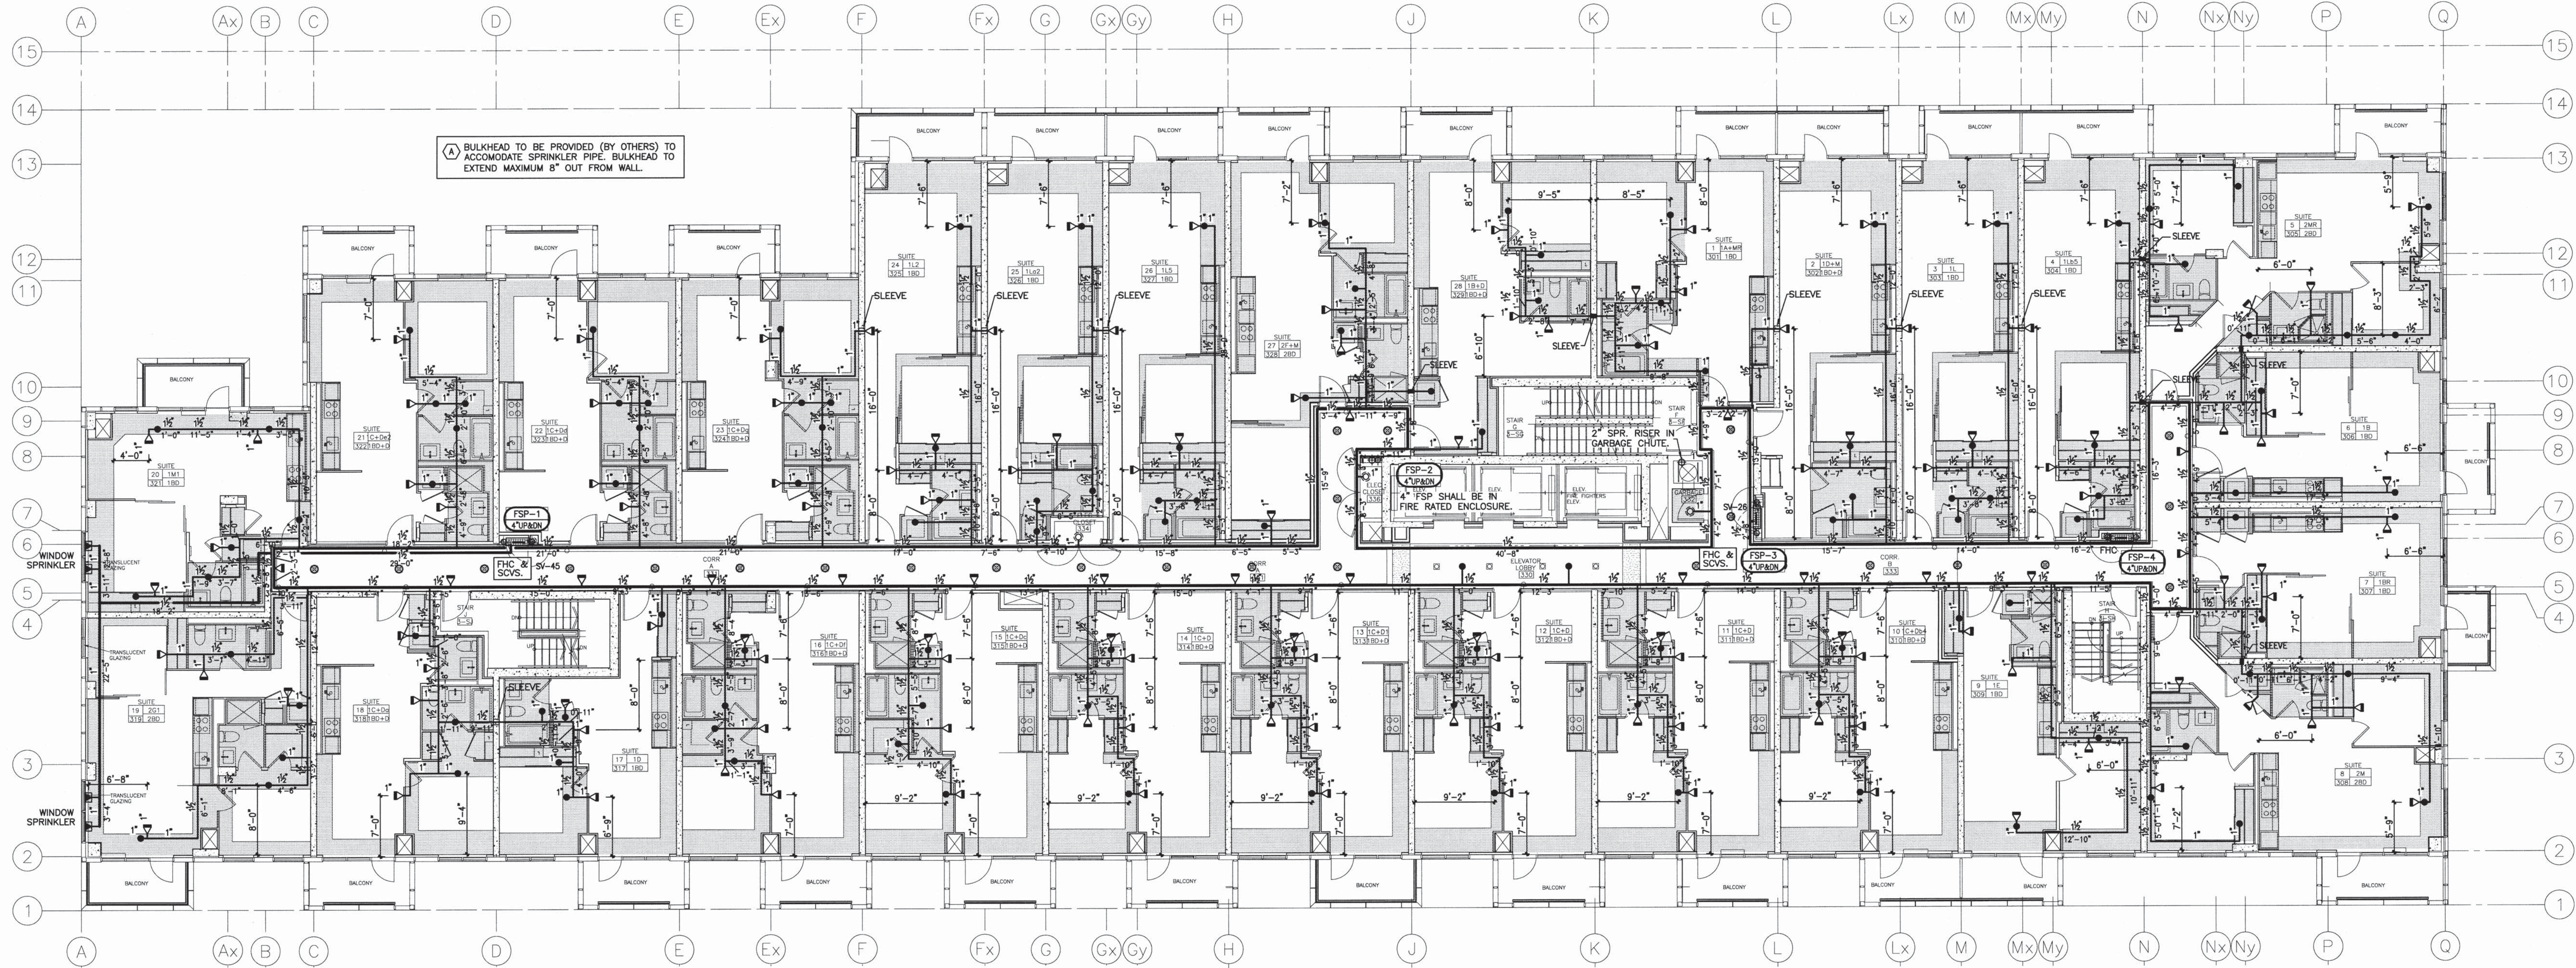

▲ BULKHEAD TO BE PROVIDED (BY OTHERS) TO ACCOMMODATE SPRINKLER PIPE. BULKHEAD TO EXTEND MAXIMUM 8" OUT FROM WALL.

NO.	REVISIONS	DATE
2.	RE-ISSUED FOR PERMIT.	AUG. 15 2014
4.	REVISED SPRINKLER LAYOUT SUIT TO NEW BULKHEAD REVISIONS AS PER ARCH.	SEP. 08 2015
5.	ISSUED FOR CONSTRUCTION.	OCT. 20 2015

NOTES

--- THIS DRAWING ASSOCIATED CALCULATIONS AND SPECIFICATIONS ARE THE PROPERTY OF THE DESIGNER AND MUST BE RETURNED AT THE COMPLETION OF THE WORK OR UPON REQUEST.

--- DIMENSIONS TAKE PRECEDENCE OVER SCALES.

--- THE SPRINKLER SYSTEM IS TO BE INSTALLED AS PER N.F.P.A. STANDARD 13 AND O.B.C. STANDARDS.

--- CONTRACTOR TO VERIFY FOR SYSTEMS IN BRANCH LINES AND MAINS WHERE REQUIRED.

--- ALL MATERIALS TO BE U.L.C. LISTED AND APPROVED BY LOCAL AUTHORITIES.

--- UNDERGROUND WATERMANN TO BE INSTALLED ACCORDING TO LOCAL AUTHORITIES AND INSURANCE CO. STANDARDS.

--- IF APPLICABLE (7) INSTALL HIGH TEMPERATURE HEADS WHERE REQUIRED AS PER N.F.P.A. STANDARD # 13.

--- ALL INTERIOR GRID BRANCH LINE MEASUREMENTS ARE GIVEN AS CENTER LINE TO CENTER LINE DIMENSIONS (SIGHT TO PIPE).

--- ALL OTHER BRANCH LINE MEASUREMENTS ARE GIVEN AS CENTER LINE TO CENTER LINE (SIGHT-40 PIPE).

--- ALL MAIN MEASUREMENTS ARE GIVEN AS CENTER LINE TO CENTER LINE DIMENSIONS (THRU WALL PIPE).

--- DIMENSIONS TO BE U.L.C. LISTED AND APPROVED BY LOCAL AUTHORITIES.

--- IN DENOTES RISER NIPPLE.

--- ON DENOTES RISER NIPPLE.

--- ALL SUPERHEATED VALVES (PRESSURE) SWITCHES AND LOW PRESSURE MONITORING SWITCHES TO BE CONNECTED TO FIRE ALARM SYSTEM. (IF P.A.S. IS INSTALLED).

--- CONTRACTOR TO VERIFY SITE TO DETERMINE EXACT LOCATION AND ELEVATION OF MAINS (TO BE INSTALLED AS INDICATED ON DRAWINGS). ANY MAJOR DISCREPANCIES TO BE REPORTED TO THE DESIGNER PRIOR TO FABRICATION AND INSTALLATION.

OWNER (OR OTHERS) TO PROVIDE ADEQUATE HEAT IN ALL AREAS OF BUILDING SUBJECT TO FREEZING THAT ARE PROTECTED BY A WET TYPE SPRINKLER SYSTEM.

ALL GLASS BULB TYPE SPRINKLERS TO BE OF RECENT ISSUE MANUFACTURE DATE OF AT LEAST YEAR 2013.

SYMBOL	DESCRIPTION	QUANTITY
○	1/2" 155F STANDARD COVERAGE CONCEALED PENDENT (K=5.6) Q/R	00
○	1/2" 155F STANDARD COVERAGE UPRIGHT (K=5.6) Q/R	3
●	1/2" 155F RESIDENTIAL CONCEALED PENDENT (K=4.9)	122
◐	1/2" 155F RESIDENTIAL CONCEALED SIDEWALL (K=4.0)	142
◑	1/2" 155F RESIDENTIAL SEM-RECESSED SIDEWALL (K=5.8)	00
◒	WINDOW SPRINKLER (K=5.6)	4
▣	FIRE HOSE RACK - 100 FT OF 1/2" LINED HOSE C/W COMBINATION FOG NOZZLE	4


DESIGN CRITERIA

DESIGNED FOR RESIDENTIAL SPRINKLERS AS PER NFPA 13 SECTION 11.3.1 (2010 ED.).

DESIGN AREA TO INCLUDE THE FOUR ADJACENT SPRINKLERS THAT PRODUCE THE GREATEST HYDRAULIC DEMAND.

THE REQUIRED DISCHARGE FROM EACH SPRINKLER SHALL BE THE GREATER OF THE FOLLOWING:

- (1) MIN. FLOW RATES INDICATED IN SPR. LISTING.
- (2) MIN. 0.10 GPM/SQ.FT. OVER DESIGN AREA.

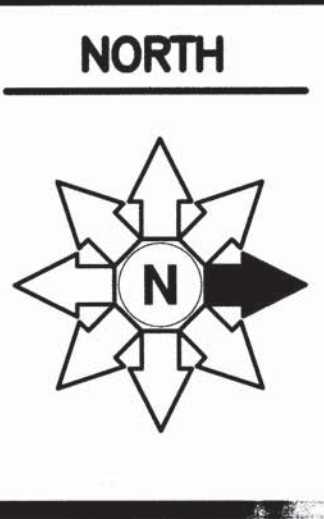

TRIDEL
4800 DUFFERIN STREET
TORONTO ONTARIO

PROJECT
SQ ALEXANDRA PARK
BLOCK 11
38 CAMERON ST. TORONTO

DWG TITLE
3RD FLOOR
SPRINKLER & STANDPIPE SYSTEM

DATE	SCALE	DWN BY	ISSUED FOR REVISION NO.
JULY 2014	1:100	H.W.	

PROJECT NO. 14-10224
DWG NO. SP-6
OF 16

IF SPRINKLER CONTRACTOR USES PLASTIC PIPING THEN THE FOLLOWING IS APPLICABLE.

NOTE: CONTRACTOR TO INSTALL PLASTIC PIPING AS PER MANUFACTURER'S SPECIFICATIONS INCLUDING EXPANSION LOOP.

O.B.C. SECTION 3.2.5.14 COMBUSTIBLE SPRINKLER PIPING

- (1) COMBUSTIBLE SPRINKLER PIPING SHALL BE USED ONLY FOR WET SYSTEMS IN RESIDENTIAL OCCUPANCIES AND OTHER LIGHT HAZARD OCCUPANCIES. (SEE APPENDIX A)
- (2) COMBUSTIBLE SPRINKLER PIPING SHALL MEET THE REQUIREMENTS OF ULC/ORD-199P-M, "COMBUSTIBLE PIPING FOR SPRINKLER SYSTEMS".
- (3) COMBUSTIBLE SPRINKLER PIPING SHALL BE SEPARATED FROM THE AREA SERVED BY THE SPRINKLER SYSTEM AND FROM ANY OTHER FIRE COMPARTMENT BY CEILINGS, WALLS, OR SOFFITS CONSISTING AS A MINIMUM:
 - (A) LATH AND PLASTER,
 - (B) GYPSUM BOARD NOT LESS THAN 9.5 MM (3/8 IN) THICK
 - (C) PLYWOOD NOT LESS THAN 13 MM (1/2 IN) THICK OR
 - (D) A SUSPENDED MEMBRANE CEILING WITH
 - (i) STEEL SUSPENSION GRID, AND
 - (ii) LATH-IN PANELS OR TILES HAVING A MASS NOT LESS THAN 1.7 KG/SQUARE METRE (0.35 LB/SQUARE FOOT)
- (4) IF COMBUSTIBLE SPRINKLER PIPING IS LOCATED ABOVE A CEILING, AN OPENING THROUGH THE CEILING THAT IS NOT PROTECTED IN CONFORMANCE WITH SENTENCE (3) SHALL BE LOCATED SO THAT THE DISTANCE BETWEEN THE EDGE OF THE OPENING AND THE NEAREST SPRINKLER IS NOT MORE THAN 300 MM (11 3/4").
- (5) THE PROTECTION REQUIRED BY SENTENCES (3) AND (4) IS PERMITTED TO BE WAIVED WHERE COMBUSTIBLE SPRINKLER PIPING HAS BEEN TESTED IN CONFORMANCE WITH ULC/ORD-199P-M, "COMBUSTIBLE PIPING FOR SPRINKLER SYSTEMS", AND HAS BEEN SHOWN TO MEET THE REQUIREMENTS IN THAT DOCUMENT WITHOUT ADDITIONAL PROTECTION.

GENERAL NOTES

- NOTE 1: IN BUILDINGS SPRINKLERED IN ACCORDANCE WITH NFPA 13, CLOSETS LESS THAN 12 SQ.FT. IN AREA IN INDIVIDUAL DWELLING UNITS SHALL NOT BE REQUIRED TO BE SPRINKLERED. CLOSETS THAT CONTAIN EQUIPMENT SUCH AS WASHERS, DRYERS, FURNACES, OR WATER HEATERS SHALL BE SPRINKLERED REGARDLESS OF SIZE. AS PER NFPA-13 (2007) CLAUSE 21.20.19.2.1
- NOTE 2: SPRINKLERS SHALL NOT BE REQUIRED IN BATHROOMS THAT ARE LOCATED WITHIN DWELLING UNITS, THAT DO NOT EXCEED 55 SQ.FT. IN AREA, AND THAT HAVE WALLS AND CEILING OF NONCOMBUSTIBLE OR LIMITED-COMBUSTIBLE MATERIALS WITH A 15-MINUTE THERMAL BARRIER RATING, INCLUDING THE WALLS AND CEILING BEHIND ANY SHOWER ENCLOSURE OR TUB. AS PER NFPA-13 (2007) CLAUSE 8.15.8.1.1
- NOTE 3: WHERE SIDEWALL SPRINKLER IS INSTALLED AT SOFFIT (BULKHEAD) EXCEEDING MORE THAN 8" IN WIDTH, PENDENT SPRINKLERS SHALL BE INSTALLED UNDER THE SOFFIT (BULKHEAD).
- NOTE 4: RESIDENTIAL SIDEWALL SPRINKLERS SHALL BE PERMITTED TO BE INSTALLED IN THE FACE OF A SOFFIT LOCATED DIRECTLY OVER CABINETS WITHOUT REQUIRING ADDITIONAL SPRINKLERS BELOW THE SOFFIT OR CABINETS WHERE THE SOFFIT DOES NOT PROJECT HORIZONTALLY MORE THAN 12" FROM THE WALL.
- NOTE 5: IF CPVC PIPE IS USED, CONTRACTOR TO PROVIDE "EXPANSION LOOP" ON STRAIGHT RUNS EXCEEDING 100 FT IN LENGTH.
- NOTE 6: ANY FIRE STOPPING, ACOUSTIC SEALANT AND MATERIALS USED IN THIS PROJECT WHICH COME IN CONTACT WITH CPVC SPRINKLER PIPING IS TO BE COMPATIBLE WITH CPVC PIPING
- NOTE 7: SPRINKLERS TO BE A MINIMUM 3"-0" FROM EDGE OF ALL SURFACE MOUNTED LIGHT FIXTURE.

SPRINKLER LAYOUT BASED ON BULKHEADS BEING MAXIMUM 12" DEEP. ADDITIONAL SIDEWALL SPRINKLERS MAY BE REQUIRED IF BULKHEAD DEPTH EXCEEDS 12".


PROTECTION AREA PER RESIDENTIAL CONCEALED PENDENT SPRINKLER SHALL NOT EXCEED 300 SQ.FT. MAX. SPACING IS 20 FT. PROTECTION AREA PER RESIDENTIAL CONCEALED SIDEWALL SPRINKLER SHALL NOT EXCEED 256 SQ.FT. (16 FT. X 16 FT.)

CONTRACTOR SHALL COORDINATE WITH LIGHTING, DIFFUSER & INTERIOR DESIGN DRAWINGS PRIOR TO INSTALLATION OF SPRINKLER SYSTEM.


THE HEIGHT OF THE BULKHEAD NOT TO EXCEED 12" AS PER ARCHITECTURAL DRAWING.

SPRINKLER CONTROL VALVE STATION

- 1 STANDARD SHUT OFF VALVE
 - 2 2" CHECK VALVE
 - 3 FLOW SWITCH
 - 4 1/2" DRAIN GLOBE VALVE
 - 5 1" INSPECTOR TEST VALVE SIGHT GLASS
 - 6 UNION WITH CORROSION RESISTANT ORIFICE OWING FLOW EQUIVALENT TO SMALLEST SPRINKLER ORIFICE IN SYSTEM.
 - 7 1/2" RELIEF VALVE (SET AT 175 PSI)
- WHERE AUXILIARY AIR RESERVOIRS ARE INSTALLED TO ABSORB PRESSURE INCREASES, A RELIEF VALVE SHALL BE NOT REQUIRED.
- FLOW SWITCH & SHUT OFF VALVE OR PIV TO BE SUPERVISED AND CONNECTED TO FIRE ALARM SYSTEM.

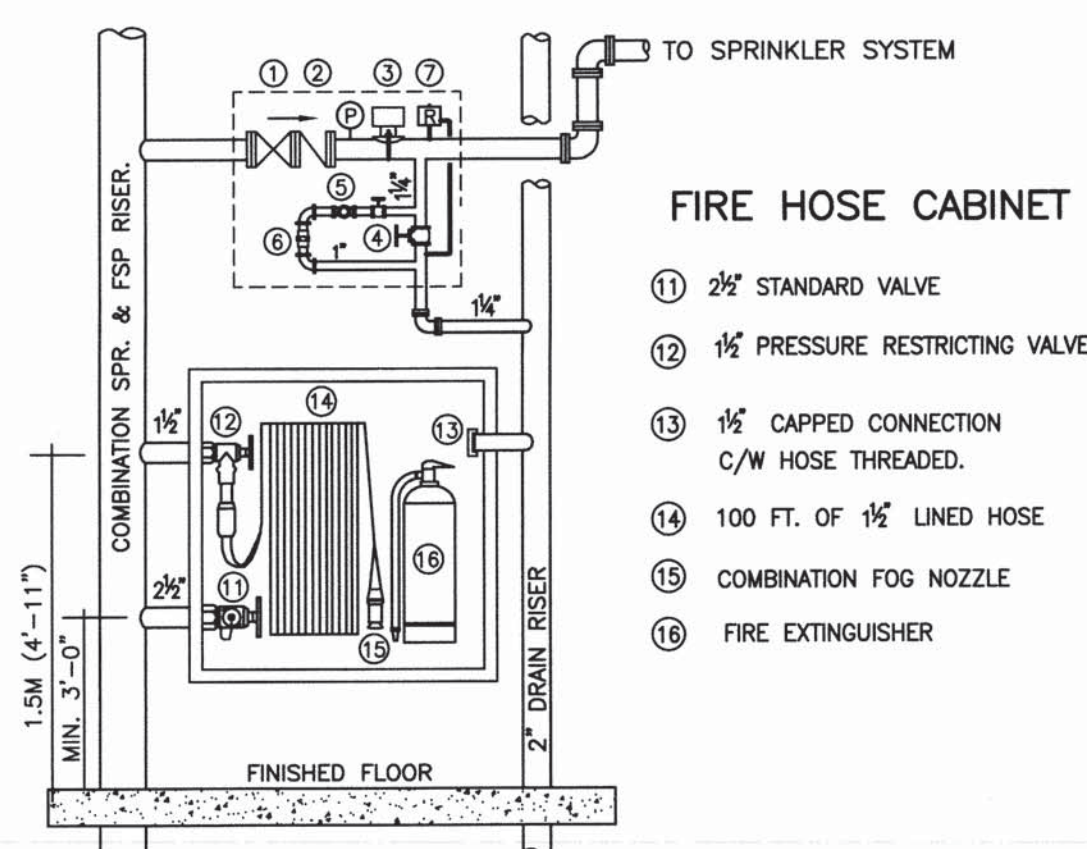

FIRE HOSE CABINET AND SPRINKLER CONTROL VALVE STATION DETAIL
N.T.S.

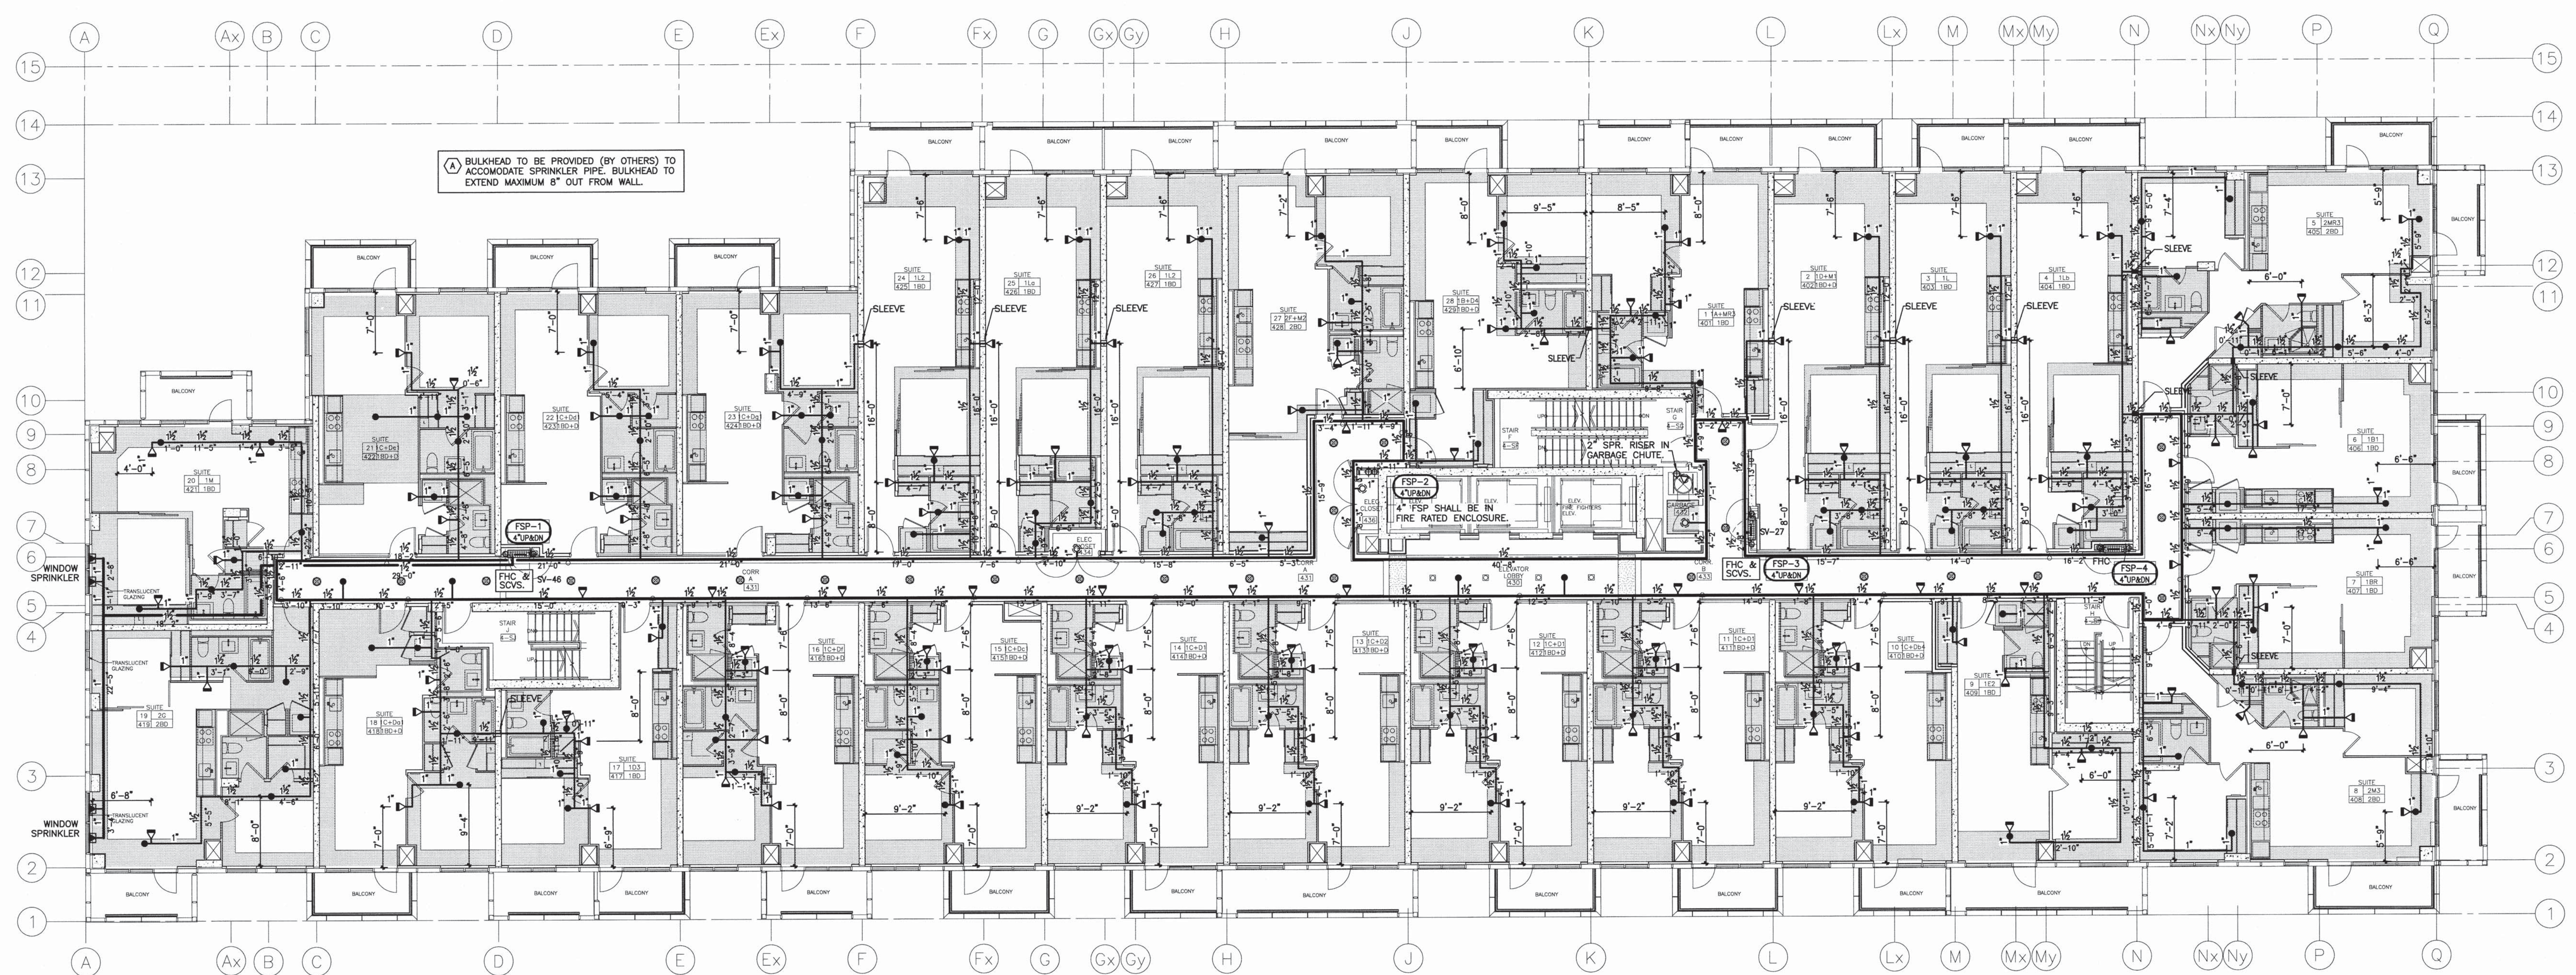

BULKHEAD TO BE PROVIDED (BY OTHERS) TO ACCOMMODATE SPRINKLER PIPE BULKHEAD TO EXTEND MAXIMUM 8" OUT FROM WALL.

FSP SHALL BE IN FIRE RATED ENCLOSURE.

REVISIONS	DATE	DESCRIPTION
2.	AUG. 15 2014	RE-ISSUED FOR PERMIT.
4.	SEP. 08 2015	REVISED SPRINKLER LAYOUT SUIT TO NEW BULKHEAD.
5.	OCT. 2 2015	ISSUED FOR CONSTRUCTION.

NOTES

--- THIS DRAWING ASSOCIATED CALCULATIONS AND SPECIFICATIONS ARE THE PROPERTY OF THE DESIGNER AND MUST BE RETURNED AT THE COMPLETION OF THE WORK OR UPON REQUEST.

--- DIMENSIONS TAKE PRECEDENCE OVER SCALES.

--- THE SPRINKLER SYSTEM IS TO BE INSTALLED AS PER N.F.P.A. STANDARD # 13 AND O.B.C. STANDARD # 3.2.5.14.

--- CONTRACTOR TO VERIFY FOR SYSTEMS IN BRANCH LINES AND MAINS WHERE REQUIRED.

--- ALL MATERIALS TO BE U.L.C. LISTED AND APPROVED BY LOCAL AUTHORITIES.

--- UNDERGROUND WATERMAIN TO BE INSTALLED ACCORDING TO LOCAL AUTHORITIES AND INSURANCE CO. STANDARDS.

--- METRIC HEAD TEMPERATURE HEADS WHERE REQUIRED AS PER N.F.P.A. STANDARD # 13.

--- ALL INTERIOR GRID BRANCH LINE MEASUREMENTS ARE GIVEN AS CENTER LINE TO CENTER LINE DIMENSIONS (SICHTO PIPE).

--- ALL OTHER BRANCH LINE MEASUREMENTS ARE GIVEN AS CENTER LINE TO CENTER LINE (SCH40 PIPE).

--- ALL MAIN MEASUREMENTS ARE GIVEN AS CENTER LINE TO CENTER LINE DIMENSIONS. (THIN WALL PIPE).

--- IDENTIFIED DISTANCE IN INCHES FROM CENTER LINE OF PIPE TO UNDERSIDE OF CEILING.

--- RN DENOTES RISER NIPPLE ON INDICATED CORNER.

--- ALL SUPERHEATED VALVES/FLOW (PRESSURE) SWITCHES AND LOW PRESSURE MONITORING SWITCHES TO BE CONNECTED TO FIRE ALARM SYSTEM. (P.A.S.) IS DETAILLED.

--- CONTRACTOR TO VERIFY SET-POINT LOCATIONS AND EXACT LOCATION AND ELEVATION OF MANIC TO BE INSTALLED AS INDICATED ON DRAWINGS. ANY MANIC DISCREPANCIES TO BE REPORTED TO THE DESIGNER PRIOR TO FABRICATION AND INSTALLATION.

OWNER (OR OTHERS) TO PROVIDE ADEQUATE HEAT IN ALL AREAS OF BUILDING SUBJECT TO FREEZING THAT ARE PROTECTED BY A WET TYPE SPRINKLER SYSTEM.

ALL GLASS BULB TYPE SPRINKLERS TO BE OF RECENT ISSUE. MANUFACTURE DATE OF AT LEAST YEAR 2013.

S/R=STANDARD RESPONSE Q/R=QUICK RESPONSE C/W GUARD		
○	1/2" 155F STANDARD COVERAGE CONCEALED PENDENT (K=5.6) Q/R	00
○	1/2" 155F STANDARD COVERAGE UPRIGHT (K=5.6) Q/R	3
●	1/2" 155F RESIDENTIAL CONCEALED PENDENT (K=4.9)	128
●	1/2" 155F RESIDENTIAL CONCEALED SIDEWALL (K=4.0)	139
◄	1/2" 155F RESIDENTIAL SEMI-RECESSED SIDEWALL (K=5.8)	00
◄	1/2" 155F RESIDENTIAL SEMI-RECESSED SIDEWALL (K=5.8)	00
◄	WINDOW SPRINKLER (K=5.6)	4
◄	1/2" 165F STANDARD COVERAGE SIDEWALL (K=5.6) Q/R	1
◄	FIRE HOSE RACK - 100' FT OF 1 1/2" LINED HOSE C/W COMBINATION FOG NOZZLE	4


DESIGN CRITERIA

DESIGNED FOR RESIDENTIAL SPRINKLERS AS PER NFPA 13 SECTION 11.3.1 (2010 ED.).

DESIGN AREA TO INCLUDE THE FOUR ADJACENT SPRINKLERS THAT PRODUCE THE GREATEST REQUIRED DISCHARGE FROM EACH SPRINKLER HYDRAULIC DEMAND.

(1) MIN. FLOW RATES INDICATED IN SPR. LISTING.

(2) MIN. 0.10 GPM/SQ.FT. OVER DESIGN AREA.

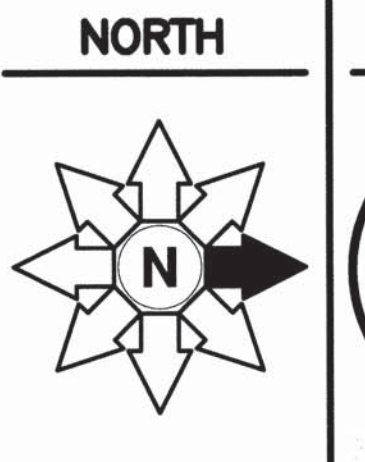

PROJECT
SQ ALEXANDRA PARK
BLOCK 11
38 CAMERON ST. TORONTO

DWG TITLE
4TH FLOOR
SPRINKLER & STANDPIPE SYSTEM

DATE	PROJECT NO.
JULY 2014	14-10224
SCALE	DWG NO.
1:100	SP-7
DWN BY	ISSUED FOR REVISION NO.
H.W.	0.2
	OF 16

IF SPRINKLER CONTRACTOR USES PLASTIC PIPING THEN THE FOLLOWING IS APPLICABLE.

NOTE: CONTRACTOR TO INSTALL PLASTIC PIPING AS PER MANUFACTURER'S SPECIFICATIONS INCLUDING EXPANSION LOOP.

O.B.C. SECTION 3.2.5.14 COMBUSTIBLE SPRINKLER PIPING

- (1) COMBUSTIBLE SPRINKLER PIPING SHALL BE USED ONLY FOR WET SYSTEMS IN RESIDENTIAL OCCUPANCIES AND OTHER LIGHT HAZARD OCCUPANCIES. (SEE APPENDIX A)
- (2) COMBUSTIBLE SPRINKLER PIPING SHALL MEET THE REQUIREMENTS OF ULC/ORD-199P-M, "COMBUSTIBLE PIPING FOR SPRINKLER SYSTEMS".
- (3) COMBUSTIBLE SPRINKLER PIPING SHALL BE SEPARATED FROM THE AREA SERVED BY THE SPRINKLER SYSTEM AND FROM ANY OTHER FIRE COMPARTMENT BY CEILINGS, WALLS, OR SOFFITS CONSISTING AS A MINIMUM.
 - (A) LATH AND PLASTER,
 - (B) GYPSUM BOARD NOT LESS THAN 9.5 MM (3/8 IN) THICK
 - (C) PLYWOOD NOT LESS THAN 13 MM (1/2 IN) THICK OR
 - (D) A SUSPENDED MEMBRANE CEILING WITH
 - (i) STEEL SUSPENSION GRID, AND
 - (ii) LATH-IN PANELS OR TILES HAVING A MASS NOT LESS THAN 1.7 KG/SQUARE METRE (0.35 LB/SQUARE FOOT)
- (4) IF COMBUSTIBLE SPRINKLER PIPING IS LOCATED ABOVE A CEILING, AN OPENING THROUGH THE CEILING THAT IS NOT PROTECTED IN CONFORMANCE WITH SENTENCE (3) SHALL BE LOCATED SO THAT THE DISTANCE BETWEEN THE EDGE OF THE OPENING AND THE NEAREST SPRINKLER IS NOT MORE THAN 300 MM (11 3/4").
- (5) THE PROTECTION REQUIRED BY SENTENCES (3) AND (4) IS PERMITTED TO BE WAIVED WHERE COMBUSTIBLE SPRINKLER PIPING HAS BEEN TESTED IN CONFORMANCE WITH ULC/ORD-199P-M, "COMBUSTIBLE PIPING FOR SPRINKLER SYSTEMS", AND HAS BEEN SHOWN TO MEET THE REQUIREMENTS IN THAT DOCUMENT WITHOUT ADDITIONAL PROTECTION.

GENERAL NOTES

- NOTE 1: IN BUILDINGS SPRINKLERED IN ACCORDANCE WITH NFPA 13, CLOSETS LESS THAN 12 SQ.FT. IN AREA IN INDIVIDUAL DWELLING UNITS SHALL NOT BE REQUIRED TO BE SPRINKLERED. CLOSETS THAT CONTAIN EQUIPMENT SUCH AS WASHERS, DRYERS, FURNACES, OR WATER HEATERS SHALL BE SPRINKLERED REGARDLESS OF SIZE. AS PER NFPA-13 (2007) CLAUSE 21.20.19.2.1
- NOTE 2: SPRINKLERS SHALL NOT BE REQUIRED IN BATHROOMS THAT ARE LOCATED WITHIN DWELLING UNITS, THAT DO NOT EXCEED 56 SQ.FT. IN AREA, AND THAT HAVE WALLS AND CEILINGS OF NONCOMBUSTIBLE OR LIMITED-COMBUSTIBLE MATERIALS WITH A 15-MINUTE THERMAL BARRIER RATING, INCLUDING THE WALLS AND CEILINGS BEHIND ANY SHOWER ENCLOSURE OR TUB. AS PER NFPA-13 (2007) CLAUSE 8.15.8.1.1
- NOTE 3: WHERE SIDEWALL SPRINKLER IS INSTALLED AT SOFFIT (BULKHEAD) EXCEEDING MORE THAN 8" IN WIDTH, PENDENT SPRINKLERS SHALL BE INSTALLED UNDER THE SOFFIT (BULKHEAD).
- NOTE 4: RESIDENTIAL SIDEWALL SPRINKLERS SHALL BE PERMITTED TO BE INSTALLED IN THE FACE OF A SOFFIT LOCATED DIRECTLY OVER CABINETS WITHOUT REQUIRING ADDITIONAL SPRINKLERS BELOW THE SOFFIT OR CABINETS WHERE THE SOFFIT DOES NOT PROJECT HORIZONTALLY MORE THAN 12" FROM THE WALL.
- NOTE 5: IF CPVC PIPE IS USED, CONTRACTOR TO PROVIDE "EXPANSION OFFSET LOOP" ON STRAIGHT RUNS EXCEEDING 100 FT IN LENGTH.
- NOTE 6: ANY FIRE STOPPING, ACOUSTIC SEALANT AND MATERIALS USED IN THIS PROJECT WHICH COME IN CONTACT WITH CPVC SPRINKLER PIPING IS TO BE COMPATIBLE WITH CPVC PIPING
- NOTE 7: SPRINKLERS TO BE A MINIMUM 3"-0" FROM EDGE OF ALL SURFACE MOUNTED LIGHT FIXTURE.

SPRINKLER LAYOUT BASED ON BULKHEADS BEING MAXIMUM 12" DEEP. ADDITIONAL SIDEWALL SPRINKLERS MAY BE REQUIRED IF BULKHEAD DEPTH EXCEEDS 12".


PROTECTION AREA PER RESIDENTIAL CONCEALED PENDENT SPRINKLER SHALL NOT EXCEED 300 SQ.FT. MAX. SPACING IS 20 FT. PROTECTION AREA PER RESIDENTIAL CONCEALED SIDEWALL SPRINKLER SHALL NOT EXCEED 256 SQ.FT. (16 FT. X 16 FT.)

CONTRACTOR SHALL COORDINATE WITH LIGHTING, DIFFUSER & INTERIOR DESIGN DRAWINGS PRIOR TO INSTALLATION OF SPRINKLER SYSTEM.


THE HEIGHT OF THE BULKHEAD NOT TO EXCEED 12" AS PER ARCHITECTURAL DRAWING.

SPRINKLER CONTROL VALVE STATION

- 1 STANDARD SHUT OFF VALVE
 - 2 2" CHECK VALVE
 - 3 FLOW SWITCH
 - 4 1/2" DRAIN GLOBE VALVE
 - 5 1" INSPECTOR TEST VALVE SIGHT GLASS
 - 6 UNION WITH CORROSION RESISTANT DRIFTE GIVING FLOW EQUIVALENT TO SMALLEST SPRINKLER ORIFICE IN SYSTEM.
 - 7 1/2" RELIEF VALVE (SET AT 175 PS)
- WHERE AUXILIARY AIR RESERVOIRS ARE INSTALLED TO ABSORB PRESSURE INCREASES, A RELIEF VALVE SHALL BE NOT REQUIRED.
- FLOW SWITCH & SHUT OFF VALVE OR FRY TO BE SUPERVISED AND CONNECTED TO FIRE ALARM SYSTEM.

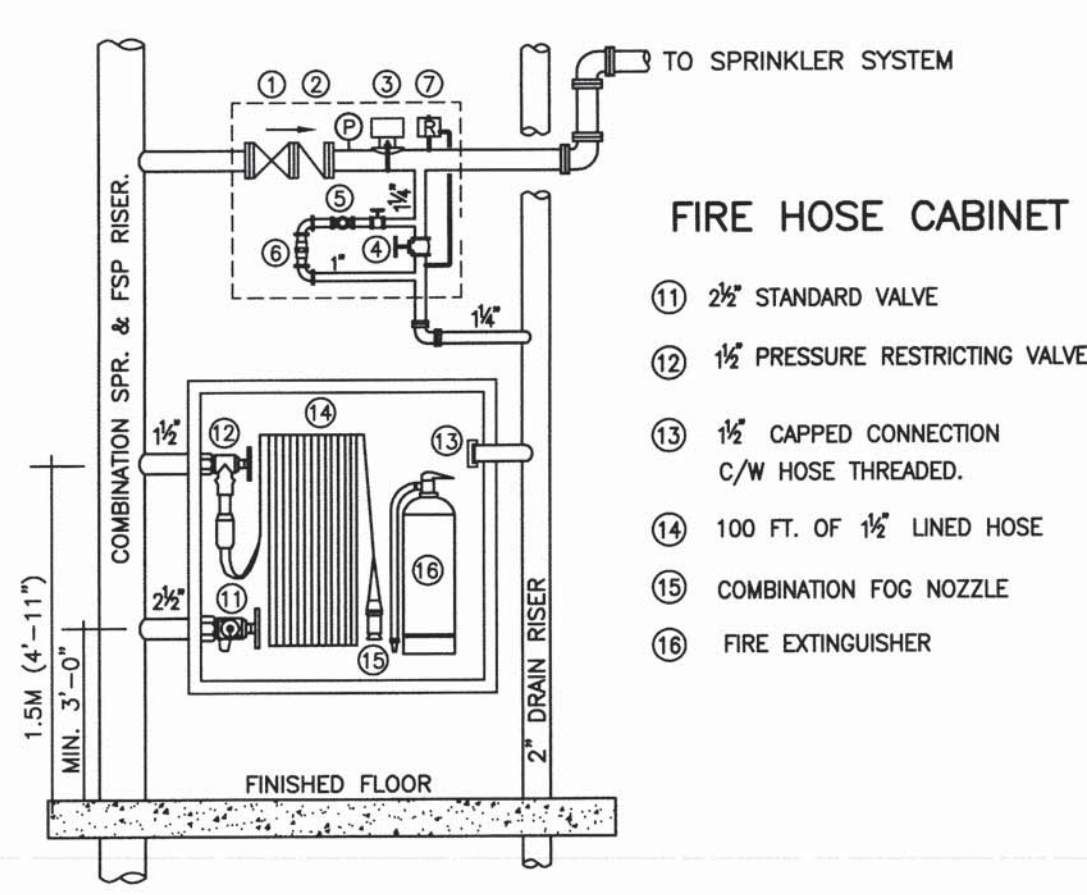

FIRE HOSE CABINET AND SPRINKLER CONTROL VALVE STATION DETAIL
N.T.S.

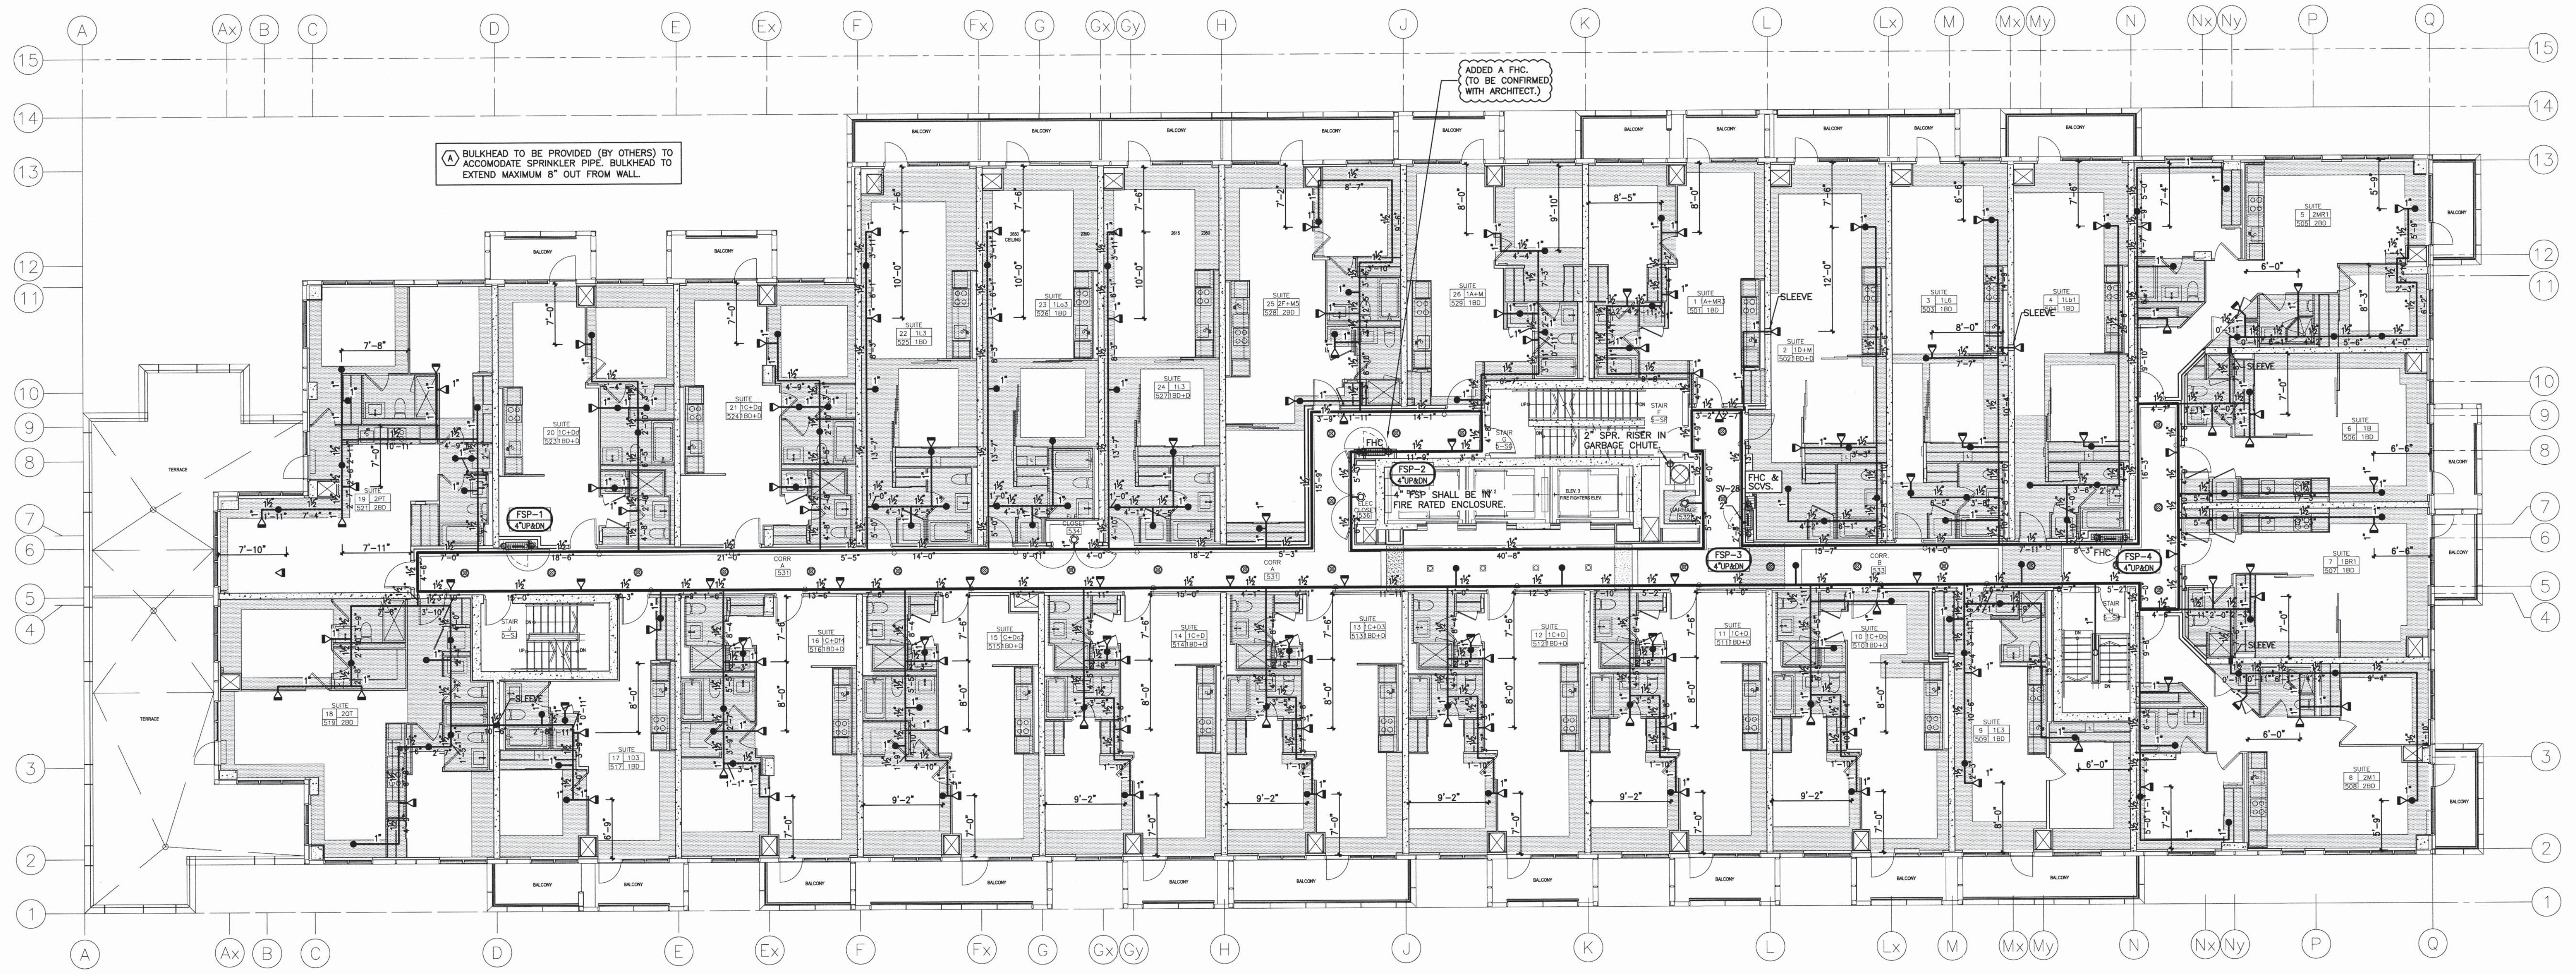

▲ BULKHEAD TO BE PROVIDED (BY OTHERS) TO ACCOMMODATE SPRINKLER PIPE. BULKHEAD TO EXTEND MAXIMUM 8" OUT FROM WALL.

ADDED A F.H.C. (TO BE CONFIRMED WITH ARCHITECT)

F.H.C. SHALL BE IN 1" FIRE RATED ENCLOSURE.

REVISIONS	DATE	DESCRIPTION
2.	AUG. 15 2014	RE-ISSUED FOR PERMIT.
3.	JUN. 08 2015	REVISED LAYOUT AS PER TEEPLE ARCHITECTS DATED IN JUN.08, 2015
4.	SEP. 08 2015	REVISED SPRINKLER LAYOUT SUIT TO NEW BULKHEAD.
5.	OCT. 2 2015	ISSUED FOR CONSTRUCTION.

NOTES

--- THIS DRAWING ASSOCIATED CALCULATIONS AND SPECIFICATIONS ARE THE PROPERTY OF THE DESIGNER AND MUST BE RETURNED AT THE COMPLETION OF THE WORK OR UPON REQUEST.

--- DIMENSIONS TAKE PRECEDENCE OVER SCALE.

--- THE SPRINKLER SYSTEM IS TO BE INSTALLED AS PER N.F.P.A. STANDARDS AND O.B.C. STANDARDS.

--- CONTRACTOR TO VERIFY ALL BRANCH LINES AND MAINS WHERE REQUIRED.

--- ALL MATERIALS TO BE LISTED AND APPROVED BY LOCAL AUTHORITIES.

--- ALL SUPERVISOR VALVES, FLOW (PRESSURE) SWITCHES AND LOW PRESSURE MONITORING SWITCHES TO BE CONNECTED TO FIRE ALARM SYSTEM. (IF F.A.S. IS INSTALLED)

--- CONTRACTOR TO VERIFY SUIT TO DETERMINE EXACT LOCATION AND ELEVATION OF MAINS TO BE INSTALLED AS INDICATED ON DRAWINGS. ANY MAJOR DISCREPANCIES TO BE REPORTED TO THE DESIGNER PRIOR TO FABRICATION AND INSTALLATION.

--- RN DENOTES RISER NIPPLE.

--- ON DENOTES OPEN.

--- ALL OTHER BRANCH LINE MEASUREMENTS ARE GIVEN AS CENTER LINE TO CENTER LINE (SCL-40 PIPE).

--- ALL MAIN MEASUREMENTS ARE GIVEN AS CENTER LINE TO CENTER LINE DIMENSIONS. (THIN WALL PIPE)

--- DIMENSIONS DISTANCE IN INCHES FROM CENTER LINE OF PIPE TO UNDERSIDE OF CEILING.

--- OWNER (OR OTHERS) TO PROVIDE ADEQUATE HEAT IN ALL AREAS OF BUILDING SUBJECT TO FREEZING THAT ARE PROTECTED BY A WET TYPE SPRINKLER SYSTEM.

--- ALL GLASS BULB TYPE SPRINKLERS TO BE OF RECENT ISSUE. MANUFACTURE DATE OF AT LEAST YEAR 2013.

SYMBOL	DESCRIPTION	QUANTITY
○	1/2" 155F STANDARD COVERAGE CONCEALED PENDENT (K=5.6) Q/R	00
○	1/2" 155F STANDARD COVERAGE UPRIGHT (K=5.6) Q/R	4
●	1/2" 155F RESIDENTIAL CONCEALED PENDENT (K=4.9)	127
●	1/2" 155F RESIDENTIAL CONCEALED SIDEWALL (K=4.0)	125
◄	1/2" 155F RESIDENTIAL SEMI-RECESSED SIDEWALL (K=5.8)	00
▬	FIRE HOSE RACK - 100 FT OF 1 1/2" LINED HOSE C/W COMBINATION FOG NOZZLE	4


DESIGN CRITERIA

DESIGNED FOR RESIDENTIAL SPRINKLERS AS PER NFPA 13 SECTION 11.3.1 (2010 ED.).

DESIGN AREA TO INCLUDE THE FOUR ADJACENT SPRINKLERS THAT PRODUCE THE GREATEST HYDRAULIC DEMAND.

THE REQUIRED DISCHARGE FROM EACH SPRINKLER SHALL BE THE GREATER OF THE FOLLOWING:

- (1) MIN. FLOW RATES INDICATED IN SPR. LISTING.
- (2) MIN. 0.10 GPM/SQ.FT. OVER DESIGN AREA.

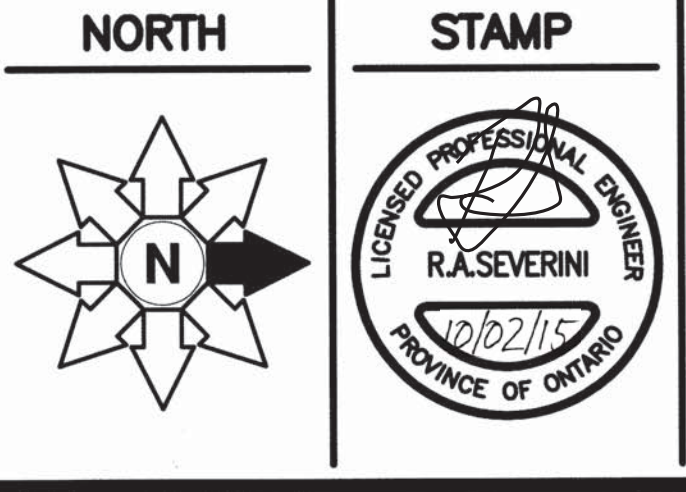

TRIDEL
4800 DUFFERIN STREET
TORONTO ONTARIO

PROJECT
SQ ALEXANDRA PARK
BLOCK 11
38 CAMERON ST. TORONTO

DWG TITLE
5TH FLOOR
SPRINKLER & STANDPIPE SYSTEM

DATE
JULY 2014

SCALE
1:100

DWN BY
H.W.

ISSUED FOR REVISION NO.
0.2

PROJECT NO.
14-10224

DWG NO.
SP-8

OF 16

IF SPRINKLER CONTRACTOR USES PLASTIC PIPING THEN THE FOLLOWING IS APPLICABLE.

NOTE: CONTRACTOR TO INSTALL PLASTIC PIPING AS PER MANUFACTURER'S SPECIFICATIONS INCLUDING EXPANSION LOOP.

O.B.C. SECTION 3.2.5.14 COMBUSTIBLE SPRINKLER PIPING

- (1) COMBUSTIBLE SPRINKLER PIPING SHALL BE USED ONLY FOR WET SYSTEMS IN RESIDENTIAL OCCUPANCIES AND OTHER LIGHT HAZARD OCCUPANCIES. (SEE APPENDIX A.)
- (2) COMBUSTIBLE SPRINKLER PIPING SHALL MEET THE REQUIREMENTS OF ULC/ORD-199P-M, "COMBUSTIBLE PIPING FOR SPRINKLER SYSTEMS".
- (3) COMBUSTIBLE SPRINKLER PIPING SHALL BE SEPARATED FROM THE AREA SERVED BY THE SPRINKLER SYSTEM AND FROM ANY OTHER FIRE COMPARTMENT BY CEILINGS, WALLS, OR SOFFITS CONSISTING AS A MINIMUM:
 - (A) LATH AND PLASTER,
 - (B) GYPSUM BOARD NOT LESS THAN 9.5 MM (3/8 IN) THICK
 - (C) PLYWOOD NOT LESS THAN 13 MM (1/2 IN) THICK OR
 - (D) A SUSPENDED MEMBRANE CEILING WITH
 - (i) STEEL SUSPENSION GRID, AND
 - (ii) LAY-IN PANELS OR TILES HAVING A MASS NOT LESS THAN 1.7 KG/SQUARE METRE (0.35 LB/SQUARE FOOT)
- (4) IF COMBUSTIBLE SPRINKLER PIPING IS LOCATED ABOVE A CEILING, AN OPENING THROUGH THE CEILING THAT IS NOT PROTECTED IN CONFORMANCE WITH SENTENCE (3) SHALL BE LOCATED SO THAT THE DISTANCE BETWEEN THE EDGE OF THE OPENING AND THE NEAREST SPRINKLER IS NOT MORE THAN 300 MM (11 3/4").
- (5) THE PROTECTION REQUIRED BY SENTENCES (3) AND (4) IS PERMITTED TO BE WAIVED WHERE COMBUSTIBLE SPRINKLER PIPING HAS BEEN TESTED IN CONFORMANCE WITH ULC/ORD-C199P-M, "COMBUSTIBLE PIPING FOR SPRINKLER SYSTEMS", AND HAS BEEN SHOWN TO MEET THE REQUIREMENTS IN THAT DOCUMENT WITHOUT ADDITIONAL PROTECTION.

GENERAL NOTES

- NOTE 1:**
IN BUILDINGS SPRINKLERED IN ACCORDANCE WITH NFPA 13, CLOSETS LESS THAN 12 SQ.FT. IN AREA IN INDIVIDUAL DWELLING UNITS SHALL NOT BE REQUIRED TO BE SPRINKLERED. CLOSETS THAT CONTAIN EQUIPMENT SUCH AS WASHERS, DRYERS, FURNACES, OR WATER HEATERS SHALL BE SPRINKLERED REGARDLESS OF SIZE.
AS PER NFPA-13 (2007) CLAUSE 21.20.19.2.1
- NOTE 2:**
SPRINKLERS SHALL NOT BE REQUIRED IN BATHROOMS THAT ARE LOCATED WITHIN DWELLING UNITS, THAT DO NOT EXCEED 50 SQ.FT. IN AREA AND THAT HAVE WALLS AND CEILING OF NONCOMBUSTIBLE OR LIMITED-COMBUSTIBLE MATERIALS WITH A 15-MINUTE THERMAL BARRIER RATING, INCLUDING THE WALLS AND CEILING BEHIND ANY SHOWER ENCLOSURE OR TUB.
AS PER NFPA-13 (2007) CLAUSE 8.15.B.1.1
- NOTE 3:**
WHERE SIDEWALL SPRINKLER IS INSTALLED AT SOFFIT (BULKHEAD) EXCEEDING MORE THAN 8" IN WIDTH, PENDENT SPRINKLERS SHALL BE INSTALLED UNDER THE SOFFIT (BULKHEAD).
- NOTE 4:**
RESIDENTIAL SIDEWALL SPRINKLERS SHALL BE PERMITTED TO BE INSTALLED IN THE FACE OF A SOFFIT LOCATED DIRECTLY OVER CABINETS WITHOUT REQUIRING ADDITIONAL SPRINKLERS BELOW THE SOFFIT OR CABINETS WHERE THE SOFFIT DOES NOT PROJECT HORIZONTALLY MORE THAN 12" FROM THE WALL.
- NOTE 5:**
IF CPVC PIPE IS USED, CONTRACTOR TO PROVIDE "EXPANSION OFFSET LOOP" ON STRAIGHT RUNS EXCEEDING 100 FT IN LENGTH.
- NOTE 6:**
ANY FIRE STOPPING, ACOUSTIC SEALANT AND MATERIALS USED IN THIS PROJECT WHICH COME IN CONTACT WITH CPVC SPRINKLER PIPING IS TO BE COMPATIBLE WITH CPVC PIPING.
- NOTE 7:**
SPRINKLERS TO BE A MINIMUM 3"-0" FROM EDGE OF ALL SURFACE MOUNTED LIGHT FIXTURE.

SPRINKLER LAYOUT BASED ON BULKHEADS BEING MAXIMUM 12" DEEP. ADDITIONAL SIDEWALL SPRINKLERS MAY BE REQUIRED IF BULKHEAD DEPTH EXCEEDS 12".


PROTECTION AREA PER RESIDENTIAL CONCEALED PENDENT SPRINKLER SHALL NOT EXCEED 300 SQ.FT. MAX. SPACING IS 20 FT. PROTECTION AREA PER RESIDENTIAL CONCEALED SIDEWALL SPRINKLER SHALL NOT EXCEED 256 SQ.FT. (16 FT. X 16 FT.).

CONTRACTOR SHALL COORDINATE WITH LIGHTING, DIFFUSER & INTERIOR DESIGN DRAWINGS PRIOR TO INSTALLATION OF SPRINKLER SYSTEM.


THE HEIGHT OF THE BULKHEAD NOT TO EXCEED 12" AS PER ARCHITECTURAL DRAWING.

SPRINKLER CONTROL VALVE STATION

- 1 STANDARD SHUT OFF VALVE
 - 2 2" CHECK VALVE
 - 3 FLOW SWITCH
 - 4 1/2" DRAIN GLOBE VALVE
 - 5 1" INSPECTOR TEST VALVE SIGHT GLASS
 - 6 UNION WITH CORROSION RESISTANT ORIFICE GIVING FLOW EQUIVALENT TO SMALLEST SPRINKLER ORIFICE IN SYSTEM.
 - 7 1/2" RELIEF VALVE (SET AT 175 PSI)
- WHERE AUXILIARY AIR RESERVOIRS ARE INSTALLED TO ABSORB PRESSURE INCREASES, A RELIEF VALVE SHALL BE NOT REQUIRED.
- FLOW SWITCH & SHUT OFF VALVE OR FV TO BE SUPERVISED AND CONNECTED TO FIRE ALARM SYSTEM.

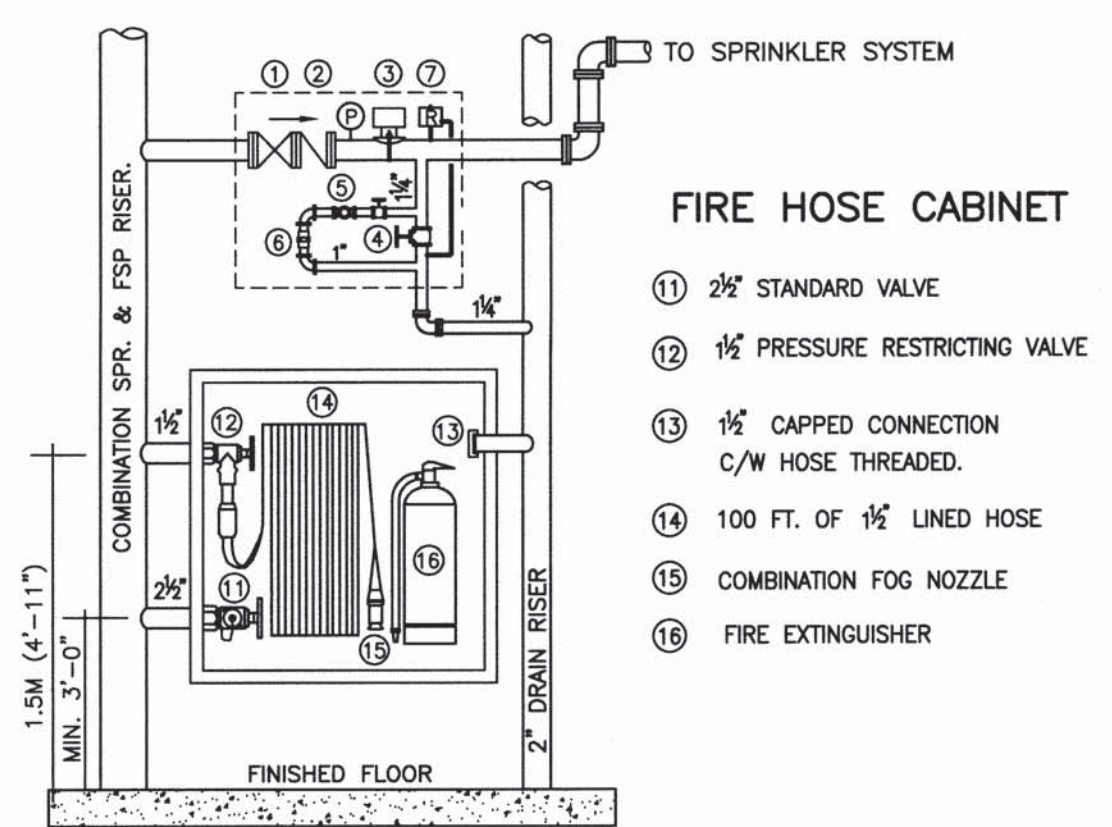

FIRE HOSE CABINET AND SPRINKLER CONTROL VALVE STATION DETAIL
N.T.S.

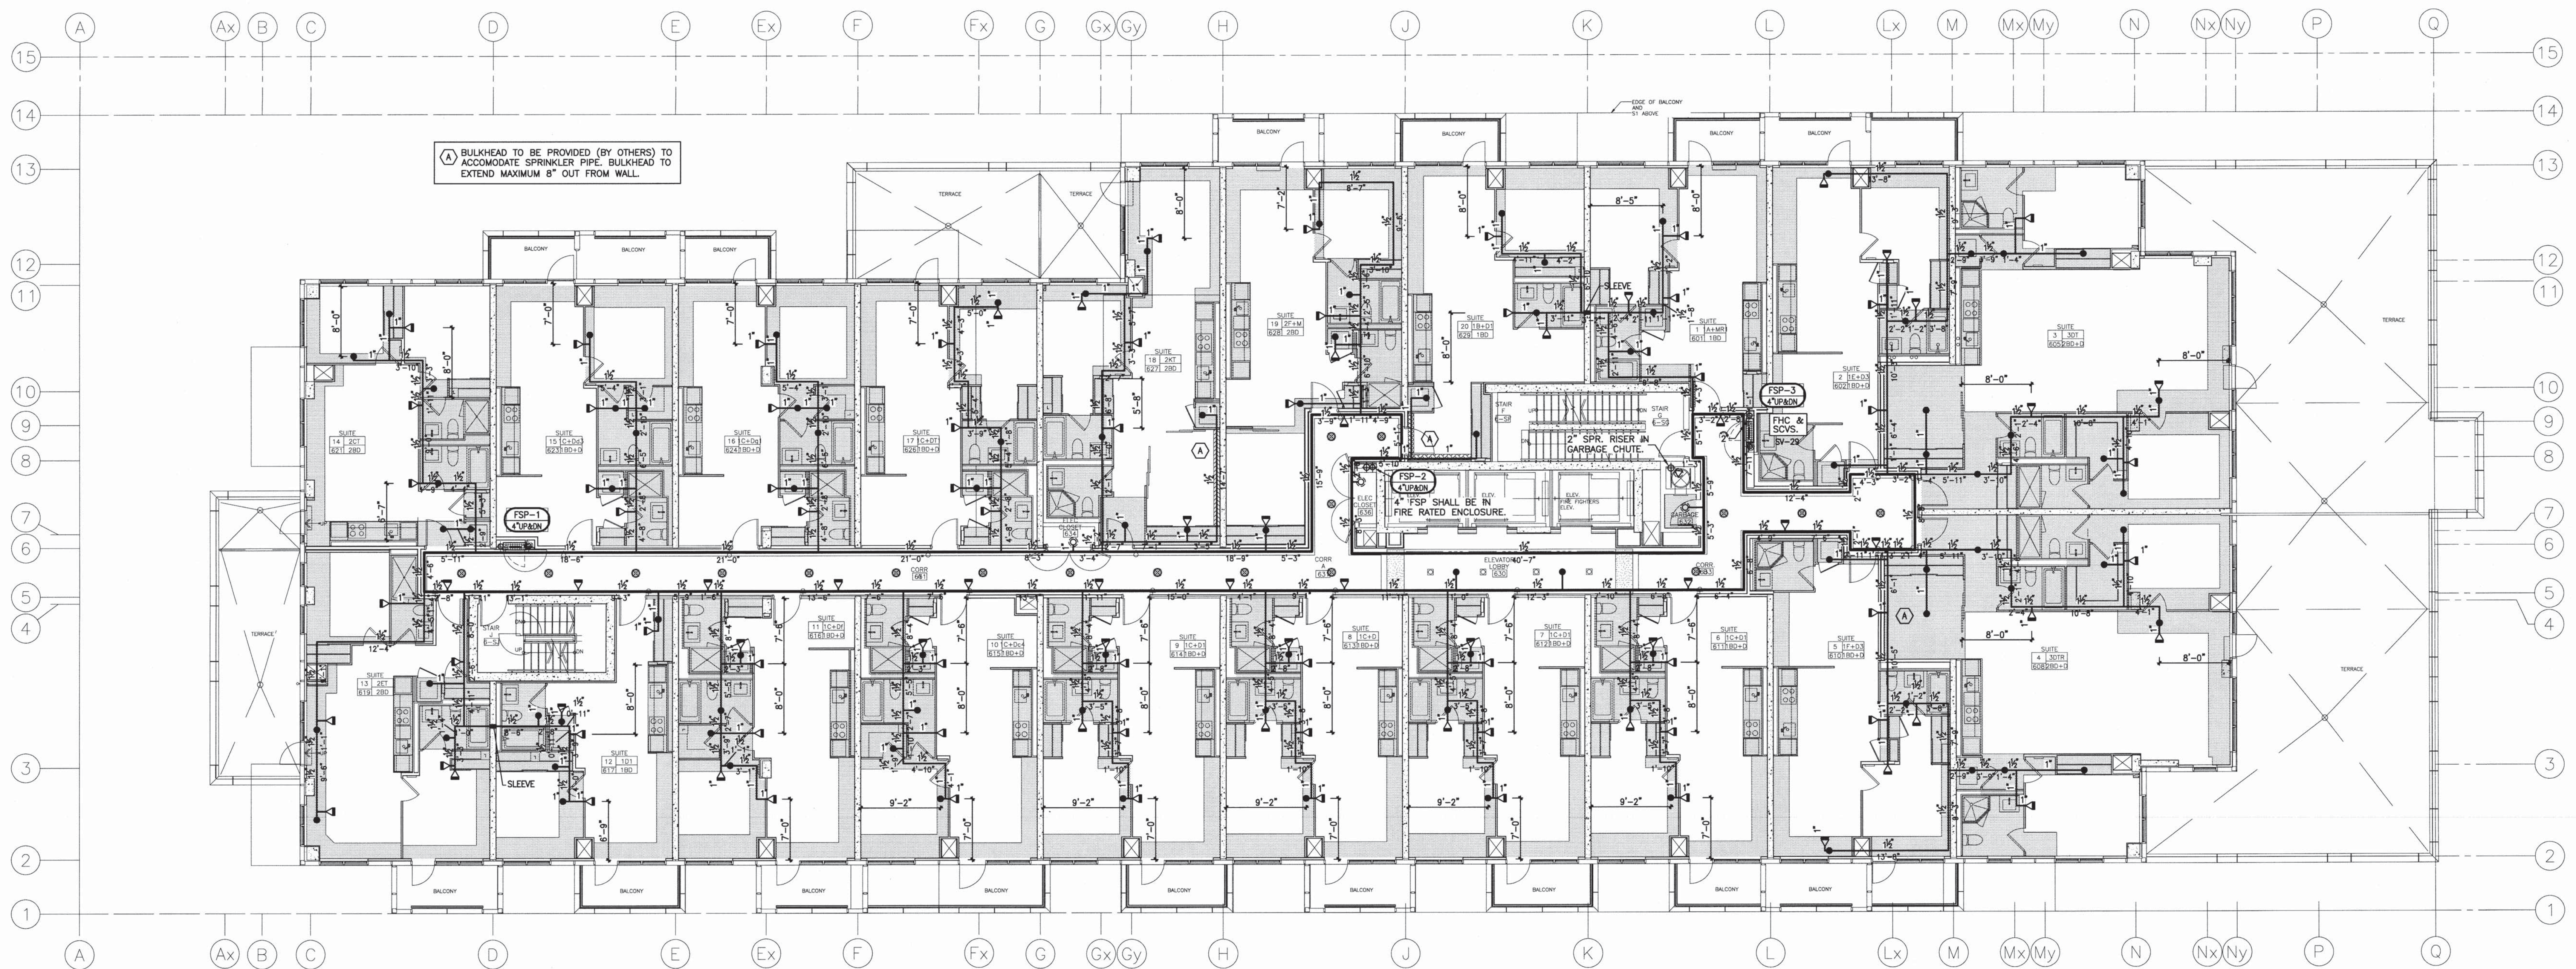

▲ BULKHEAD TO BE PROVIDED (BY OTHERS) TO ACCOMMODATE SPRINKLER PIPE. BULKHEAD TO EXTEND MAXIMUM 8" OUT FROM WALL.

REVISIONS

2.	RE-ISSUED FOR PERMIT.	AUG. 15 2014
3.	REVISED LAYOUT AS PER TEEPLE ARCHITECTS COMMENTS DATED IN JUN.08, 2015	JUN. 08 2015
5.	ISSUED FOR CONSTRUCTION.	OCT. 2 2015

NOTES

- THIS DRAWING ASSOCIATED CALCULATIONS AND SPECIFICATIONS ARE THE PROPERTY OF THE DESIGNER AND MUST BE RETURNED AT THE COMPLETION OF THE WORK OR UPON REQUEST.
- DIMENSIONS TAKE PRECEDENCE OVER DIMENSIONS ON PIPING.
- THE SPRINKLER SYSTEM IS TO BE INSTALLED AS PER N.F.P.A. STANDARD # 13 AND U.L.C. STANDARDS.
- CONTRACTOR TO INCLUDE FOR OFFSETS IN BRANCH LINES AND MAINS WHERE REQUIRED.
- ALL MATERIALS TO BE I.L.C. LISTED AND APPROVED BY LOCAL AUTHORITIES.
- UNDERGROUND WATERMAN TO BE INSTALLED ACCORDING TO LOCAL AUTHORITIES AND INSURANCE CO. STANDARDS.
- IF APPLICABLE, CONTRACTOR TO VISIT SITE TO DETERMINE EXACT LOCATION AND ELEVATION OF MAINS TO BE REPORTED TO THE DESIGNER PRIOR TO FABRICATION AND INSTALLATION.
- ALL INTERIOR GRID BRANCH LINE MEASUREMENTS ARE GIVEN AS CENTER LINE TO CENTER LINE DIMENSIONS. (C/C TO PIPING)
- ALL OTHER BRANCH LINE MEASUREMENTS ARE GIVEN AS CENTER LINE TO CENTER LINE DIMENSIONS. (C/C TO PIPING)
- ALL MAIN MEASUREMENTS ARE GIVEN AS CENTER LINE TO CENTER LINE DIMENSIONS. (C/C TO WALL FACE)
- DIMENES DISTANCE IN INCHES FROM CENTER LINE OF PIPE TO UNDERSIDE OF CEILING.
- R/N DENOTES RISER NIPPLE ON DENOTES DOWN.
- ALL SUPERVISING VALVES/FLOW (PRESSURE) SWITCHES AND LOW PRESSURE MONITORS, INSTALLED TO BE CONNECTED TO FIRE ALARM SYSTEM. (F.A.S.) IS INSTALLED.
- CONTRACTOR TO VISIT SITE TO DETERMINE EXACT LOCATION AND ELEVATION OF MAINS TO BE REPORTED TO THE DESIGNER PRIOR TO FABRICATION AND INSTALLATION.

OWNER (OR OTHER) TO PROVIDE ADEQUATE HEAT IN ALL AREAS OF BUILDING SUBJECT TO FREEZING THAT ARE PROTECTED BY A WET TYPE SPRINKLER SYSTEM.

ALL GLASS BULB TYPE SPRINKLERS TO BE OF RECENT ISSUE. MANUFACTURE DATE OF AT LEAST YEAR 2013.

S/R=STANDARD RESPONSE Q/R=QUICK RESPONSE C/W GUARD

●	1/2" 155F STANDARD COVERAGE CONCEALED PENDENT (K=5.6) Q/R	00
○	1/2" 155F STANDARD COVERAGE UPRIGHT (K=5.6) Q/R	3
●	1/2" 155F RESIDENTIAL CONCEALED PENDENT (K=4.9)	95
●	1/2" 155F RESIDENTIAL CONCEALED SIDEWALL (K=4.0)	105
◁	1/2" 165F STANDARD COVERAGE SIDEWALL (K=5.6) Q/R	1
□	FIRE HOSE RACK - 100 FT OF 1 1/2" LINED HOSE C/W COMBINATION FOG NOZZLE	2


DESIGN CRITERIA

DESIGNED FOR RESIDENTIAL SPRINKLERS AS PER NFPA 13 SECTION 11.3.1 (2010 ED.).

DESIGN AREA TO INCLUDE THE FOUR ADJACENT SPRINKLERS THAT PRODUCE THE GREATEST HYDRAULIC DEMAND.

THE REQUIRED DISCHARGE FROM EACH SPRINKLER SHALL BE THE GREATER OF THE FOLLOWING:

- (1) MIN. FLOW RATES INDICATED IN SPR. LISTING.
- (2) MIN. 0.10 GPM/SQ.FT. OVER DESIGN AREA.

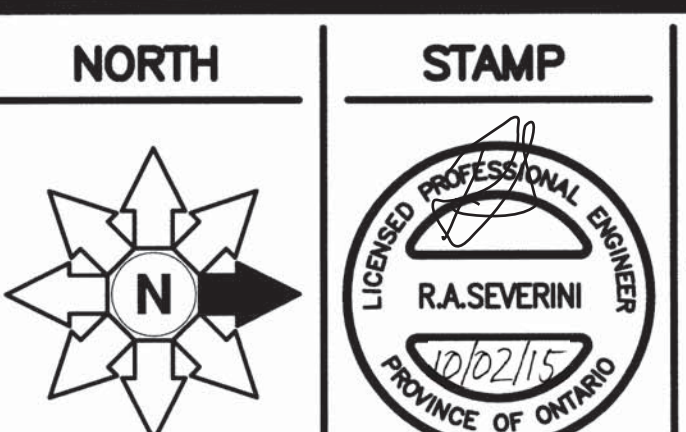

TRIDEL
4800 DUFFERIN STREET
TORONTO ONTARIO

PROJECT
SQ ALEXANDRA PARK
BLOCK 11
38 CAMERON ST. TORONTO

DWG TITLE
6TH FLOOR
SPRINKLER & STANDPIPE SYSTEM

DATE	JULY 2014	PROJECT NO.	14-10224
SCALE	1:100	DWG NO.	SP-9
DWN BY	H.W.	ISSUED FOR REVISION NO.	0/2
OF	16		

IF SPRINKLER CONTRACTOR USES PLASTIC PIPING THEN THE FOLLOWING IS APPLICABLE.

NOTE: CONTRACTOR TO INSTALL PLASTIC PIPING AS PER MANUFACTURE'S SPECIFICATIONS INCLUDING EXPANSION LOOP.

O.B.C. SECTION 3.2.5.14 COMBUSTIBLE SPRINKLER PIPING

- (1) COMBUSTIBLE SPRINKLER PIPING SHALL BE USED ONLY FOR WET SYSTEMS IN RESIDENTIAL OCCUPANCIES AND OTHER LIGHT HAZARD OCCUPANCIES. (SEE APPENDIX A.)
- (2) COMBUSTIBLE SPRINKLER PIPING SHALL MEET THE REQUIREMENTS OF ULC/ORD-199P-M, "COMBUSTIBLE PIPING FOR SPRINKLER SYSTEMS".
- (3) COMBUSTIBLE SPRINKLER PIPING SHALL BE SEPARATED FROM THE AREA SERVED BY THE SPRINKLER SYSTEM AND FROM ANY OTHER FIRE COMPARTMENT BY CEILINGS, WALLS, OR SOFFITS CONSISTING AS A MINIMUM:
 - (A) LATH AND PLASTER,
 - (B) GYPSUM BOARD NOT LESS THAN 9.5 MM (3/8 IN) THICK
 - (C) PLYWOOD NOT LESS THAN 13 MM (1/2 IN) THICK OR
 - (D) A SUSPENDED MEMBRANE CEILING WITH
 - (i) STEEL SUSPENSION GRID, AND
 - (ii) LATH-IN PANELS OR TILES HAVING A MASS NOT LESS THAN 1.7 KG/SQUARE METRE (0.35 LB/SQUARE FOOT)
- (4) IF COMBUSTIBLE SPRINKLER PIPING IS LOCATED ABOVE A CEILING, AN OPENING THROUGH THE CEILING THAT IS NOT PROTECTED IN CONFORMANCE WITH SENTENCE (3) SHALL BE LOCATED SO THAT THE DISTANCE BETWEEN THE EDGE OF THE OPENING AND THE NEAREST SPRINKLER IS NOT MORE THAN 300 MM (11 3/4").
- (5) THE PROTECTION REQUIRED BY SENTENCES (3) AND (4) IS PERMITTED TO BE WAIVED WHERE COMBUSTIBLE SPRINKLER PIPING HAS BEEN TESTED IN CONFORMANCE WITH ULC/ORD-C199P-M, "COMBUSTIBLE PIPING FOR SPRINKLER SYSTEMS", AND HAS BEEN SHOWN TO MEET THE REQUIREMENTS IN THAT DOCUMENT WITHOUT ADDITIONAL PROTECTION.

GENERAL NOTES

- NOTE 1:**
IN BUILDINGS SPRINKLERED IN ACCORDANCE WITH NFPA 13, CLOSETS LESS THAN 12 SQ.FT. IN AREA IN INDIVIDUAL DWELLING UNITS SHALL NOT BE REQUIRED TO BE SPRINKLERED. CLOSETS THAT CONTAIN EQUIPMENT SUCH AS WASHERS, DRYERS, FURNACES, OR WATER HEATERS SHALL BE SPRINKLERED REGARDLESS OF SIZE. AS PER NFPA-13 (2007) CLAUSE 21.20.19.2.1
- NOTE 2:**
SPRINKLERS SHALL NOT BE REQUIRED IN BATHROOMS THAT ARE LOCATED WITHIN DWELLING UNITS, THAT DO NOT EXCEED 55 SQ.FT. IN AREA AND THAT HAVE WALLS AND CEILINGS OF NONCOMBUSTIBLE OR LIMITED-COMBUSTIBLE MATERIALS WITH A 15-MINUTE THERMAL BARRIER RATING, INCLUDING THE WALLS AND CEILINGS BEHIND ANY SHOWER ENCLOSURE OR TUB. AS PER NFPA-13 (2007) CLAUSE 8.15.B.1.1
- NOTE 3:**
WHERE SIDEWALL SPRINKLER IS INSTALLED AT SOFFIT (BULKHEAD) EXCEEDING MORE THAN 8" IN WIDTH, PENDENT SPRINKLERS SHALL BE INSTALLED UNDER THE SOFFIT (BULKHEAD).
- NOTE 4:**
RESIDENTIAL SIDEWALL SPRINKLERS SHALL BE PERMITTED TO BE INSTALLED IN THE FACE OF A SOFFIT LOCATED DIRECTLY OVER CABINETS WITHOUT REQUIRING ADDITIONAL SPRINKLERS BELOW THE SOFFIT OR CABINETS WHERE THE SOFFIT DOES NOT PROJECT HORIZONTALLY MORE THAN 12" FROM THE WALL.
- NOTE 5:**
IF CPVC PIPE IS USED, CONTRACTOR TO PROVIDE "EXPANSION OFFSET LOOP" ON STRAIGHT RUNS EXCEEDING 100 FT IN LENGTH.
- NOTE 6:**
ANY FIRE STOPPING, ACOUSTIC SEALANT AND MATERIALS USED IN THIS PROJECT WHICH COME IN CONTACT WITH CPVC SPRINKLER PIPING IS TO BE COMPATIBLE WITH CPVC PIPING.
- NOTE 7:**
SPRINKLERS TO BE A MINIMUM 3"-0" FROM EDGE OF ALL SURFACE MOUNTED LIGHT FIXTURE.

SPRINKLER LAYOUT BASED ON BULKHEADS BEING MAXIMUM 12" DEEP. ADDITIONAL SIDEWALL SPRINKLERS MAY BE REQUIRED IF BULKHEAD DEPTH EXCEEDS 12".



PROTECTION AREA PER RESIDENTIAL CONCEALED PENDENT SPRINKLER SHALL NOT EXCEED 300 SQ.FT. MAX. SPACING IS 20 FT. PROTECTION AREA PER RESIDENTIAL CONCEALED SIDEWALL SPRINKLER SHALL NOT EXCEED 256 SQ.FT. (16 FT. X 16 FT.)

CONTRACTOR SHALL COORDINATE WITH LIGHTING, DIFFUSER & INTERIOR DESIGN DRAWINGS PRIOR TO INSTALLATION OF SPRINKLER SYSTEM.

THE HEIGHT OF THE BULKHEAD NOT TO EXCEED 12" AS PER ARCHITECTURAL DRAWING.

SPRINKLER CONTROL VALVE STATION

- 1 STANDARD SHUT OFF VALVE
 - 2 2" CHECK VALVE
 - 3 FLOW SWITCH
 - 4 1/4" DRAIN GLOBE VALVE
 - 5 1" INSPECTOR TEST VALVE SIGHT GLASS
 - 6 UNION WITH CORROSION RESISTANT ORIFICE GIVING FLOW EQUIVALENT TO SMALLEST SPRINKLER ORIFICE IN SYSTEM.
 - 7 1/2" RELIEF VALVE (SET AT 175 PS)
- WHERE AUXILIARY AIR RESERVOIRS ARE INSTALLED TO ABSORB PRESSURE INCREASES, A RELIEF VALVE SHALL BE NOT REQUIRED.
- FLOW SWITCH & SHUT OFF VALVE OR FLOW SWITCH TO BE SUPERSEDED AND CONNECTED TO FIRE ALARM SYSTEM.

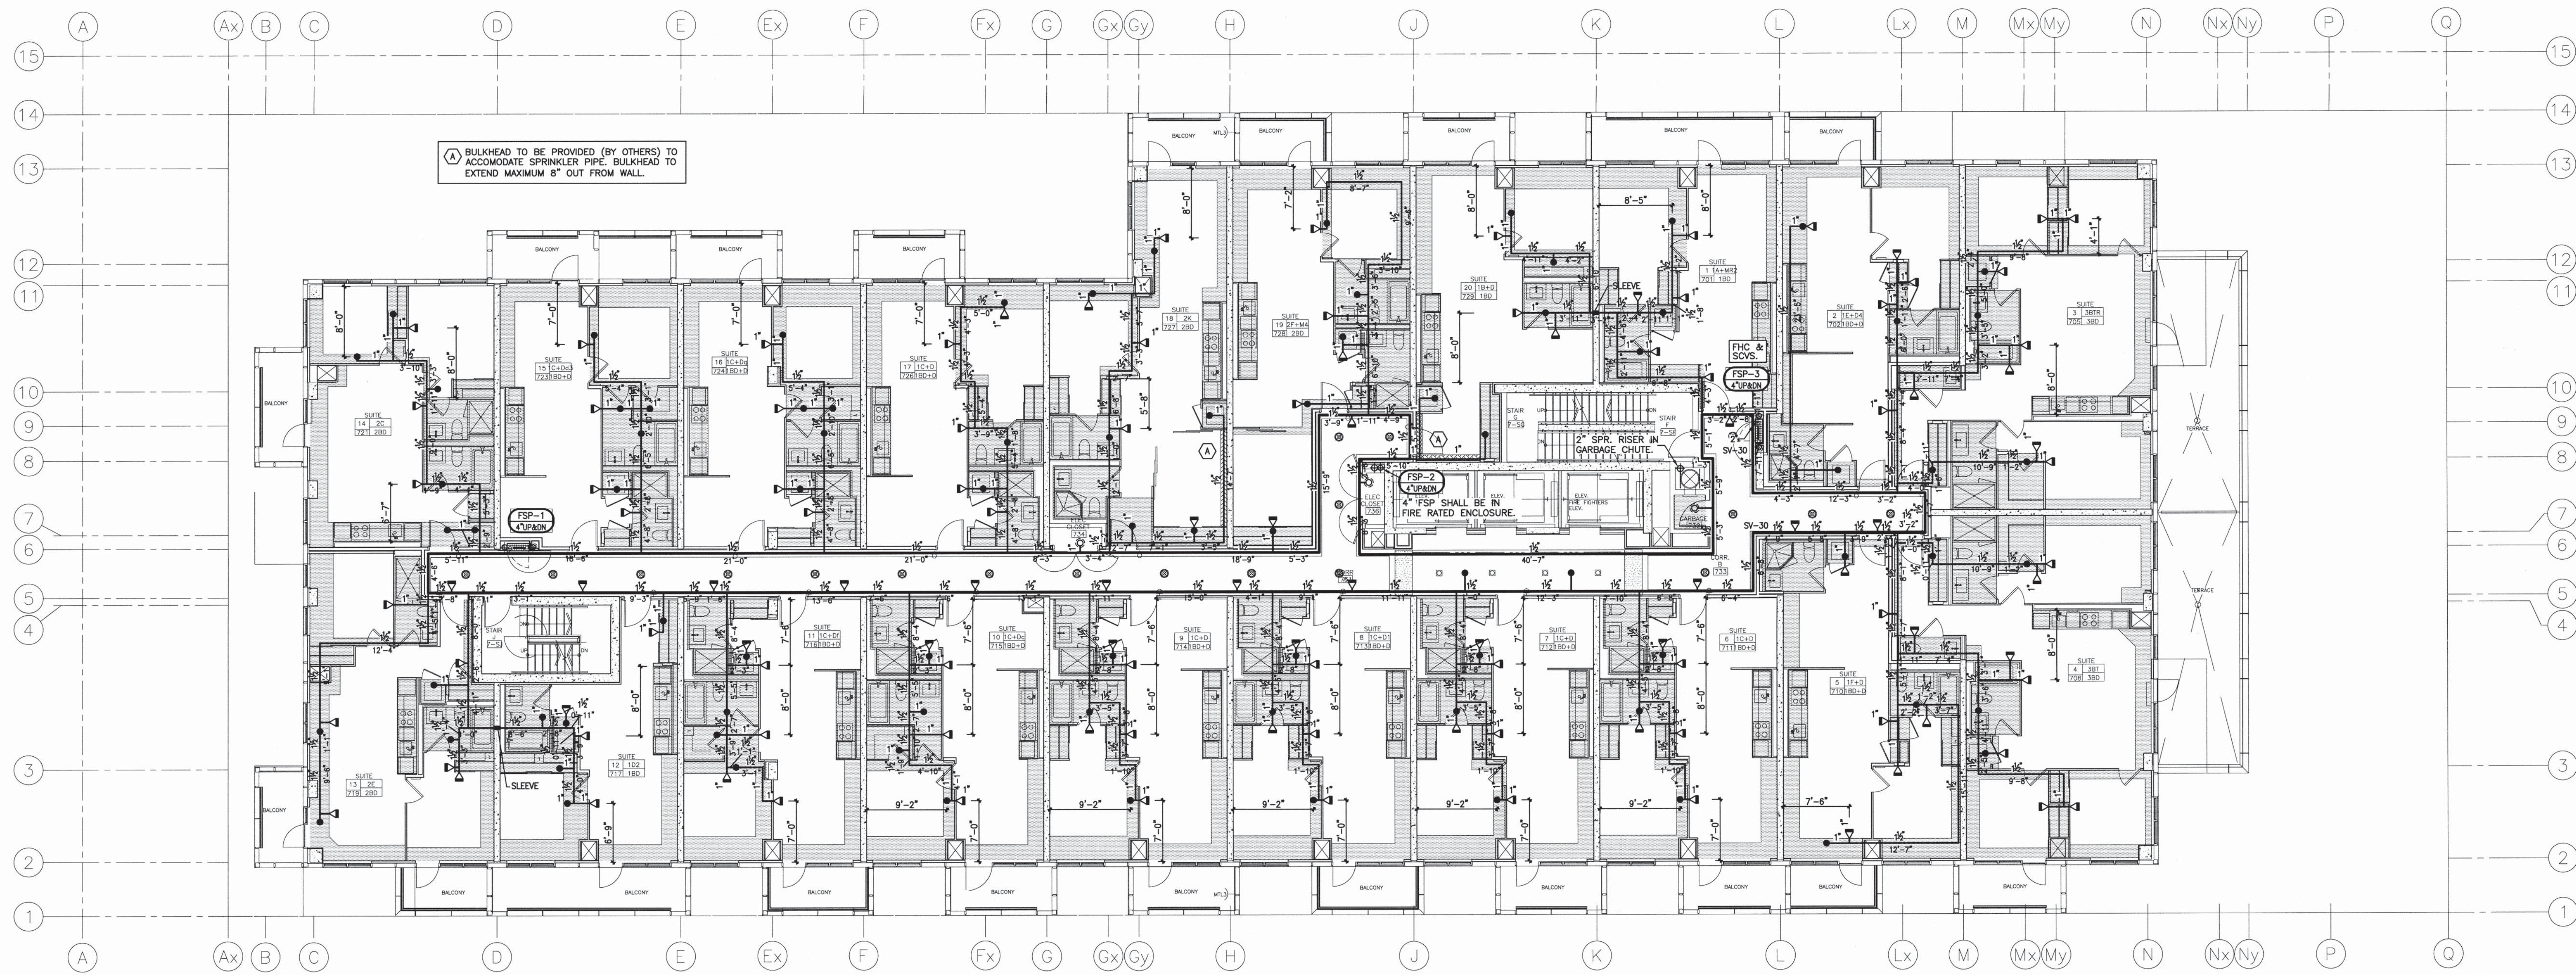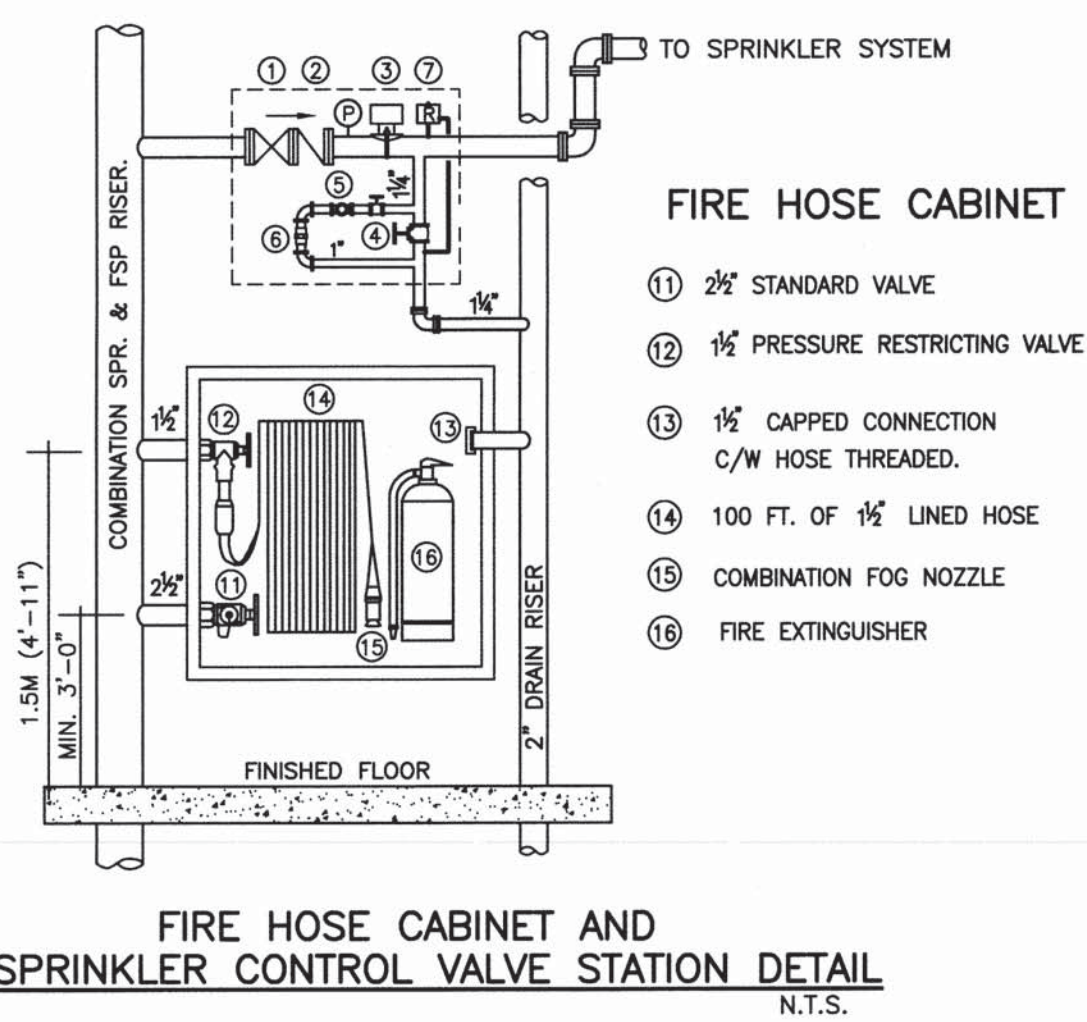

▲ BULKHEAD TO BE PROVIDED (BY OTHERS) TO ACCOMMODATE SPRINKLER PIPE BULKHEAD TO EXTEND MAXIMUM 8" OUT FROM WALL.

4" FSP SHALL BE IN FIRE RATED ENCLOSURE.

REVISIONS

NO.	REVISION	DATE
2.	RE-ISSUED FOR PERMIT.	AUG. 15 2014
3.	REVISED LAYOUT AS PER PEOPLE ARCHITECTS COMMENTS DATED IN JUN.08, 2015	JUN. 08 2015
5.	ISSUED FOR CONSTRUCTION.	OCT. 2 2015

NOTES

- THIS DRAWING ASSOCIATED CALCULATIONS AND SPECIFICATIONS ARE THE PROPERTY OF THE DESIGNER AND MUST BE RETURNED AT THE COMPLETION OF THE WORK OR UPON REQUEST.
- DIMENSIONS TAKE PRECEDENCE OVER DIMENSIONS.
- THE SPRINKLER SYSTEM IS TO BE INSTALLED AS PER N.F.P.A. STANDARD # 13 AND U.L.C. STANDARDS.
- CONTRACTOR TO INCLUDE FOR OFFSETS IN BRANCH LINES AND MAINS WHERE REQUIRED.
- ALL MATERIALS TO BE U.L.C. LISTED AND APPROVED BY LOCAL AUTHORITIES.
- UNDERGROUND WATERMAN TO BE INSTALLED ACCORDING TO LOCAL AUTHORITIES AND INSURANCE CO. STANDARDS.
- (IF APPLICABLE)
- INSTALL HIGH TEMPERATURE HEADS WHERE REQUIRED AS PER N.F.P.A. STANDARD # 13.
- ALL INTERIOR GRID BRANCH LINE MEASUREMENTS ARE GIVEN AS CENTER LINE TO CENTER LINE DIMENSIONS.
- (SEE L10 PLAN)
- ALL OTHER BRANCH LINE MEASUREMENTS ARE GIVEN AS CENTER LINE TO CENTER LINE DIMENSIONS.
- ALL MAIN MEASUREMENTS ARE GIVEN AS CENTER LINE TO CENTER LINE DIMENSIONS. (ON WALL POINT)
- (IF APPLICABLE)
- DENOTES DISTANCE IN INCHES FROM CENTER LINE OF PIPE TO UNDERSIDE OF CEILING.
- RIN DENOTES RISER NIPPLE ON SOURCE DOWN.
- ALL SUPPLY DOWN PRESSURE MONITORING SWITCHES AND LOW PRESSURE MONITORING SWITCHES TO BE CONNECTED TO FIRE ALARM SYSTEM (IF P.A.S. IS INSTALLED)
- CONTRACTOR TO VISIT SITE TO DETERMINE EXACT LOCATION AND ELEVATION OF MAINS TO BE INSTALLED AS INDICATED ON DRAWINGS. ANY MAJOR DISCREPANCIES TO BE REPORTED TO THE DESIGNER PRIOR TO FABRICATION AND INSTALLATION.

OWNER (OR OTHERS) TO PROVIDE ADEQUATE HEAT IN ALL AREAS OF BUILDING SUBJECT TO FREEZING THAT ARE PROTECTED BY A WET TYPE SPRINKLER SYSTEM.


ALL GLASS BUILD TYPE SPRINKLERS TO BE OF RECENT ISSUE. MANUFACTURE DATE OF AT LEAST YEAR 2013.

SYMBOL	DESCRIPTION	QUANTITY
○	1/2" 155°F STANDARD COVERAGE CONCEALED PENDENT (K=5.6) Q/R	00
●	1/2" 155°F STANDARD COVERAGE UPRIGHT (K=5.6) Q/R	3
○	1/2" 155°F RESIDENTIAL CONCEALED PENDENT (K=4.9)	83
●	1/2" 155°F RESIDENTIAL CONCEALED SIDEWALL (K=4.0)	113
□	FIRE HOSE RACK - 100 FT OF 1 1/2" LINED HOSE C/W COMBINATION FOG NOZZLE	2

DESIGN CRITERIA

DESIGNED FOR RESIDENTIAL SPRINKLERS AS PER NFPA 13 SECTION 11.3.1 (2010 ED.).
DESIGN AREA TO INCLUDE THE FOUR ADJACENT SPRINKLERS THAT PRODUCE THE GREATEST HYDRAULIC DEMAND.
THE REQUIRED DISCHARGE FROM EACH SPRINKLER SHALL BE THE GREATER OF THE FOLLOWING:
(1) MIN. FLOW RATES INDICATED IN SPR. LISTING.
(2) MIN. 0.10 GPM/SQ.FT. OVER DESIGN AREA.

NORTH

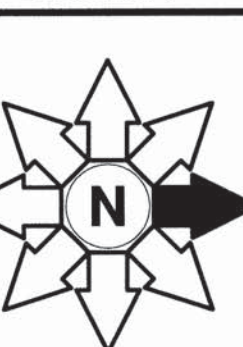

STAMP



TRIDEL
4800 DUFFERIN STREET
TORONTO ONTARIO

PROJECT
SQ ALEXANDRA PARK
BLOCK 11
38 CAMERON ST. TORONTO

DWG TITLE
7TH FLOOR
SPRINKLER & STANDPIPE SYSTEM

DATE
JULY 2014

SCALE
1:100

DWN BY
H.W.

ISSUED FOR REVISION NO.

PROJECT NO.
14-10224

DWG NO.
SP-10

OF 16

IF SPRINKLER CONTRACTOR USES PLASTIC PIPING THEN THE FOLLOWING IS APPLICABLE.

NOTE: CONTRACTOR TO INSTALL PLASTIC PIPING AS PER MANUFACTURER'S SPECIFICATIONS INCLUDING EXPANSION LOOP.

O.B.C. SECTION 3.2.5.14 COMBUSTIBLE SPRINKLER PIPING

- (1) COMBUSTIBLE SPRINKLER PIPING SHALL BE USED ONLY FOR WET SYSTEMS IN RESIDENTIAL OCCUPANCIES AND OTHER LIGHT HAZARD OCCUPANCIES. (SEE APPENDIX A.)
- (2) COMBUSTIBLE SPRINKLER PIPING SHALL MEET THE REQUIREMENTS OF ULC/ORD-199P-M, "COMBUSTIBLE PIPING FOR SPRINKLER SYSTEMS".
- (3) COMBUSTIBLE SPRINKLER PIPING SHALL BE SEPARATED FROM THE AREA SERVED BY THE SPRINKLER SYSTEM AND FROM ANY OTHER FIRE COMPARTMENT BY CEILINGS, WALLS, OR SOFFITS CONSISTING AS A MINIMUM:
 - (A) LATH AND PLASTER,
 - (B) GYPSUM BOARD NOT LESS THAN 9.5 MM (3/8 IN) THICK
 - (C) PLYWOOD NOT LESS THAN 13 MM (1/2 IN) THICK OR
 - (D) A SUSPENDED MEMBRANE CEILING WITH
 - (i) STEEL SUSPENSION GRID, AND
 - (ii) LATH-IN PANELS OR TILES HAVING A MASS NOT LESS THAN 1.7 KG/SQUARE METRE (0.35 LB/SQUARE FOOT)
- (4) IF COMBUSTIBLE SPRINKLER PIPING IS LOCATED ABOVE A CEILING, AN OPENING THROUGH THE CEILING THAT IS NOT PROTECTED IN CONFORMANCE WITH SENTENCE (3) SHALL BE LOCATED SO THAT THE DISTANCE BETWEEN THE EDGE OF THE OPENING AND THE NEAREST SPRINKLER IS NOT MORE THAN 300 MM (11 3/4").
- (5) THE PROTECTION REQUIRED BY SENTENCES (3) AND (4) IS PERMITTED TO BE WAIVED WHERE COMBUSTIBLE SPRINKLER PIPING HAS BEEN TESTED IN CONFORMANCE WITH ULC/ORD-C199P-M, "COMBUSTIBLE PIPING FOR SPRINKLER SYSTEMS", AND HAS BEEN SHOWN TO MEET THE REQUIREMENTS IN THAT DOCUMENT WITHOUT ADDITIONAL PROTECTION.

GENERAL NOTES

- NOTE 1:**
IN BUILDINGS SPRINKLERED IN ACCORDANCE WITH NFPA 13, CLOSETS LESS THAN 12 SQ.FT. IN AREA IN INDIVIDUAL DWELLING UNITS SHALL NOT BE REQUIRED TO BE SPRINKLERED. CLOSETS THAT CONTAIN EQUIPMENT SUCH AS WASHERS, DRYERS, FURNACES, OR WATER HEATERS SHALL BE SPRINKLERED REGARDLESS OF SIZE.
AS PER NFPA-13 (2007) CLAUSE 21.20.19.2.1
- NOTE 2:**
SPRINKLERS SHALL NOT BE REQUIRED IN BATHROOMS THAT ARE LOCATED WITHIN DWELLING UNITS, THAT DO NOT EXCEED 55 SQ.FT. IN AREA, AND THAT HAVE WALLS AND CEILINGS OF NONCOMBUSTIBLE OR LIMITED-COMBUSTIBLE MATERIALS WITH A 15-MINUTE THERMAL BARRIER RATING, INCLUDING THE WALLS AND CEILINGS BEHIND ANY SHOWER ENCLOSURE OR TUB.
AS PER NFPA-13 (2007) CLAUSE 8.15.8.1.1
- NOTE 3:**
WHERE SIDEWALL SPRINKLER IS INSTALLED AT SOFFIT (BULKHEAD) EXCEEDING MORE THAN 8" IN WIDTH, PENDENT SPRINKLERS SHALL BE INSTALLED UNDER THE SOFFIT (BULKHEAD).
- NOTE 4:**
RESIDENTIAL SIDEWALL SPRINKLERS SHALL BE PERMITTED TO BE INSTALLED IN THE FACE OF A SOFFIT LOCATED DIRECTLY OVER CABINETS WITHOUT REQUIRING ADDITIONAL SPRINKLERS BELOW THE SOFFIT OR CABINETS WHERE THE SOFFIT DOES NOT PROJECT HORIZONTALLY MORE THAN 12" FROM THE WALL.
- NOTE 5:**
IF CPVC PIPE IS USED, CONTRACTOR TO PROVIDE "EXPANSION OFFSET LOOP" ON STRAIGHT RUNS EXCEEDING 100 FT IN LENGTH.
- NOTE 6:**
ANY FIRE STOPPING, ACOUSTIC SEALANT AND MATERIALS USED IN THIS PROJECT WHICH COME IN CONTACT WITH CPVC SPRINKLER PIPING IS TO BE COMPATIBLE WITH CPVC PIPING.
- NOTE 7:**
SPRINKLERS TO BE A MINIMUM 3"-0" FROM EDGE OF ALL SURFACE MOUNTED LIGHT FIXTURE.

SPRINKLER LAYOUT BASED ON BULKHEADS BEING MAXIMUM 12" DEEP. ADDITIONAL SIDEWALL SPRINKLERS MAY BE REQUIRED IF BULKHEAD DEPTH EXCEEDS 12".


PROTECTION AREA PER RESIDENTIAL CONCEALED PENDENT SPRINKLER SHALL NOT EXCEED 300 SQ.FT. MAX. SPACING IS 20 FT. PROTECTION AREA PER RESIDENTIAL CONCEALED SIDEWALL SPRINKLER SHALL NOT EXCEED 256 SQ.FT. (16 FT. X 16 FT.)

CONTRACTOR SHALL COORDINATE WITH LIGHTING, DIFFUSER & INTERIOR DESIGN DRAWINGS PRIOR TO INSTALLATION OF SPRINKLER SYSTEM.


THE HEIGHT OF THE BULKHEAD NOT TO EXCEED 12" AS PER ARCHITECTURAL DRAWING.

SPRINKLER CONTROL VALVE STATION

- 1 STANDARD SHUT OFF VALVE
 - 2 2" CHECK VALVE
 - 3 FLOW SWITCH
 - 4 1/2" DRAIN GLOBE VALVE
 - 5 1" INSPECTOR TEST VALVE SIGHT GLASS
 - 6 UNION WITH CORROSION RESISTANT ORIFICE GIVING FLOW EQUIVALENT TO SMALLEST SPRINKLER ORIFICE IN SYSTEM.
 - 7 1/2" RELIEF VALVE (SET AT 175 PS)
- WHERE AUXILIARY AIR RESERVOIRS ARE INSTALLED TO ABSORB PRESSURE INCREASES, A RELIEF VALVE SHALL BE NOT REQUIRED.
- FLOW SWITCH & SHUT OFF VALVE OR FRY TO BE SUPERVISED AND CONNECTED TO FIRE ALARM SYSTEM.

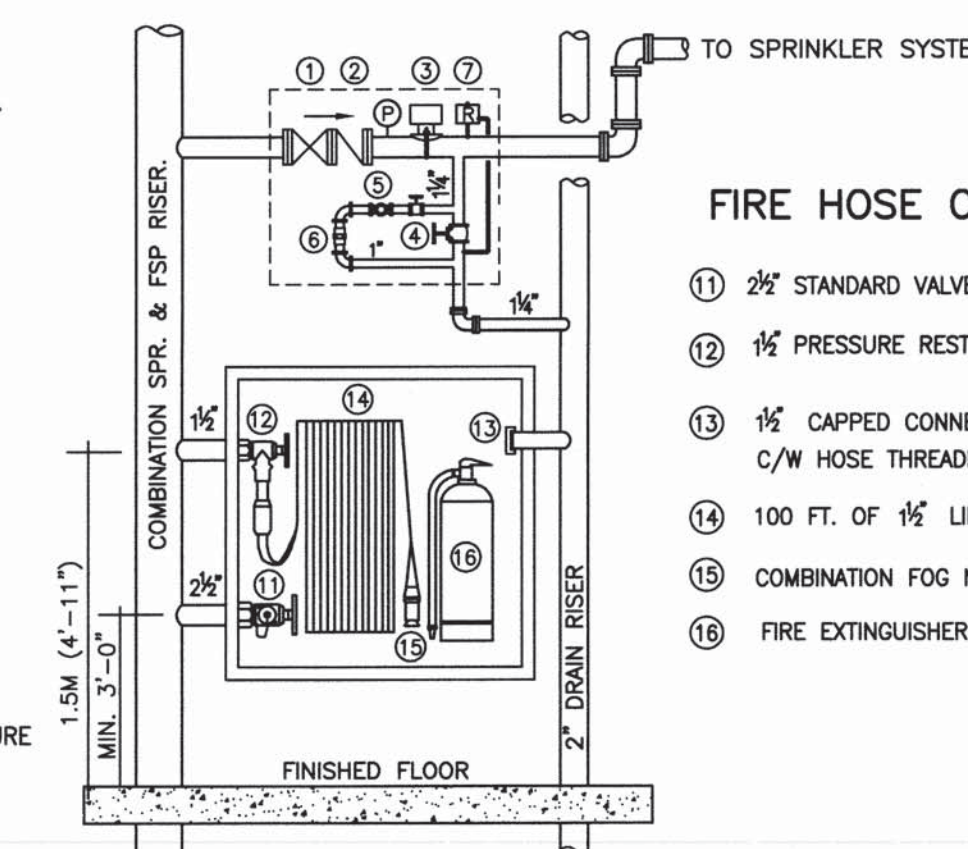

- FIRE HOSE CABINET**
- 1 2" STANDARD VALVE
 - 2 1/2" PRESSURE RESTRICTING VALVE
 - 3 1/2" CAPPED CONNECTION C/W HOSE THREADED.
 - 4 100 FT. OF 1/2" LINED HOSE
 - 5 COMBINATION FOG NOZZLE
 - 6 FIRE EXTINGUISHER

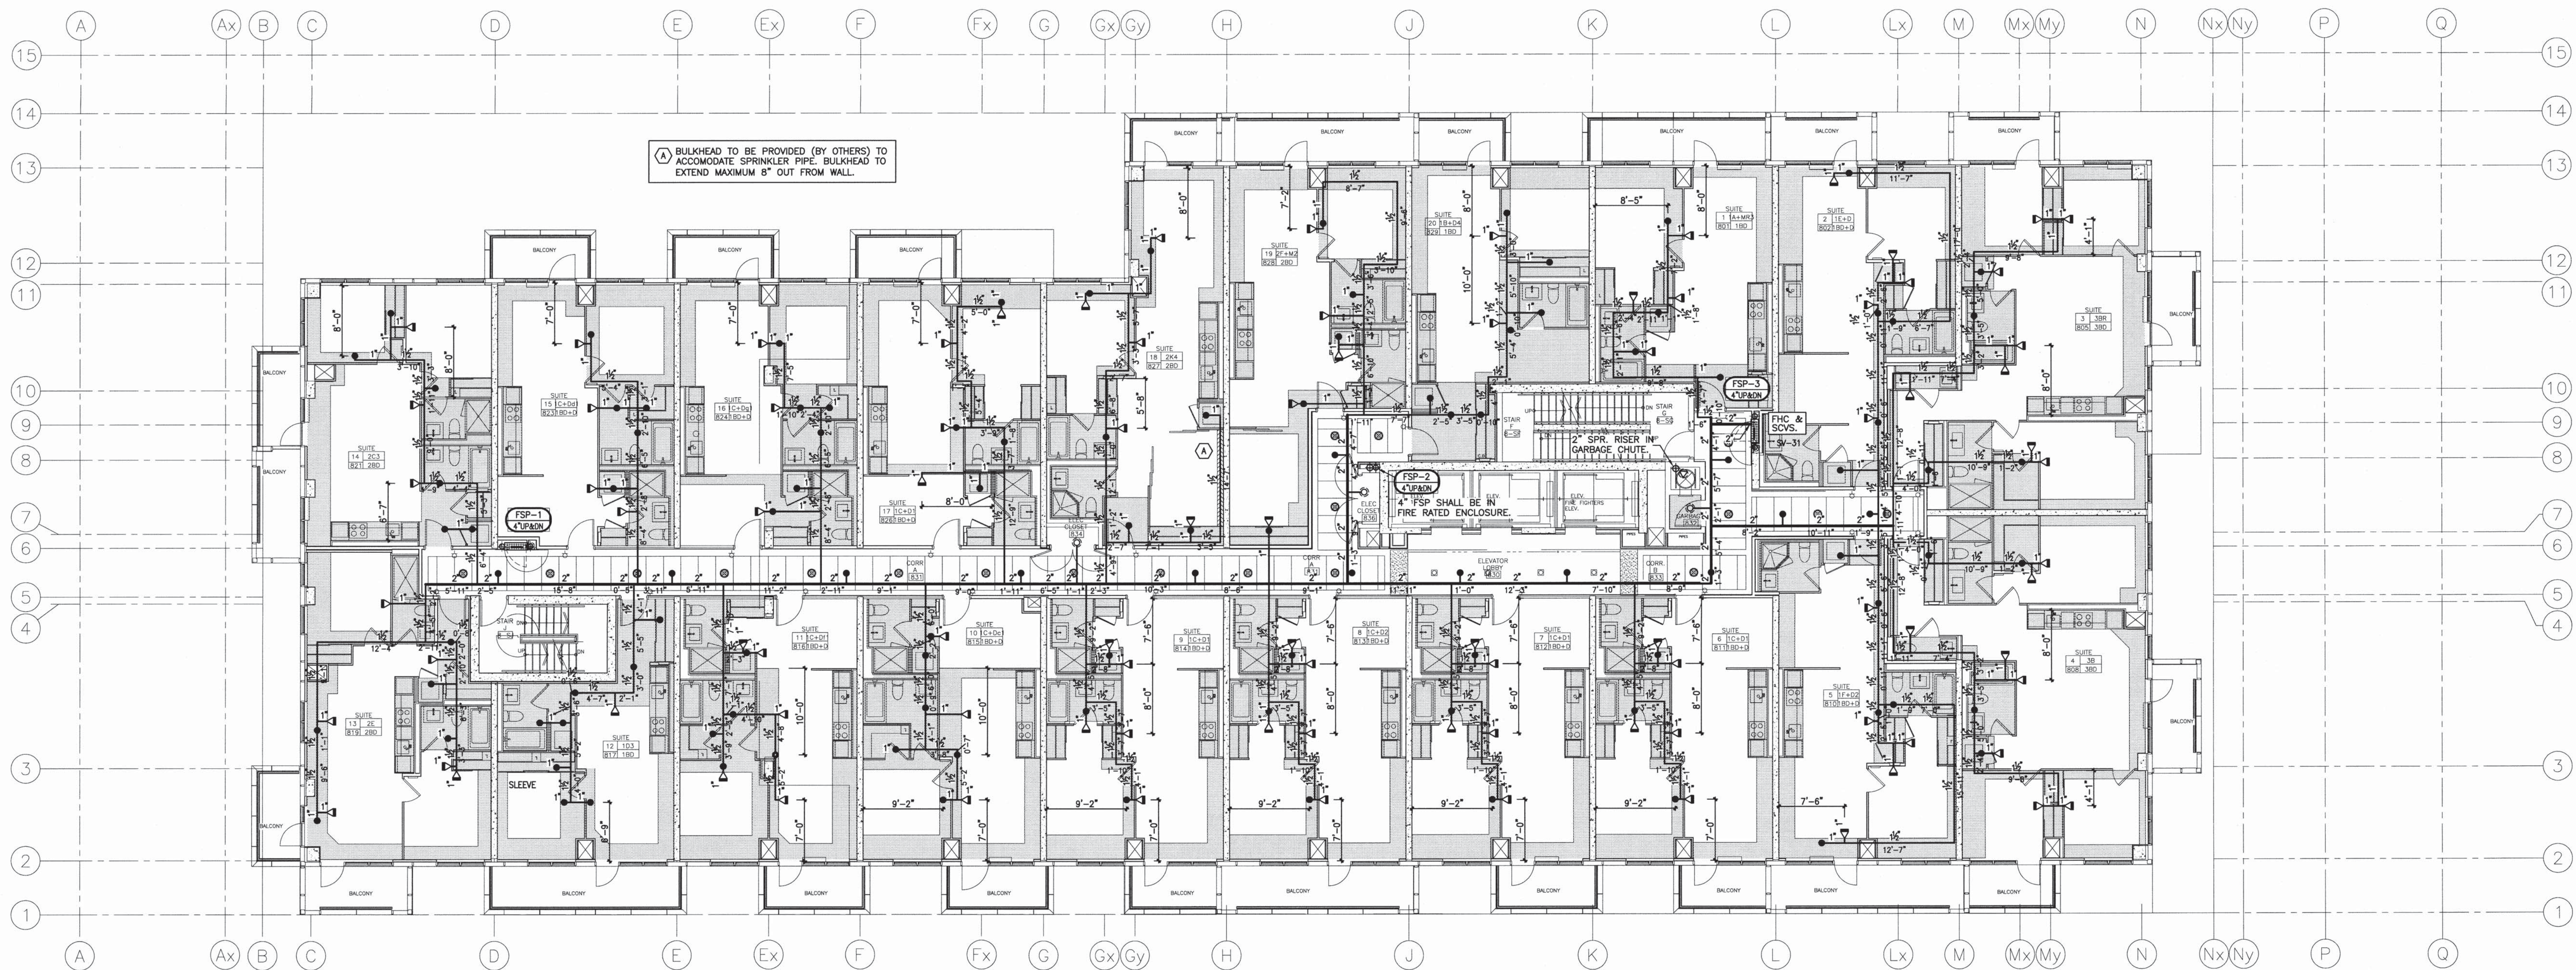

REVISIONS	DATE	DESCRIPTION
2.	AUG. 15 2014	RE-ISSUED FOR PERMIT.
3.	JUN. 08 2015	REVISED LAYOUT AS PER TEEPLE ARCHITECTS COMMENTS DATED IN JUN.08, 2015
5.	OCT. 2 2015	ISSUED FOR CONSTRUCTION.

NOTES
<p>--- THIS DRAWING ASSOCIATED CALCULATIONS AND SPECIFICATIONS ARE THE PROPERTY OF THE DESIGNER AND MUST BE RETURNED AT THE COMPLETION OF THE WORK OR UPON REQUEST.</p> <p>--- DIMENSIONS TAKE PRECEDENCE OVER SCALE.</p> <p>--- THE SPRINKLER SYSTEM IS TO BE INSTALLED AS PER N.F.P.A. STANDARD (IF APPLICABLE).</p> <p>--- CONTRACTOR TO INCLUDE FOR OFFSETS IN BRANCH LINES AND MAINS WHERE APPLICABLE.</p> <p>--- ALL MATERIALS TO BE U.L.C. LISTED AND APPROVED BY LOCAL AUTHORITIES.</p> <p>--- UNDERGROUND WATERMAIN TO BE INSTALLED ACCORDING TO LOCAL AUTHORITIES AND INSURANCE CO. STANDARDS (IF APPLICABLE).</p> <p>--- INSTALL-HIGH TEMPERATURE HEADS WHERE REQUIRED AS PER N.F.P.A. STANDARD # 13.</p> <p>--- ALL INTERIOR CIVIL BRANCH LINE MEASUREMENTS ARE GIVEN AS CENTER LINE TO CENTER LINE DIMENSIONS.</p> <p>--- ALL EXTERIOR CIVIL BRANCH LINE MEASUREMENTS ARE GIVEN AS CENTER LINE TO CENTER LINE DIMENSIONS.</p>

OWNER (OR OTHERS) TO PROVIDE ADEQUATE HEAT IN ALL AREAS OF BUILDING SUBJECT TO FREEZING THAT ARE PROTECTED BY A WET TYPE SPRINKLER SYSTEM.

ALL GLASS BULB TYPE SPRINKLERS TO BE OF RECENT ISSUE. MANUFACTURE DATE OF AT LEAST YEAR 2013.

S/R=STANDARD RESPONSE Q/R=QUICK RESPONSE C/W GUARD		
○	1/2" 155°F STANDARD COVERAGE CONCEALED PENDENT (K=5.6) Q/R	00
○	1/2" 155°F STANDARD COVERAGE UPRIGHT (K=5.6) Q/R	3
○	1/2" 155°F RESIDENTIAL CONCEALED PENDENT (K=4.9)	110
●	1/2" 155°F RESIDENTIAL CONCEALED SIDEWALL (K=4.0)	91
◁	1/2" 165°F STANDARD COVERAGE SIDEWALL (K=5.6) Q/R	1
■	FIRE HOSE BACK - 100 FT OF 1 1/2" LINED HOSE C/W COMBINATION FOG NOZZLE.	2



DESIGN CRITERIA

DESIGNED FOR RESIDENTIAL SPRINKLERS AS PER NFPA 13 SECTION 11.3.1 (2010 ED.).

DESIGN AREA TO INCLUDE THE FOUR ADJACENT SPRINKLERS THAT PRODUCE THE GREATEST HYDRAULIC DEMAND.

THE REQUIRED DISCHARGE FROM EACH SPRINKLER SHALL BE THE GREATER OF THE FOLLOWING:

- (1) MIN. FLOW RATES INDICATED IN SPR. LISTING.
- (2) MIN. 0.10 GPM/SQ.FT. OVER DESIGN AREA.

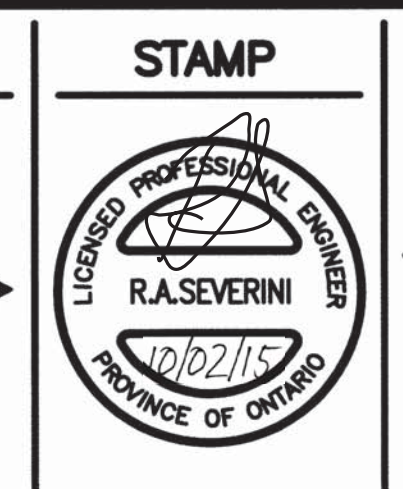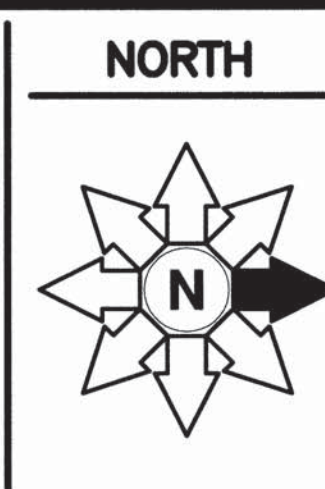

PROJECT	SQ ALEXANDRA PARK BLOCK 11 38 CAMERON ST. TORONTO
DWG TITLE	8TH FLOOR SPRINKLER & STANDPIPE SYSTEM

DATE	JULY 2014	PROJECT NO.	14-10224
SCALE	1:100	DWG NO.	SP-11
DWN BY	H.W.	ISSUED FOR REVISION NO.	02
DATE		PROJECT NO.	

IF SPRINKLER CONTRACTOR USES PLASTIC PIPING THEN THE FOLLOWING IS APPLICABLE.

NOTE: CONTRACTOR TO INSTALL PLASTIC PIPING AS PER MANUFACTURER'S SPECIFICATIONS INCLUDING EXPANSION LOOP.

O.B.C. SECTION 3.2.5.14 COMBUSTIBLE SPRINKLER PIPING

- COMBUSTIBLE SPRINKLER PIPING SHALL BE USED ONLY FOR WET SYSTEMS IN RESIDENTIAL OCCUPANCIES AND OTHER LIGHT HAZARD OCCUPANCIES. (SEE APPENDIX A)
- COMBUSTIBLE SPRINKLER PIPING SHALL MEET THE REQUIREMENTS OF ULC/ORD-199P-M, "COMBUSTIBLE PIPING FOR SPRINKLER SYSTEMS".
- COMBUSTIBLE SPRINKLER PIPING SHALL BE SEPARATED FROM THE AREA SERVED BY THE SPRINKLER SYSTEM AND FROM ANY OTHER FIRE COMPARTMENT BY CEILINGS, WALLS, OR SOFFITS CONSISTING AS A MINIMUM,
 - LATH AND PLASTER,
 - GYPSUM BOARD NOT LESS THAN 9.5 MM (3/8 IN) THICK
 - PLYWOOD NOT LESS THAN 13 MM (1/2 IN) THICK OR
 - A SUSPENDED MEMBRANE CEILING WITH
 - STEEL SUSPENSION GRID, AND
 - LATH-IN PANELS OR TILES HAVING A MASS NOT LESS THAN 1.7 KG/SQUARE METRE (0.35 LB/SQUARE FOOT)
- IF COMBUSTIBLE SPRINKLER PIPING IS LOCATED ABOVE A CEILING, AN OPENING THROUGH THE CEILING THAT IS NOT PROTECTED IN CONFORMANCE WITH SENTENCE (3) SHALL BE LOCATED SO THAT THE DISTANCE BETWEEN THE EDGE OF THE OPENING AND THE NEAREST SPRINKLER IS NOT MORE THAN 300 MM (11 3/4").
- THE PROTECTION REQUIRED BY SENTENCES (3) AND (4) IS PERMITTED TO BE WAIVED WHERE COMBUSTIBLE SPRINKLER PIPING HAS BEEN TESTED IN CONFORMANCE WITH ULC/ORD-C198P-M, "COMBUSTIBLE PIPING FOR SPRINKLER SYSTEMS", AND HAS BEEN SHOWN TO MEET THE REQUIREMENTS IN THAT DOCUMENT WITHOUT ADDITIONAL PROTECTION.

GENERAL NOTES

NOTE 1:
IN BUILDINGS SPRINKLERED IN ACCORDANCE WITH NFPA 13, CLOSETS LESS THAN 12 SQ.FT. IN AREA IN INDIVIDUAL DWELLING UNITS SHALL NOT BE REQUIRED TO BE SPRINKLERED. CLOSETS THAT CONTAIN EQUIPMENT SUCH AS WASHERS, DRYERS, FURNACES, OR WATER HEATERS SHALL BE SPRINKLERED REGARDLESS OF SIZE.
AS PER NFPA-13 (2007) CLAUSE 21.20.19.2.1

NOTE 2:
SPRINKLERS SHALL NOT BE REQUIRED IN BATHROOMS THAT ARE LOCATED WITHIN DWELLING UNITS, THAT DO NOT EXCEED 55 SQ.FT. IN AREA, AND THAT HAVE WALLS AND CEILINGS OF NONCOMBUSTIBLE OR LIMITED-COMBUSTIBLE MATERIALS WITH A 15-MINUTE THERMAL BARRIER RATING, INCLUDING THE WALLS AND CEILINGS BEHIND ANY SHOWER ENCLOSURE OR TUB.
AS PER NFPA-13 (2007) CLAUSE 8.15.8.1.1

NOTE 3:
WHERE SIDEWALL SPRINKLER IS INSTALLED AT SOFFIT (BULKHEAD) EXCEEDING MORE THAN 8" IN WIDTH, PENDENT SPRINKLERS SHALL BE INSTALLED UNDER THE SOFFIT (BULKHEAD).

NOTE 4:
RESIDENTIAL SIDEWALL SPRINKLERS SHALL BE PERMITTED TO BE INSTALLED IN THE FACE OF A SOFFIT LOCATED DIRECTLY OVER CABINETS WITHOUT REQUIRING ADDITIONAL SPRINKLERS BELOW THE SOFFIT OR CABINETS WHERE THE SOFFIT DOES NOT PROJECT HORIZONTALLY MORE THAN 12" FROM THE WALL.

NOTE 5:
IF CPVC PIPE IS USED, CONTRACTOR TO PROVIDE "EXPANSION OFFSET LOOP" ON STRAIGHT RUNS EXCEEDING 100 FT IN LENGTH.

NOTE 6:
ANY FIRE STOPPING, ACOUSTIC SEALANT AND MATERIALS USED IN THIS PROJECT WHICH COME IN CONTACT WITH CPVC SPRINKLER PIPING IS TO BE COMPATIBLE WITH CPVC PIPING



NOTE 7:
SPRINKLERS TO BE A MINIMUM 3"-0" FROM EDGE OF ALL SURFACE MOUNTED LIGHT FIXTURE.

SPRINKLER LAYOUT BASED ON BULKHEADS BEING MAXIMUM 12" DEEP. ADDITIONAL SIDEWALL SPRINKLERS MAY BE REQUIRED IF BULKHEAD DEPTH EXCEEDS 12".

PROTECTION AREA PER RESIDENTIAL CONCEALED PENDENT SPRINKLER SHALL NOT EXCEED 300 SQ.FT. MAX. SPACING IS 20 FT. PROTECTION AREA PER RESIDENTIAL CONCEALED SIDEWALL SPRINKLER SHALL NOT EXCEED 256 SQ.FT. (16 FT. X 16 FT.)

CONTRACTOR SHALL COORDINATE WITH LIGHTING, DIFFUSER & INTERIOR DESIGN DRAWINGS PRIOR TO INSTALLATION OF SPRINKLER SYSTEM.

THE HEIGHT OF THE BULKHEAD NOT TO EXCEED 12" AS PER ARCHITECTURAL DRAWING.

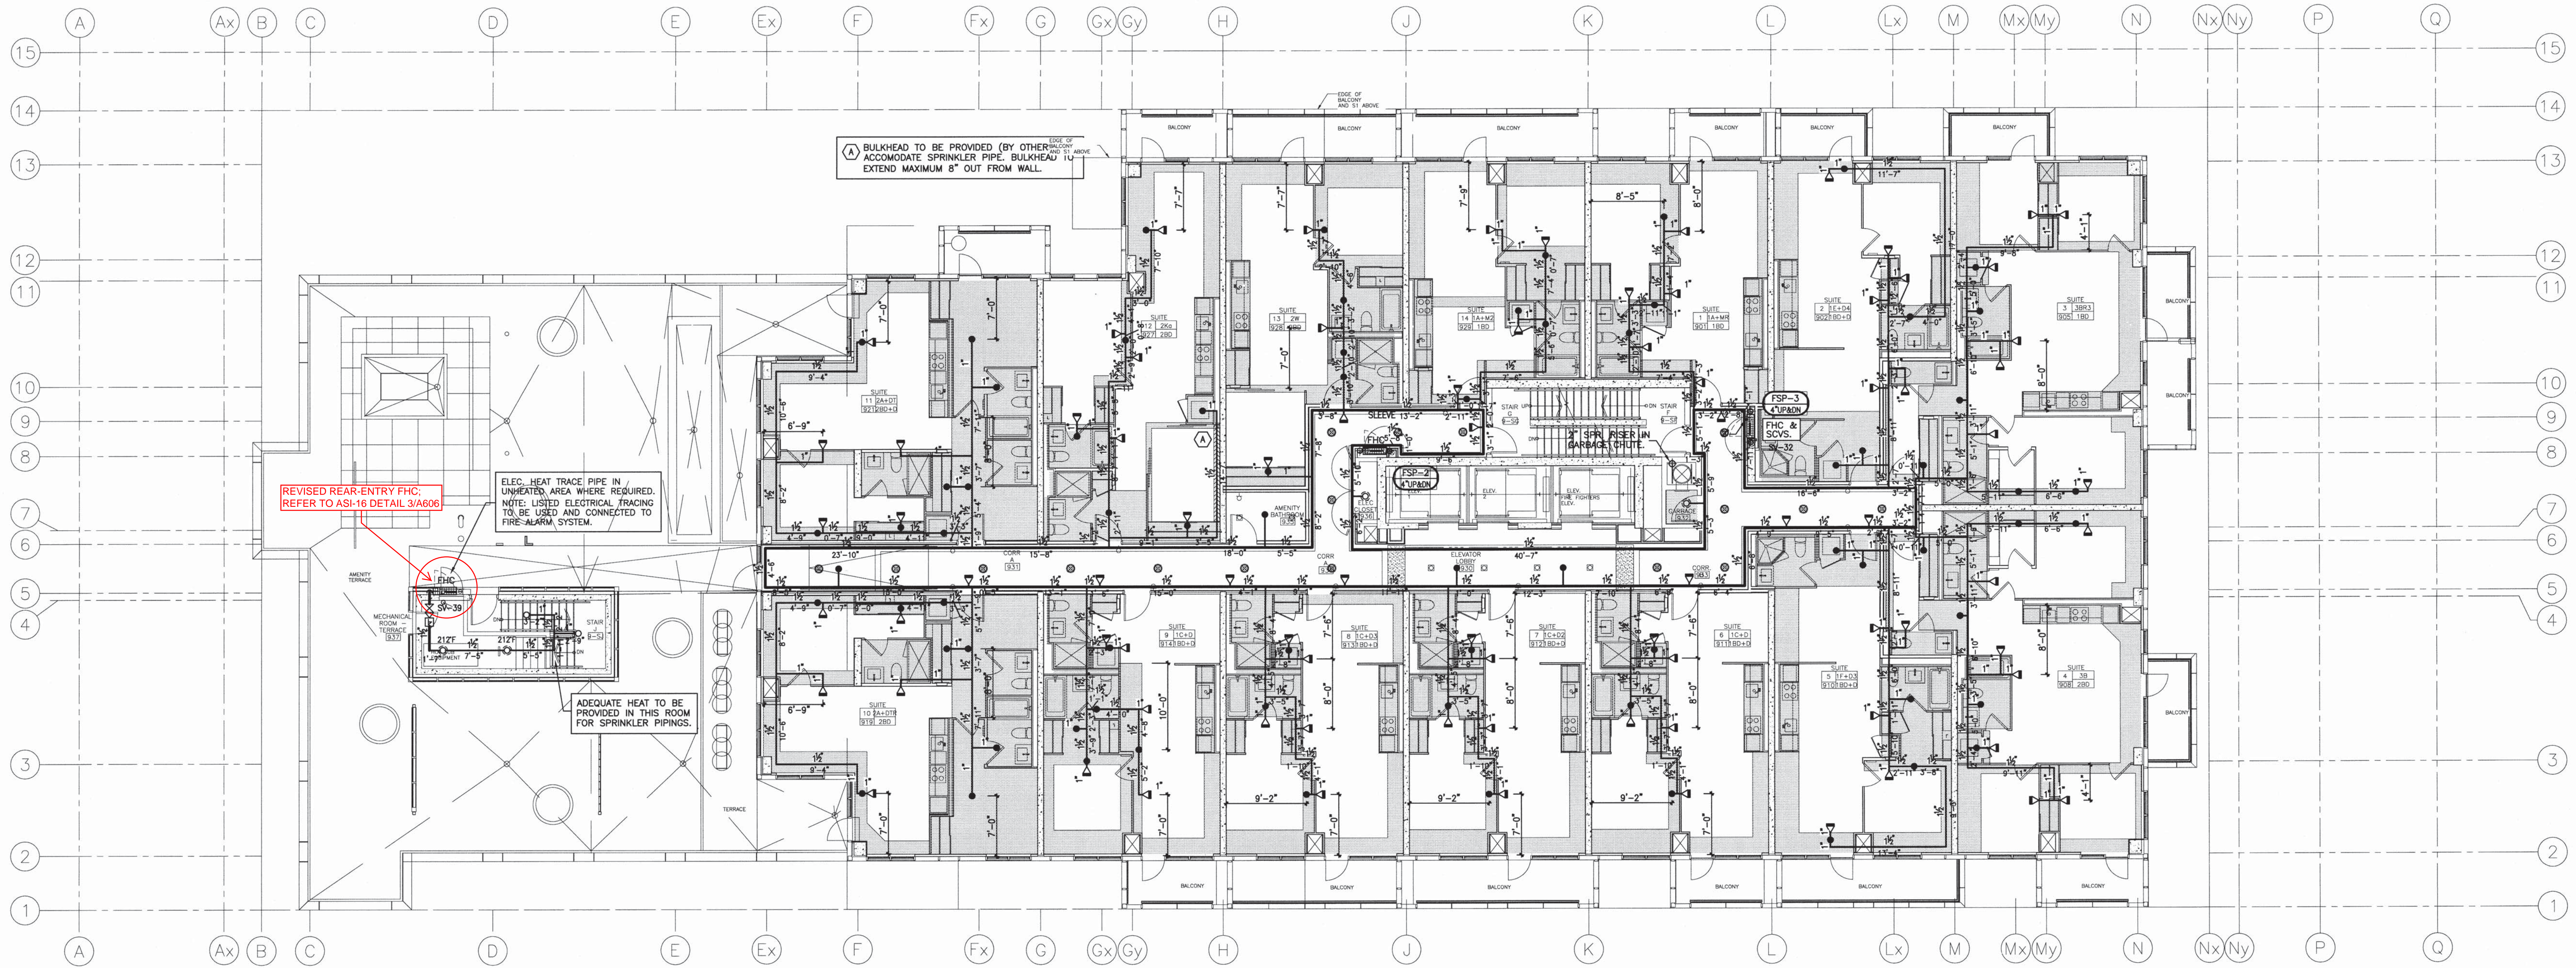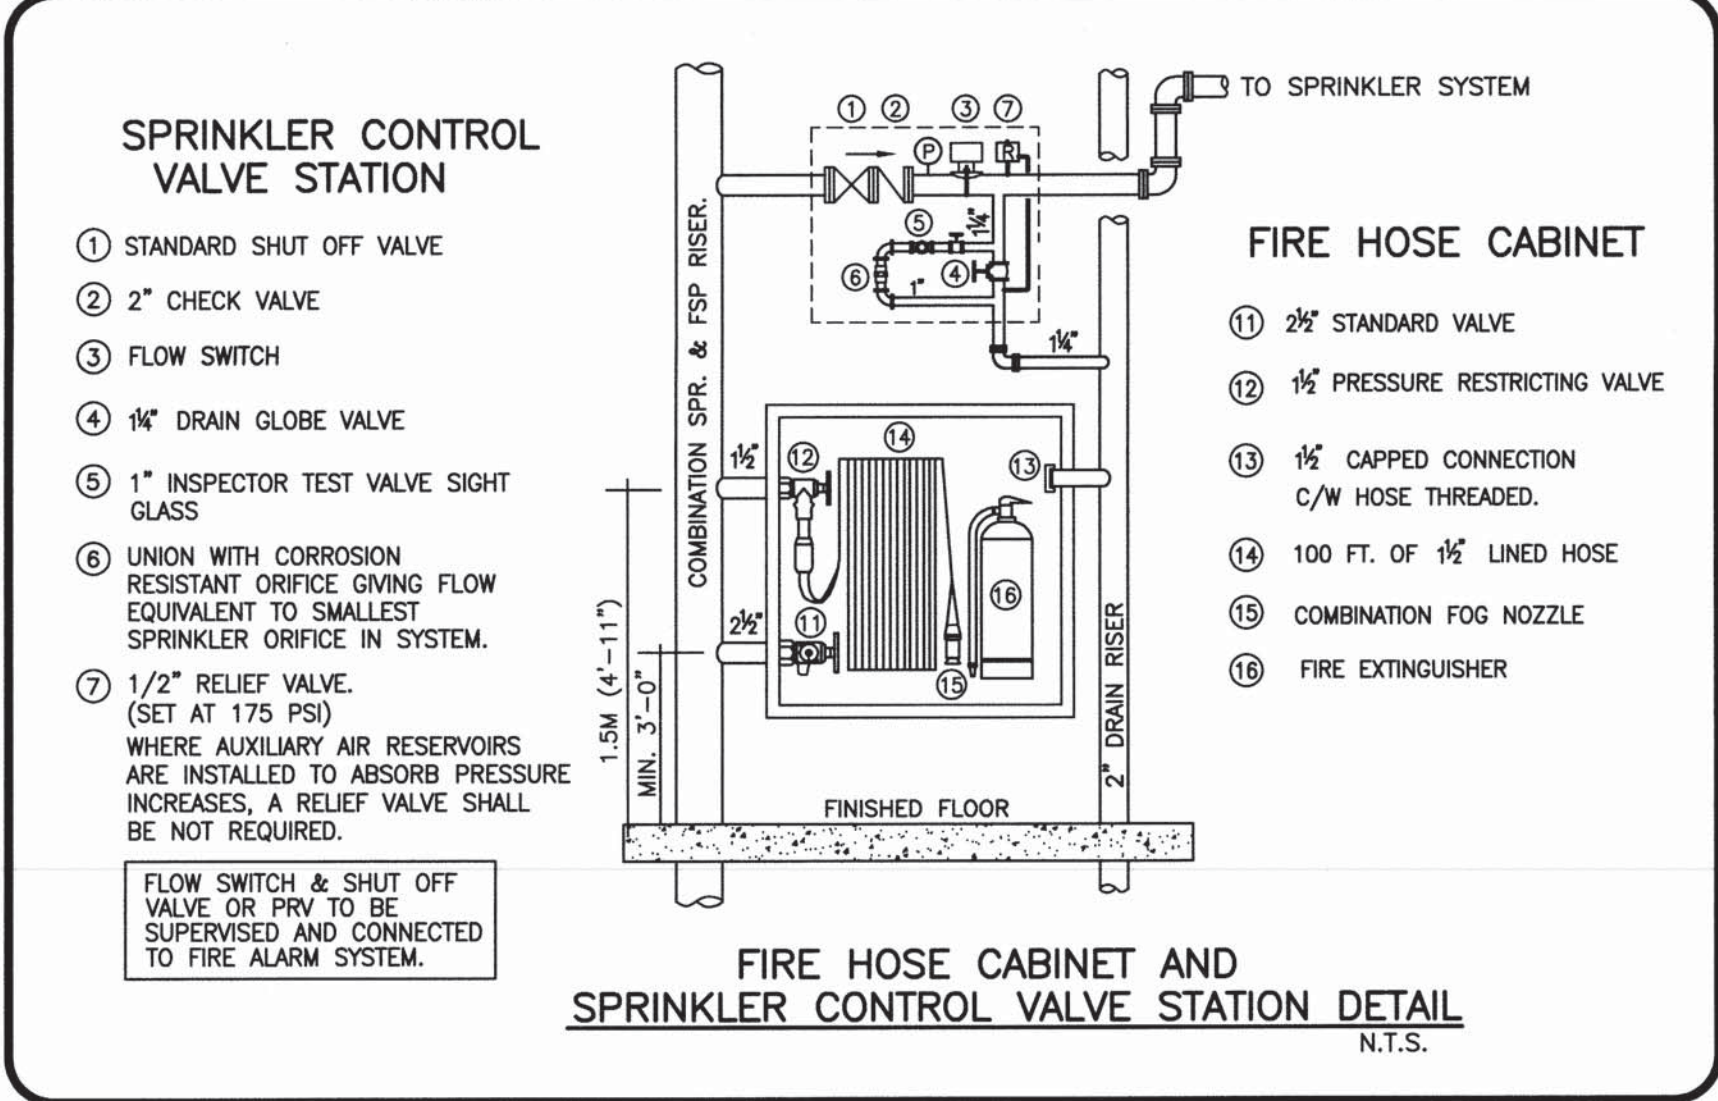

REVISIONS

NO.	DESCRIPTION	DATE
2.	RE-ISSUED FOR PERMIT.	AUG. 15 2014
3.	REVISED LAYOUT AS PER TEEPLE ARCHITECTS COMMENTS DATED IN JUN/08, 2015	JUN. 08 2015
5.	ISSUED FOR CONSTRUCTION.	OCT. 2 2015

NOTES

THIS DRAWING ASSOCIATED CALCULATIONS AND SPECIFICATIONS ARE THE PROPERTY OF THE DESIGNER AND MUST BE RETURNED AT THE COMPLETION OF THE WORK OR UPON REQUEST.

ALL DIMENSIONS TAKE PRECEDENCE OVER SCALE.

THE SPRINKLER SYSTEM IS TO BE INSTALLED AS PER N.F.P.A. STANDARDS # 13 AND U.L.C. STANDARDS (IF APPLICABLE).

CONTRACTOR TO INCLUDE FOR OFFSETS IN BRANCH LINES AND MAINS WHERE REQUIRED.

CONTRACTOR TO BE I.L.C. LISTED AND APPROVED BY LOCAL AUTHORITIES.

ALL UNDERGROUND WATERMAIN TO BE INSTALLED ACCORDING TO LOCAL AUTHORITIES AND INSURANCE CO. STANDARDS.

INSTALL HIGH TEMPERATURE HEADS WHERE REQUIRED AS PER N.F.P.A. STANDARD # 13.

ALL INTERIOR GRID BRANCH LINE MEASUREMENTS ARE GIVEN AS CENTER LINE TO CENTER LINE DIMENSIONS. (SEE TO PIPE)

ALL OTHER BRANCH LINE MEASUREMENTS ARE GIVEN AS CENTER LINE TO CENTER LINE (SCH 40 PIPE).

ALL MAIN MEASUREMENTS ARE GIVEN AS CENTER LINE TO CENTER LINE DIMENSIONS. (THIN WALL PIPE)

SHOULDER DISTANCE IN INCHES FROM CENTER LINE OF PIPE TO UNDERSIDE OF CEILING.

RN DENOTES RISER NIPPLE ON DENOTES DOWN.

ALL SUPERVISED VALVES/FLOW (PRESSURE) SWITCHES AND LOW PRESSURE MONITORING SWITCHES TO BE CONNECTED TO FIRE ALARM SYSTEM (IF F.A.S. IS INSTALLED).

CONTRACTOR TO VERIFY DATE TO DETERMINE EXACT LOCATION ON ELEVATOR OR MAKE IT TO BE INSTALLED AS INDICATED ON DRAWINGS. ANY MAJOR DISCREPANCIES TO BE REPORTED TO THE DESIGNER PRIOR TO FABRICATION AND INSTALLATION.

OWNER (OR OTHERS) TO PROVIDE ADEQUATE HEAT IN ALL AREAS OF BUILDING SUBJECT TO FREEZING THAT ARE PROTECTED BY A WET TYPE SPRINKLER SYSTEM.

ALL GLASS BULB TYPE SPRINKLERS TO BE OF RECENT ISSUE. MANUFACTURE DATE OF AT LEAST YEAR 2013.

S/R=STANDARD RESPONSE Q/R=QUICK RESPONSE C/W GUARD

●	1/2" 155°F STANDARD COVERAGE CONCEALED PENDENT (K=5.6) Q/R	00
○	1/2" 155°F STANDARD COVERAGE UPRIGHT (K=5.6) Q/R	4
●	1/2" 155°F RESIDENTIAL CONCEALED PENDENT (K=4.9)	73
●	1/2" 155°F RESIDENTIAL CONCEALED SIDEWALL (K=4.0)	84
●	1/2" 212°F STANDARD COVERAGE UPRIGHT (K=5.6) Q/R	2
■	FIRE HOSE RACK - 100 FT OF 1 1/2" LINED HOSE C/W COMBINATION FOG NOZZLE	3

DESIGN CRITERIA



DESIGNED FOR RESIDENTIAL SPRINKLERS AS PER NFPA 13 SECTION 11.3.1 (2010 ED.).

DESIGN AREA TO INCLUDE THE FOUR ADJACENT SPRINKLERS THAT PRODUCE THE GREATEST HYDRAULIC DEMAND.

THE REQUIRED DISCHARGE FROM EACH SPRINKLER SHALL BE THE GREATER OF THE FOLLOWING:

(1) MIN. FLOW RATES INDICATED IN SPR. LISTING.

(2) MIN. 0.10 GPM/SQ.FT. OVER DESIGN AREA.

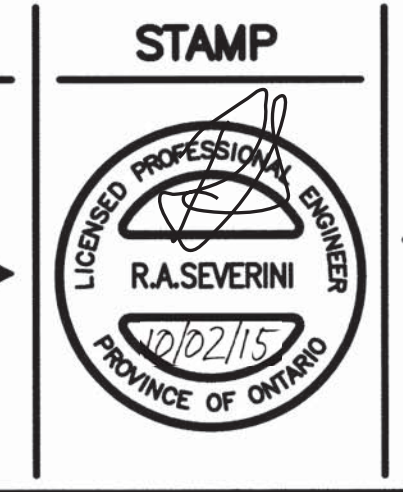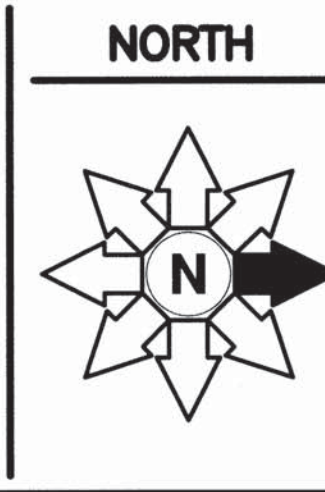

PROJECT

SQ ALEXANDRA PARK
BLOCK 11
38 CAMERON ST. TORONTO

DWG TITLE

9TH FLOOR
SPRINKLER & STANDPIPE SYSTEM

DATE	JULY 2014	PROJECT NO.	14-10224
SCALE	1:100	DWG NO.	SP-12
DWN BY	H.W.	ISSUED FOR REVISION NO.	02

IF SPRINKLER CONTRACTOR USES PLASTIC PIPING THEN THE FOLLOWING IS APPLICABLE.

NOTE: CONTRACTOR TO INSTALL PLASTIC PIPING AS PER MANUFACTURE'S SPECIFICATIONS INCLUDING EXPANSION LOOP.

O.B.C. SECTION 3.2.5.14 COMBUSTIBLE SPRINKLER PIPING

- (1) COMBUSTIBLE SPRINKLER PIPING SHALL BE USED ONLY FOR WET SYSTEMS IN RESIDENTIAL OCCUPANCIES AND OTHER LIGHT HAZARD OCCUPANCIES. (SEE APPENDIX A)
- (2) COMBUSTIBLE SPRINKLER PIPING SHALL MEET THE REQUIREMENTS OF ULC/ORD-199P-M, "COMBUSTIBLE PIPING FOR SPRINKLER SYSTEMS".
- (3) COMBUSTIBLE SPRINKLER PIPING SHALL BE SEPARATED FROM THE AREA SERVED BY THE SPRINKLER SYSTEM AND FROM ANY OTHER FIRE COMPARTMENT BY CEILINGS, WALLS, OR SOFFITS CONSISTING AS A MINIMUM,
 - (A) LATH AND PLASTER,
 - (B) GYPSUM BOARD NOT LESS THAN 9.5 MM (3/8 IN) THICK
 - (C) PLYWOOD NOT LESS THAN 13 MM (1/2 IN) THICK OR
 - (D) A SUSPENDED MEMBRANE CEILING WITH
 - (i) STEEL SUSPENSION GRID, AND
 - (ii) LAY-IN PANELS OR TILES HAVING A MASS NOT LESS THAN 1.7 KG/SQUARE METRE (0.35 LB/SQUARE FOOT)
- (4) IF COMBUSTIBLE SPRINKLER PIPING IS LOCATED ABOVE A CEILING, AN OPENING THROUGH THE CEILING THAT IS NOT PROTECTED IN CONFORMANCE WITH SENTENCE (3) SHALL BE LOCATED SO THAT THE DISTANCE BETWEEN THE EDGE OF THE OPENING AND THE NEAREST SPRINKLER IS NOT MORE THAN 300 MM (11 3/4").
- (5) THE PROTECTION REQUIRED BY SENTENCES (3) AND (4) IS PERMITTED TO BE WAIVED WHERE COMBUSTIBLE SPRINKLER PIPING HAS BEEN TESTED IN CONFORMANCE WITH ULC/ORD-C199P-M, "COMBUSTIBLE PIPING FOR SPRINKLER SYSTEMS", AND HAS BEEN SHOWN TO MEET THE REQUIREMENTS IN THAT DOCUMENT WITHOUT ADDITIONAL PROTECTION.

GENERAL NOTES

- NOTE 1: IN BUILDINGS SPRINKLERED IN ACCORDANCE WITH NFPA 13, CLOSETS LESS THAN 12 SQ.FT. IN AREA IN INDIVIDUAL DWELLING UNITS SHALL NOT BE REQUIRED TO BE SPRINKLERED. CLOSETS THAT CONTAIN EQUIPMENT SUCH AS WASHERS, DRYERS, FURNACES, OR WATER HEATERS SHALL BE SPRINKLERED REGARDLESS OF SIZE.
- NOTE 2: SPRINKLERS SHALL NOT BE REQUIRED IN BATHROOMS THAT ARE LOCATED WITHIN DWELLING UNITS, THAT DO NOT EXCEED 55 SQ.FT. IN AREA, AND THAT HAVE WALLS AND CEILINGS OF NONCOMBUSTIBLE OR LIMITED-COMBUSTIBLE MATERIALS WITH A 15-MINUTE THERMAL BARRIER RATING, INCLUDING THE WALLS AND CEILINGS BEHIND ANY SHOWER ENCLOSURE OR TUB.
- NOTE 3: WHERE SIDEWALL SPRINKLER IS INSTALLED AT SOFFIT (BULKHEAD) EXCEEDING MORE THAN 8" IN WIDTH, PENDENT SPRINKLERS SHALL BE INSTALLED UNDER THE SOFFIT (BULKHEAD).
- NOTE 4: RESIDENTIAL SIDEWALL SPRINKLERS SHALL BE PERMITTED TO BE INSTALLED IN THE FACE OF A SOFFIT LOCATED DIRECTLY OVER CABINETS WITHOUT REQUIRING ADDITIONAL SPRINKLERS BELOW THE SOFFIT OR CABINETS WHERE THE SOFFIT DOES NOT PROJECT HORIZONTALLY MORE THAN 12" FROM THE WALL.
- NOTE 5: IF CPVC PIPE IS USED, CONTRACTOR TO PROVIDE "EXPANSION OFFSET LOOP" ON STRAIGHT RUNS EXCEEDING 100 FT IN LENGTH.
- NOTE 6: ANY FIRE STOPPING, ACOUSTIC SEALANT AND MATERIALS USED IN THIS PROJECT WHICH COME IN CONTACT WITH CPVC SPRINKLER PIPING IS TO BE COMPATIBLE WITH CPVC PIPING
- NOTE 7: SPRINKLERS TO BE A MINIMUM 3"-0" FROM EDGE OF ALL SURFACE MOUNTED LIGHT FIXTURE.

SPRINKLER LAYOUT BASED ON BULKHEADS BEING MAXIMUM 12" DEEP. ADDITIONAL SIDEWALL SPRINKLERS MAY BE REQUIRED IF BULKHEAD DEPTH EXCEEDS 12".



PROTECTION AREA PER RESIDENTIAL CONCEALED PENDENT SPRINKLER SHALL NOT EXCEED 300 SQ.FT. MAX. SPACING IS 20 FT. PROTECTION AREA PER RESIDENTIAL CONCEALED SIDEWALL SPRINKLER SHALL NOT EXCEED 256 SQ.FT. (16 FT. X 16 FT.)

CONTRACTOR SHALL COORDINATE WITH LIGHTING, DIFFUSER & INTERIOR DESIGN DRAWINGS PRIOR TO INSTALLATION OF SPRINKLER SYSTEM.

THE HEIGHT OF THE BULKHEAD NOT TO EXCEED 12" AS PER ARCHITECTURAL DRAWING.

SPRINKLER CONTROL VALVE STATION

- 1 STANDARD SHUT OFF VALVE
 - 2 2" CHECK VALVE
 - 3 FLOW SWITCH
 - 4 1/4" DRAIN GLOBE VALVE
 - 5 1" INSPECTOR TEST VALVE SIGHT GLASS
 - 6 UNION WITH CORROSION RESISTANT ORIFICE SWING FLOW EQUIVALENT TO SMALLEST SPRINKLER ORIFICE IN SYSTEM.
 - 7 1/2" RELIEF VALVE. (SET AT 175 PSIG)
- WHERE AUXILIARY AIR RESERVOIRS ARE INSTALLED TO ABSORB PRESSURE INCREASES, A RELIEF VALVE SHALL BE NOT REQUIRED.
- FLOW SWITCH & SHUT OFF VALVE OR PRV TO BE SUPERVISED AND CONNECTED TO FIRE ALARM SYSTEM.

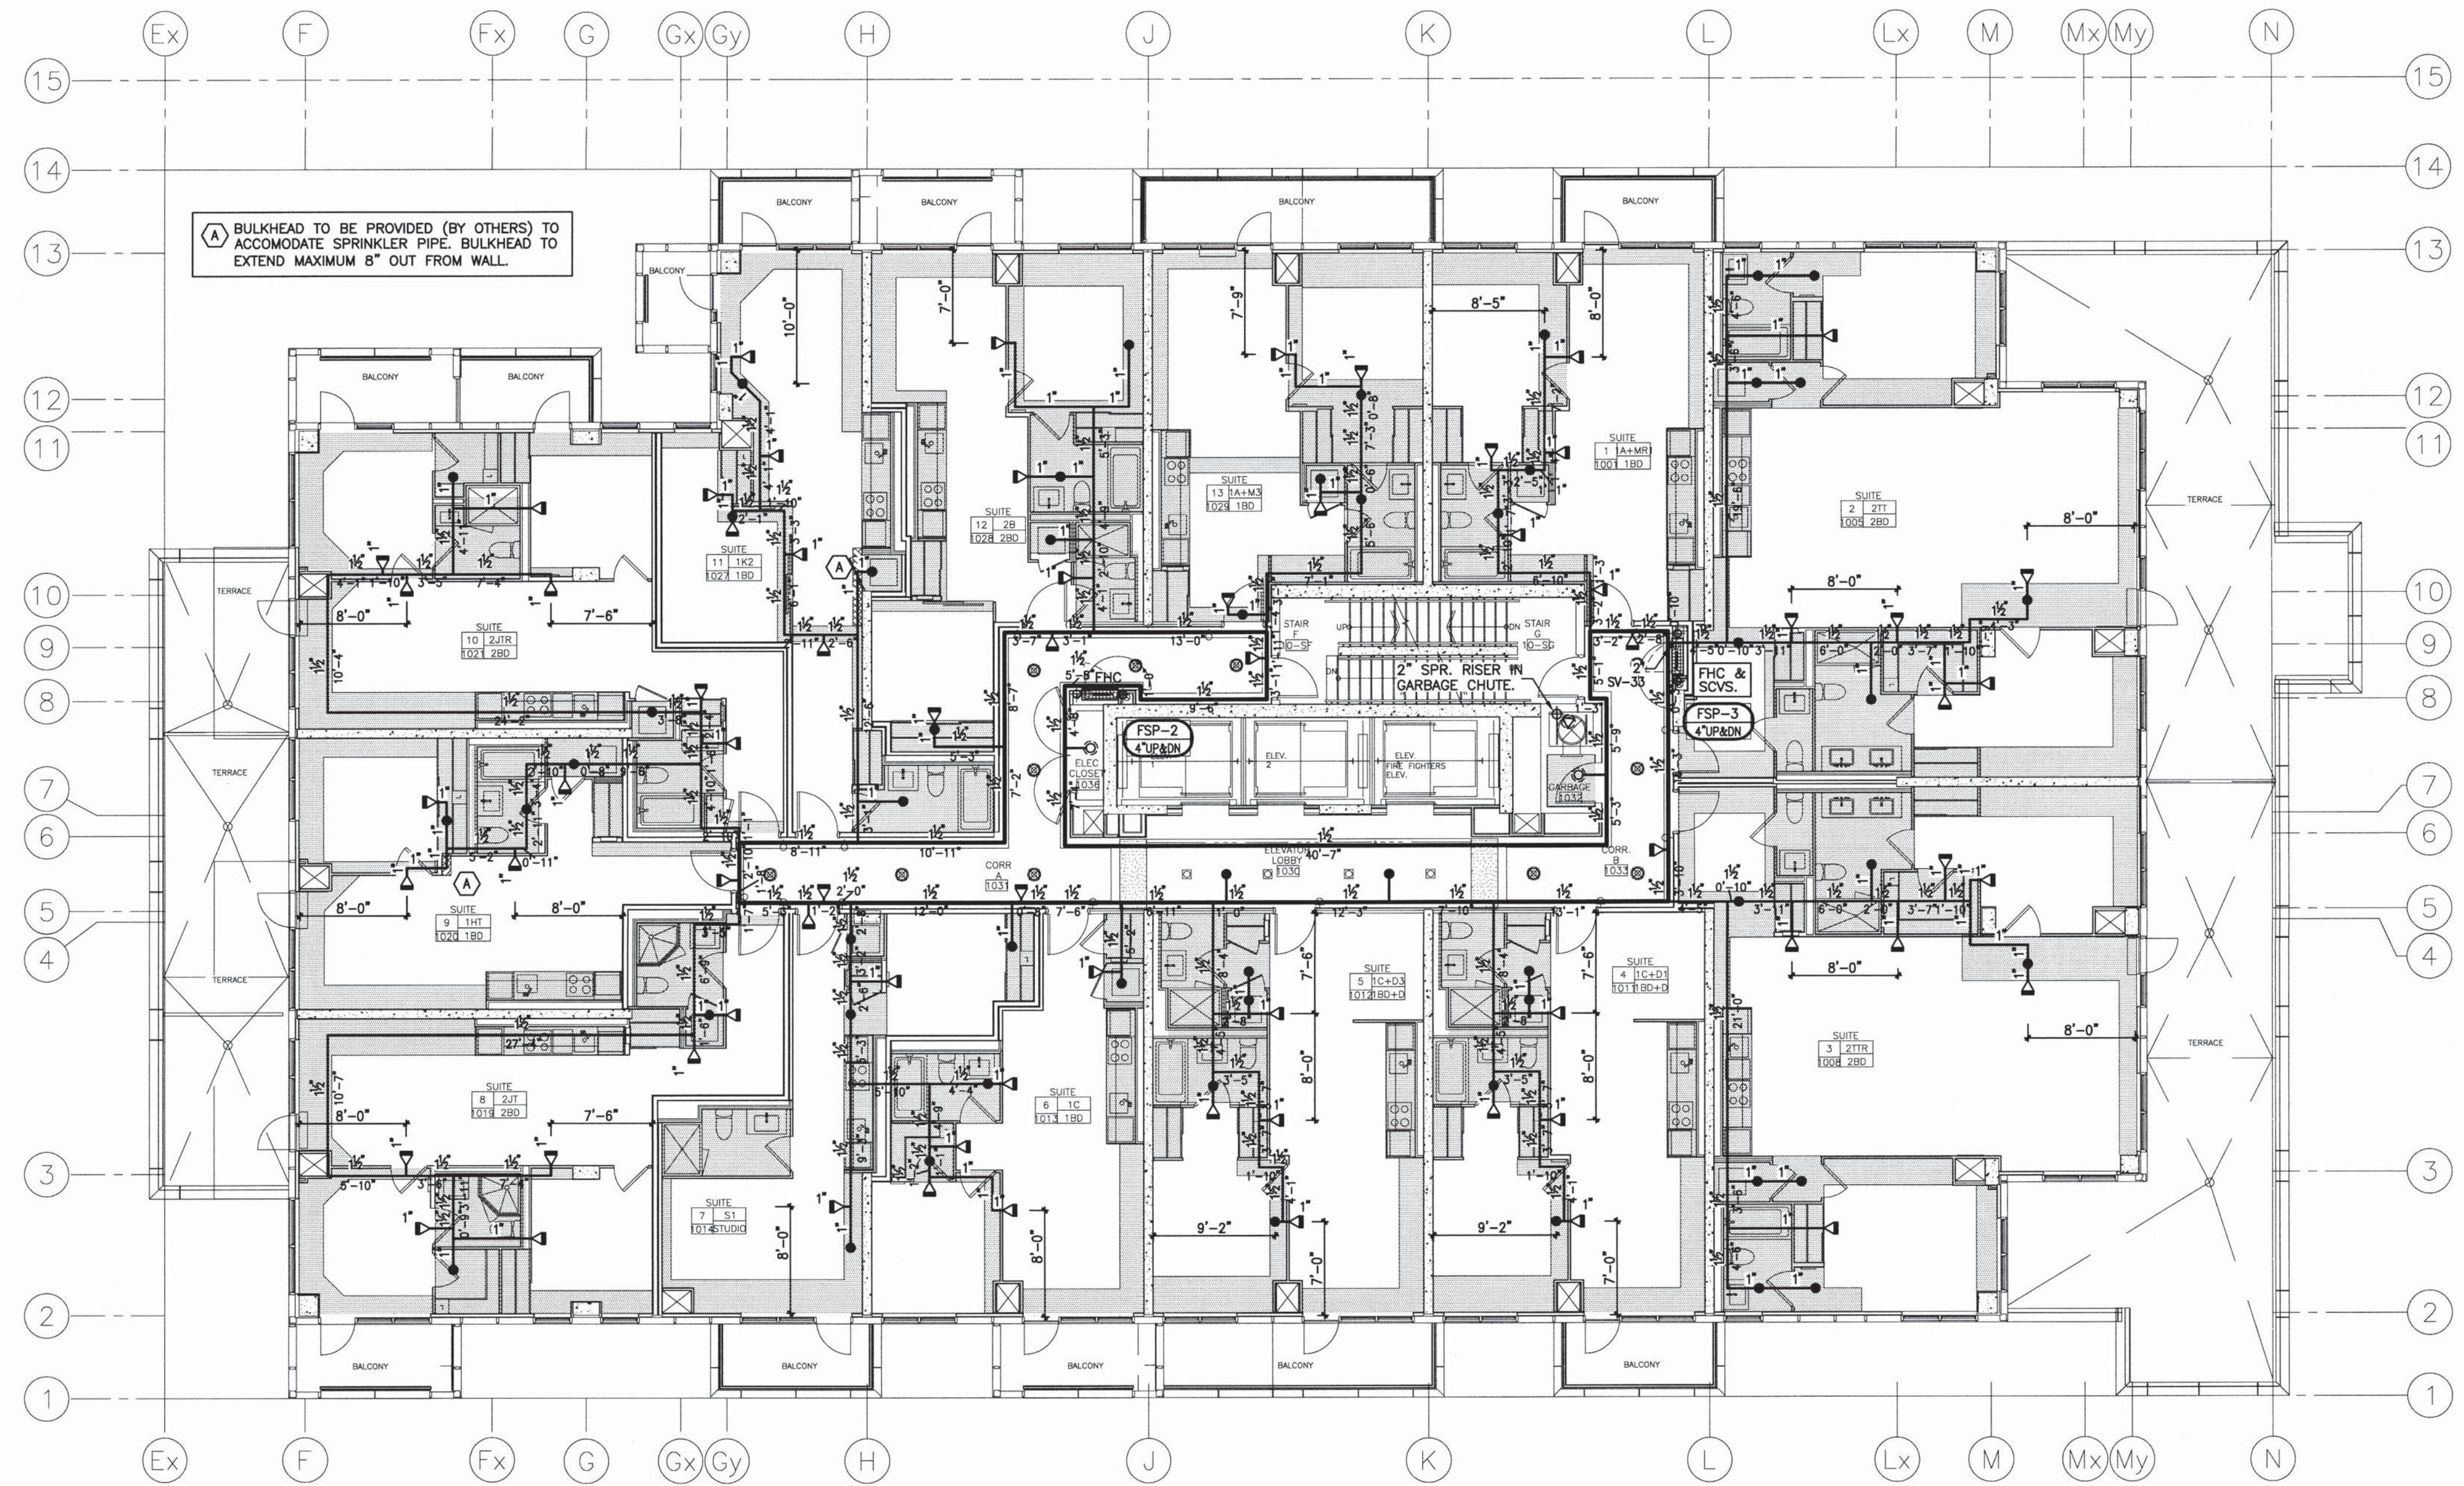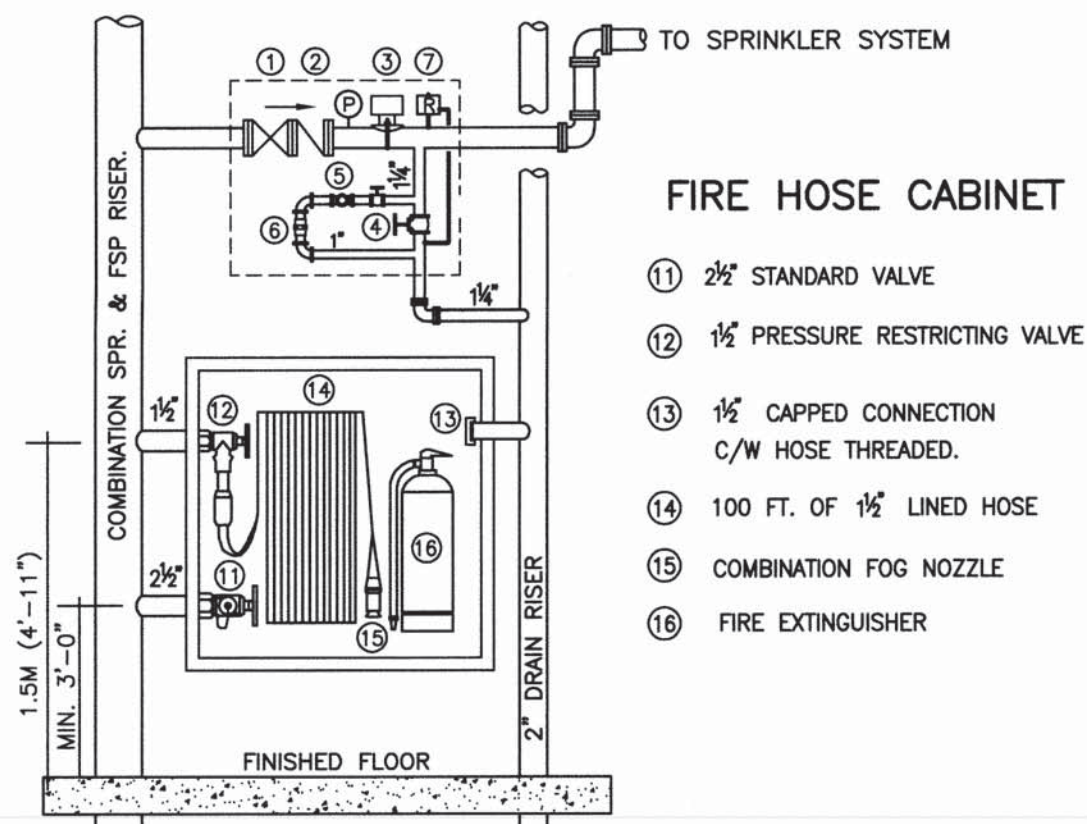

REVISIONS	DATE	DESCRIPTION
2.	AUG. 15 2014	RE-ISSUED FOR PERMIT.
3.	JUN.08 2015	REVISED LAYOUT AS PER TEEPLE ARCHITECTS COMMENTS DATED IN JUN.08, 2015
5.	OCT. 2 2015	ISSUED FOR CONSTRUCTION.

NOTES

— THIS DRAWING ASSOCIATED CALCULATIONS AND SPECIFICATIONS ARE THE PROPERTY OF THE DESIGNER AND MUST BE RETURNED AT THE COMPLETION OF THE WORK OR UPON REQUEST.

— DIMENSIONS TAKE PRECEDENCE OVER SCALE.

— THE SPRINKLER SYSTEM IS TO BE INSTALLED AS PER N.F.P.A. STANDARD # 13 AND O.B.C. STANDARDS.

— CONTRACTOR TO INCLUDE FOR OFFSETS IN BRANCH LINES AND MAINS WHERE REQUIRED.

— ALL MATERIALS TO BE U.L.C. LISTED AND APPROVED BY LOCAL AUTHORITIES.

— UNDERGROUND WATERMAIN TO BE INSTALLED ACCORDING TO LOCAL AUTHORITIES AND INSURANCE CO. STANDARDS.

— INSTALL HIGH TEMPERATURE HEADS WHERE REQUIRED AS PER N.F.P.A. STANDARD # 13.

— ALL INTERIOR BRID BRANCH LINE MEASUREMENTS ARE GIVEN AS CENTER LINE TO CENTER LINE DIMENSIONS.

— ALL OTHER BRANCH LINE MEASUREMENTS ARE GIVEN AS CENTER LINE TO CENTER LINE (SCH40 PIPE).

— ALL MAIN MEASUREMENTS ARE GIVEN AS CENTER LINE TO CENTER LINE DIMENSIONS. (THIN WALL PIPE)

— NOTES DISTANCE IN INCHES FROM CENTER LINE OF PIPE TO UNDERSIDE OF CEILING.

— RN DENOTES RISER NIPPLE ON DENOTES DOWN.

— ALL SUPERVISED VALVES/FLOW (PRESSURE) SWITCHES AND LOW PRESSURE MONITORING SWITCHES TO BE CONNECTED TO FIRE ALARM SYSTEM (IF F.A.S. IS INSTALLED).

— CONTRACTOR TO VISIT SITE TO DETERMINE EXACT LOCATION AND ELEVATION OF MAINS TO BE INSTALLED, AS INDICATED ON DRAWING. ANY MAJOR DISCREPANCIES TO BE REPORTED TO THE DESIGNER PRIOR TO FABRICATION AND INSTALLATION.

OWNER (OR OTHERS) TO PROVIDE ADEQUATE HEAT IN ALL AREAS OF BUILDING SUBJECT TO FREEZING THAT ARE PROTECTED BY A WET TYPE SPRINKLER SYSTEM.

ALL GLASS BULB TYPE SPRINKLERS TO BE OF RECENT ISSUE. MANUFACTURE DATE OF AT LEAST YEAR 2013.

S/R=STANDARD RESPONSE Q/R=QUICK RESPONSE C/W GUARD		
⊙	1/2" 155F STANDARD COVERAGE CONCEALED PENDENT (K=5.6) Q/R	00
○	1/2" 155F STANDARD COVERAGE UPRIGHT (K=5.6) Q/R	2
●	1/2" 155F RESIDENTIAL CONCEALED PENDENT (K=4.9)	53
◐	1/2" 155F RESIDENTIAL CONCEALED SIDEWALL (K=4.0)	70
◑	1/2" 165F STANDARD COVERAGE SIDEWALL (K=5.6) Q/R	1
□	FIRE HOSE RACK - 100 FT OF 1/2" LINED HOSE C/W COMBINATION FOG NOZZLE	2

DESIGN CRITERIA


DESIGNED FOR RESIDENTIAL SPRINKLERS AS PER NFPA 13 SECTION 11.3.1 (2010 ED.).

DESIGN AREA TO INCLUDE THE FOUR ADJACENT SPRINKLERS THAT PRODUCE THE GREATEST HYDRAULIC DEMAND.

THE REQUIRED DISCHARGE FROM EACH SPRINKLER SHALL BE THE GREATER OF THE FOLLOWING:

(1) MIN. FLOW RATES INDICATED IN SPR. LISTING.

(2) MIN. 0.10 GPM/SQ.FT. OVER DESIGN AREA.

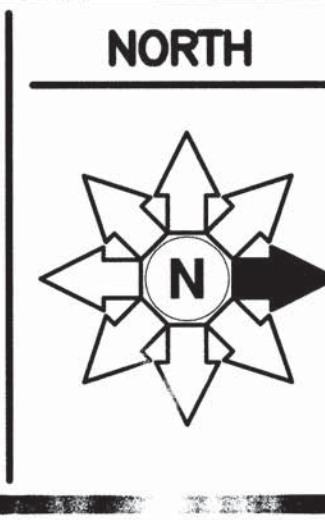

TRIDEL
4800 DUFFERIN STREET
TORONTO ONTARIO

PROJECT
SQ ALEXANDRA PARK
BLOCK 11
38 CAMERON ST. TORONTO

DWG TITLE
10TH FLOOR
SPRINKLER & STANDPIPE SYSTEM

DATE
JULY 2014

SCALE
1:100

DWN BY
H.W.

ISSUED FOR REVISION NO.
DZ

PROJECT NO.
14-10224

DWG NO.
SP-13

OF 16

IF SPRINKLER CONTRACTOR USES PLASTIC PIPING THEN THE FOLLOWING IS APPLICABLE.

NOTE: CONTRACTOR TO INSTALL PLASTIC PIPING AS PER MANUFACTURER'S SPECIFICATIONS INCLUDING EXPANSION LOOP.

O.B.C. SECTION 3.2.5.14 COMBUSTIBLE SPRINKLER PIPING

- COMBUSTIBLE SPRINKLER PIPING SHALL BE USED ONLY FOR WET SYSTEMS IN RESIDENTIAL OCCUPANCIES AND OTHER LIGHT HAZARD OCCUPANCIES. (SEE APPENDIX A.)
- COMBUSTIBLE SPRINKLER PIPING SHALL MEET THE REQUIREMENTS OF ULC/ORD-199P-M, "COMBUSTIBLE PIPING FOR SPRINKLER SYSTEMS".
- COMBUSTIBLE SPRINKLER PIPING SHALL BE SEPARATED FROM THE AREA SERVED BY THE SPRINKLER SYSTEM AND FROM ANY OTHER FIRE COMPARTMENT BY CEILINGS, WALLS, OR SOFFITS CONSISTING AS A MINIMUM,
 - LATH AND PLASTER,
 - GYPSUM BOARD NOT LESS THAN 9.5 MM (3/8 IN) THICK
 - PLYWOOD NOT LESS THAN 13 MM (1/2 IN) THICK OR
 - A SUSPENDED MEMBRANE CEILING WITH
 - STEEL SUSPENSION GRID, AND
 - LAY-IN PANELS OR TILES HAVING A MASS NOT LESS THAN 1.7 KG/SQUARE METRE (0.35 LB/SQUARE FOOT)
- IF COMBUSTIBLE SPRINKLER PIPING IS LOCATED ABOVE A CEILING, AN OPENING THROUGH THE CEILING THAT IS NOT PROTECTED IN CONFORMANCE WITH SENTENCE (3) SHALL BE LOCATED SO THAT THE DISTANCE BETWEEN THE EDGE OF THE OPENING AND THE NEAREST SPRINKLER IS NOT MORE THAN 300 MM (11 3/4").
- THE PROTECTION REQUIRED BY SENTENCES (3) AND (4) IS PERMITTED TO BE WAIVED WHERE COMBUSTIBLE SPRINKLER PIPING HAS BEEN TESTED IN CONFORMANCE WITH ULC/ORD-C199P-M, "COMBUSTIBLE PIPING FOR SPRINKLER SYSTEMS", AND HAS BEEN SHOWN TO MEET THE REQUIREMENTS IN THAT DOCUMENT WITHOUT ADDITIONAL PROTECTION.

GENERAL NOTES

NOTE 1: IN BUILDINGS SPRINKLERED IN ACCORDANCE WITH NFPA 13, CLOSETS LESS THAN 12 SQ.FT. IN AREA IN INDIVIDUAL DWELLING UNITS SHALL NOT BE REQUIRED TO BE SPRINKLERED. CLOSETS THAT CONTAIN EQUIPMENT SUCH AS WASHERS, DRYERS, FURNACES, OR WATER HEATERS SHALL BE SPRINKLERED REGARDLESS OF SIZE. AS PER NFPA-13 (2007) CLAUSE 21.20.19.2.1

NOTE 2: SPRINKLERS SHALL NOT BE REQUIRED IN BATHROOMS THAT ARE LOCATED WITHIN DWELLING UNITS, THAT DO NOT EXCEED 55 SQ.FT. IN AREA, AND THAT HAVE WALLS AND CEILINGS OF NONCOMBUSTIBLE OR LIMITED-COMBUSTIBLE MATERIALS WITH A 15-MINUTE THERMAL BARRIER RATING, INCLUDING THE WALLS AND CEILINGS BEHIND ANY SHOWER ENCLOSURE OR TUB. AS PER NFPA-13 (2007) CLAUSE 8.15.8.1.1

NOTE 3: WHERE SIDEWALL SPRINKLER IS INSTALLED AT SOFFIT (BULKHEAD) EXCEEDING MORE THAN 8" IN WIDTH, PENDENT SPRINKLERS SHALL BE INSTALLED UNDER THE SOFFIT (BULKHEAD).

NOTE 4: RESIDENTIAL SIDEWALL SPRINKLERS SHALL BE PERMITTED TO BE INSTALLED IN THE FACE OF A SOFFIT LOCATED DIRECTLY OVER CABINETS WITHOUT REQUIRING ADDITIONAL SPRINKLERS BELOW THE SOFFIT OR CABINETS WHERE THE SOFFIT DOES NOT PROJECT HORIZONTALLY MORE THAN 12" FROM THE WALL.

NOTE 5: IF CPVC PIPE IS USED, CONTRACTOR TO PROVIDE "EXPANSION OFFSET LOOP" ON STRAIGHT RUNS EXCEEDING 100 FT IN LENGTH.

NOTE 6: ANY FIRE STOPPING, ACOUSTIC SEALANT AND MATERIALS USED IN THIS PROJECT WHICH COME IN CONTACT WITH CPVC SPRINKLER PIPING IS TO BE COMPATIBLE WITH CPVC PIPING



NOTE 7: SPRINKLERS TO BE A MINIMUM 3"-0" FROM EDGE OF ALL SURFACE MOUNTED LIGHT FIXTURE.

SPRINKLER LAYOUT BASED ON BULKHEADS BEING MAXIMUM 12" DEEP. ADDITIONAL SIDEWALL SPRINKLERS MAY BE REQUIRED IF BULKHEAD DEPTH EXCEEDS 12".

PROTECTION AREA PER RESIDENTIAL CONCEALED PENDENT SPRINKLER SHALL NOT EXCEED 300 SQ.FT. MAX. SPACING IS 20 FT. PROTECTION AREA PER RESIDENTIAL CONCEALED SIDEWALL SPRINKLER SHALL NOT EXCEED 256 SQ.FT. (16 FT. X 16 FT.)

CONTRACTOR SHALL COORDINATE WITH LIGHTING, DIFFUSER & INTERIOR DESIGN DRAWINGS PRIOR TO INSTALLATION OF SPRINKLER SYSTEM.

THE HEIGHT OF THE BULKHEAD NOT TO EXCEED 12" AS PER ARCHITECTURAL DRAWING.

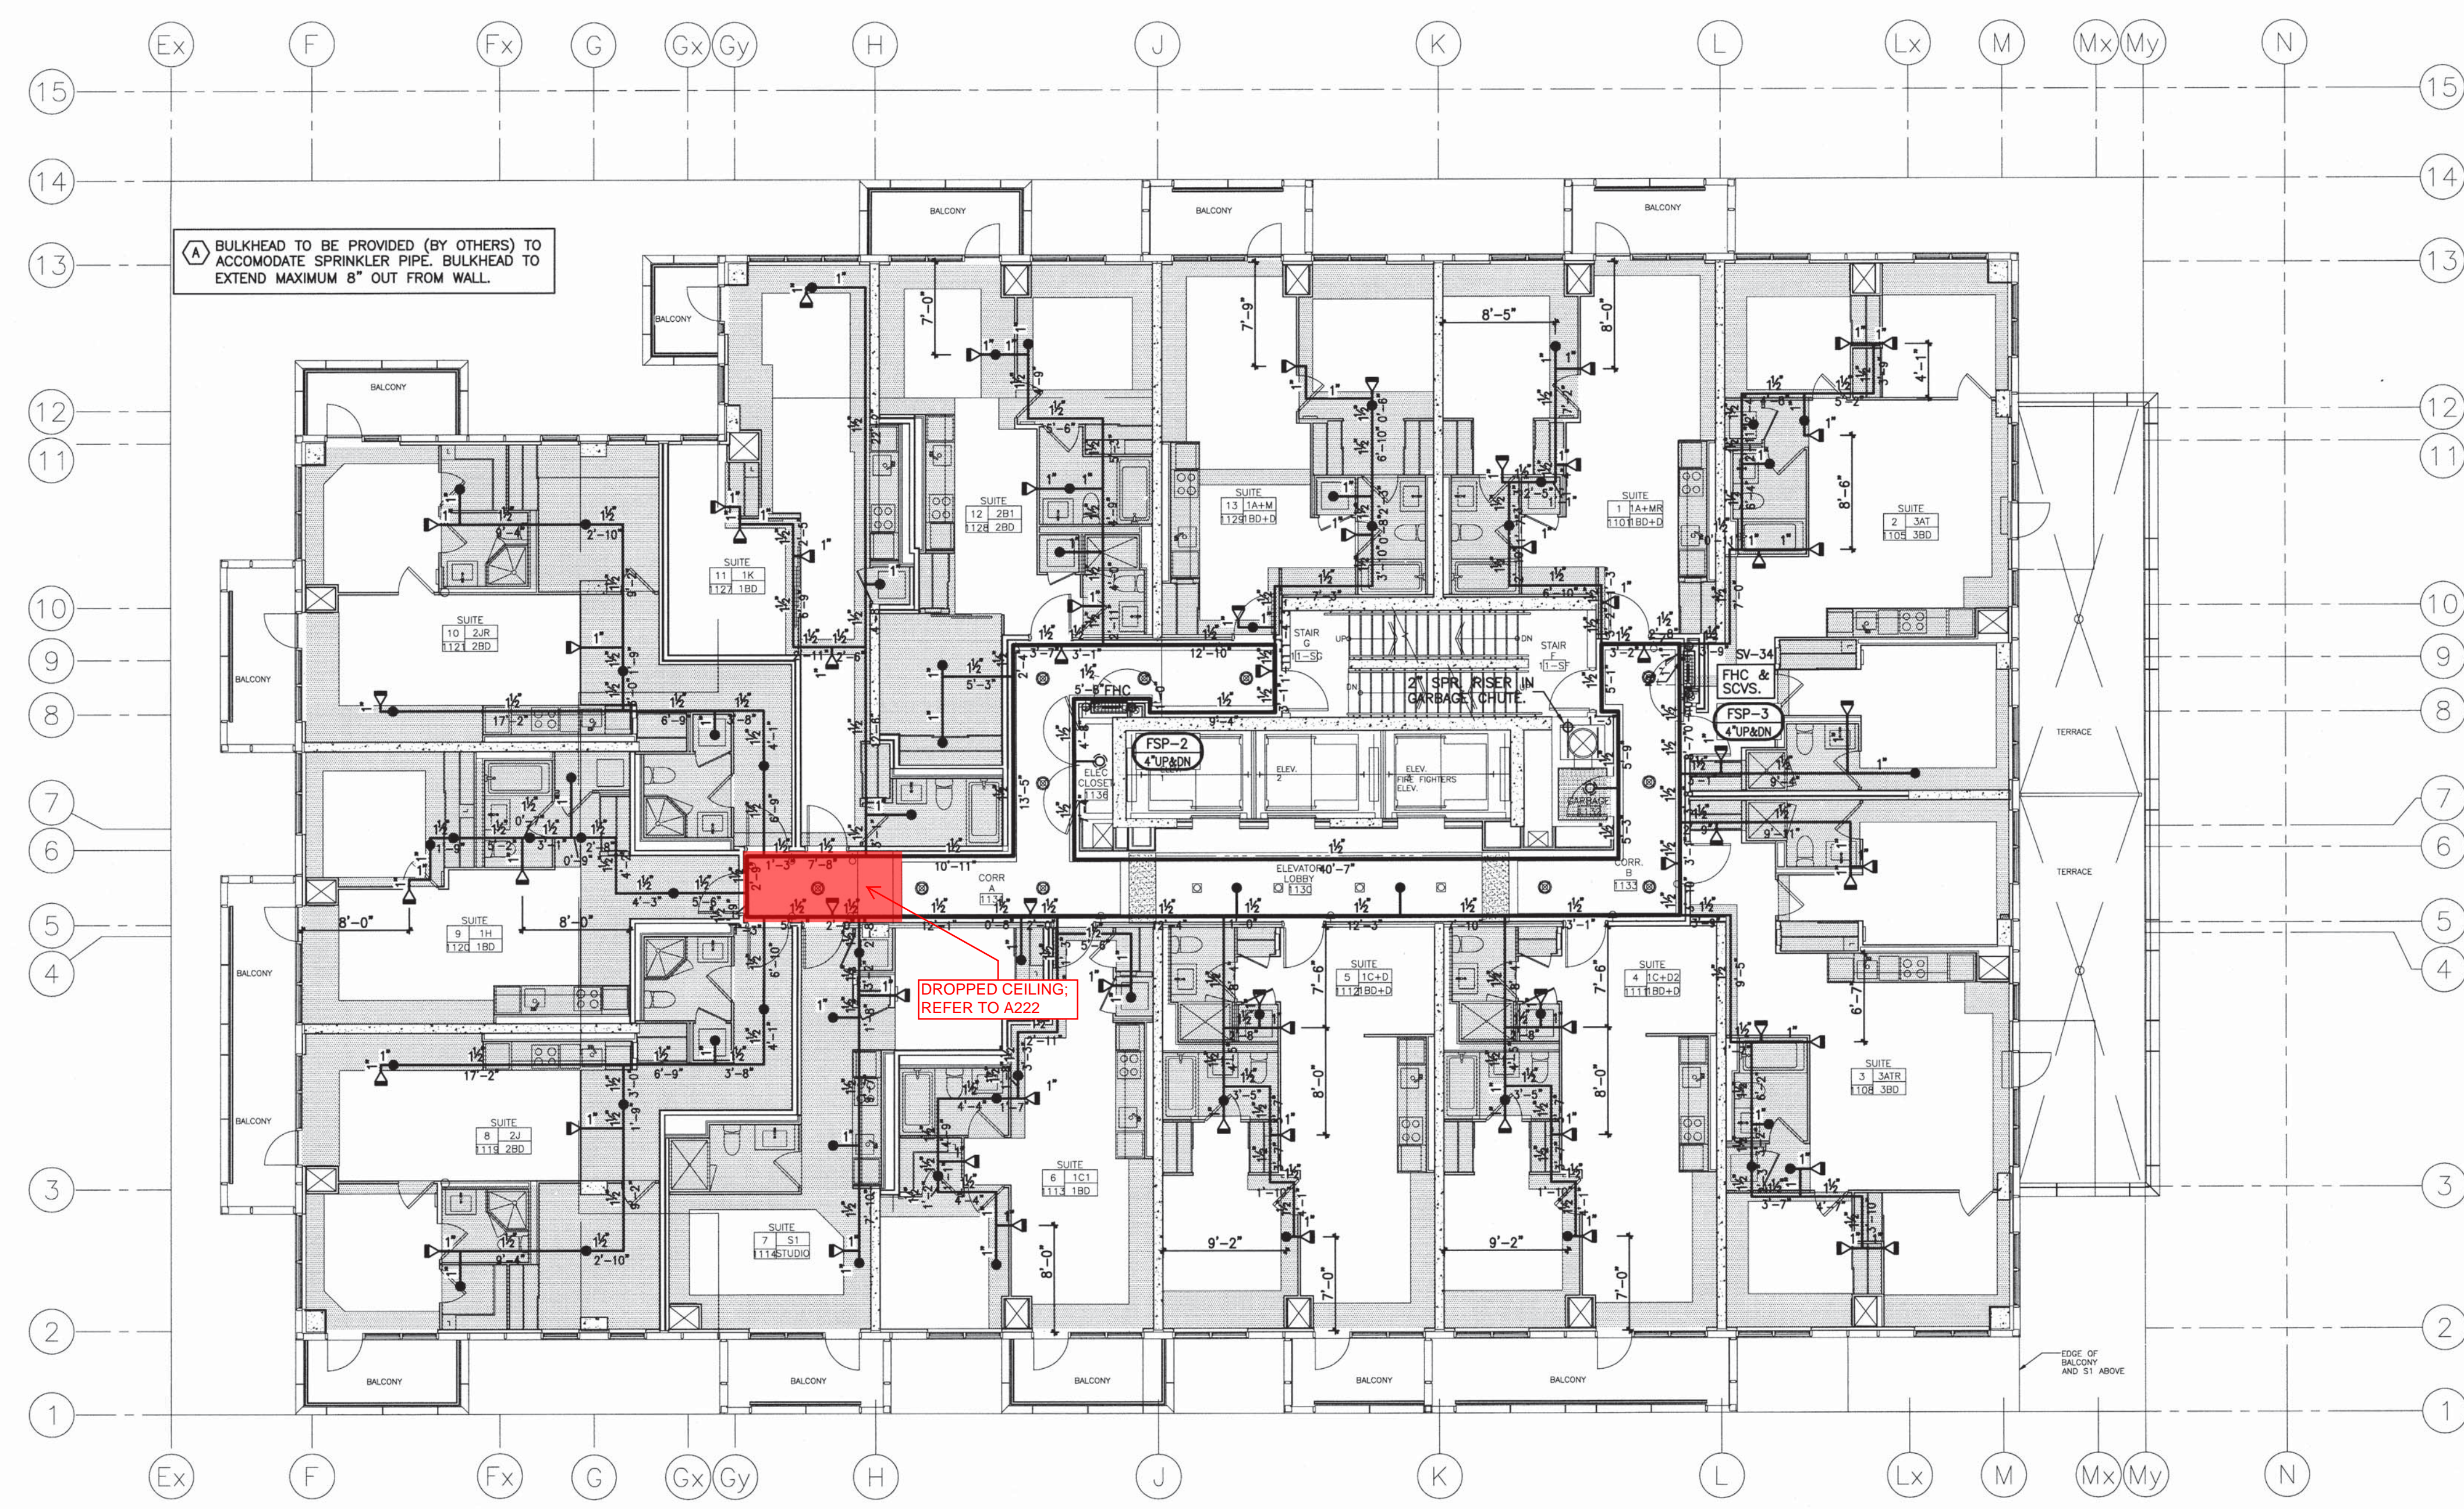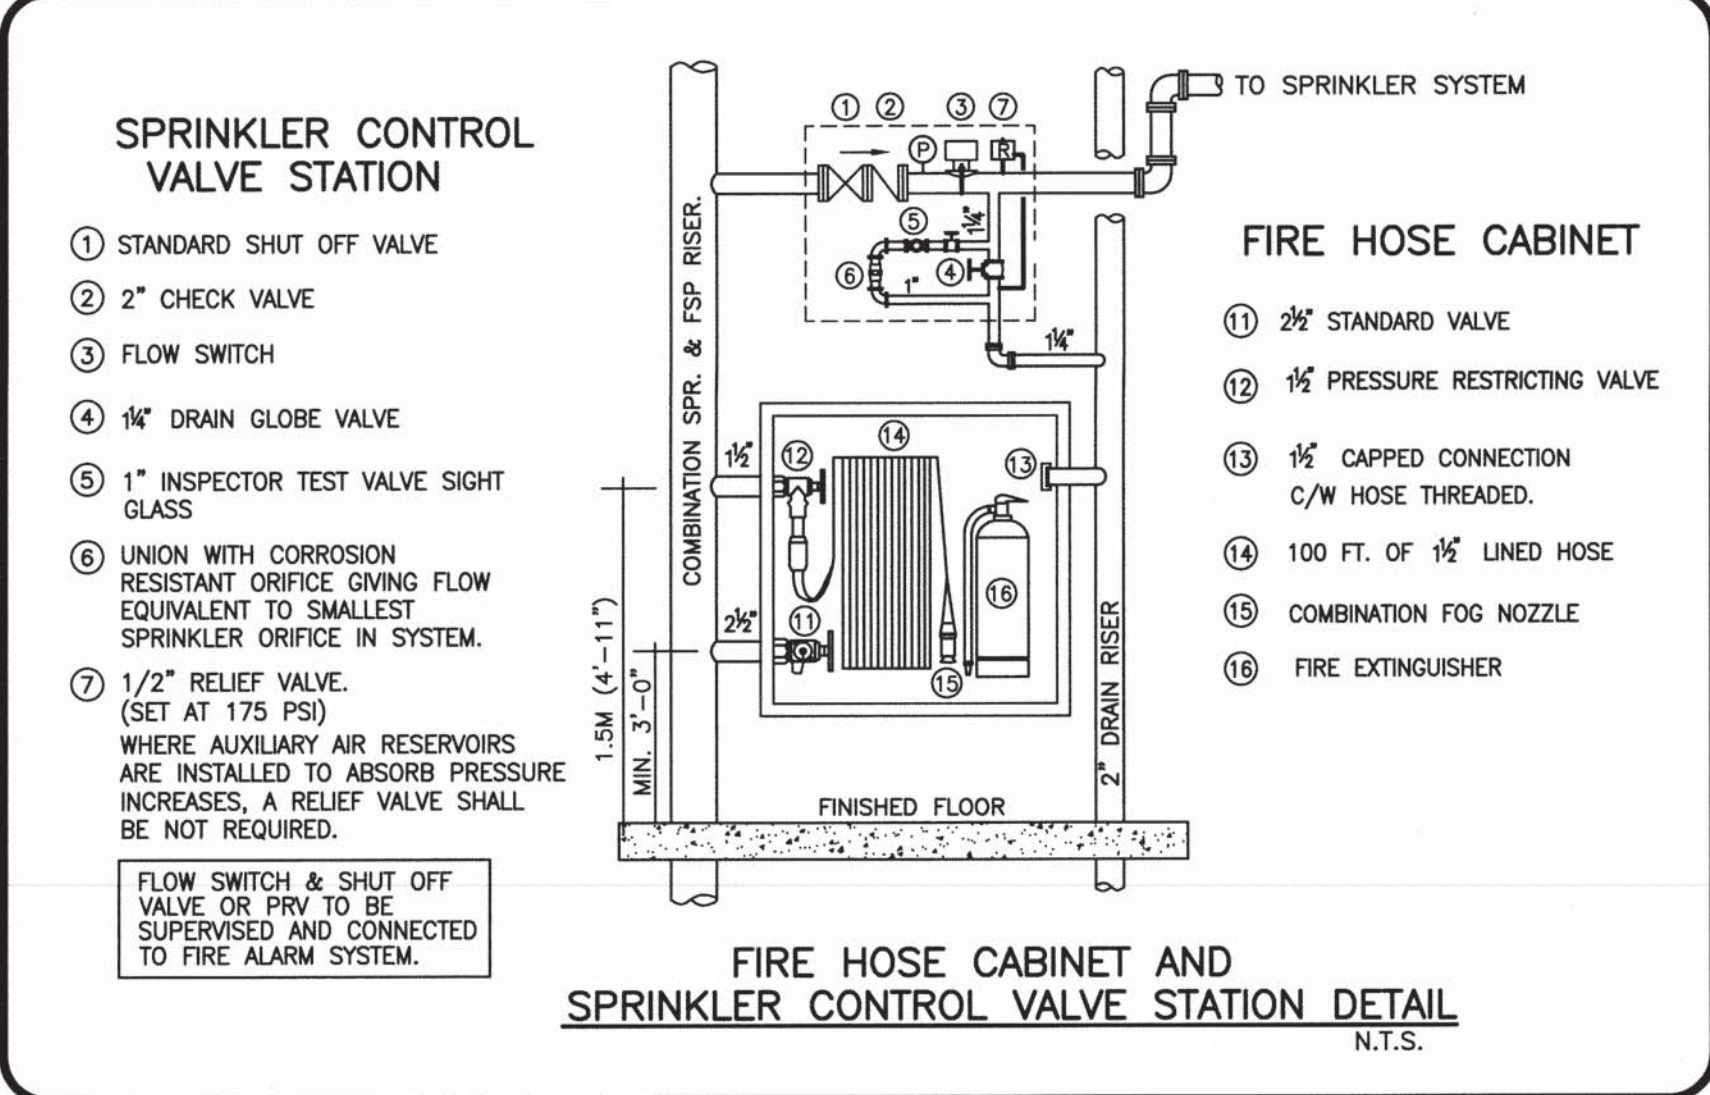

REVISIONS

NO.	DESCRIPTION	DATE
2.	RE-ISSUED FOR PERMIT.	AUG. 15 2014
3.	REVISED LAYOUT AS PER TEEPLE ARCHITECTS COMMENTS DATED IN JUN.08, 2015	JUN. 08 2015
5.	ISSUED FOR CONSTRUCTION.	OCT. 2 2015

NOTES

- THIS DRAWING ASSOCIATED CALCULATIONS AND SPECIFICATIONS ARE THE PROPERTY OF THE DESIGNER AND MUST BE RETURNED AT THE COMPLETION OF THE WORK OR UPON REQUEST.
- ALL DIMENSIONS UNLESS OTHERWISE NOTED ARE TO FACE UNLESS SPECIFIED OTHERWISE.
- THE SPRINKLER SYSTEM IS TO BE INSTALLED AS PER N.F.P.A. STANDARD 13 AND O.B.C. STANDARDS.
- CONTRACTOR TO INCLUDE FOR OFFSETS IN BRANCH LINES AND MAINS WHERE REQUIRED.
- ALL MATERIALS TO BE U.L.C. LISTED AND APPROVED BY LOCAL AUTHORITIES.
- UNDERGROUND WATERMAIN TO BE INSTALLED ACCORDING TO LOCAL AUTHORITIES AND INSURANCE CO. STANDARDS.
- INSTALL HIGH TEMPERATURE HEADS WHERE REQUIRED AS PER N.F.P.A. STANDARD 13.
- ALL CENTER LINE TO CENTER LINE MEASUREMENTS ARE GIVEN (SEE 10 PAGES).
- ALL OTHER BRANCH LINE MEASUREMENTS ARE GIVEN AS CENTER LINE TO CENTER LINE (SCHED. PIPE).
- ALL MAIN MEASUREMENTS ARE GIVEN AS CENTER LINE TO CENTER LINE DIMENSIONS (CON. WALL PIPE).
- DETAILS DISTANCE IN INCHES FROM CENTER LINE OF PIPE TO UNDERSIDE OF CEILING.
- IN DENOTES RISER NOZZLE.
- IN DENOTES DOWN.
- ALL SUPERVISED WALKFLOW (PRESSURE) SWITCHES AND LOW PRESSURE MONITORING SWITCHES TO BE CONNECTED TO FIRE ALARM SYSTEM (IF F.A.S. IS INSTALLED).
- CONTRACTOR TO VISIT SITE TO DETERMINE EXACT LOCATION AND ELEVATION OF MAINS (TO BE INSTALLED AS INDICATED ON DRAWINGS) ANY MAJOR DISCREPANCIES TO BE REPORTED TO THE DESIGNER PRIOR TO FABRICATION AND INSTALLATION.

OWNER (OR OTHERS) TO PROVIDE ADEQUATE HEAT IN ALL AREAS OF BUILDING SUBJECT TO FREEZING THAT ARE PROTECTED BY A WET TYPE SPRINKLER SYSTEM.

ALL GLASS BULB TYPE SPRINKLERS TO BE OF RECENT ISSUE. MANUFACTURE DATE OF AT LEAST YEAR 2013.

SYMBOL	DESCRIPTION	QUANTITY
○	1/2" 155F STANDARD COVERAGE CONCEALED PENDENT (K=5.6) Q/R	00
○	1/2" 155F STANDARD COVERAGE UPRIGHT (K=5.6) Q/R	2
●	1/2" 155F RESIDENTIAL CONCEALED PENDENT (K=4.9)	59
◁	1/2" 155F RESIDENTIAL CONCEALED SIDEWALL (K=4.0)	62
■	FIRE HOSE RACK - 100 FT OF 1/2" LINED HOSE C/W COMBINATION FOG NOZZLE	2



DESIGN CRITERIA

DESIGNED FOR RESIDENTIAL SPRINKLERS AS PER NFPA 13 SECTION 11.3.1 (2010 ED.).

DESIGN AREA TO INCLUDE THE FOUR ADJACENT SPRINKLERS THAT PRODUCE THE GREATEST HYDRAULIC DEMAND.

THE REQUIRED DISCHARGE FROM EACH SPRINKLER SHALL BE THE GREATER OF THE FOLLOWING:

- MIN. FLOW RATES INDICATED IN SPR. LISTING.
- MIN. 0.10 GPM/SQ.FT. OVER DESIGN AREA.

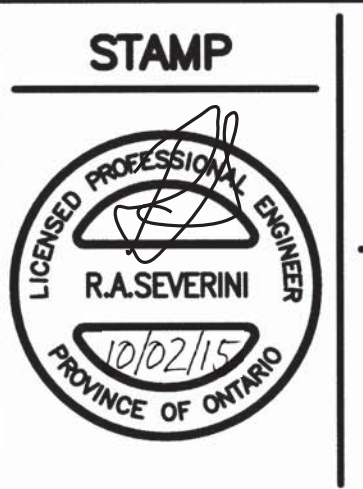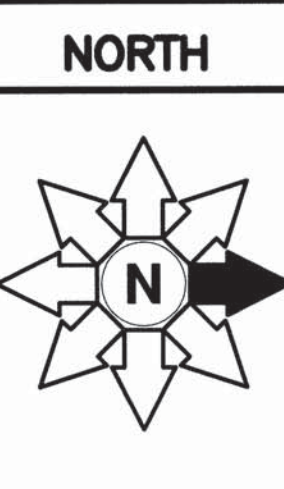

TRIDEL
4800 DUFFERIN STREET
TORONTO ONTARIO

PROJECT
SQ ALEXANDRA PARK
BLOCK 11
38 CAMERON ST. TORONTO

DWG TITLE
11TH FLOOR
SPRINKLER & STANDPIPE SYSTEM

DATE	PROJECT NO.
JULY 2014	14-10224
SCALE	DWG NO.
1:100	SP-14
DWN BY	ISSUED FOR REVISION NO.
H.W.	

IF SPRINKLER CONTRACTOR USES PLASTIC PIPING THEN THE FOLLOWING IS APPLICABLE.
 NOTE: CONTRACTOR TO INSTALL PLASTIC PIPING AS PER MANUFACTURER'S SPECIFICATIONS INCLUDING EXPANSION LOOP.

O.B.C. SECTION 3.2.5.14 COMBUSTIBLE SPRINKLER PIPING

- COMBUSTIBLE SPRINKLER PIPING SHALL BE USED ONLY FOR WET SYSTEMS IN RESIDENTIAL OCCUPANCIES AND OTHER LIGHT HAZARD OCCUPANCIES. (SEE APPENDIX A.)
- COMBUSTIBLE SPRINKLER PIPING SHALL MEET THE REQUIREMENTS OF ULC/ORD-199P-M, "COMBUSTIBLE PIPING FOR SPRINKLER SYSTEMS".
- COMBUSTIBLE SPRINKLER PIPING SHALL BE SEPARATED FROM THE AREA SERVED BY THE SPRINKLER SYSTEM AND FROM ANY OTHER FIRE COMPARTMENT BY CEILINGS, WALLS, OR SOFFITS CONSISTING AS A MINIMUM:
 - LATH AND PLASTER.
 - GYPSUM BOARD NOT LESS THAN 9.5 MM (3/8 IN) THICK
 - PLYWOOD NOT LESS THAN 13 MM (1/2 IN) THICK OR
 - A SUSPENDED MEMBRANE CEILING WITH
 - STEEL SUSPENSION GRID, AND
 - LAY-IN PANELS OR TILES HAVING A MASS NOT LESS THAN 1.7 KG/SQUARE METRE (0.35 LB/SQUARE FOOT)
- IF COMBUSTIBLE SPRINKLER PIPING IS LOCATED ABOVE A CEILING, AN OPENING THROUGH THE CEILING THAT IS NOT PROTECTED IN CONFORMANCE WITH SENTENCE (3) SHALL BE LOCATED SO THAT THE DISTANCE BETWEEN THE EDGE OF THE OPENING AND THE NEAREST SPRINKLER IS NOT MORE THAN 300 MM (11 3/4").
- THE PROTECTION REQUIRED BY SENTENCES (3) AND (4) IS PERMITTED TO BE WAIVED WHERE COMBUSTIBLE SPRINKLER PIPING HAS BEEN TESTED IN CONFORMANCE WITH ULC/ORD-C199P-M, "COMBUSTIBLE PIPING FOR SPRINKLER SYSTEMS", AND HAS BEEN SHOWN TO MEET THE REQUIREMENTS IN THAT DOCUMENT WITHOUT ADDITIONAL PROTECTION.

GENERAL NOTES

NOTE 1: IN BUILDINGS SPRINKLERED IN ACCORDANCE WITH NFPA 13, CLOSETS LESS THAN 12 SQ.FT. IN AREA IN INDIVIDUAL DWELLING UNITS SHALL NOT BE REQUIRED TO BE SPRINKLERED. CLOSETS THAT CONTAIN EQUIPMENT SUCH AS WASHERS, DRYERS, FURNACES, OR WATER HEATERS SHALL BE SPRINKLERED REGARDLESS OF SIZE AS PER NFPA-13 (2007) CLAUSE 21.20.19.2.1

NOTE 2: SPRINKLERS SHALL NOT BE REQUIRED IN BATHROOMS THAT ARE LOCATED WITHIN DWELLING UNITS, THAT DO NOT EXCEED 55 SQ.FT. IN AREA, AND THAT HAVE WALLS AND CEILINGS OF NONCOMBUSTIBLE OR LIMITED-COMBUSTIBLE MATERIALS WITH A 15-MINUTE THERMAL BARRIER RATING, INCLUDING THE WALLS AND CEILINGS BEHIND ANY SHOWER ENCLOSURE OR TUB. AS PER NFPA-13 (2007) CLAUSE 8.15.5.1.1

NOTE 3: WHERE SIDEWALL SPRINKLER IS INSTALLED AT SOFFIT (BULKHEAD) EXCEEDING MORE THAN 8" IN WIDTH, PENDENT SPRINKLERS SHALL BE INSTALLED UNDER THE SOFFIT (BULKHEAD).

NOTE 4: RESIDENTIAL SIDEWALL SPRINKLERS SHALL BE PERMITTED TO BE INSTALLED IN THE FACE OF A SOFFIT LOCATED DIRECTLY OVER CABINETS WITHOUT REQUIRING ADDITIONAL SPRINKLERS BELOW THE SOFFIT OR CABINETS WHERE THE SOFFIT DOES NOT PROJECT HORIZONTALLY MORE THAN 12" FROM THE WALL.

NOTE 5: IF CPVC PIPE IS USED, CONTRACTOR TO PROVIDE "EXPANSION OFFSET LOOP" ON STRAIGHT RUNS EXCEEDING 100 FT IN LENGTH.

NOTE 6: ANY FIRE STOPPING, ACOUSTIC SEALANT AND MATERIALS USED IN THIS PROJECT WHICH COME IN CONTACT WITH CPVC SPRINKLER PIPING IS TO BE COMPATIBLE WITH CPVC PIPING.




NOTE 7: SPRINKLERS TO BE A MINIMUM 3"-0" FROM EDGE OF ALL SURFACE MOUNTED LIGHT FIXTURE.

SPRINKLER LAYOUT BASED ON BULKHEADS BEING MAXIMUM 12" DEEP. ADDITIONAL SIDEWALL SPRINKLERS MAY BE REQUIRED IF BULKHEAD DEPTH EXCEEDS 12".

PROTECTION AREA PER RESIDENTIAL CONCEALED PENDENT SPRINKLERS SHALL NOT EXCEED 300 SQ.FT. MAX. SPACING IS 20 FT. PROTECTION AREA PER RESIDENTIAL CONCEALED SIDEWALL SPRINKLER SHALL NOT EXCEED 256 SQ.FT. (16 FT. X 16 FT.)

CONTRACTOR SHALL COORDINATE WITH LIGHTING, DIFFUSER & INTERIOR DESIGN DRAWINGS PRIOR TO INSTALLATION OF SPRINKLER SYSTEM.

THE HEIGHT OF THE BULKHEAD NOT TO EXCEED 12" AS PER ARCHITECTURAL DRAWING.

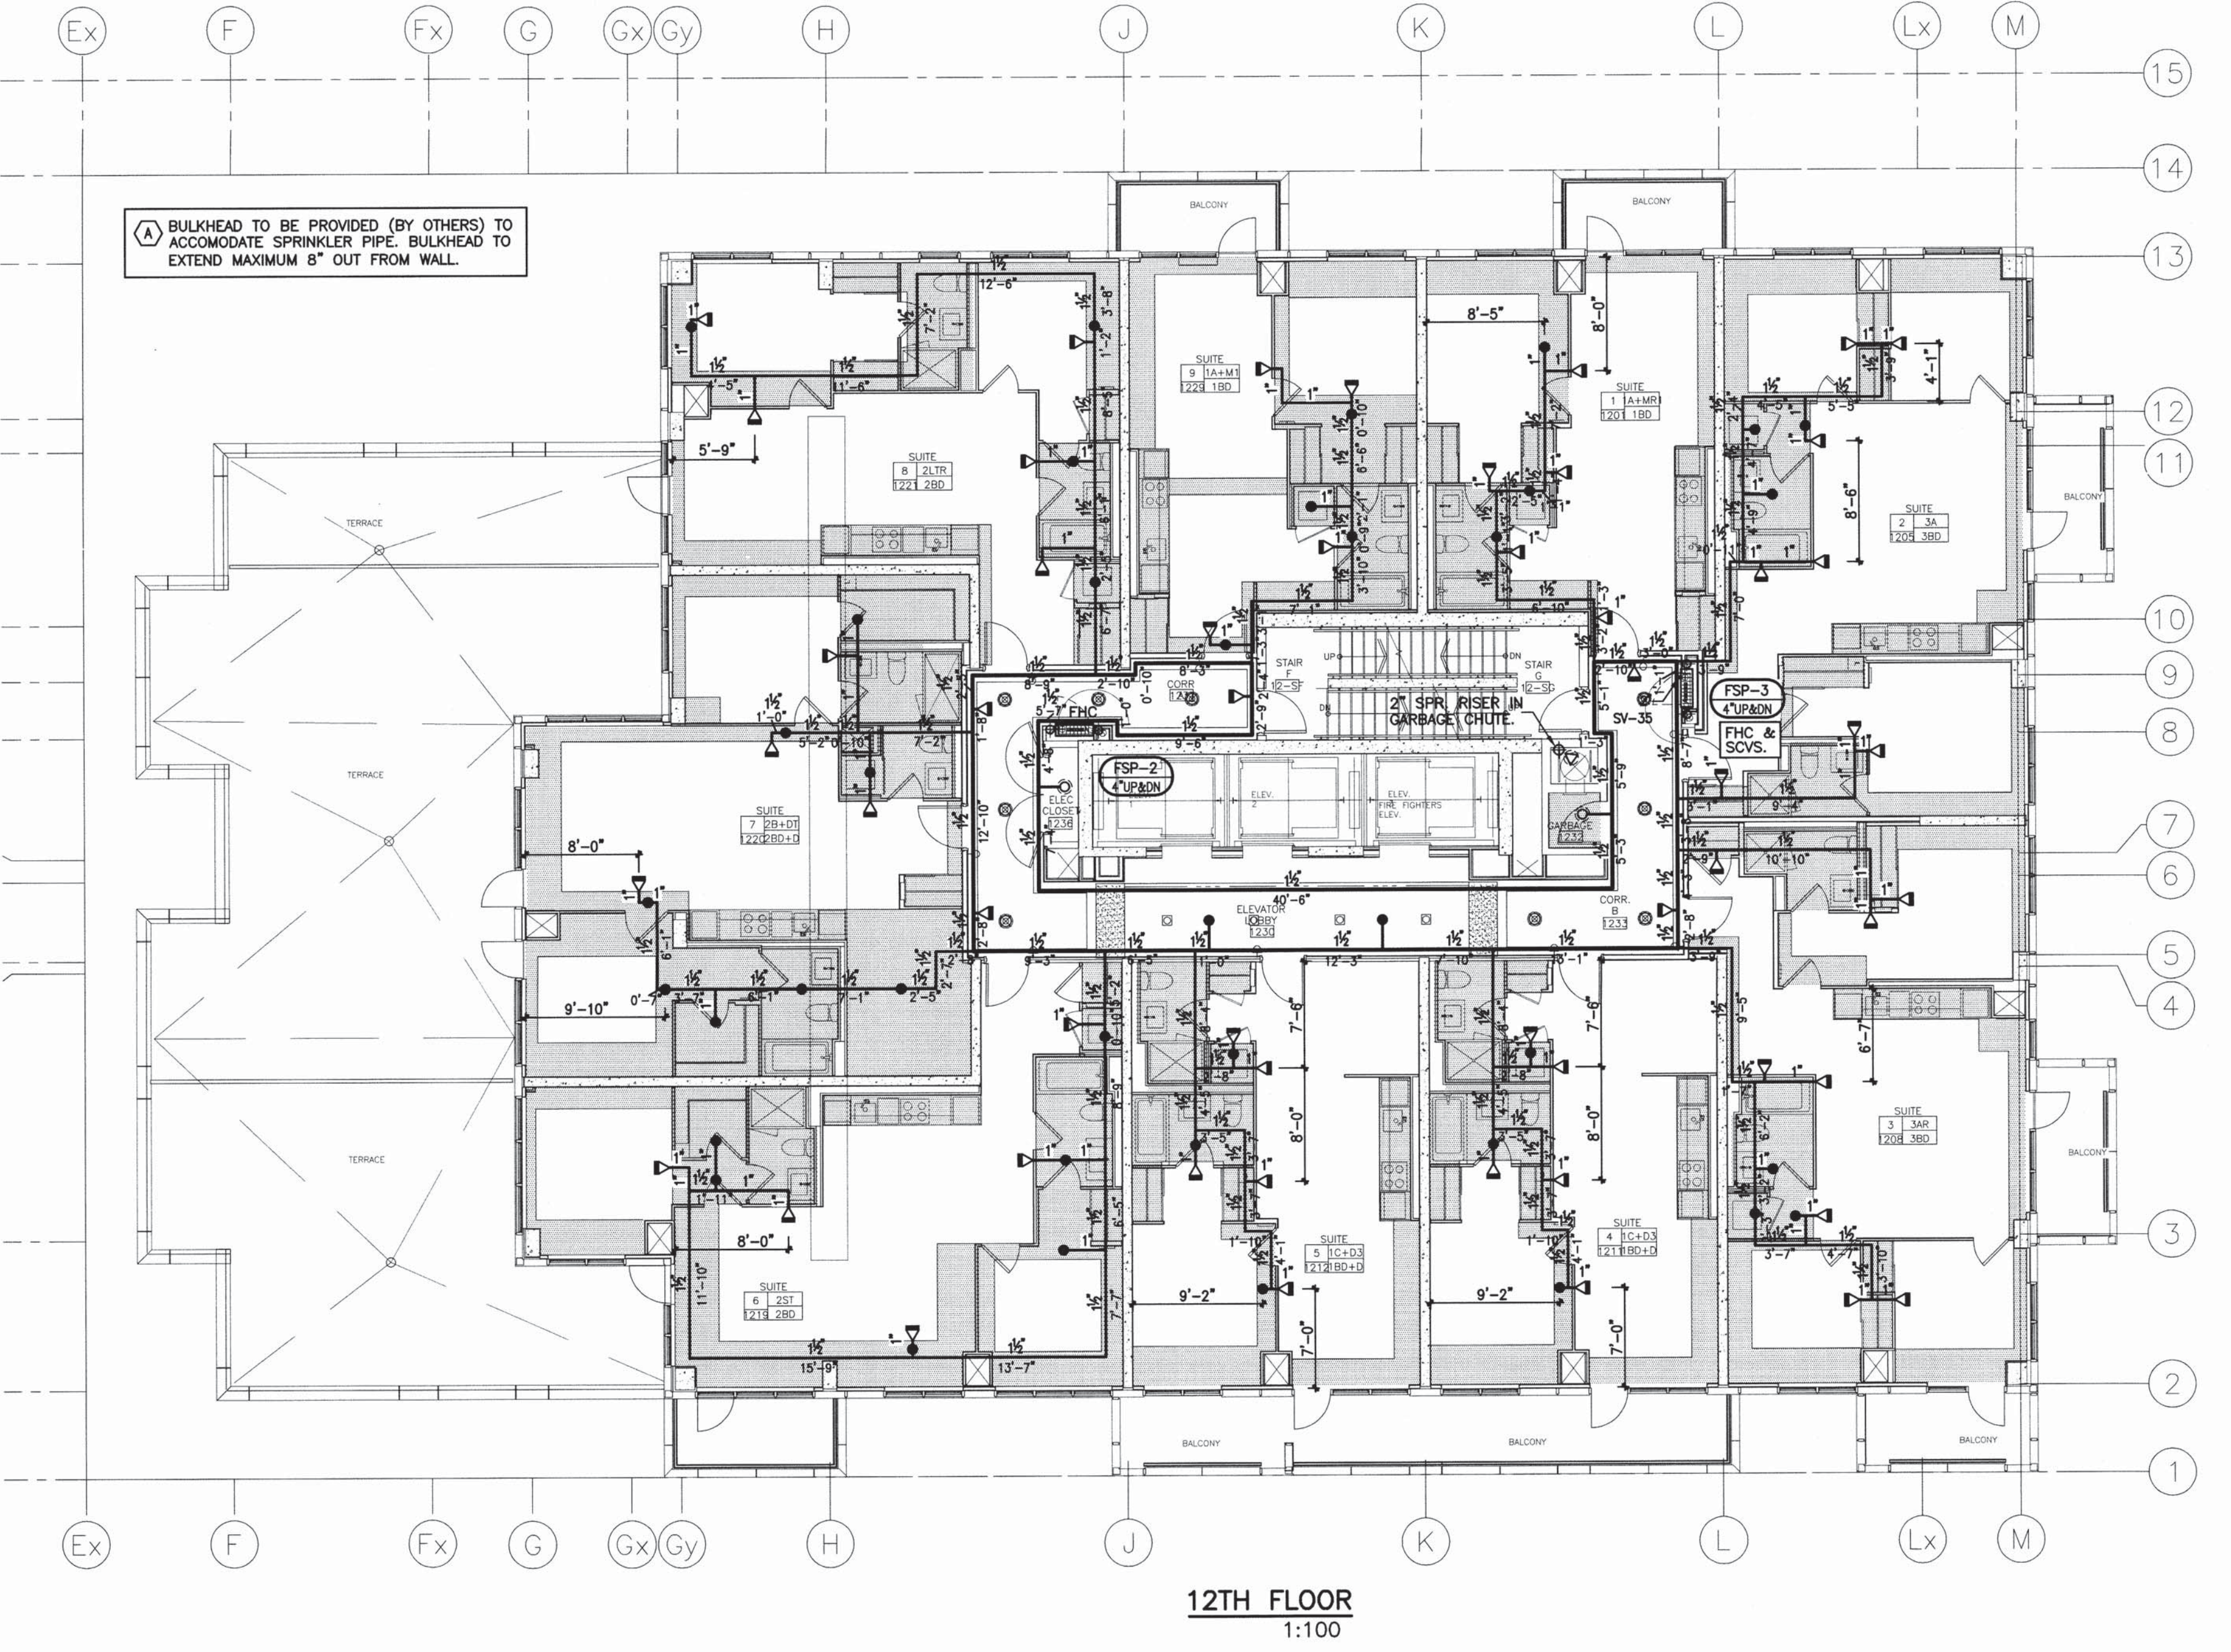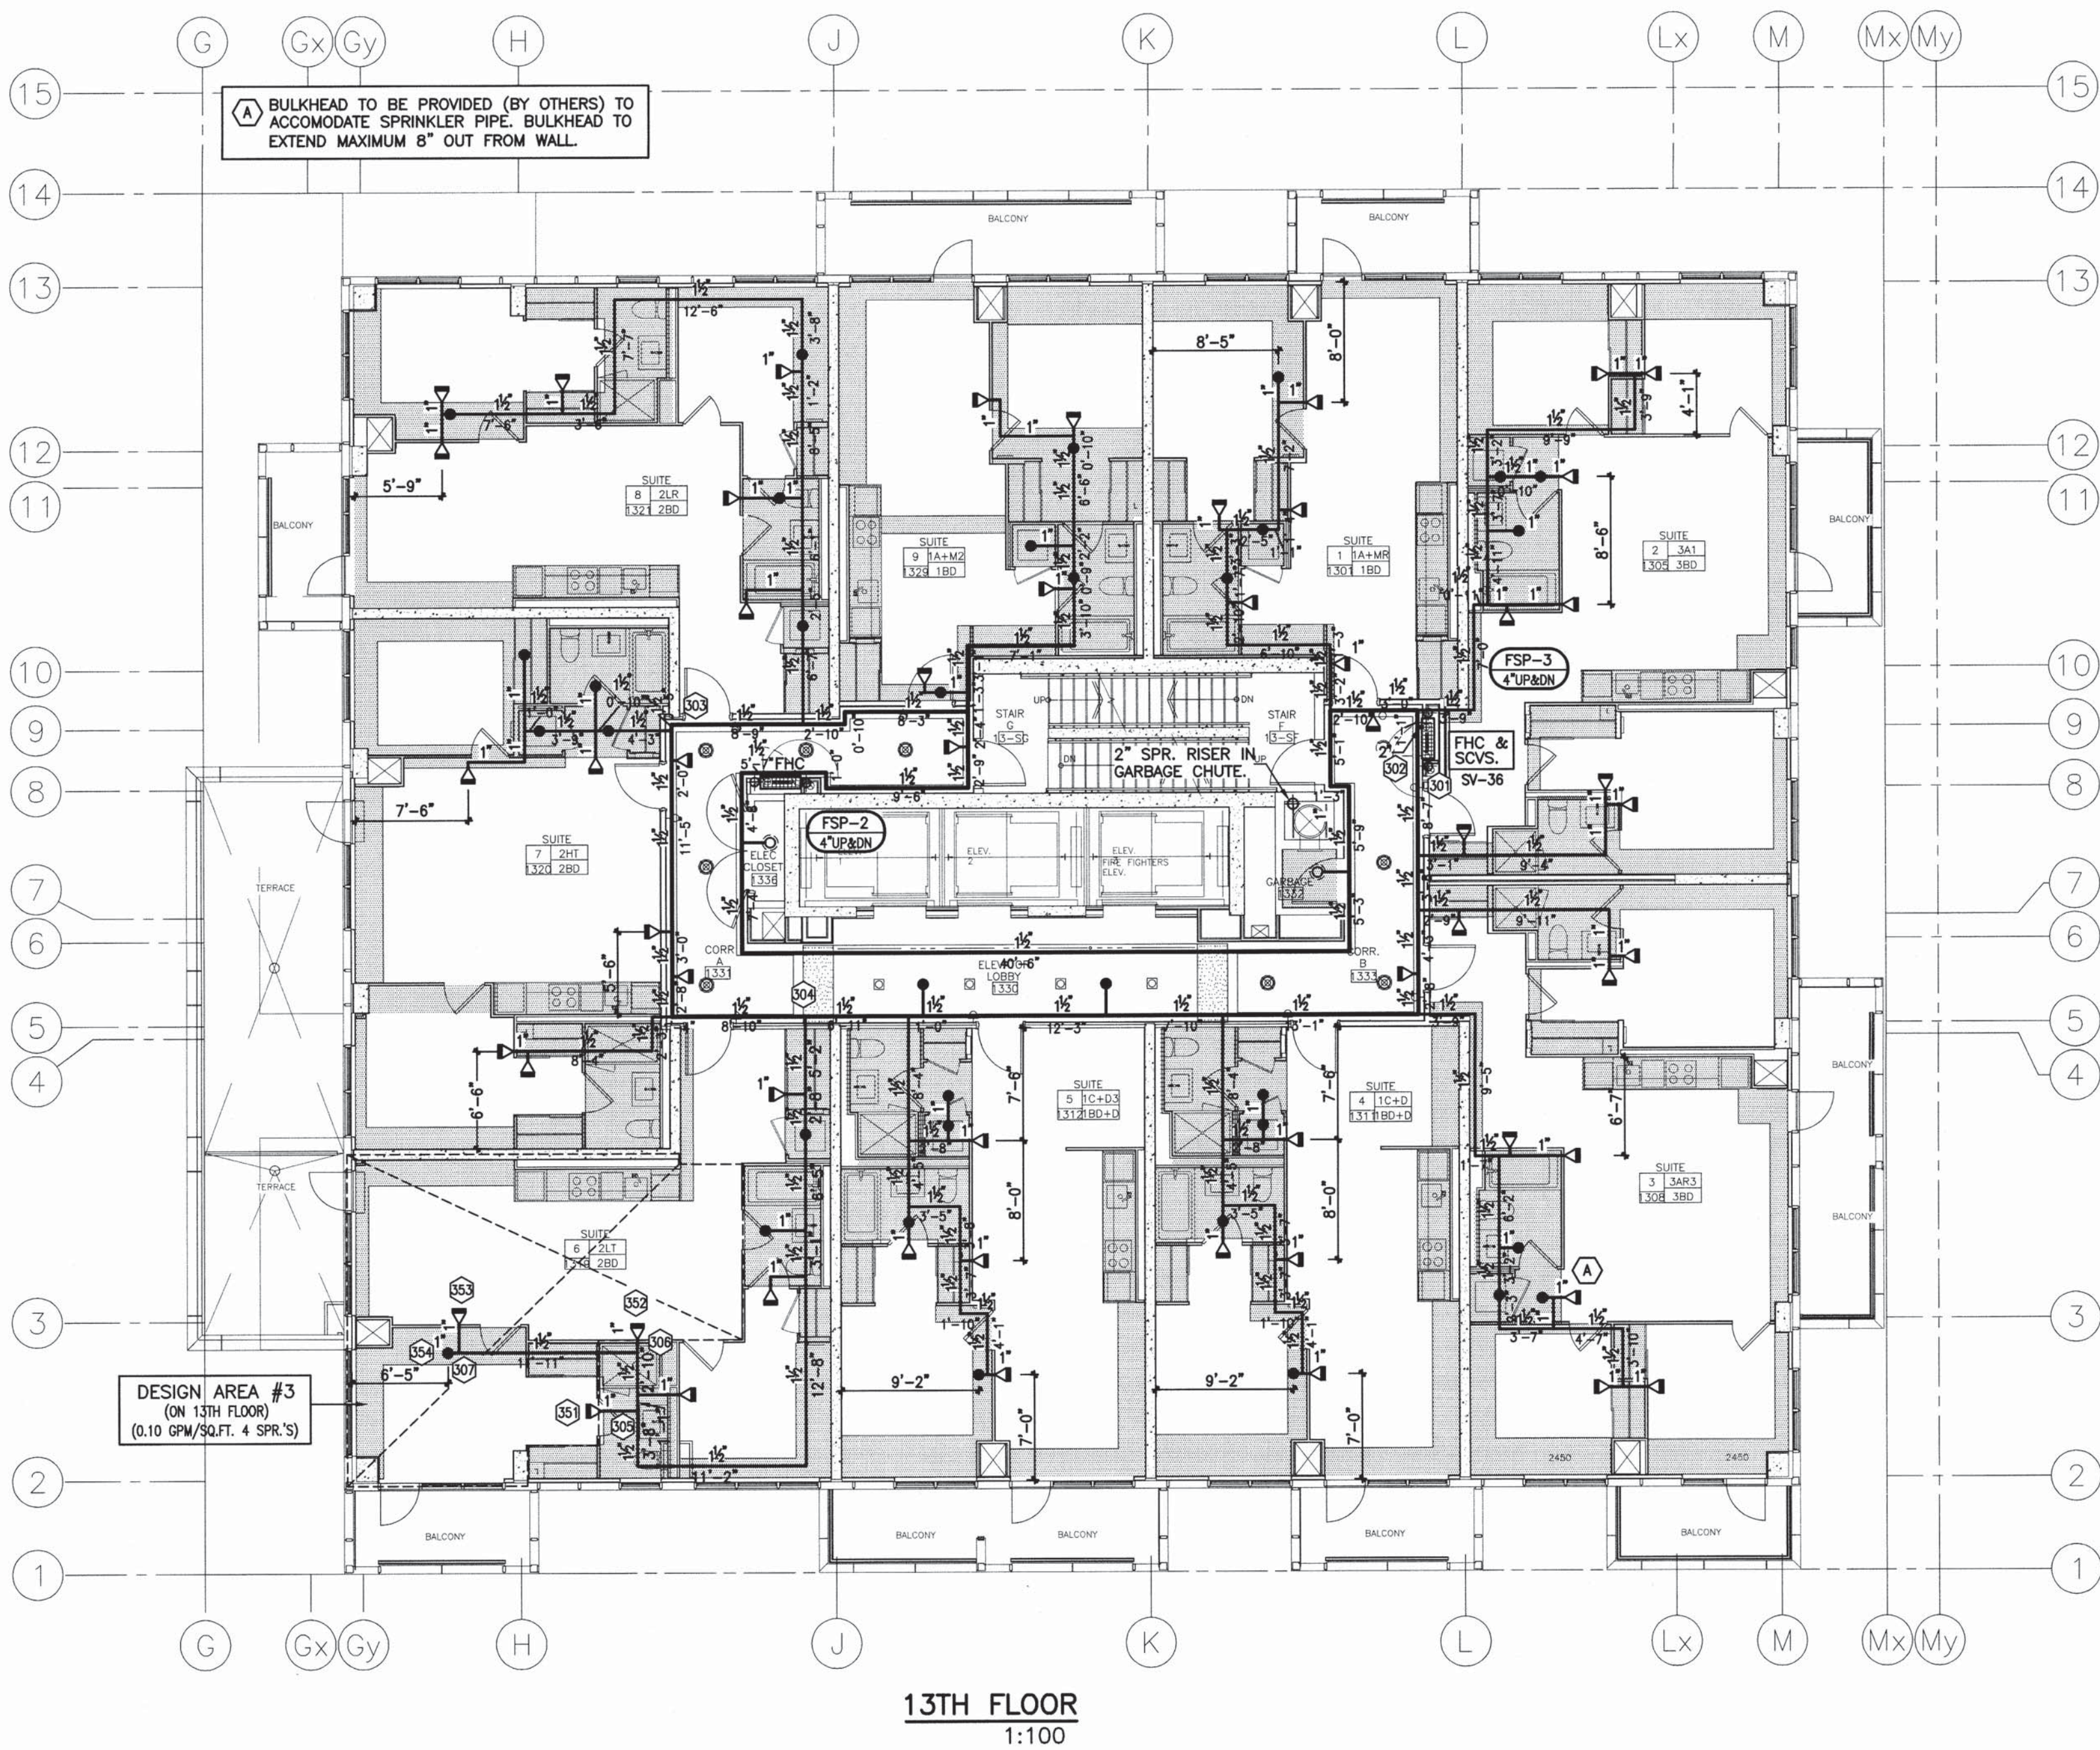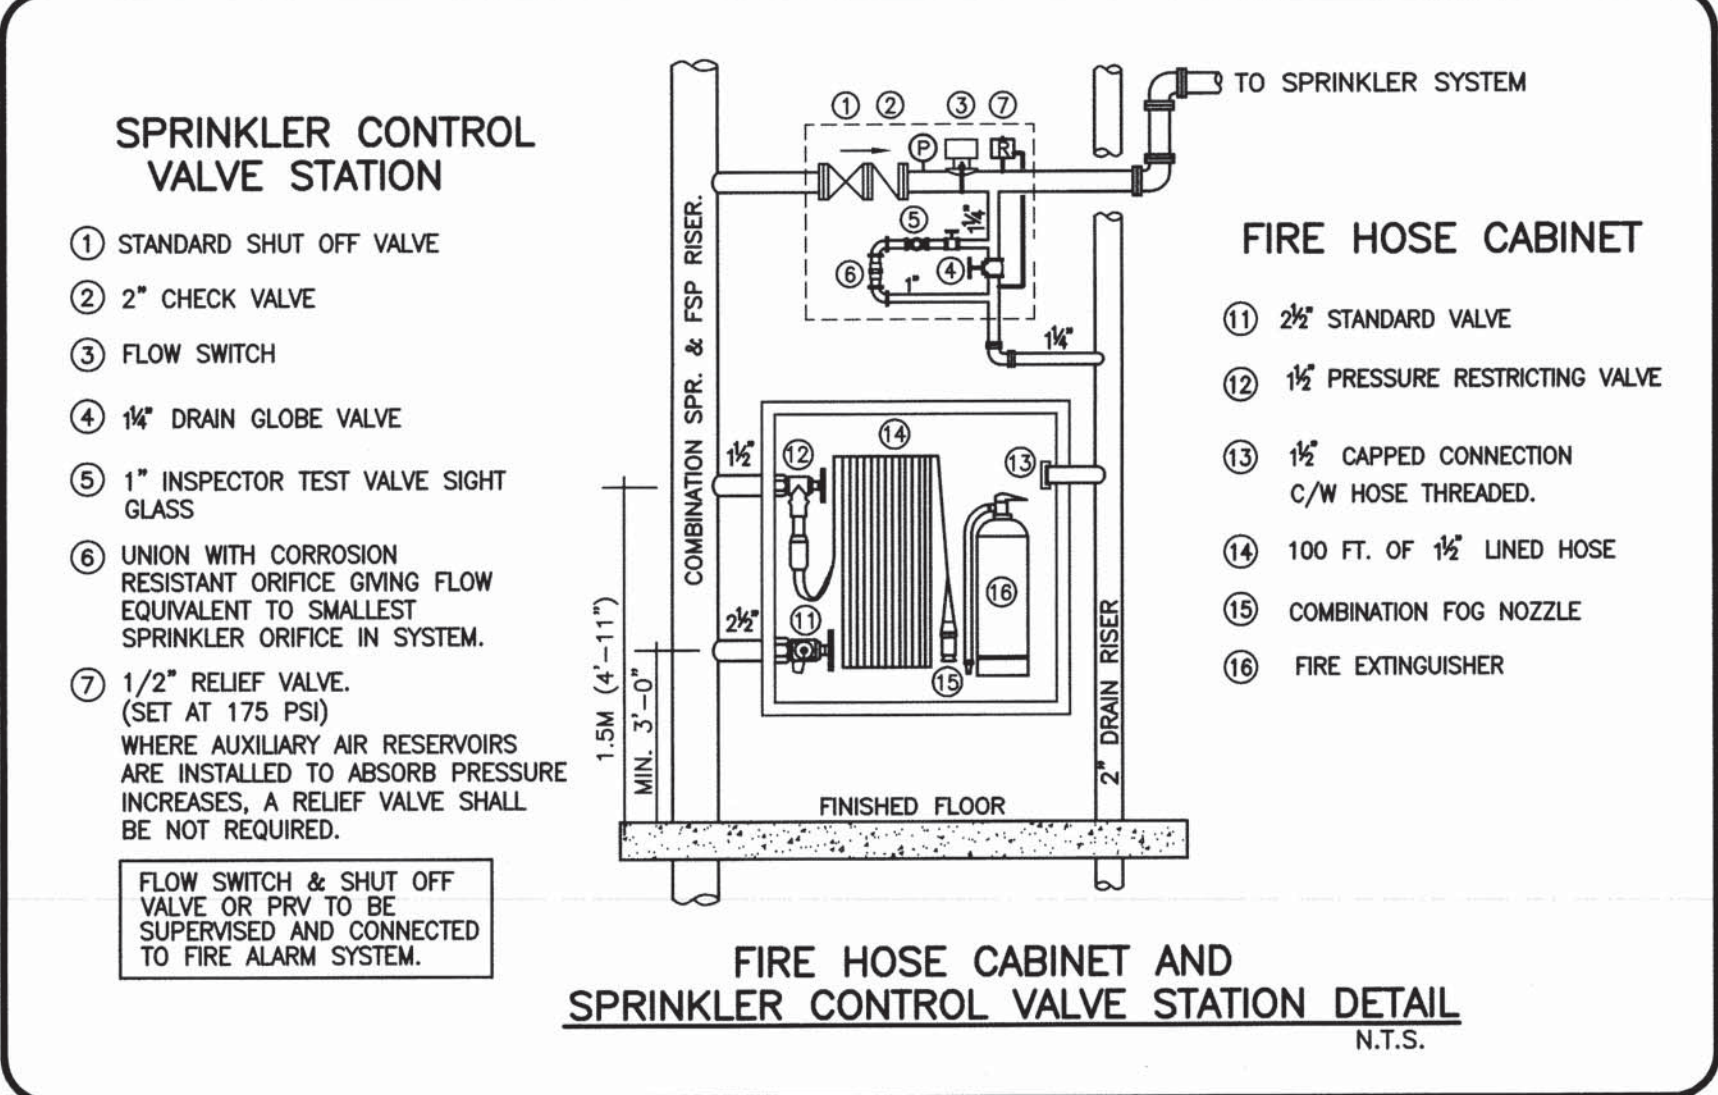

NO.	REVISIONS	DATE
2.	RE-ISSUED FOR PERMIT.	AUG. 15 2014
3.	REVISED LAYOUT AS PER TEEPLE ARCHITECTS COMMENTS DATED IN JUN.08, 2015	JUN. 08 2015
5.	ISSUED FOR CONSTRUCTION.	OCT. 2 2015

NOTES

--- THIS DRAWING ASSOCIATED CALCULATIONS AND SPECIFICATIONS ARE THE PROPERTY OF THE DESIGNER AND MUST BE RETURNED AT THE COMPLETION OF THE WORK OR UPON REQUEST.

--- ALL MAIN MEASUREMENTS ARE GIVEN AS CENTER LINE TO CENTER LINE DIMENSIONS UNLESS OTHERWISE NOTED.

--- THE SPRINKLER SYSTEM IS TO BE INSTALLED AS PER N.F.P.A. STANDARD # 13 AND O.B.C. STANDARDS.

--- CONTRACTOR TO INCLUDE FOR OFFSETS IN BRANCH LINES AND MAINS WHERE REQUIRED.

--- ALL MATERIALS TO BE U.L.C. LISTED AND APPROVED BY LOCAL AUTHORITY.

--- UNDERGROUND WATERMAIN TO BE INSTALLED ACCORDING TO LOCAL AUTHORITY STANDARDS AND INSURANCE CO. STANDARDS.

--- INSTALL HIGH TEMPERATURE HEADS WHERE REQUIRED AS PER N.F.P.A. STANDARD # 13.

--- ALL CENTER LINE TO CENTER LINE MEASUREMENTS ARE GIVEN (S&L TO PIPE)

--- ALL OTHER BRANCH LINE MEASUREMENTS ARE GIVEN AS CENTER LINE TO CENTER LINE TO CENTER LINE (S&L TO PIPE)

--- ALL MAIN MEASUREMENTS ARE GIVEN AS CENTER LINE TO CENTER LINE DIMENSIONS (O/W WALL PIPE)

--- DENOTES DISTANCE IN INCHES FROM CENTER LINE OF PIPE TO UNDERSIDE OF CEILING.

--- RN DENOTES RISER WIPPLE.

--- ON DENOTES DOWN.

--- ALL SUPERHEATED VALVES (PRESSURE) SWITCHES AND LOW PRESSURE MONITORING SWITCHES TO BE CONNECTED TO FIRE ALARM SYSTEM, IF F.A.S. IS INSTALLED.

--- CONTRACTOR TO VISIT SITE TO DETERMINE EXACT LOCATION AND ELEVATION OF MAINS TO BE INSTALLED AS INDICATED ON DRAWINGS. ANY MAINS TO BE INSTALLED AS REPORTED TO THE DESIGNER PRIOR TO FABRICATION AND INSTALLATION.

OWNER (OR OTHERS) TO PROVIDE ADEQUATE HEAT IN ALL AREAS OF BUILDING SUBJECT TO FREEZING THAT ARE PROTECTED BY A WET TYPE SPRINKLER SYSTEM.

ALL GLASS BULB TYPE SPRINKLERS TO BE OF RECENT ISSUE. MANUFACTURE DATE OF AT LEAST YEAR 2013.

SYMBOL	DESCRIPTION	QUANTITY
⊙	1/2" 155F STANDARD COVERAGE CONCEALED PENDENT (K=5.6) Q/R	00
⊙	1/2" 155F STANDARD COVERAGE UPRIGHT (K=5.6) Q/R	4
●	1/2" 155F RESIDENTIAL CONCEALED PENDENT (K=4.9)	73
◁	1/2" 155F RESIDENTIAL CONCEALED SIDEWALL (K=4.0)	109
◁	1/2" 165F STANDARD COVERAGE SIDEWALL (K=5.6) Q/R	1
▬	FIRE HOSE RACK - 100 FT OF 1 1/2" LINED HOSE C/W COMBINATION FOG NOZZLE	4



DESIGN CRITERIA

DESIGNED FOR RESIDENTIAL SPRINKLERS AS PER NFPA 13 SECTION 11.3.1 (2010 ED.).

DESIGN AREA TO INCLUDE THE FOUR ADJACENT SPRINKLERS THAT PRODUCE THE GREATEST HYDRAULIC DEMAND.

THE REQUIRED DISCHARGE FROM EACH SPRINKLER SHALL BE THE GREATER OF THE FOLLOWING:

- MIN. FLOW RATES INDICATED IN SPR. LISTING.
- MIN. 0.10 GPM/SQ.FT. OVER DESIGN AREA.

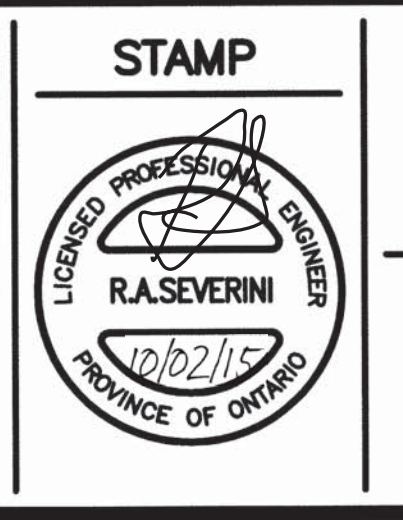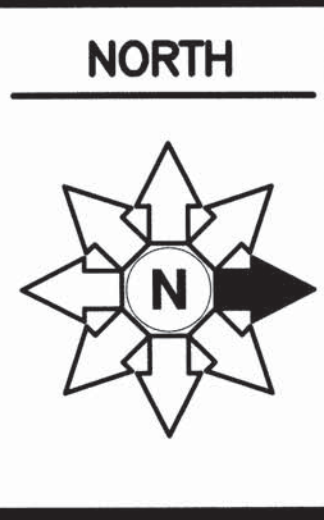

TRIDEL
4800 DUFFERIN STREET
TORONTO ONTARIO

PROJECT
SQ ALEXANDRA PARK
BLOCK 11
38 CAMERON ST. TORONTO

DWG TITLE
12TH & 13TH FLOOR
SPRINKLER & STANDPIPE SYSTEM

DATE
JULY 2014

SCALE
1:100

DWN BY
H.W.

ISSUED FOR REVISION NO.

PROJECT NO.
14-10224

DWG NO.
SP-15

OF 16

IF SPRINKLER CONTRACTOR USES PLASTIC PIPING THEN THE FOLLOWING IS APPLICABLE.
 NOTE: CONTRACTOR TO INSTALL PLASTIC PIPING AS PER MANUFACTURER'S SPECIFICATIONS INCLUDING EXPANSION LOOP.

O.B.C. SECTION 3.2.5.14 COMBUSTIBLE SPRINKLER PIPING

- COMBUSTIBLE SPRINKLER PIPING SHALL BE USED ONLY FOR WET SYSTEMS IN RESIDENTIAL OCCUPANCIES AND OTHER LIGHT HAZARD OCCUPANCIES. (SEE APPENDIX A.)
- COMBUSTIBLE SPRINKLER PIPING SHALL MEET THE REQUIREMENTS OF ULC/ORD-1999-M, "COMBUSTIBLE PIPING FOR SPRINKLER SYSTEMS".
- COMBUSTIBLE SPRINKLER PIPING SHALL BE SEPARATED FROM THE AREA SERVED BY THE SPRINKLER SYSTEM AND FROM ANY OTHER FIRE COMPARTMENT BY CEILINGS, WALLS, OR SOFFITS CONSISTING AS A MINIMUM,
 - LATH AND PLASTER.
 - GYPSUM BOARD NOT LESS THAN 9.5 MM (3/8 IN) THICK
 - PLYWOOD NOT LESS THAN 13 MM (1/2 IN) THICK OR
 - A SUSPENDED MEMBRANE CEILING WITH
 - STEEL SUSPENSION GRID, AND
 - LAY-IN PANELS OR TILES HAVING A MASS NOT LESS THAN 1.7 KG/SQUARE METRE (0.35 LB/SQUARE FOOT)
- IF COMBUSTIBLE SPRINKLER PIPING IS LOCATED ABOVE A CEILING, AN OPENING THROUGH THE CEILING THAT IS NOT PROTECTED IN CONFORMANCE WITH SENTENCE (3) SHALL BE LOCATED SO THAT THE DISTANCE BETWEEN THE EDGE OF THE OPENING AND THE NEAREST SPRINKLER IS NOT MORE THAN 300 MM (11 3/4").
- THE PROTECTION REQUIRED BY SENTENCES (3) AND (4) IS PERMITTED TO BE WAIVED WHERE COMBUSTIBLE SPRINKLER PIPING HAS BEEN TESTED IN CONFORMANCE WITH ULC/ORD-C1999-M, "COMBUSTIBLE PIPING FOR SPRINKLER SYSTEMS", AND HAS BEEN SHOWN TO MEET THE REQUIREMENTS IN THAT DOCUMENT WITHOUT ADDITIONAL PROTECTION.

GENERAL NOTES

NOTE 1:
 IN BUILDINGS SPRINKLERED IN ACCORDANCE WITH NFPA 13, CLOSETS LESS THAN 12 SQ.FT. IN AREA IN INDIVIDUAL DWELLING UNITS SHALL NOT BE REQUIRED TO BE SPRINKLERED. CLOSETS THAT CONTAIN EQUIPMENT SUCH AS WASHERS, DRYERS, FURNACES, OR WATER HEATERS SHALL BE SPRINKLERED REGARDLESS OF SIZE.
 AS PER NFPA-13 (2007) CLAUSE 21.20.19.2.1

NOTE 2:
 SPRINKLERS SHALL NOT BE REQUIRED IN BATHROOMS THAT ARE LOCATED WITHIN DWELLING UNITS, THAT DO NOT EXCEED 55 SQ.FT. IN AREA, AND THAT HAVE WALLS AND CEILINGS OF NONCOMBUSTIBLE OR LIMITED-COMBUSTIBLE MATERIALS WITH A 15-MINUTE THERMAL BARRIER RATING, INCLUDING THE WALLS AND CEILINGS BEHIND ANY SHOWER ENCLOSURE OR TUB.
 AS PER NFPA-13 (2007) CLAUSE 8.15.8.1.1

NOTE 3:
 WHERE SIDEWALL SPRINKLER IS INSTALLED AT SOFFIT (BULKHEAD) EXCEEDING MORE THAN 8" IN WIDTH, PENDENT SPRINKLERS SHALL BE INSTALLED UNDER THE SOFFIT (BULKHEAD).

NOTE 4:
 RESIDENTIAL SIDEWALL SPRINKLERS SHALL BE PERMITTED TO BE INSTALLED IN THE FACE OF A SOFFIT LOCATED DIRECTLY OVER CABINETS WITHOUT REQUIRING ADDITIONAL SPRINKLERS BELOW THE SOFFIT OR CABINETS WHERE THE SOFFIT DOES NOT PROJECT HORIZONTALLY MORE THAN 12" FROM THE WALL.

NOTE 5:
 IF CPVC PIPE IS USED, CONTRACTOR TO PROVIDE "EXPANSION OFFSET LOOP" ON STRAIGHT RUNS EXCEEDING 100 FT IN LENGTH.

NOTE 6:
 ANY FIRE STOPPING, ACOUSTIC SEALANT AND MATERIALS USED IN THIS PROJECT WHICH COME IN CONTACT WITH CPVC SPRINKLER PIPING IS TO BE COMPATIBLE WITH CPVC PIPING




NOTE 7:
 SPRINKLERS TO BE A MINIMUM 3"-0" FROM EDGE OF ALL SURFACE MOUNTED LIGHT FIXTURE.

SPRINKLER LAYOUT BASED ON BULKHEADS BEING MAXIMUM 12" DEEP. ADDITIONAL SIDEWALL SPRINKLERS MAY BE REQUIRED IF BULKHEAD DEPTH EXCEEDS 12".

PROTECTION AREA PER RESIDENTIAL CONCEALED PENDENT SPRINKLER SHALL NOT EXCEED 300 SQ.FT. MAX. SPACING IS 20 FT. PROTECTION AREA PER RESIDENTIAL CONCEALED SIDEWALL SPRINKLER SHALL NOT EXCEED 256 SQ.FT. (16 FT. X 16 FT.)

CONTRACTOR SHALL COORDINATE WITH LIGHTING, DIFFUSER & INTERIOR DESIGN DRAWINGS PRIOR TO INSTALLATION OF SPRINKLER SYSTEM.

THE HEIGHT OF THE BULKHEAD NOT TO EXCEED 12" AS PER ARCHITECTURAL DRAWING.

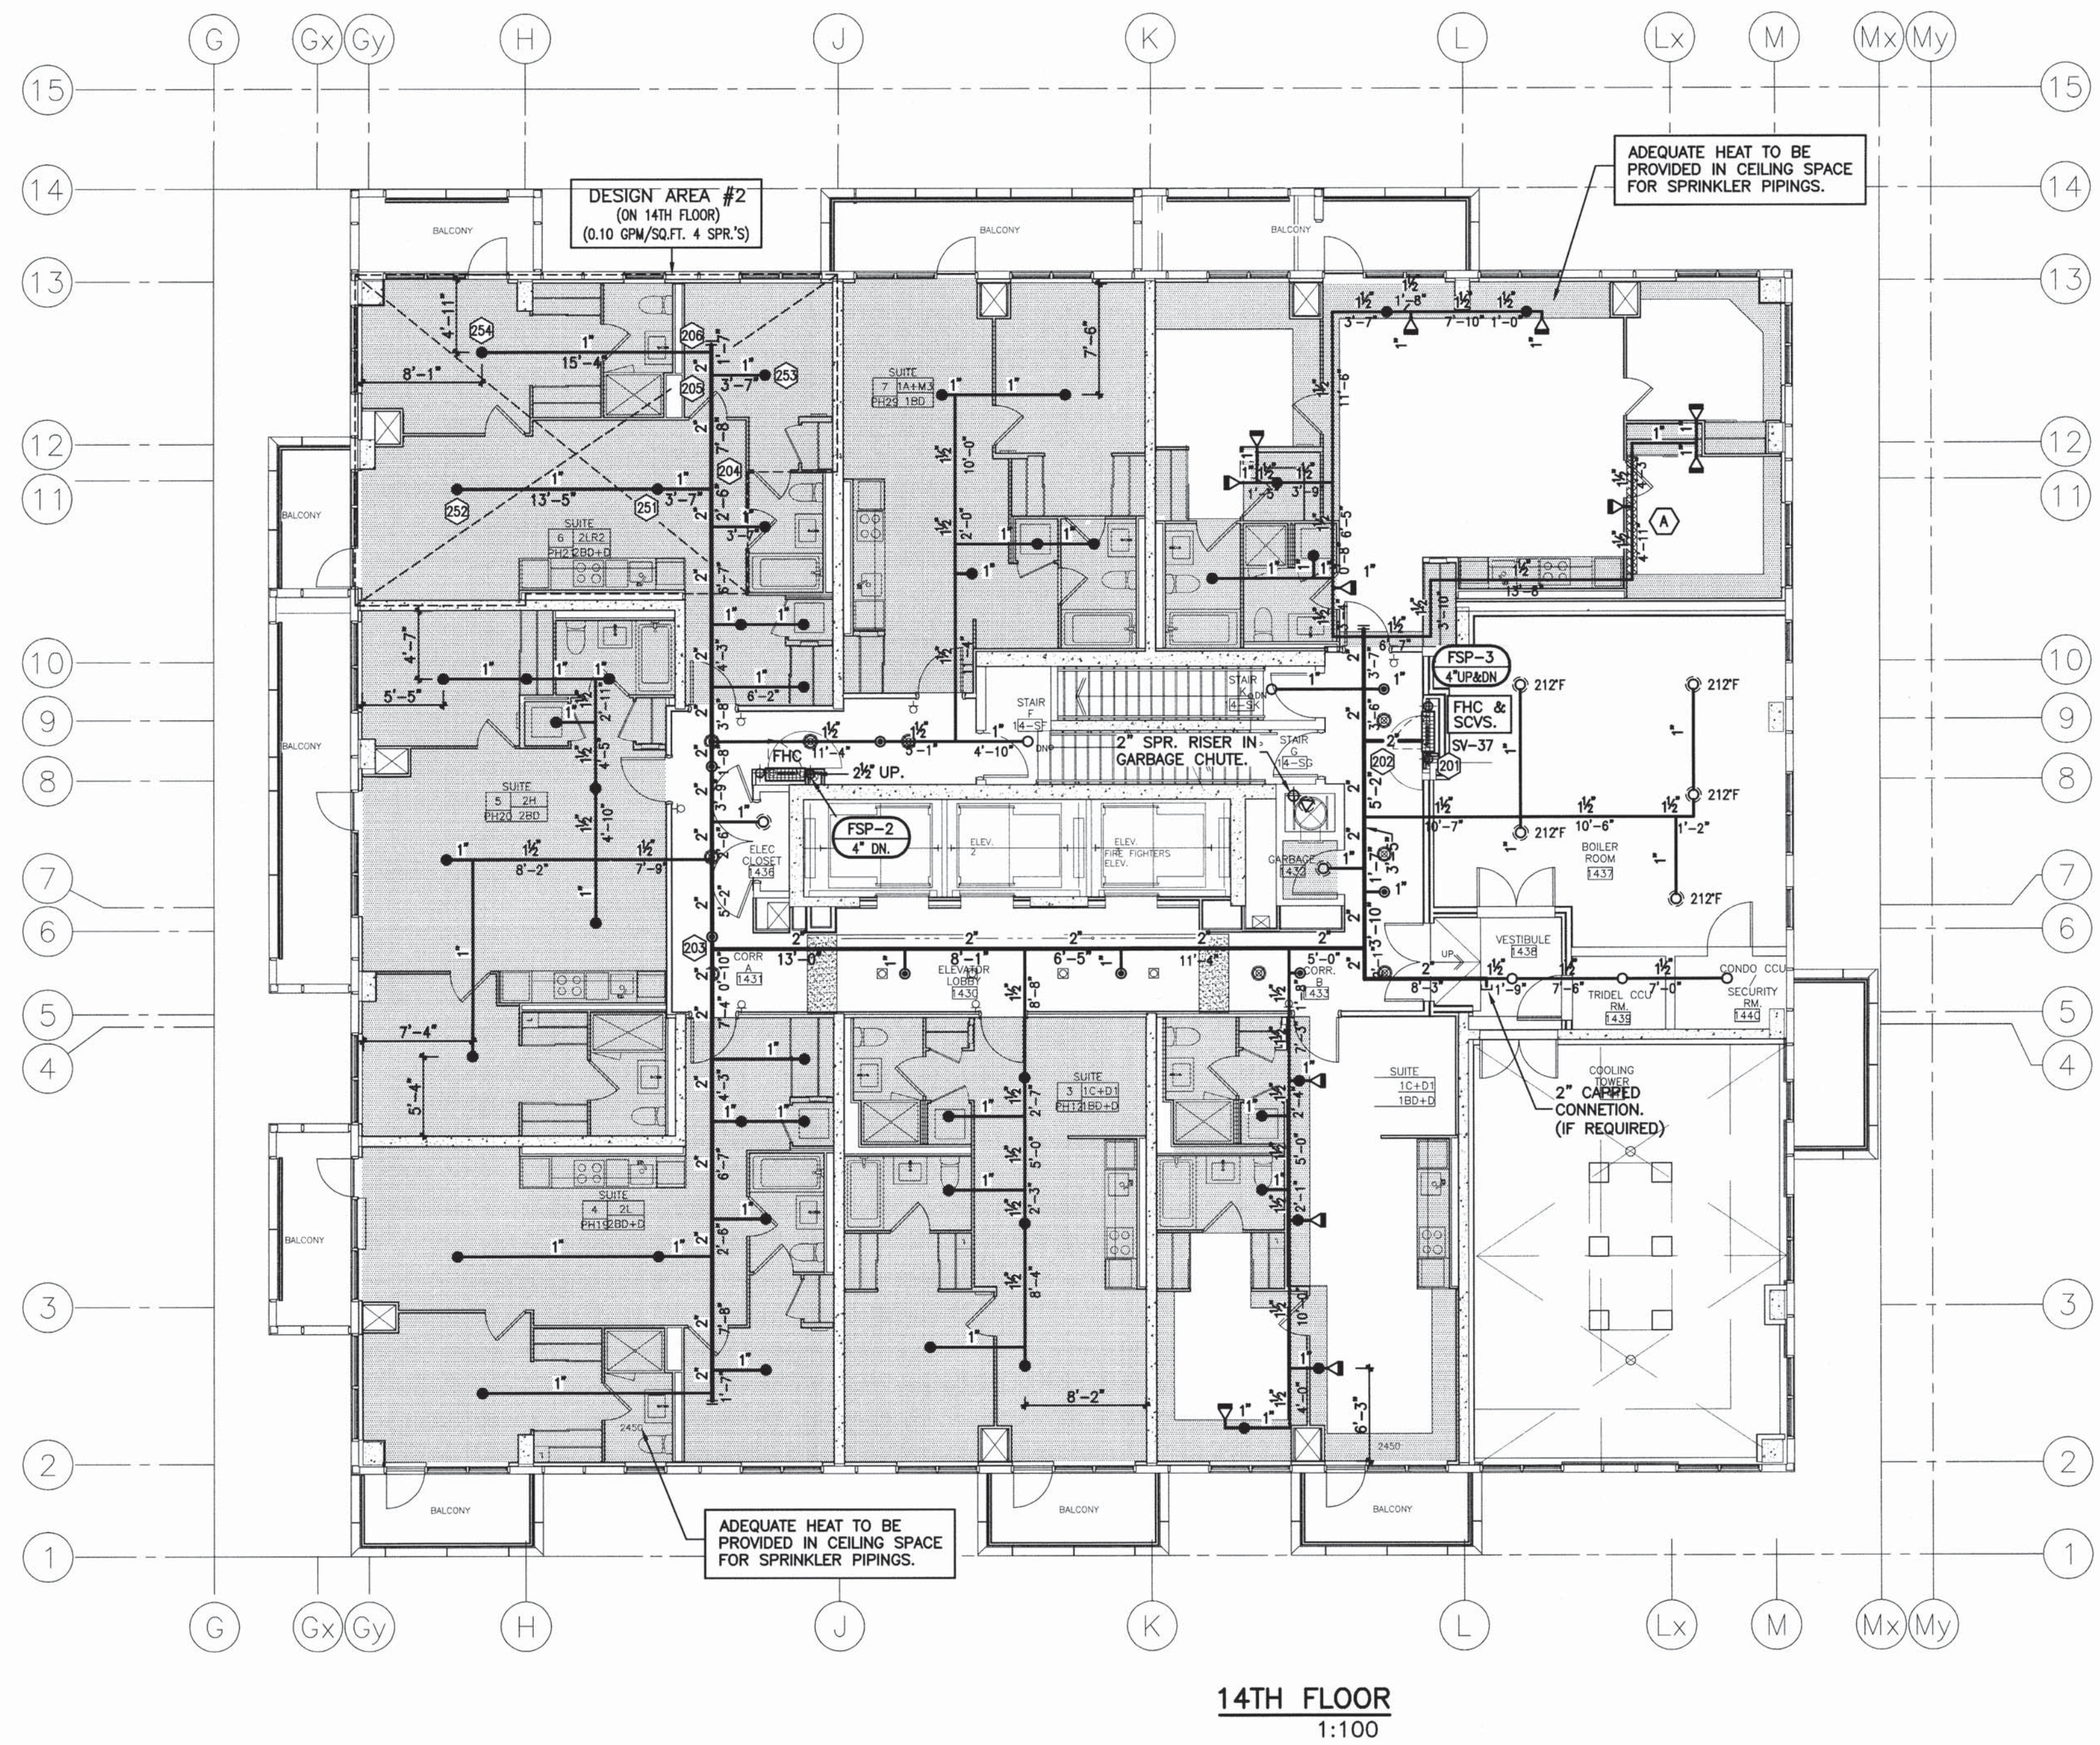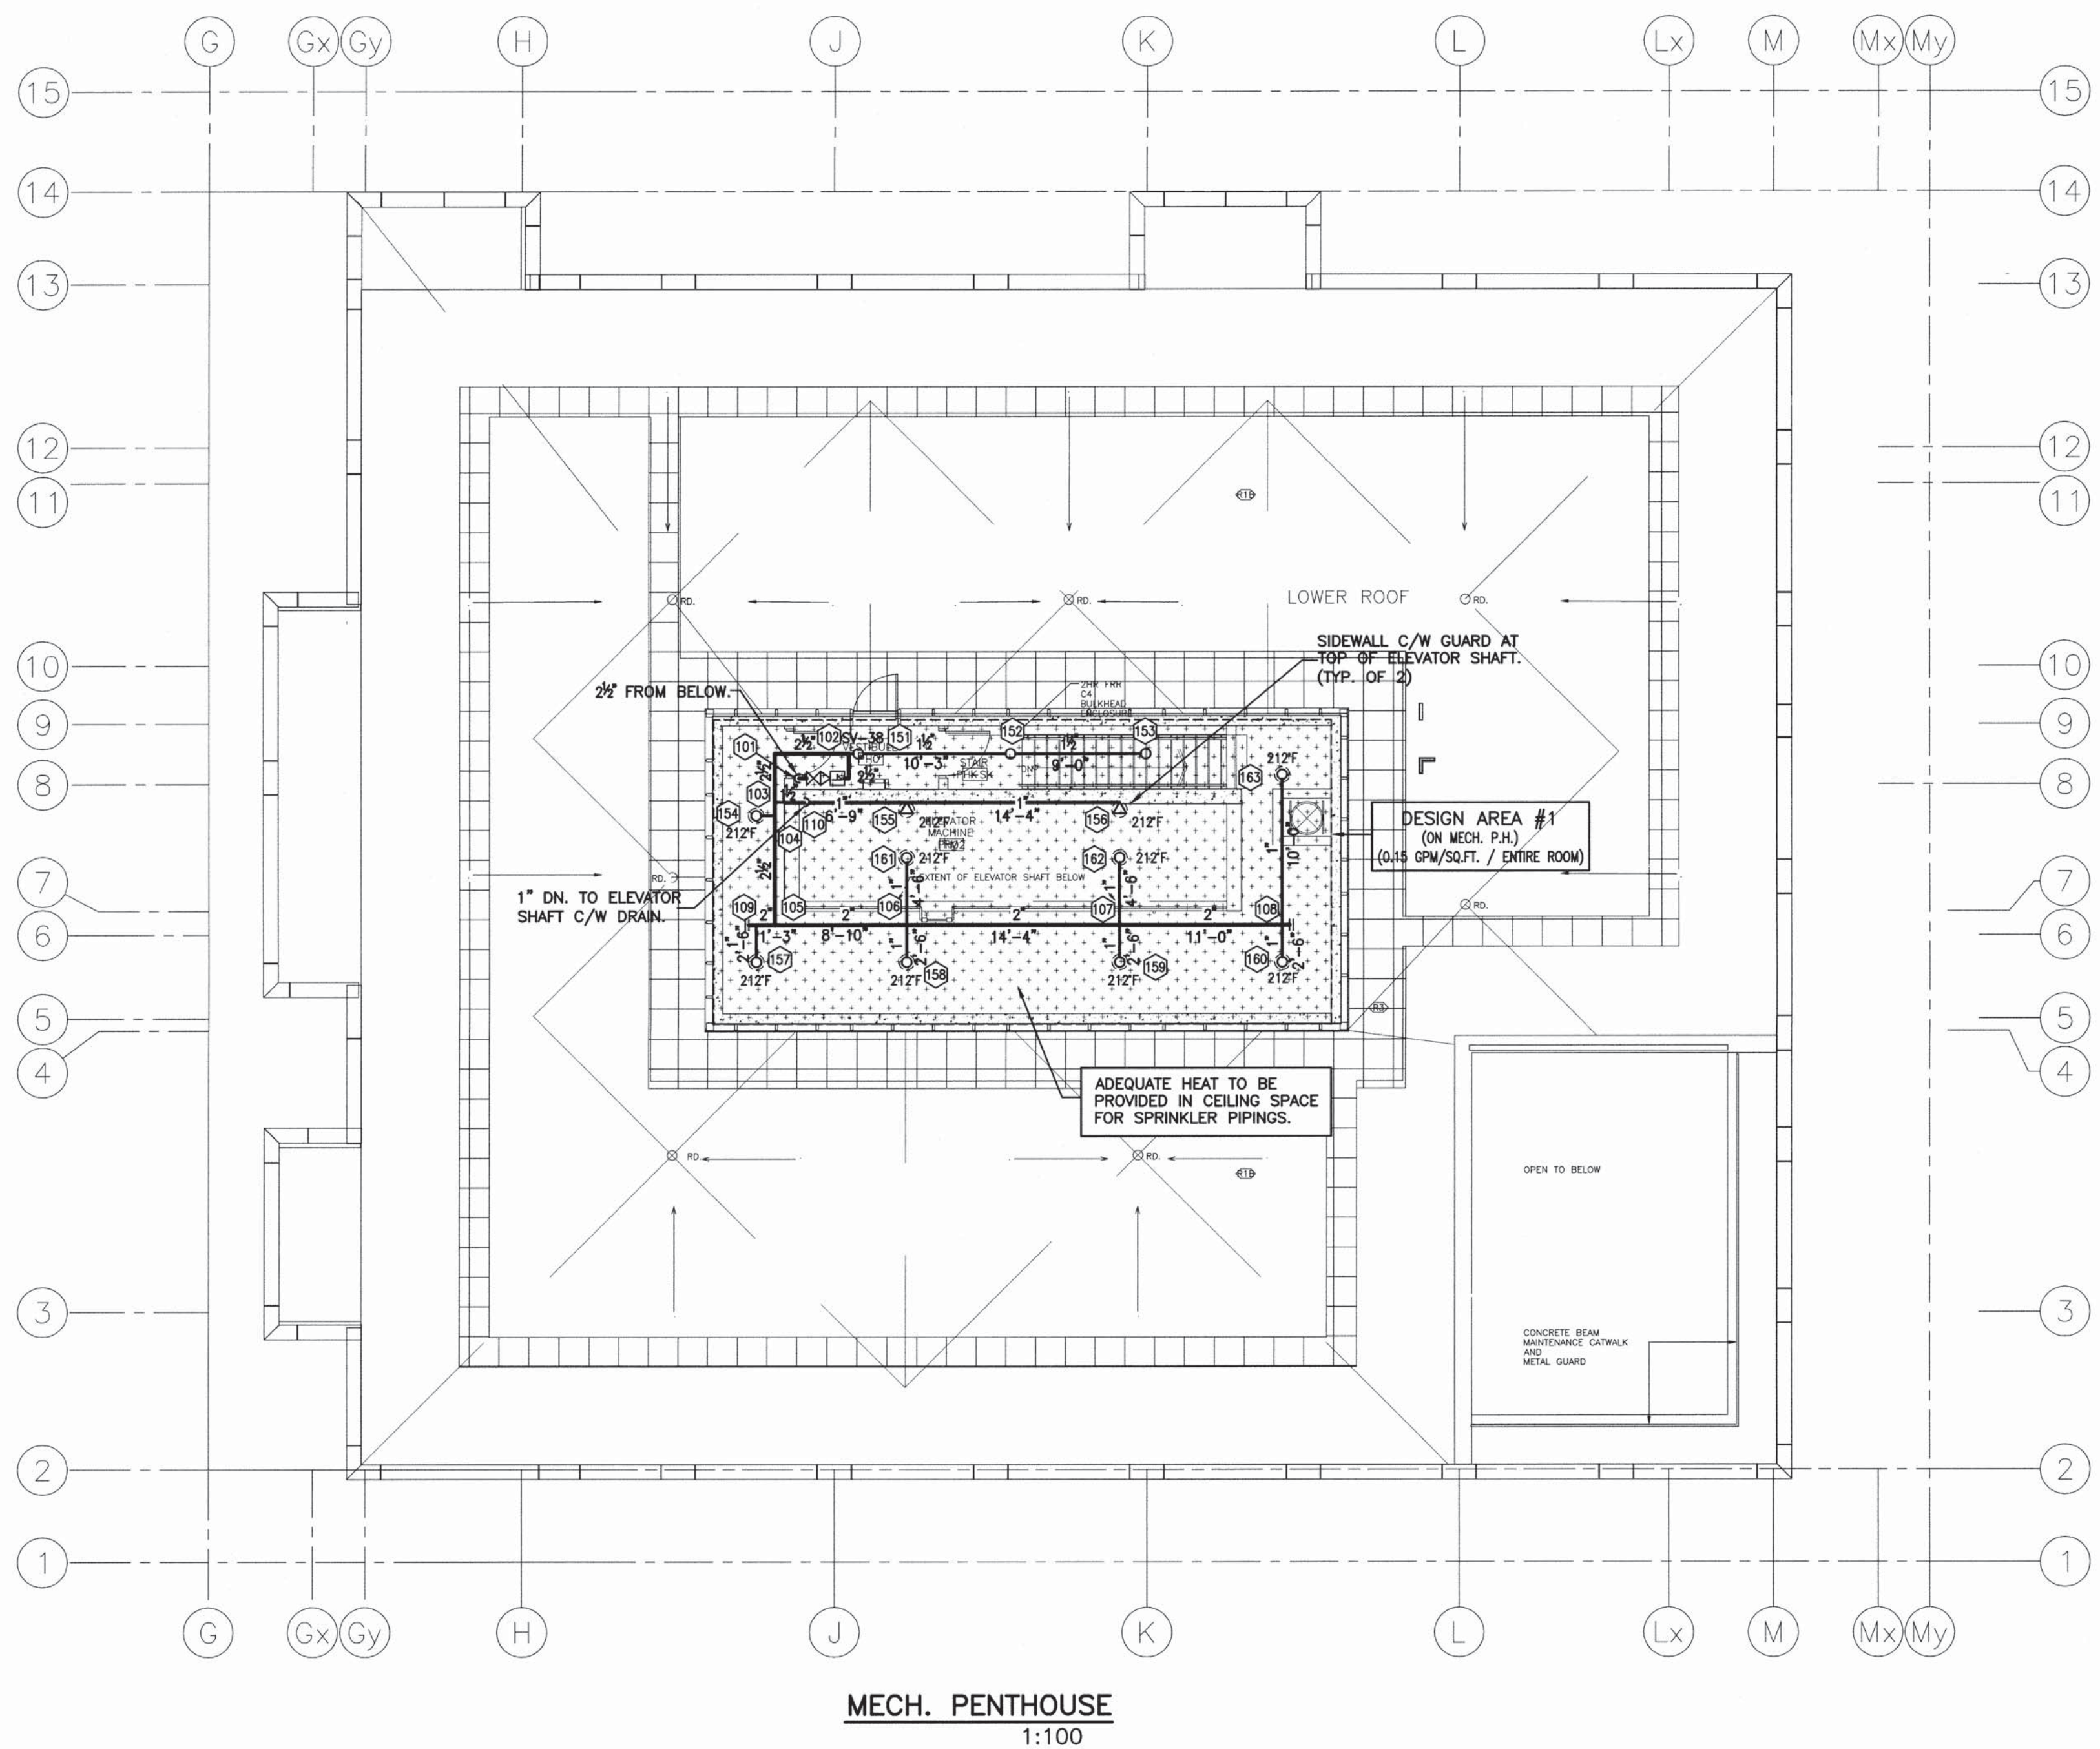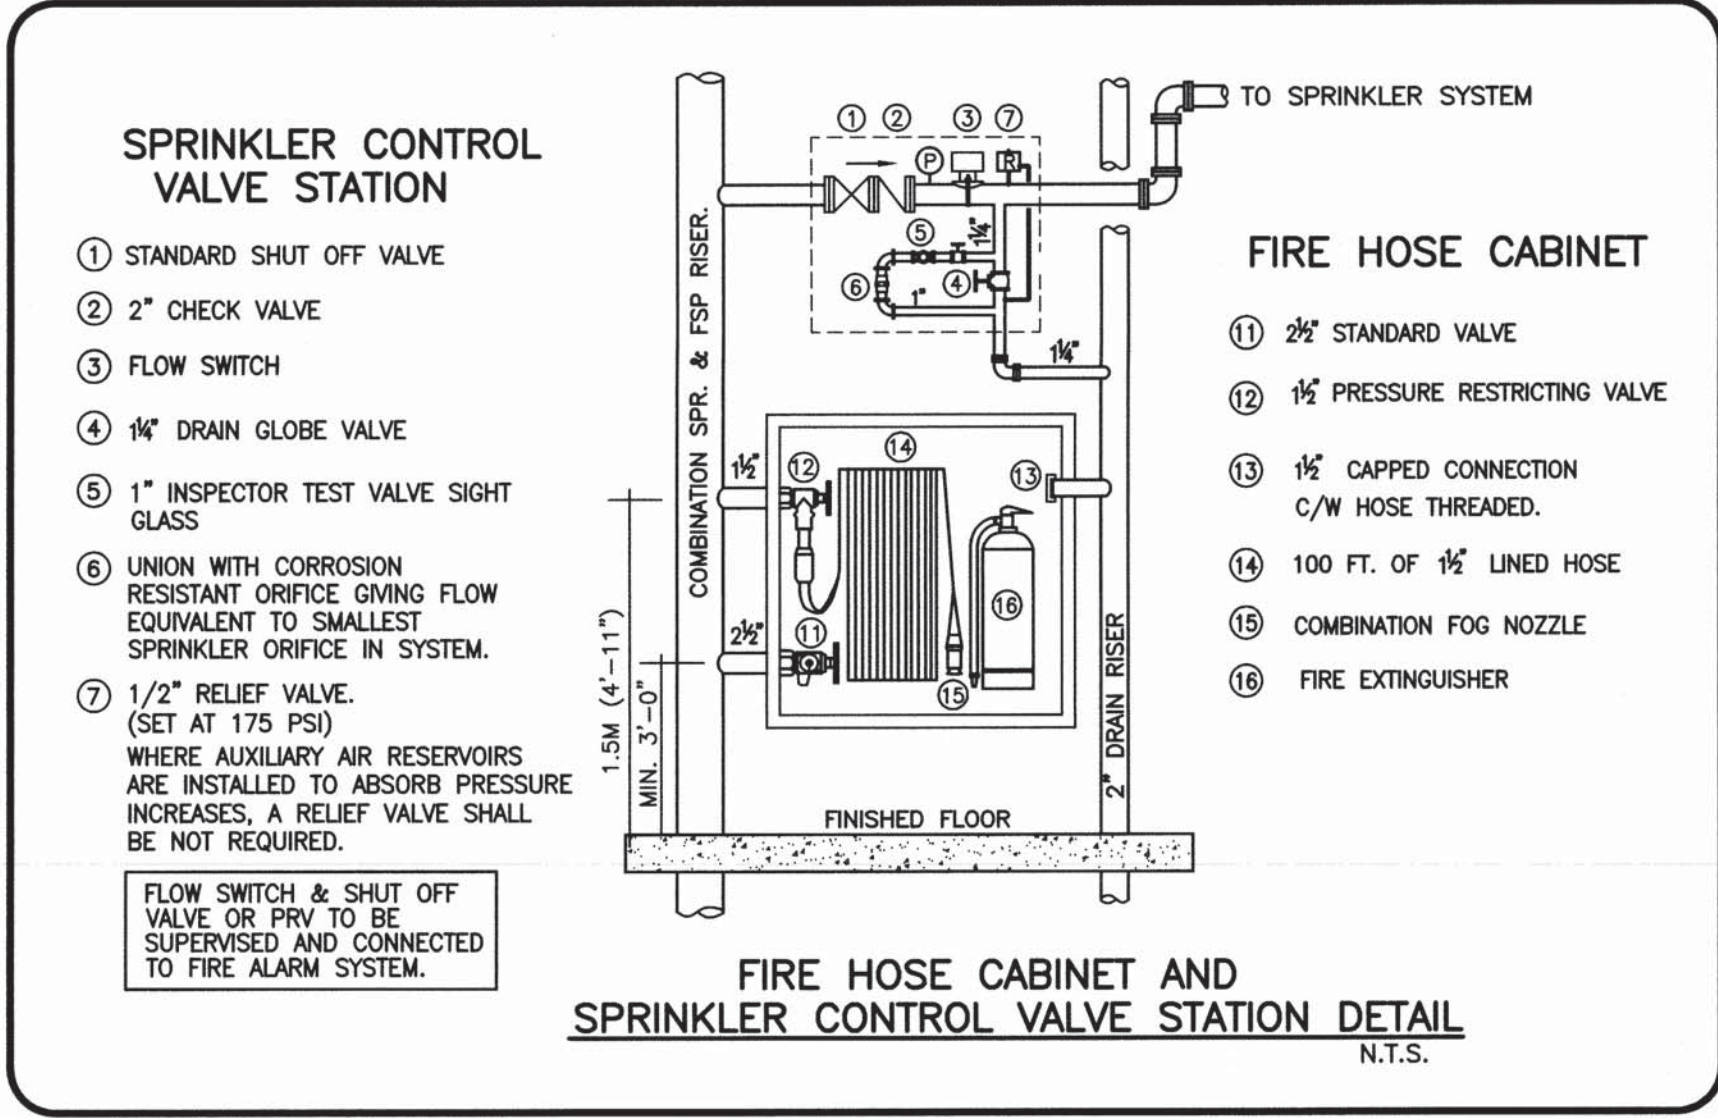

REVISIONS	DATE	DESCRIPTION
2.	AUG. 15 2014	RE-ISSUED FOR PERMIT.
5.	OCT. 2 2015	ISSUED FOR CONSTRUCTION.

NOTES

--- THIS DRAWING ASSOCIATED CALCULATIONS AND SPECIFICATIONS ARE THE PROPERTY OF THE DESIGNER AND MUST BE RETURNED AT THE COMPLETION OF THE WORK OR UPON REQUEST.

--- DIMENSIONS TAKE PRECEDENCE TO OVER SCALE.

--- SPRINKLER SYSTEM IS TO BE INSTALLED AS PER NFPA STANDARD # 13 AND O.B.C. STANDARDS.

--- CONTRACTOR TO INCLUDE FOR OFFSETS IN BRANCH LINES AND MAINS WHERE REQUIRED.

--- ALL MATERIALS TO BE U.L.C. LISTED AND APPROVED BY LOCAL AUTHORITIES.

--- UNDERGROUND WATERMAN TO BE INSTALLED ACCORDING TO LOCAL AUTHORITIES AND INSURANCE CO. STANDARDS.

--- INSTALL HIGH TEMPERATURE HEADS WHERE REQUIRED AS PER NFPA STANDARD # 13.

--- ALL INTERIOR GRID BRANCH LINE MEASUREMENTS ARE GIVEN AS CENTER LINE TO CENTER LINE DIMENSIONS (SCH.10 PIPE).

--- ALL OTHER BRANCH LINE MEASUREMENTS ARE GIVEN AS CENTER LINE TO CENTER LINE DIMENSIONS (SCH.40 PIPE).

--- ALL MAIN MEASUREMENTS ARE GIVEN AS CENTER LINE TO CENTER LINE DIMENSIONS (SCH.40 WALL PIPE).

--- DENOTES DISTANCE IN INCHES FROM CENTER LINE OF PIPE TO UNDERSIDE OF CEILING.

--- RIN DENOTES RISER NIPPLE.

--- DN DENOTES DOWN.

--- ALL SUPERVED VALVES, FLOW (PRESSURE) SWITCHES AND LOW PRESSURE MONITORING SWITCHES TO BE CONNECTED TO FIRE ALARM SYSTEM, (IF A.S. IS INSTALLED).

--- CONTRACTOR TO BE RESPONSIBLE FOR DETERMINING EXACT LOCATION AND ELEVATION OF MAINS TO BE INSTALLED AS INDICATED ON DRAWINGS AND MAKE DISCREPANCIES TO BE REPORTED TO THE DESIGNER PRIOR TO FABRICATION AND INSTALLATION.

--- ALL GLASS BULB TYPE SPRINKLERS TO BE OF RECENT ISSUE, MANUFACTURE DATE OF AT LEAST YEAR 2013.


OWNER (OR OTHERS) TO PROVIDE ADEQUATE HEAT IN ALL AREAS OF BUILDING SUBJECT TO FREEZING THAT ARE PROTECTED BY A WET TYPE SPRINKLER SYSTEM.

ALL GLASS BULB TYPE SPRINKLERS TO BE OF RECENT ISSUE, MANUFACTURE DATE OF AT LEAST YEAR 2013.

SYMBOL	DESCRIPTION	QUANTITY
212F	1/2" 212F STANDARD COVERAGE UPRIGHT (K=5.6) Q/R	8
155F	1/2" 155F STANDARD COVERAGE UPRIGHT (K=5.6) Q/R	15
155F	1/2" 155F STANDARD COVERAGE CONCEALED PENDENT (K=5.6) Q/R	8
212F	1/2" 212F STANDARD COVERAGE UPRIGHT (K=5.6) Q/R	2
155F	1/2" 155F RESIDENTIAL CONCEALED PENDENT (K=4.9)	46
155F	1/2" 155F RESIDENTIAL CONCEALED SIDEWALL (K=4.0)	12
155F	1/2" 155F STANDARD COVERAGE SIDEWALL (K=5.6) Q/R	1
FHC	FIRE HOSE RACK - 100 FT OF 1/2" LINED HOSE C/W COMBINATION FOG NOZZLE	2

DESIGN CRITERIA

MECH. PENTHOUSE: SPRINKLER WET SYSTEM DESIGNED FOR ORDINARY HAZARD GROUP 1, 0.15 GPM PER SQ.FT. OVER 1500 SQ.FT. PLUS 250 GPM FOR HOSES. AS PER NFPA 13.

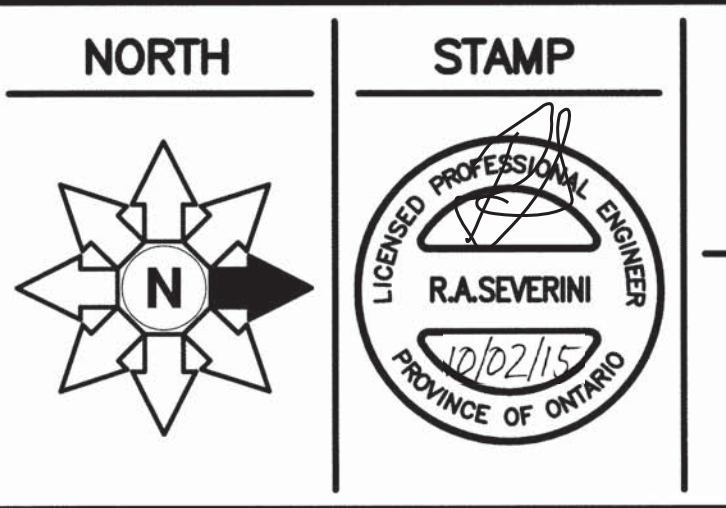

TRIDEL
 4800 DUFFERIN STREET
 TORONTO ONTARIO

PROJECT
 SQ ALEXANDRA PARK
 BLOCK 11
 38 CAMERON ST. TORONTO

DWG TITLE
 14TH FL. & MECH. PENTHOUSE
 SPRINKLER & STANDPIPE SYSTEM

DATE	SCALE	DWN BY	ISSUED FOR REVISION NO.	PROJECT NO.	DWG NO.
JULY 2014	1:100	H.W.	REV-5	14-10224	SP-16