




1 CONSTRUCTION PLAN  
P1 LEVEL SCALE 1:50

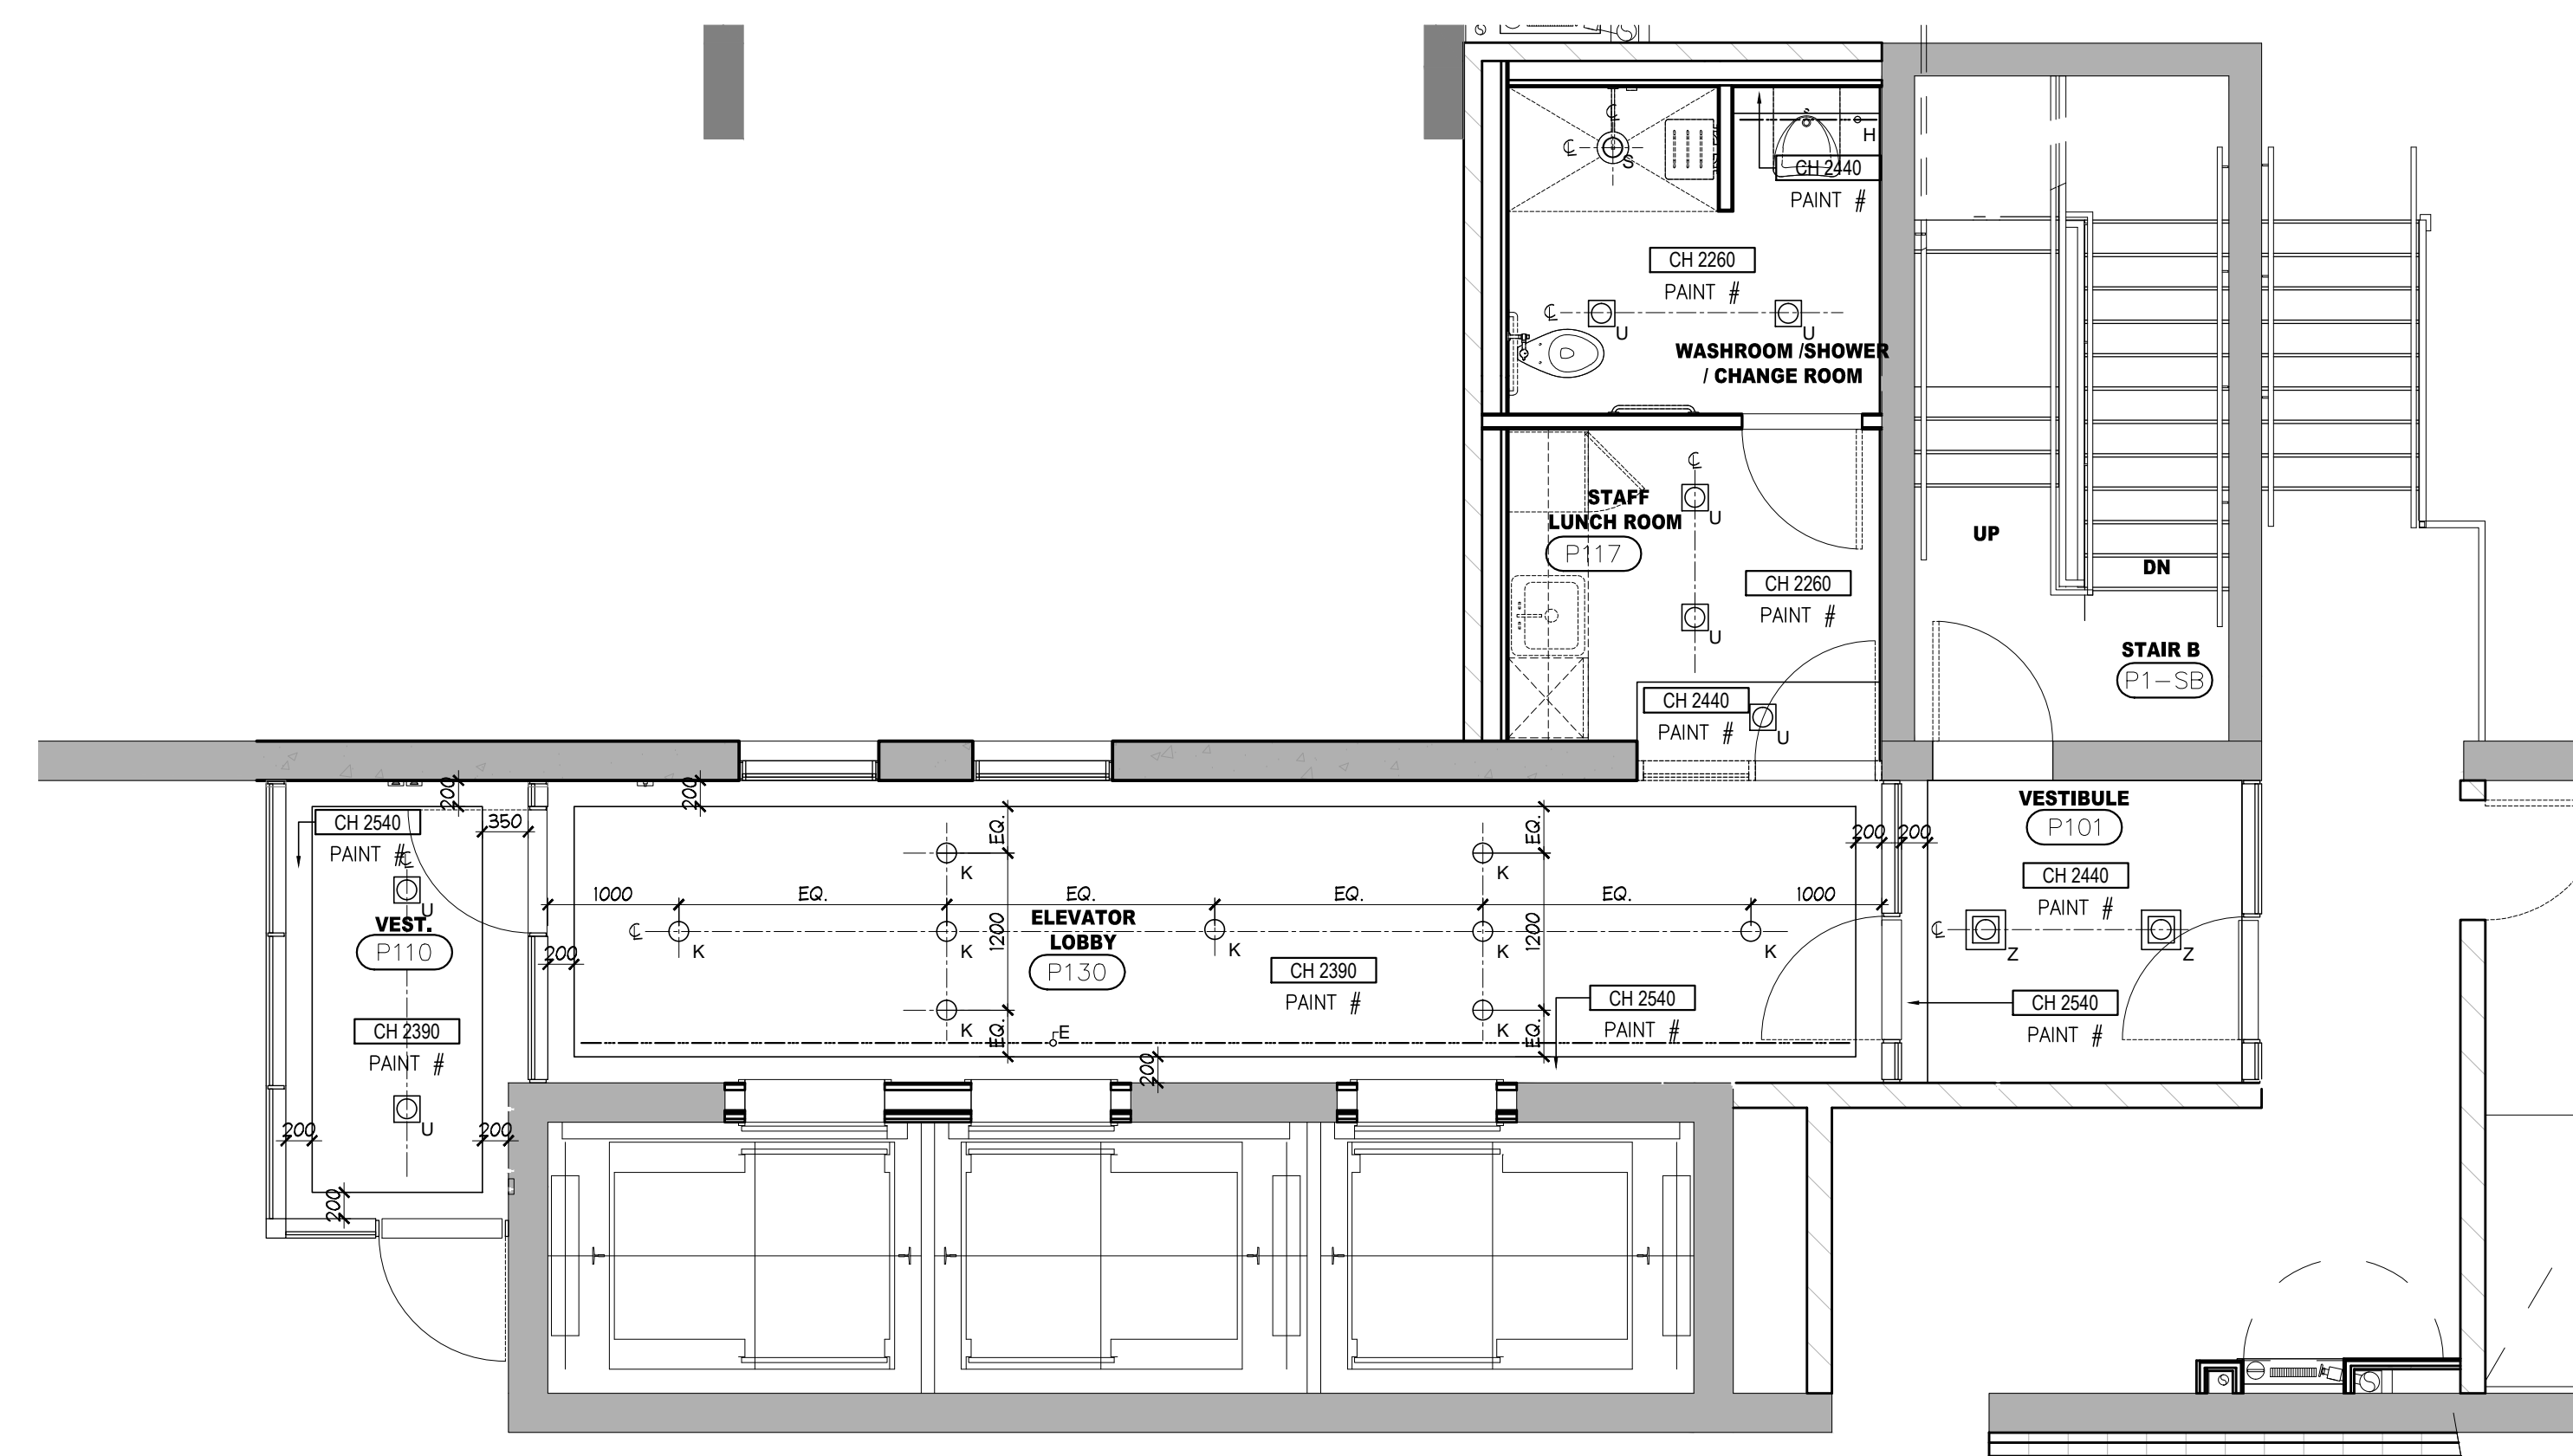


2 REFLECTED CEILING PLAN  
P1 LEVEL SCALE 1:50

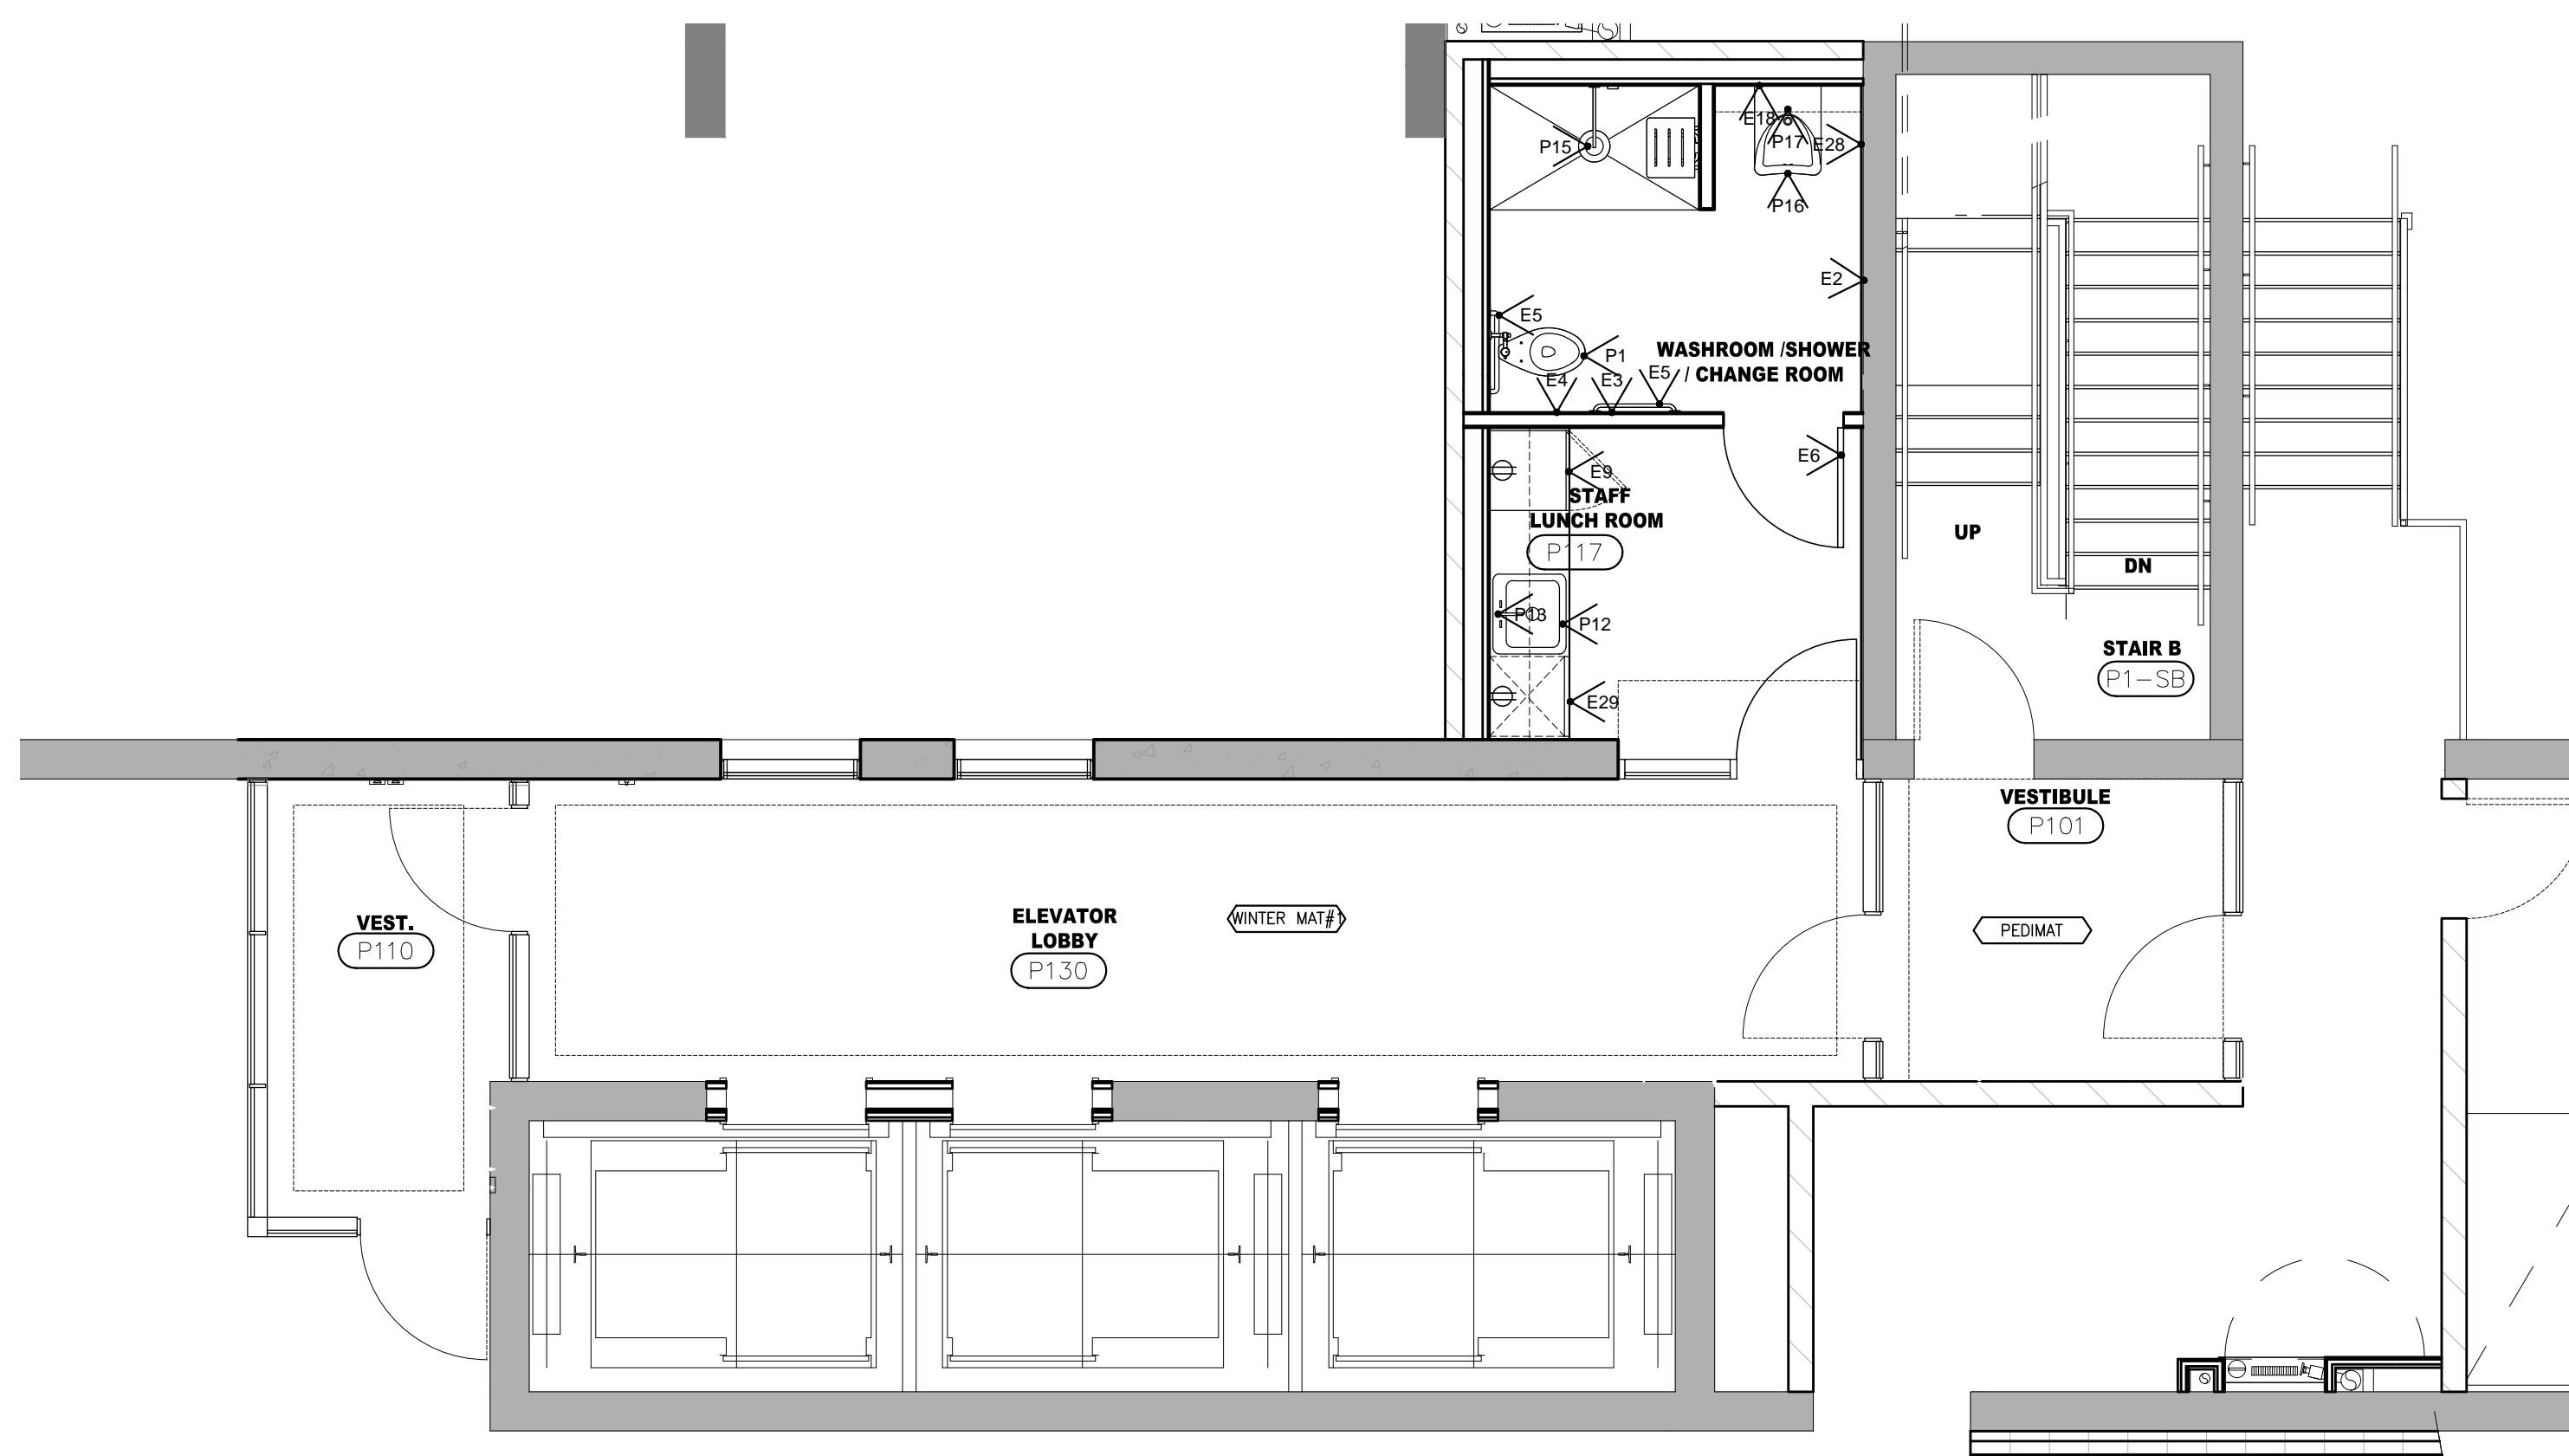


3 POWER & FURNITURE PLAN  
P1 LEVEL SCALE 1:50

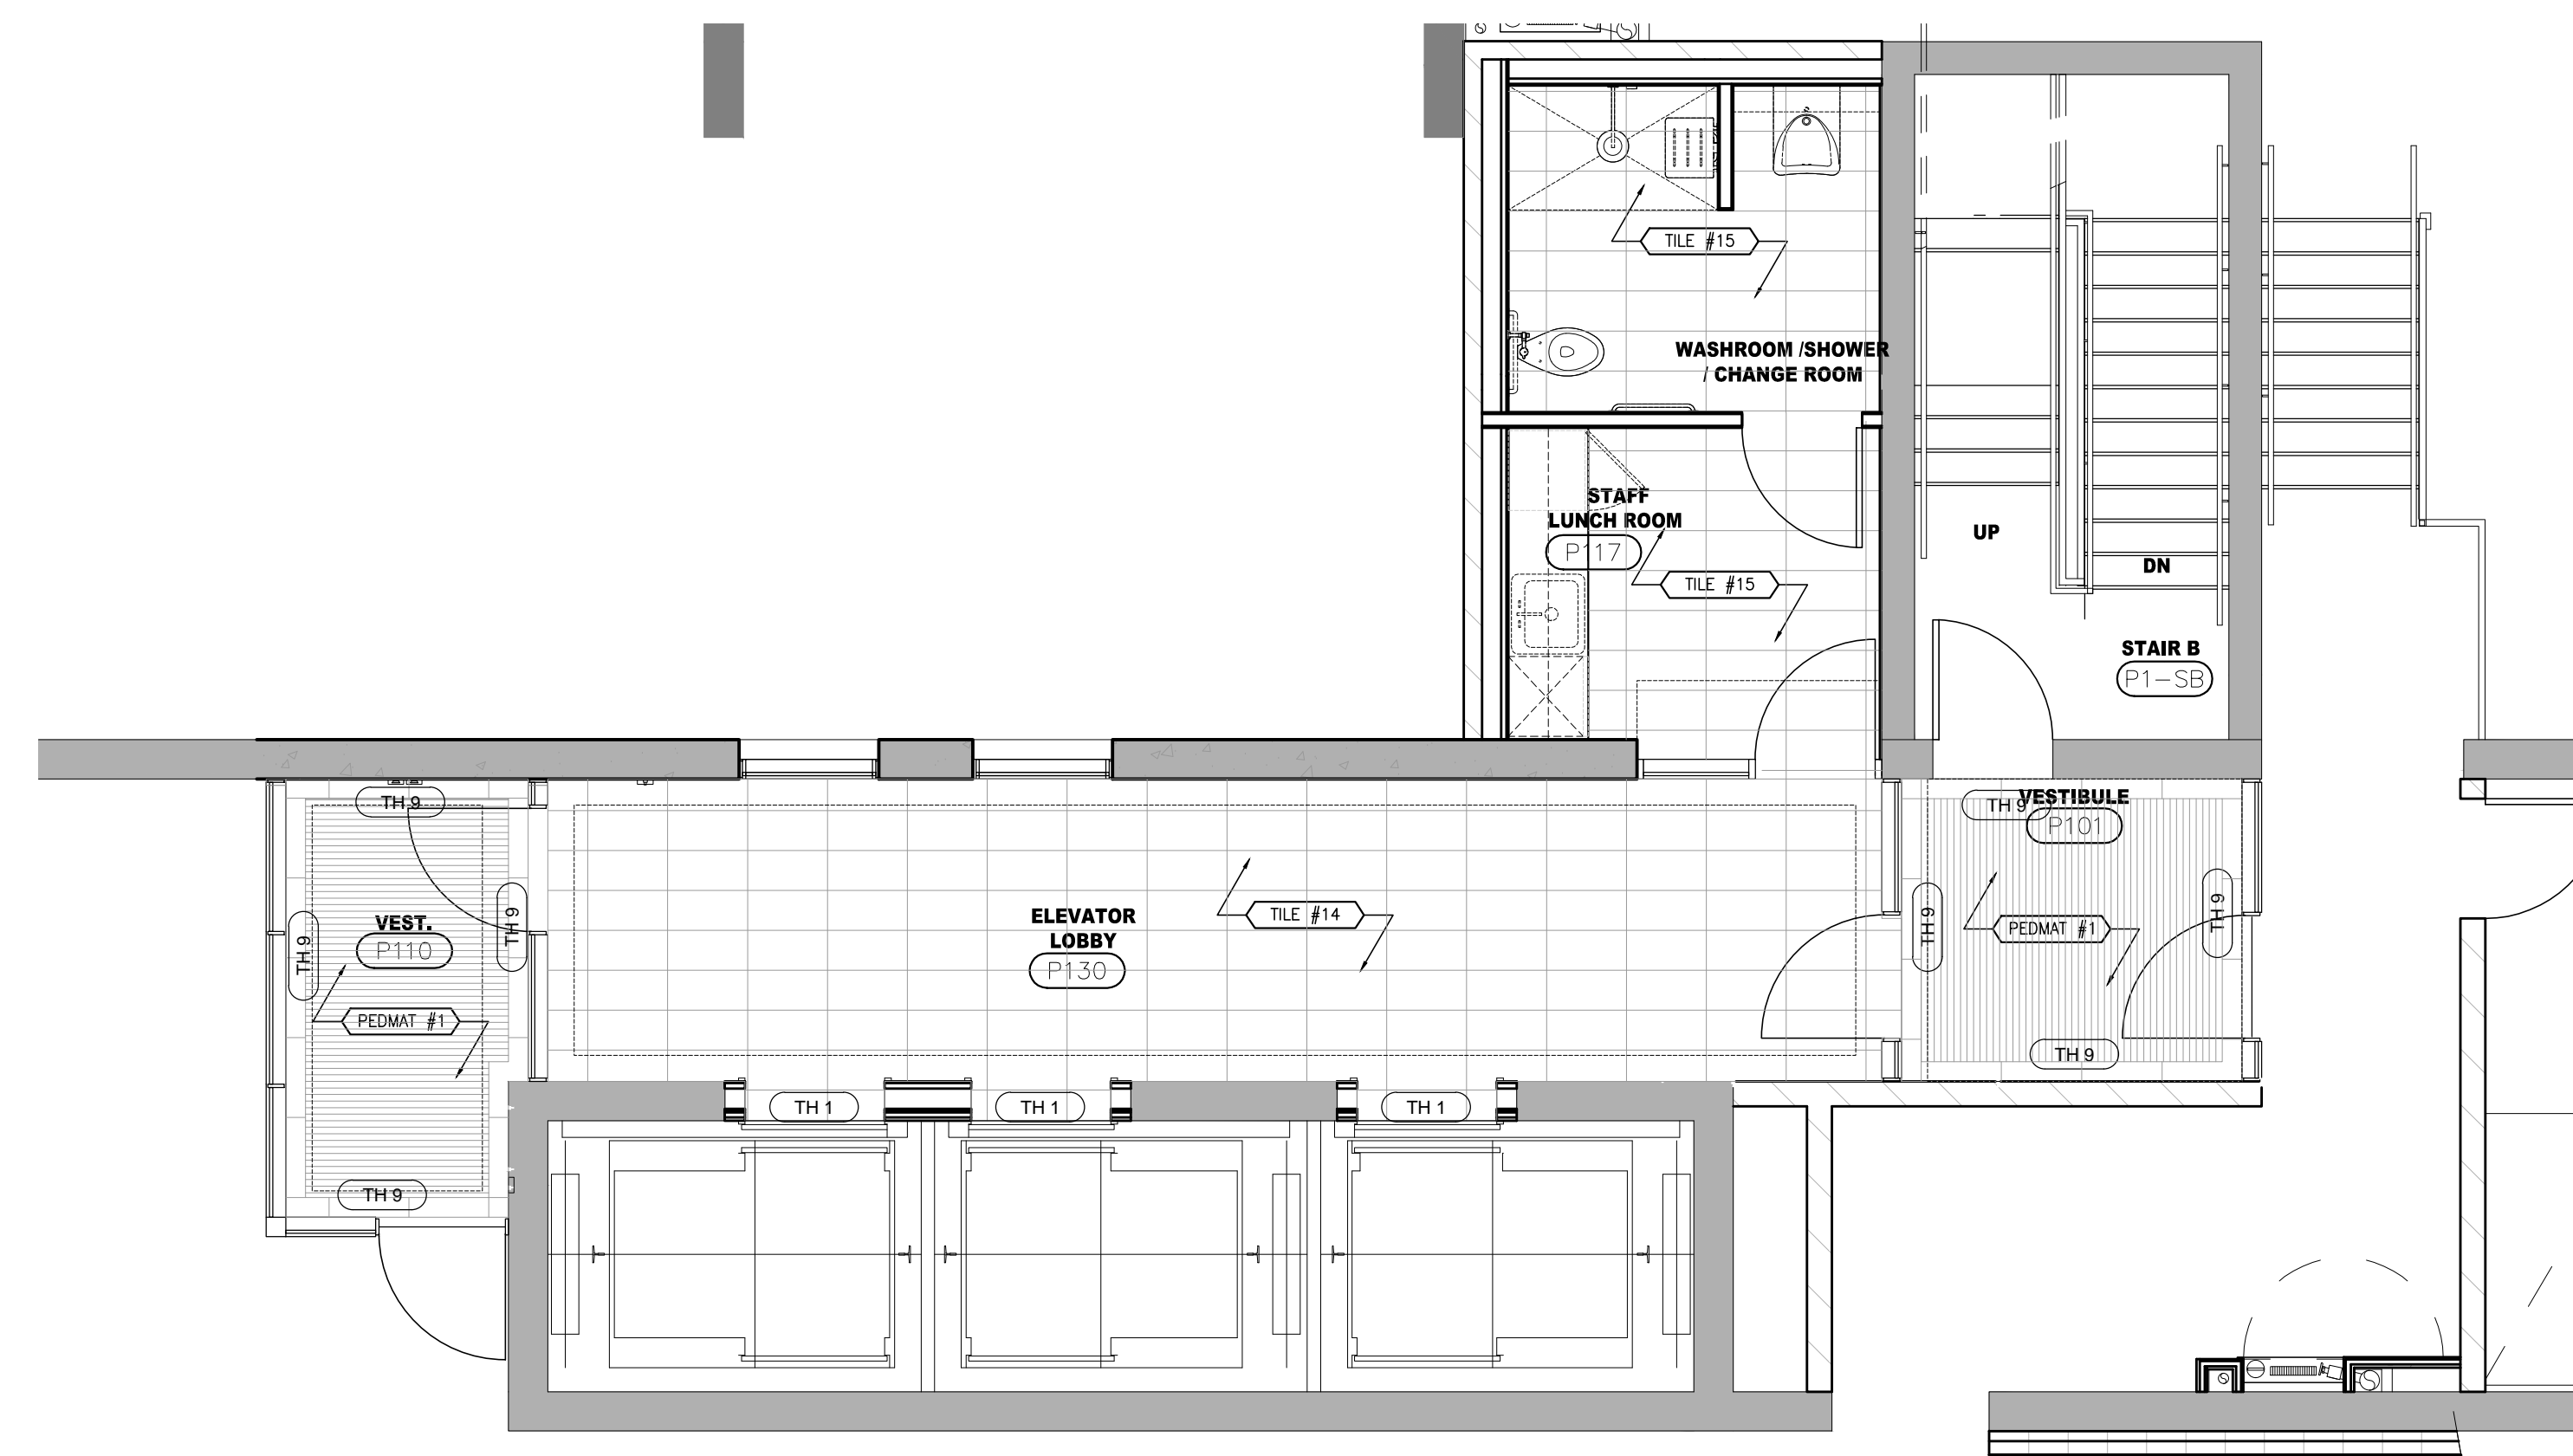

4 FLOOR FINISHES PLAN  
P1 LEVEL SCALE 1:50

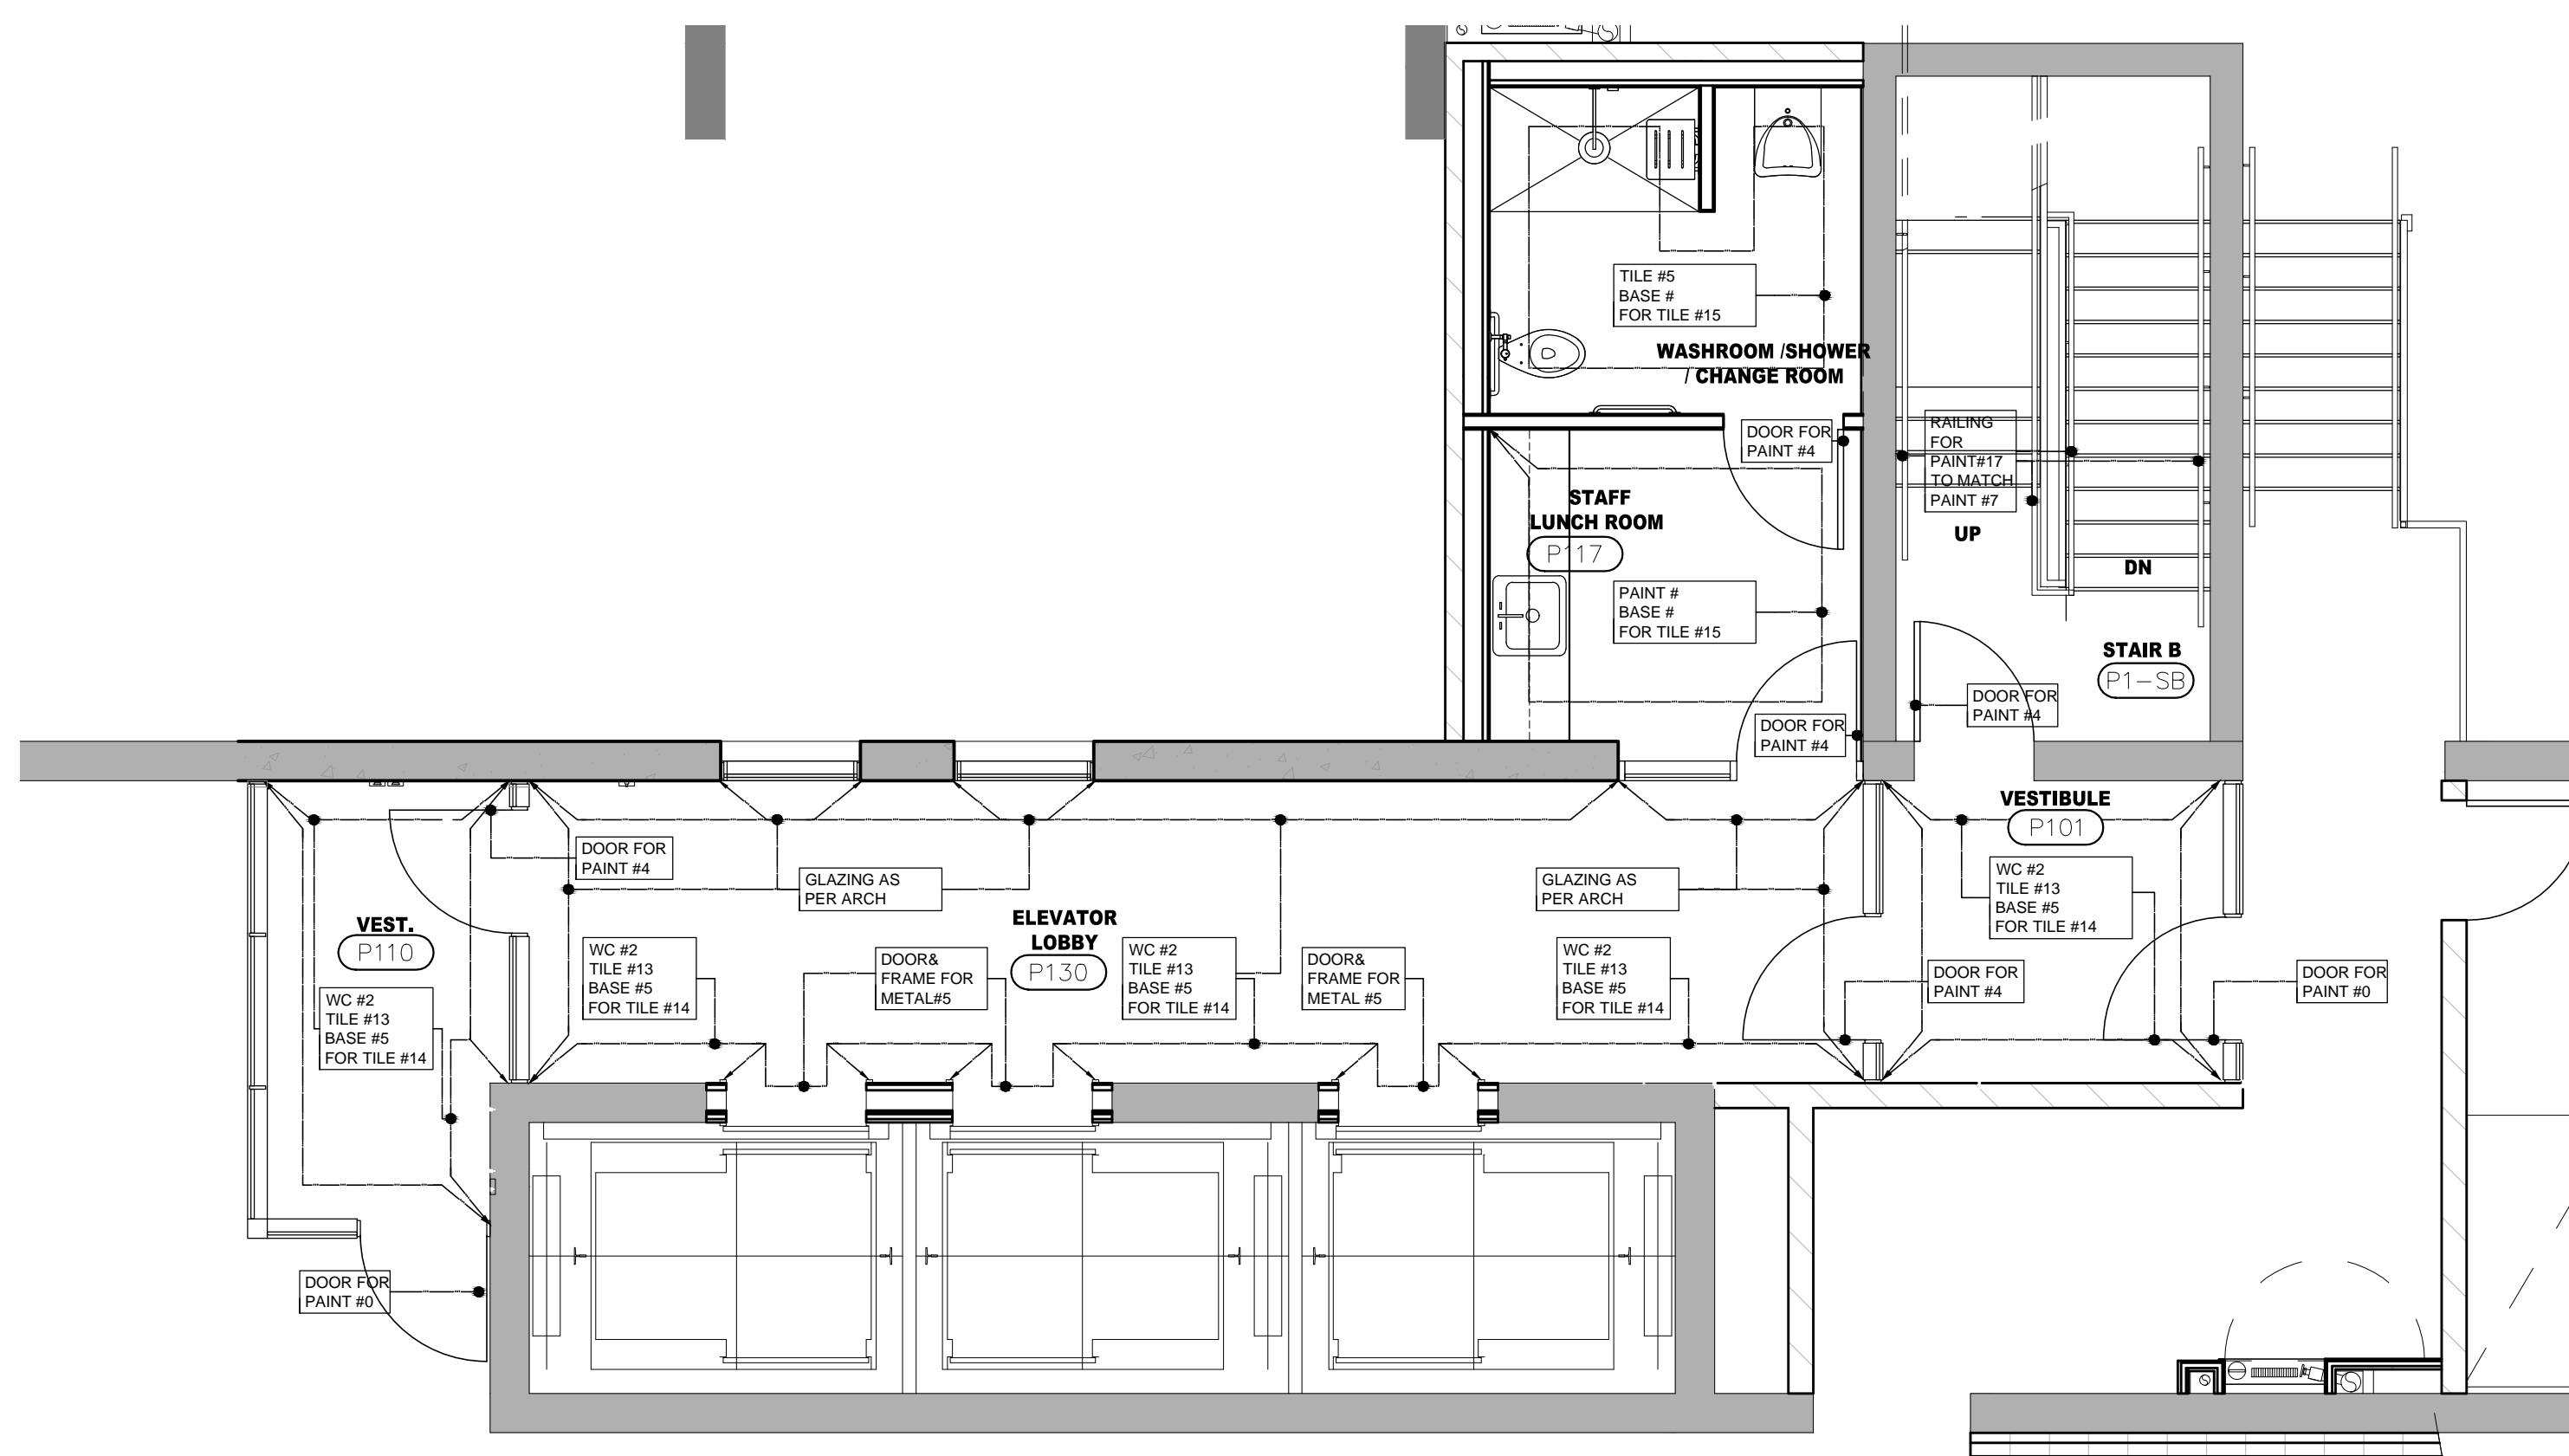

5 WALL FINISHES PLAN  
P1 LEVEL SCALE 1:50

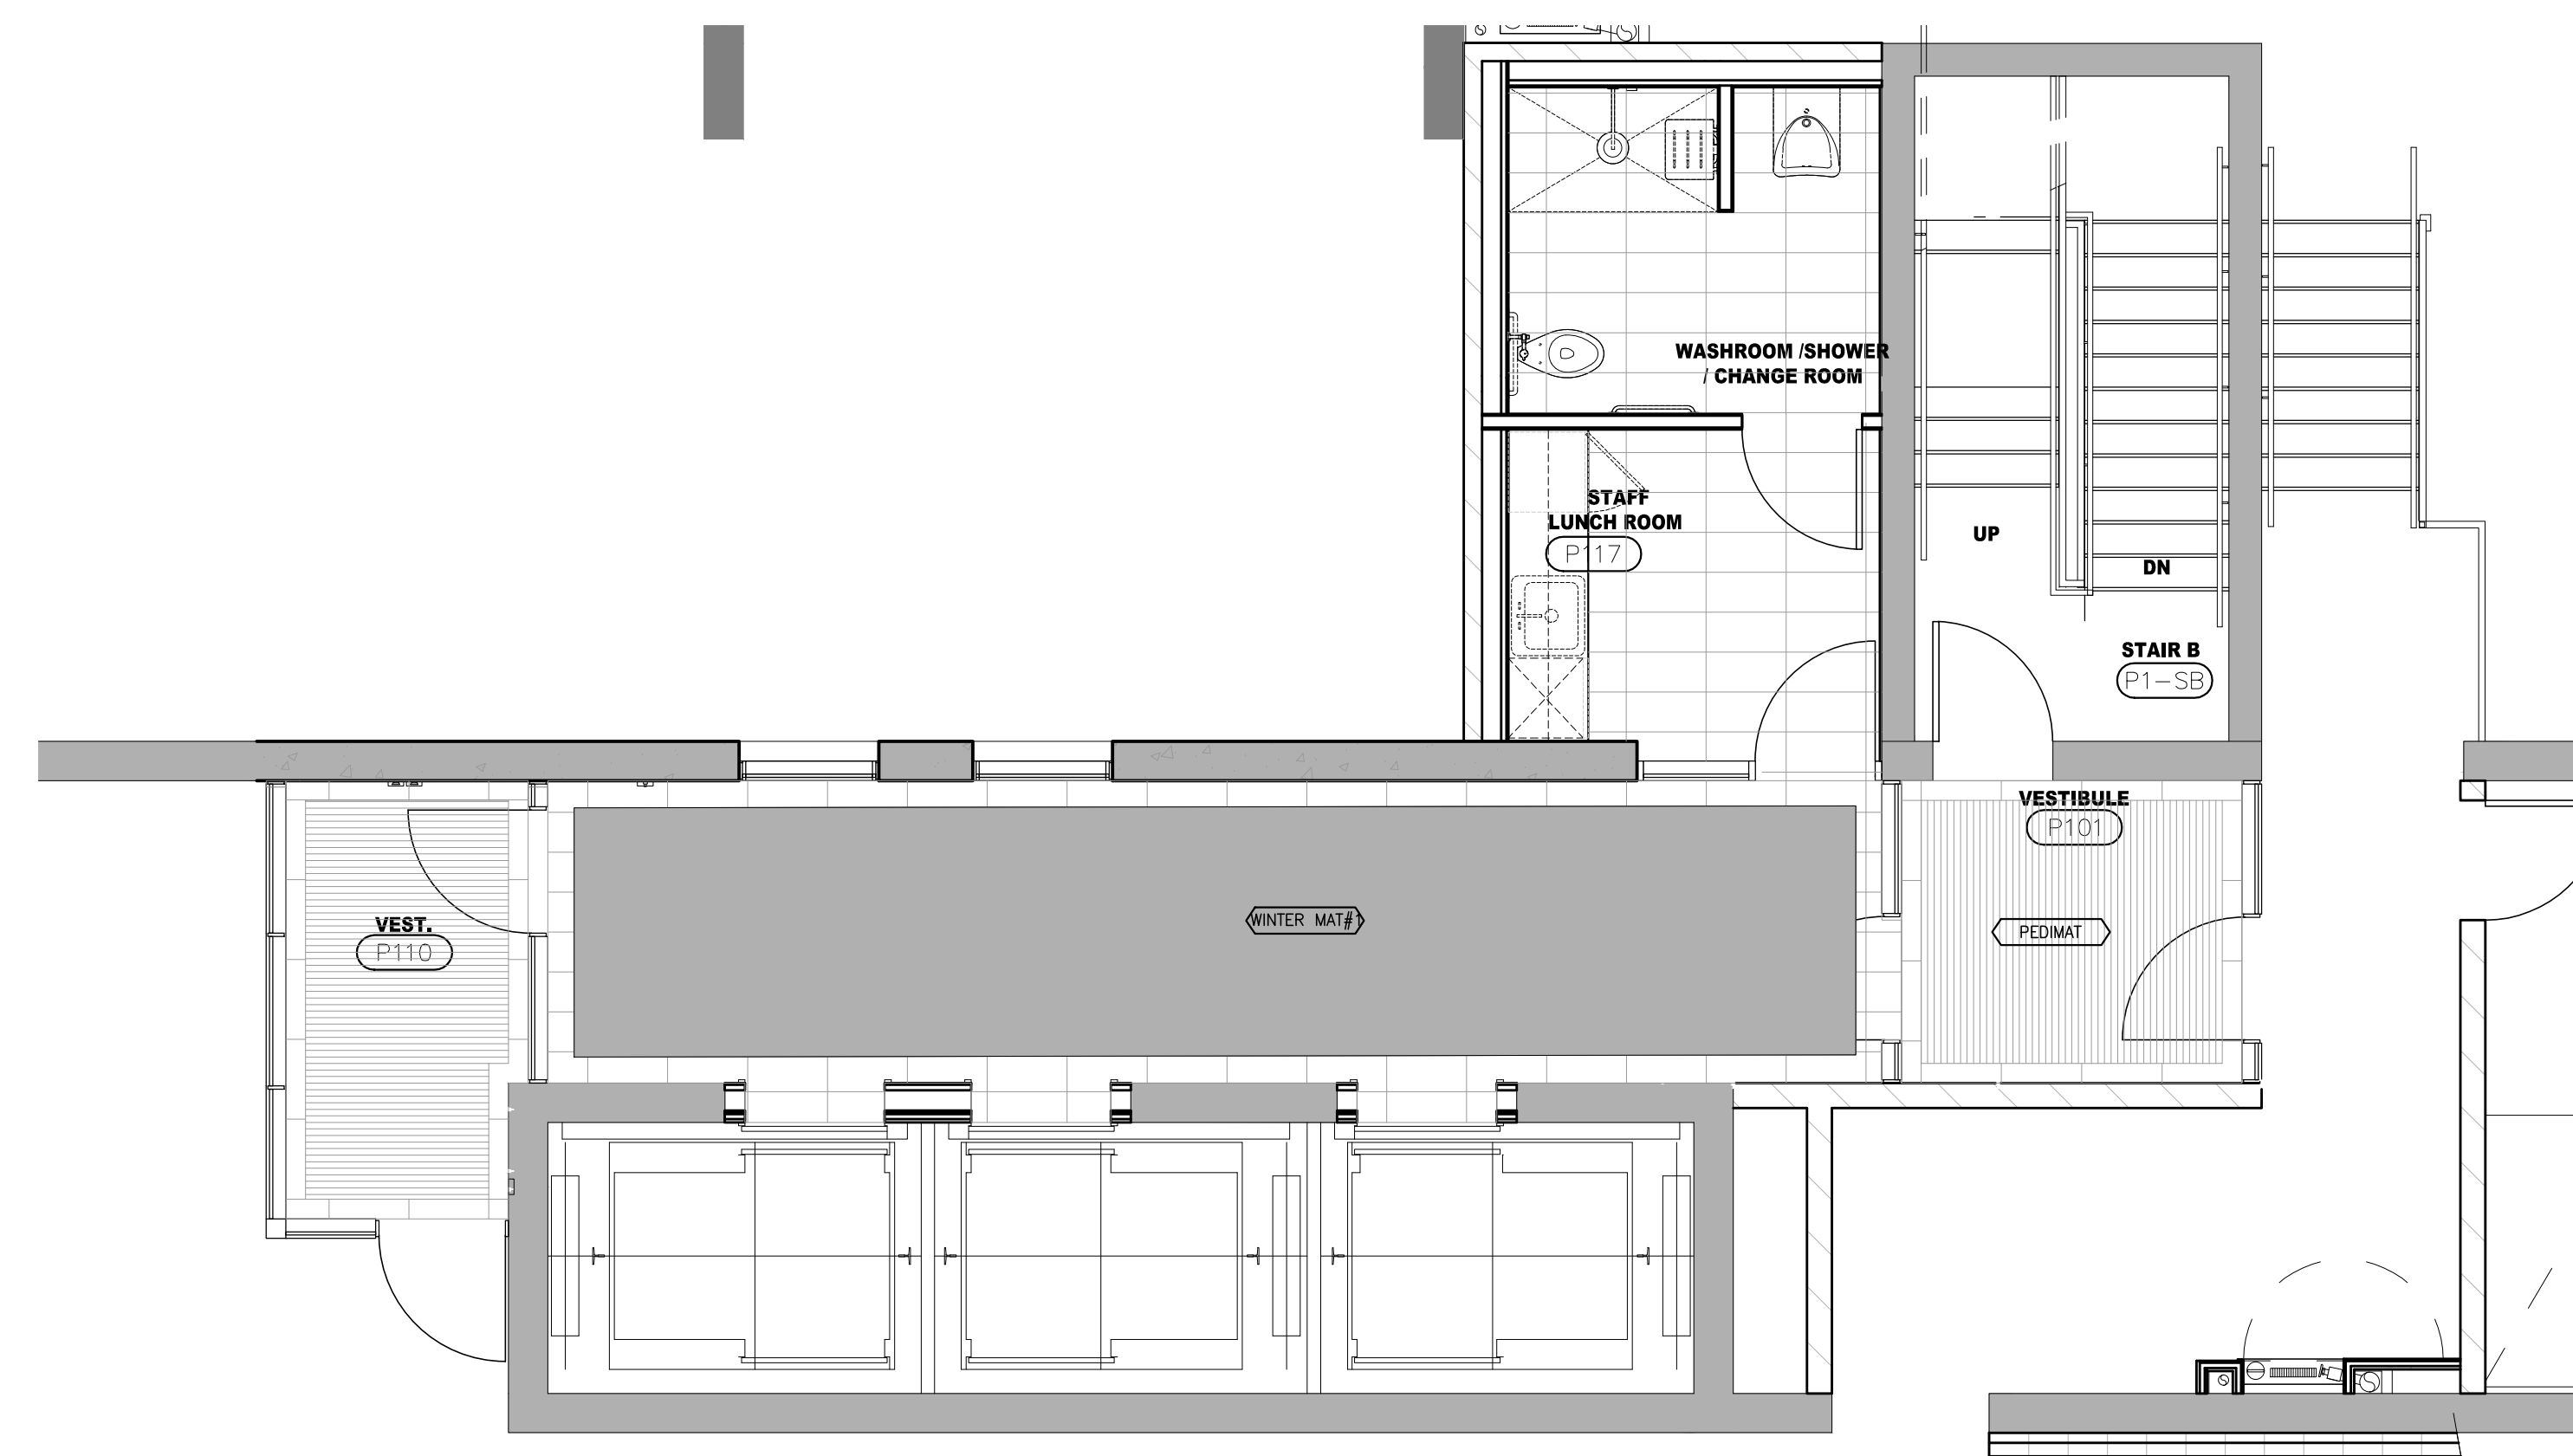

6 WINTER MATTING PLAN  
P1 LEVEL SCALE 1:50

DO NOT SCALE DRAWINGS.

CONTRACTOR MUST VERIFY ALL DRAWINGS, DIMENSIONS, DETAILS AND SPECIFICATIONS, AND REPORT ANY DISCREPANCIES TO UNICOR 31 INC. BEFORE PROCEEDING WITH WORK. MATERIALS MAY NOT BE SUBSTITUTED WITHOUT WRITTEN APPROVAL FROM UNICOR 31 INC. ALL DRAWINGS AND SPECIFICATIONS ARE INSTRUMENTS OF SERVICE AND THE PROPERTY OF UNICOR 31 INC. WHICH MUST BE RETURNED AT THE COMPLETION OF THE WORK.

PRINTED: 30-May-17

ISSUED FOR  
AS-BUILT

NO.	DATE	COMMENTS	INI
01	31 MAY / 17	ISSUED FOR AS-BUILT	SV
REVISIONS:			

UNICOR31

UNICOR31 INC.  
183 BATHURST STREET, STE. 201  
TORONTO, ON, M5T 2R7, CANADA  
TEL: 416-597-1576 FAX: 416-597-2139

PROJECT NAME:	ALEXANDRA PARK MAIN BUILDING
PROJECT NO.:	13-949
DRAWINGS:	P 1 LEVEL CONSTRUCTION PLAN & REFLECTED CEILING PLAN FLOOR & WALL FINISHES PLANS
DATE STARTED:	07 AUG / 13
SCALE:	1:50
DRAWN BY:	AP
APPROVED BY:	KC
DRAWING NO.:	ID
	1.0.1