



DO NOT SCALE DRAWINGS.

CONTRACTOR MUST VERIFY ALL DRAWINGS, DIMENSIONS, DETAILS AND SPECIFICATIONS. AND REPORT ANY DISCREPANCIES TO UNION 31 INC. BEFORE PROCEEDING WITH WORK. MATERIALS MAY NOT BE SUBSTITUTED WITHOUT WRITTEN APPROVAL FROM UNION 31 INC. ALL DRAWINGS AND SPECIFICATIONS ARE INSTRUMENTS OF SERVICE AND THE PROPERTY OF UNION 31 INC. WHICH MUST BE RETURNED AT THE COMPLETION OF THE WORK.


PRINTED: 30-May-17

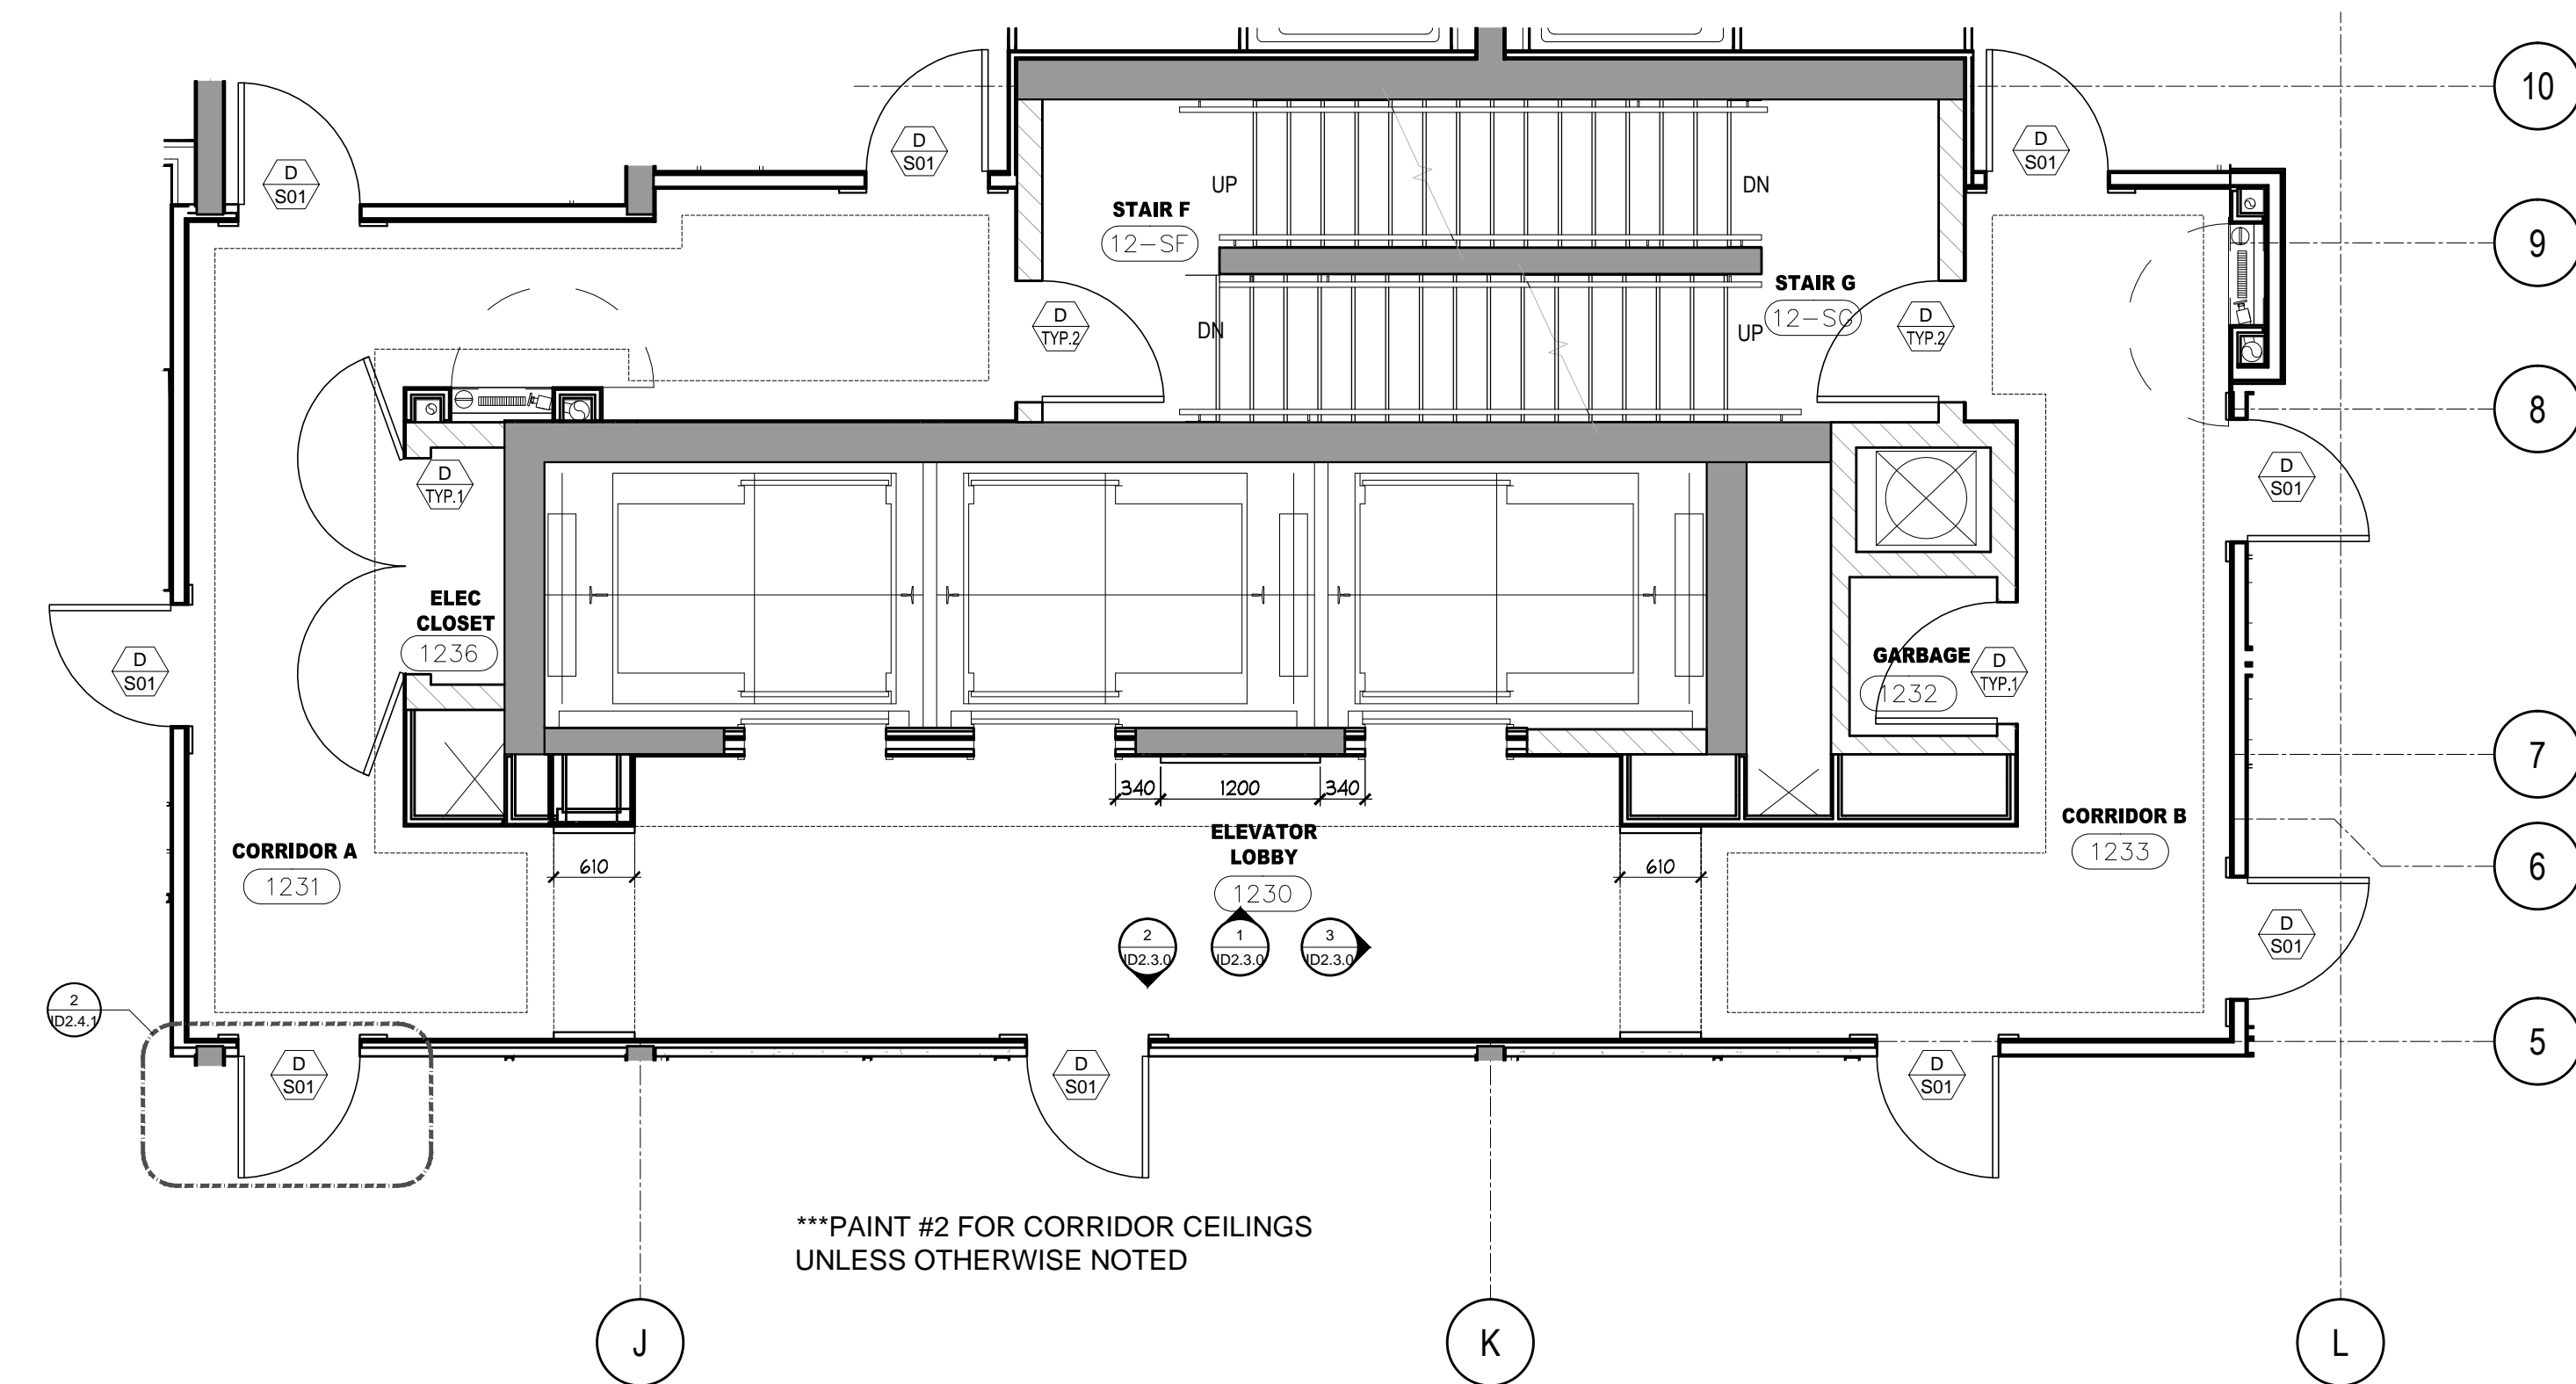


1 CONSTRUCTION PLAN
D1.12.0 12TH FLOOR SCALE 1:50

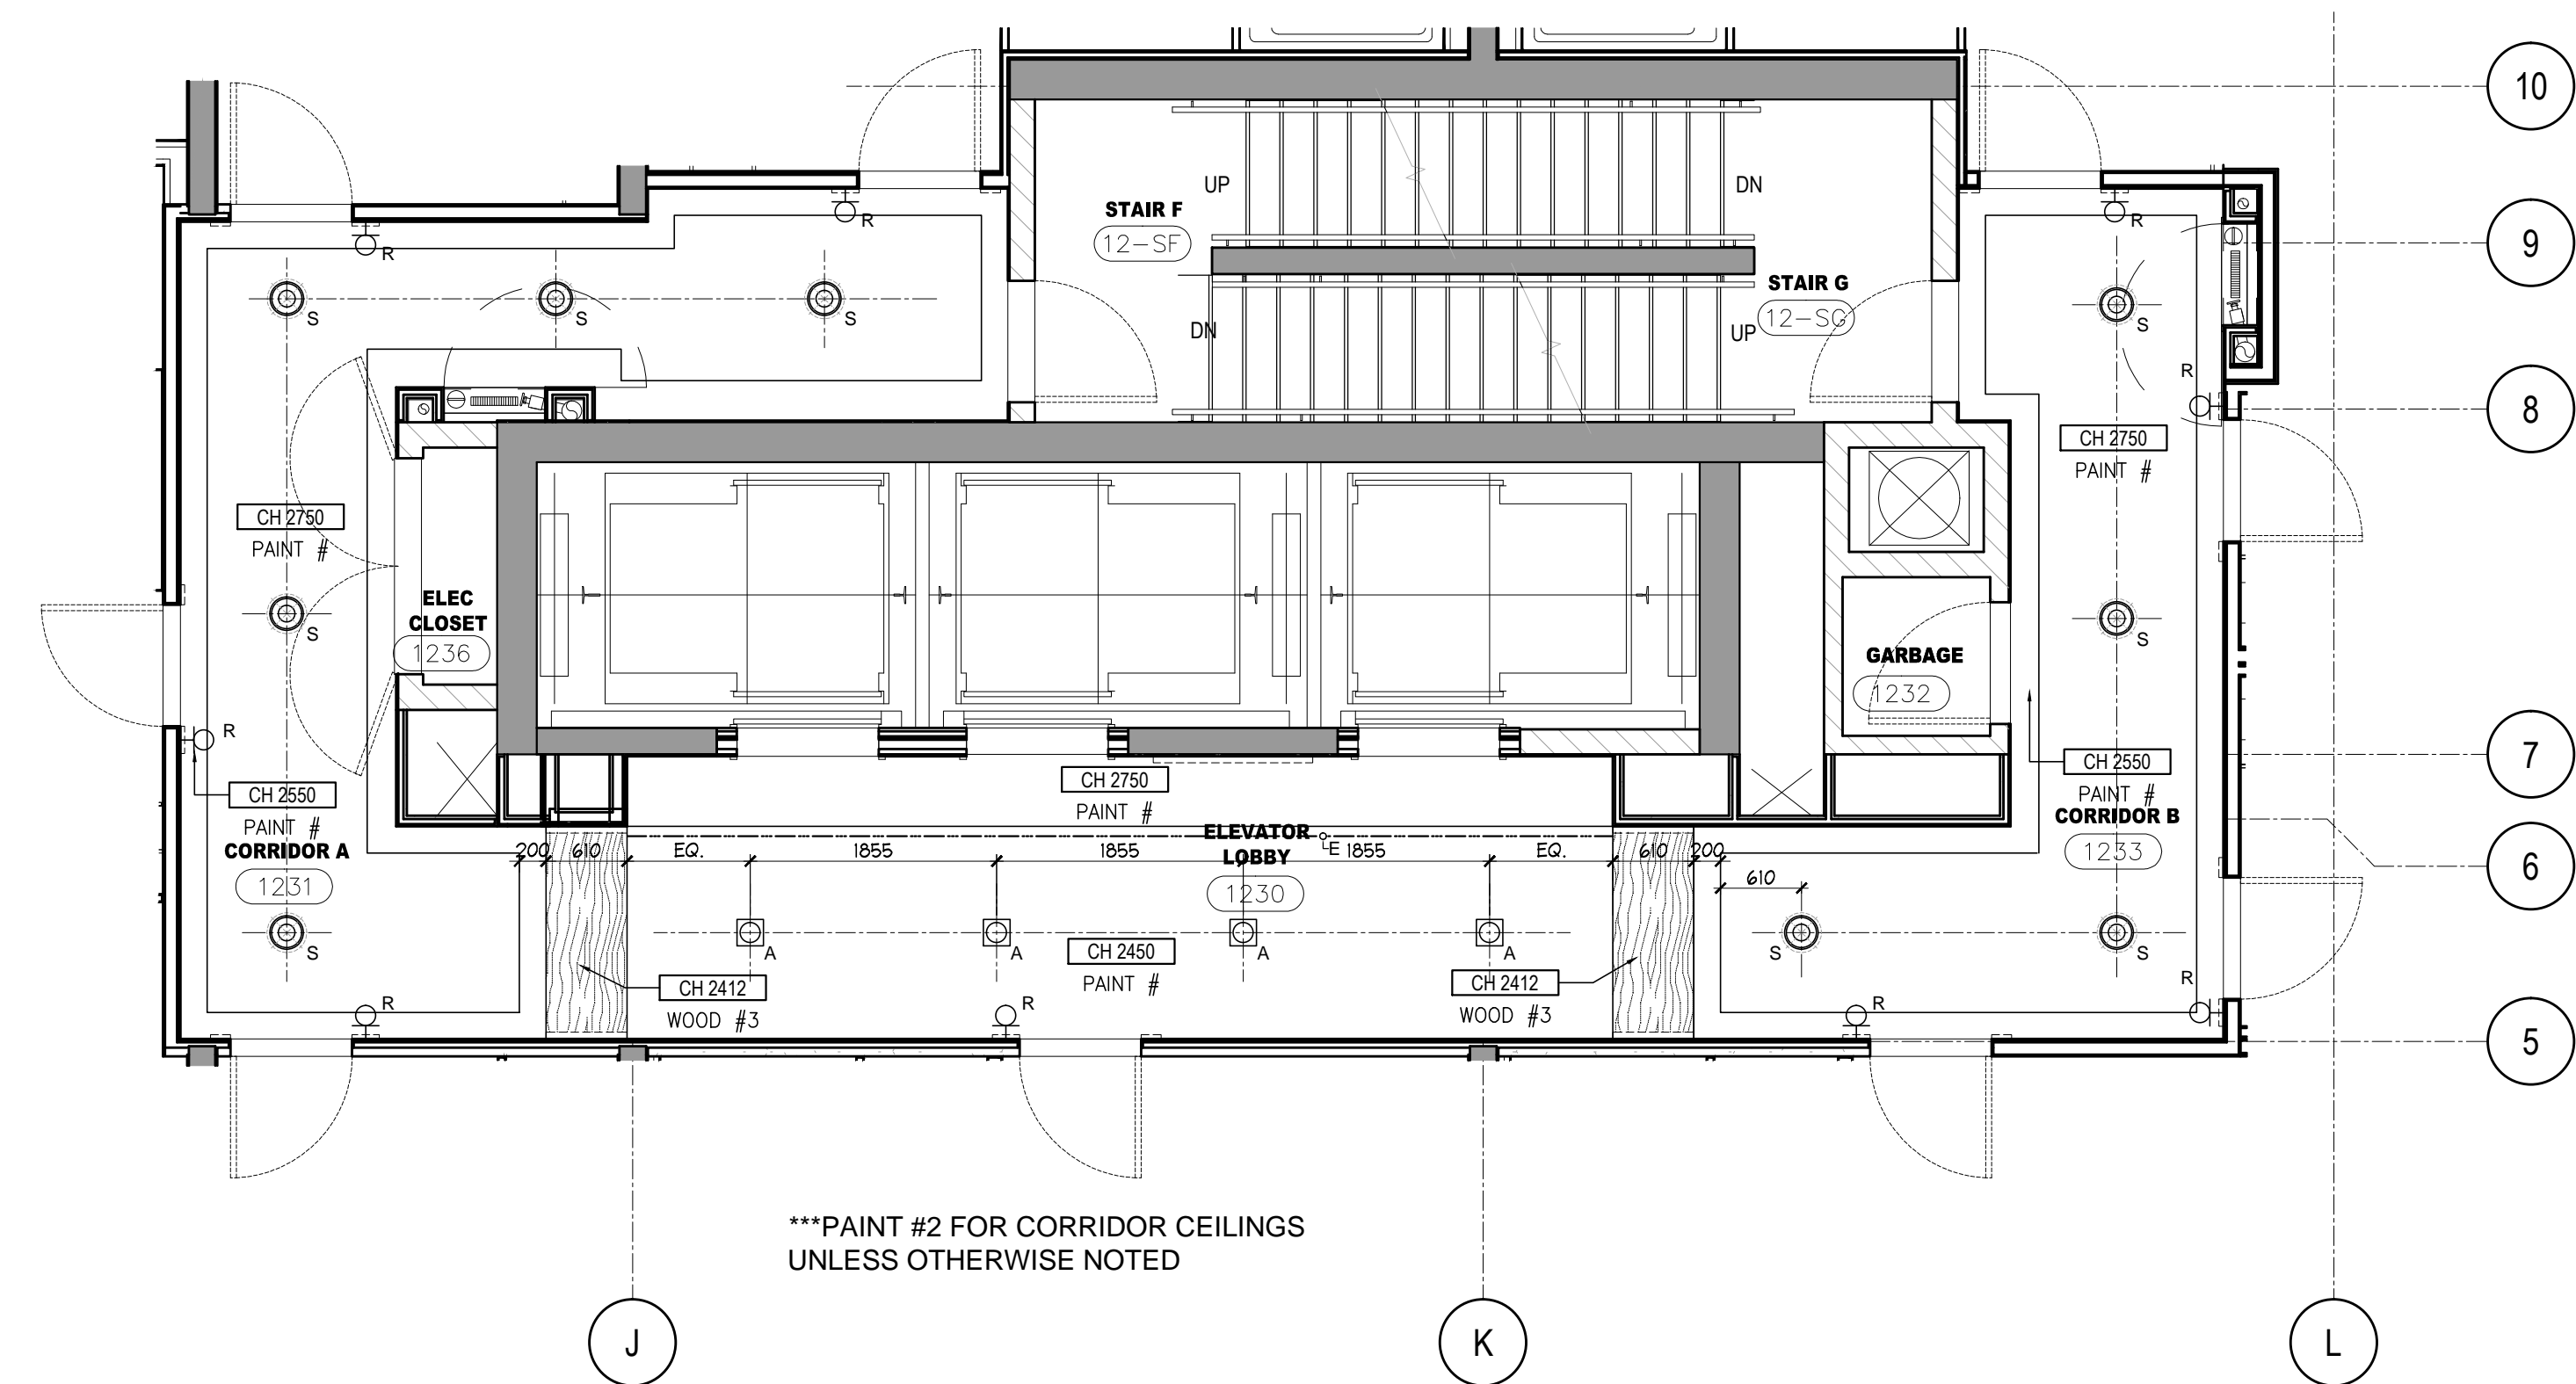

2 REFLECTED CEILING PLAN
D1.12.0 12TH FLOOR SCALE 1:50

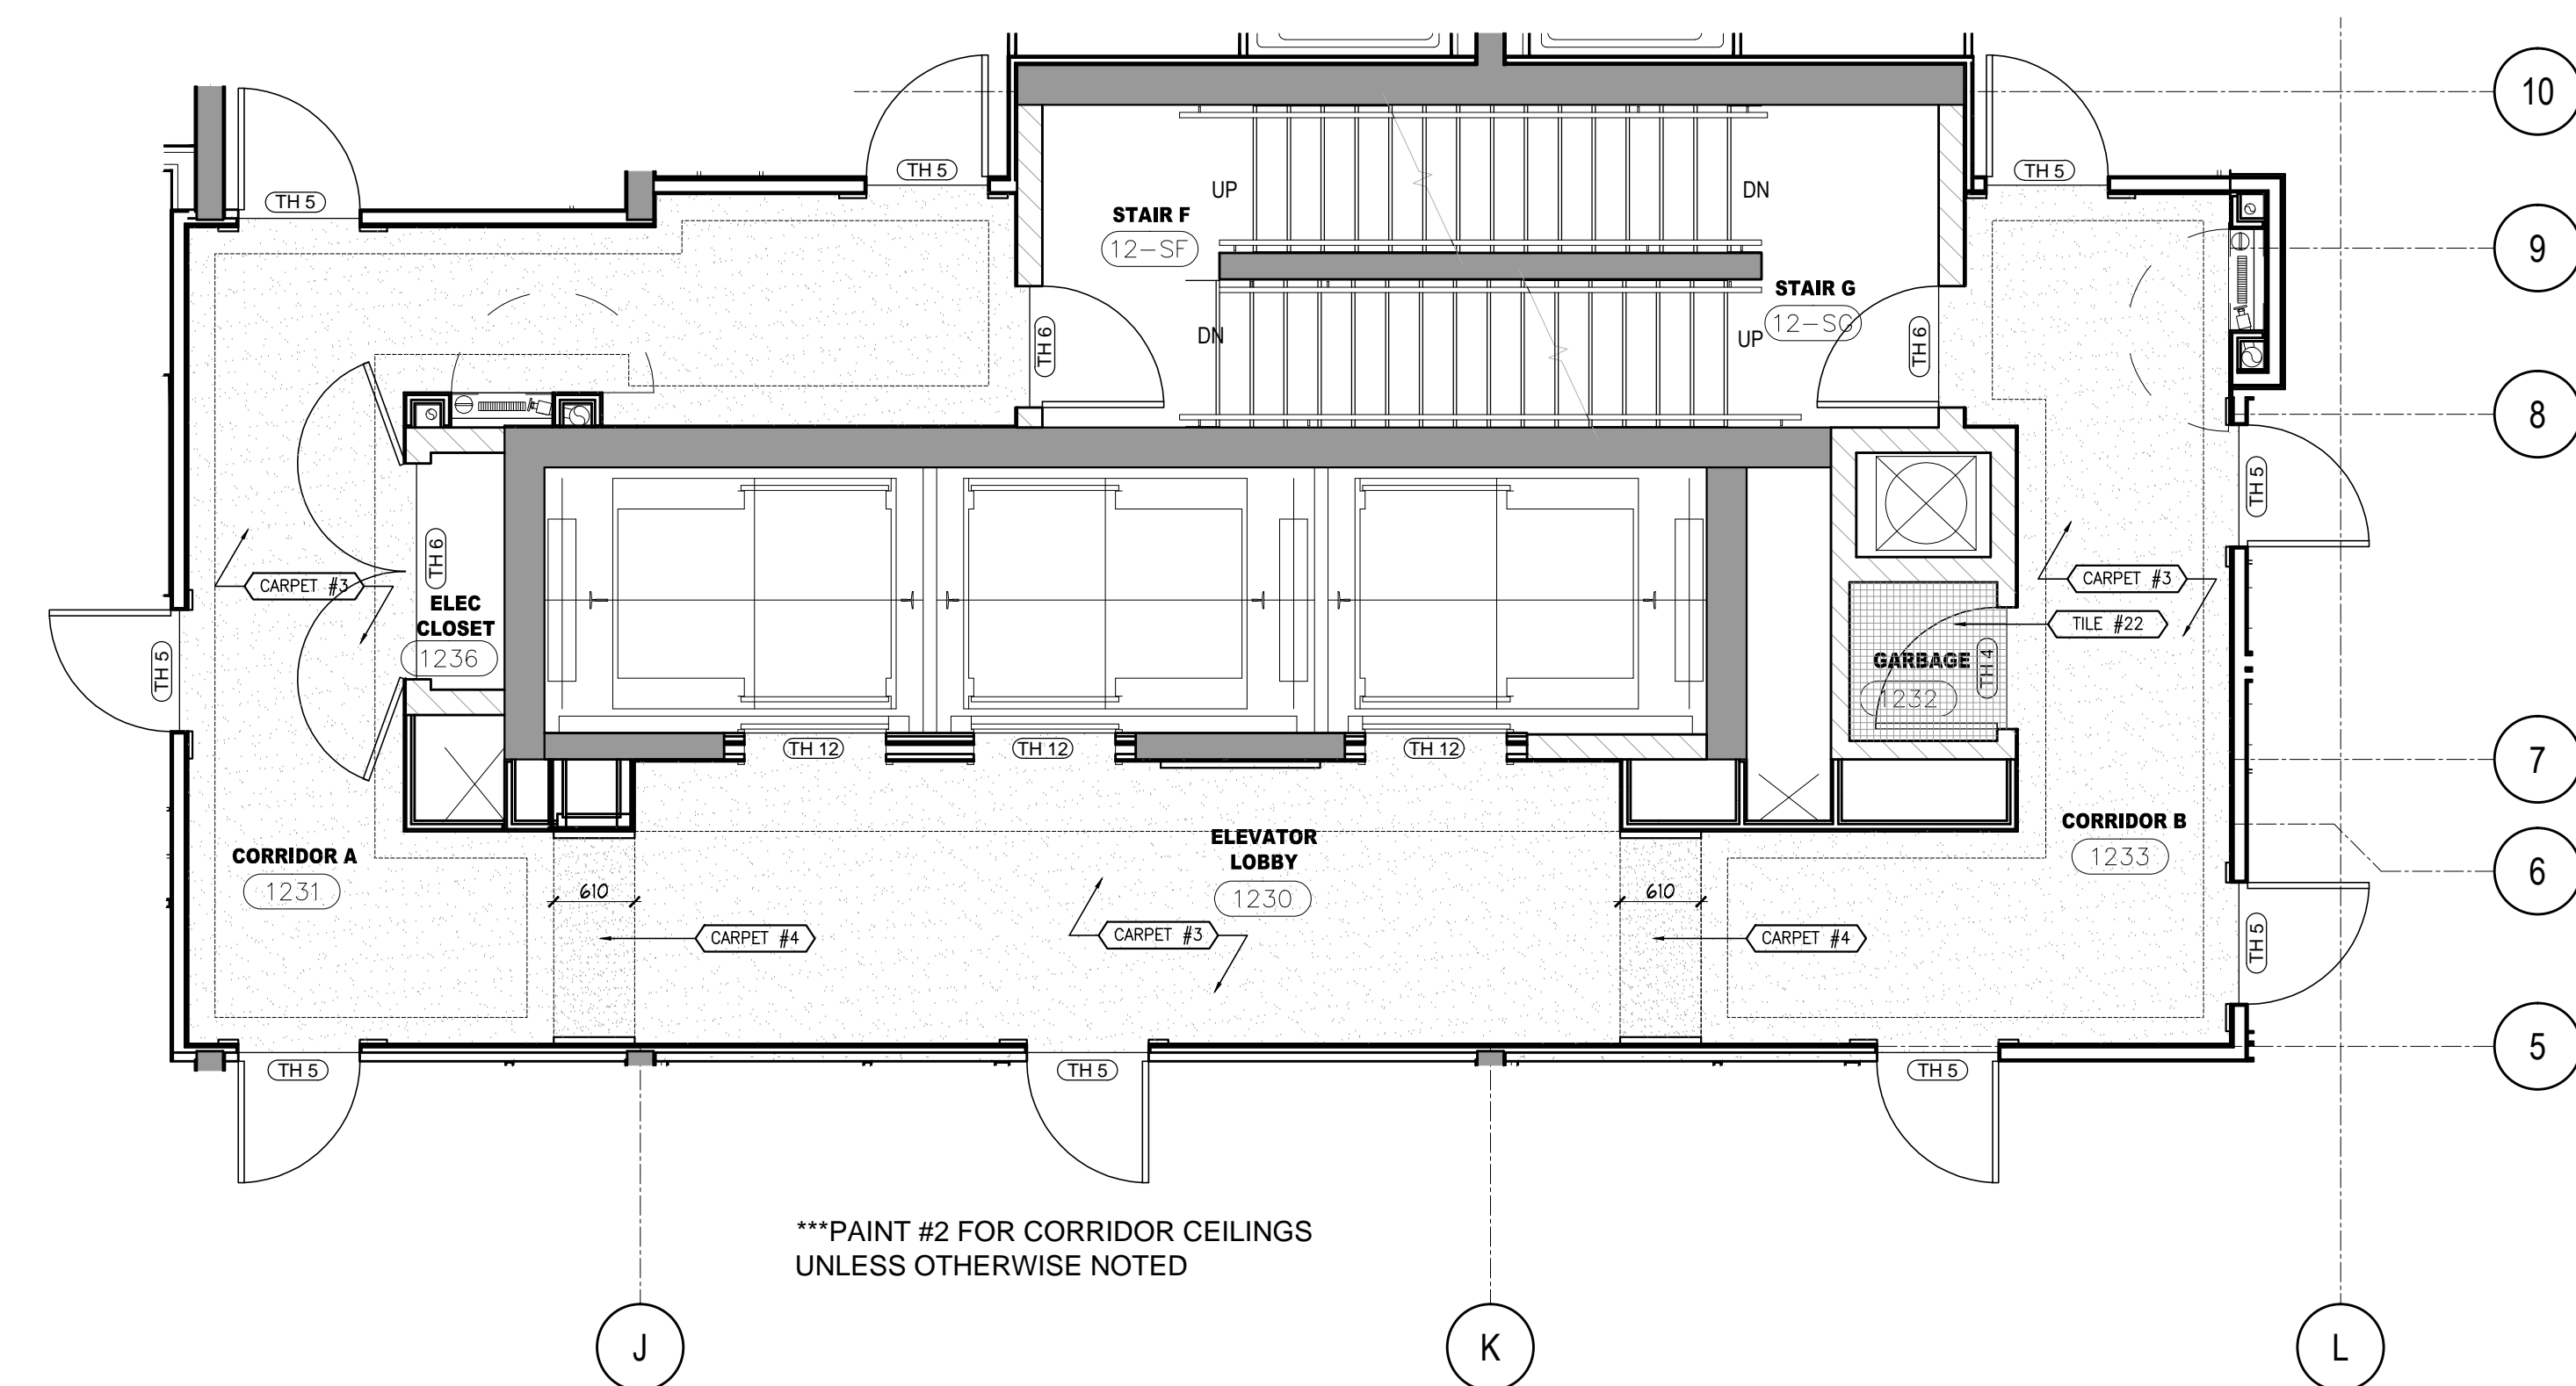

3 FLOOR FINISHES PLAN
D1.12.0 12TH FLOOR SCALE 1:50

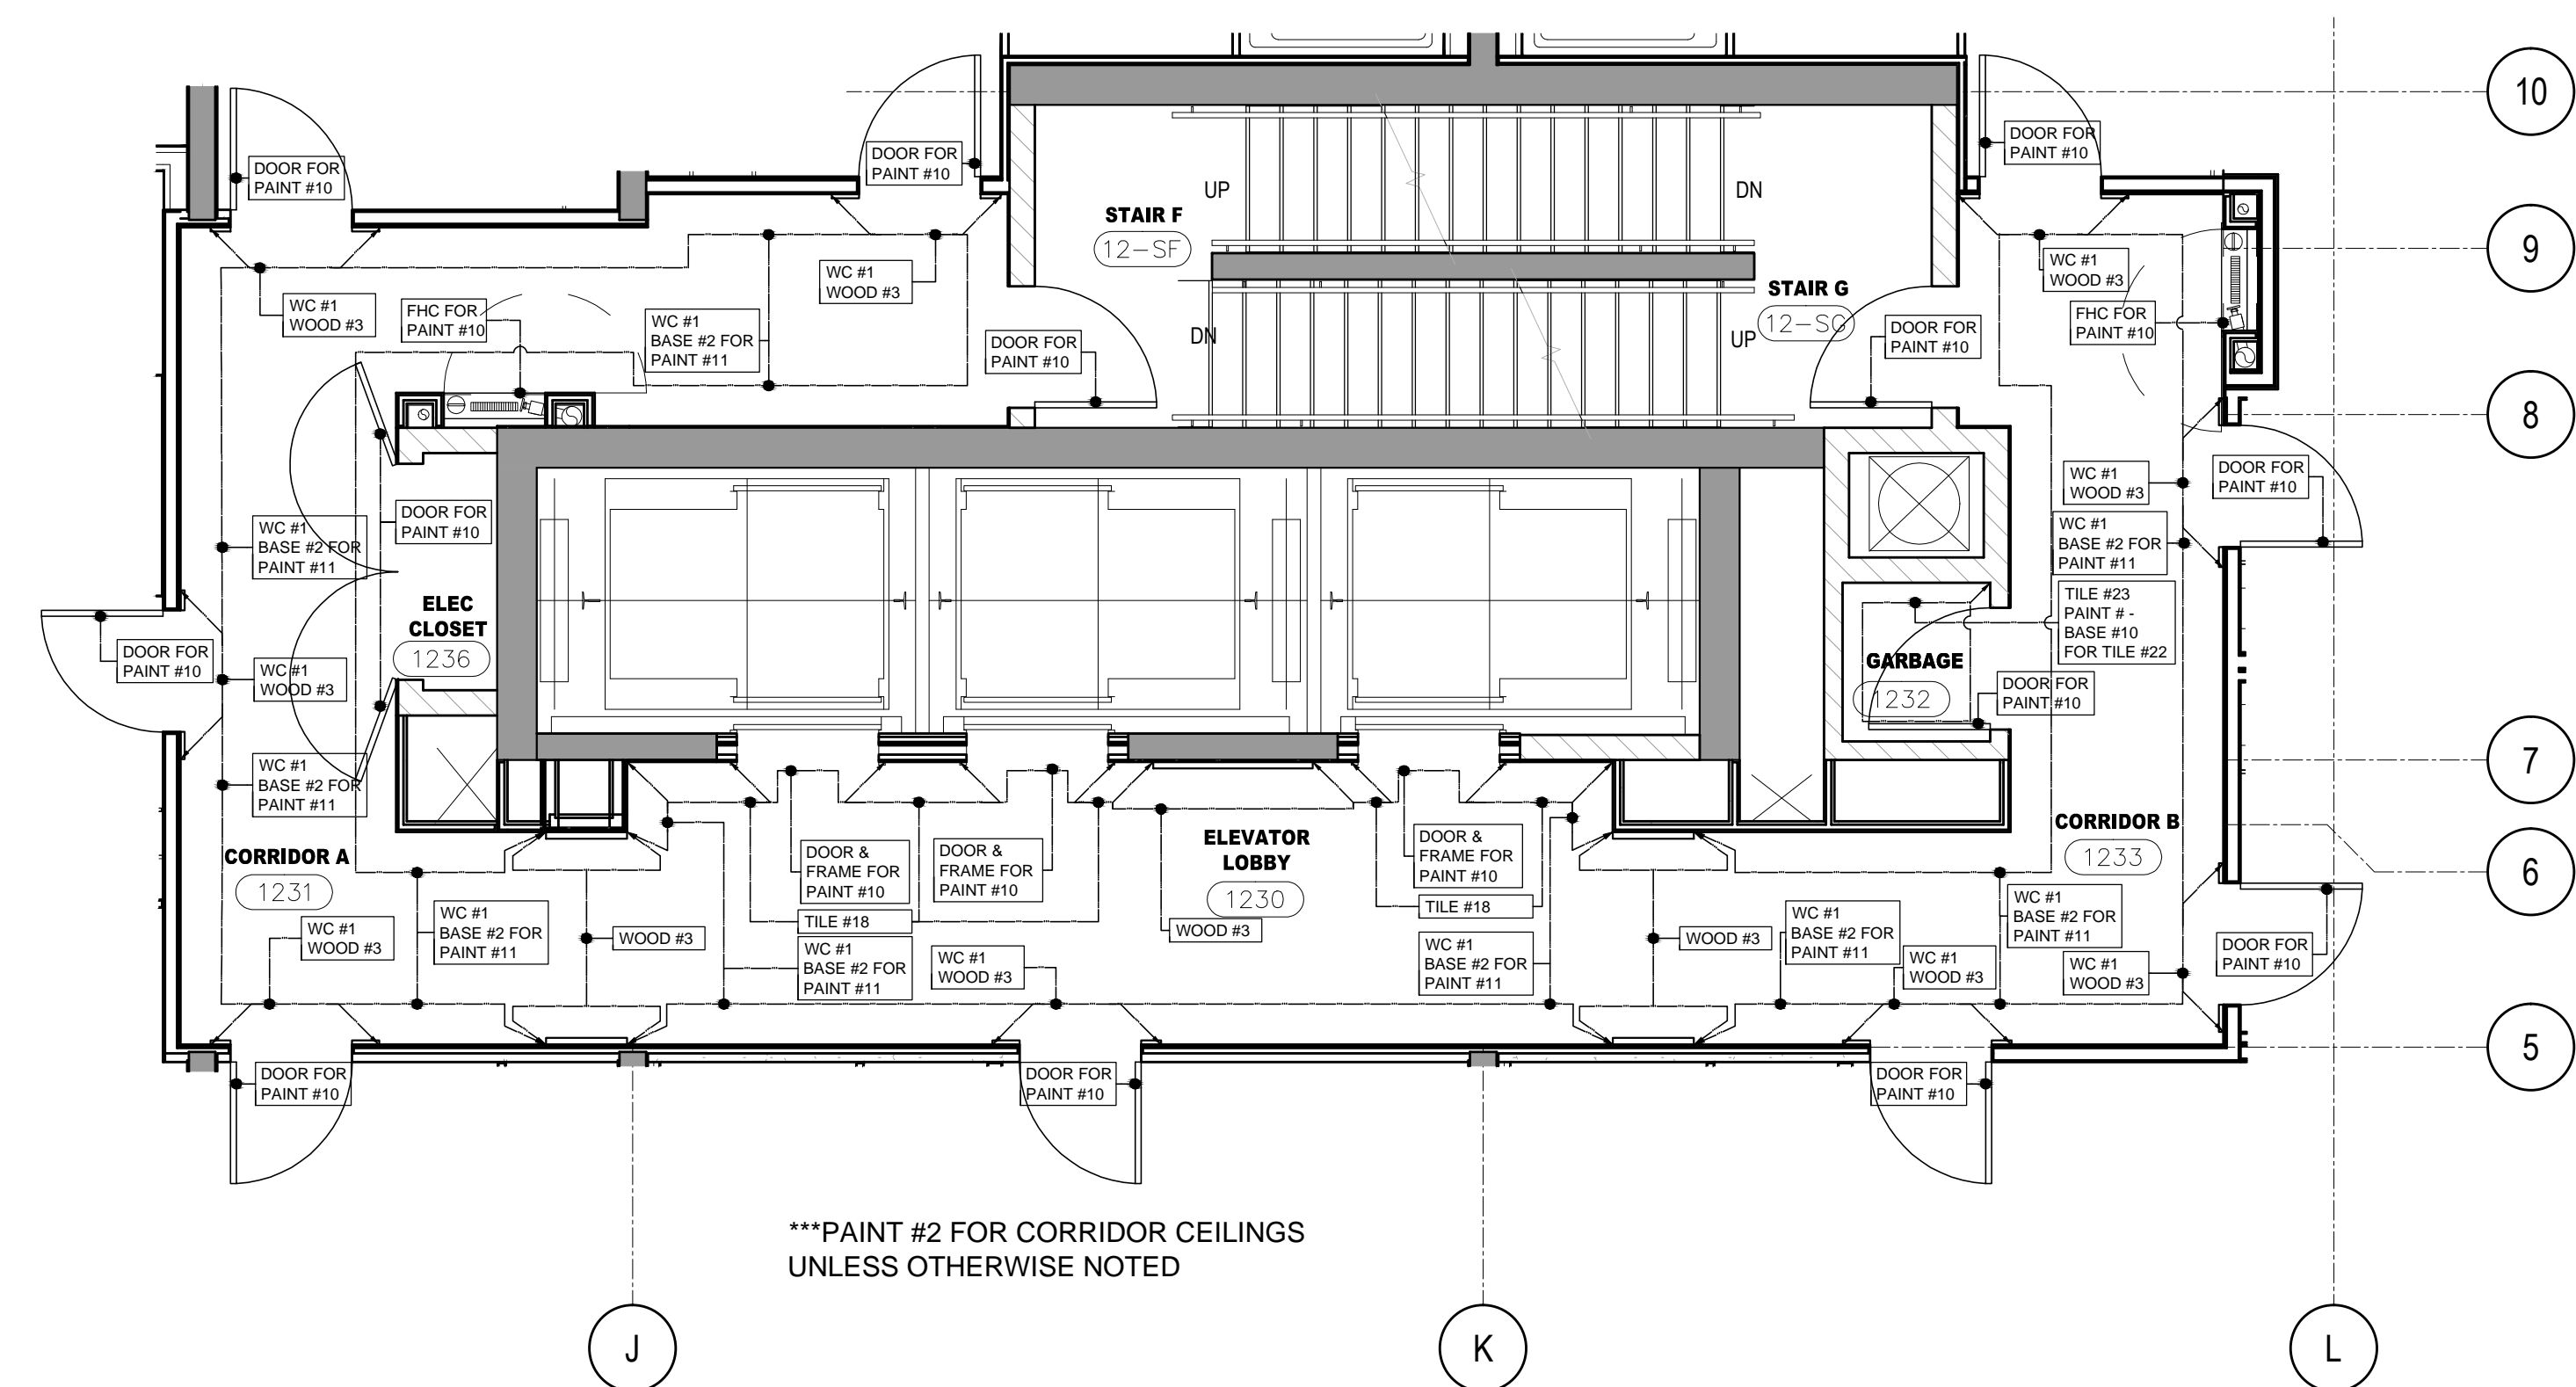

4 WALL FINISHES PLAN
D1.12.0 12TH FLOOR SCALE 1:50

ISSUED FOR
AS-BUILT

NO.	DATE	ISSUED FOR AS-BUILT	SV
01	31 MAY / 17	ISSUED FOR AS-BUILT	SV
REVISIONS:		COMMENTS	INI

UNION 31

UNION 31 INC.
183 BATHURST STREET, STE. 201
TORONTO, ON, M5T 2R7, CANADA
TEL: 416-597-1576 FAX: 416-597-2139

PROJECT NAME:	
ALEXANDRA PARK MAIN BUILDING	
BLOCK 11 ON, Canada	
PROJECT NO.:	13-949
DRAWINGS:	
12TH FLOOR CONSTRUCTION PLAN & REFLECTED CEILING PLAN & FLOOR & WALL FINISHES PLANS	
DATE STARTED:	07 AUG / 13
SCALE:	1:50
DRAWN BY:	AP
APPROVED BY:	KC
DRAWING NO.:	1.12.0