




1 CONSTRUCTION PLAN  
 101.1.3 GROUND FLOOR SCALE 1:50

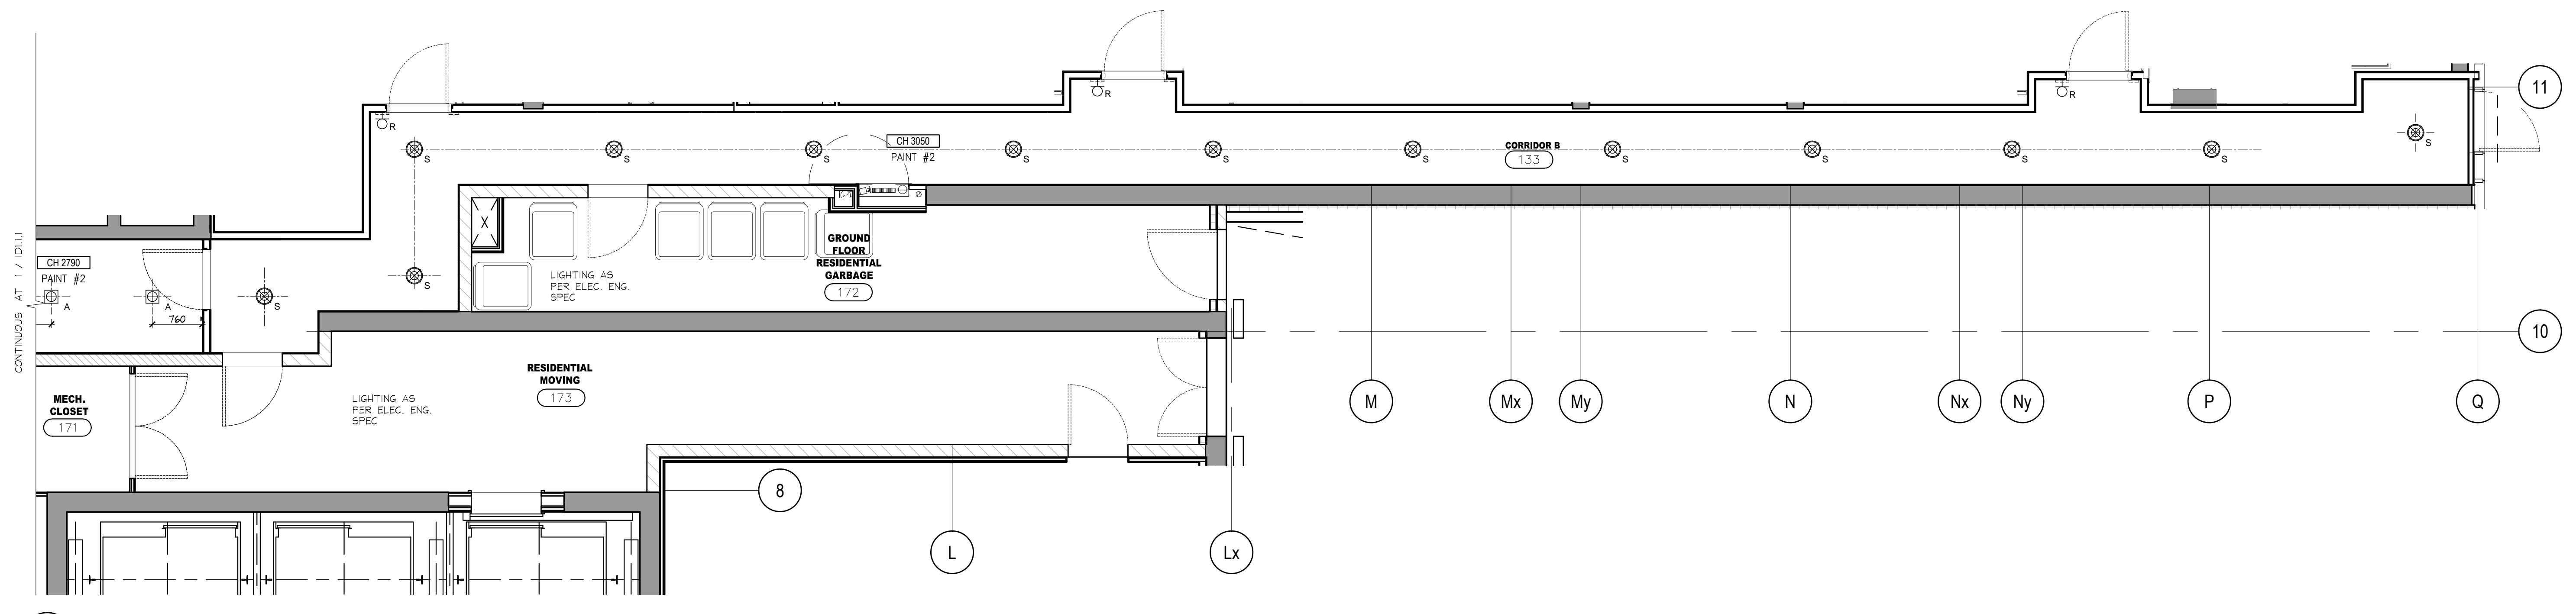

2 REFLECTED CEILING PLAN  
 101.1.3 GROUND FLOOR SCALE 1:50

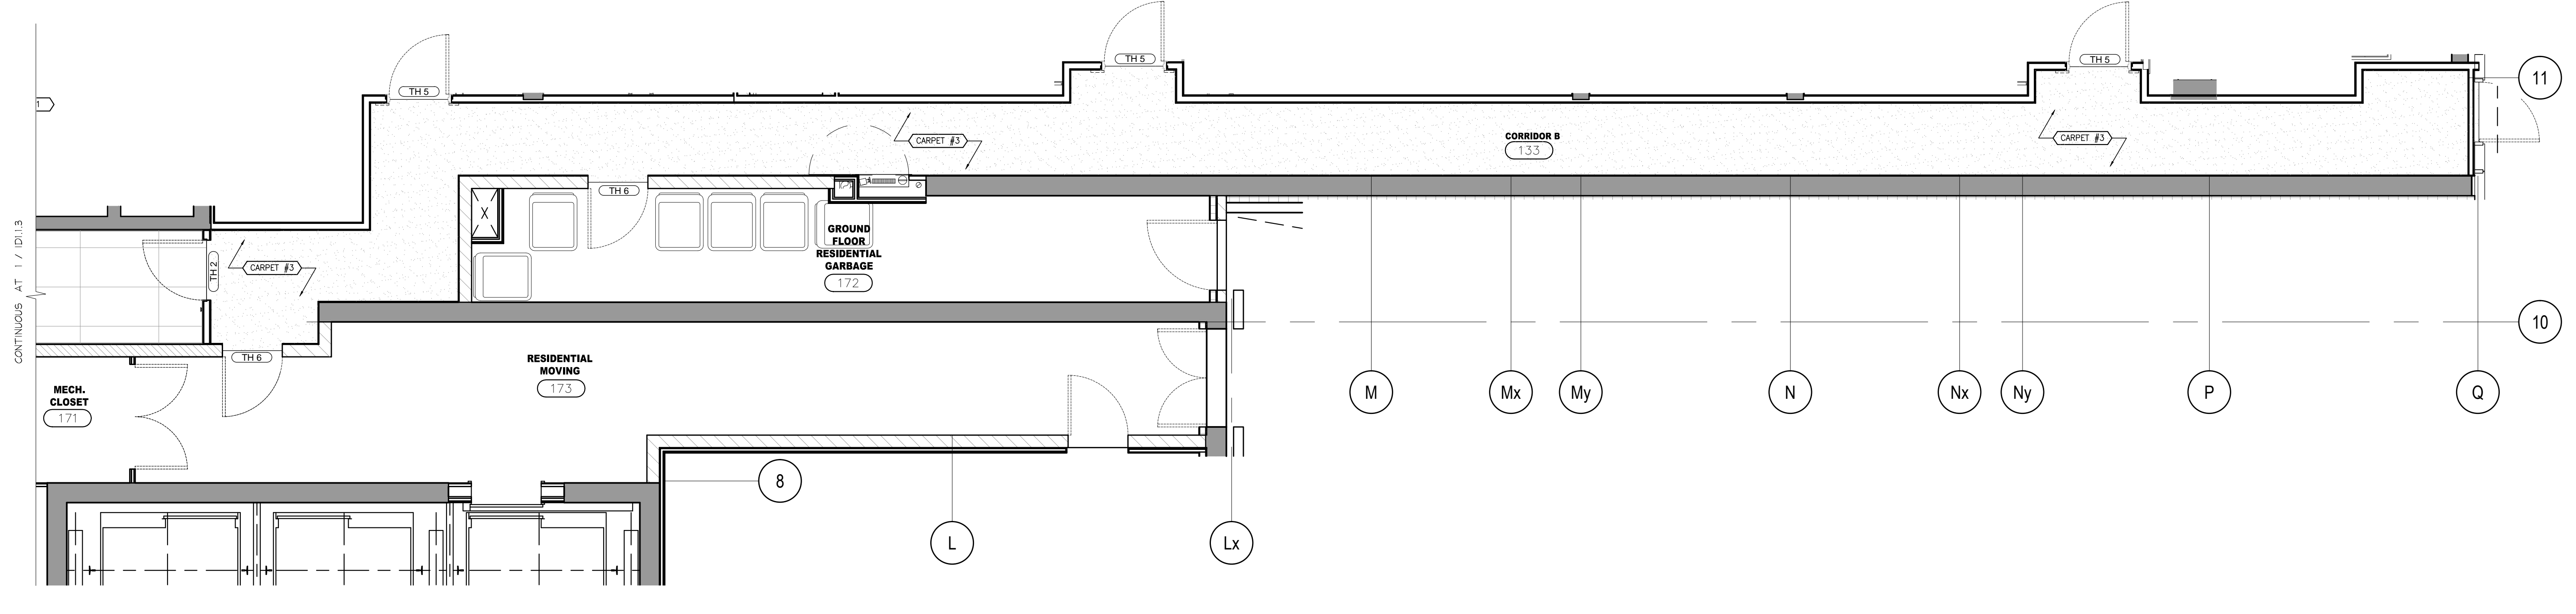

3 FLOOR FINISHES PLAN  
 101.1.3 GROUND FLOOR SCALE 1:50

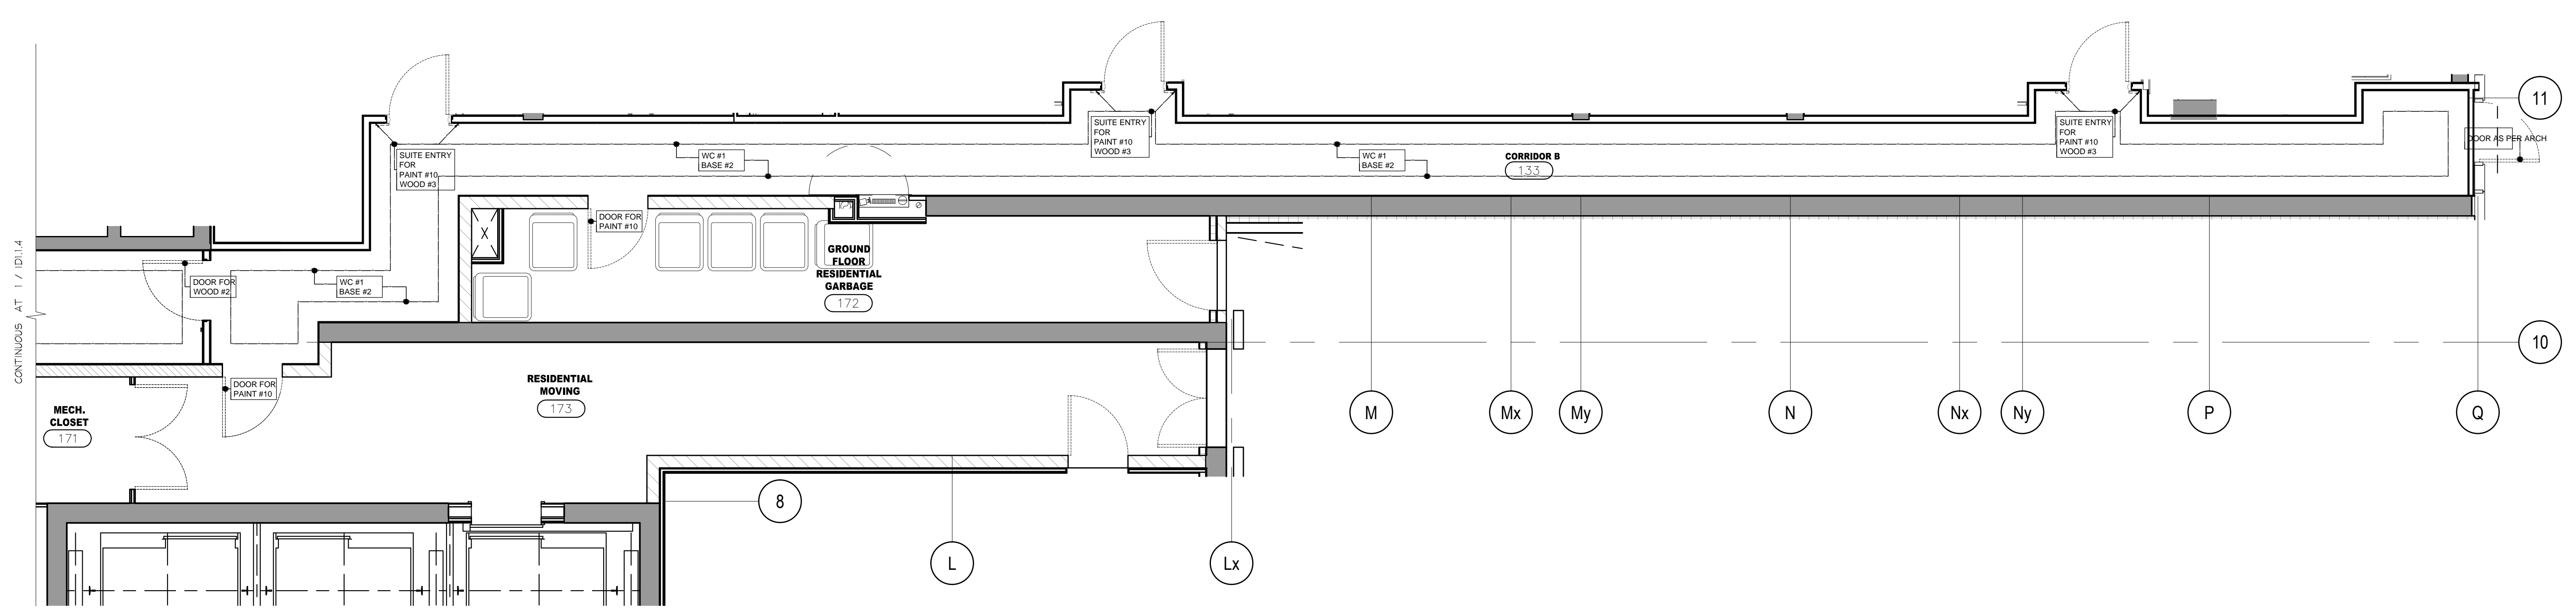

4 WALL FINISHES PLAN  
 101.1.3 GROUND FLOOR SCALE 1:50

**DO NOT SCALE DRAWINGS.**  
 CONTRACTOR MUST VERIFY ALL DRAWINGS, DIMENSIONS, DETAILS AND SPECIFICATIONS, AND REPORT ANY DISCREPANCIES TO UNION 31 INC. BEFORE PROCEEDING WITH WORK. MATERIALS MAY NOT BE SUBSTITUTED WITHOUT WRITTEN APPROVAL FROM UNION 31 INC.  
 ALL DRAWINGS AND SPECIFICATIONS ARE INSTRUMENTS OF SERVICE AND THE PROPERTY OF UNION 31 INC. WHICH MUST BE RETURNED AT THE COMPLETION OF THE WORK.

PRINTED: 30-May-17

**ISSUED FOR AS-BUILT**

NO.	DATE	COMMENTS	INI
01	31 MAY / 17	ISSUED FOR AS-BUILT	SV

**UNION 31**  
 183 BATHURST STREET, STE. 201  
 TORONTO, ON, M5T 2R7, CANADA  
 TEL: 416-597-1576 FAX: 416-597-2139

PROJECT NAME:  
**ALEXANDRA PARK MAIN BUILDING**  
 BLOCK 11  
 ON, Canada

PROJECT NO.:  
 13-949

DRAWINGS:  
 GROUND FLOOR / CORRIDOR  
 CONSTRUCTION PLAN &  
 REFLECTED CEILING PLAN  
 FLOOR & WALL FINISHES PLANS

DATE STARTED: 07 AUG / 13  
 SCALE: 1:50  
 DRAWN BY: AP  
 APPROVED BY: KC

DRAWING NO.:  
**ID 1.1.5**