




1 FLOOR FINISHES PLAN  
4TH FLOOR  
SCALE 1:50

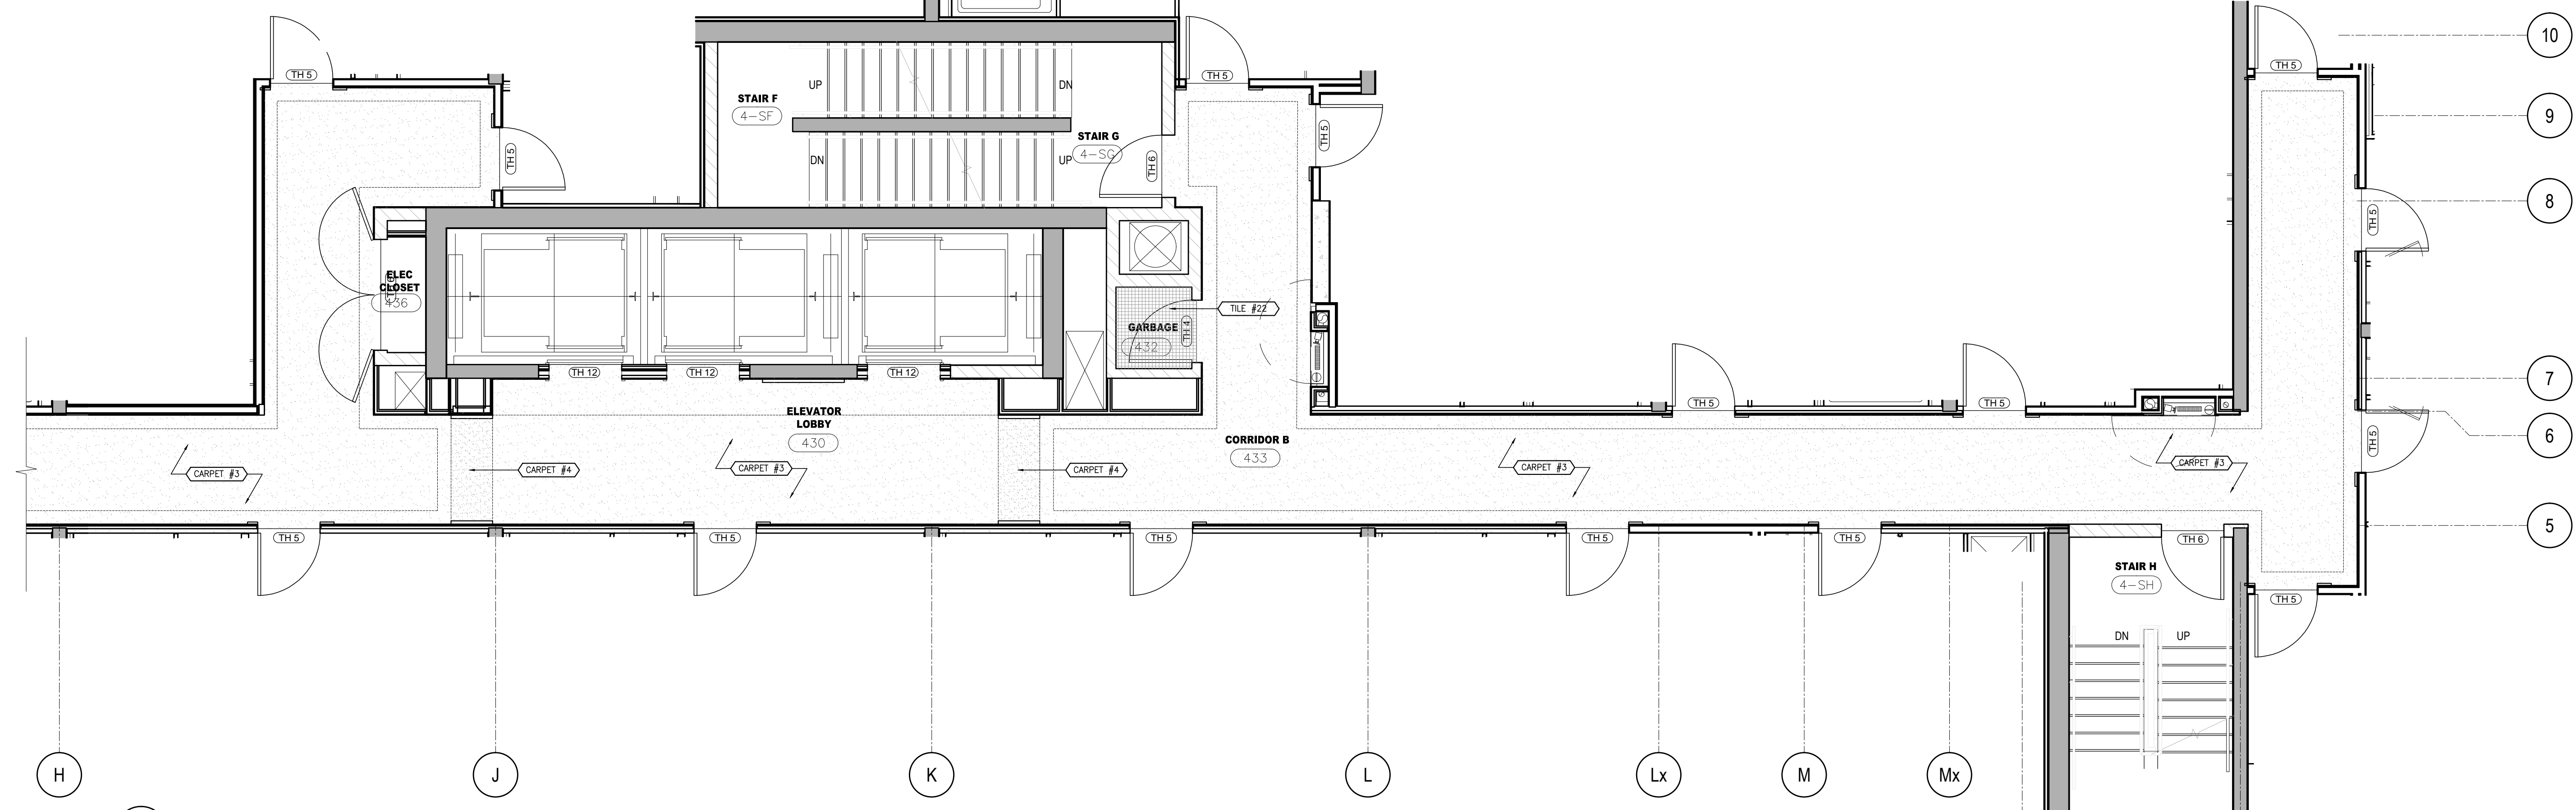

2 FLOOR FINISHES PLAN  
4TH FLOOR  
SCALE 1:50

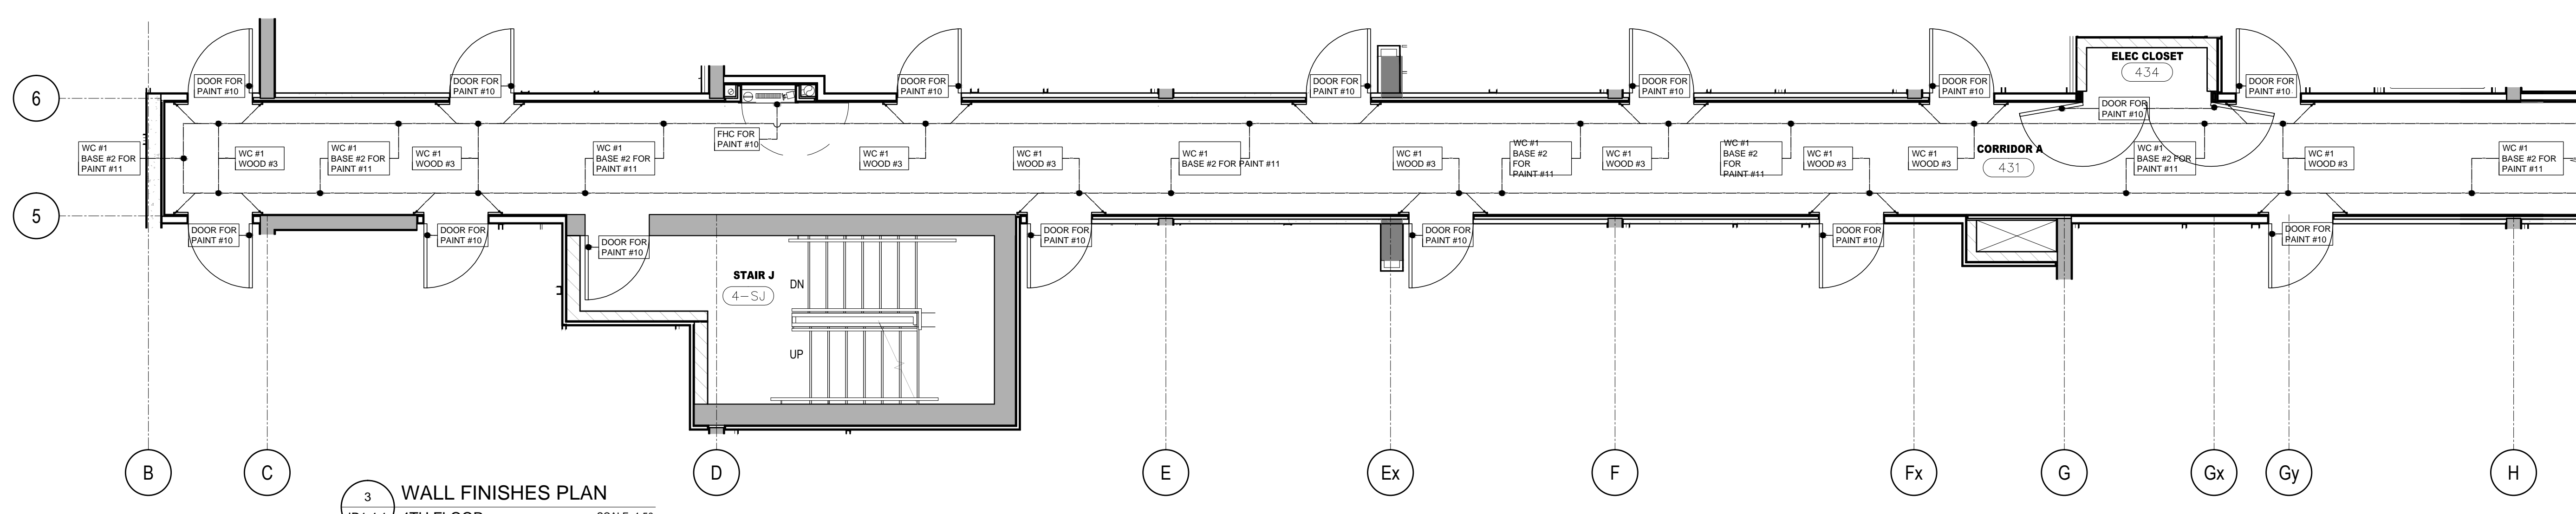

3 WALL FINISHES PLAN  
4TH FLOOR  
SCALE 1:50

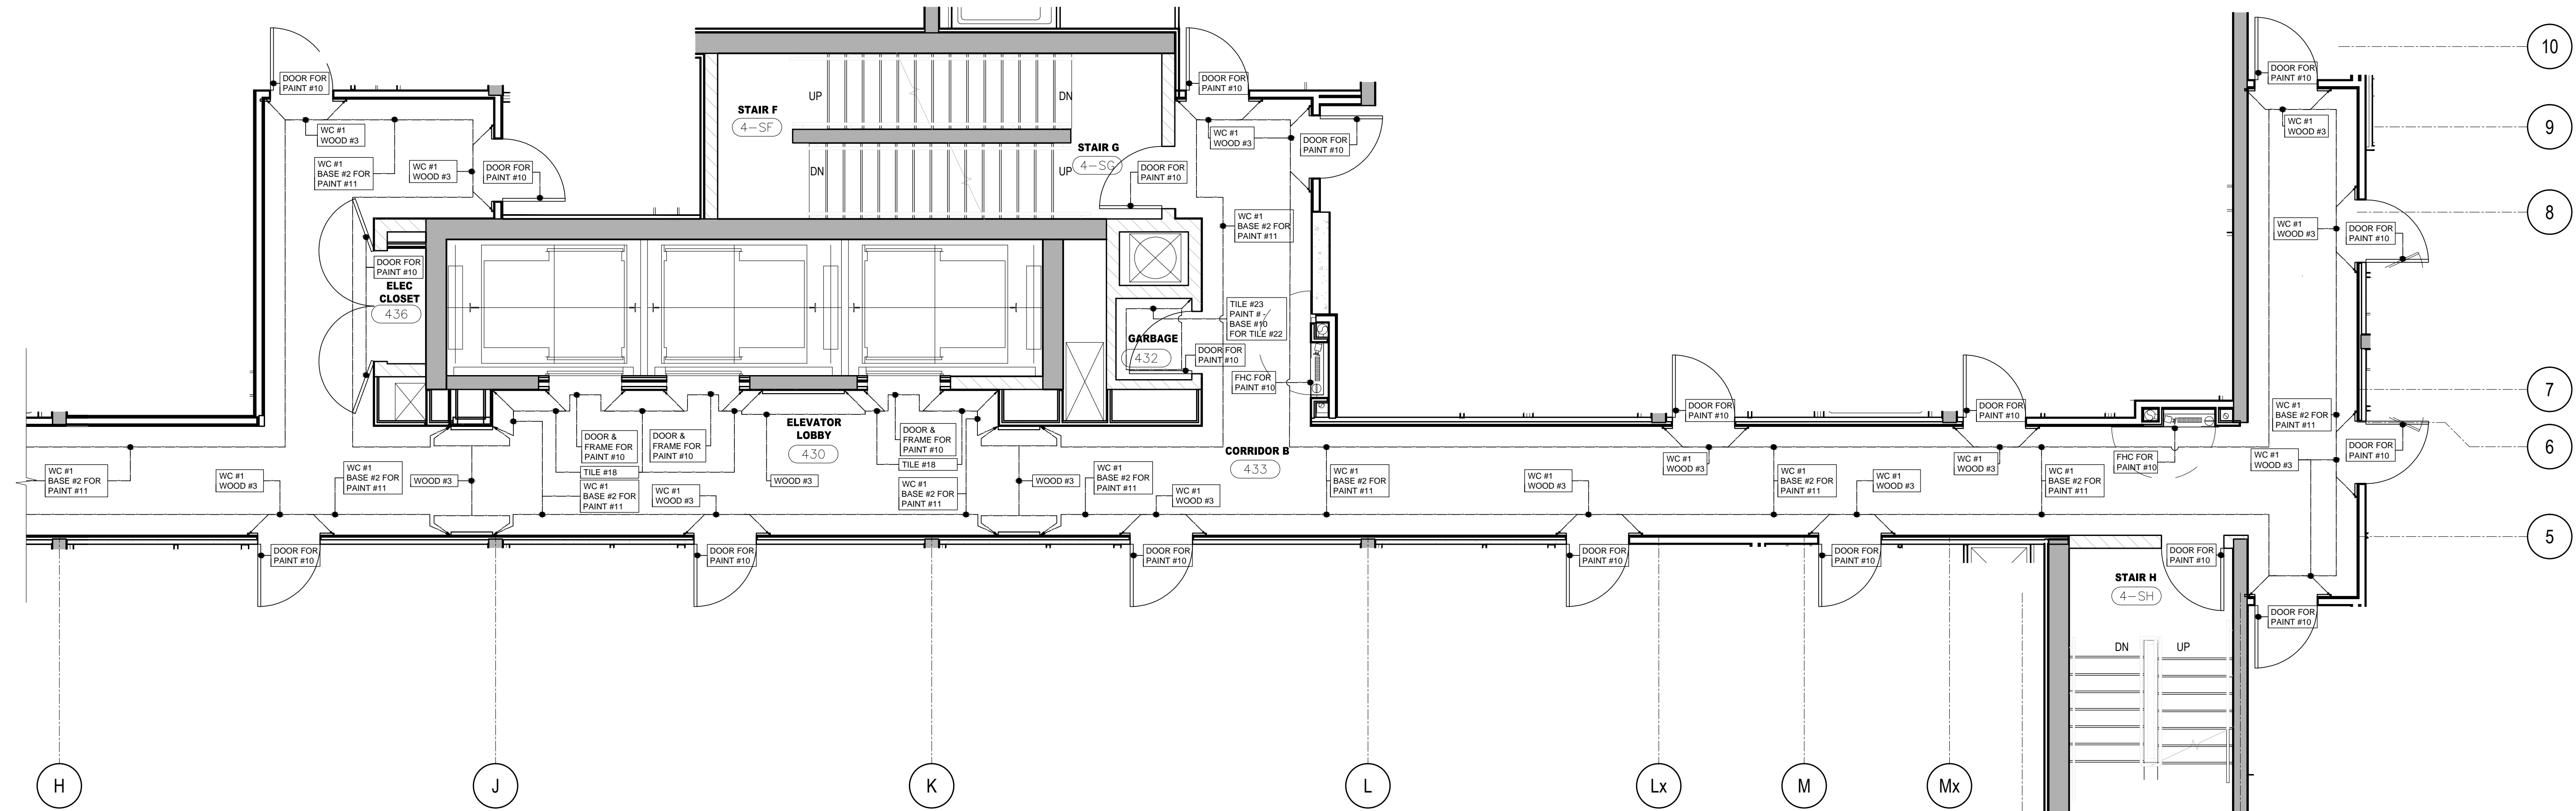

4 WALL FINISHES PLAN  
4TH FLOOR  
SCALE 1:50

**DO NOT SCALE DRAWINGS.**  
CONTRACTOR MUST VERIFY ALL DRAWINGS, DIMENSIONS, DETAILS AND SPECIFICATIONS, AND REPORT ANY DISCREPANCIES TO UNOCBI INC. BEFORE PROCEEDING WITH WORK. MATERIALS MAY NOT BE SUBSTITUTED WITHOUT WRITTEN APPROVAL FROM UNOCBI INC.  
ALL DRAWINGS AND SPECIFICATIONS ARE INSTRUMENTS OF SERVICE AND THE PROPERTY OF UNOCBI INC. WHICH MUST BE RETURNED AT THE COMPLETION OF THE WORK.

PRINTED: 30-May-17

ISSUED FOR AS-BUILT

NO.	DATE	COMMENTS	BY
01	31 MAY / 17	ISSUED FOR AS-BUILT	SV

UNOCBI

UNOCBI INC.  
183 BATHURST STREET, STE. 201  
TORONTO, ON, M5T 2R7, CANADA  
TEL: 416-597-1576 FAX: 416-597-2139

PROJECT NAME:	
ALEXANDRA PARK MAIN BUILDING	
BLOCK 11 ON, Canada	
PROJECT NO.:	13-949
DRAWINGS:	
4TH FLOOR FLOOR FINISHES PLAN & WALL FINISHES PLAN	
DATE STARTED:	07 AUG / 13
SCALE:	1 : 50
DRAWN BY:	AP
APPROVED BY:	KC
DRAWING NO.:	ID
	1.4.1