




1 CONSTRUCTION PLAN  
5TH FLOOR SCALE 1:50

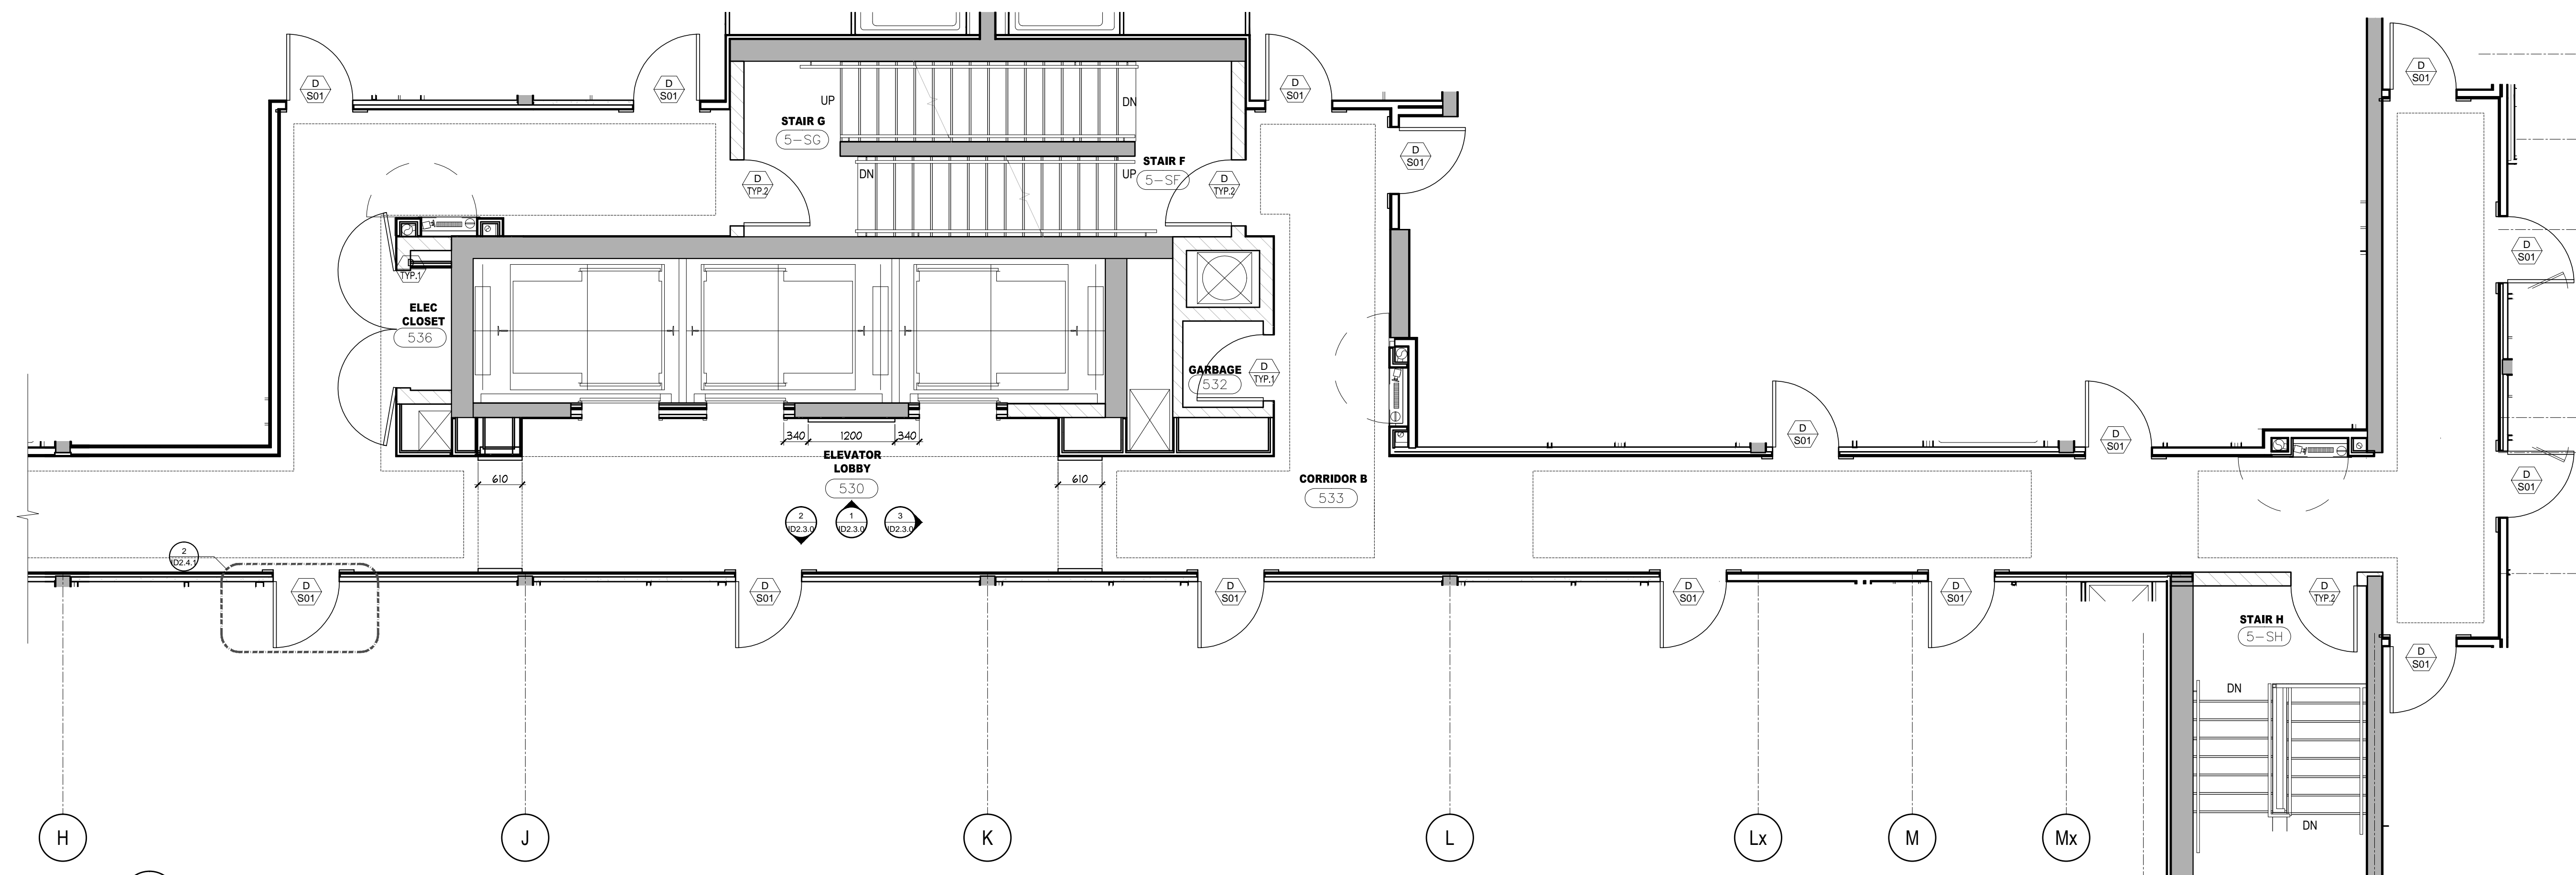

2 CONSTRUCTION PLAN  
5TH FLOOR SCALE 1:50

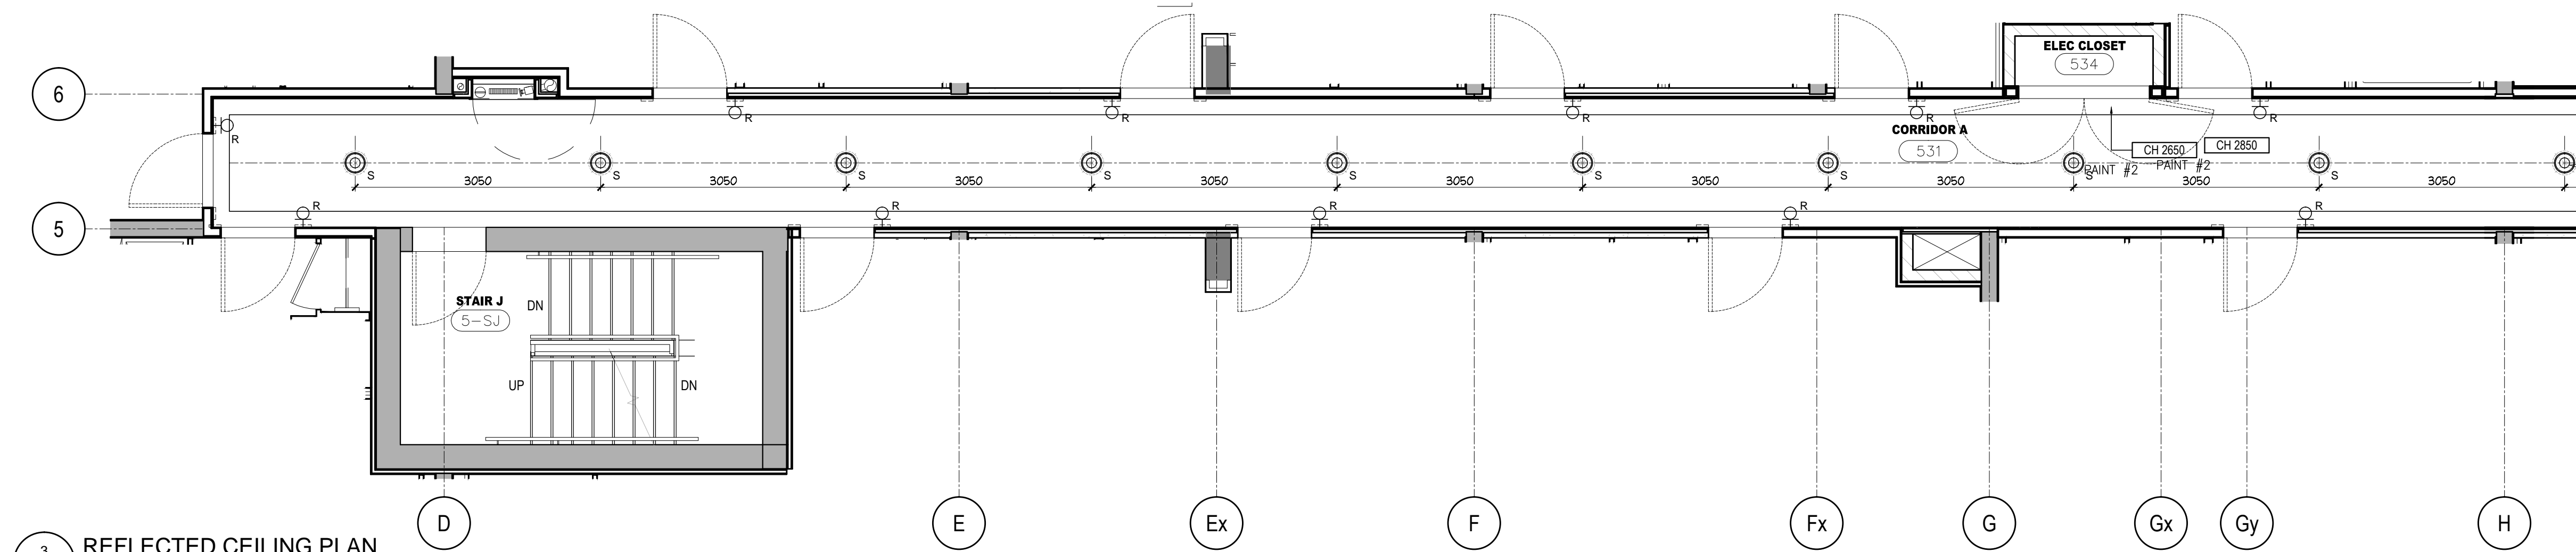

3 REFLECTED CEILING PLAN  
5TH FLOOR SCALE 1:50

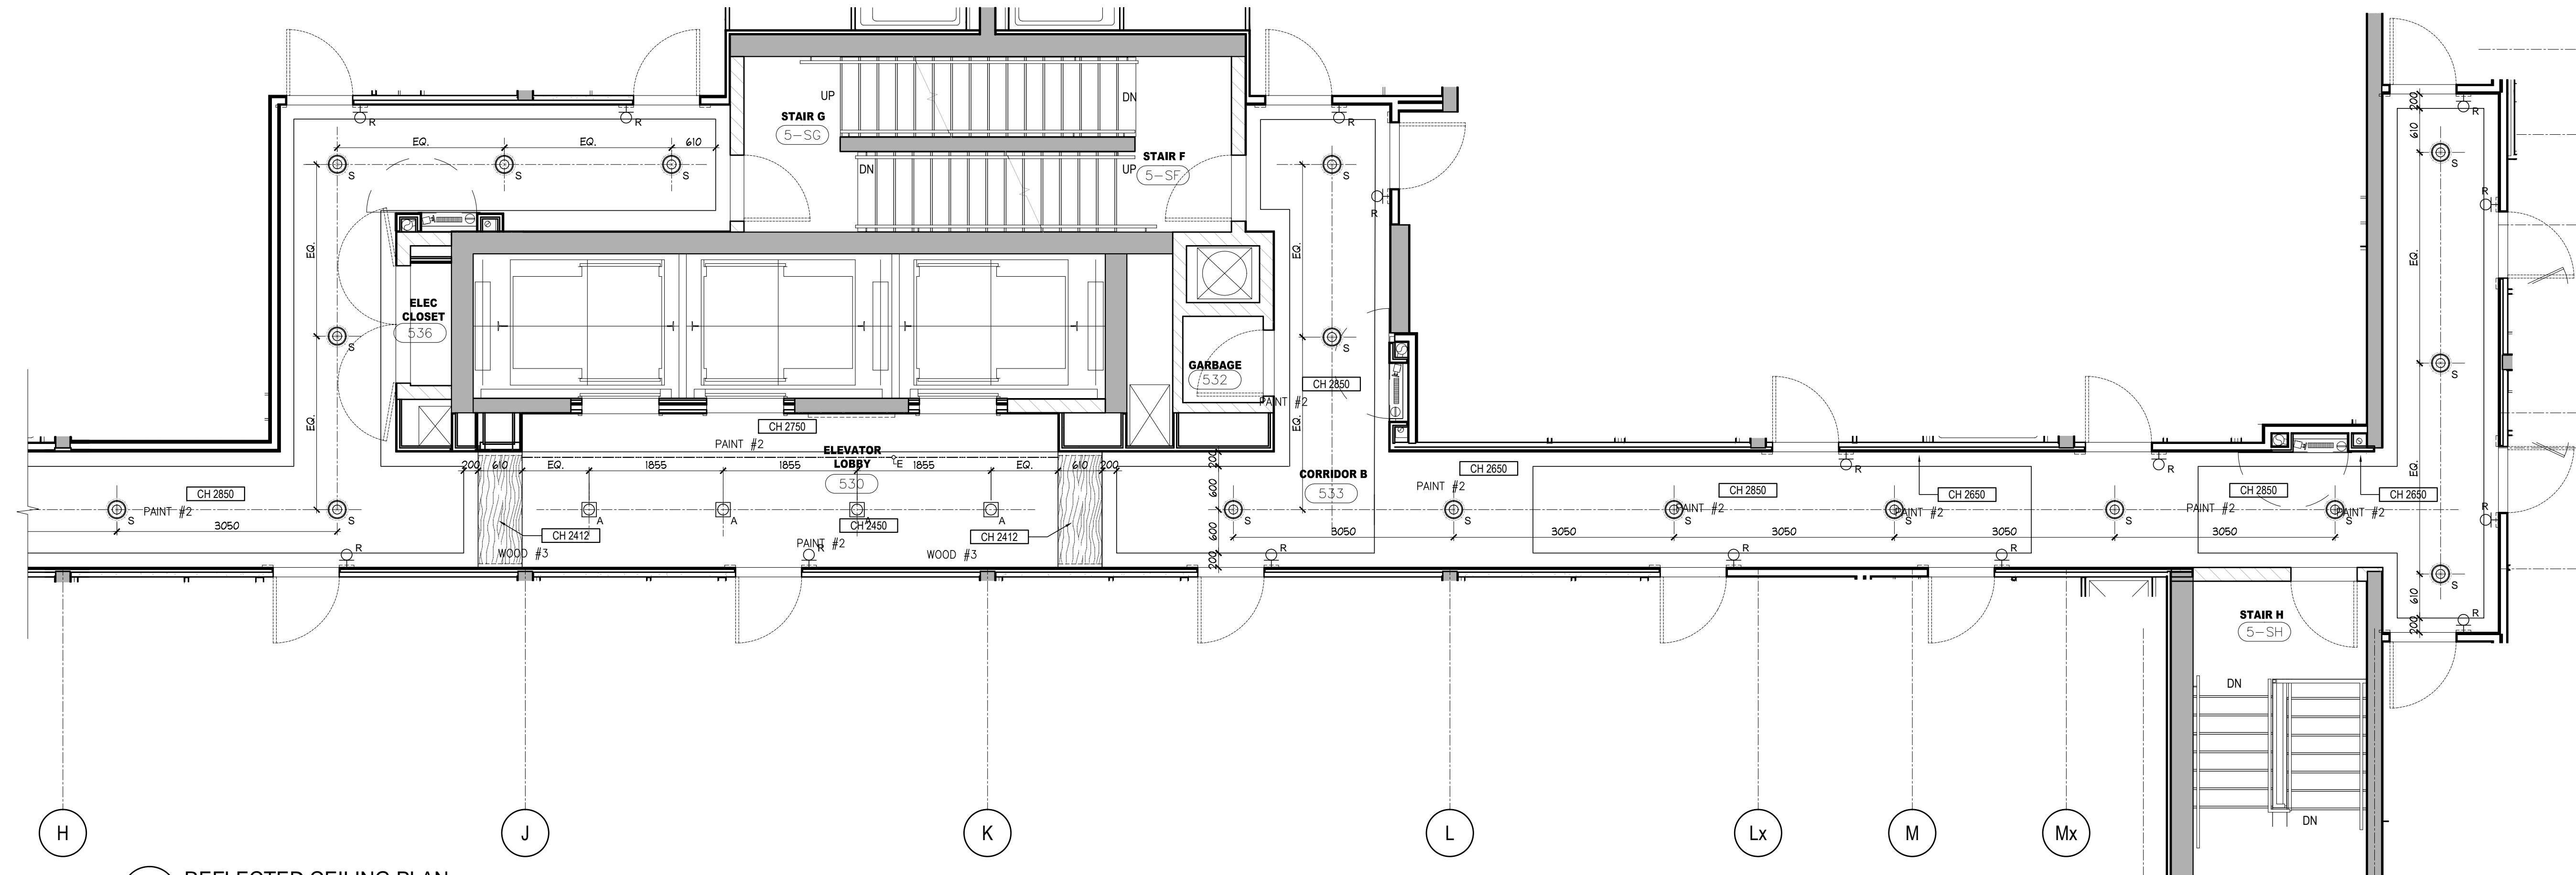

4 REFLECTED CEILING PLAN  
5TH FLOOR SCALE 1:50

**DO NOT SCALE DRAWINGS.**  
CONTRACTOR MUST VERIFY ALL DRAWINGS, DIMENSIONS, DETAILS AND SPECIFICATIONS, AND REPORT ANY DISCREPANCIES TO UNIOB1 INC. BEFORE PROCEEDING WITH WORK. MATERIALS MAY NOT BE SUBSTITUTED WITHOUT WRITTEN APPROVAL FROM UNIOB1 INC.  
ALL DRAWINGS AND SPECIFICATIONS ARE INSTRUMENTS OF SERVICE AND THE PROPERTY OF UNIOB1 INC. WHICH MUST BE RETURNED AT THE COMPLETION OF THE WORK.

PRINTED: 30-May-17

**ISSUED FOR AS-BUILT**

NO.	DATE	COMMENTS	INI
01	31 MAY / 17	ISSUED FOR AS-BUILT	SV

**UNIOB1**

**UNIOB1 INC.**  
183 BATHURST STREET, STE. 201  
TORONTO, ON, M5T 2R7, CANADA  
TEL: 416-597-1576 FAX: 416-597-2139

PROJECT NAME: <b>ALEXANDRA PARK MAIN BUILDING</b>	
BLOCK 11 ON, Canada	
PROJECT NO.: 13-949	DRAWINGS:
<b>5TH FLOOR CONSTRUCTION PLAN &amp; REFLECTED CEILING PLAN</b>	
DATE STARTED: 07 AUG / 13	DRAWING NO.:
SCALE: 1 : 50	<b>ID</b>
DRAWN BY: AP	<b>1.5.0</b>
APPROVED BY: KC	