




1 FLOOR FINISHES PLAN  
5TH FLOOR SCALE 1:50

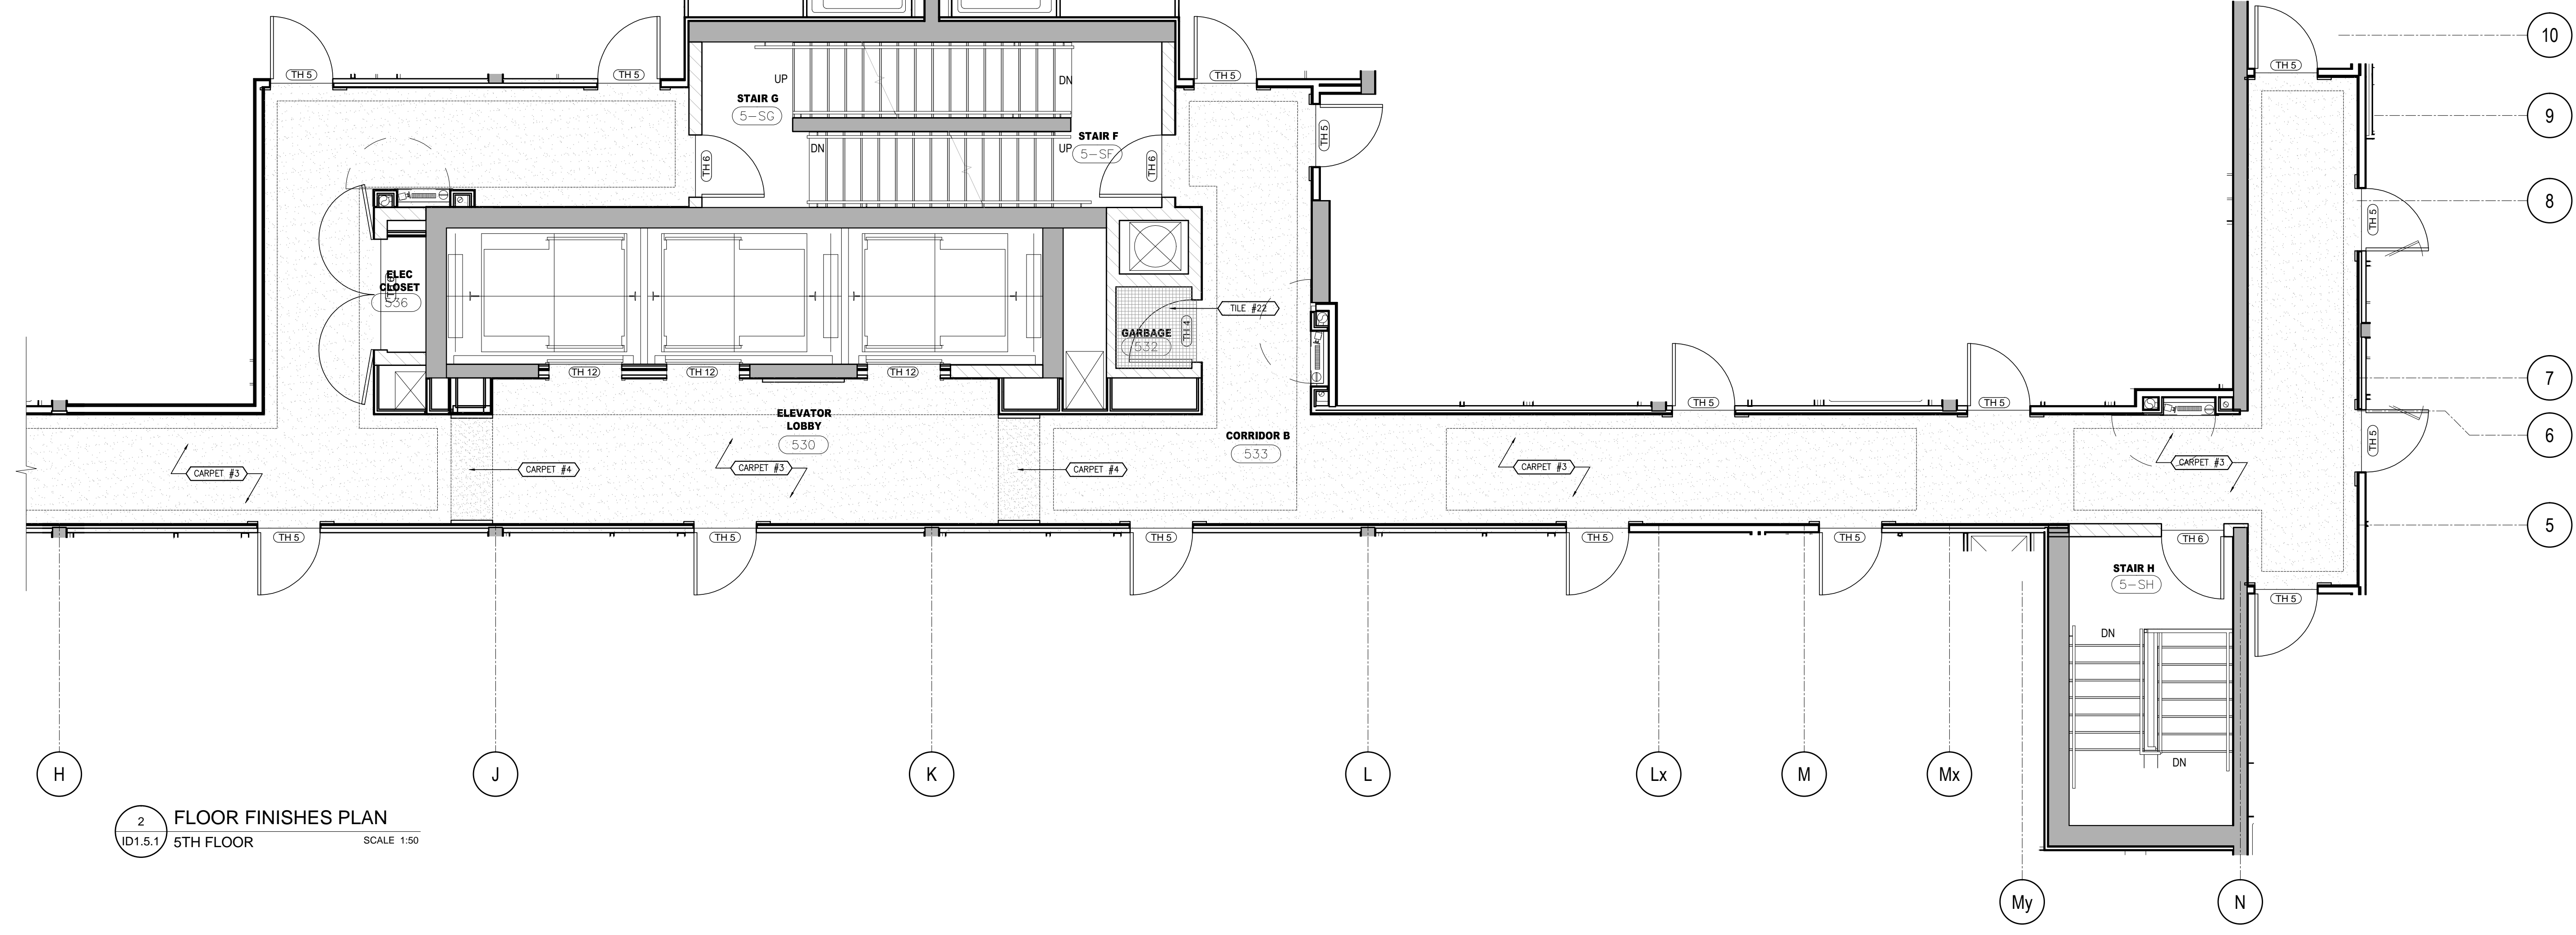

2 FLOOR FINISHES PLAN  
5TH FLOOR SCALE 1:50

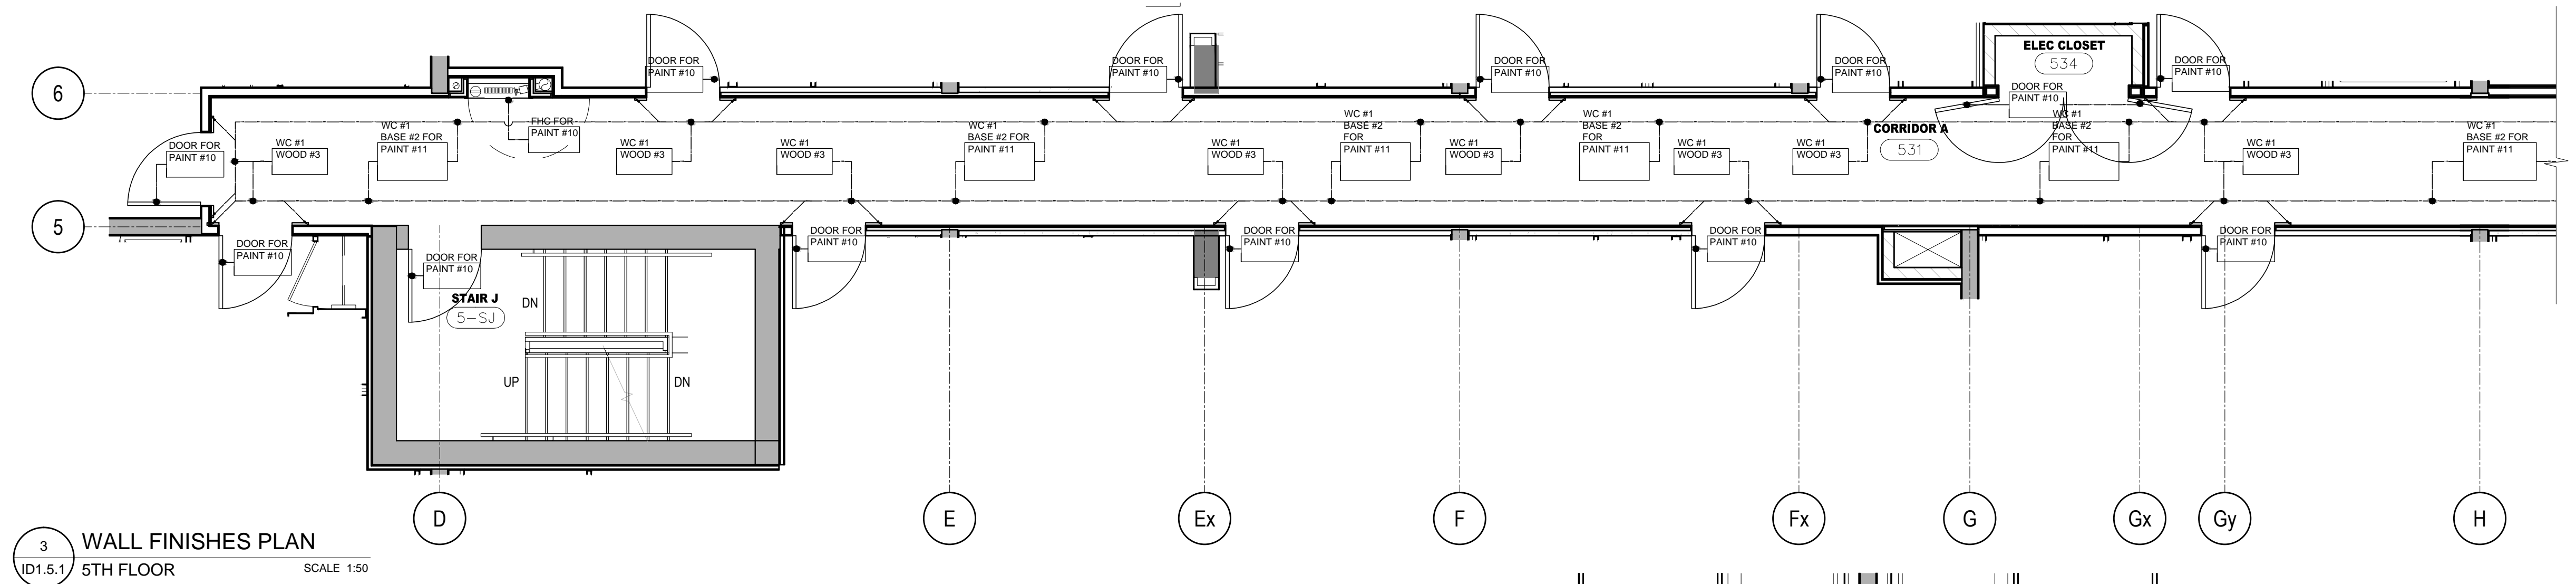

3 WALL FINISHES PLAN  
5TH FLOOR SCALE 1:50

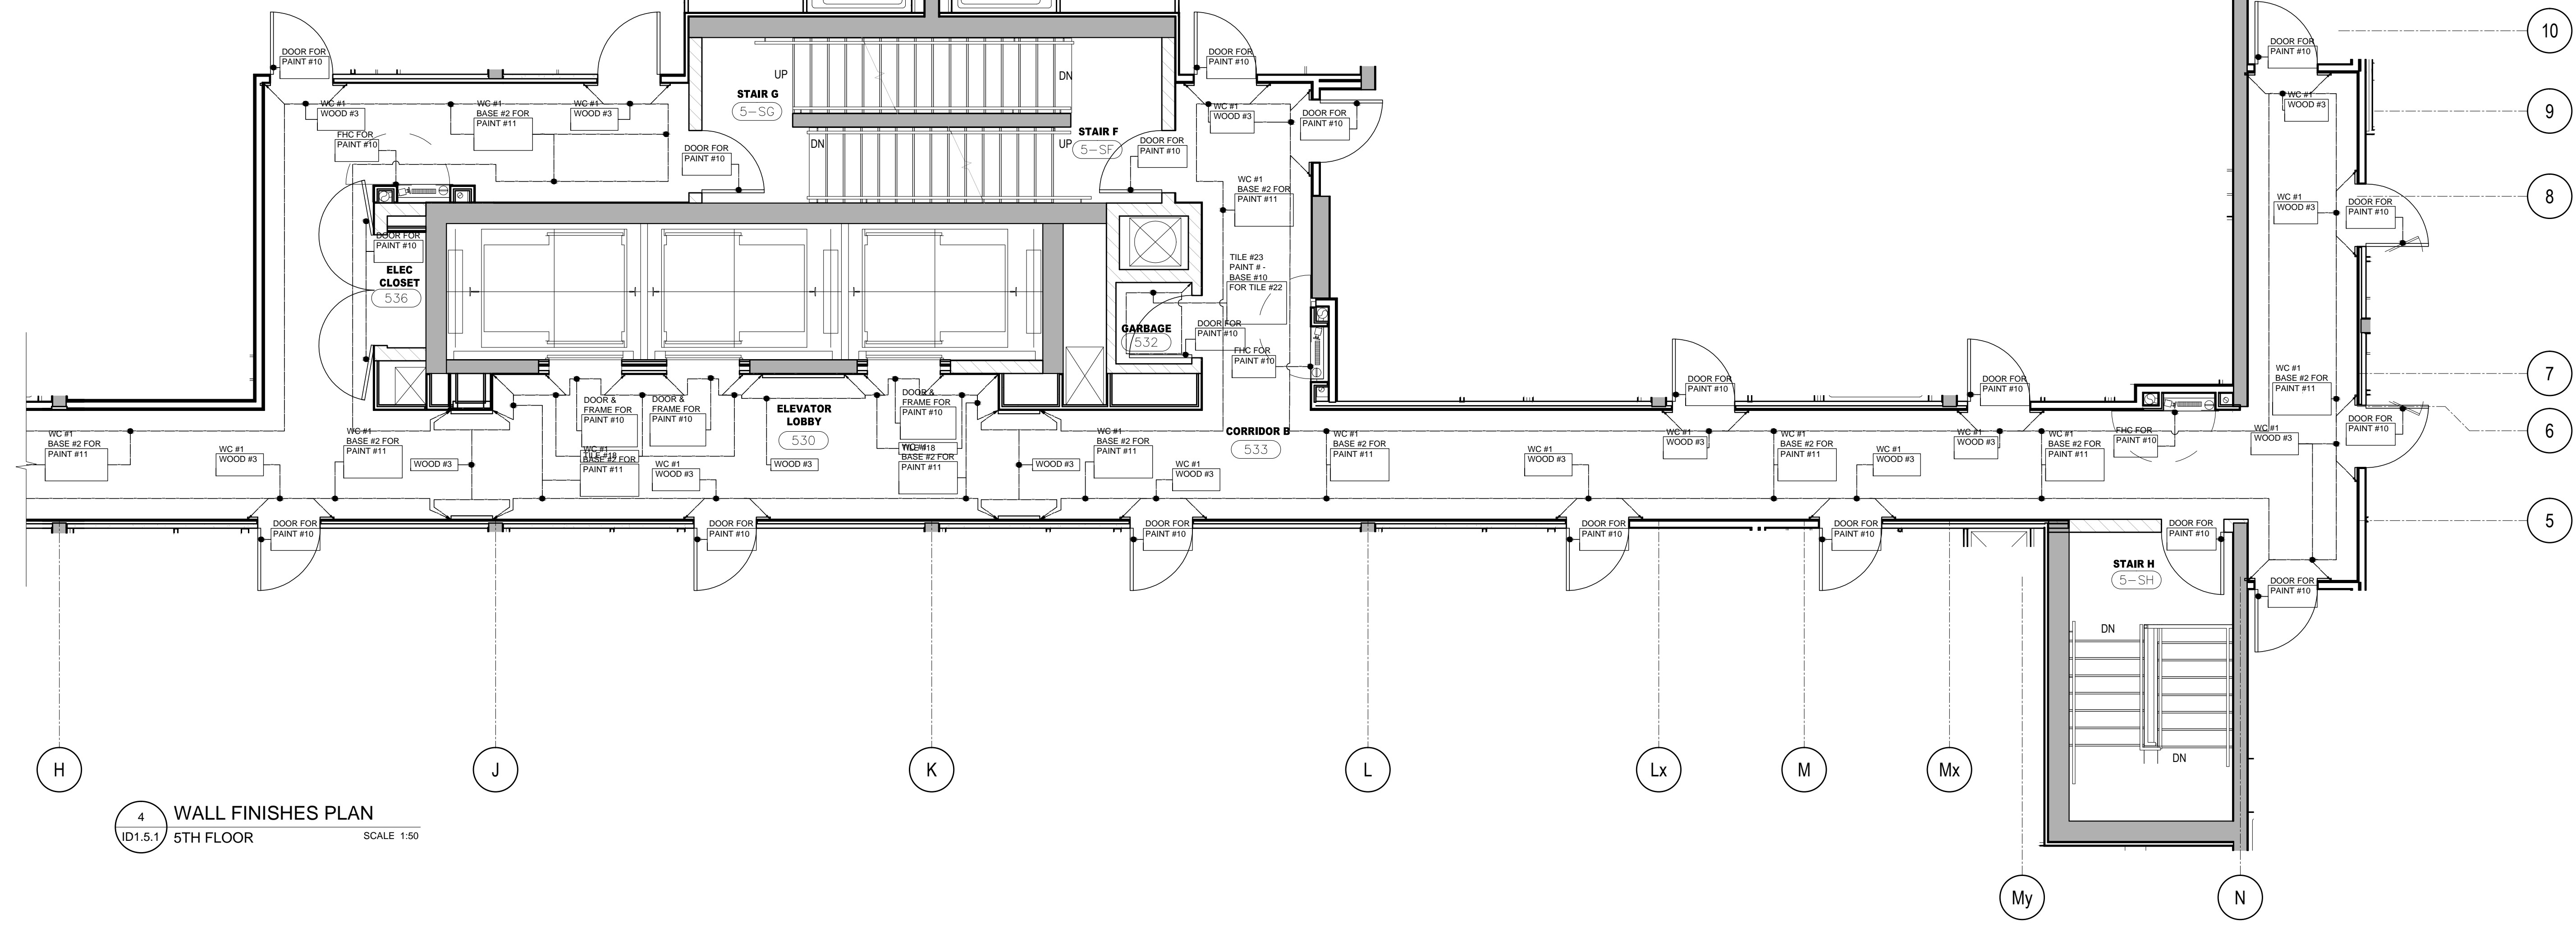

4 WALL FINISHES PLAN  
5TH FLOOR SCALE 1:50

**DO NOT SCALE DRAWINGS.**  
CONTRACTOR MUST VERIFY ALL DRAWINGS, DIMENSIONS, DETAILS AND SPECIFICATIONS, AND REPORT ANY DISCREPANCIES TO UNICOR 31 INC. BEFORE PROCEEDING WITH WORK. MATERIALS MAY NOT BE SUBSTITUTED WITHOUT WRITTEN APPROVAL FROM UNICOR 31 INC.  
ALL DRAWINGS AND SPECIFICATIONS ARE INSTRUMENTS OF SERVICE AND THE PROPERTY OF UNICOR 31 INC. WHICH MUST BE RETURNED AT THE COMPLETION OF THE WORK.

PRINTED: 30-May-17

ISSUED FOR AS-BUILT

NO.	DATE	COMMENTS	INI
01	31 MAY / 17	ISSUED FOR AS-BUILT	SV
REVISIONS:			

UNICOR31

**UNICOR 31 INC.**  
183 BATHURST STREET, STE. 201  
TORONTO, ON, M5T 2R7, CANADA  
TEL: 416-597-1576 FAX: 416-597-2139

PROJECT NAME: <b>ALEXANDRA PARK MAIN BUILDING</b>	
BLOCK 11 ON, Canada	
PROJECT NO.: 13-949	DRAWINGS:
<b>5TH FLOOR FLOOR FINISHES PLAN &amp; WALL FINISHES PLAN</b>	
DATE STARTED: 07 AUG / 13	DRAWING NO.: <b>ID</b>
SCALE: 1:50	DRAWN BY: AP
APPROVED BY: KC	SCALE: <b>1.5.1</b>