


DO NOT SCALE DRAWINGS.


CONTRACTOR MUST VERIFY ALL DRAWINGS, DIMENSIONS, DETAILS AND SPECIFICATIONS, AND REPORT ANY DISCREPANCIES TO UNION 31 INC. BEFORE PROCEEDING WITH WORK. MATERIALS MAY NOT BE SUBSTITUTED WITHOUT WRITTEN APPROVAL FROM UNION 31 INC.
ALL DRAWINGS AND SPECIFICATIONS ARE INSTRUMENTS OF SERVICE AND THE PROPERTY OF UNION 31 INC. WHICH MUST BE RETURNED AT THE COMPLETION OF THE WORK.

PRINTED: 30-May-17


NOTE:
INSTALL ALL BARRIER FREE WASHROOM COMPONENTS ACCORDING TO OBC REQUIREMENTS

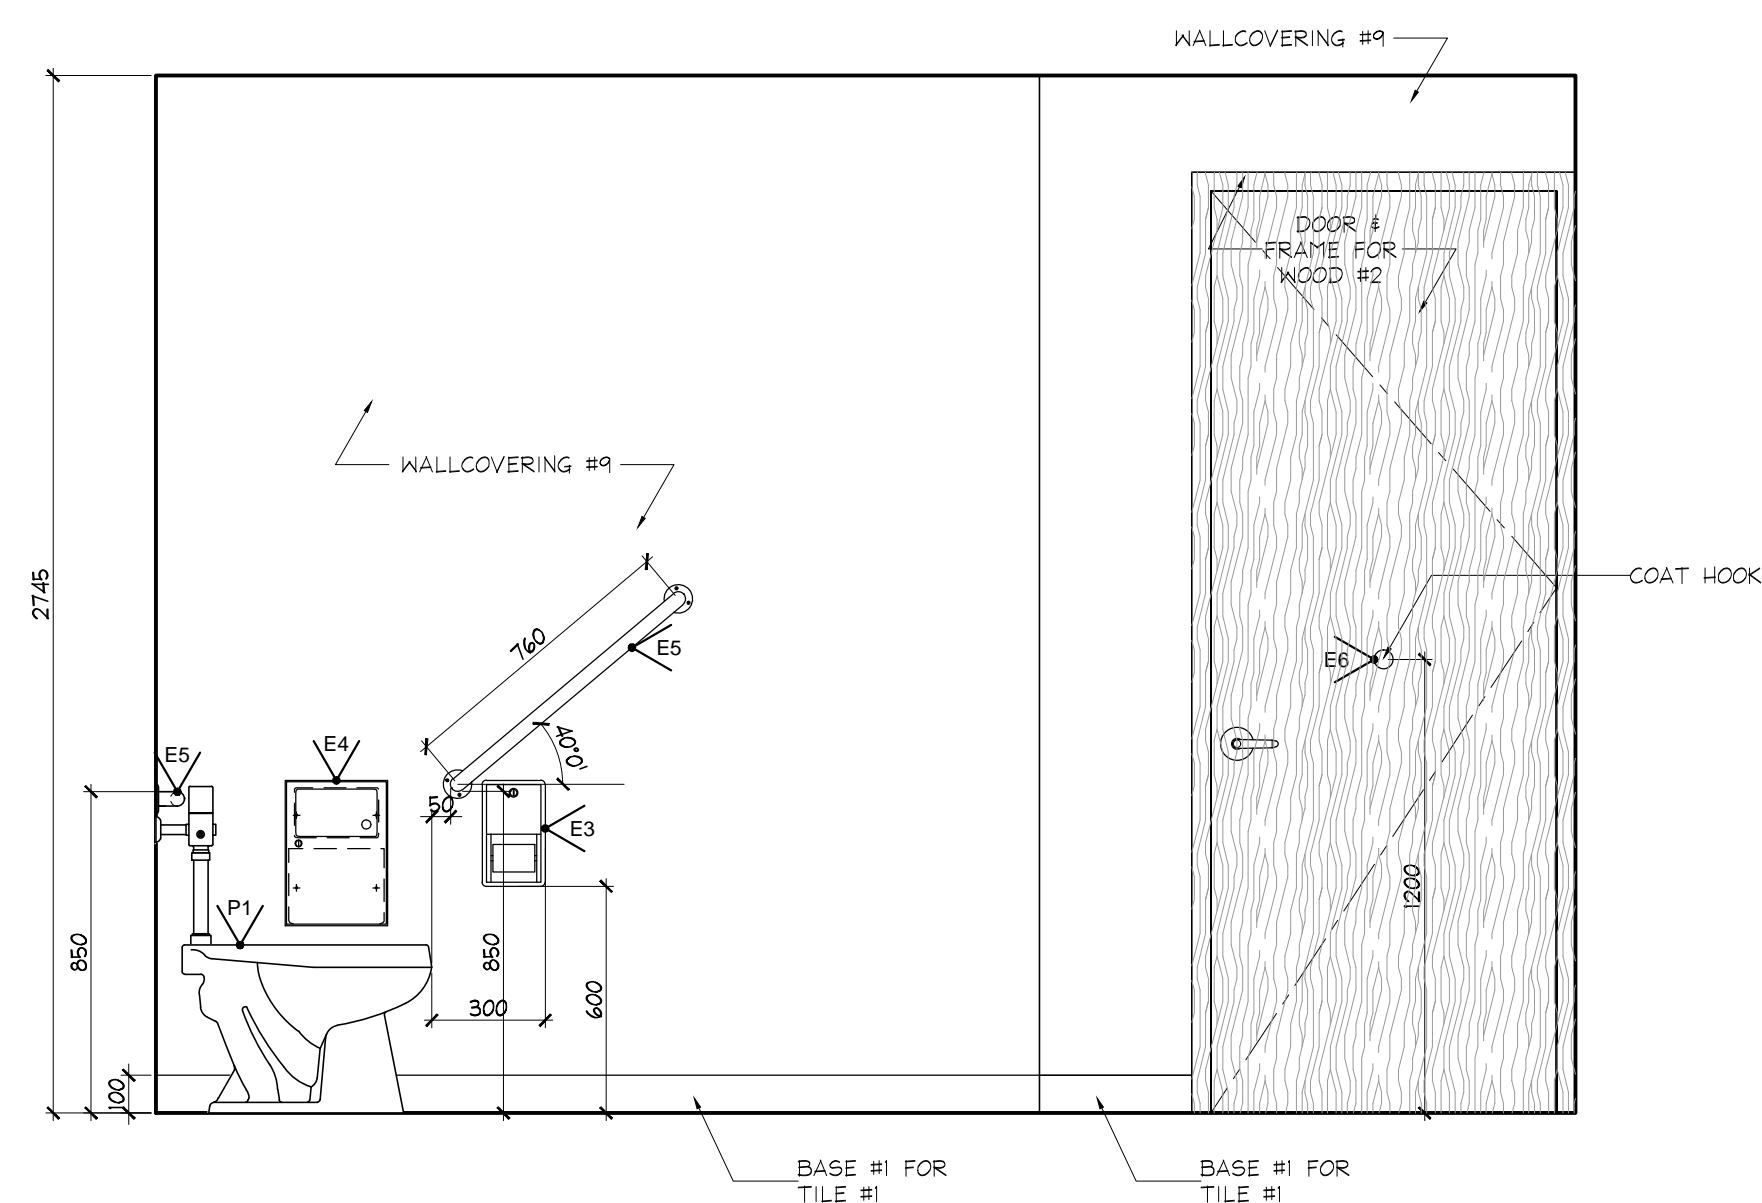


1 ELEVATION
02.1.10 GROUND FLOOR
B.F. WASHROOM SCALE 1:20

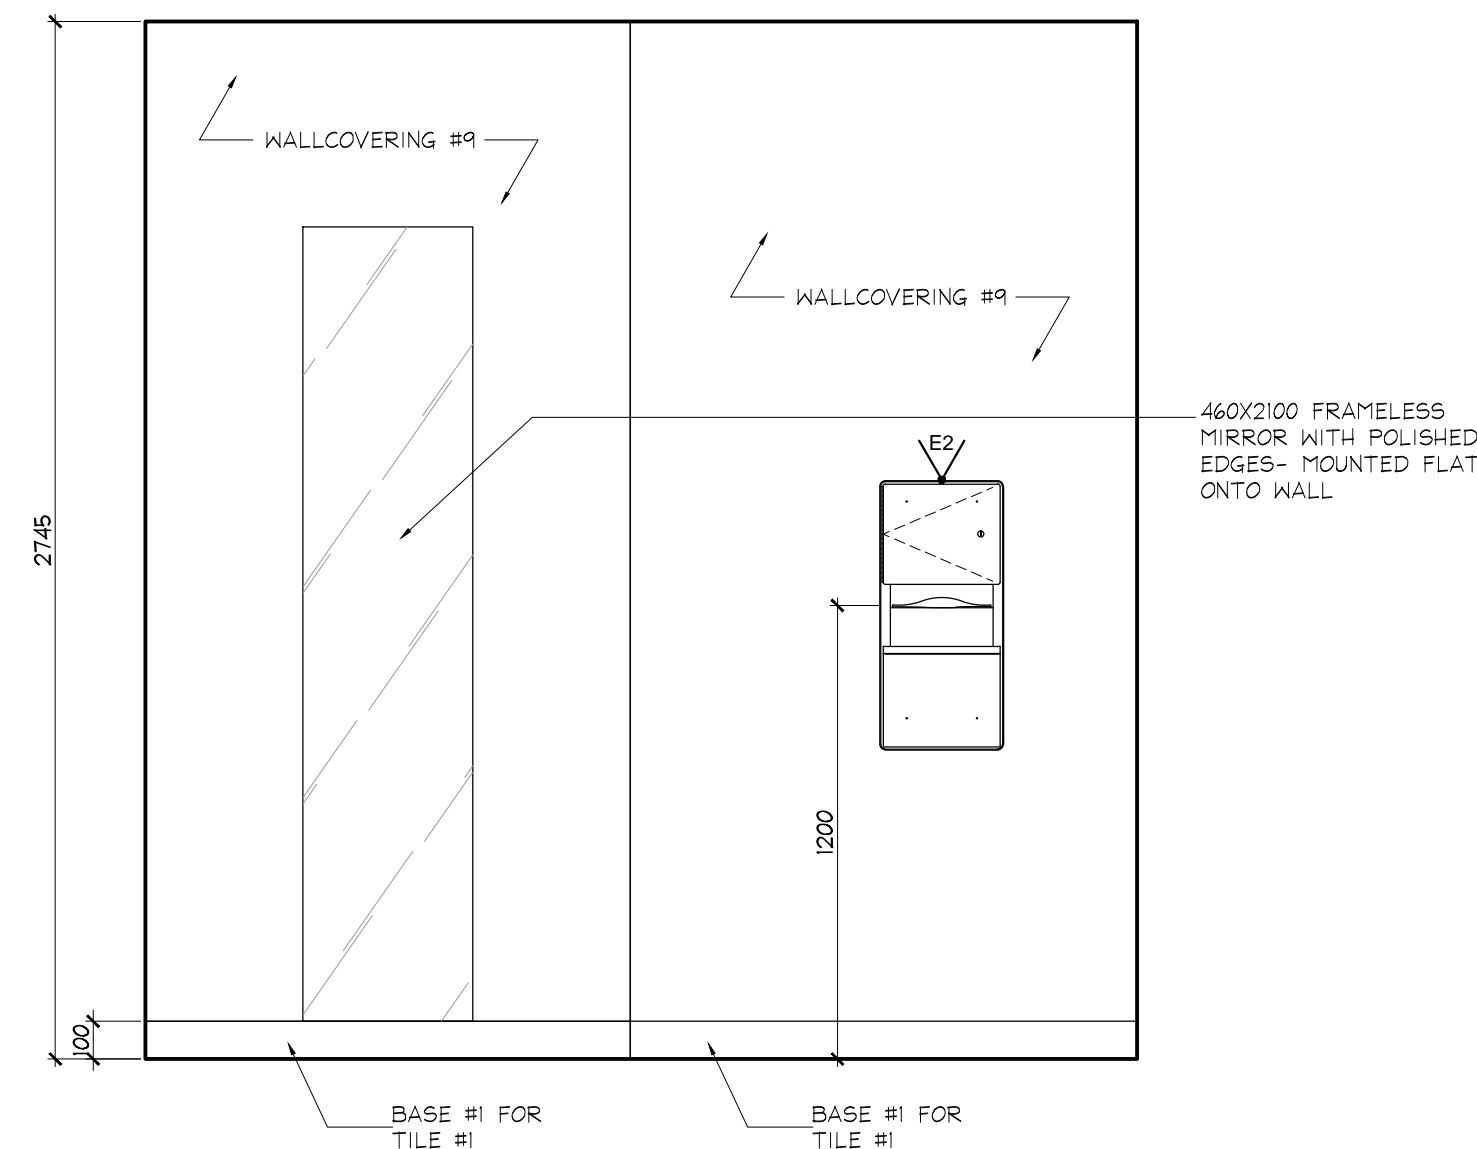


2 ELEVATION
02.1.10 GROUND FLOOR
B.F. WASHROOM SCALE 1:20

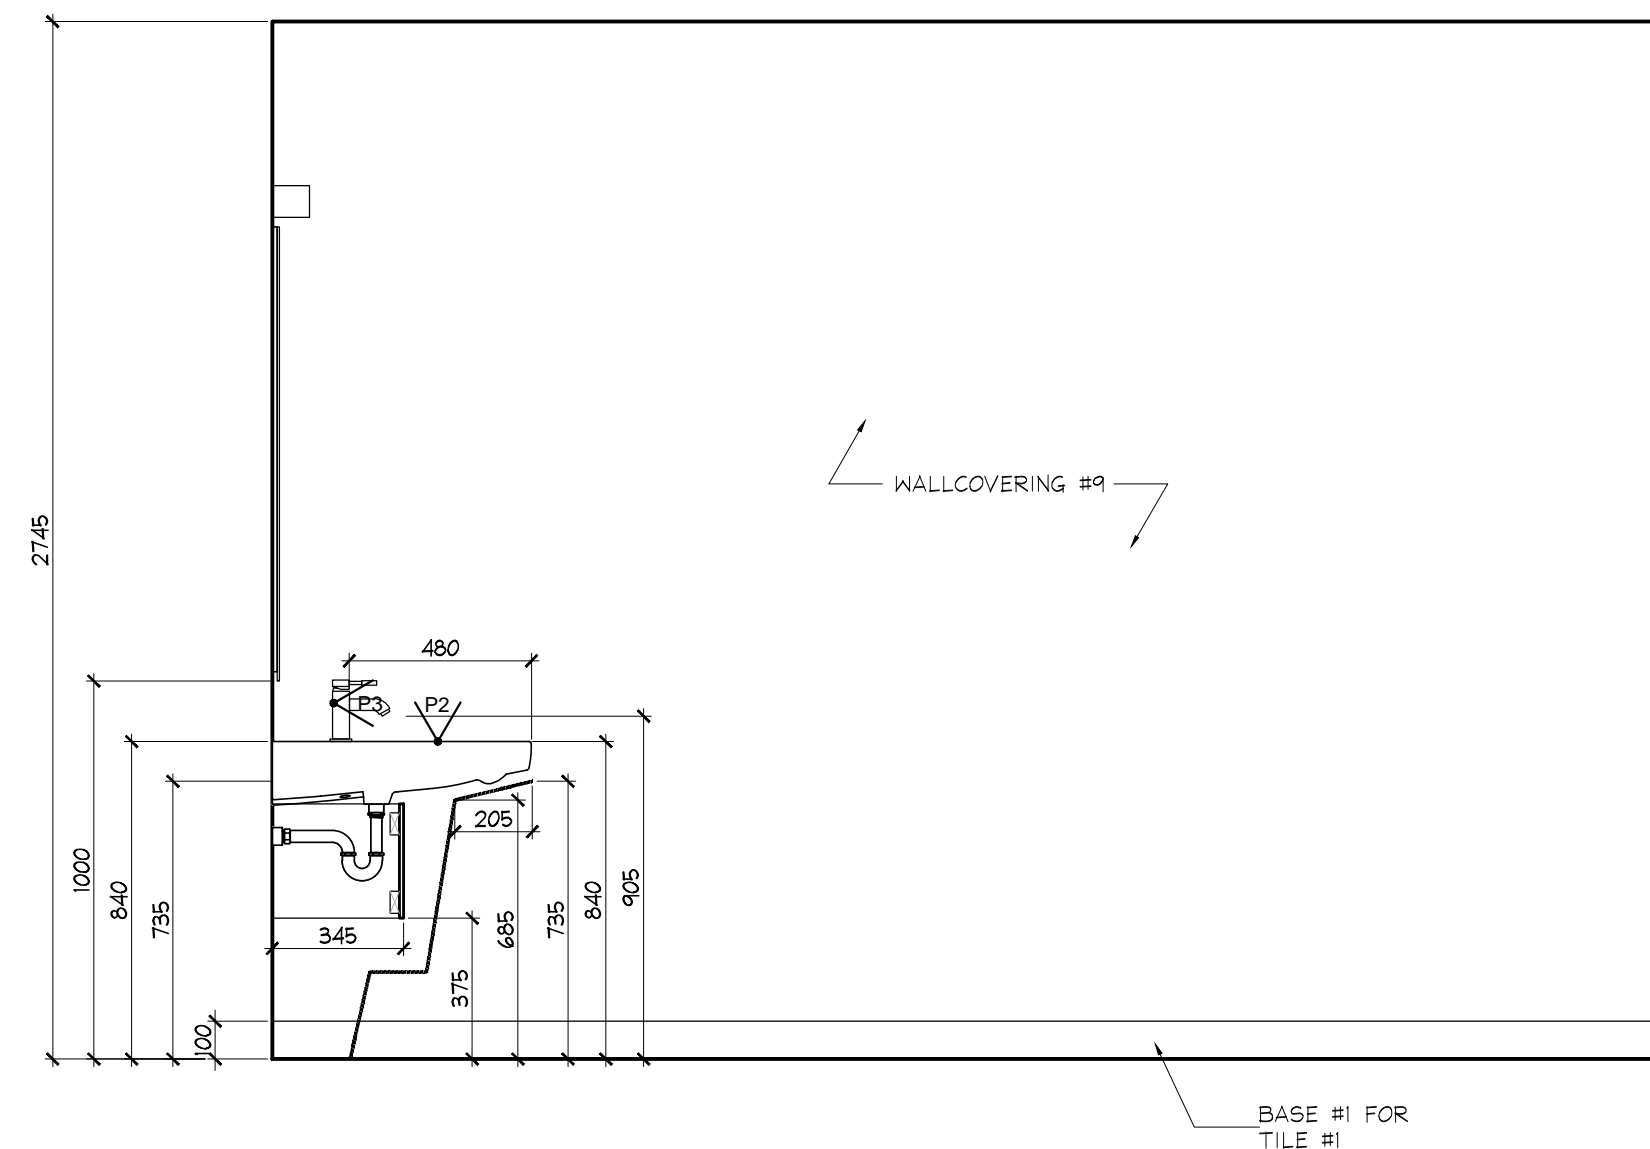


3 ELEVATION
02.1.10 GROUND FLOOR
B.F. WASHROOM SCALE 1:20

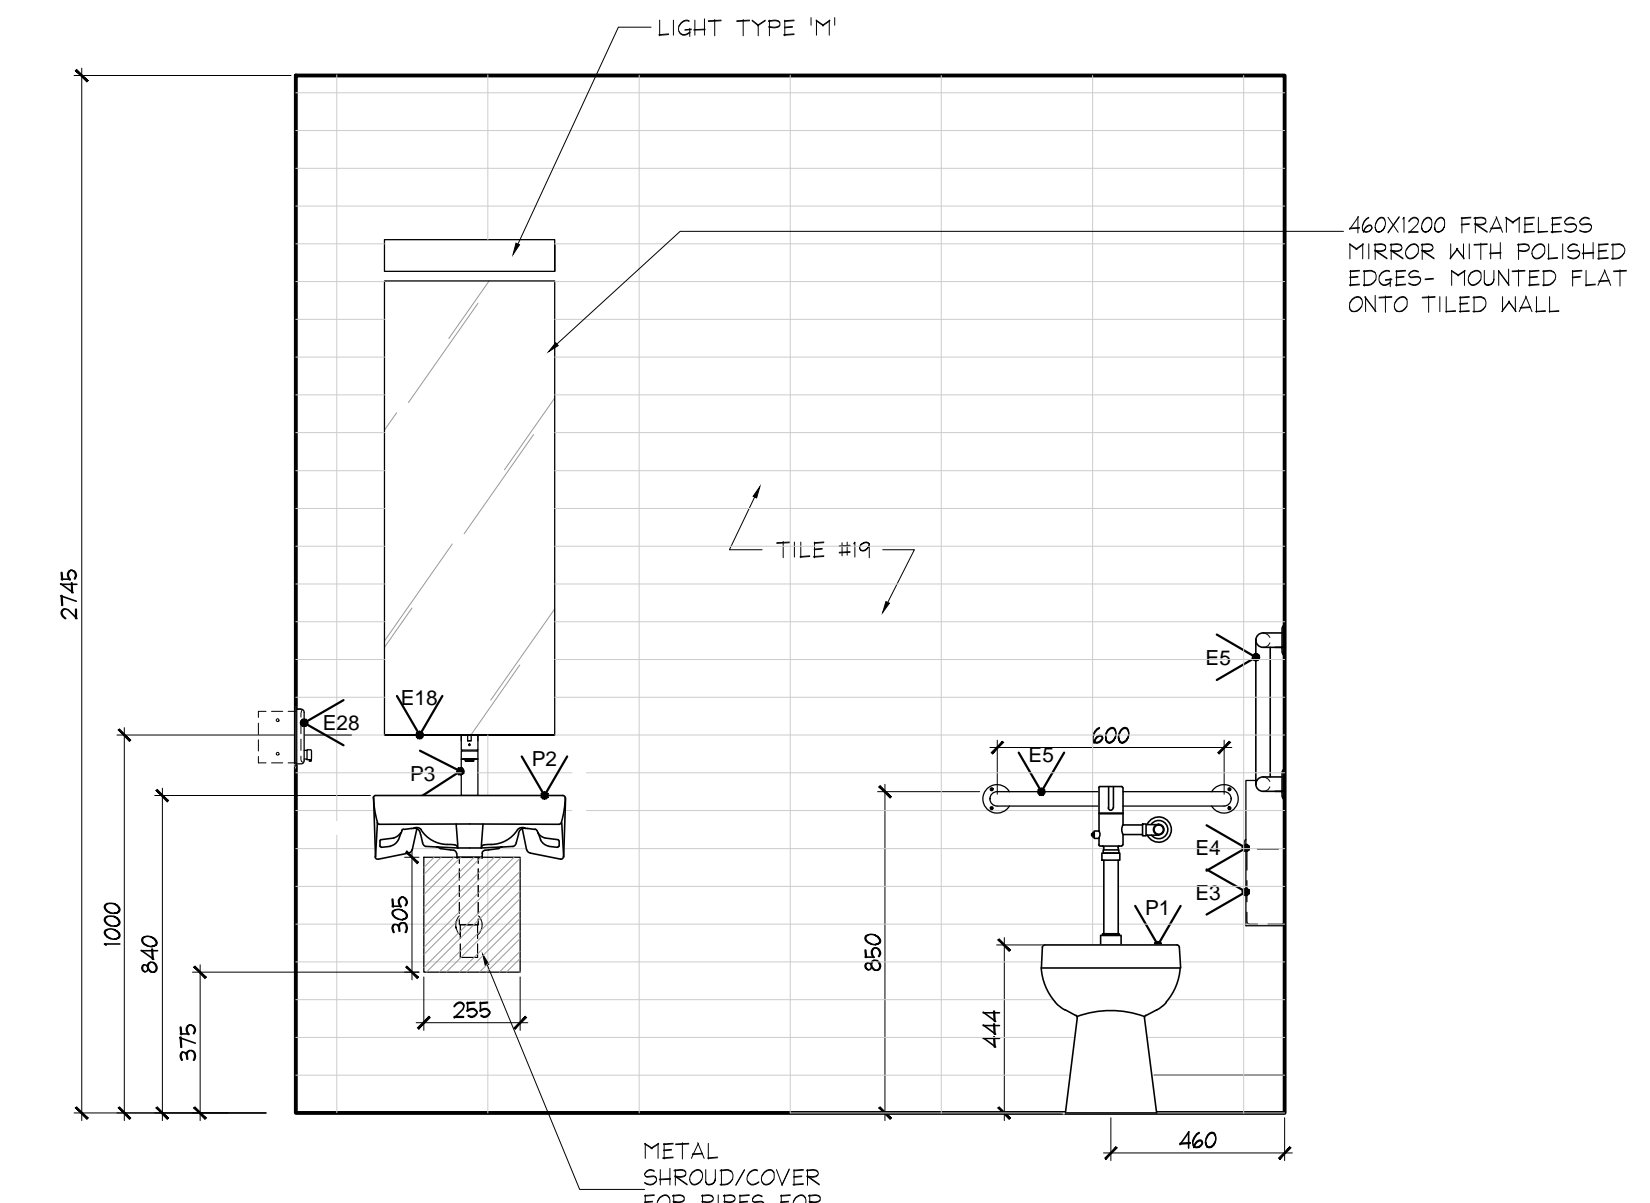


4 ELEVATION
02.1.10 GROUND FLOOR
B.F. WASHROOM SCALE 1:20

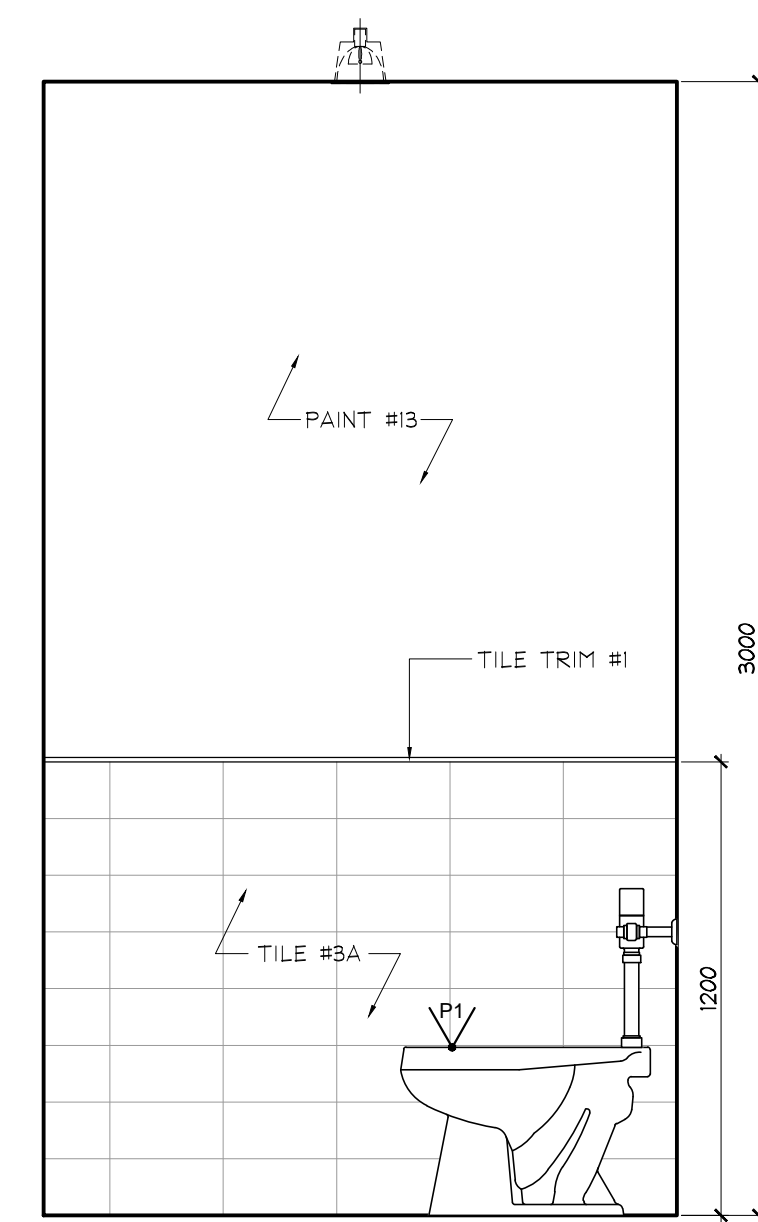


5 ELEVATION
02.1.10 GROUND FLOOR
WOMENS & MENS WASHROOM SCALE 1:20

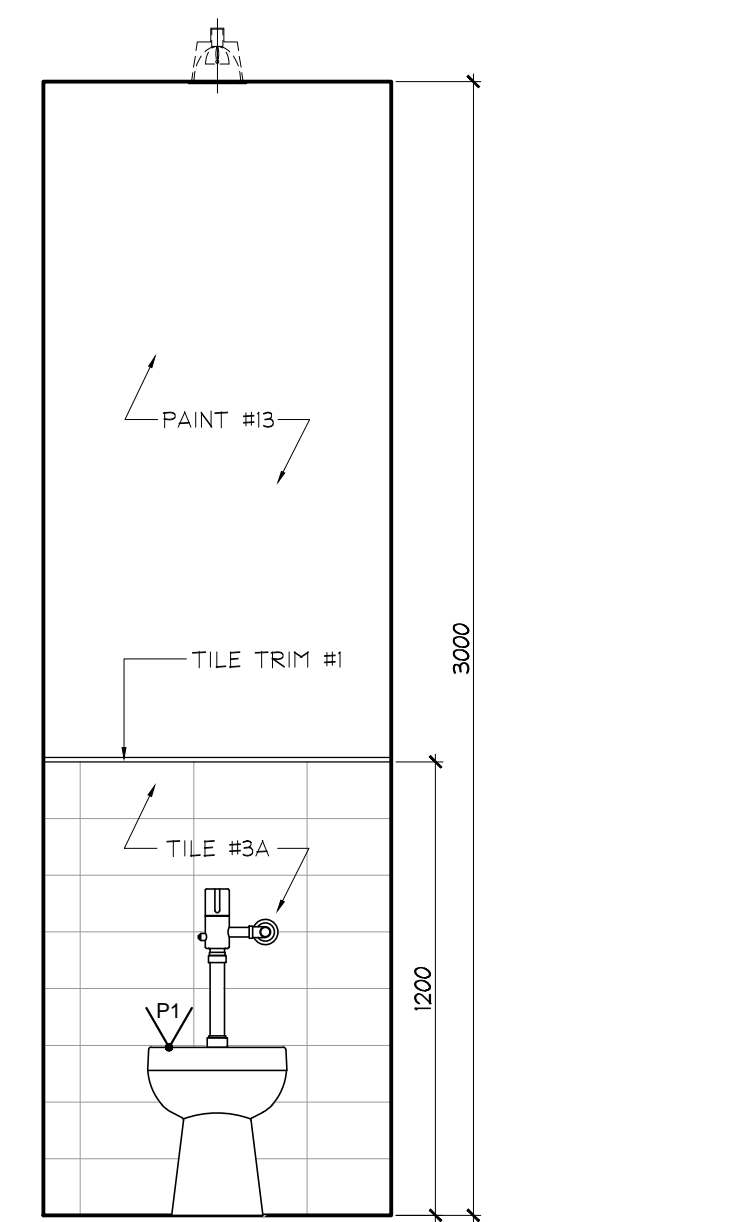

6 ELEVATION
02.1.10 GROUND FLOOR
WOMENS / MENS WASHROOM SCALE 1:20

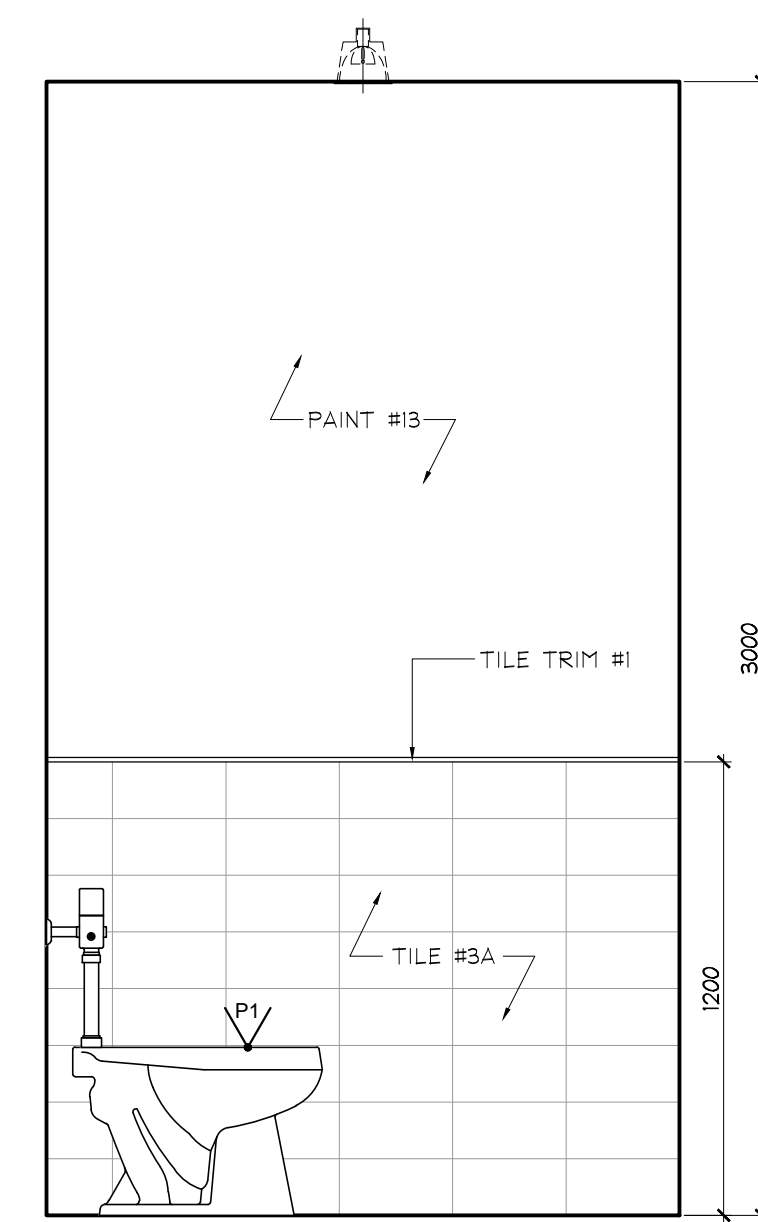

7 ELEVATION
02.1.10 GROUND FLOOR
WOMENS & MENS WASHROOM SCALE 1:20

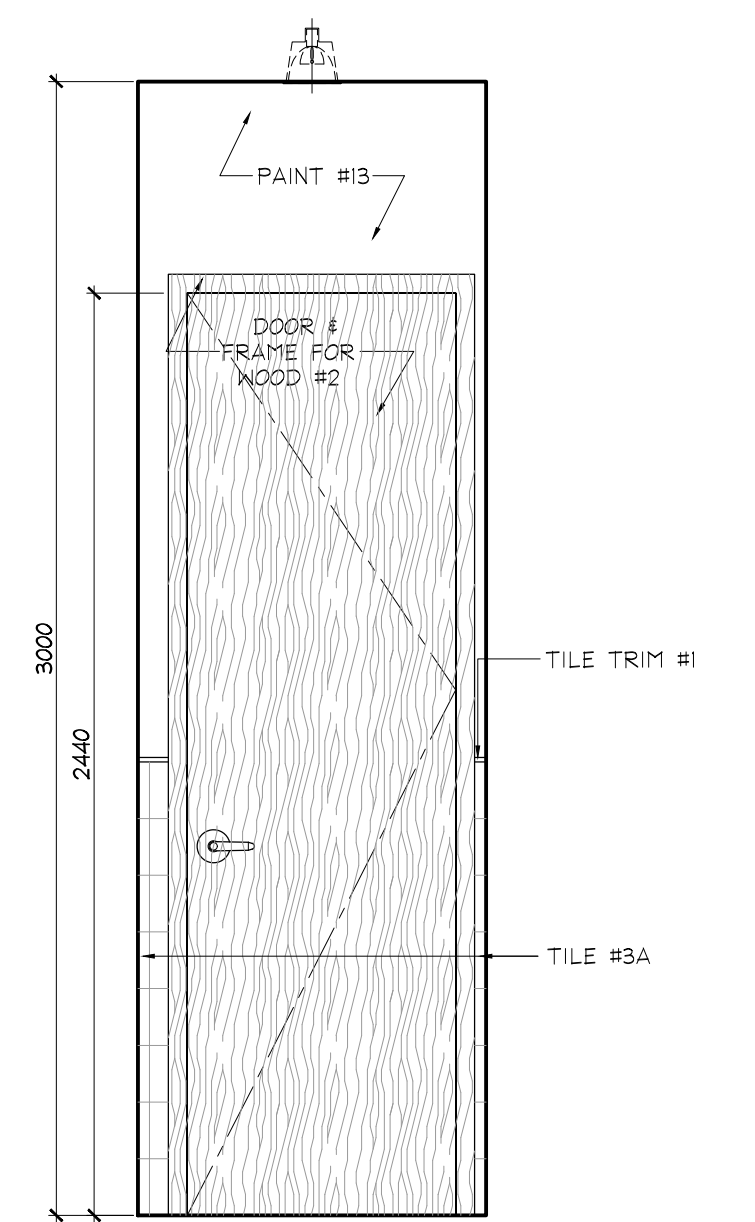

8 ELEVATION
02.1.10 GROUND FLOOR
WOMENS & MENS WASHROOM SCALE 1:20

ISSUED FOR
AS-BUILT

NO.	DATE	COMMENTS	INI
01	31 MAY / 17	ISSUED FOR AS-BUILT	SV
REVISIONS:			

UNION31

UNION31 INC.
183 BATHURST STREET, STE. 201
TORONTO, ON, M5T 2R7, CANADA
TEL: 416-597-1576 FAX: 416-597-2139

PROJECT NAME:
**ALEXANDRA PARK
MAIN BUILDING**
BLOCK 11
ON, Canada

PROJECT NO.:
13-949

DRAWINGS:
**GROUND FLOOR
ELEVATIONS**

DATE STARTED: 07 AUG / 13 DRAWING NO.:
SCALE: 1 : 20 ID
DRAWN BY: AP 2.1.10
APPROVED BY: KC