



DO NOT SCALE DRAWINGS.

CONTRACTOR MUST VERIFY ALL DRAWINGS, DIMENSIONS, DETAILS AND SPECIFICATIONS, AND REPORT ANY DISCREPANCIES TO UNION31 INC. BEFORE PROCEEDING WITH WORK. MATERIALS MAY NOT BE SUBSTITUTED WITHOUT WRITTEN APPROVAL FROM UNION31 INC. ALL DRAWINGS AND SPECIFICATIONS ARE INSTRUMENTS OF SERVICE AND THE PROPERTY OF UNION31 INC. WHICH MUST BE RETURNED AT THE COMPLETION OF THE WORK.


PRINTED: 30-May-17

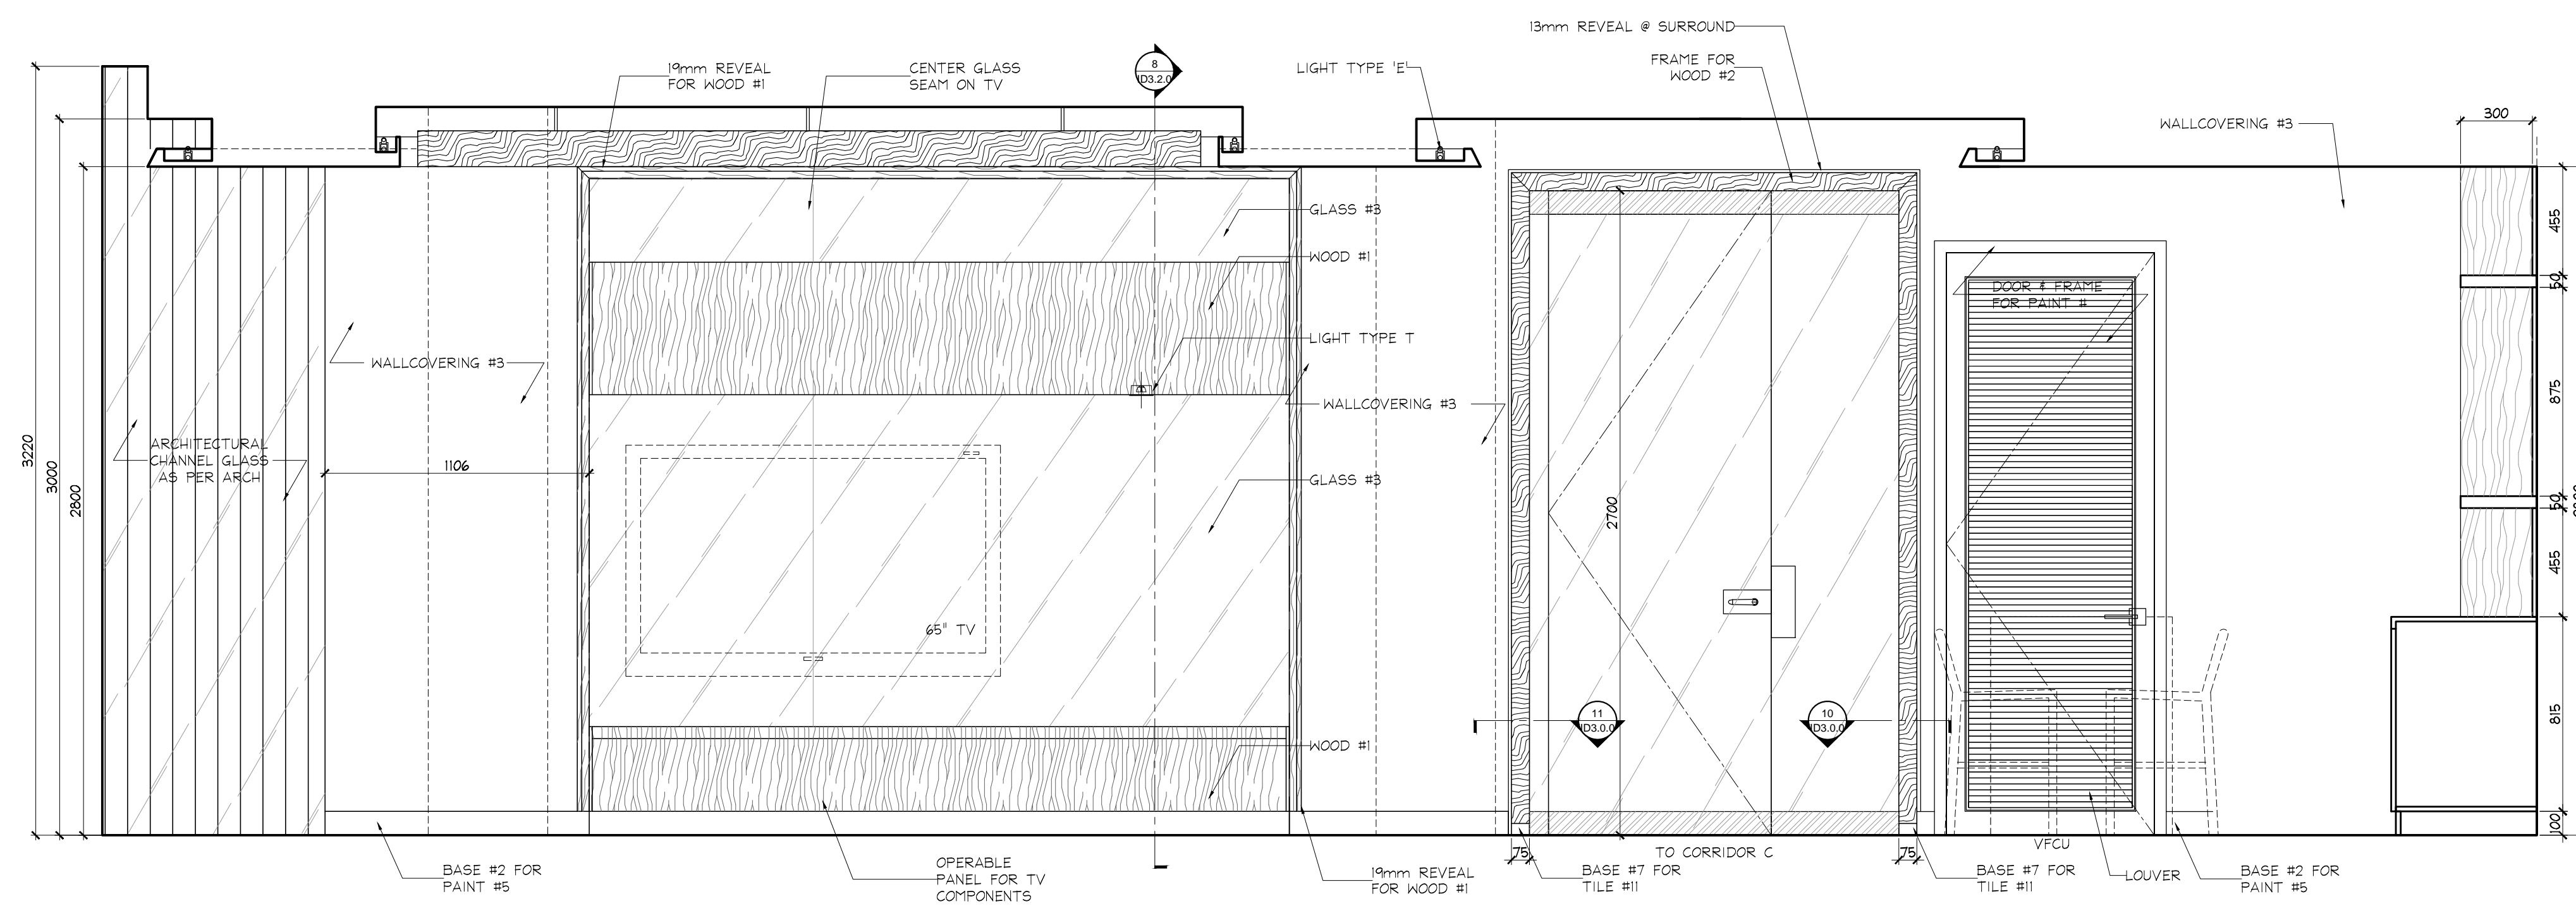


1 ELEVATION
ID2.1.3 GROUND FLOOR
AMENITY PARTY ROOM SCALE 1:20

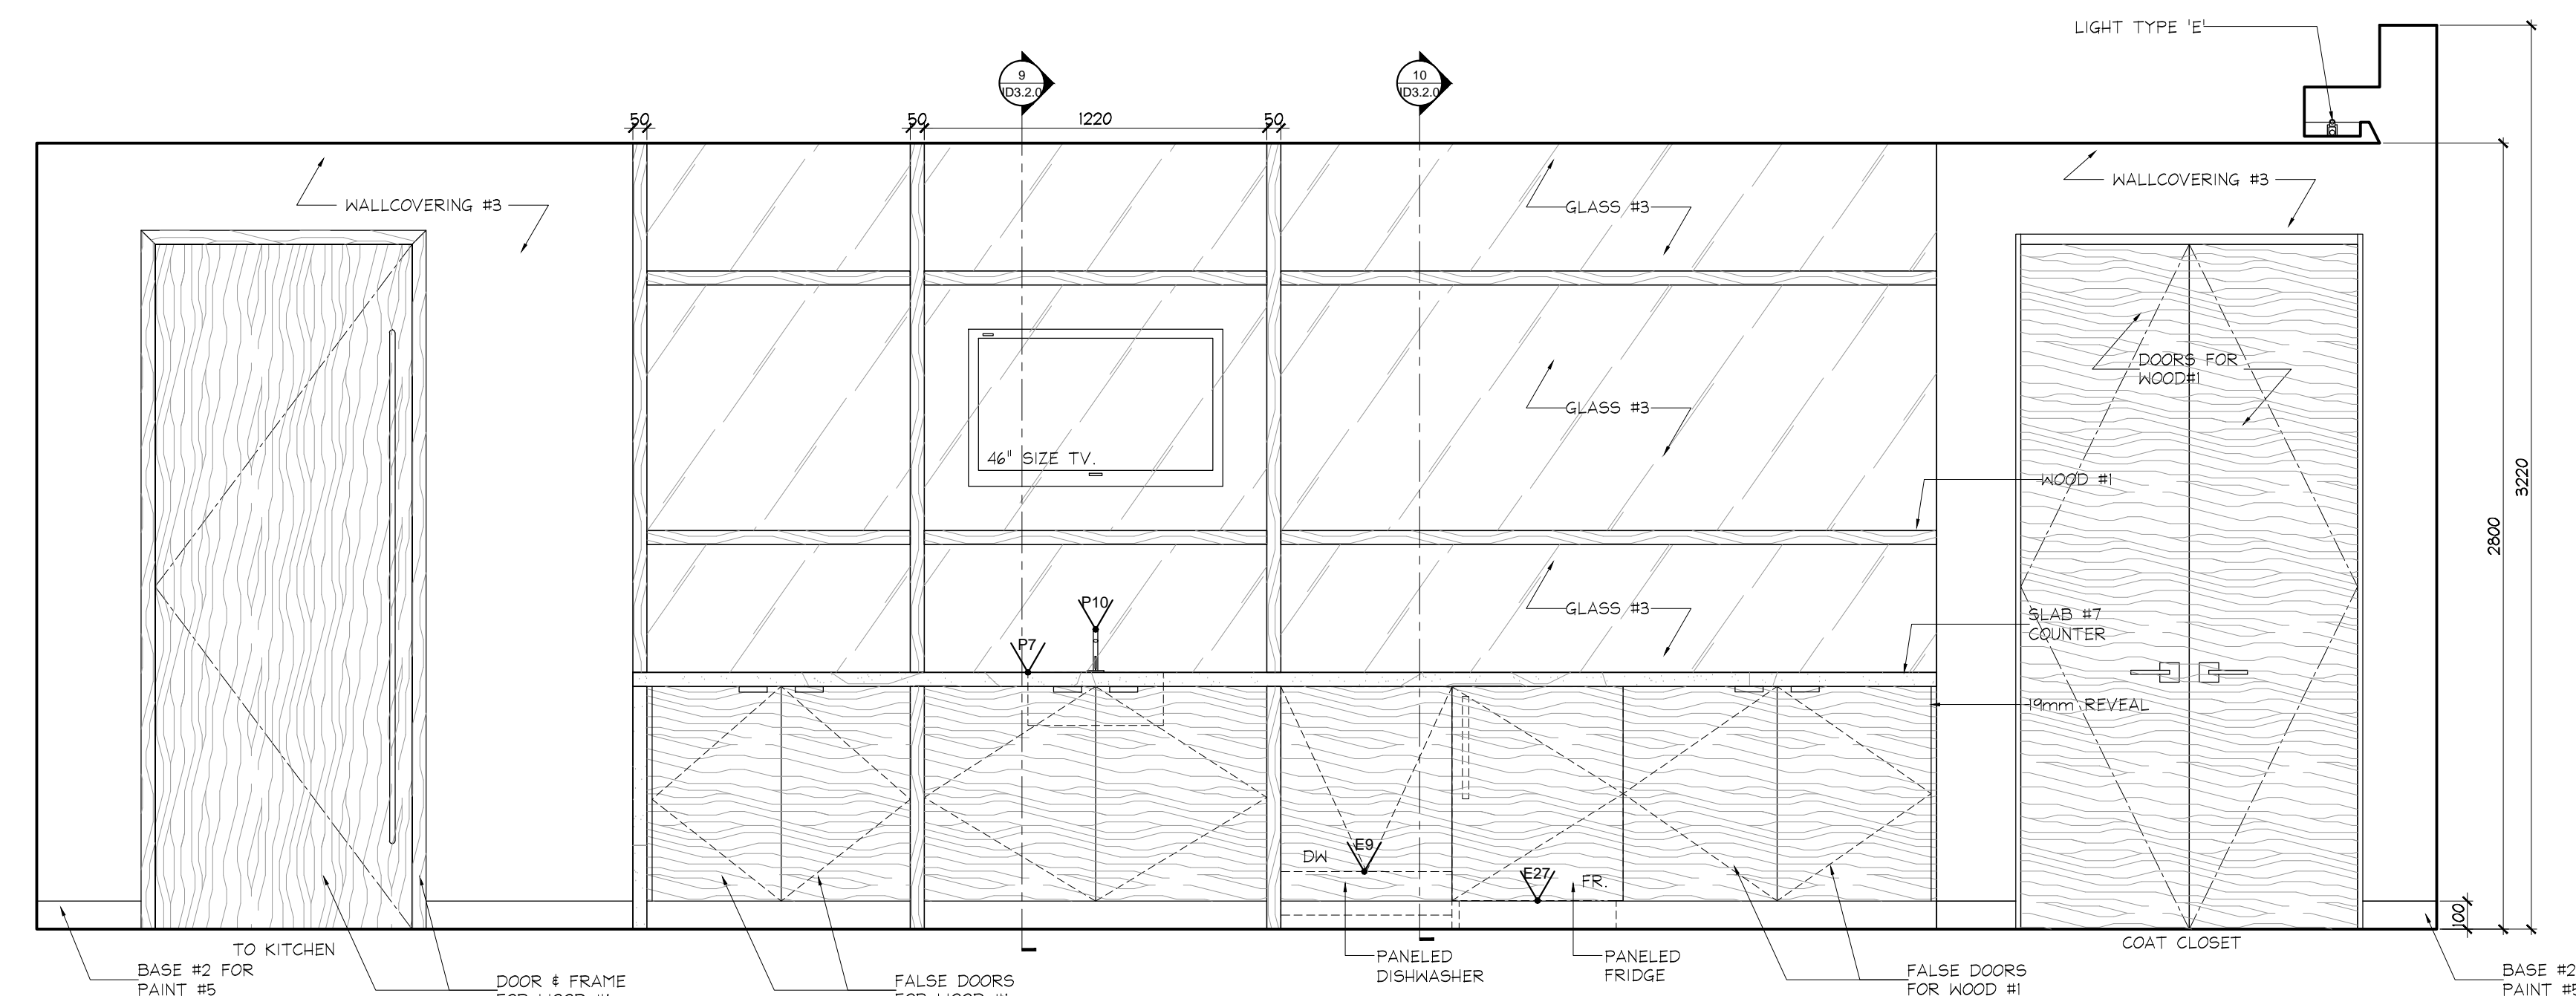

2 ELEVATION
ID2.1.3 GROUND FLOOR
AMENITY PARTY ROOM SCALE 1:20

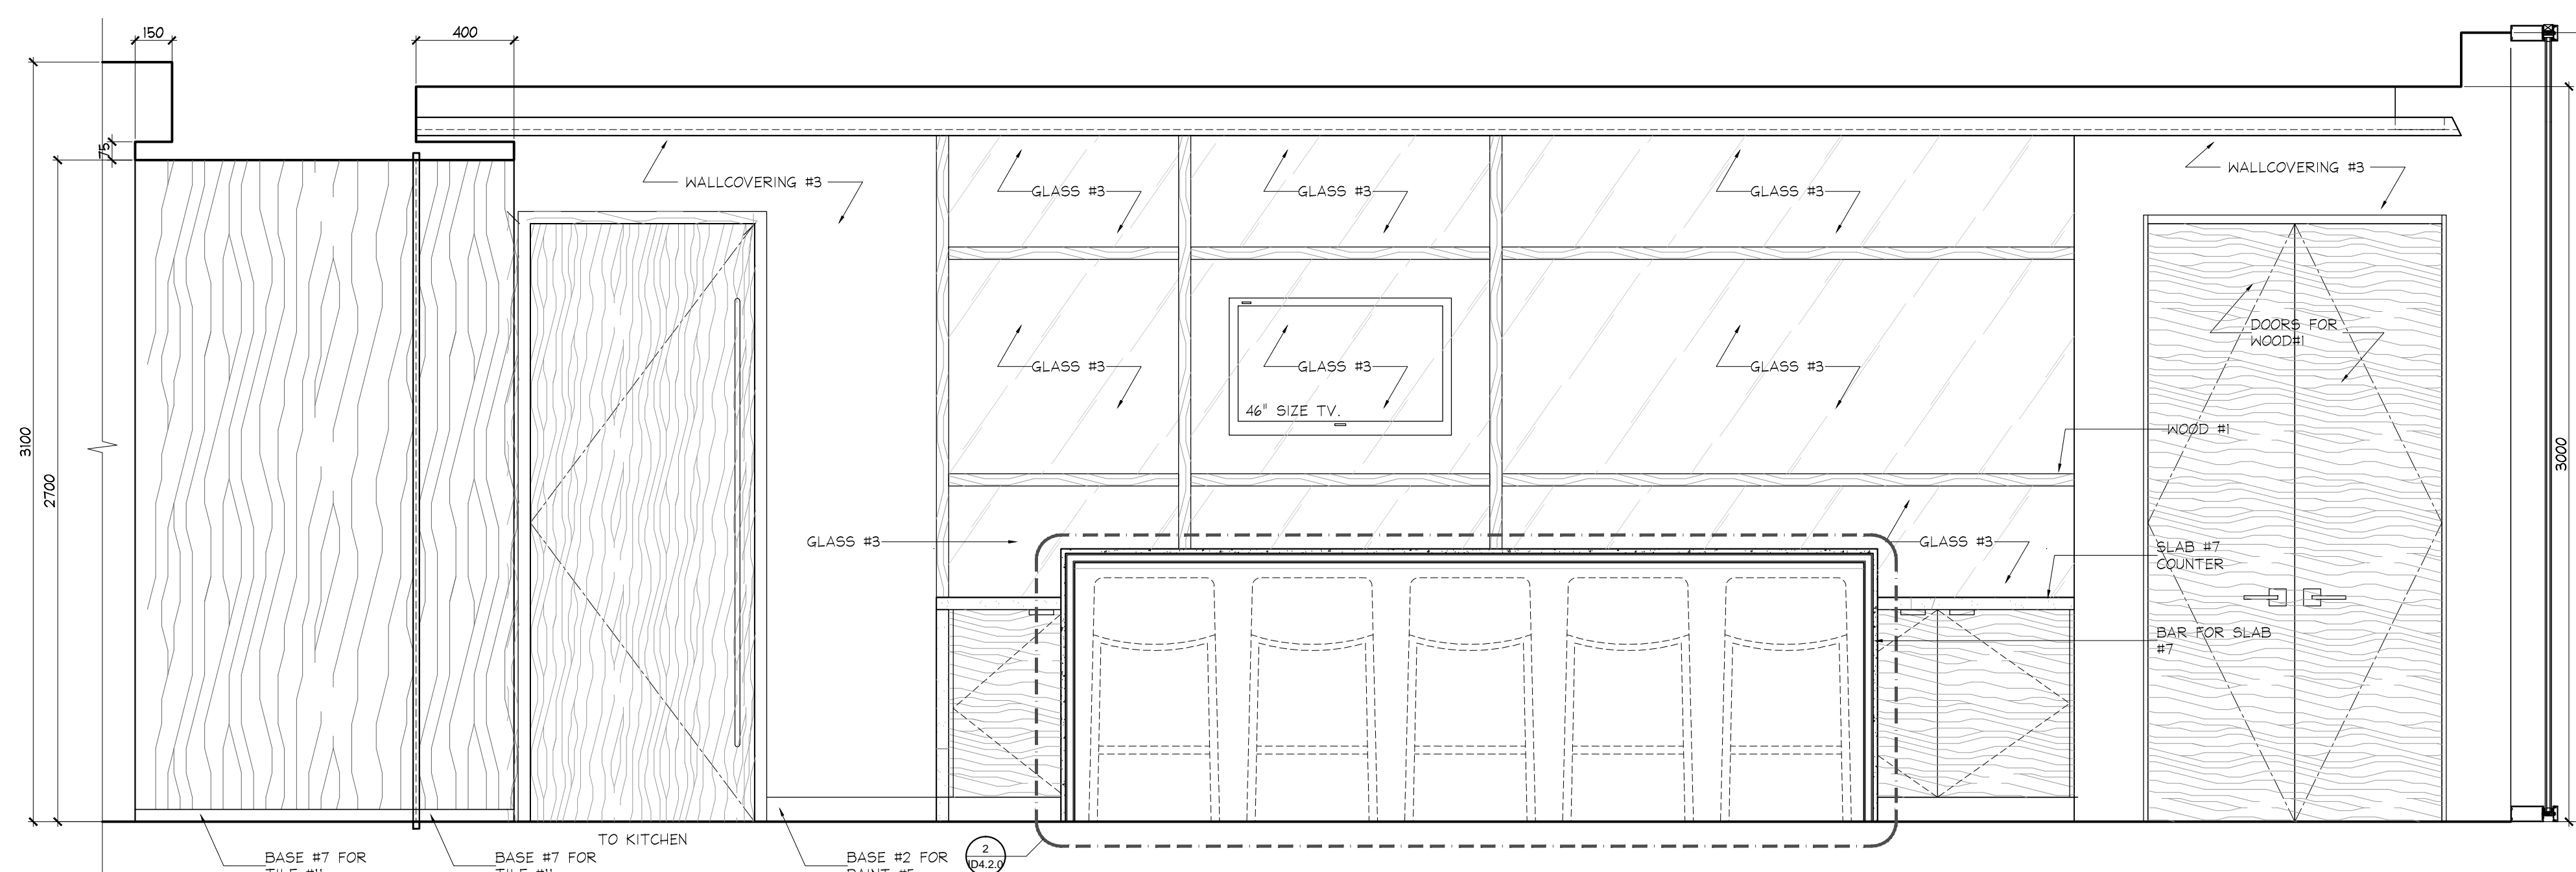

3 ELEVATION
ID2.1.3 GROUND FLOOR
AMENITY PARTY ROOM SCALE 1:20

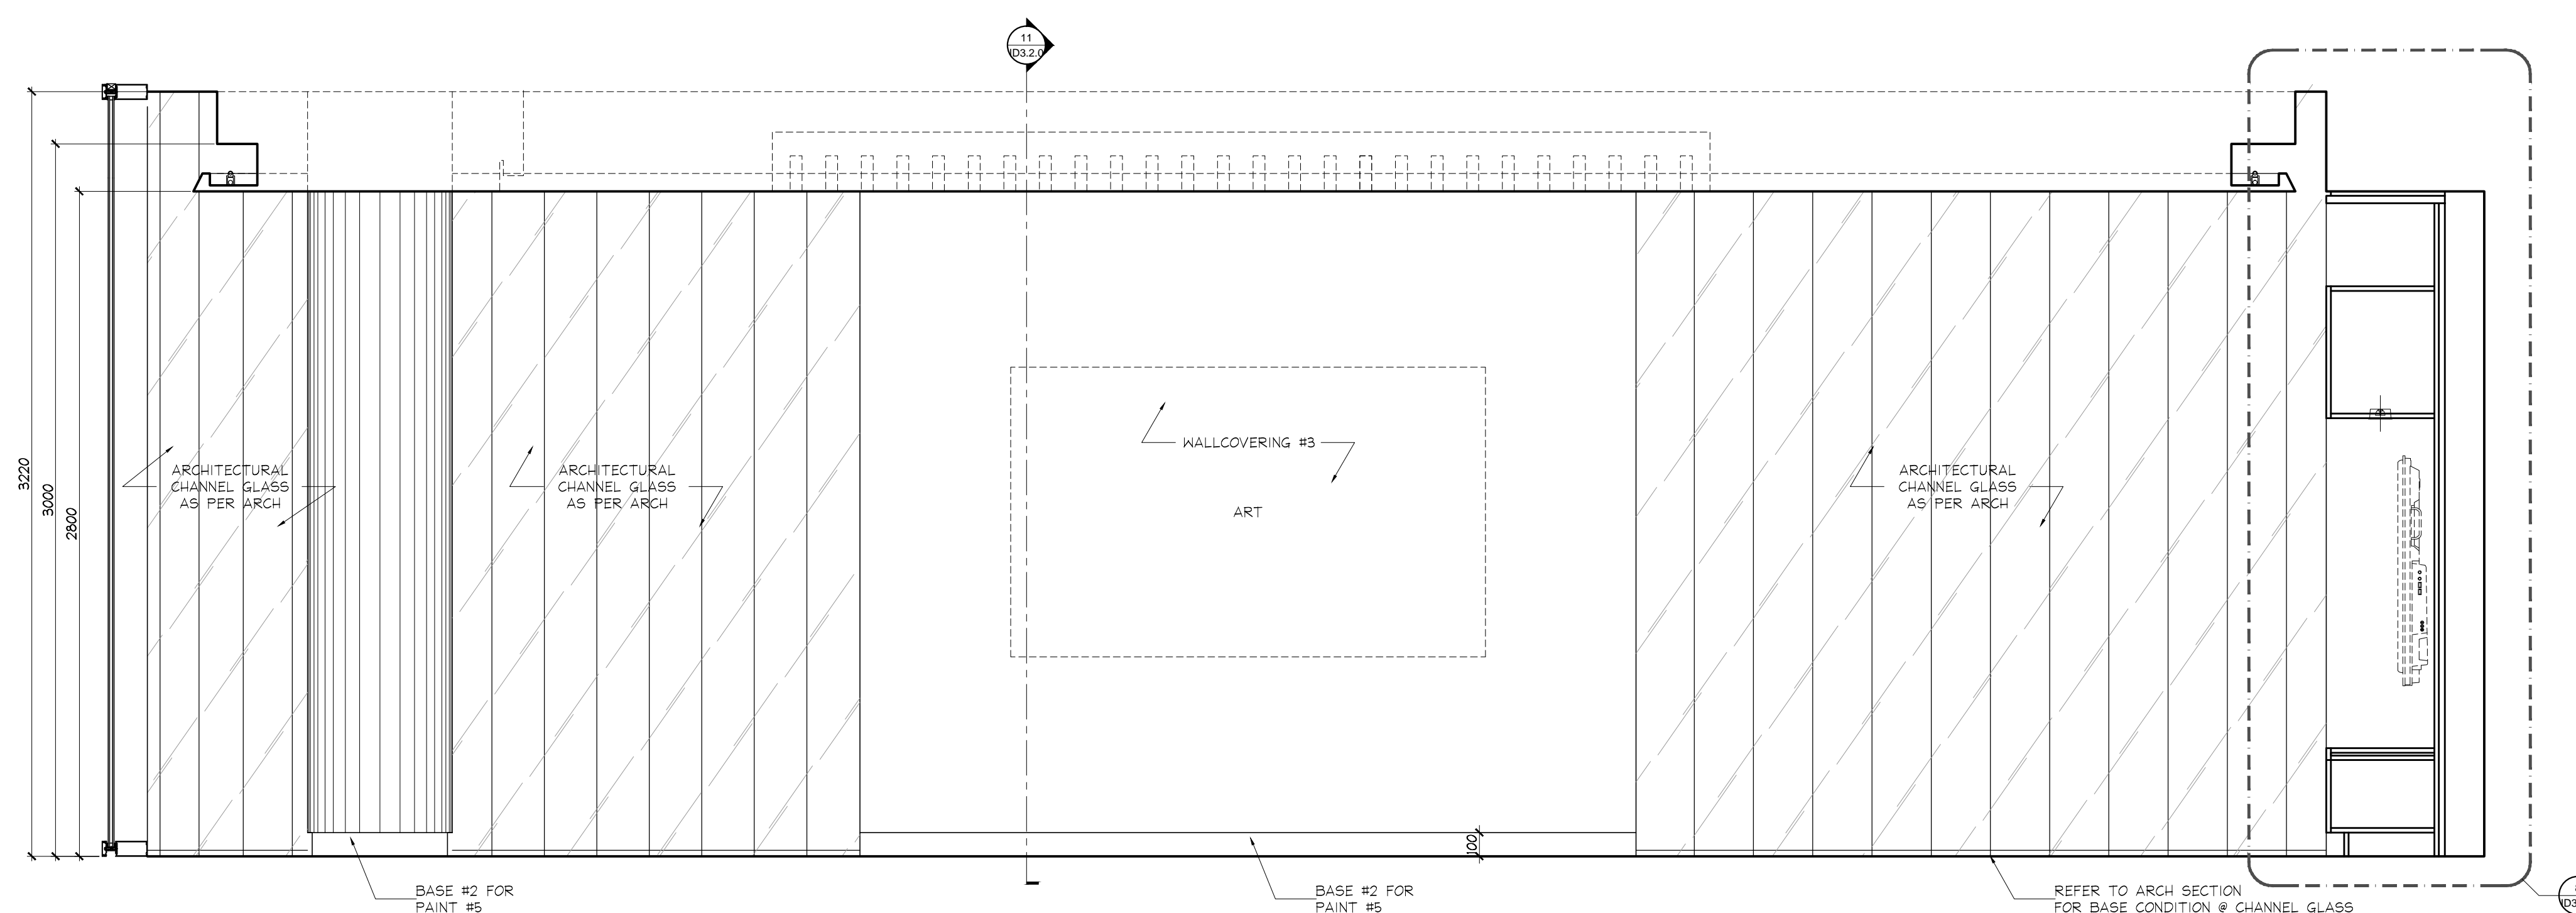

4 ELEVATION
ID2.1.3 GROUND FLOOR
AMENITY PARTY ROOM SCALE 1:20

ISSUED FOR
AS-BUILT

NO.	DATE	COMMENTS	INI
01	31 MAY / 17	ISSUED FOR AS-BUILT	SV

UNION31

UNION31 INC.
183 BATHURST STREET, STE. 201
TORONTO, ON, M5T 2R7, CANADA
TEL: 416-597-1576 FAX: 416-597-2139

PROJECT NAME:	ALEXANDRA PARK MAIN BUILDING
PROJECT NO.:	13-949
DRAWINGS:	GROUND FLOOR ELEVATIONS

DATE STARTED:	07 AUG / 13	DRAWING NO.:	ID
SCALE:	1 : 20	DRAWN BY:	AP
APPROVED BY:	KC		2.1.3