



DO NOT SCALE DRAWINGS.

CONTRACTOR MUST VERIFY ALL DRAWINGS, DIMENSIONS, DETAILS AND SPECIFICATIONS, AND REPORT ANY DISCREPANCIES TO UNION31 INC. BEFORE PROCEEDING WITH WORK. MATERIALS MAY NOT BE SUBSTITUTED WITHOUT WRITTEN APPROVAL FROM UNION31 INC. ALL DRAWINGS AND SPECIFICATIONS ARE INSTRUMENTS OF SERVICE AND THE PROPERTY OF UNION31 INC. WHICH MUST BE RETURNED AT THE COMPLETION OF THE WORK.


PRINTED: 30-May-17

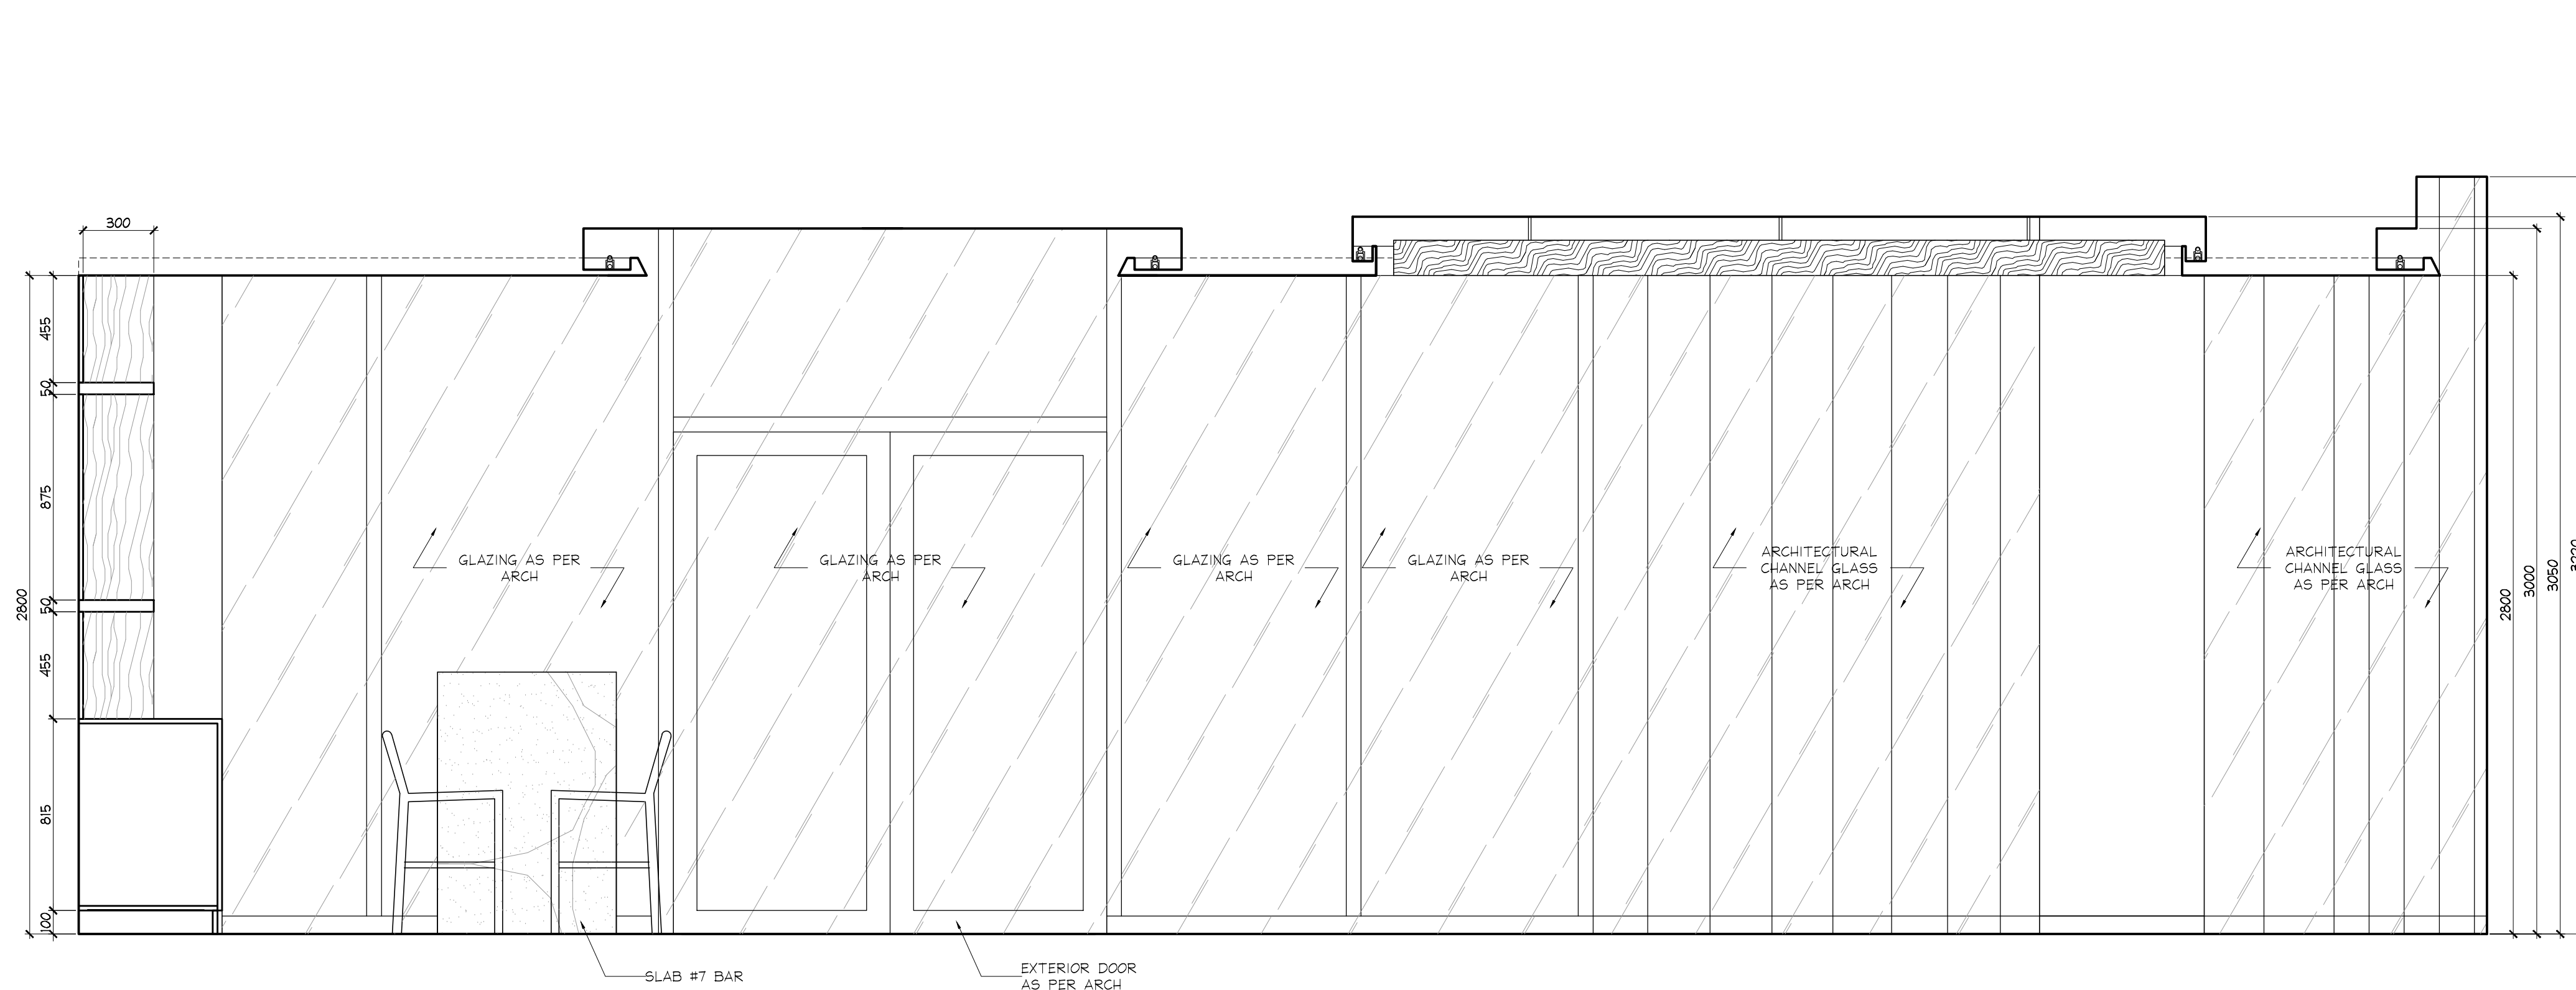


1 ELEVATION  
ID2.1.4 GROUND FLOOR AMENITY PARTY ROOM  
SCALE 1:20

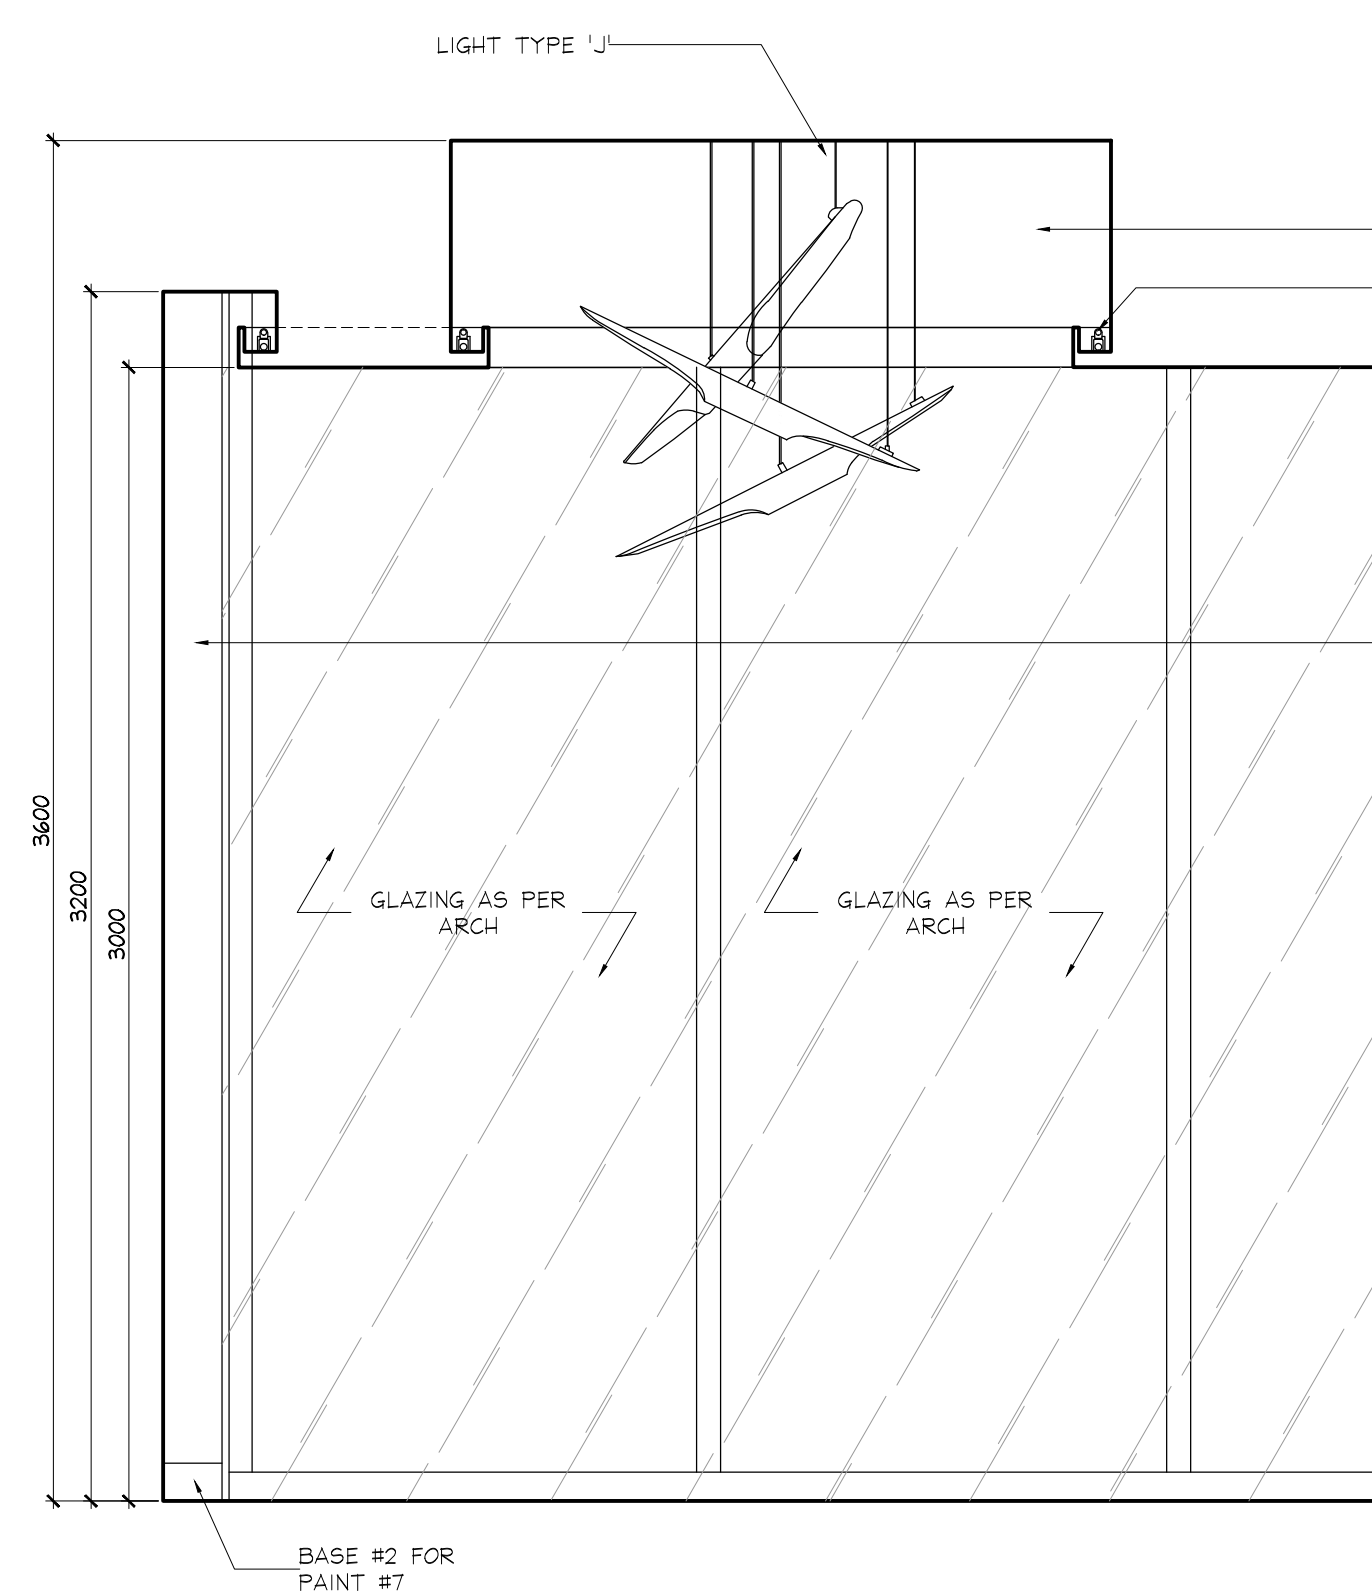


2 ELEVATION  
ID2.1.4 GROUND FLOOR DINING ROOM  
SCALE 1:20

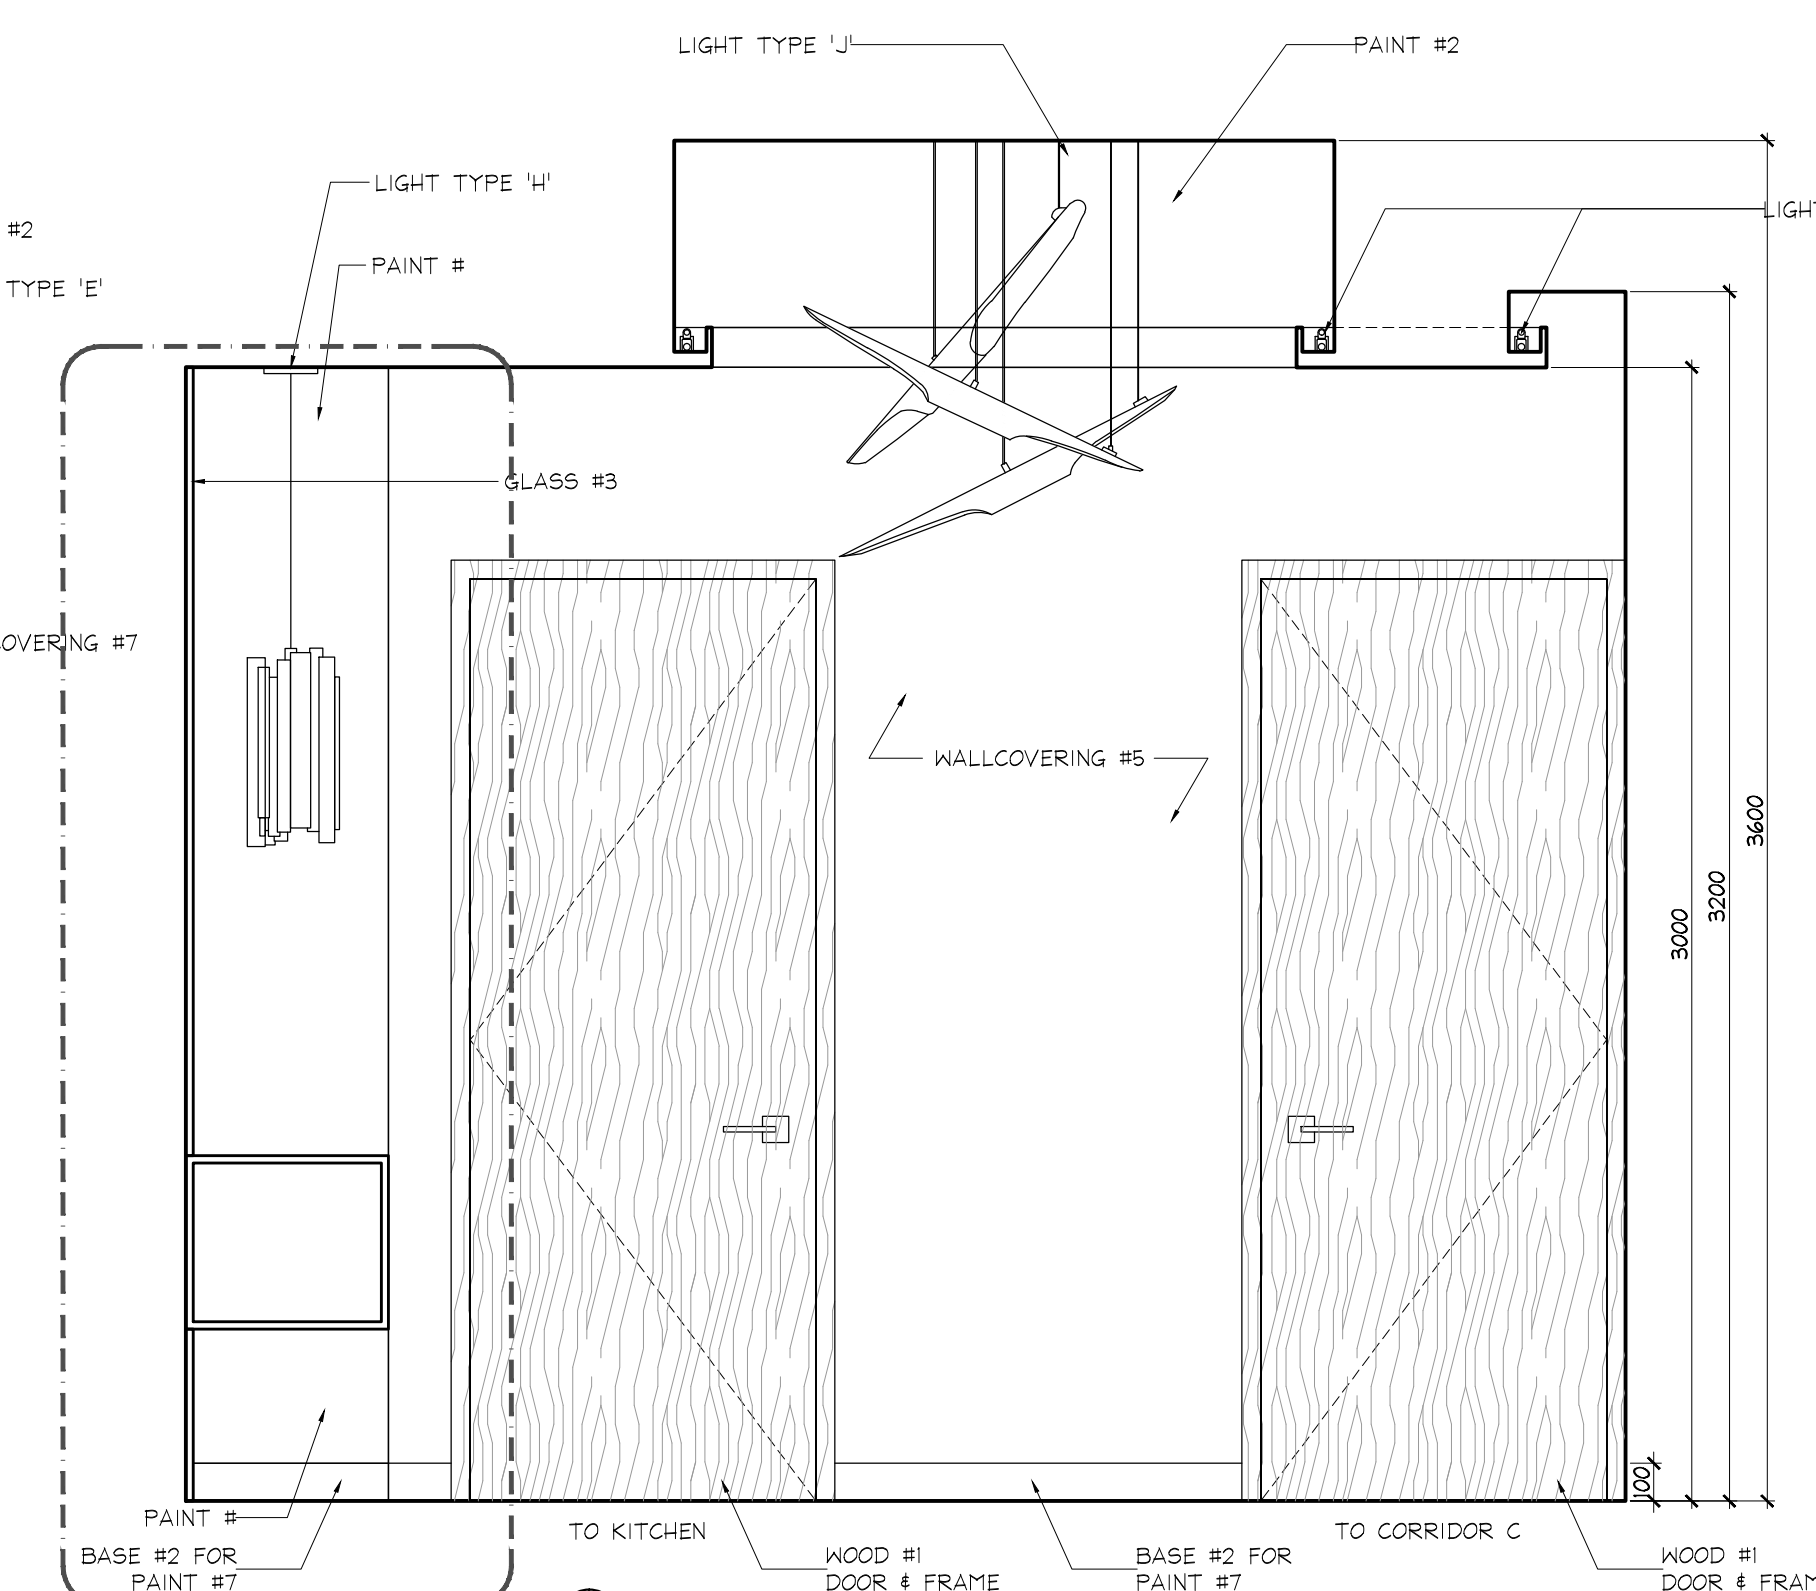


3 ELEVATION  
ID2.1.4 GROUND FLOOR DINING ROOM  
SCALE 1:20

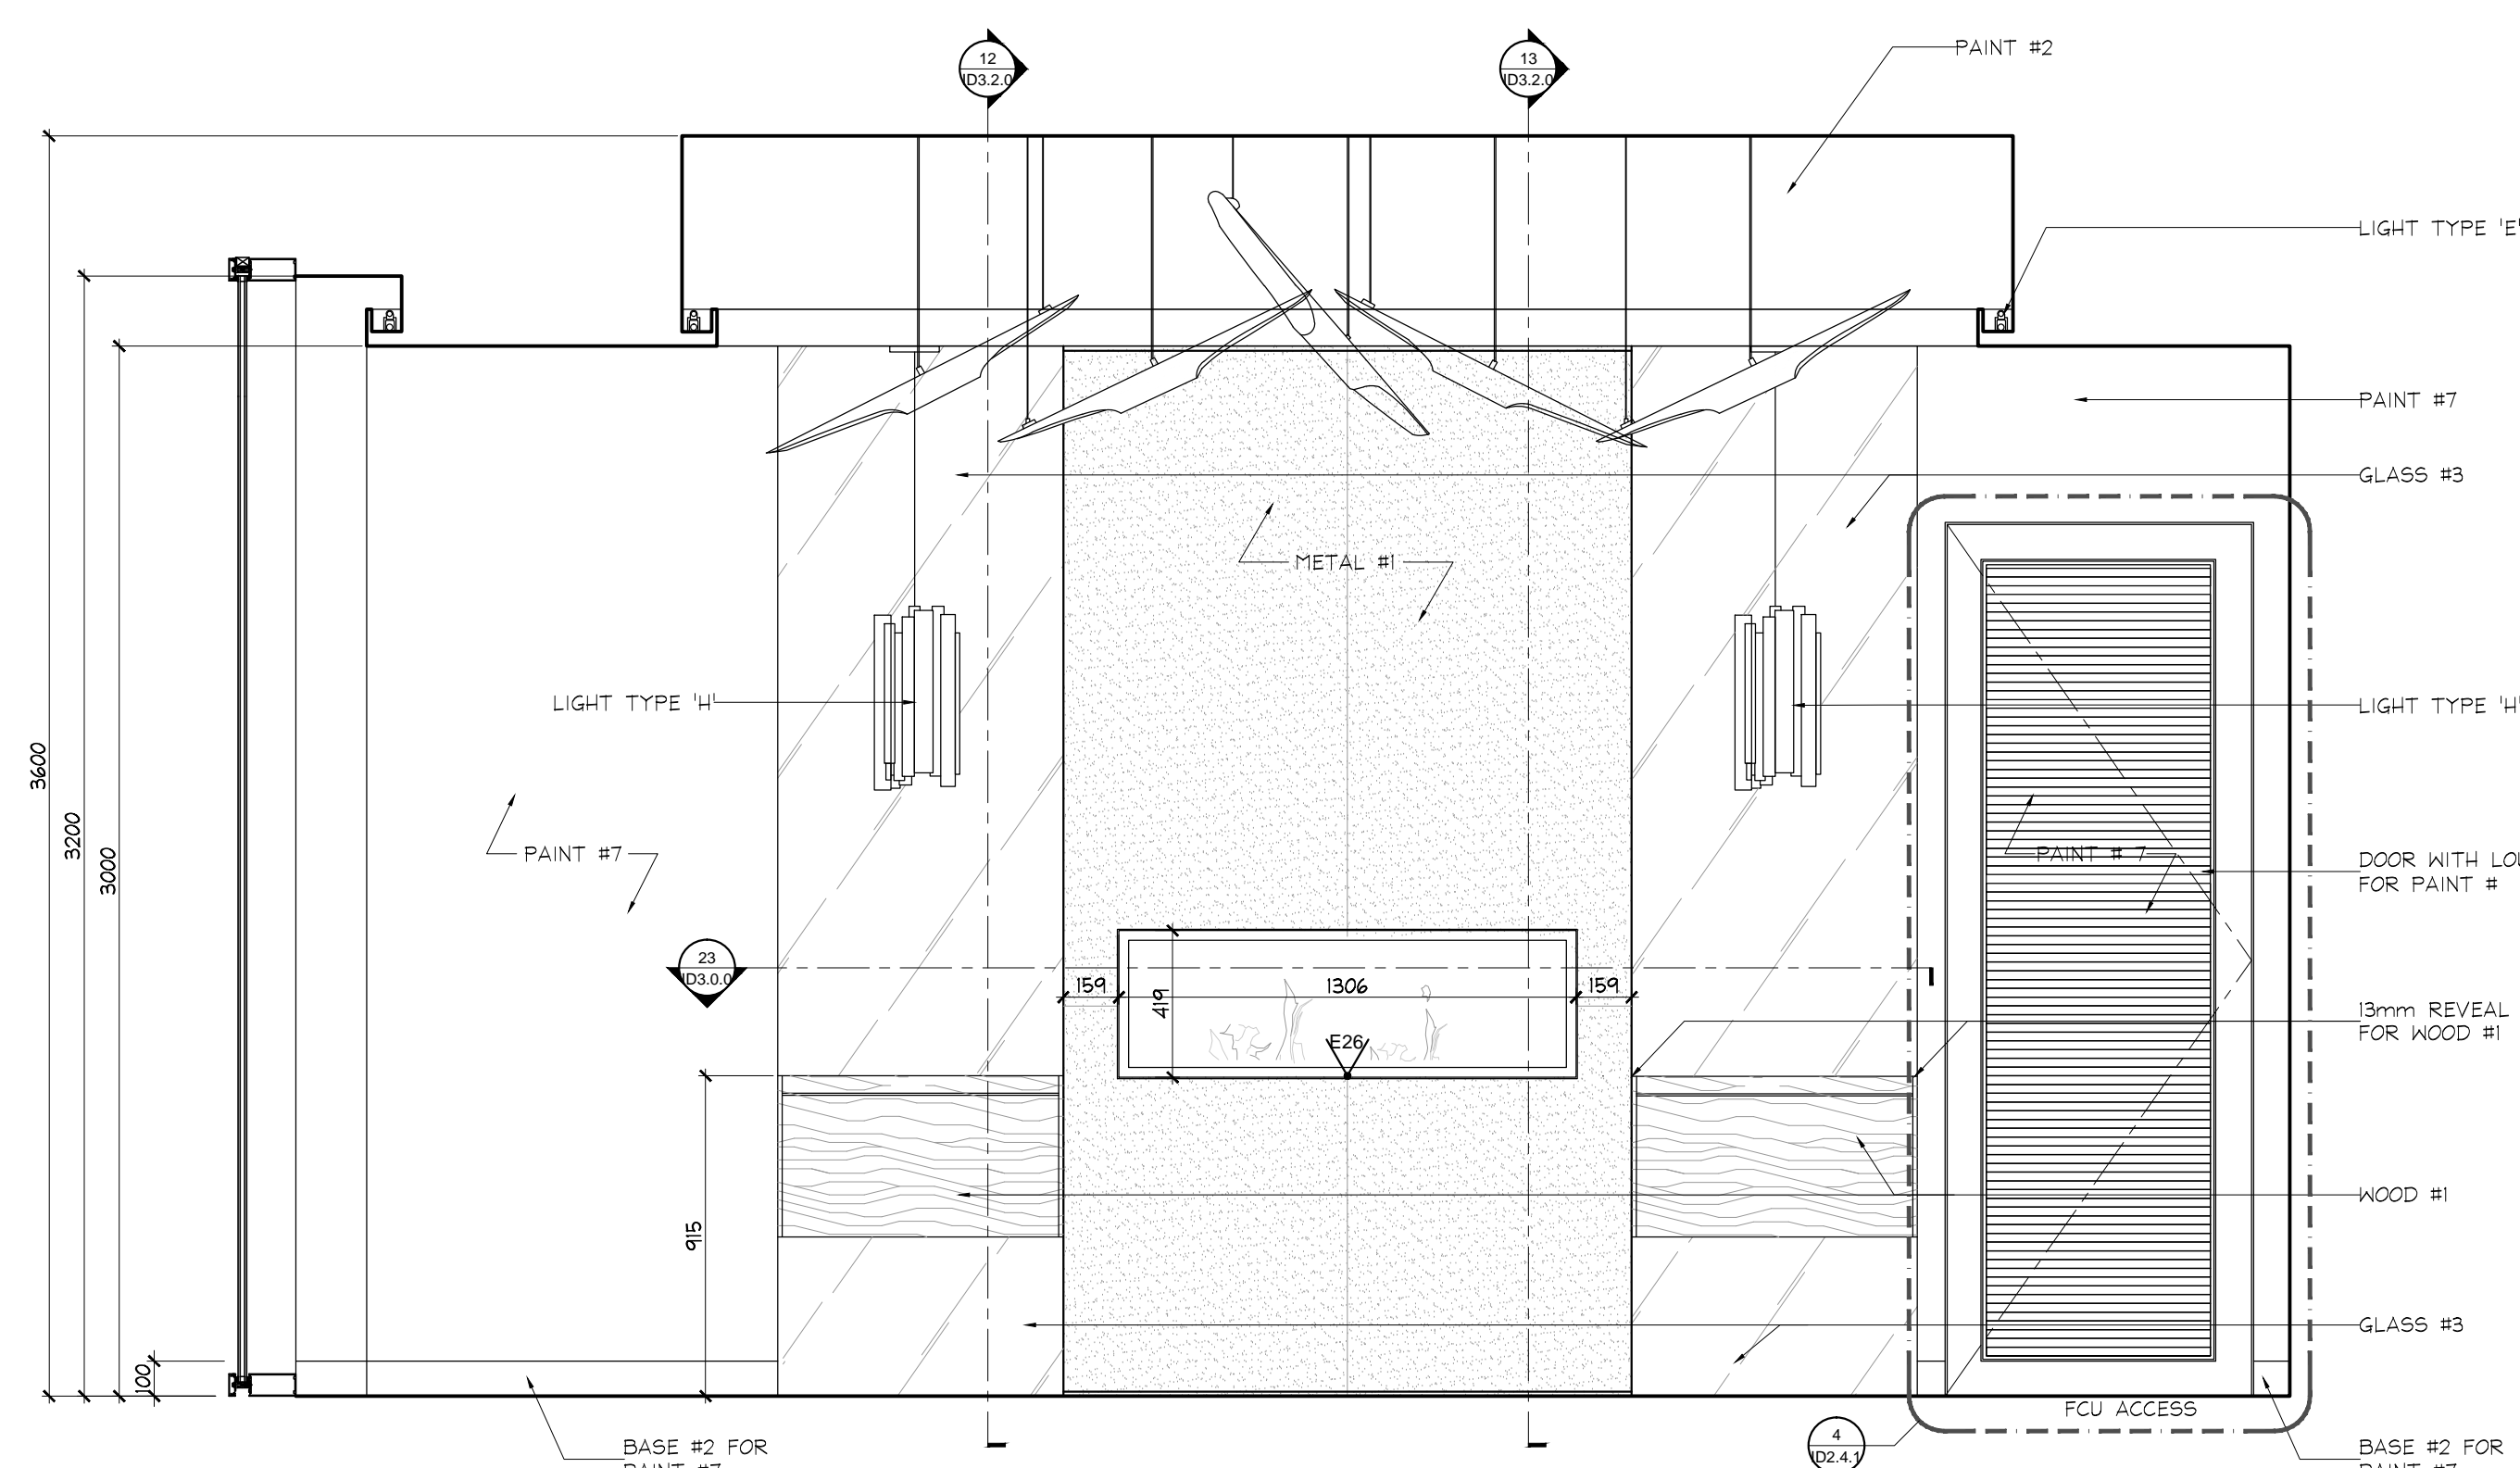


4 ELEVATION  
ID2.1.4 GROUND FLOOR DINING ROOM  
SCALE 1:20

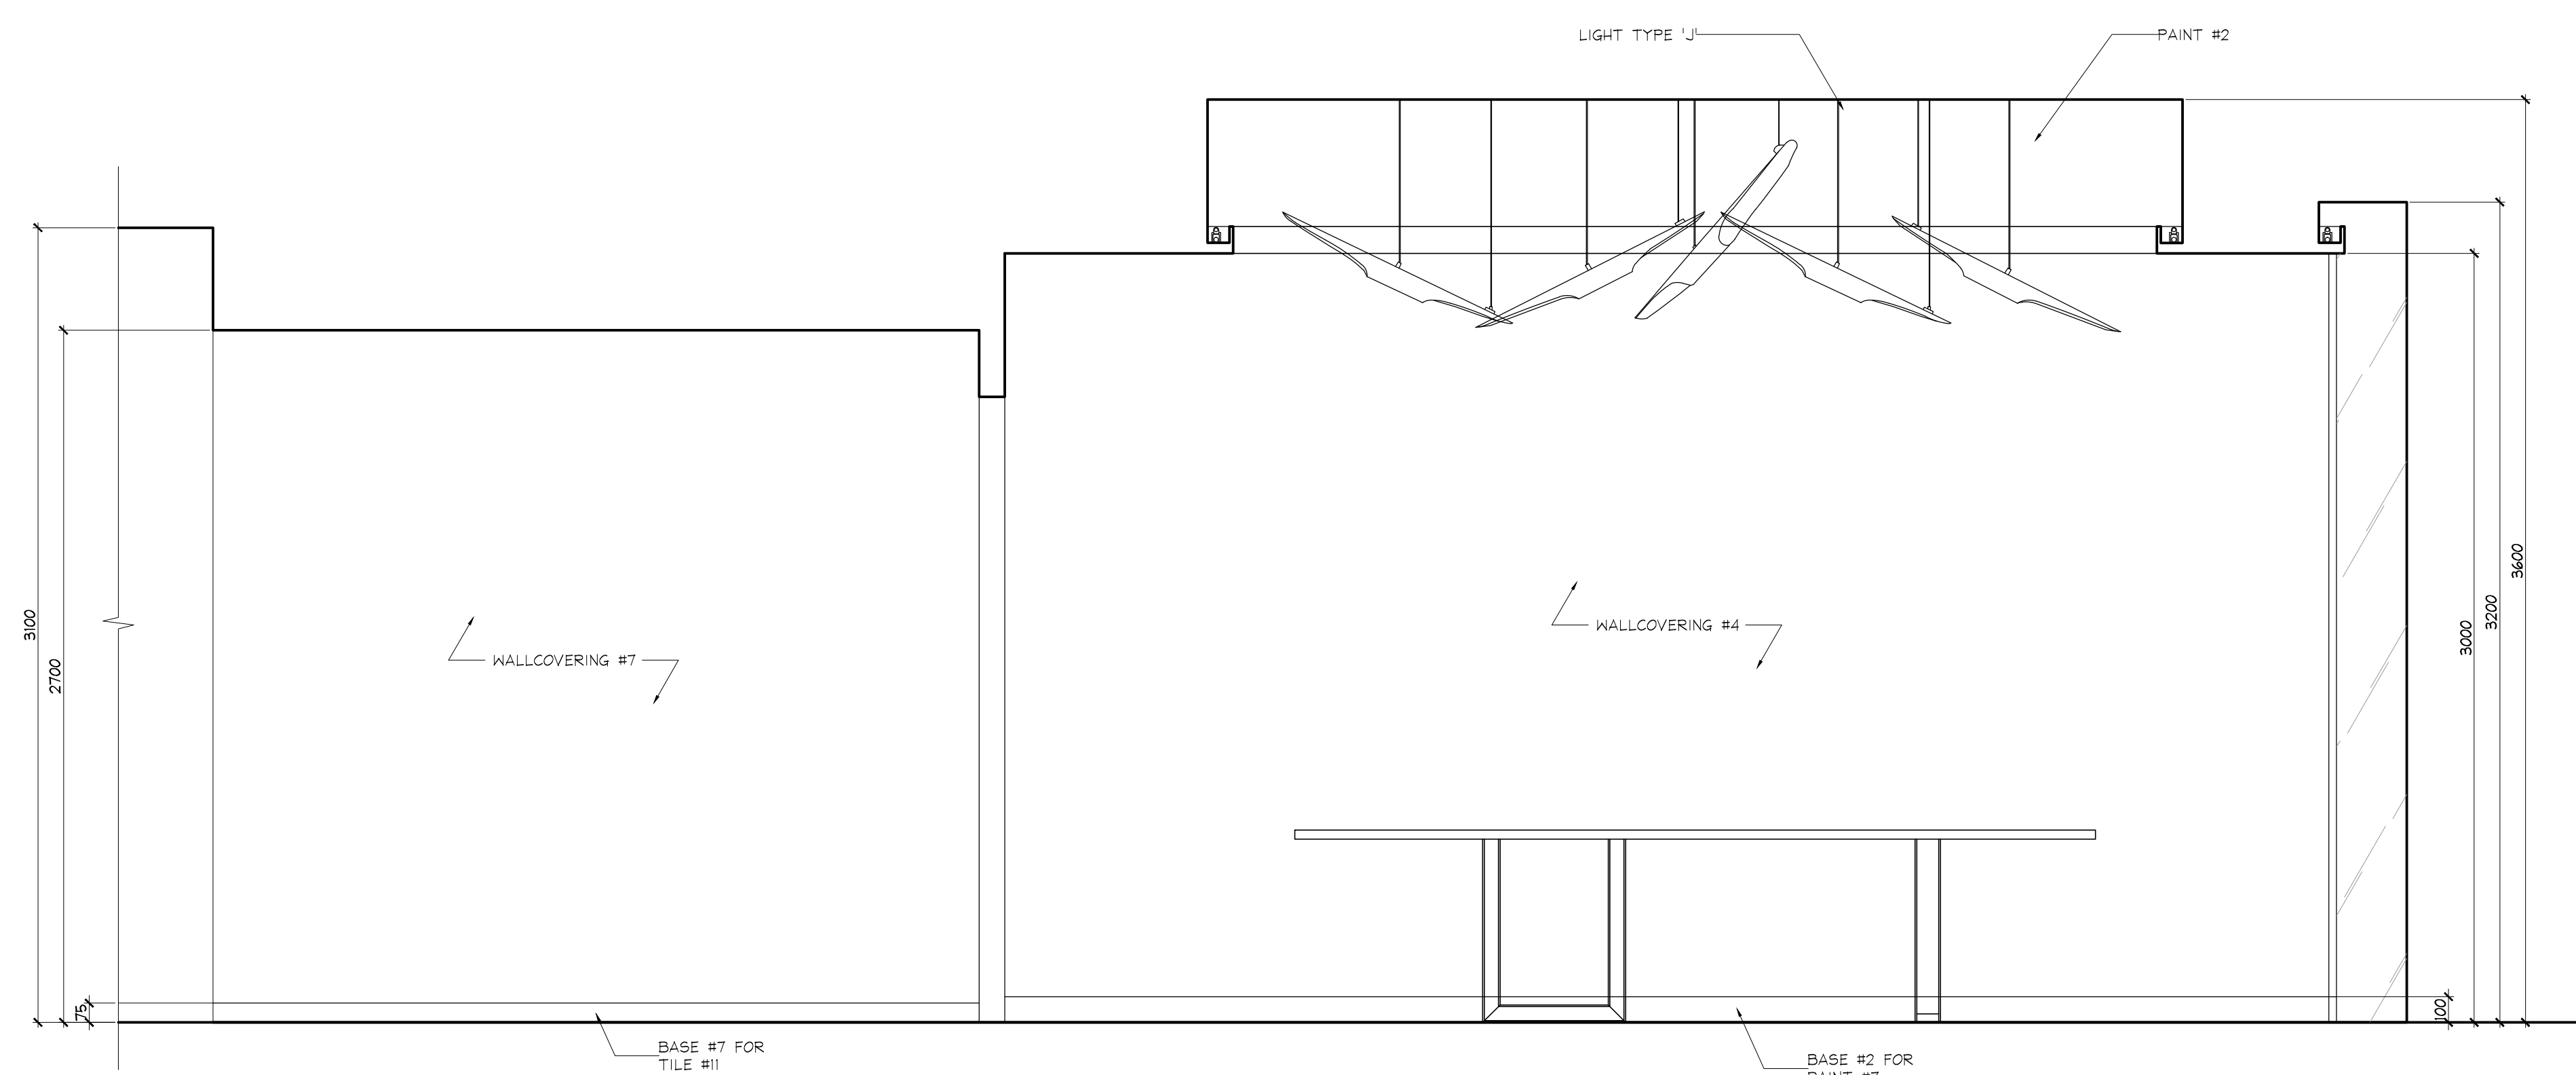


5 ELEVATION  
ID2.1.4 GROUND FLOOR DINING ROOM  
SCALE 1:20

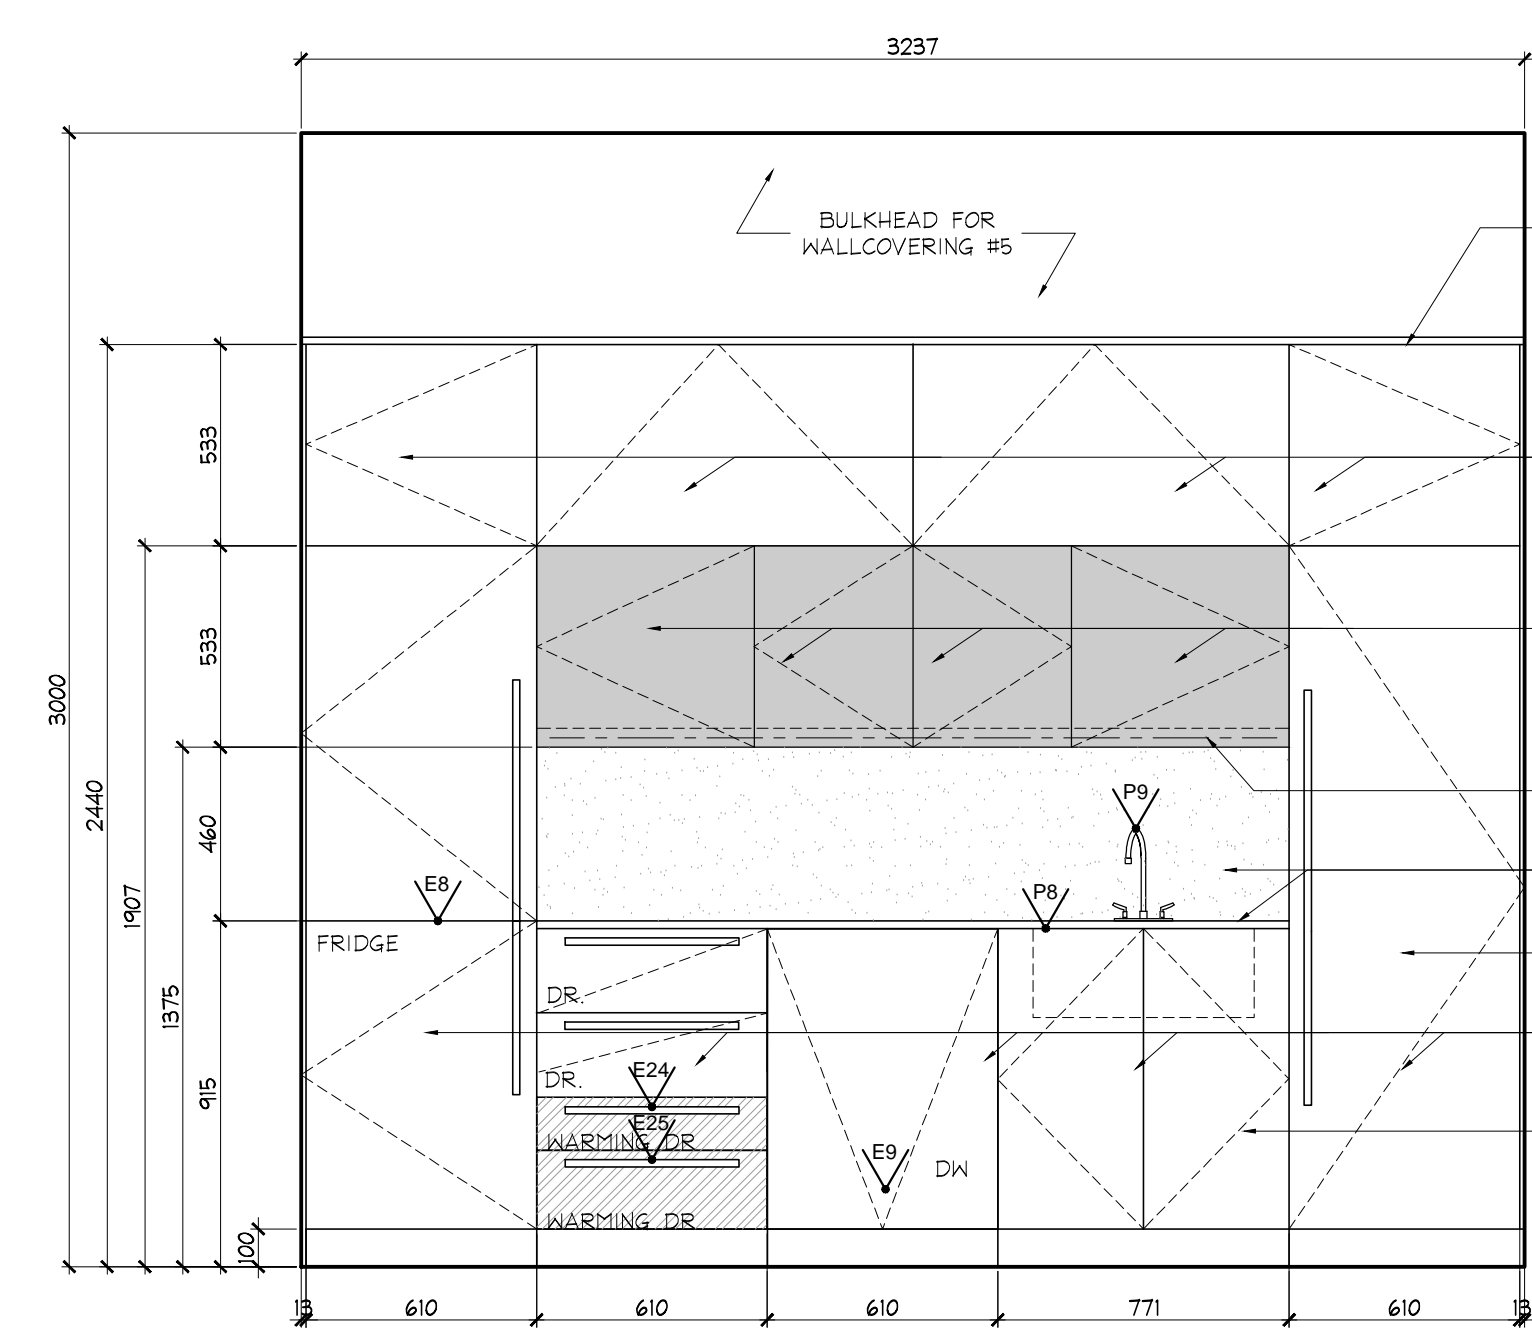


6 ELEVATION  
ID2.1.4 GROUND FLOOR KITCHEN  
SCALE 1:20

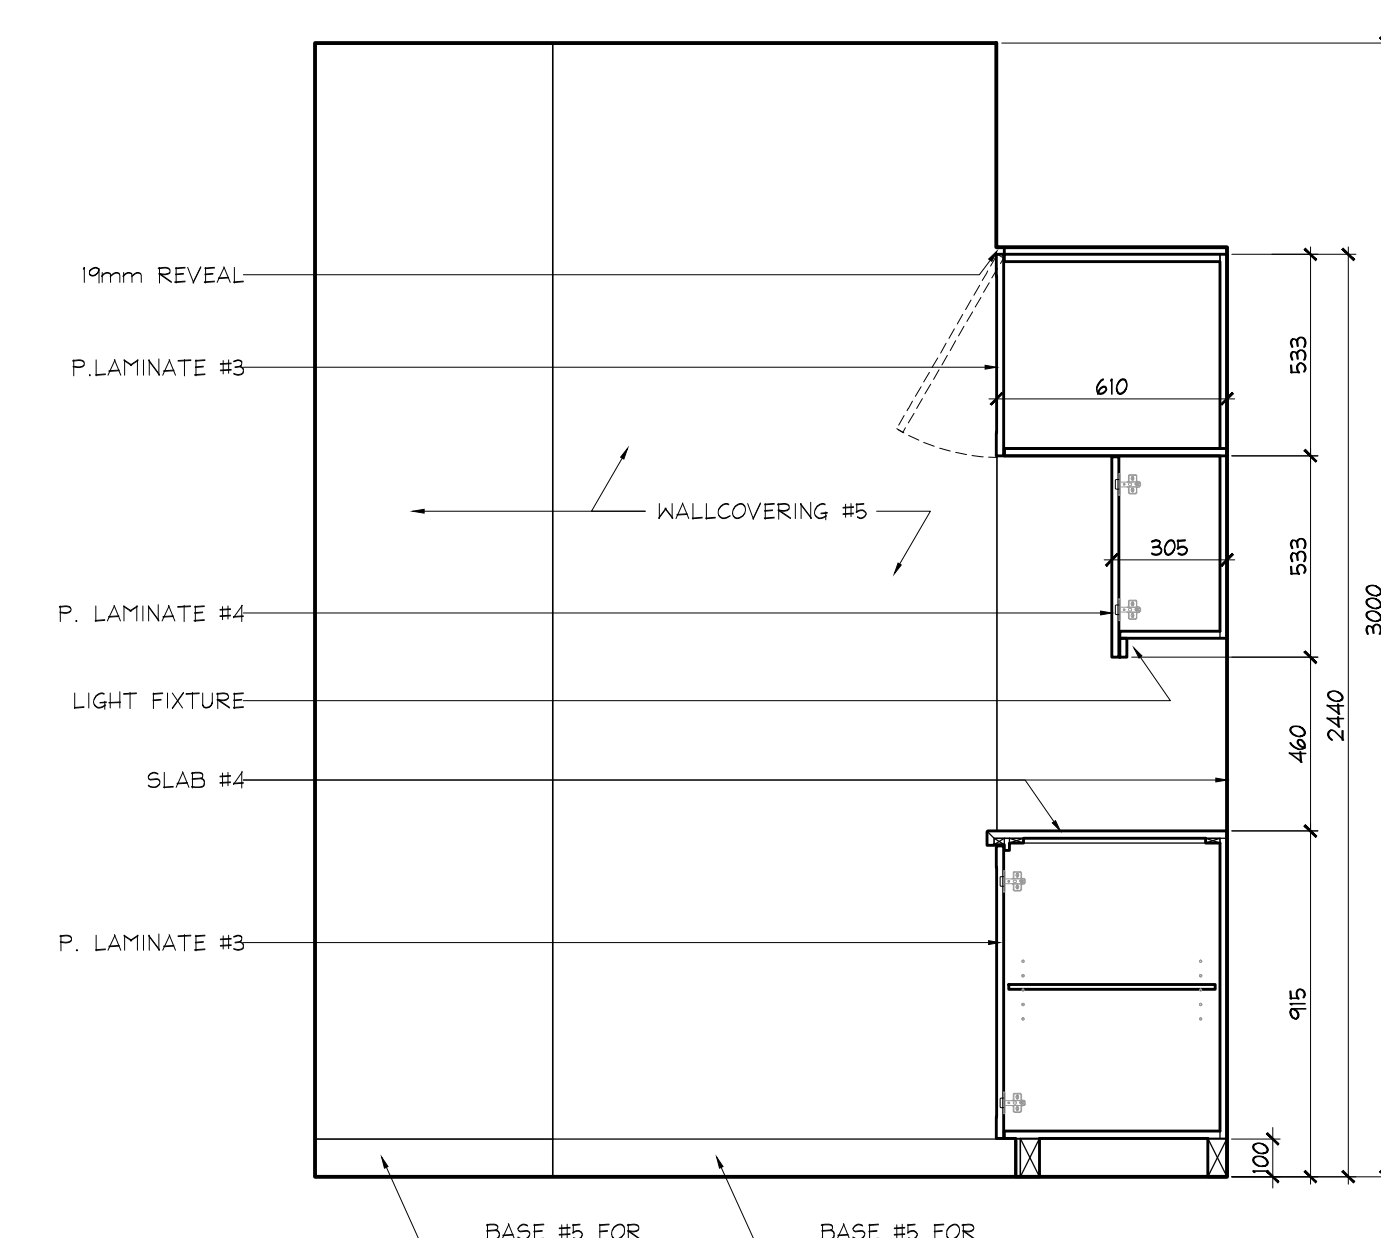

7 ELEVATION  
ID2.1.4 GROUND FLOOR KITCHEN  
SCALE 1:20

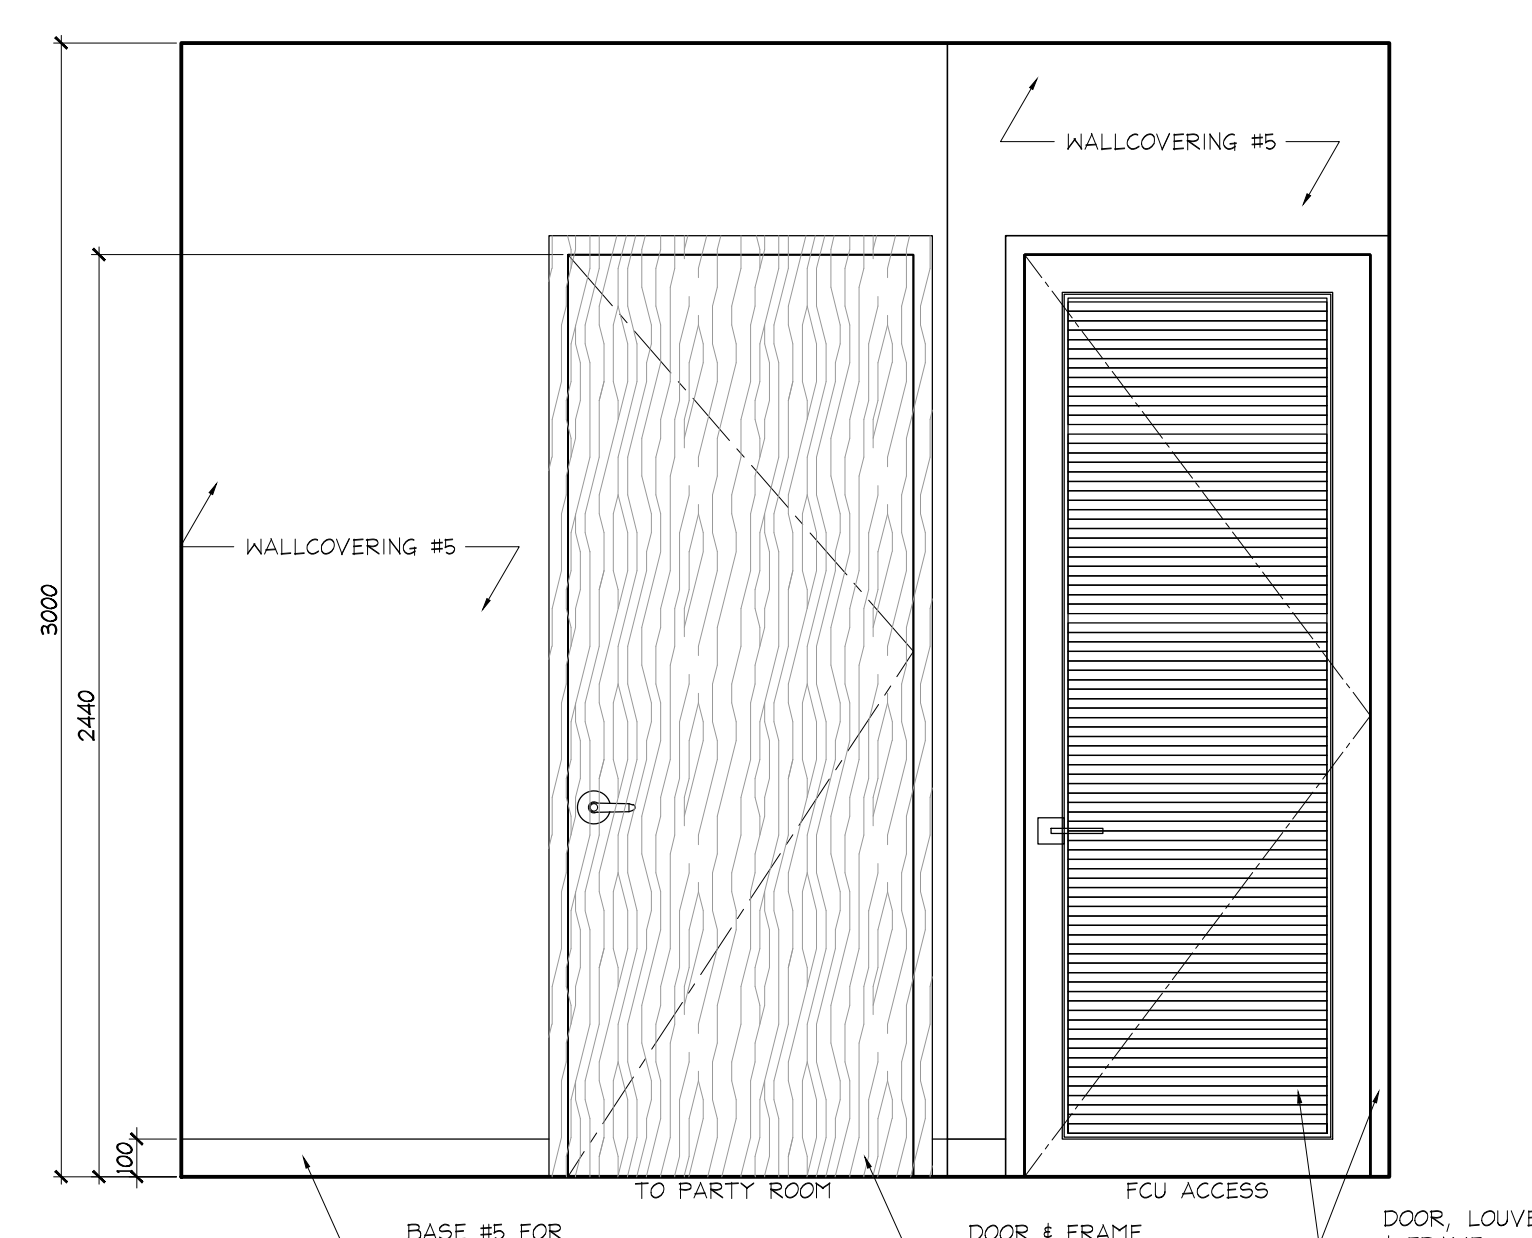

8 ELEVATION  
ID2.1.4 GROUND FLOOR KITCHEN  
SCALE 1:20

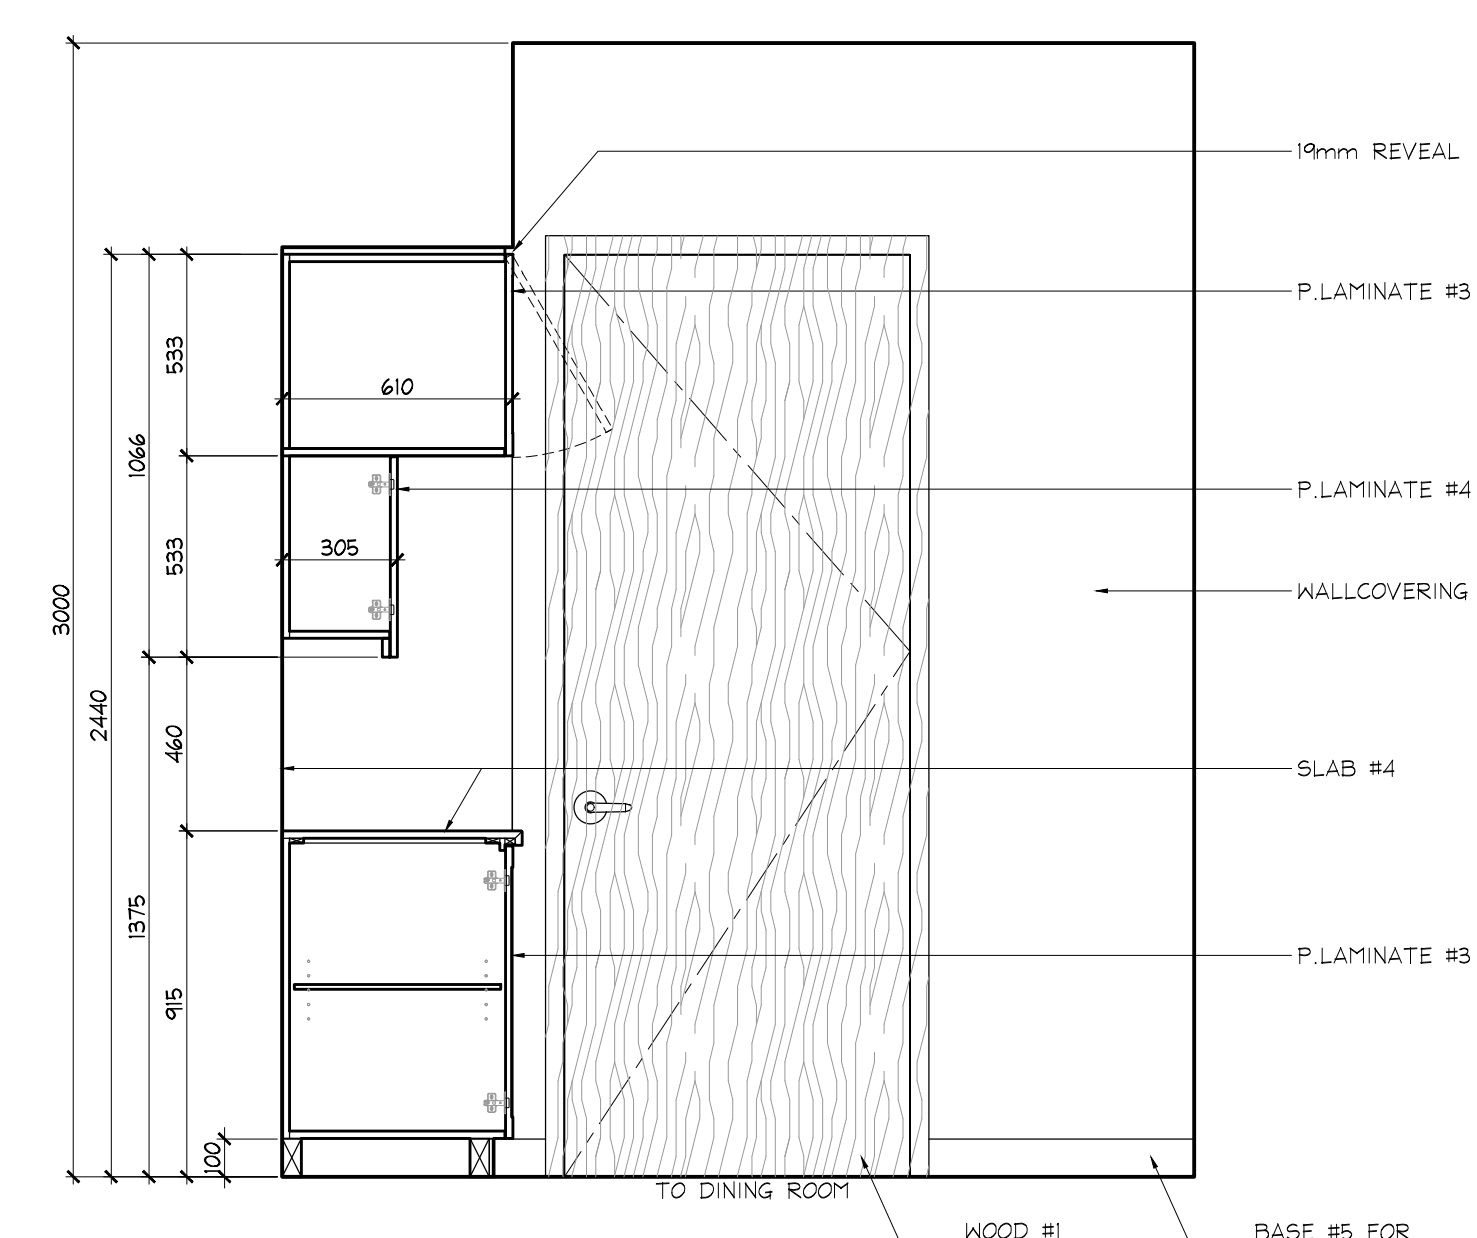

9 ELEVATION  
ID2.1.4 GROUND FLOOR KITCHEN  
SCALE 1:20

01	31 MAY / 17	ISSUED FOR AS-BUILT	SV
NO.	DATE	COMMENTS	INI
REVISIONS:			

UNION31

UNION31 INC.  
183 BATHURST STREET, STE. 201  
TORONTO, ON, M5T 2R7, CANADA  
TEL: 416-597-1576 FAX: 416-597-2139

PROJECT NAME:  
**ALEXANDRA PARK  
MAIN BUILDING**  
BLOCK 11  
ON, Canada

PROJECT NO.: 13-949

DRAWINGS:  
**GROUND FLOOR  
ELEVATIONS**

DATE STARTED: 07 AUG / 13  
SCALE: 1:20  
DRAWN BY: AP  
APPROVED BY: KC

DRAWING NO.:  
**ID  
2.1.4**

ISSUED FOR  
AS-BUILT