



DO NOT SCALE DRAWINGS.

CONTRACTOR MUST VERIFY ALL DRAWINGS, DIMENSIONS, DETAILS AND SPECIFICATIONS, AND REPORT ANY DISCREPANCIES TO UNION 31 INC. BEFORE PROCEEDING WITH WORK. MATERIALS MAY NOT BE SUBSTITUTED WITHOUT WRITTEN APPROVAL FROM UNION 31 INC. ALL DRAWINGS AND SPECIFICATIONS ARE INSTRUMENTS OF SERVICE AND THE PROPERTY OF UNION 31 INC. WHICH MUST BE RETURNED AT THE COMPLETION OF THE WORK.


PRINTED: 30-May-17

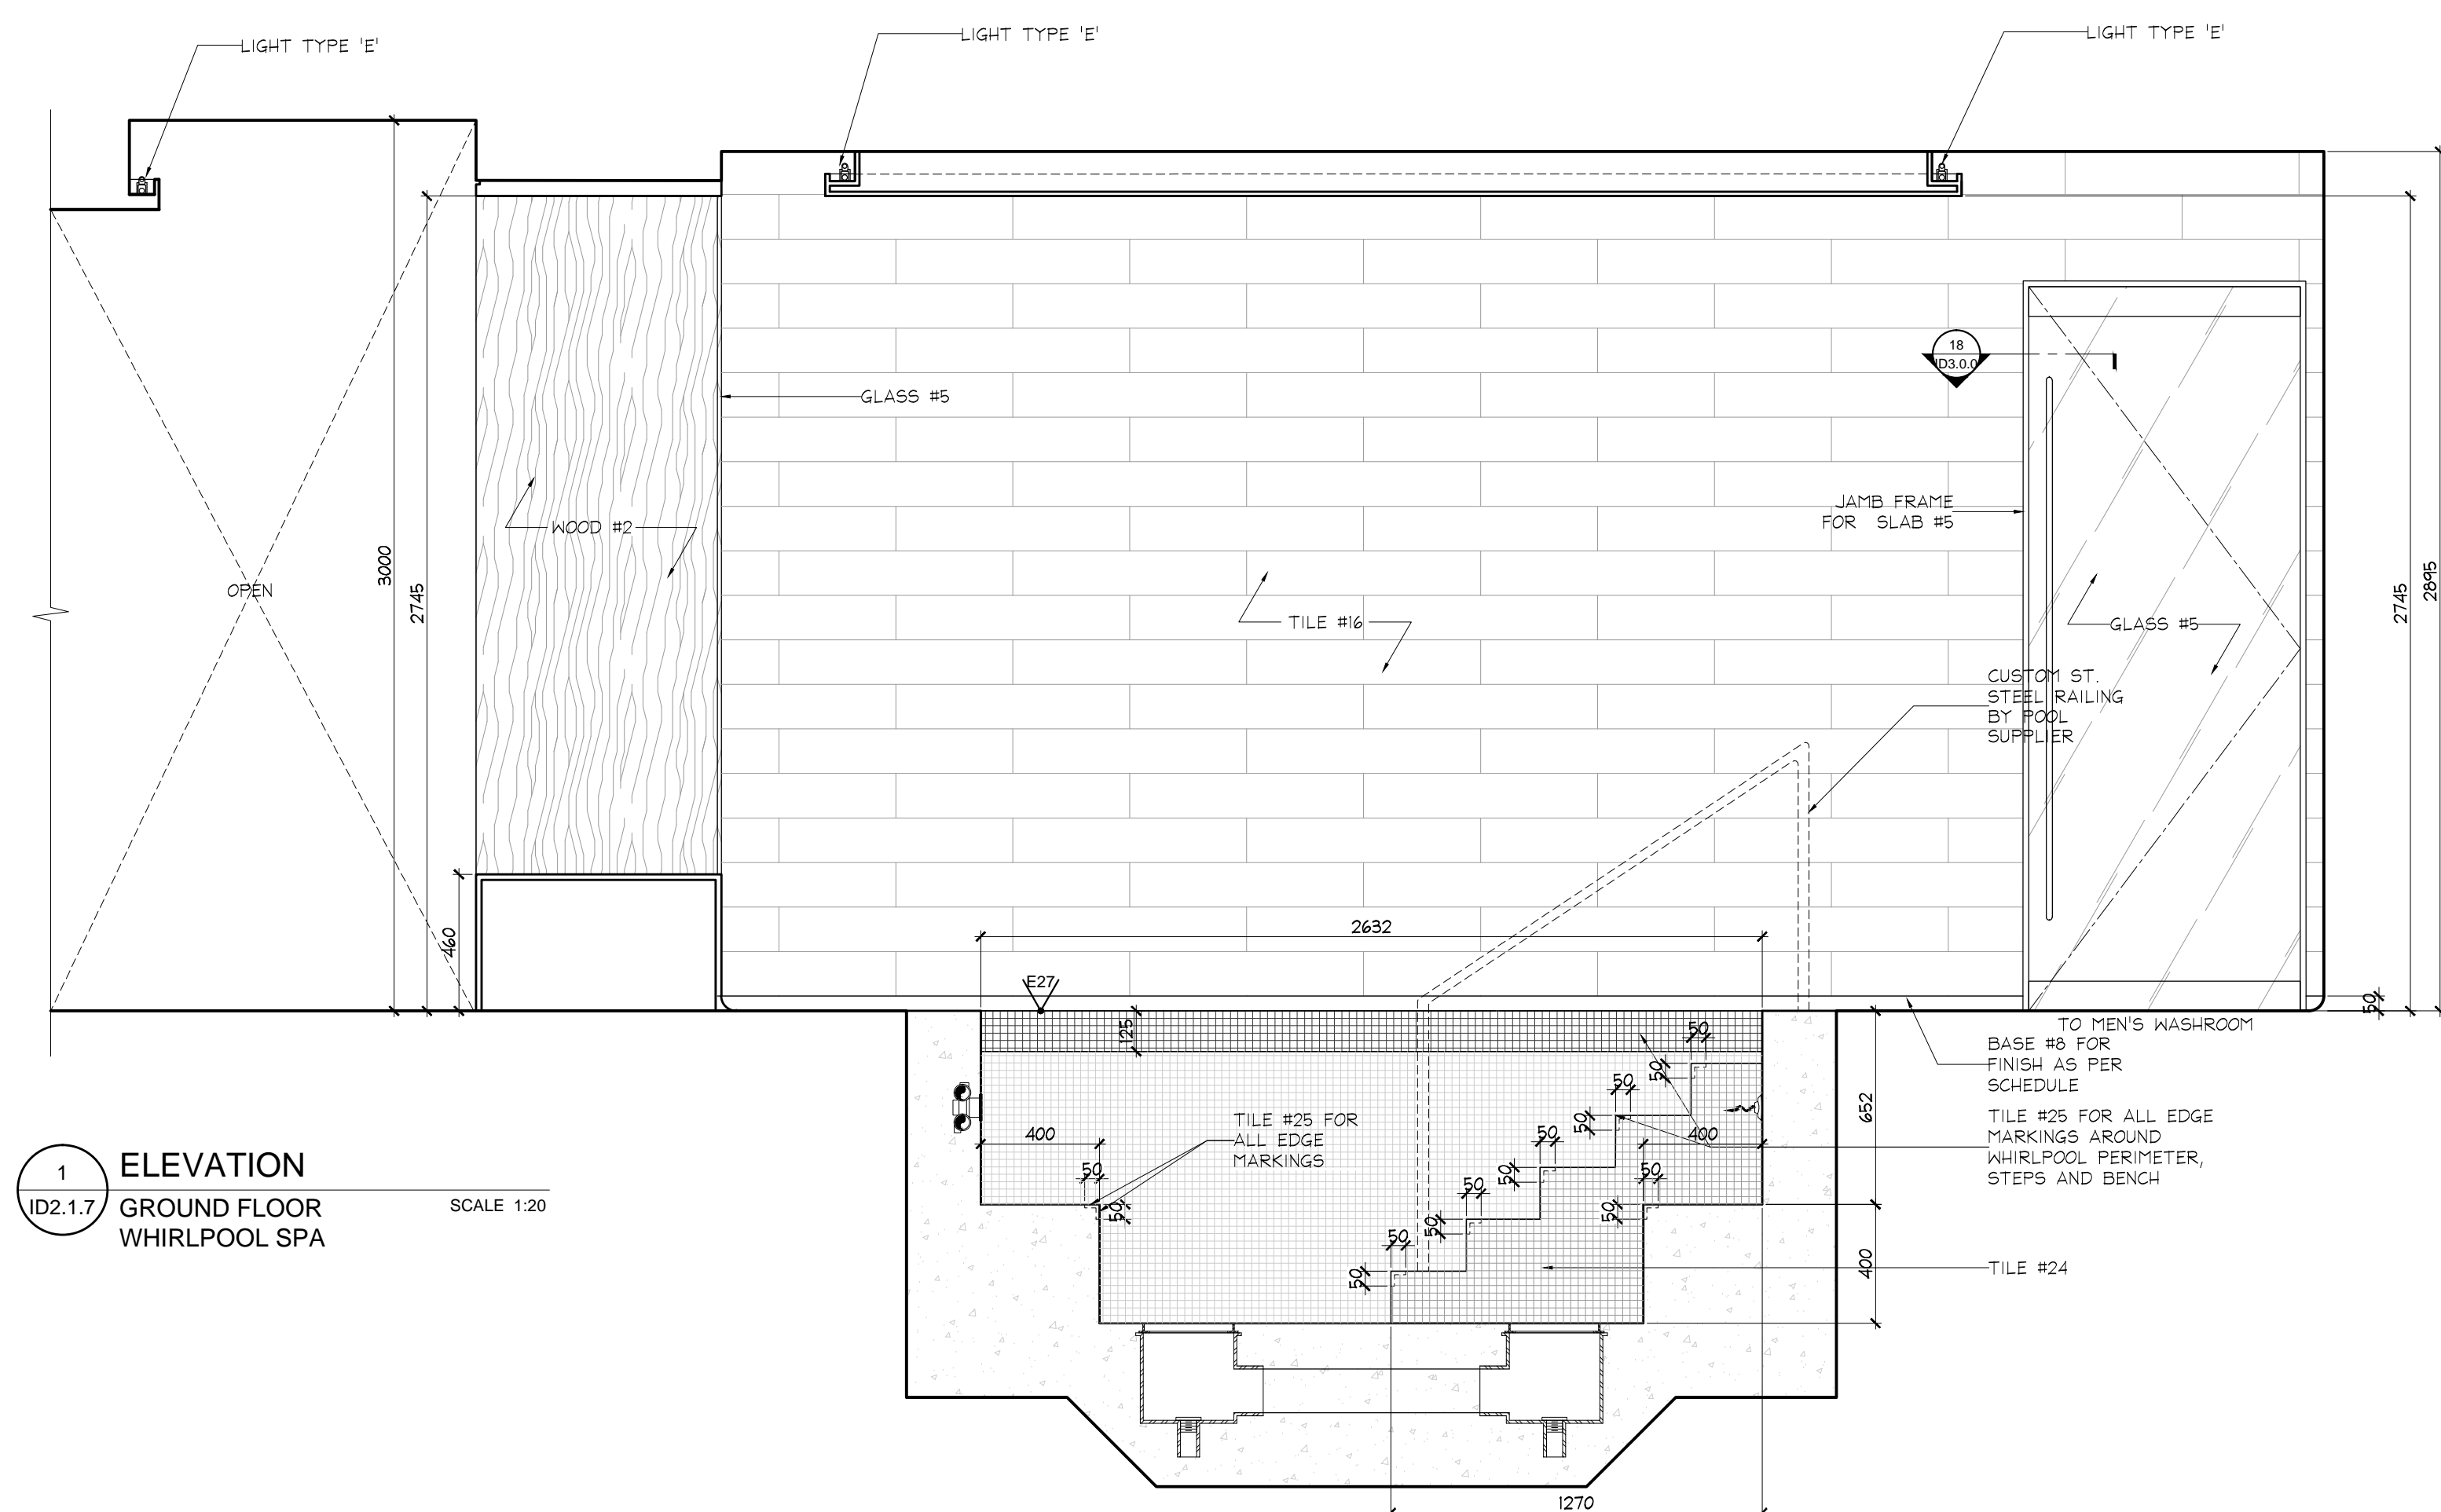


1 ELEVATION
GROUND FLOOR
WHIRLPOOL SPA
SCALE 1:20

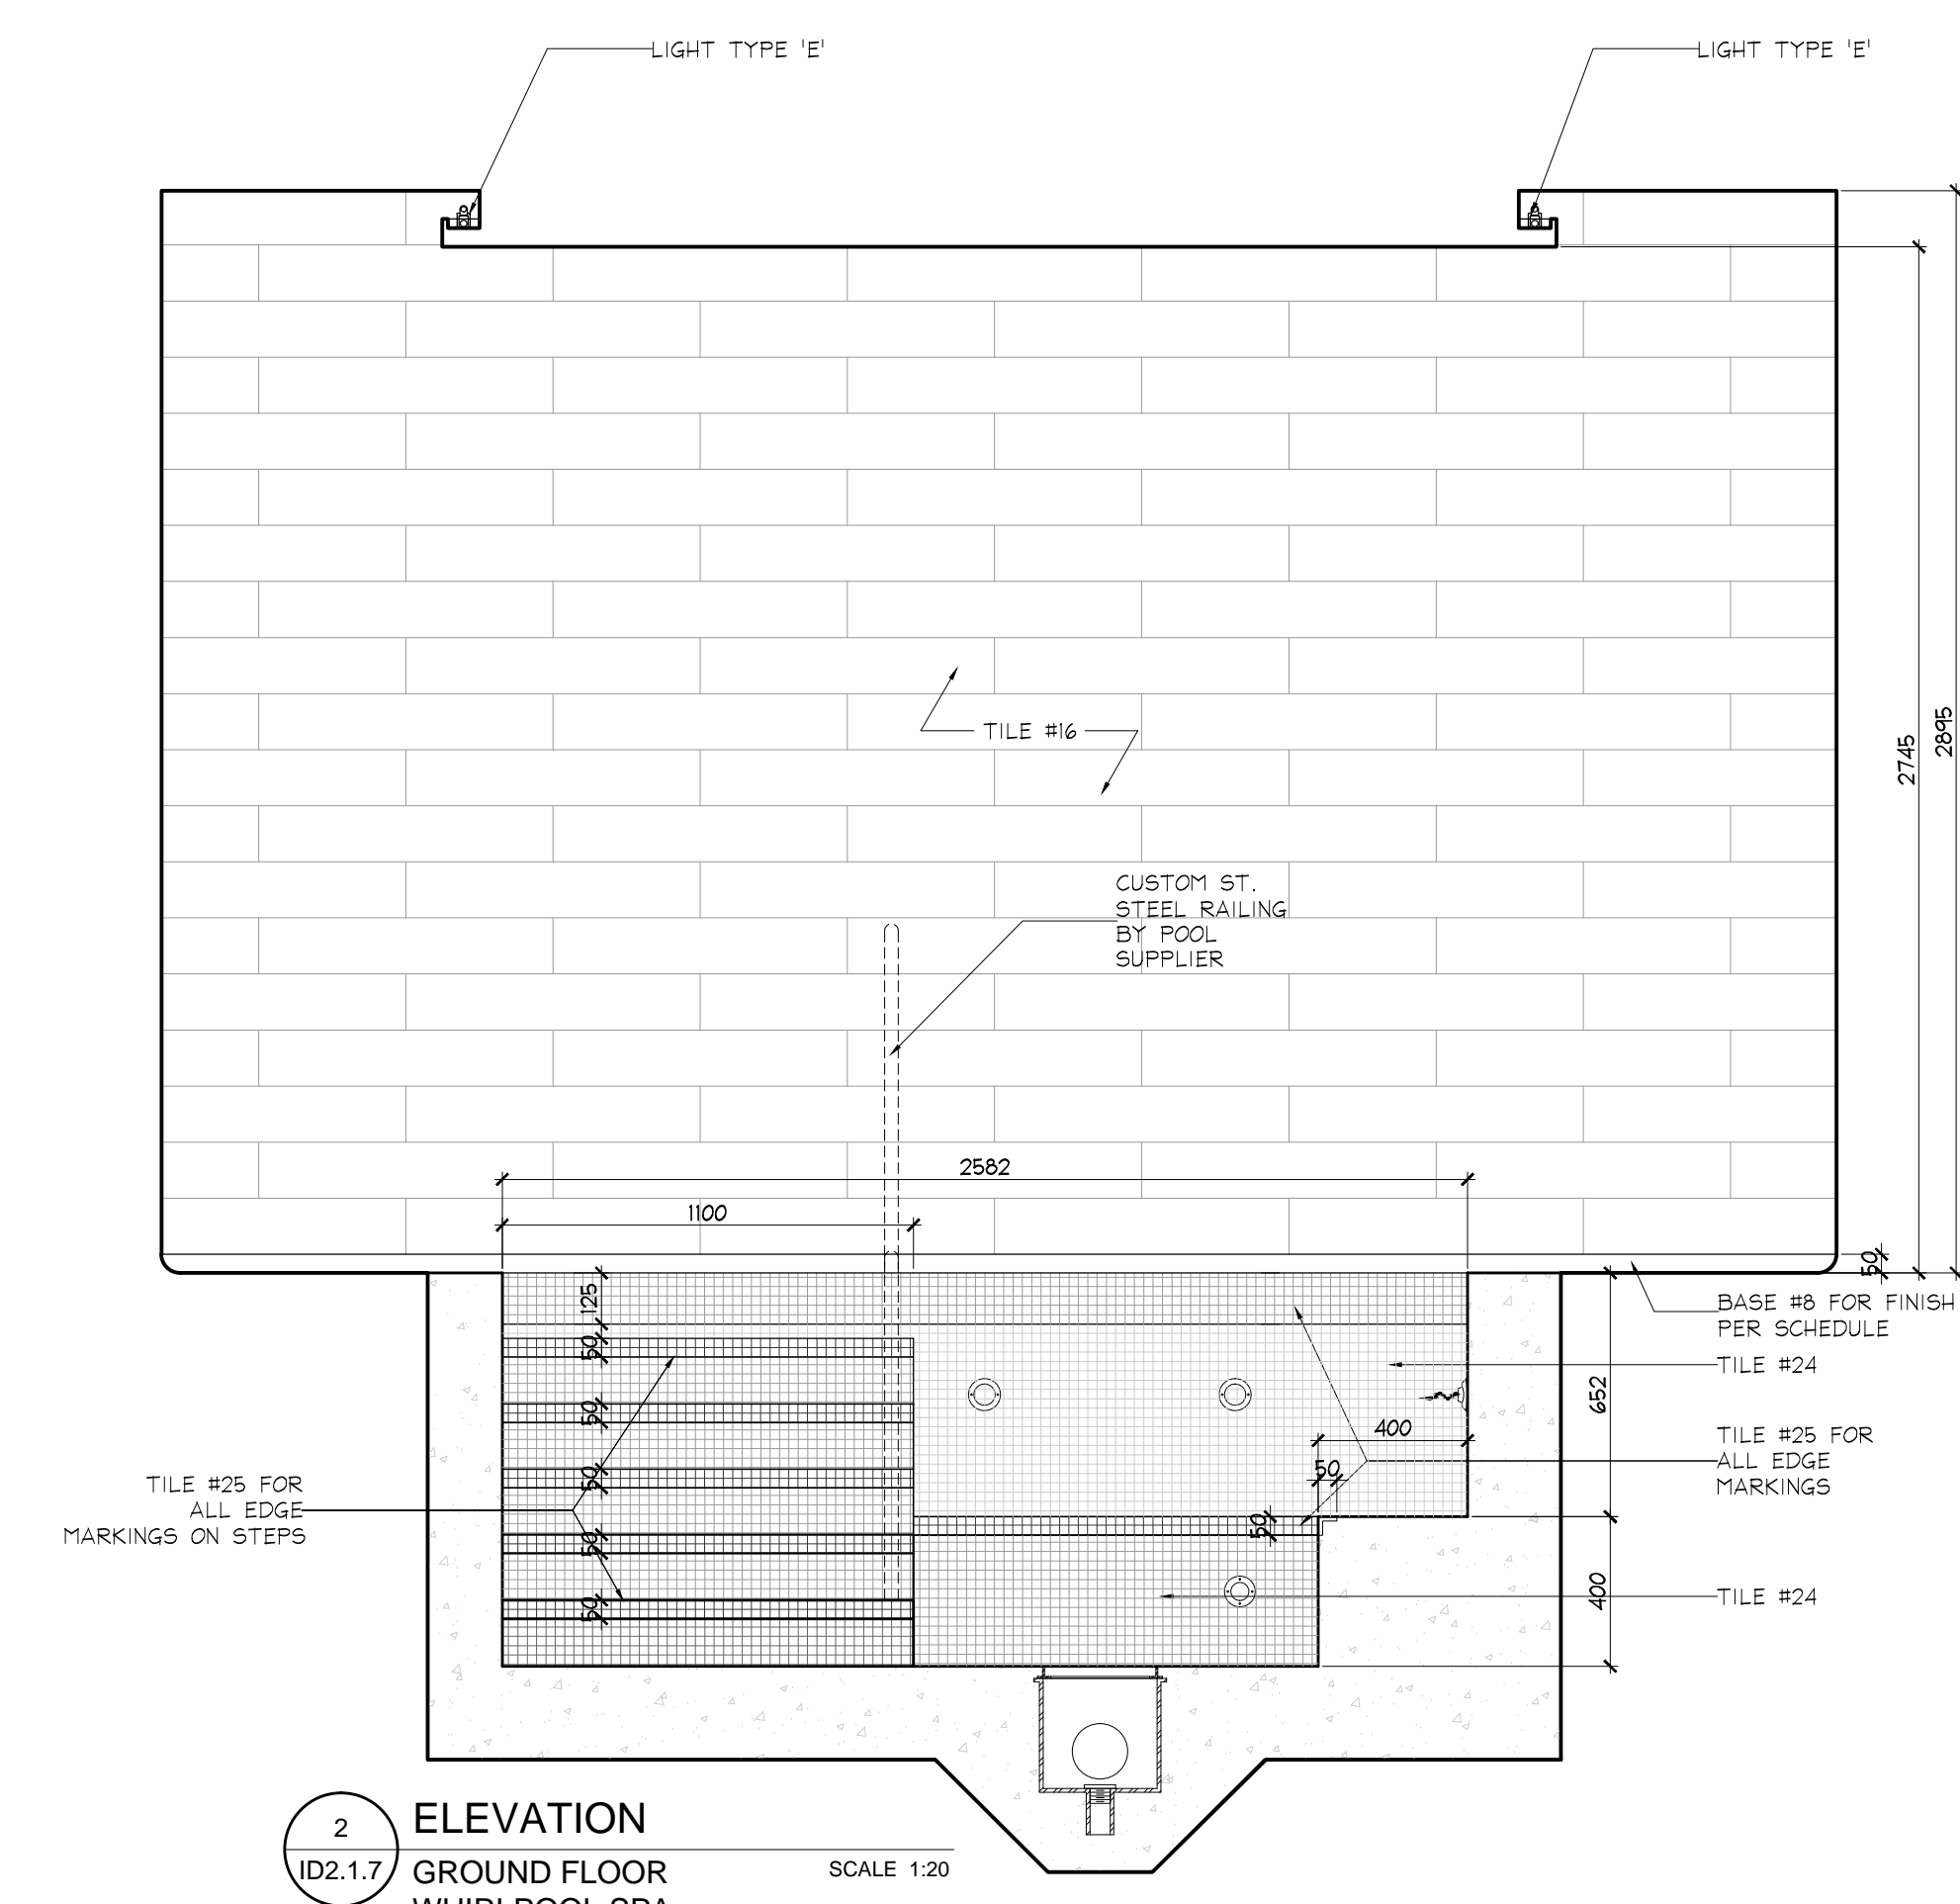


2 ELEVATION
GROUND FLOOR
WHIRLPOOL SPA
SCALE 1:20

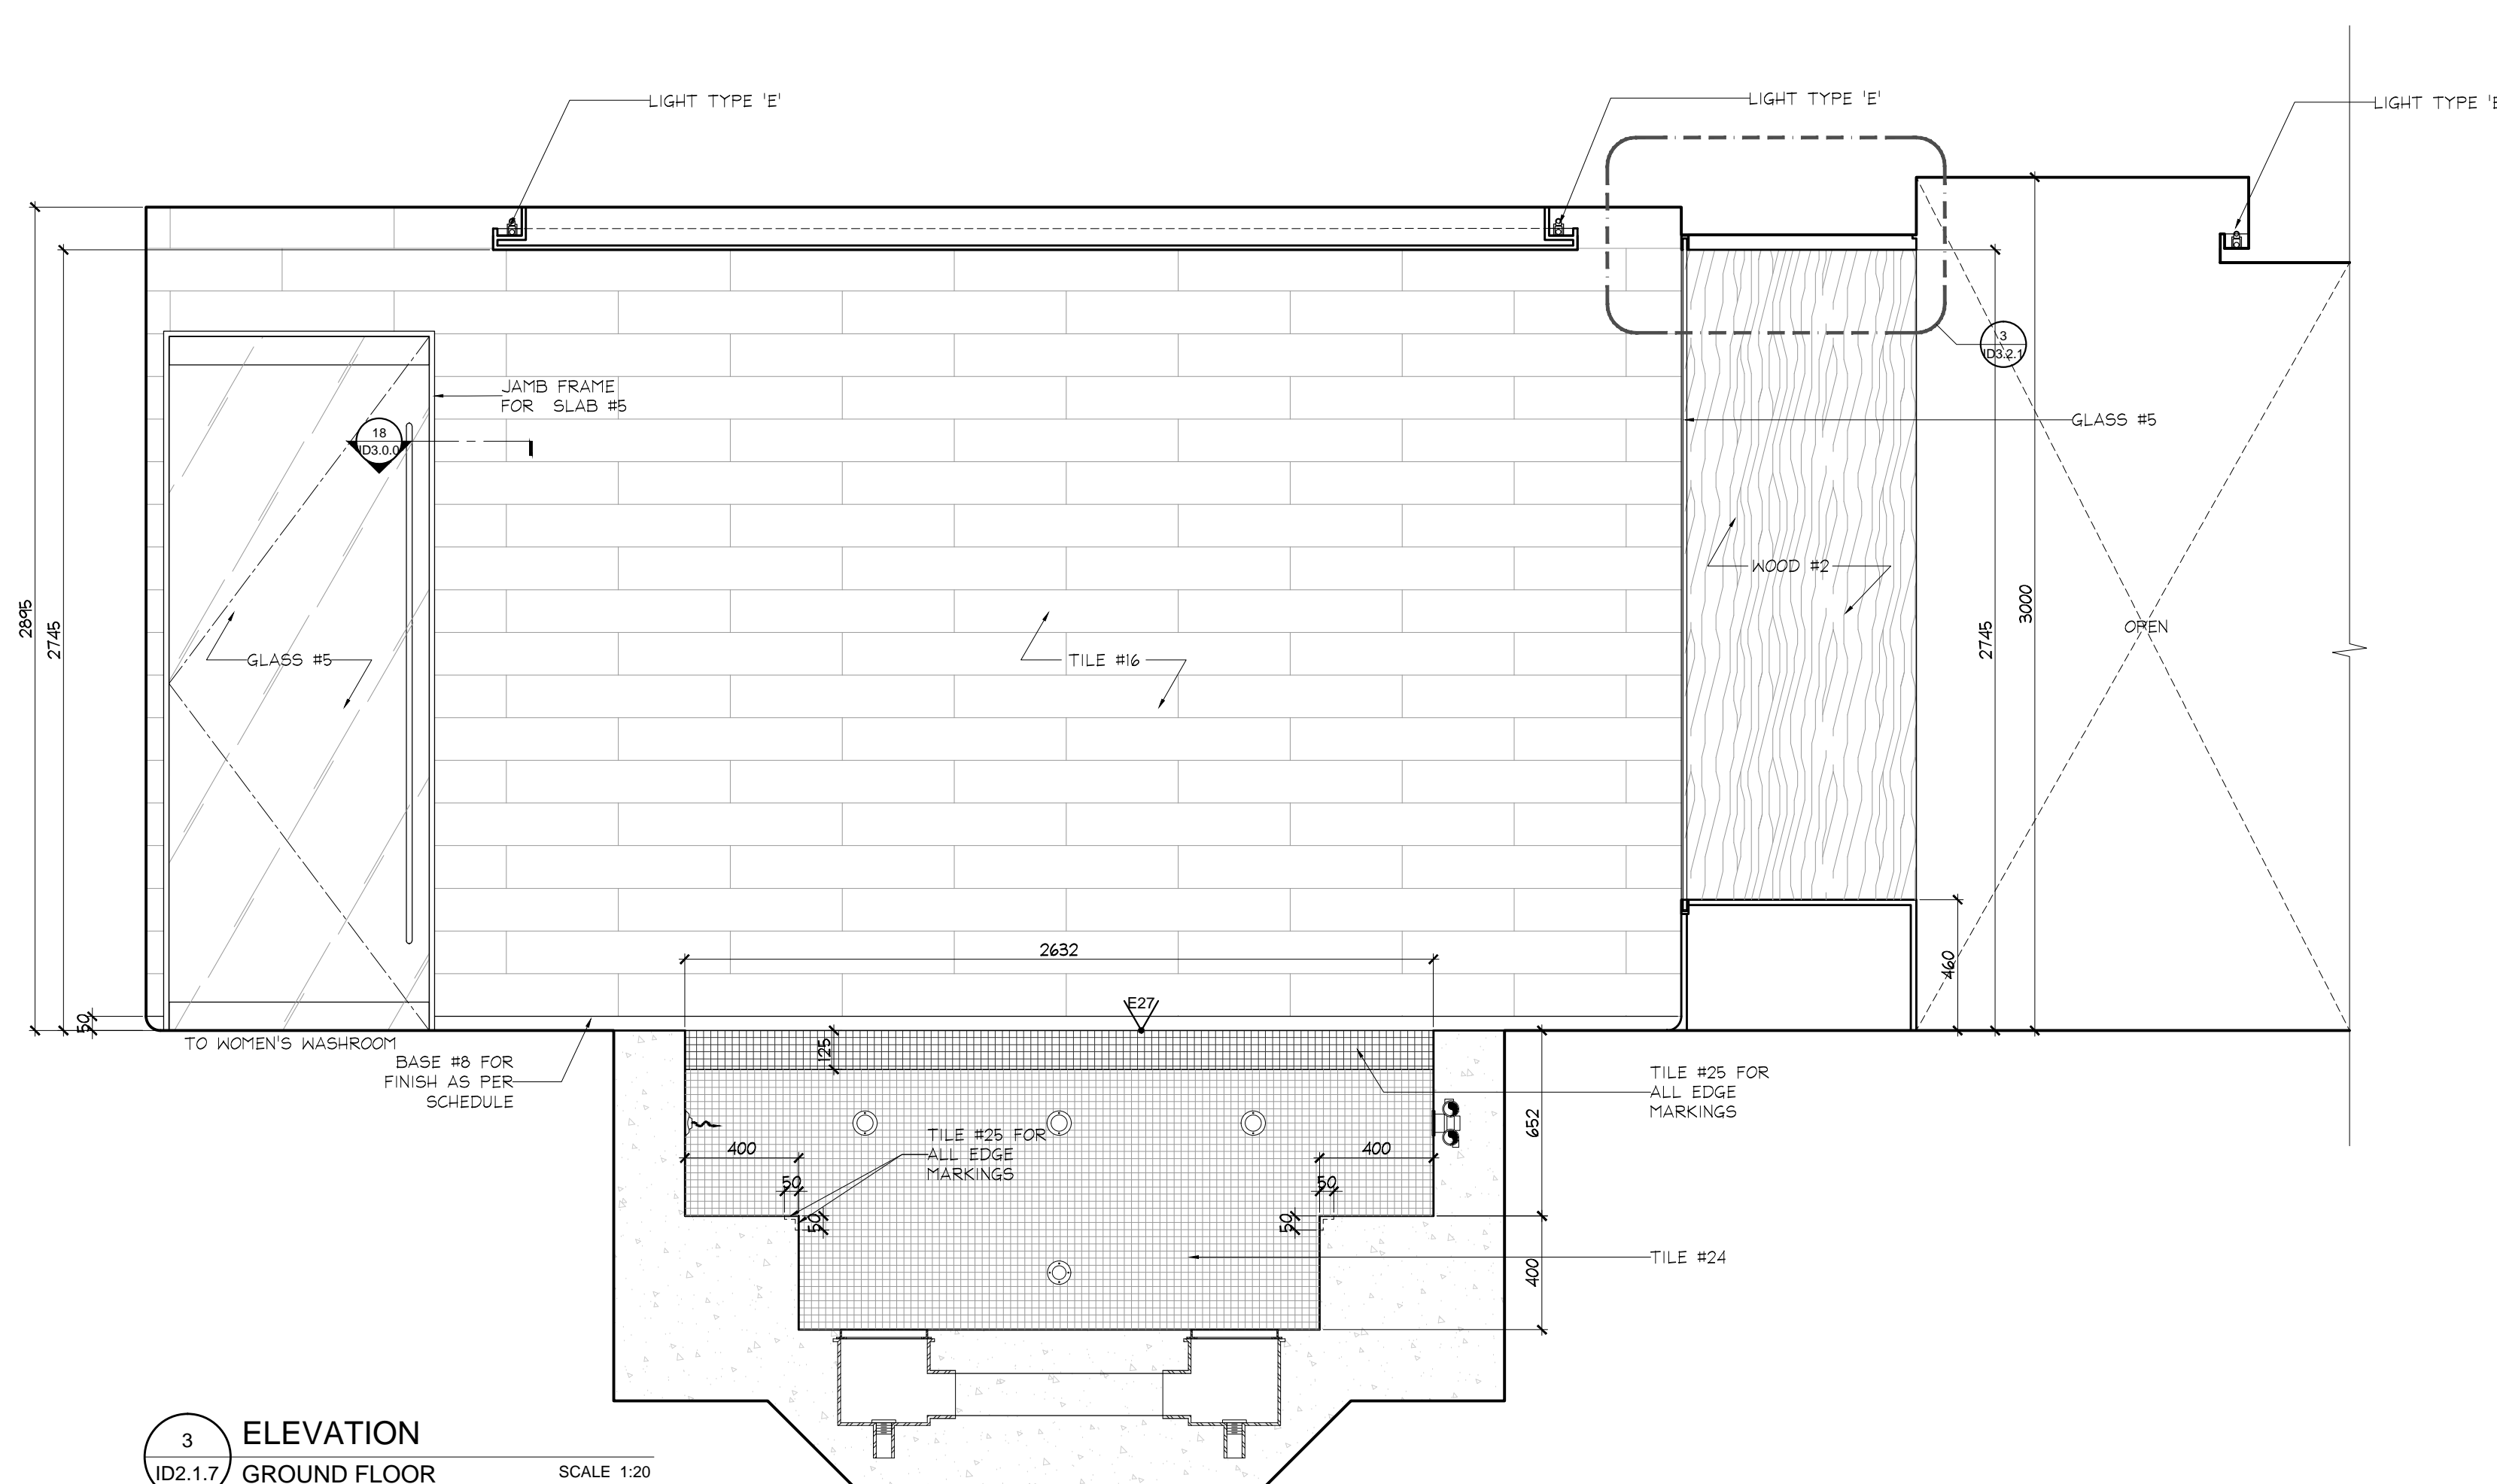


3 ELEVATION
GROUND FLOOR
WHIRLPOOL SPA
SCALE 1:20

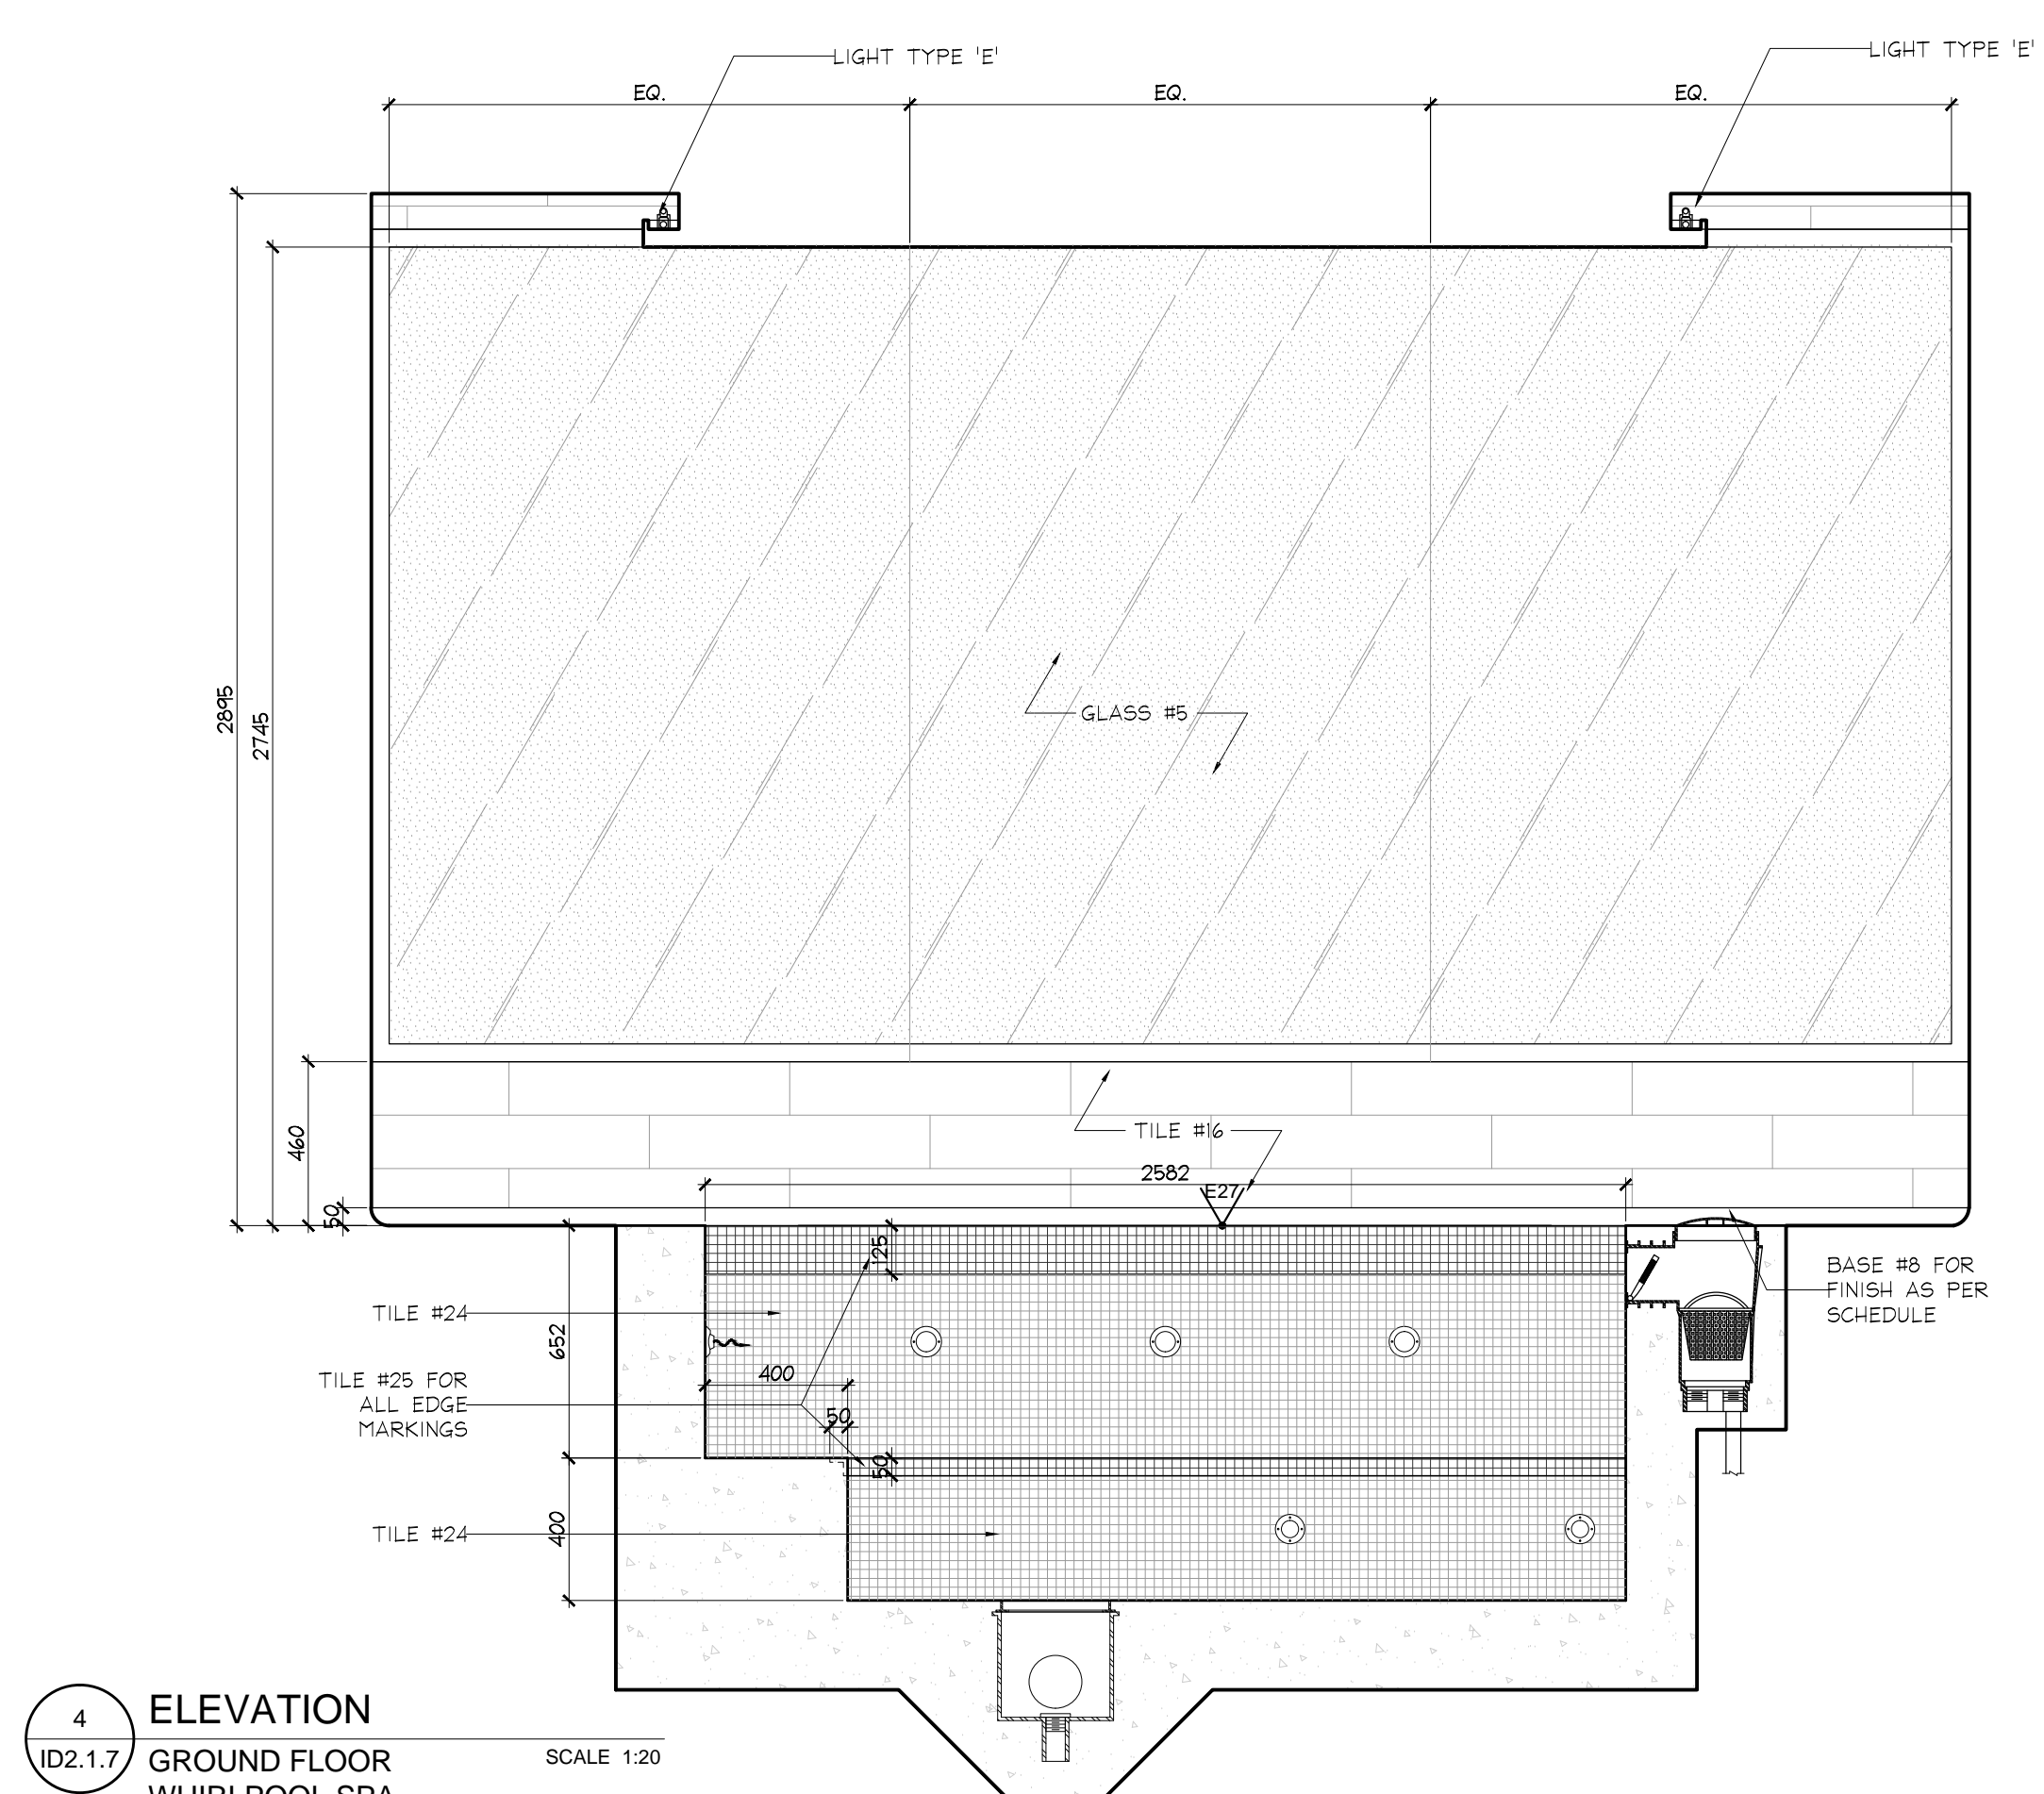


4 ELEVATION
GROUND FLOOR
WHIRLPOOL SPA
SCALE 1:20

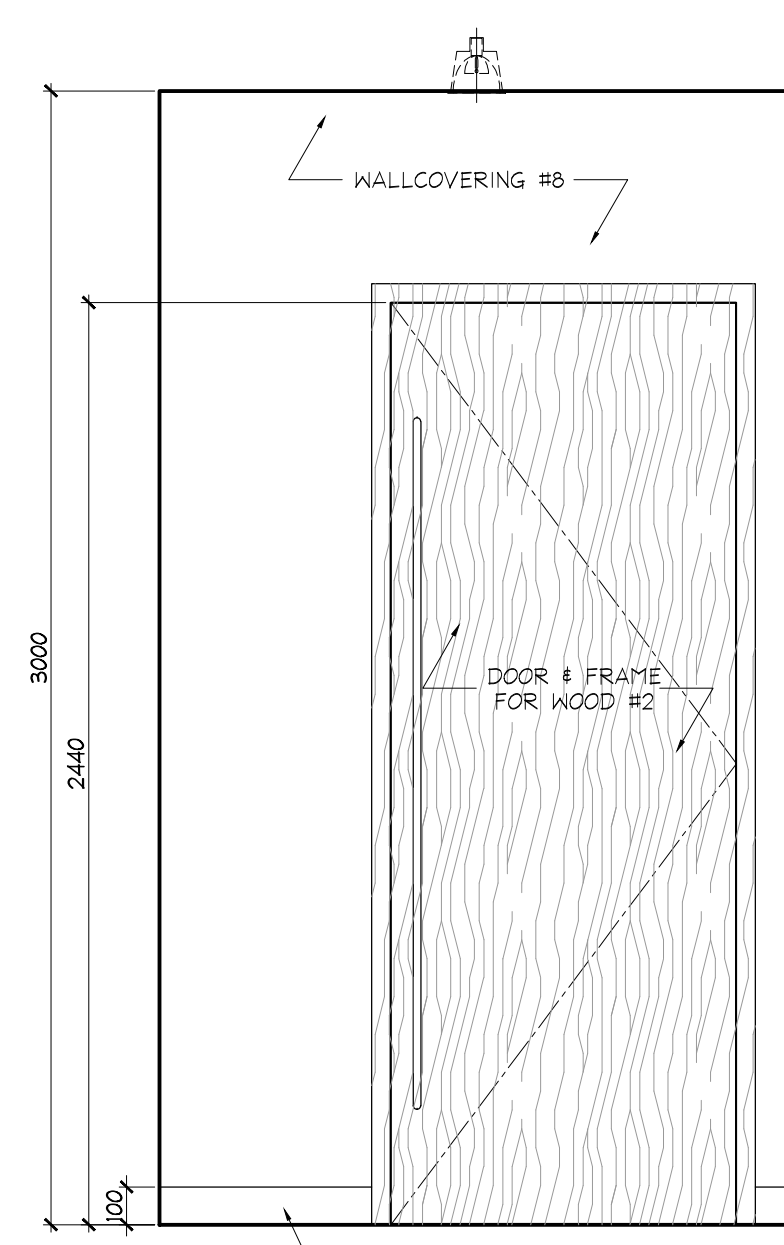


5 ELEVATION
GROUND FLOOR
WOMEN'S/ MEN'S W.R. VESTIBULE
SCALE 1:20

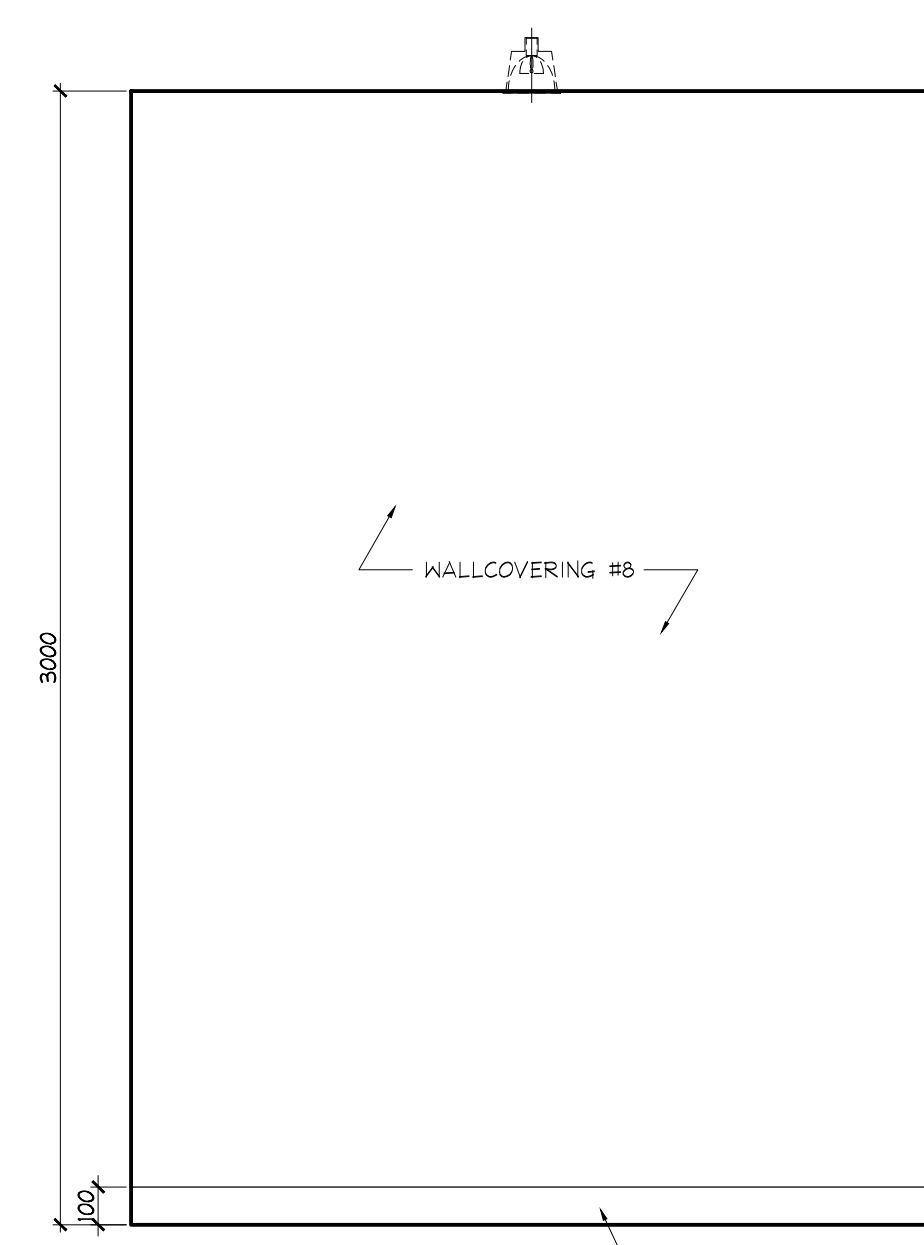

6 ELEVATION
GROUND FLOOR
WOMEN'S/ MEN'S W.R. VESTIBULE
SCALE 1:20

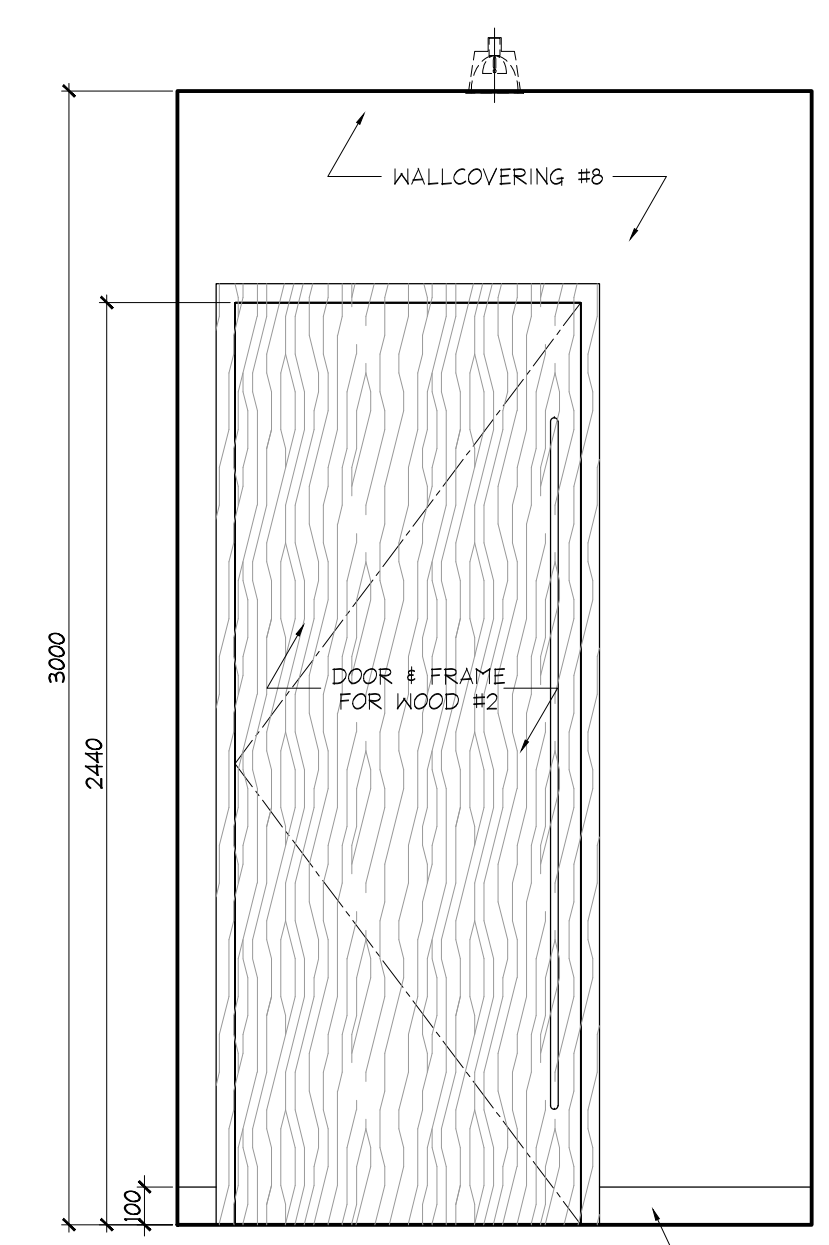

7 ELEVATION
GROUND FLOOR
WOMEN'S/ MEN'S W.R. VESTIBULE
SCALE 1:20

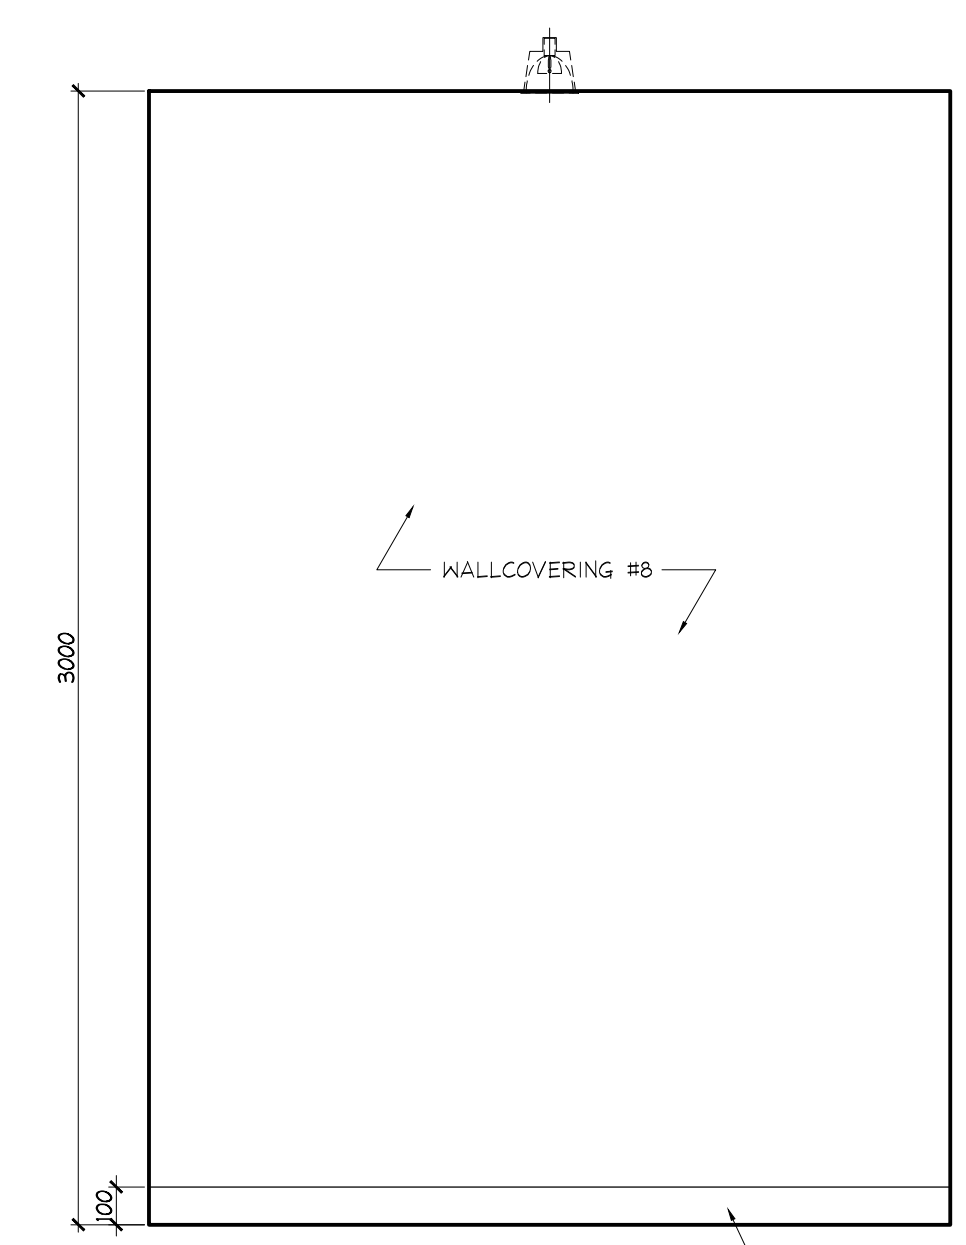

8 ELEVATION
GROUND FLOOR
WOMEN'S/ MEN'S W.R. VESTIBULE
SCALE 1:20

ISSUED FOR
AS-BUILT

01	31 MAY / 17	ISSUED FOR AS-BUILT	SV
NO.	DATE	COMMENTS	INI
REVISIONS:			

UNION 31
UNION31 INC.
183 BATHURST STREET, STE. 201
TORONTO, ON, M5T 2R7, CANADA
TEL: 416-597-1576 FAX: 416-597-2139

PROJECT NAME: ALEXANDRA PARK MAIN BUILDING	
BLOCK 11 ON, Canada	
PROJECT NO.: 13-949	DRAWINGS: GROUND FLOOR ELEVATIONS
DATE STARTED: 07 AUG / 13	DRAWING NO.: ID
SCALE: 1:20	2.1.7
DRAWN BY: AP	
APPROVED BY: KC	