



DO NOT SCALE DRAWINGS.

CONTRACTOR MUST VERIFY ALL DRAWINGS, DIMENSIONS, DETAILS AND SPECIFICATIONS, AND REPORT ANY DISCREPANCIES TO UNION31 INC. BEFORE PROCEEDING WITH WORK. MATERIALS MAY NOT BE SUBSTITUTED WITHOUT WRITTEN APPROVAL FROM UNION31 INC.  
ALL DRAWINGS AND SPECIFICATIONS ARE INSTRUMENTS OF SERVICE AND THE PROPERTY OF UNION31 INC. WHICH MUST BE RETURNED AT THE COMPLETION OF THE WORK.


PRINTED: 30-May-17

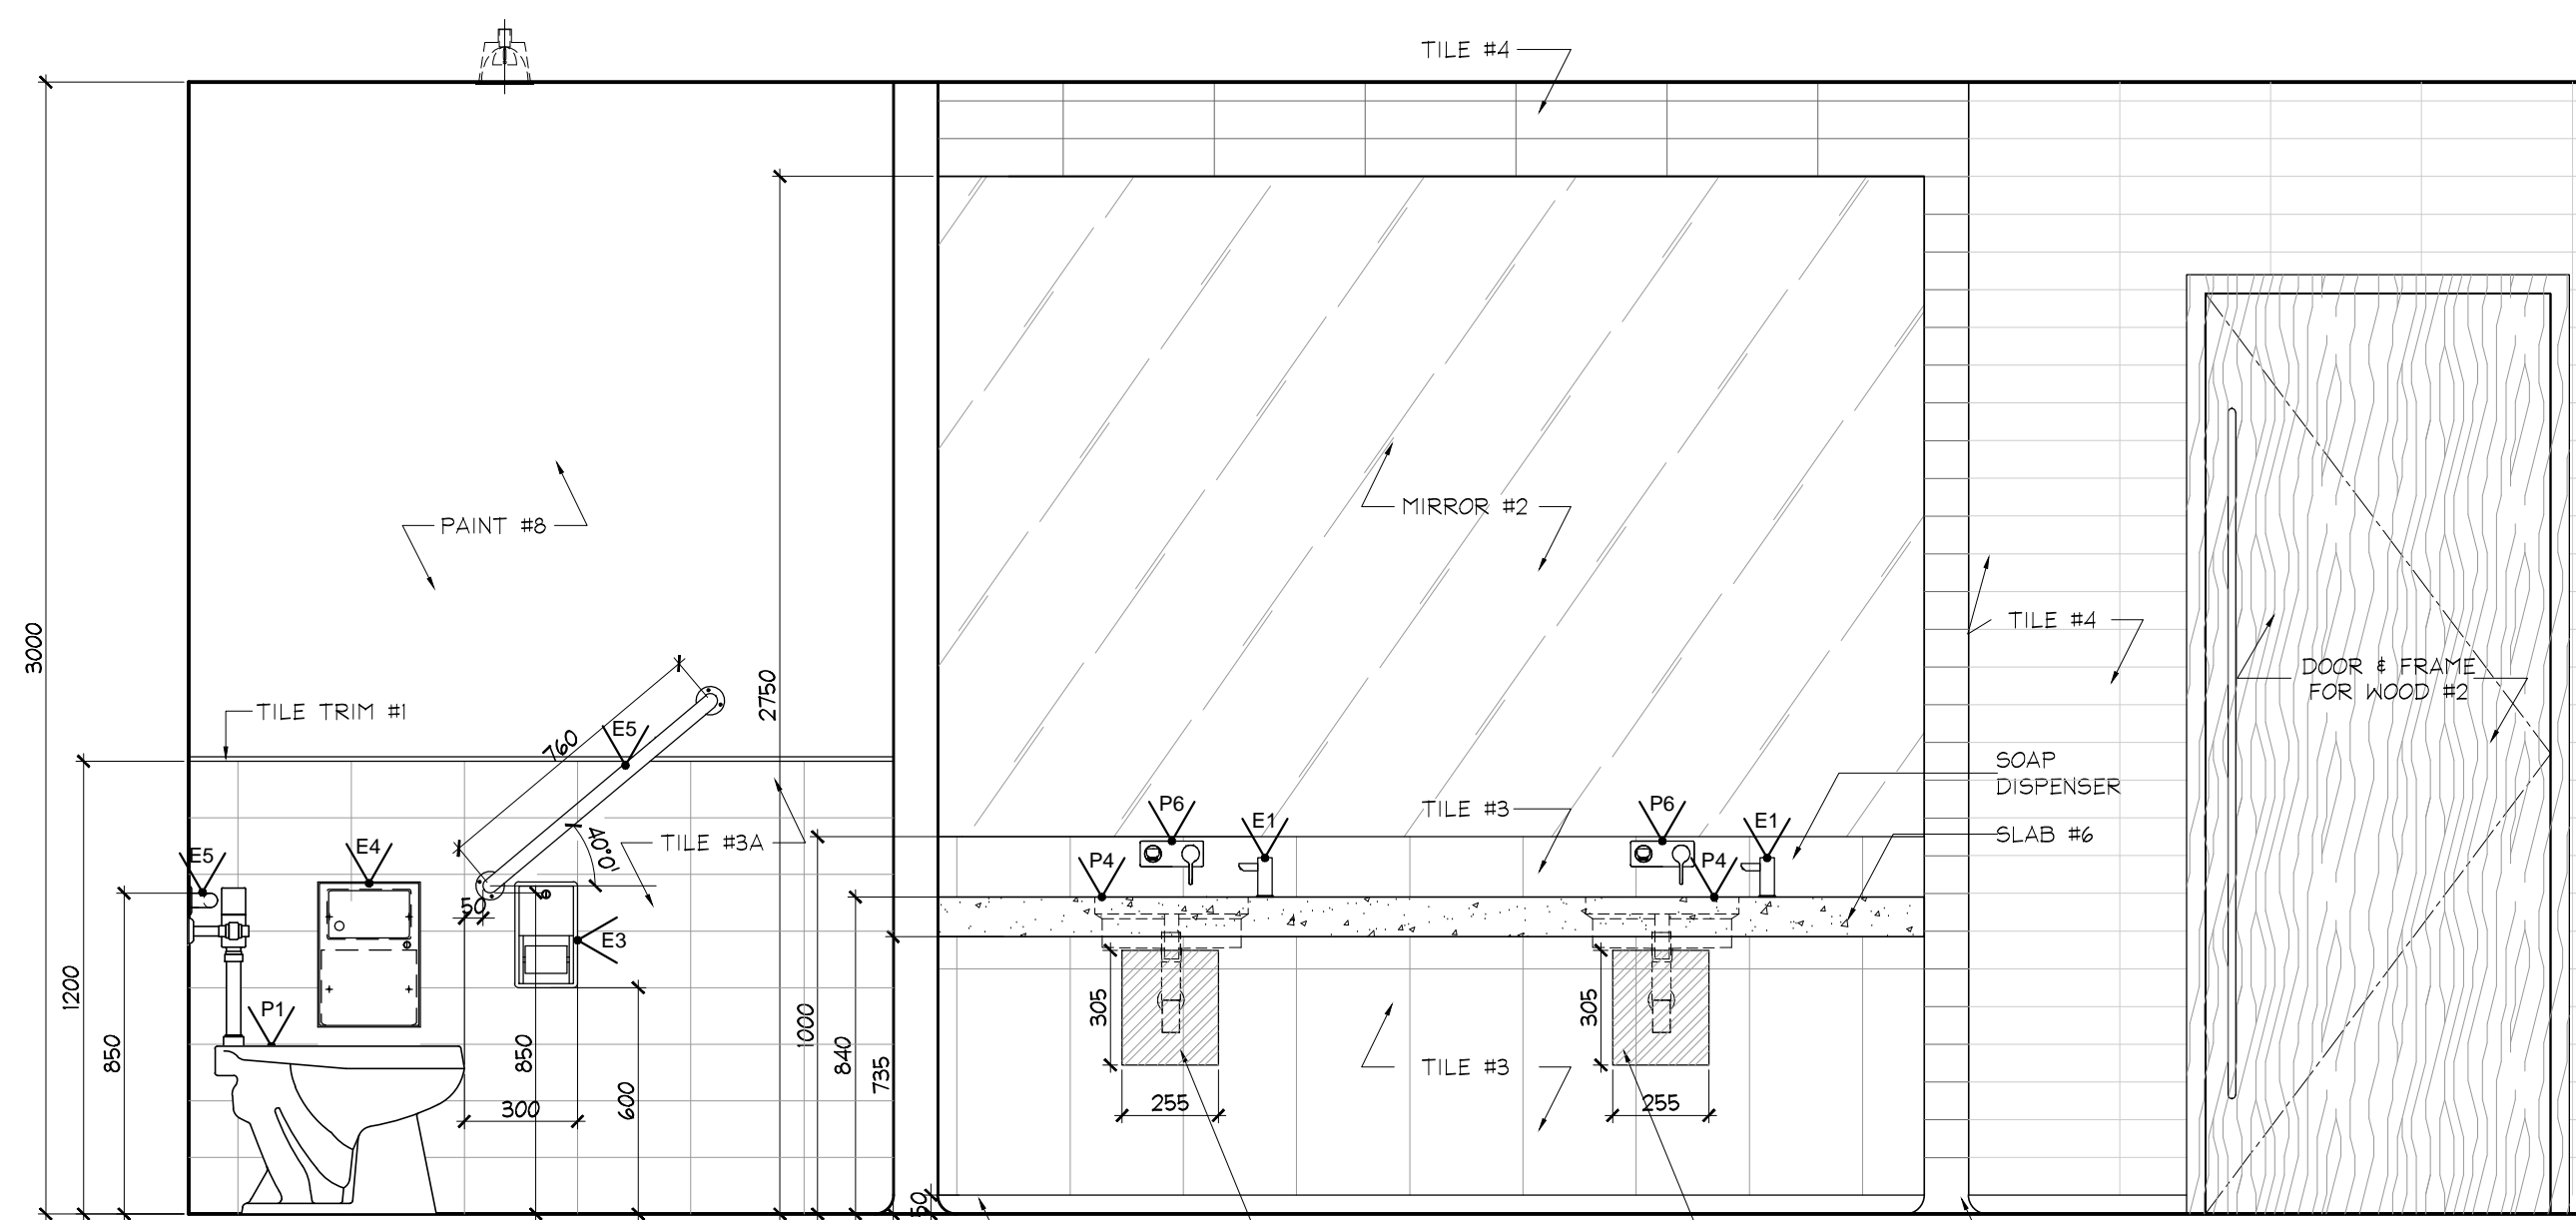


1 ELEVATION  
ID2.1.8 GROUND FLOOR  
WOMEN'S CHANGE ROOM  
SCALE 1:20

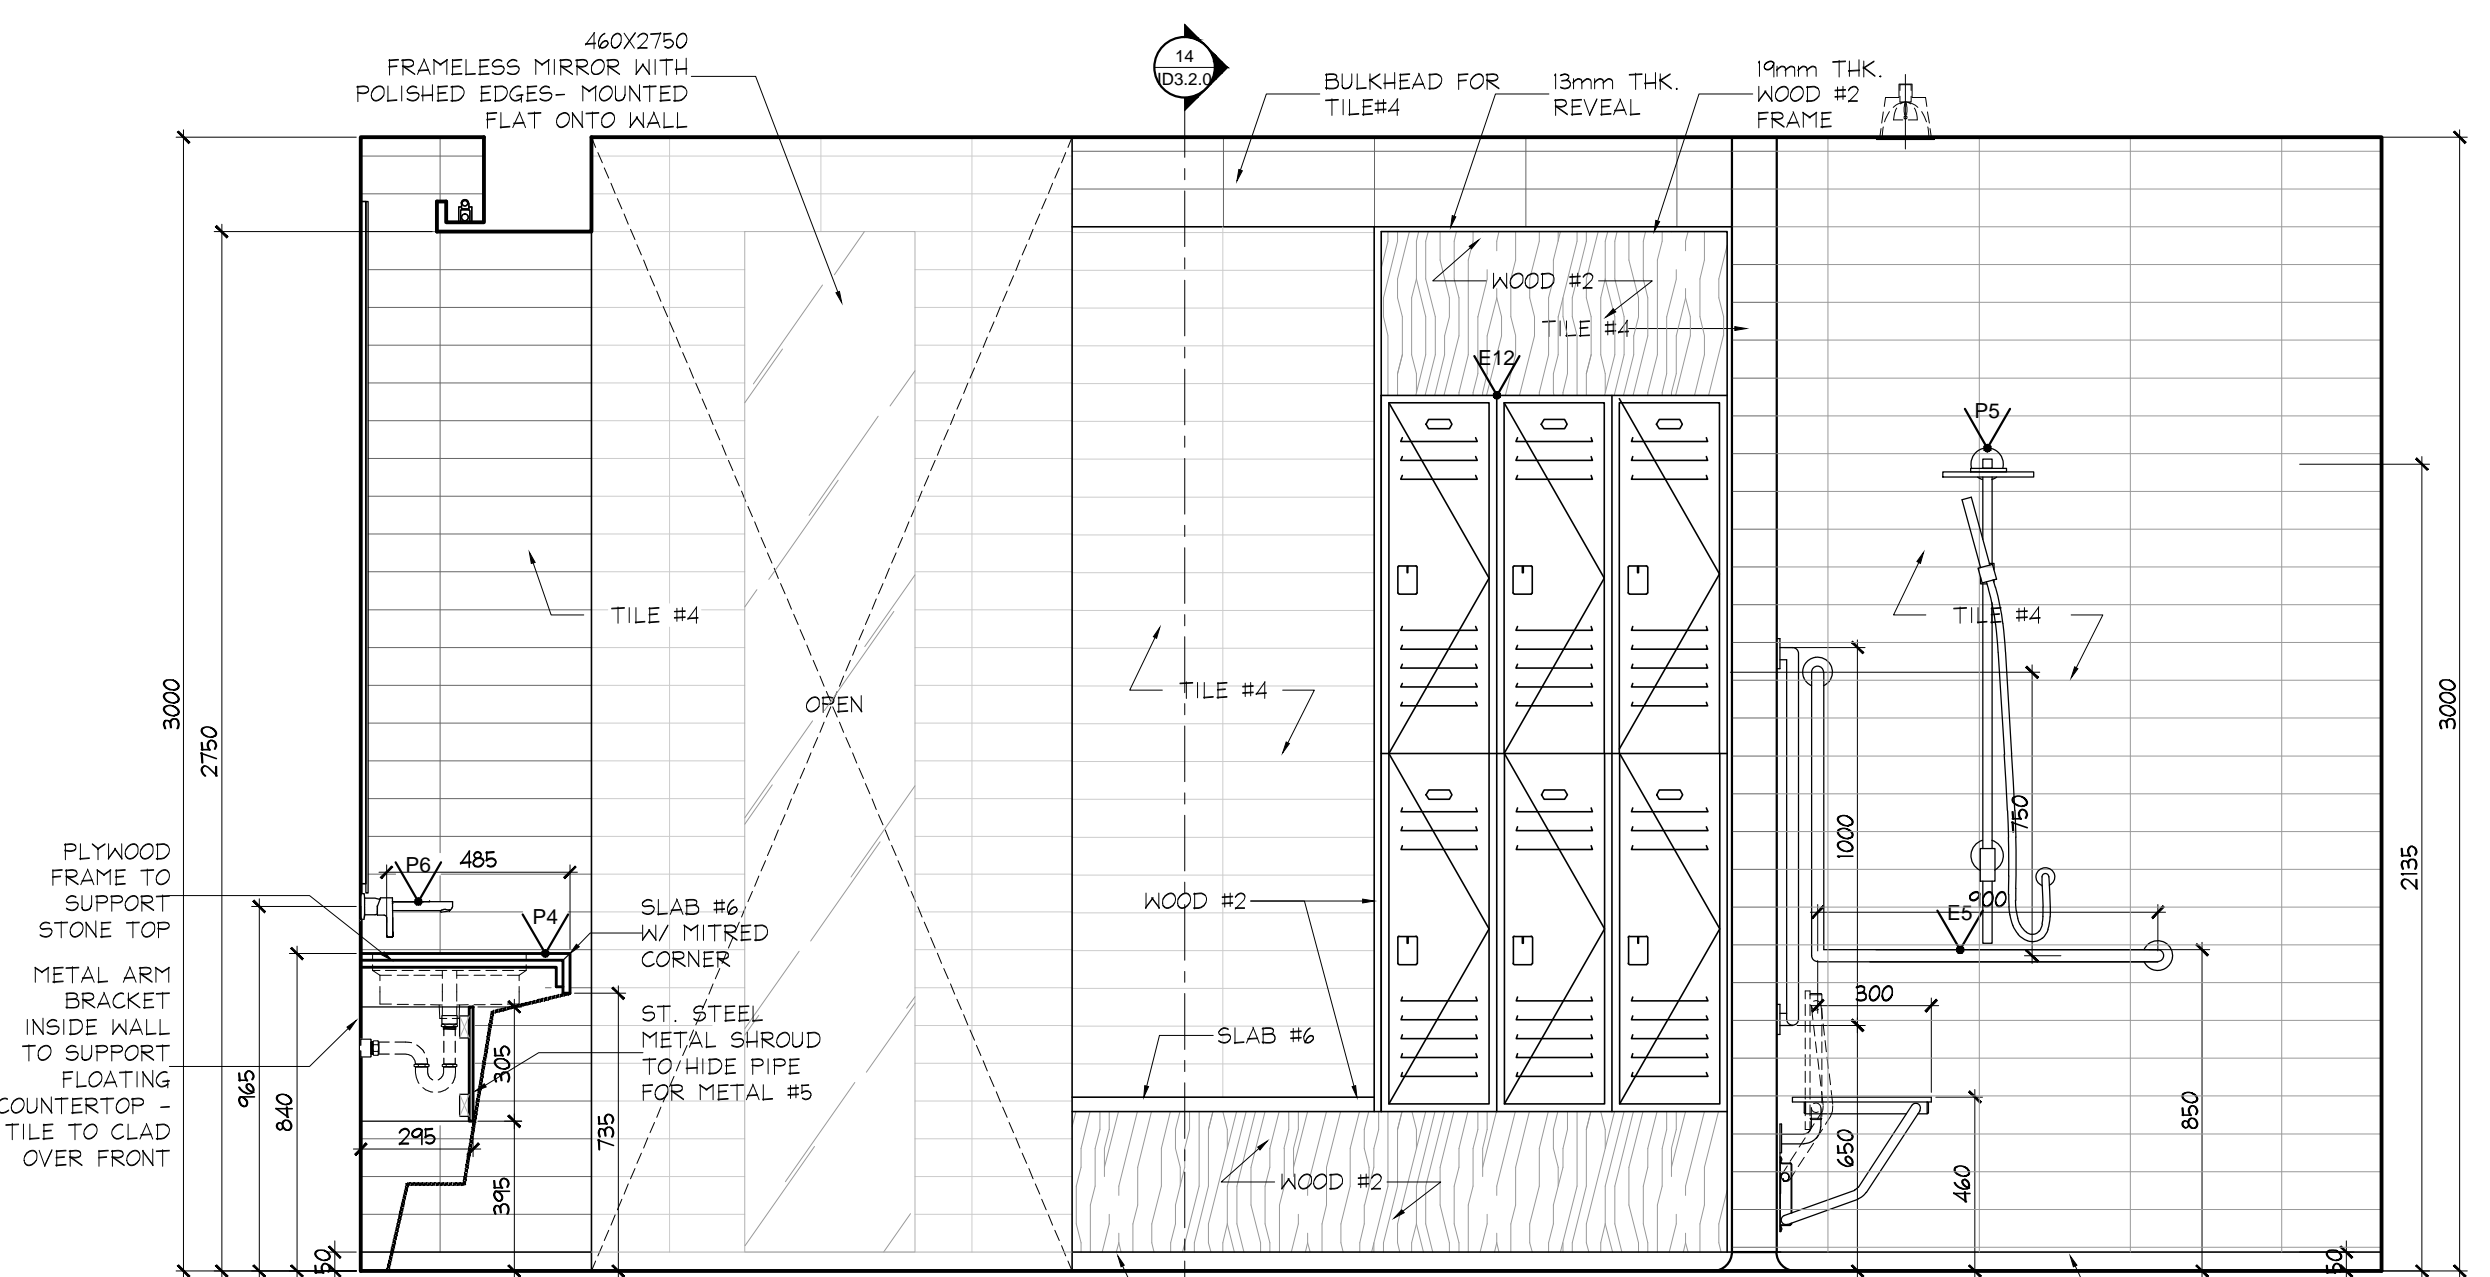


2 ELEVATION  
ID2.1.8 GROUND FLOOR  
WOMEN'S CHANGE ROOM  
SCALE 1:20

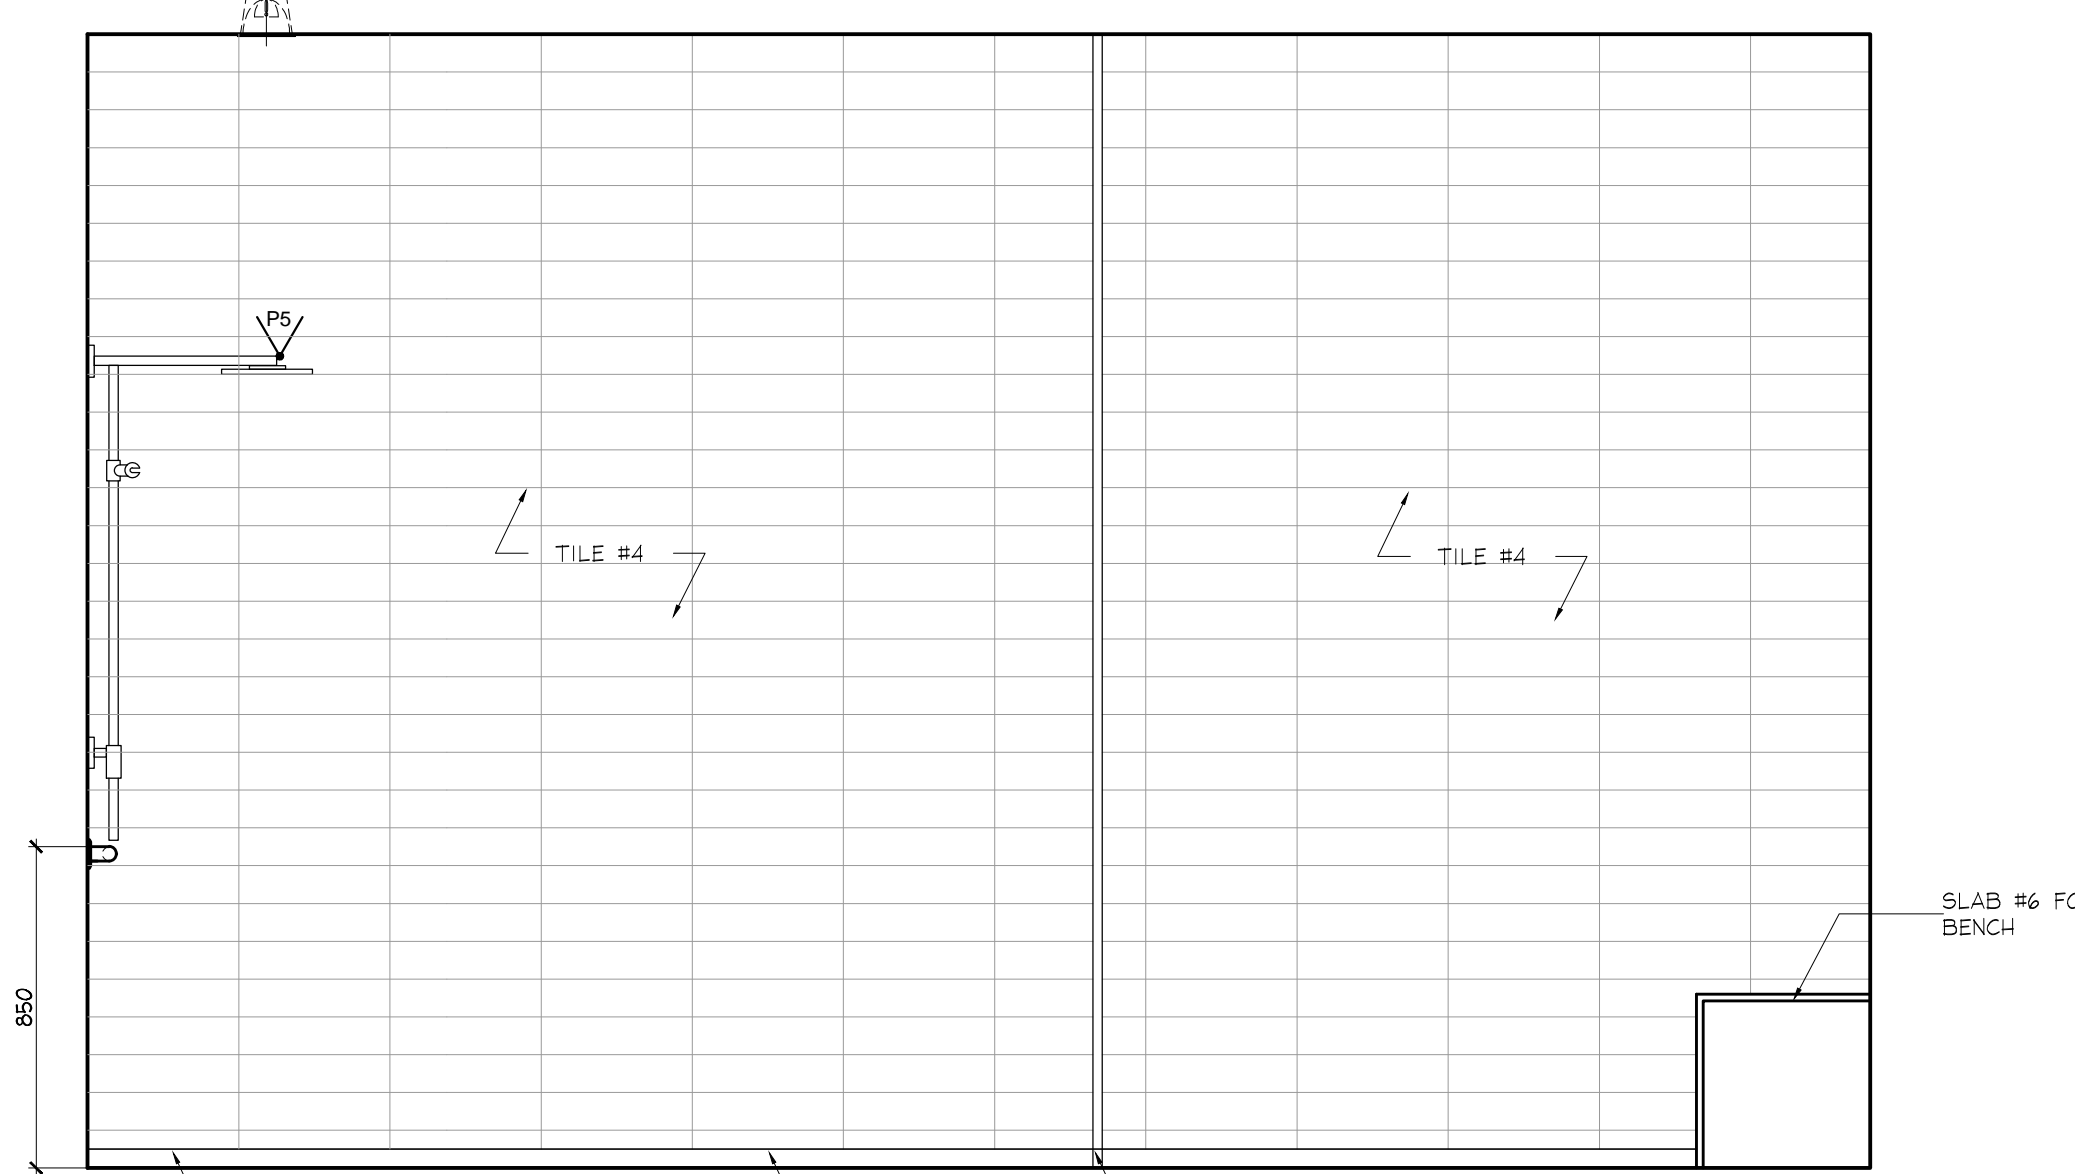


3 ELEVATION  
ID2.1.8 GROUND FLOOR  
WOMEN'S CHANGE ROOM  
SCALE 1:20

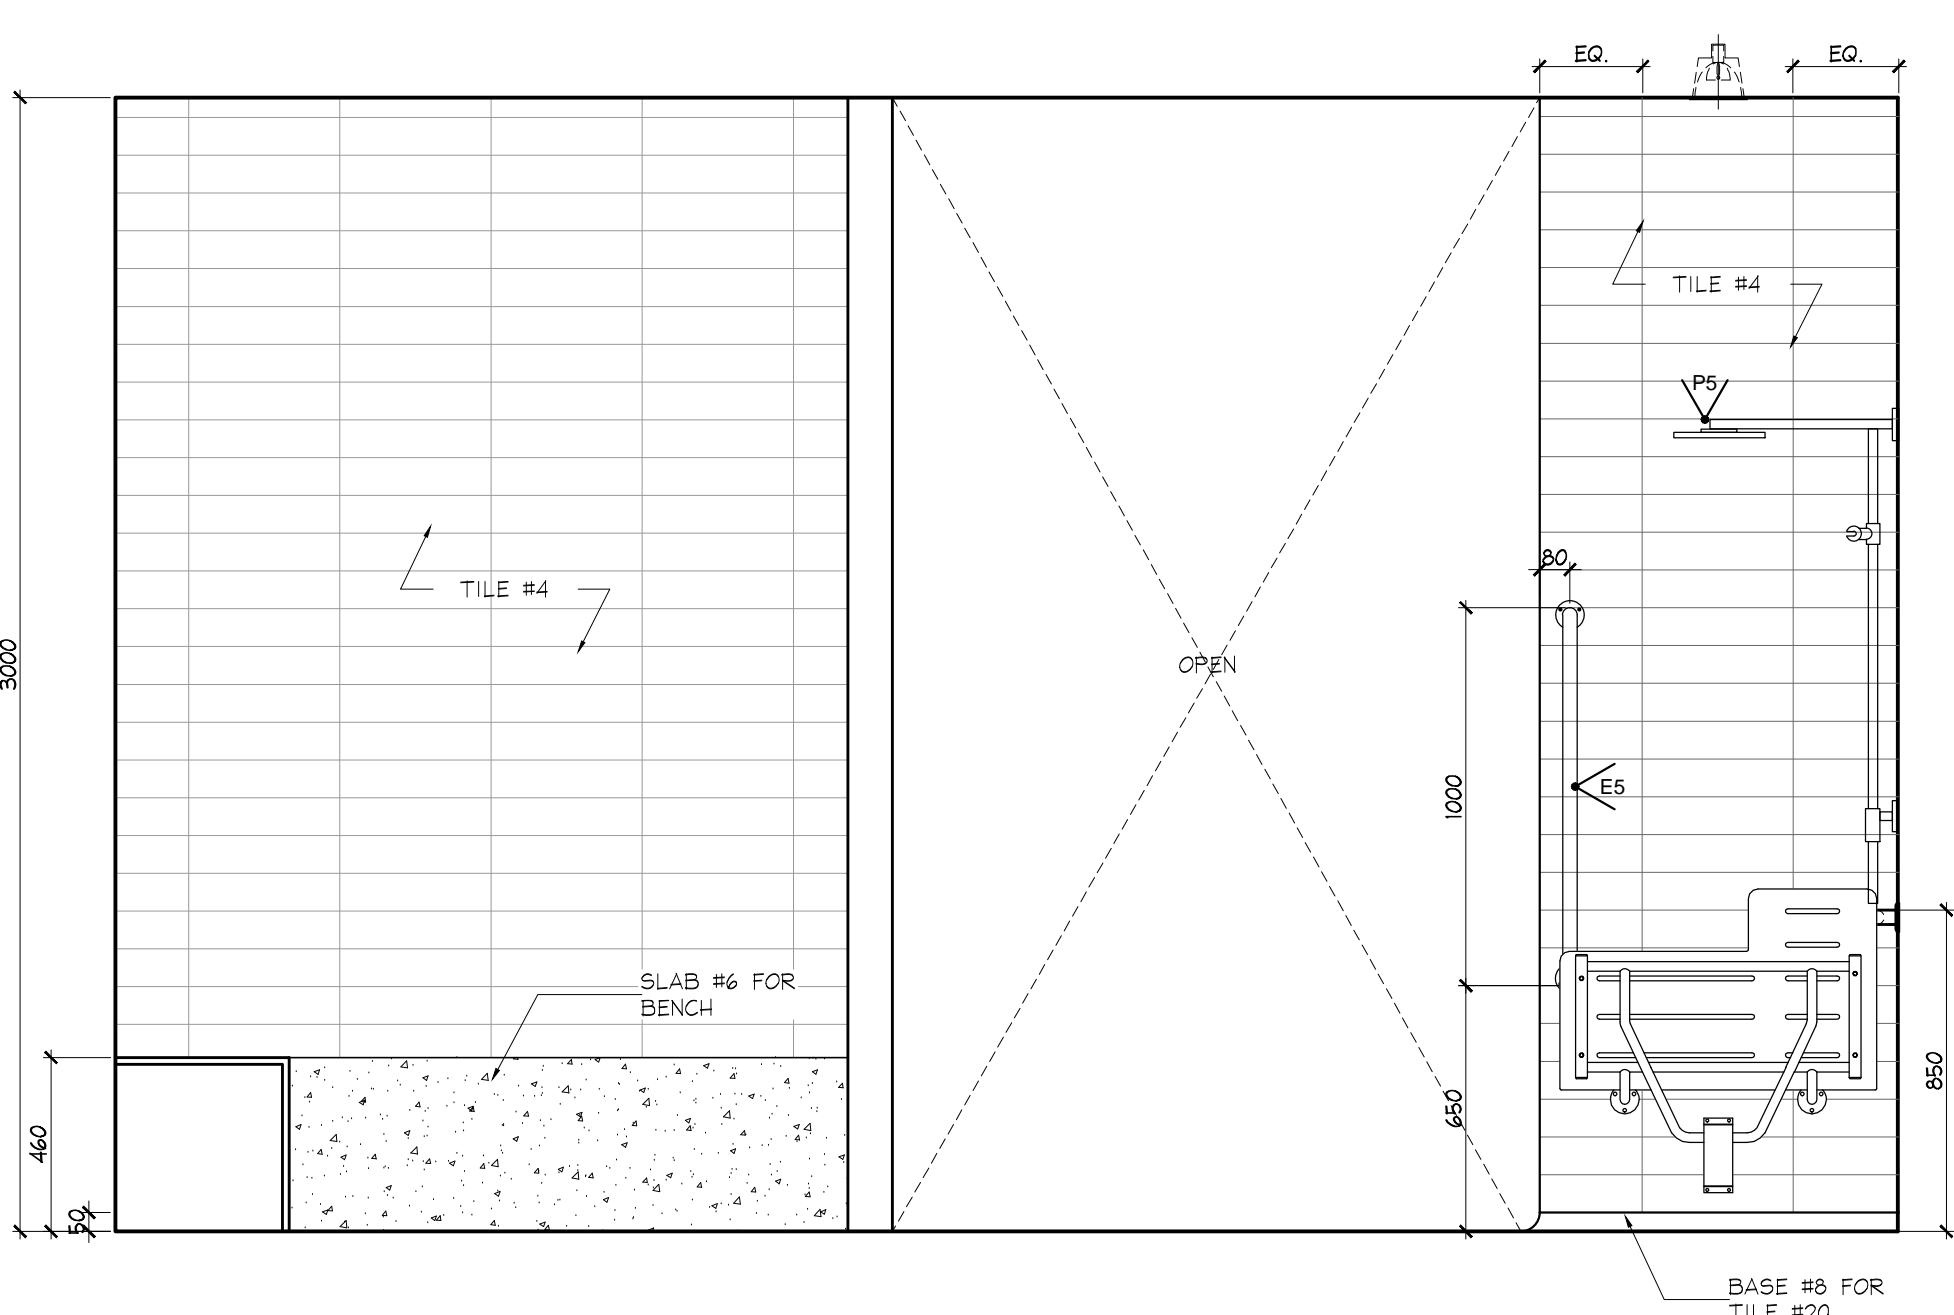


4 ELEVATION  
ID2.1.8 GROUND FLOOR  
WOMEN'S CHANGE ROOM  
SCALE 1:20

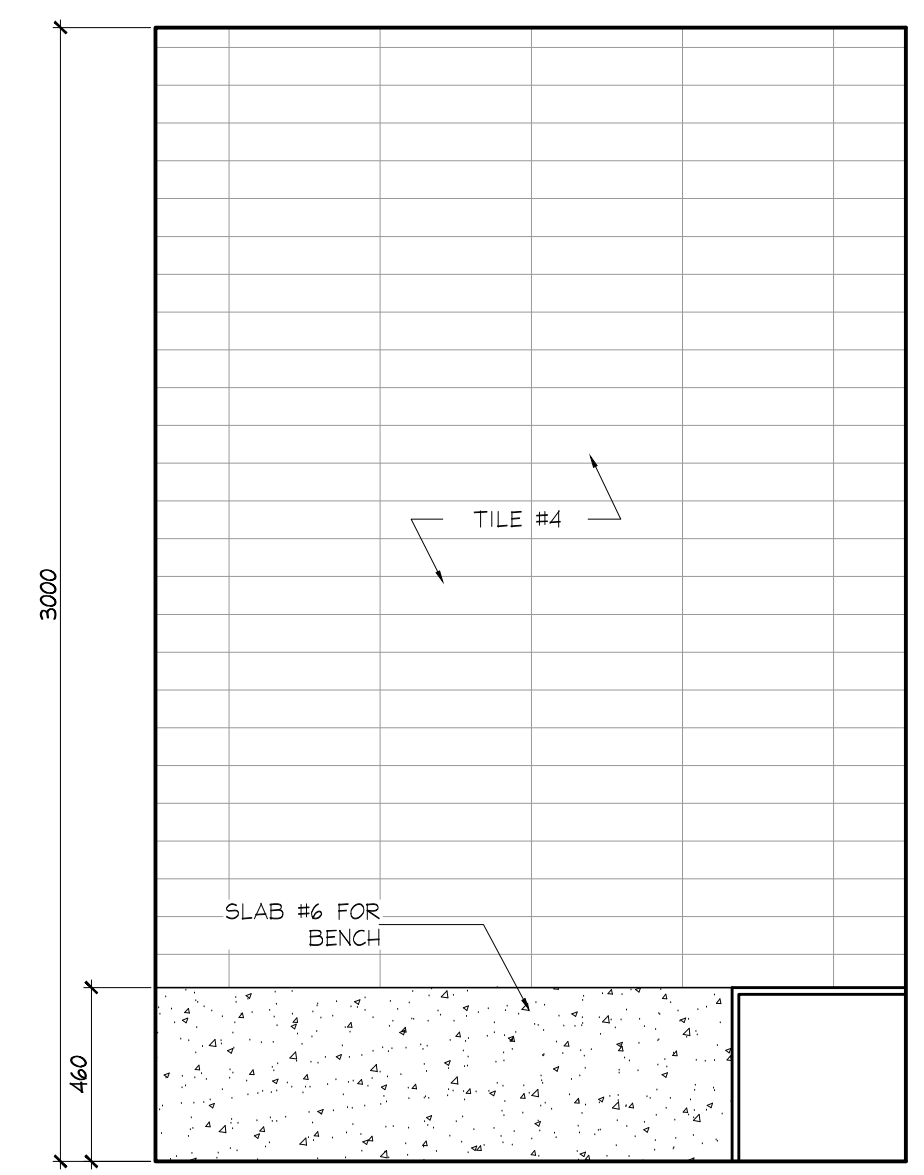


5 ELEVATION  
ID2.1.8 GROUND FLOOR  
WOMEN'S CHANGE ROOM - STEAM  
SCALE 1:20

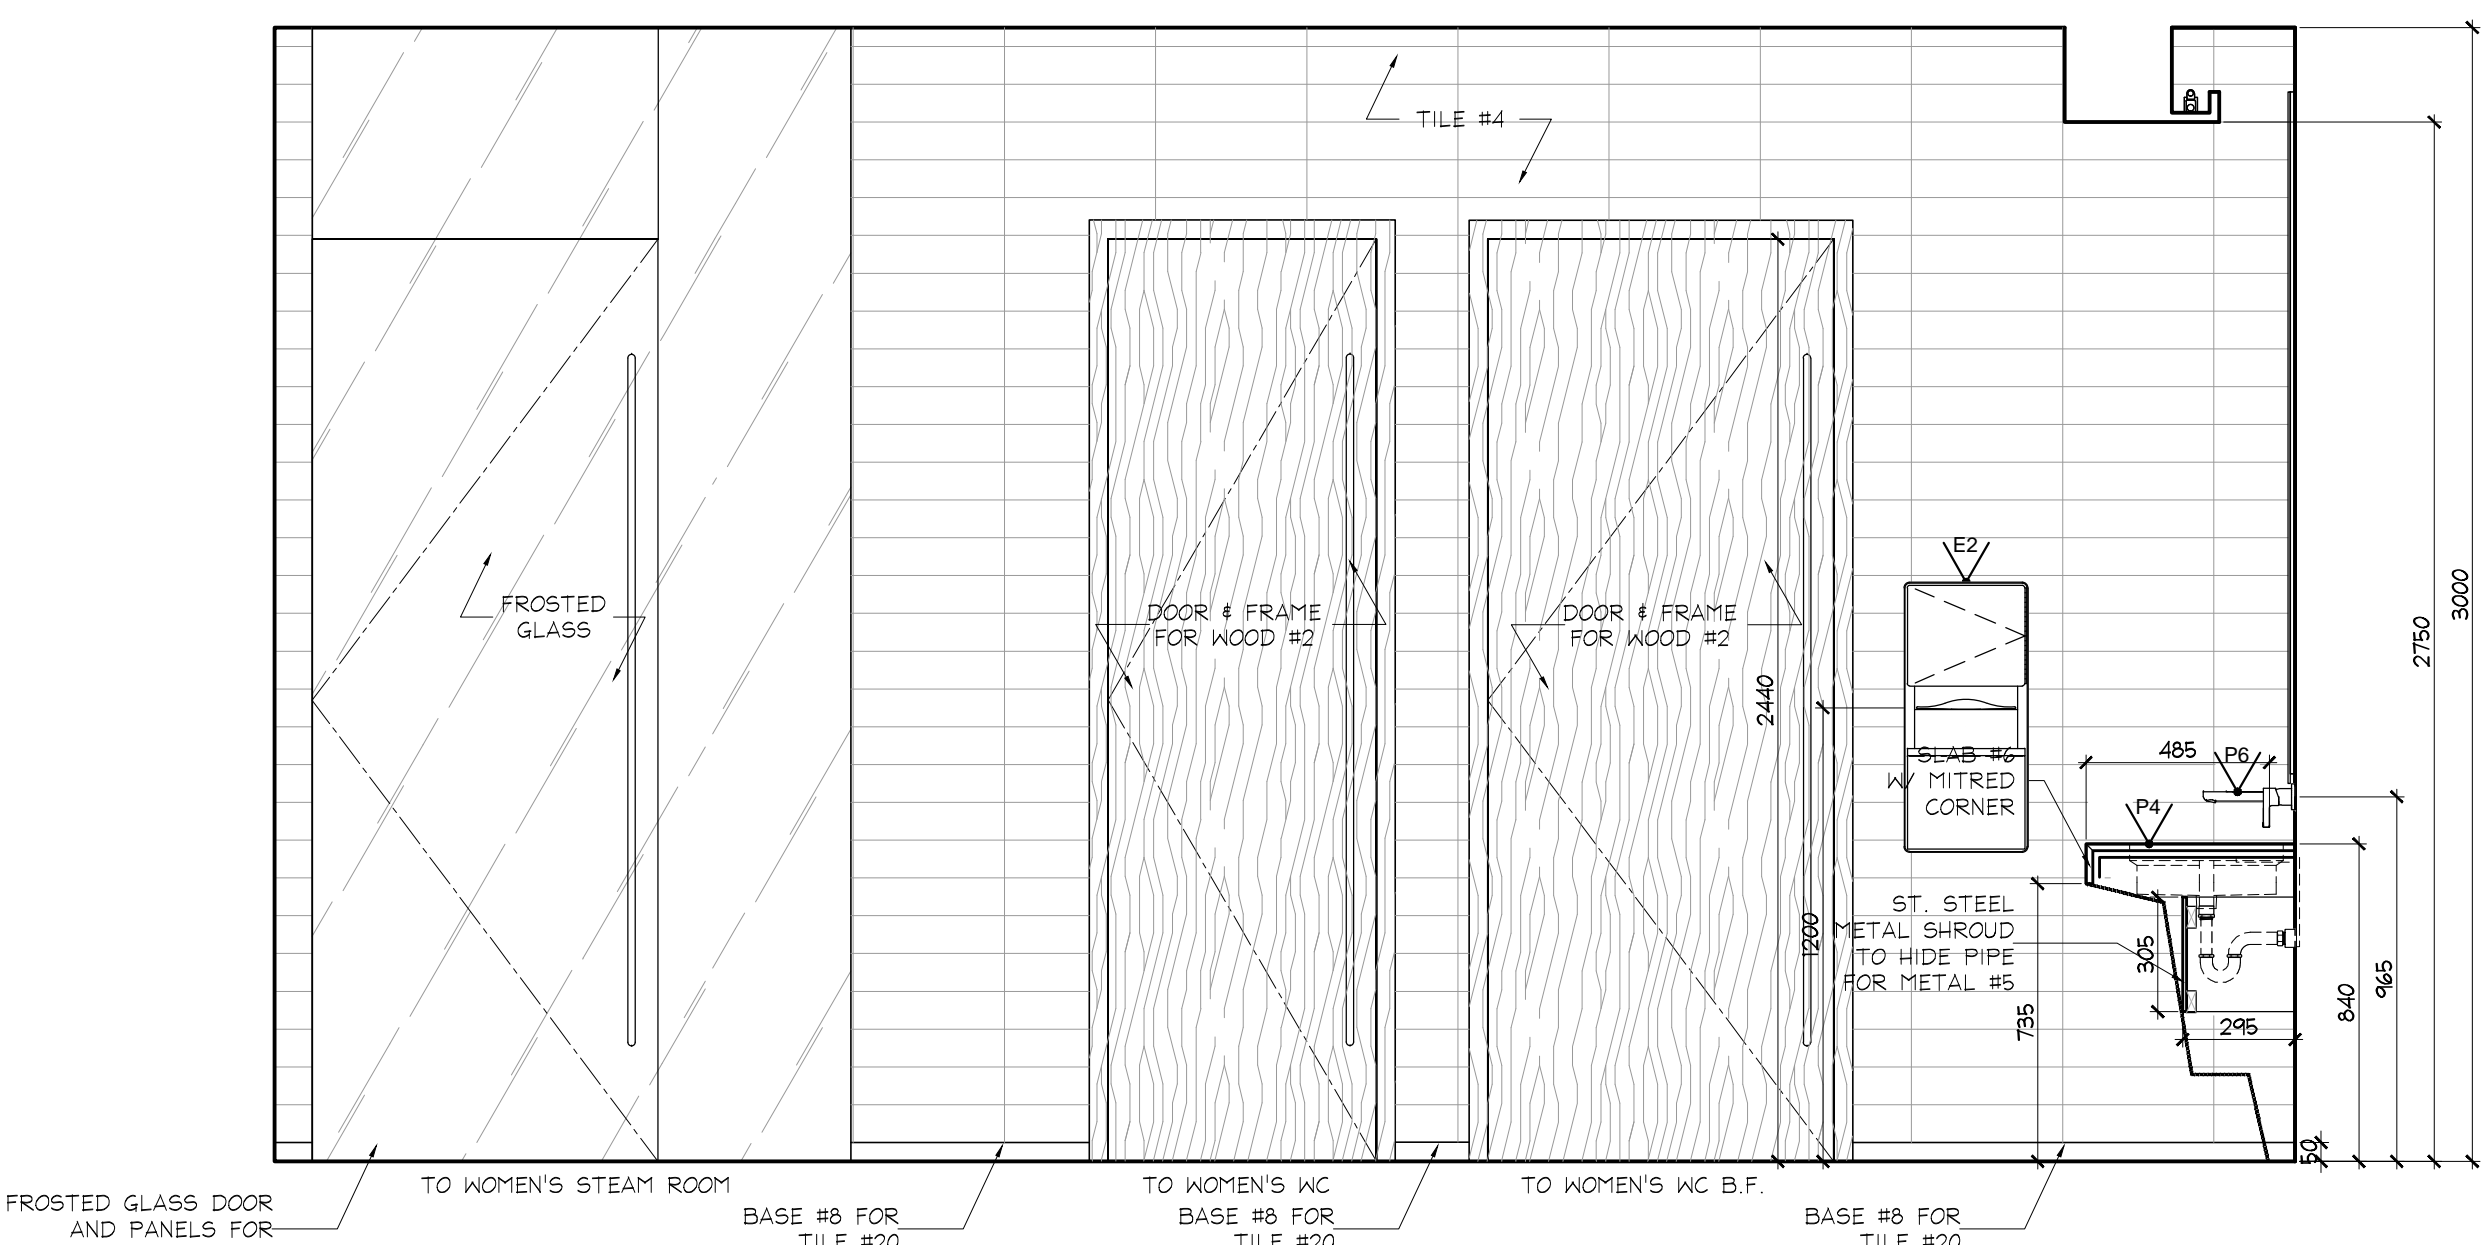

6 ELEVATION  
ID2.1.8 GROUND FLOOR  
WOMEN'S CHANGE ROOM  
SCALE 1:20

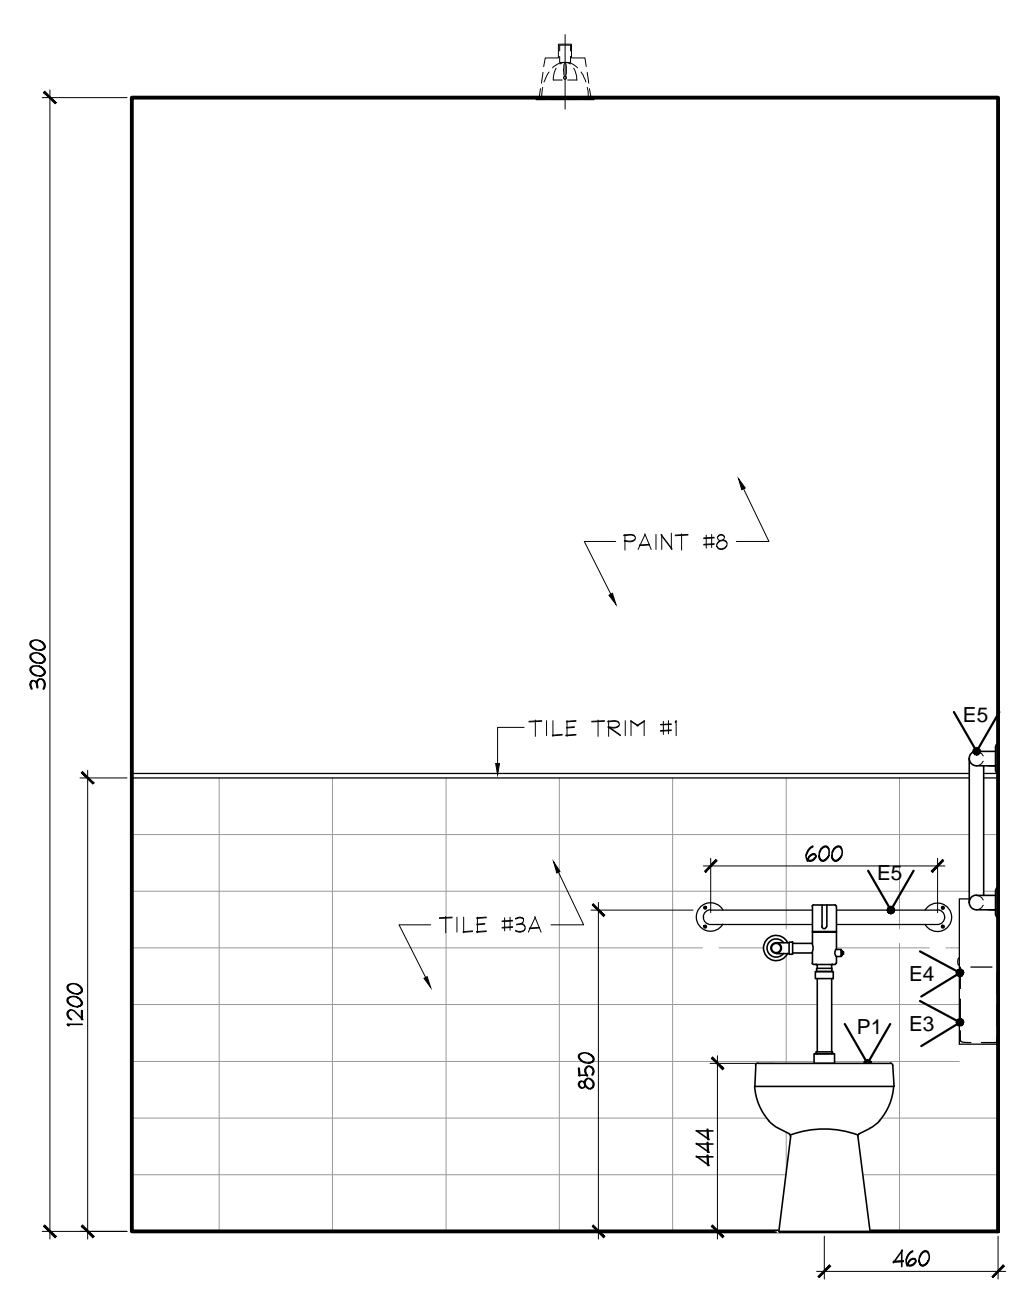

7 ELEVATION  
ID2.1.8 GROUND FLOOR  
WOMEN'S CHANGE ROOM  
SCALE 1:20

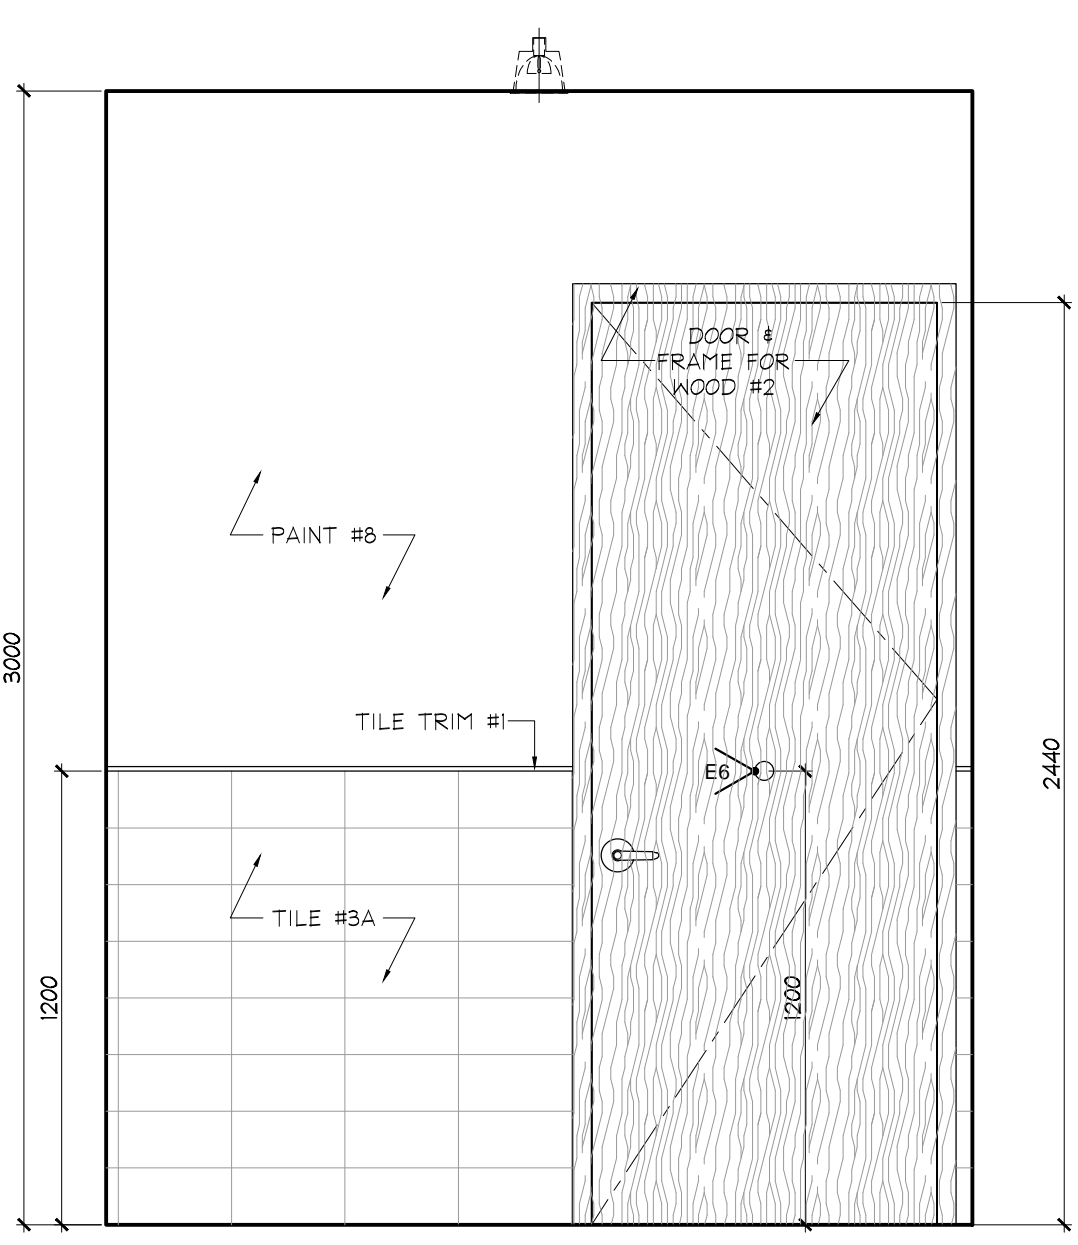

8 ELEVATION  
ID2.1.8 GROUND FLOOR  
WOMEN'S CHANGE ROOM  
SCALE 1:20

ISSUED FOR  
AS-BUILT

NO	DATE	COMMENTS	INI
01	31 MAY / 17	ISSUED FOR AS-BUILT	SV
REVISIONS:			

UNION31  
PROJECT NAME:  
**ALEXANDRA PARK  
MAIN BUILDING**  
BLOCK 11  
ON, Canada  
PROJECT NO.:  
13-949  
DRAWINGS:  
**GROUND FLOOR  
ELEVATIONS**  
DATE STARTED: 07 AUG / 13  
SCALE: 1:20  
DRAWN BY: AP  
APPROVED BY: KC  
DRAWING NO.:  
**ID  
2.1.8**