



DO NOT SCALE DRAWINGS.

CONTRACTOR MUST VERIFY ALL DRAWINGS, DIMENSIONS, DETAILS AND SPECIFICATIONS, AND REPORT ANY DISCREPANCIES TO UNION 31 INC. BEFORE PROCEEDING WITH WORK. MATERIALS MAY NOT BE SUBSTITUTED WITHOUT WRITTEN APPROVAL FROM UNION 31 INC.
ALL DRAWINGS AND SPECIFICATIONS ARE INSTRUMENTS OF SERVICE AND THE PROPERTY OF UNION 31 INC. WHICH MUST BE RETURNED AT THE COMPLETION OF THE WORK.


PRINTED: 30-May-17

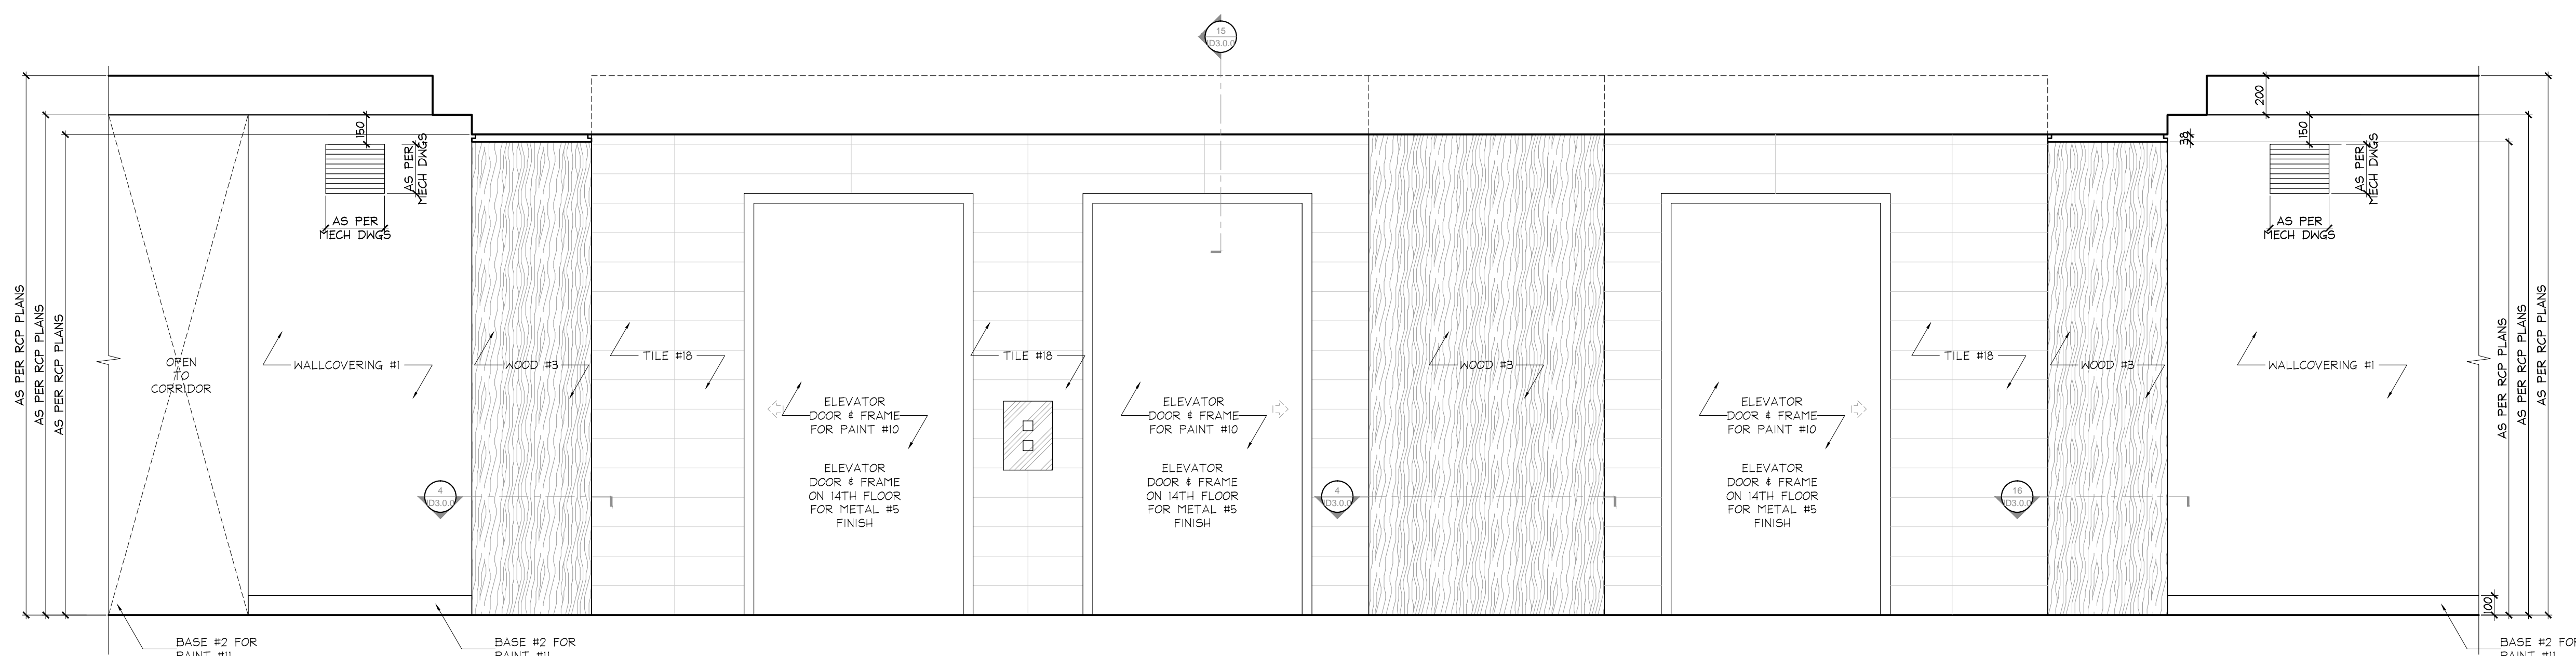

1 ELEVATION
ID2.3.0 TYPICAL CORRIDOR
ELEVATOR LOBBY SCALE 1:20

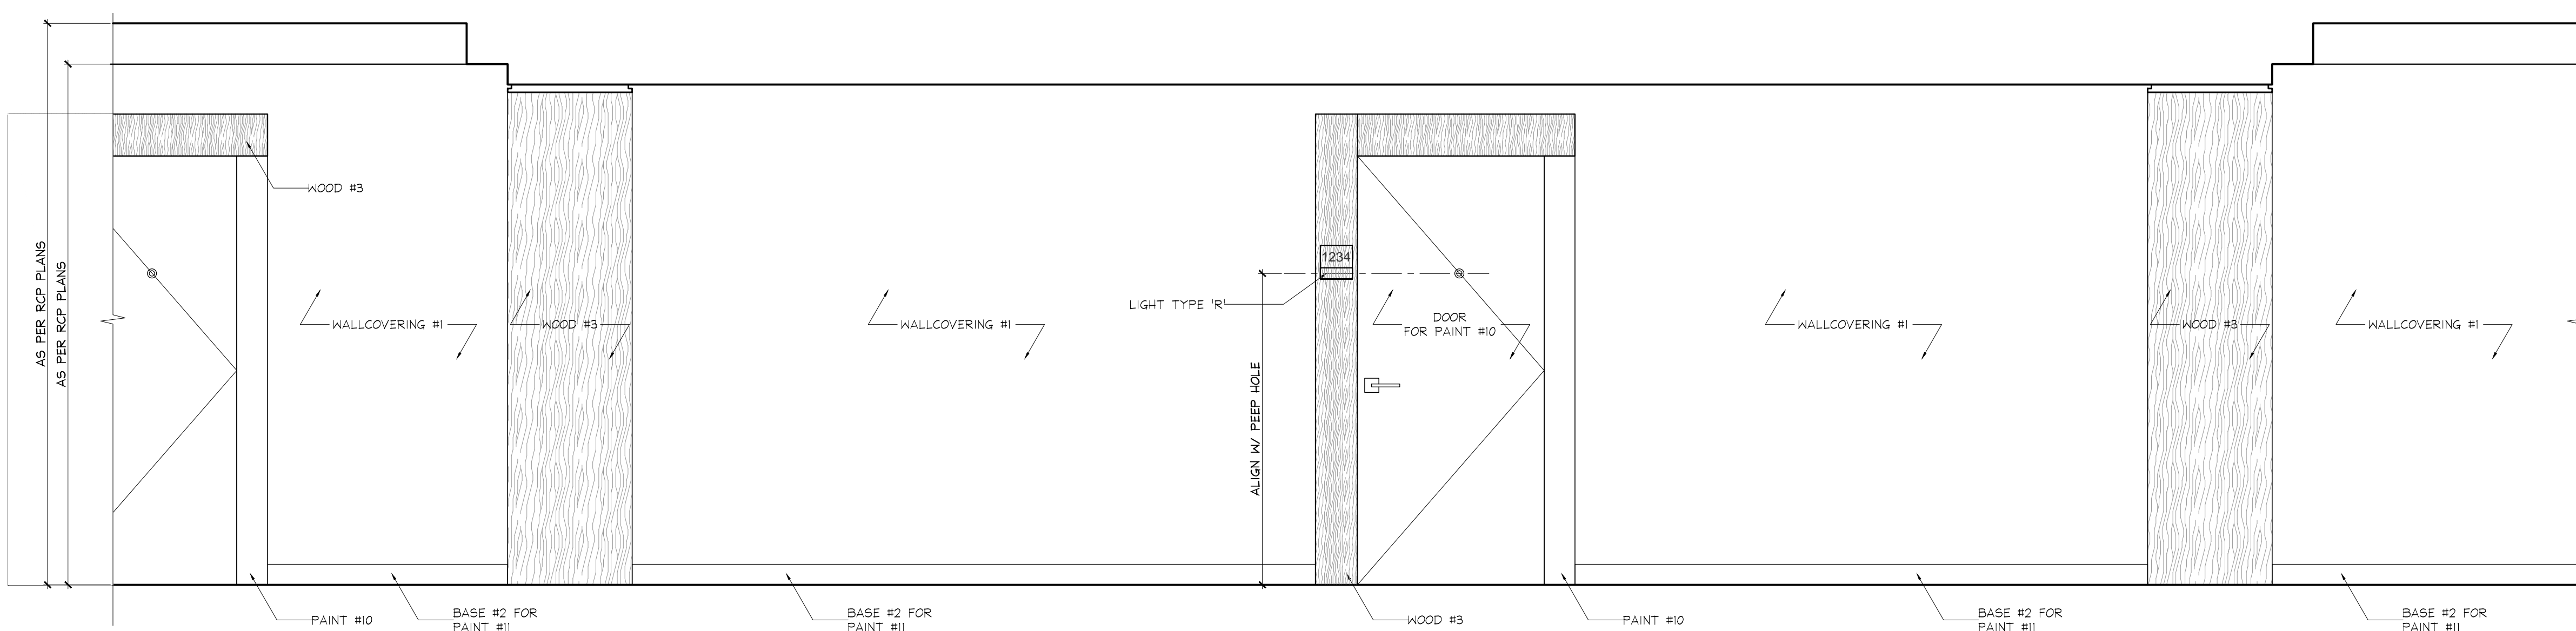

2 ELEVATION
ID2.3.0 TYPICAL CORRIDOR
ELEVATOR LOBBY SCALE 1:20

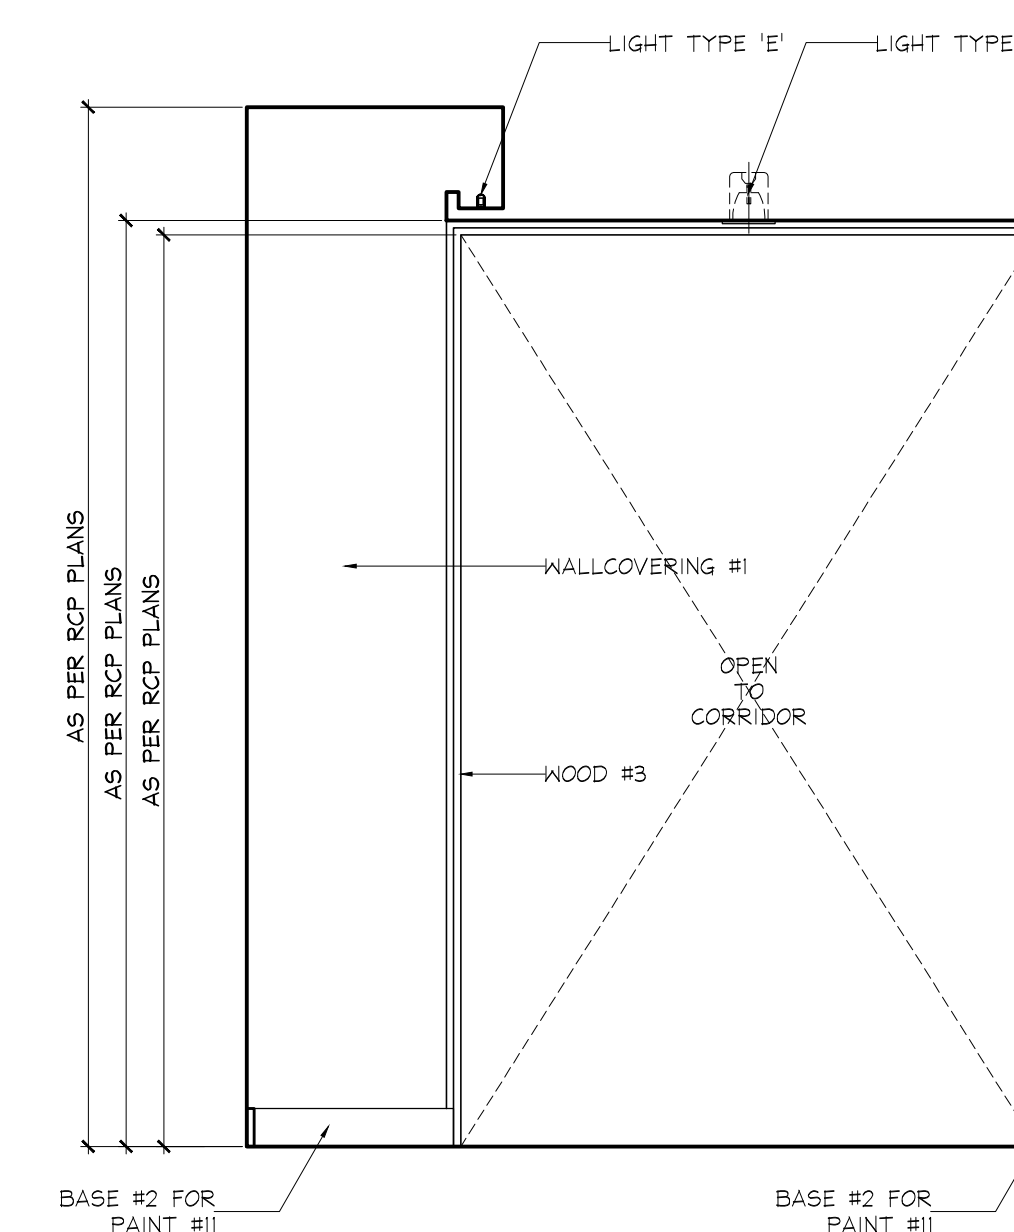

3 ELEVATION
ID2.3.0 TYPICAL CORRIDOR
ELEVATOR LOBBY SCALE 1:20

ISSUED FOR
AS-BUILT

NO	DATE	COMMENTS	INI
01	31 MAY / 17	ISSUED FOR AS-BUILT	SV

REVISIONS:

UNION31

UNION31 INC.
183 BATHURST STREET, STE. 201
TORONTO, ON, M5T 2R7, CANADA
TEL: 416-597-1576 FAX: 416-597-2139

PROJECT NAME:
ALEXANDRA PARK
MAIN BUILDING
BLOCK 11
ON, Canada

PROJECT NO.: 13-949

DRAWINGS:
TYPICAL ELEVATIONS

DATE STARTED: 07 AUG / 13 DRAWING NO.:
SCALE: 1 : 20 ID
DRAWN BY: AP
APPROVED BY: KC 2.3.0