


DO NOT SCALE DRAWINGS.

CONTRACTOR MUST VERIFY ALL DRAWINGS, DIMENSIONS, DETAILS AND SPECIFICATIONS, AND REPORT ANY DISCREPANCIES TO UNION 31 INC. BEFORE PROCEEDING WITH WORK. MATERIALS MAY NOT BE SUBSTITUTED WITHOUT WRITTEN APPROVAL FROM UNION 31 INC. ALL DRAWINGS AND SPECIFICATIONS ARE INSTRUMENTS OF SERVICE AND THE PROPERTY OF UNION 31 INC. WHICH MUST BE RETURNED AT THE COMPLETION OF THE WORK.

PRINTED: 30-May-17

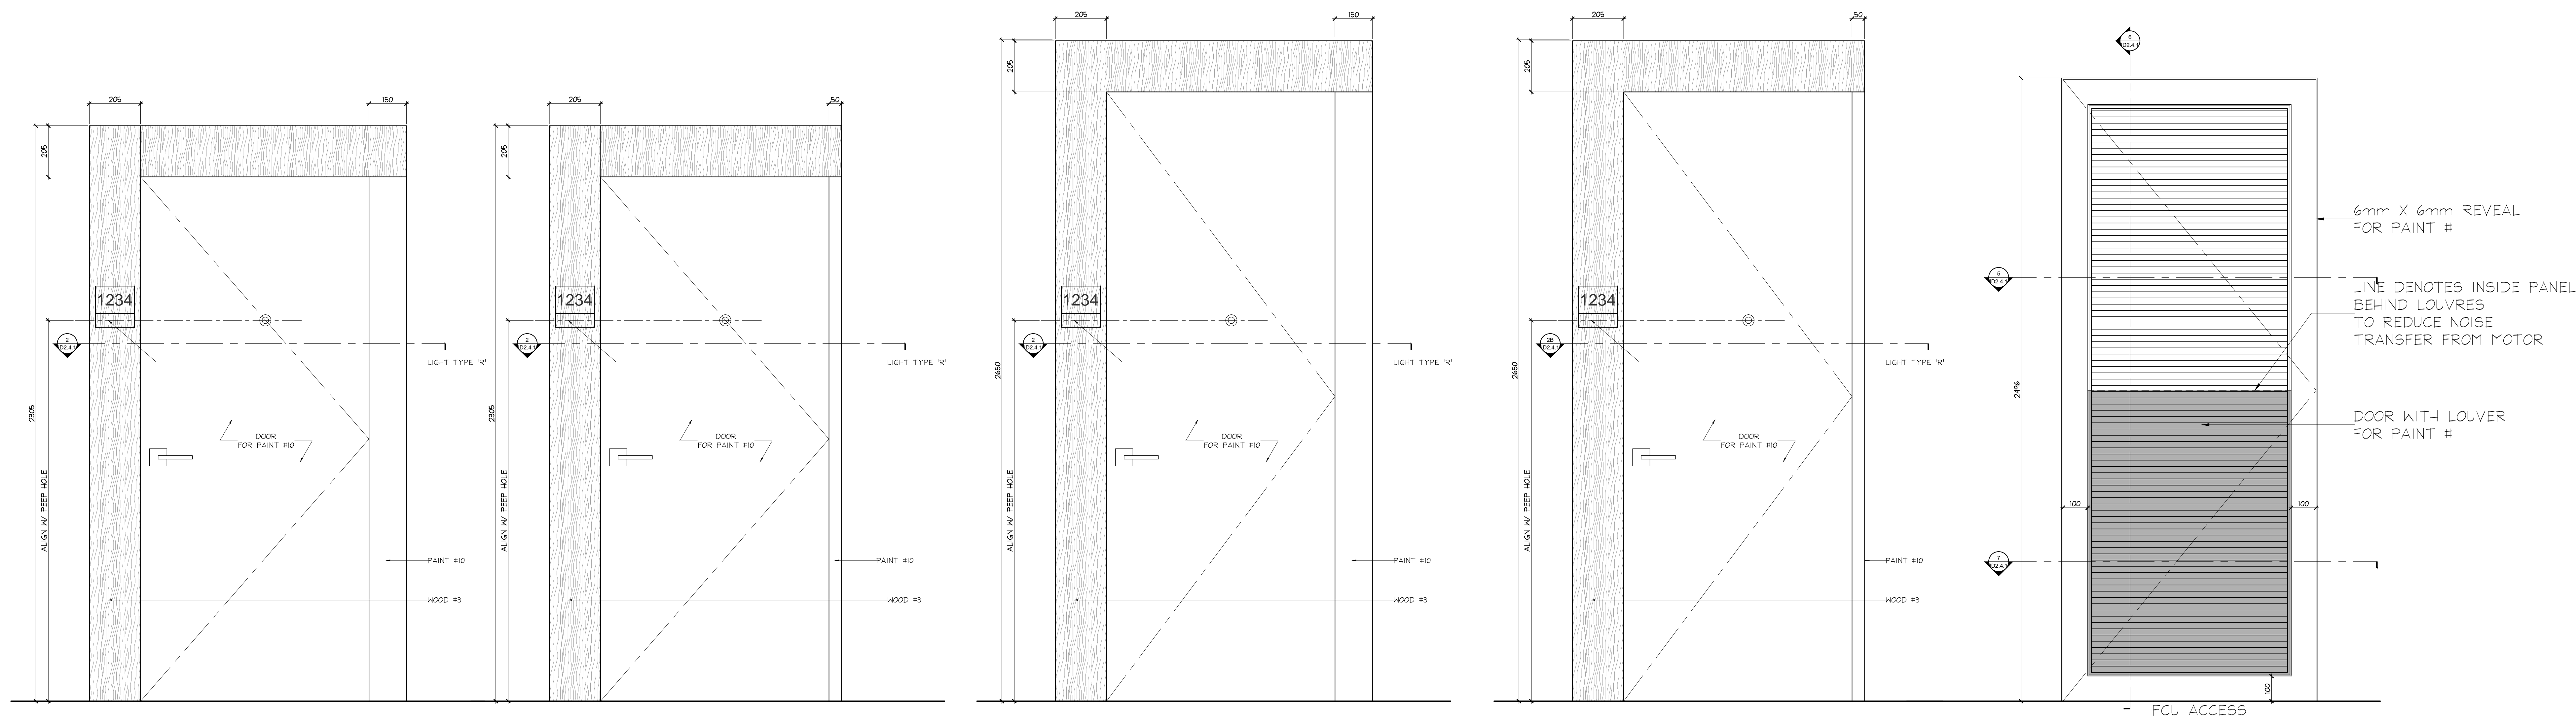


1 ELEVATION  
102.4.1 TYPICAL SUITE ENTRY SCALE 1:10

1A ELEVATION  
102.4.1 ATYPICAL SUITE ENTRY SCALE 1:10


3 ELEVATION  
102.4.1 TYPICAL SUITE ENTRY FOR 10'-0\"/>

3A ELEVATION  
102.4.1 ATYPICAL SUITE ENTRY FOR 10'-0\"/>


4 ELEVATION  
102.4.1 FCU ACCESS DOOR SCALE 1:10

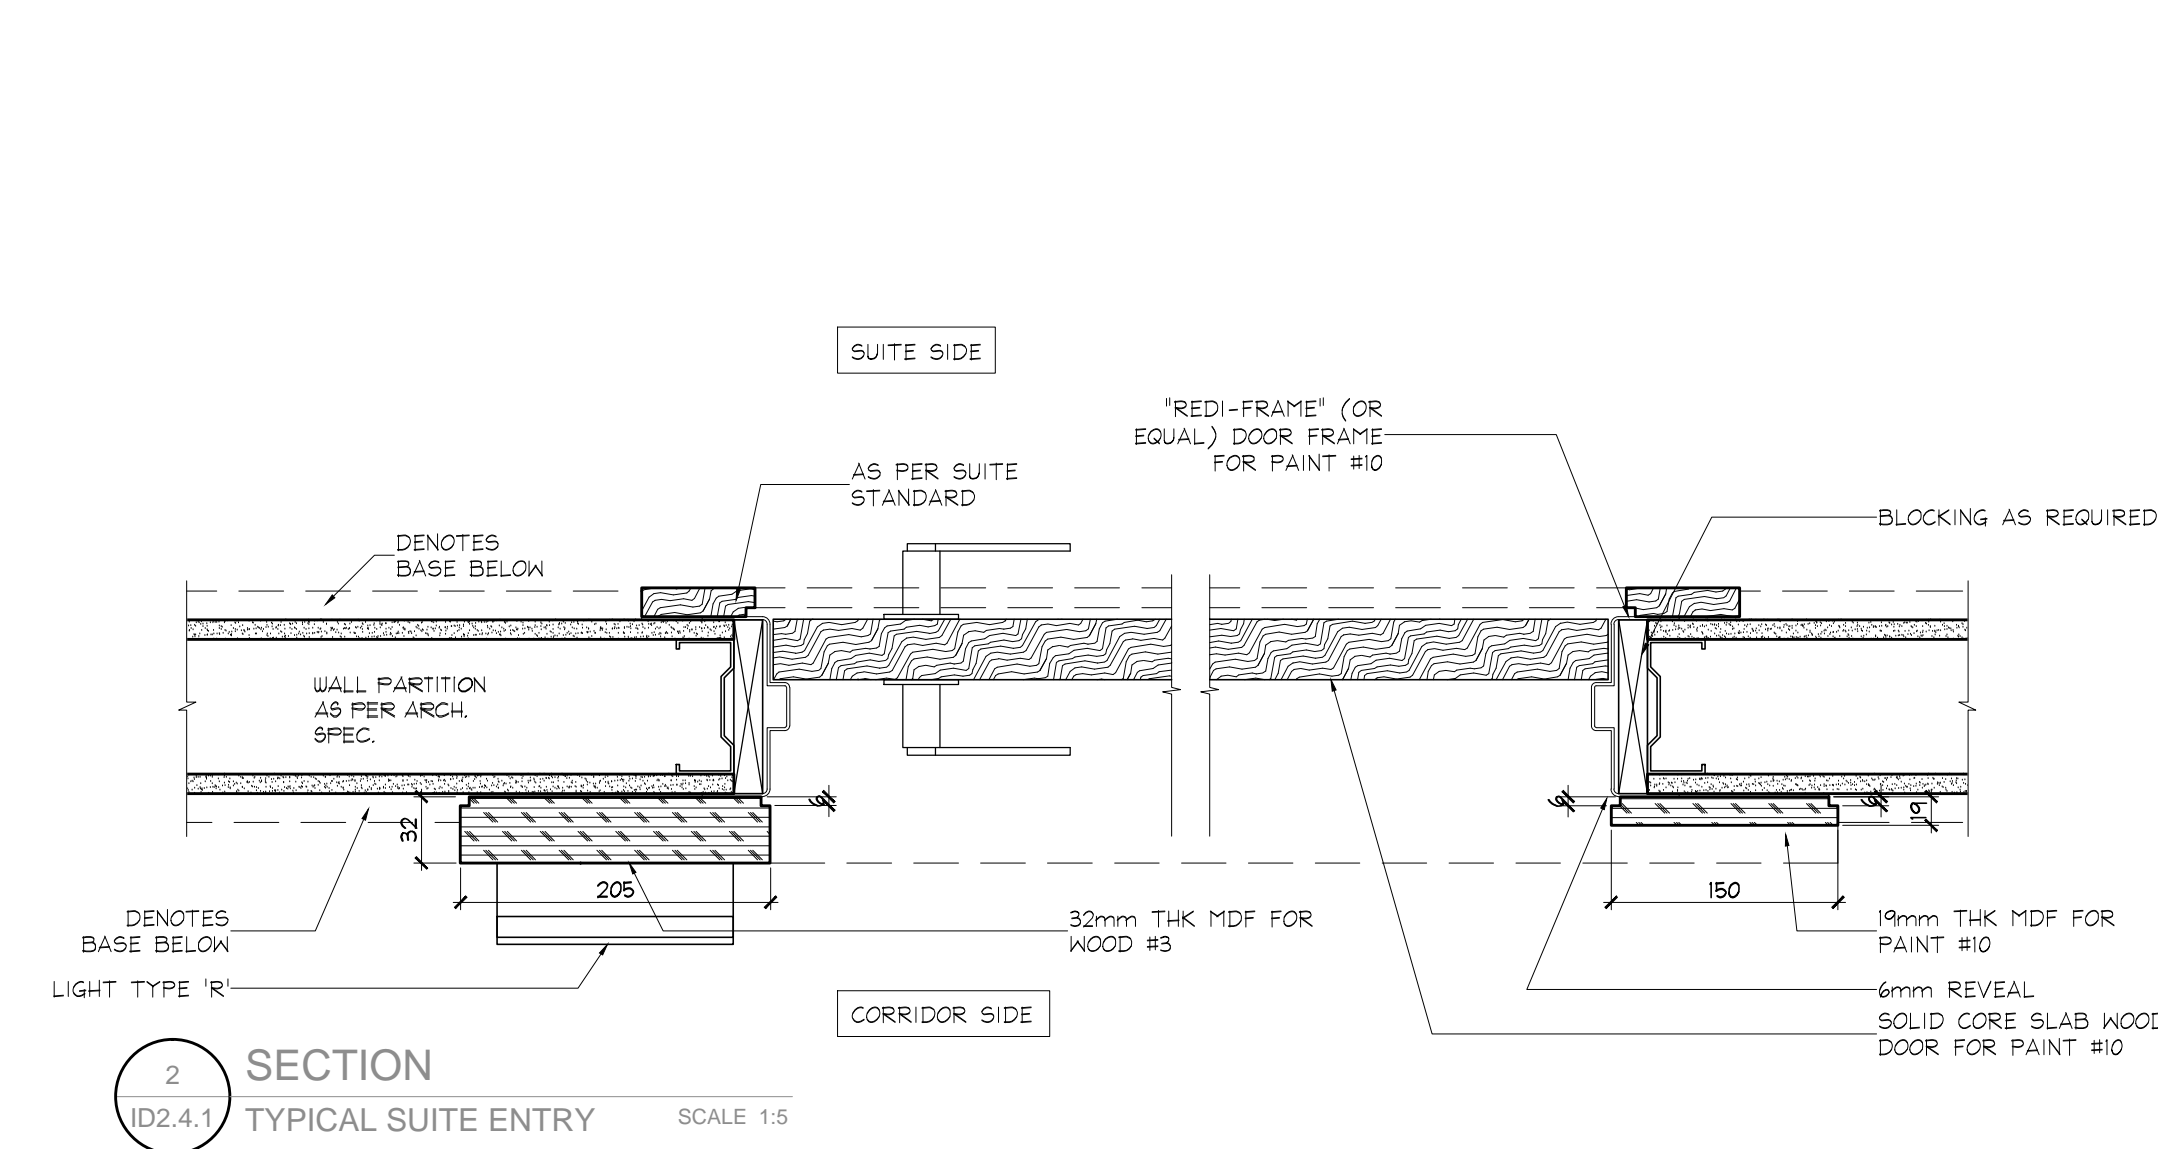


2 SECTION  
102.4.1 TYPICAL SUITE ENTRY SCALE 1:5

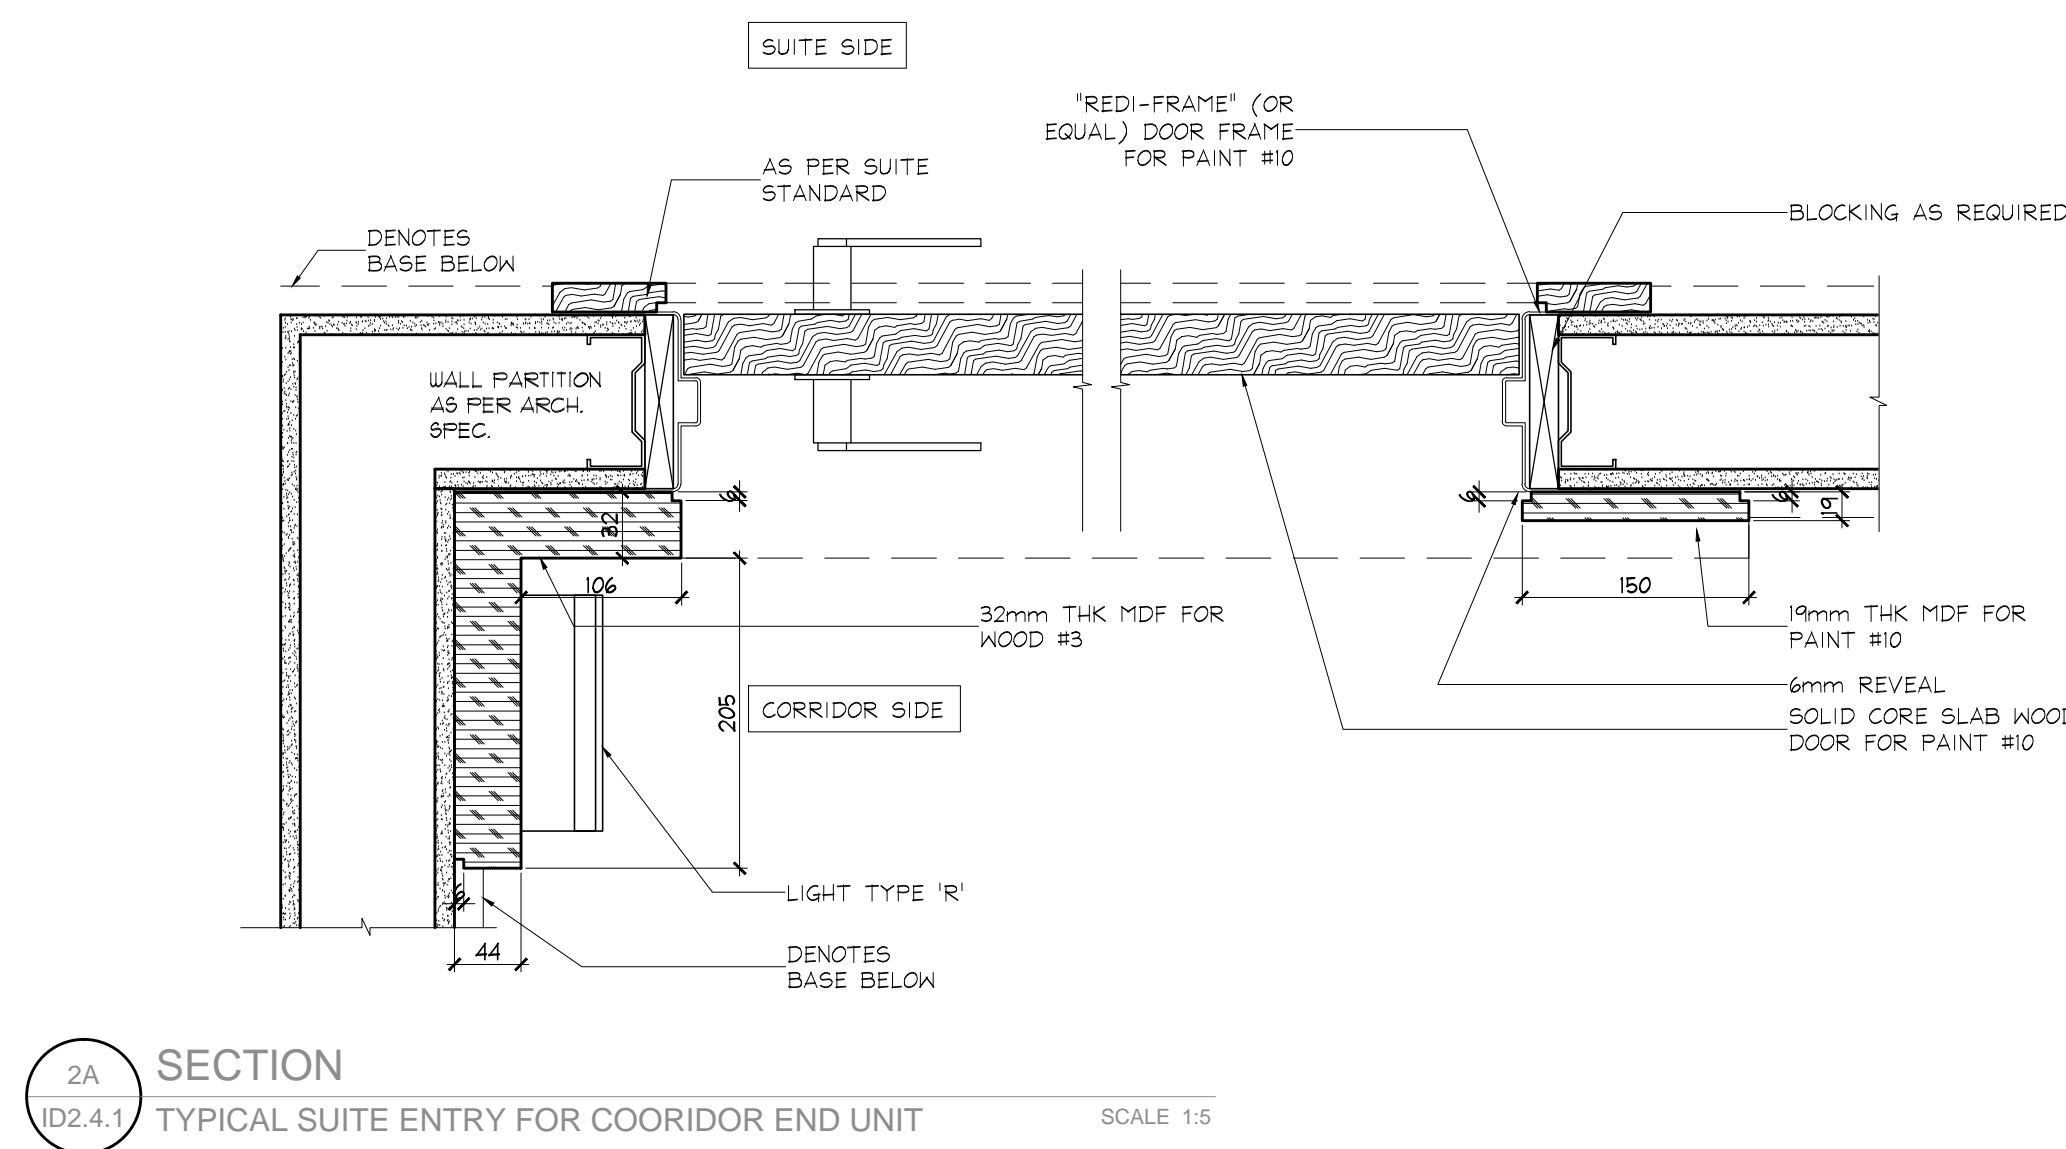

3A SECTION  
102.4.1 TYPICAL SUITE ENTRY FOR CORRIDOR END UNIT SCALE 1:5

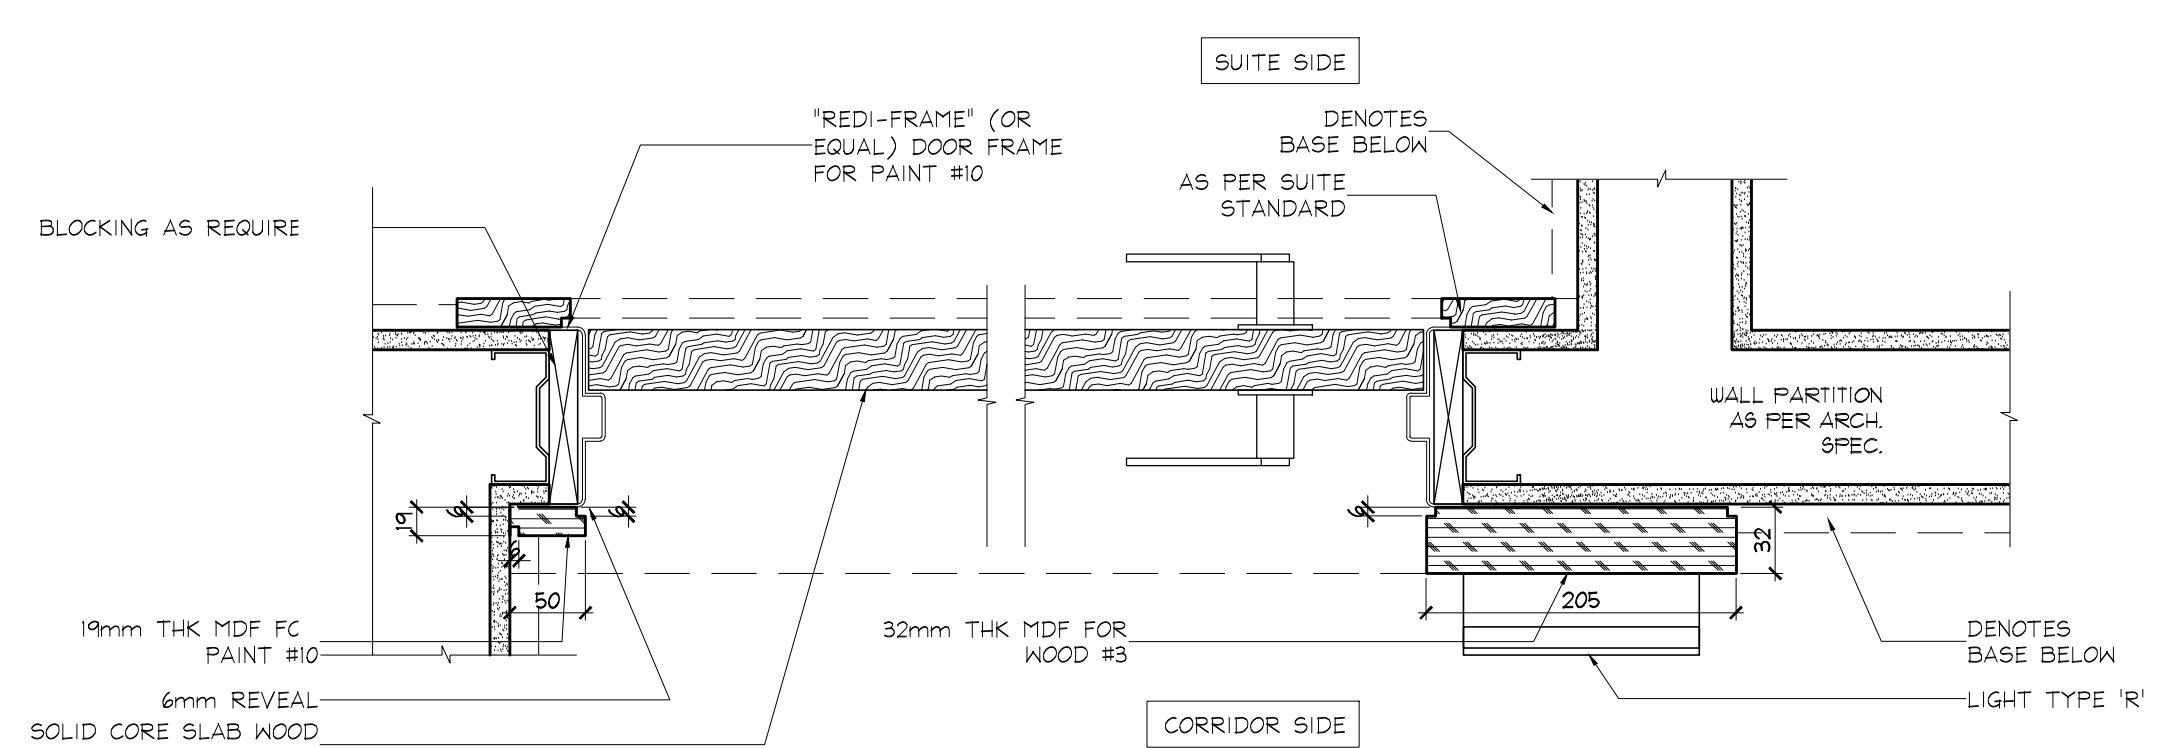


2B SECTION  
102.4.1 SUITE ENTRY NOS.1019,1021,1119,1121 SCALE 1:5

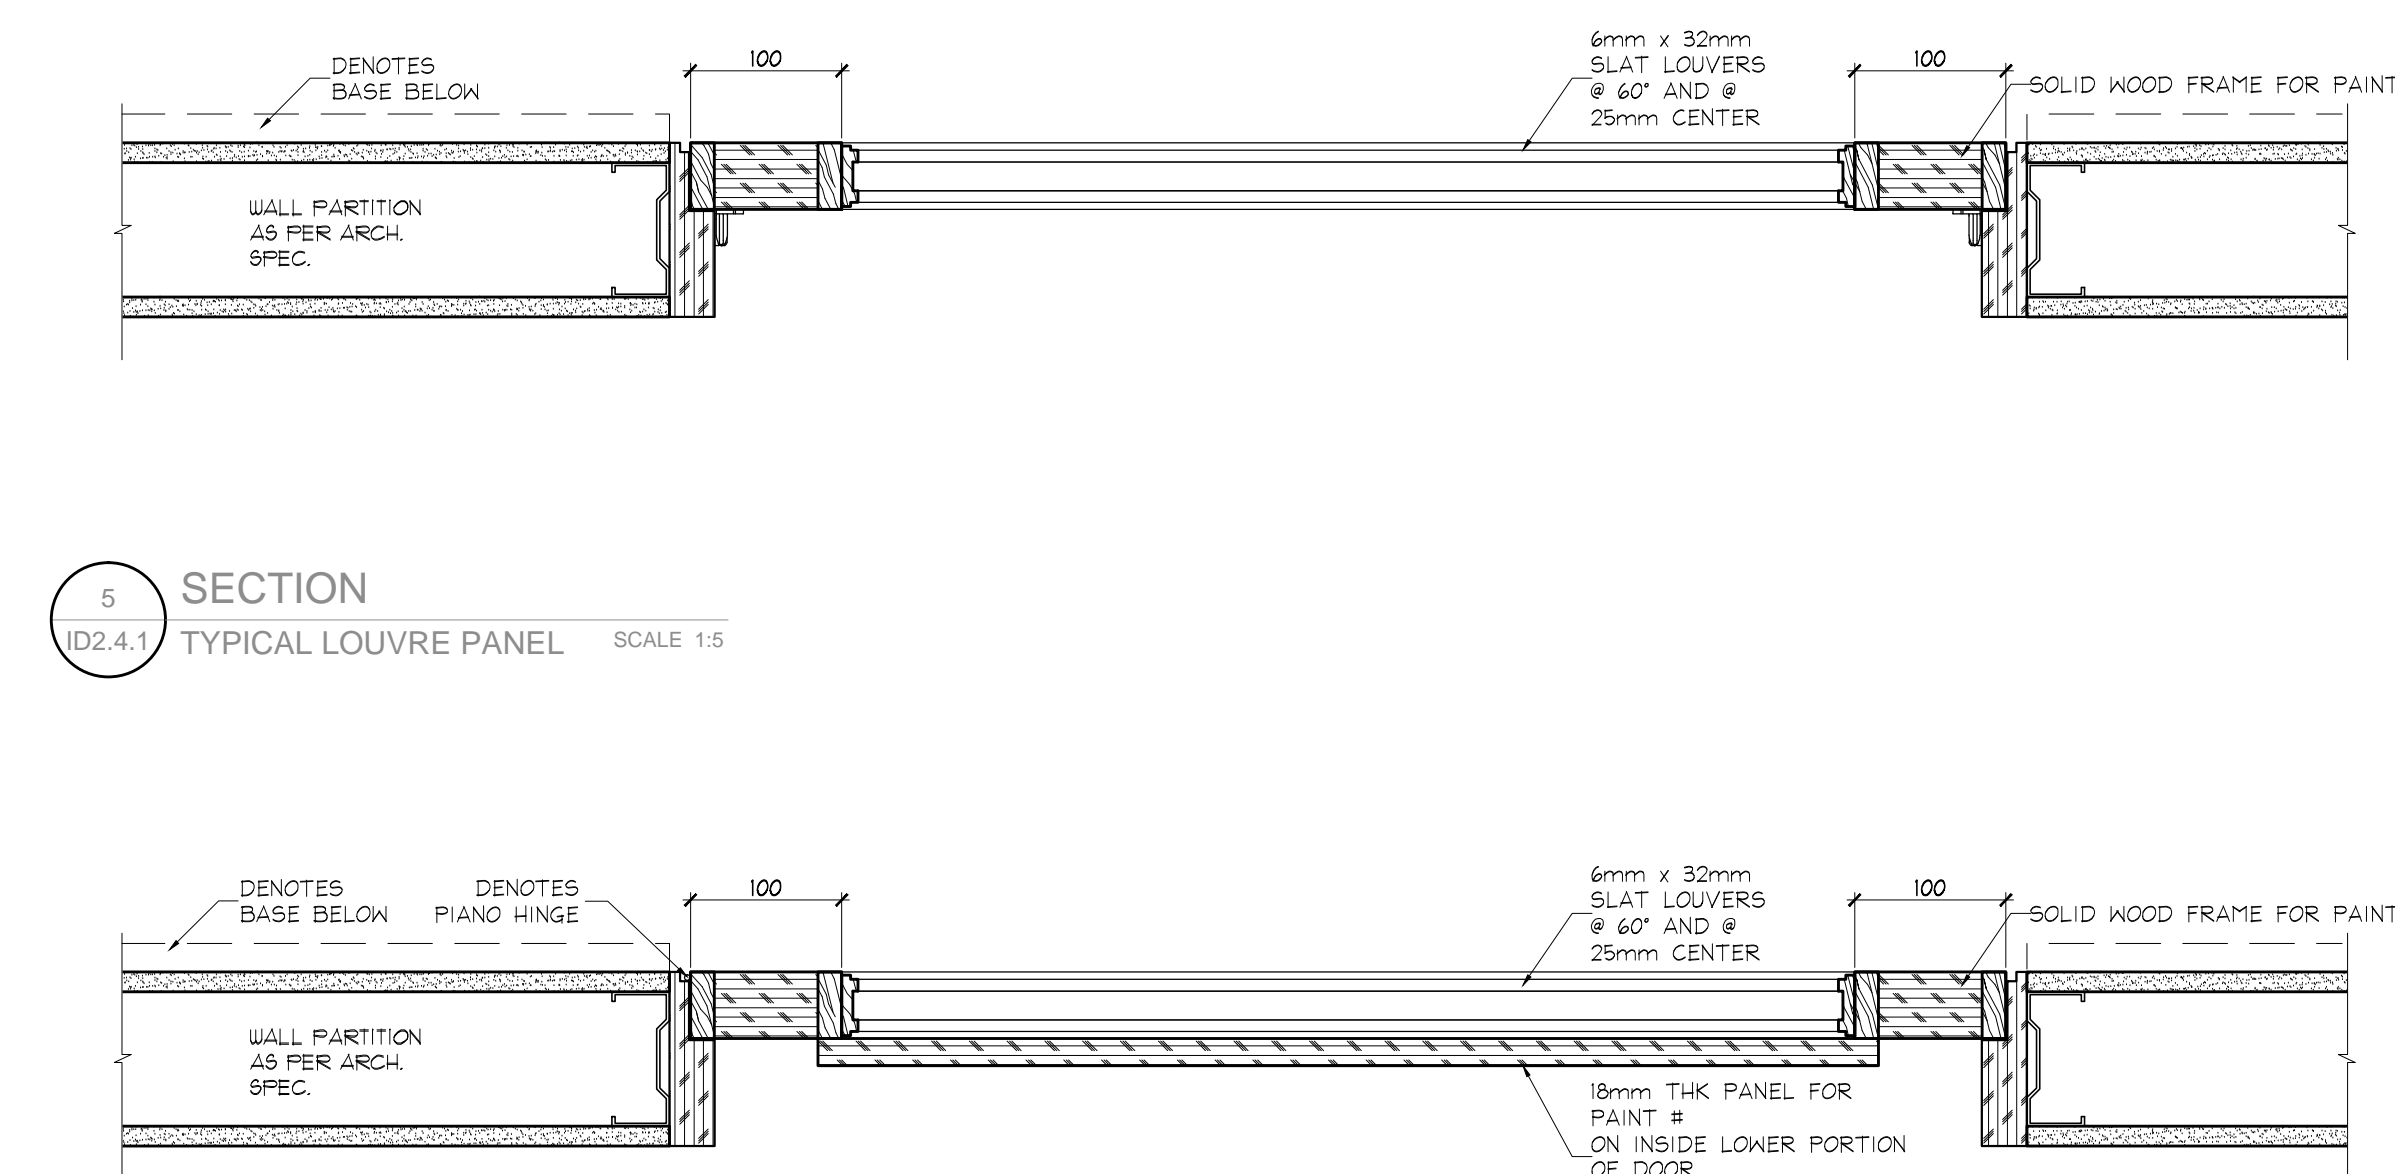

3 SECTION  
102.4.1 TYPICAL LOUVRE PANEL SCALE 1:5

3 SECTION  
102.4.1 TYPICAL LOUVRE PANEL SCALE 1:5

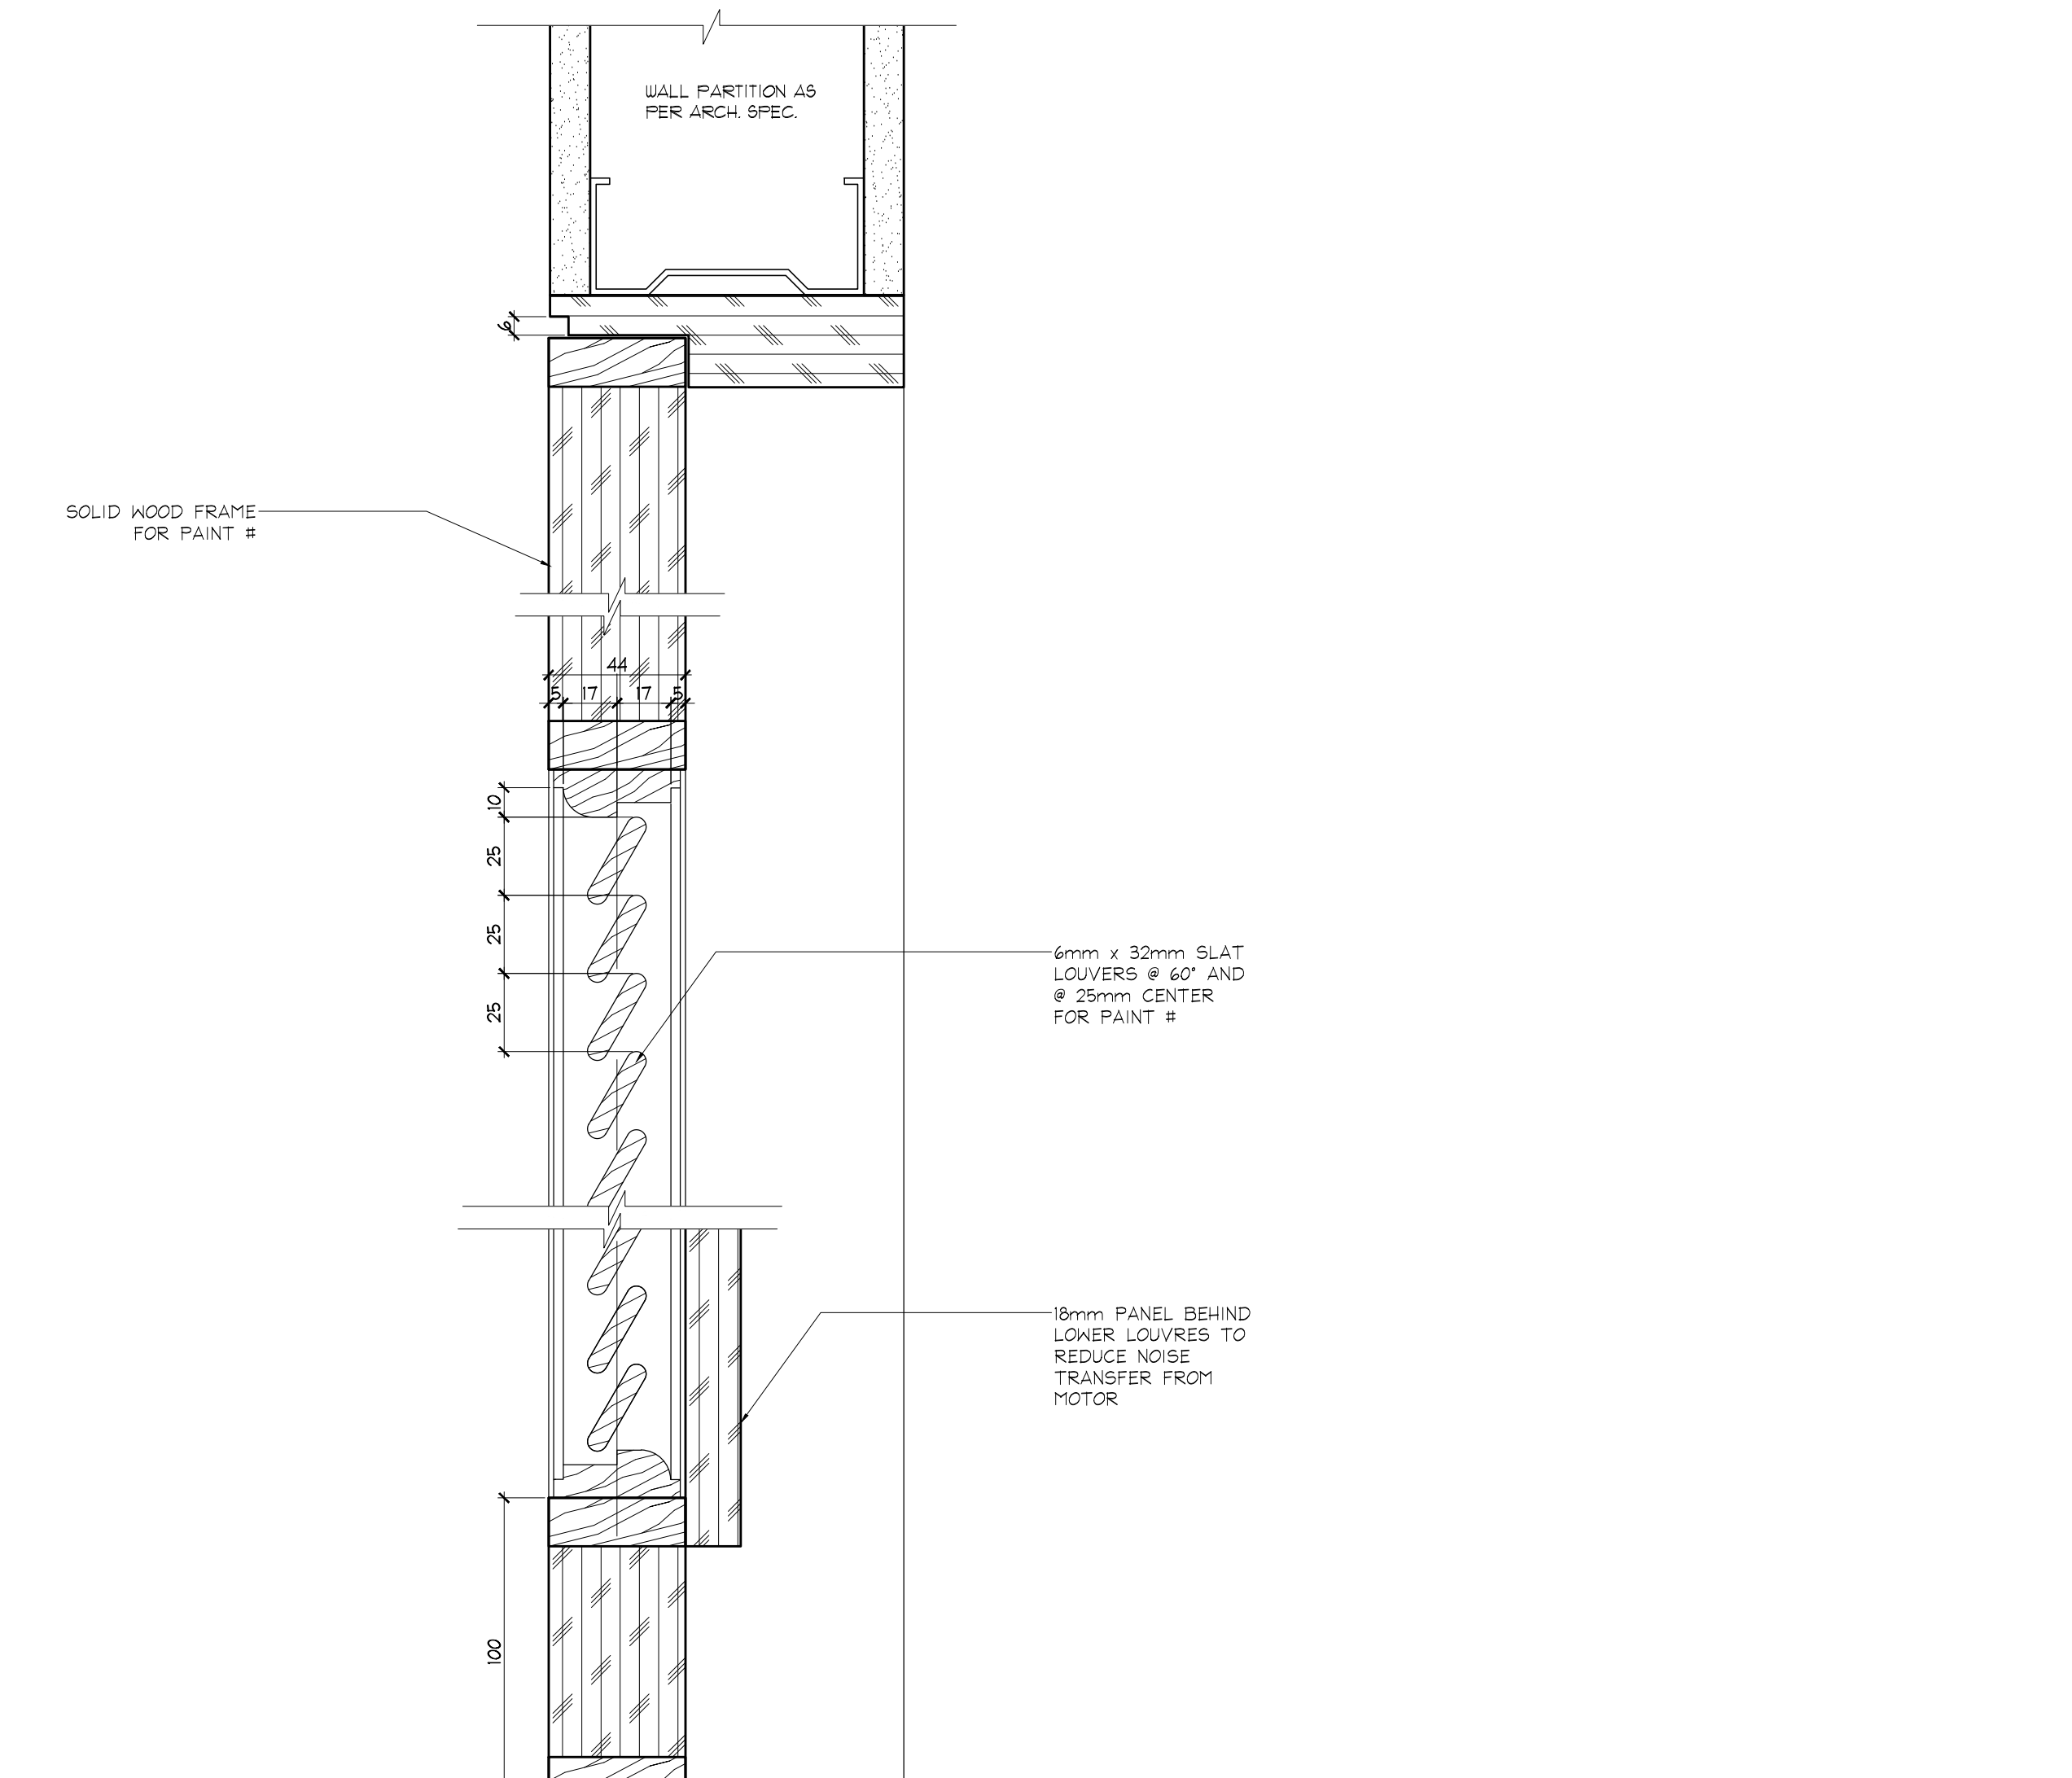

4 SECTION  
102.4.1 TYPICAL LOUVER DETAIL SCALE 1:2

01	31 MAY / 17	ISSUED FOR AS-BUILT	SV
NO.	DATE	COMMENTS	INI
REVISIONS:			

UNION 31

UNION31 INC.  
183 BATHURST STREET, STE. 201  
TORONTO, ON, M5T 2R7, CANADA  
TEL: 416-597-1576 FAX: 416-597-2139

PROJECT NAME:  
**ALEXANDRA PARK  
MAIN BUILDING**  
BLOCK 11  
ON, Canada

PROJECT NO.: 13-949

DRAWINGS:

DOOR ELEVATIONS

DATE STARTED: 07 AUG / 13	DRAWING NO.:
SCALE: AS NOTED	ID
DRAWN BY: SM	2.4.1
APPROVED BY: KC	

ISSUED FOR  
AS-BUILT