



DO NOT SCALE DRAWINGS.

CONTRACTOR MUST VERIFY ALL DRAWINGS, DIMENSIONS, DETAILS AND SPECIFICATIONS, AND REPORT ANY DISCREPANCIES TO UNION 31 INC. BEFORE PROCEEDING WITH WORK. MATERIALS MAY NOT BE SUBSTITUTED WITHOUT WRITTEN APPROVAL FROM UNION 31 INC.
ALL DRAWINGS AND SPECIFICATIONS ARE INSTRUMENTS OF SERVICE AND THE PROPERTY OF UNION 31 INC. WHICH MUST BE RETURNED AT THE COMPLETION OF THE WORK.


PRINTED: 30-May-17

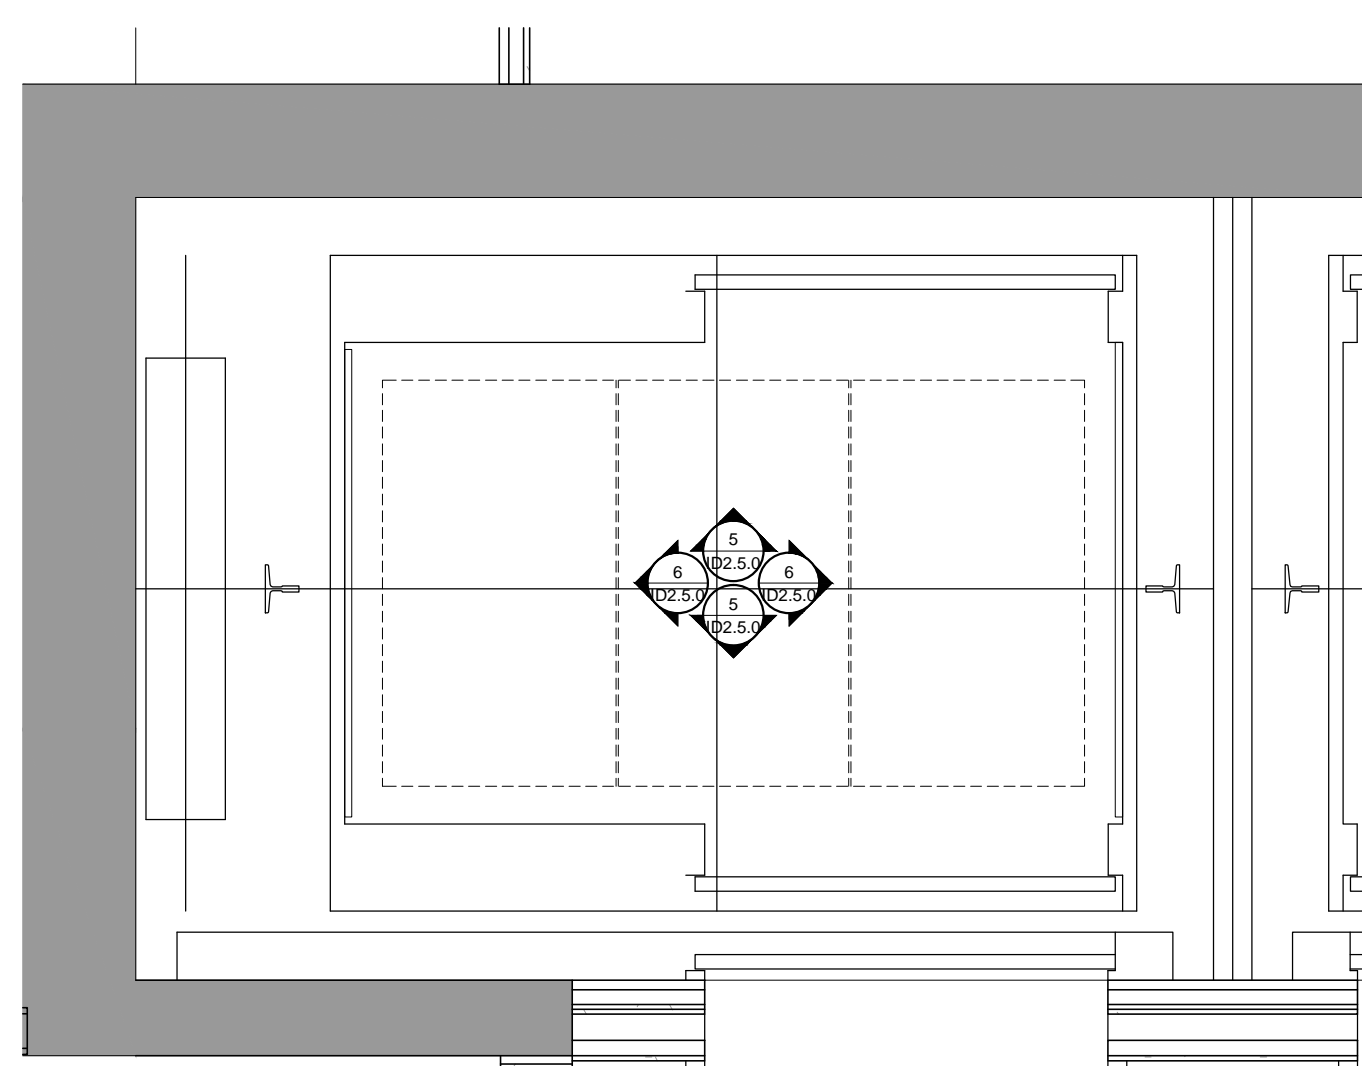


1 TYP. ELEVATOR CAB CONSTRUCTION PLAN
ID2.5.0 SCALE 1:20

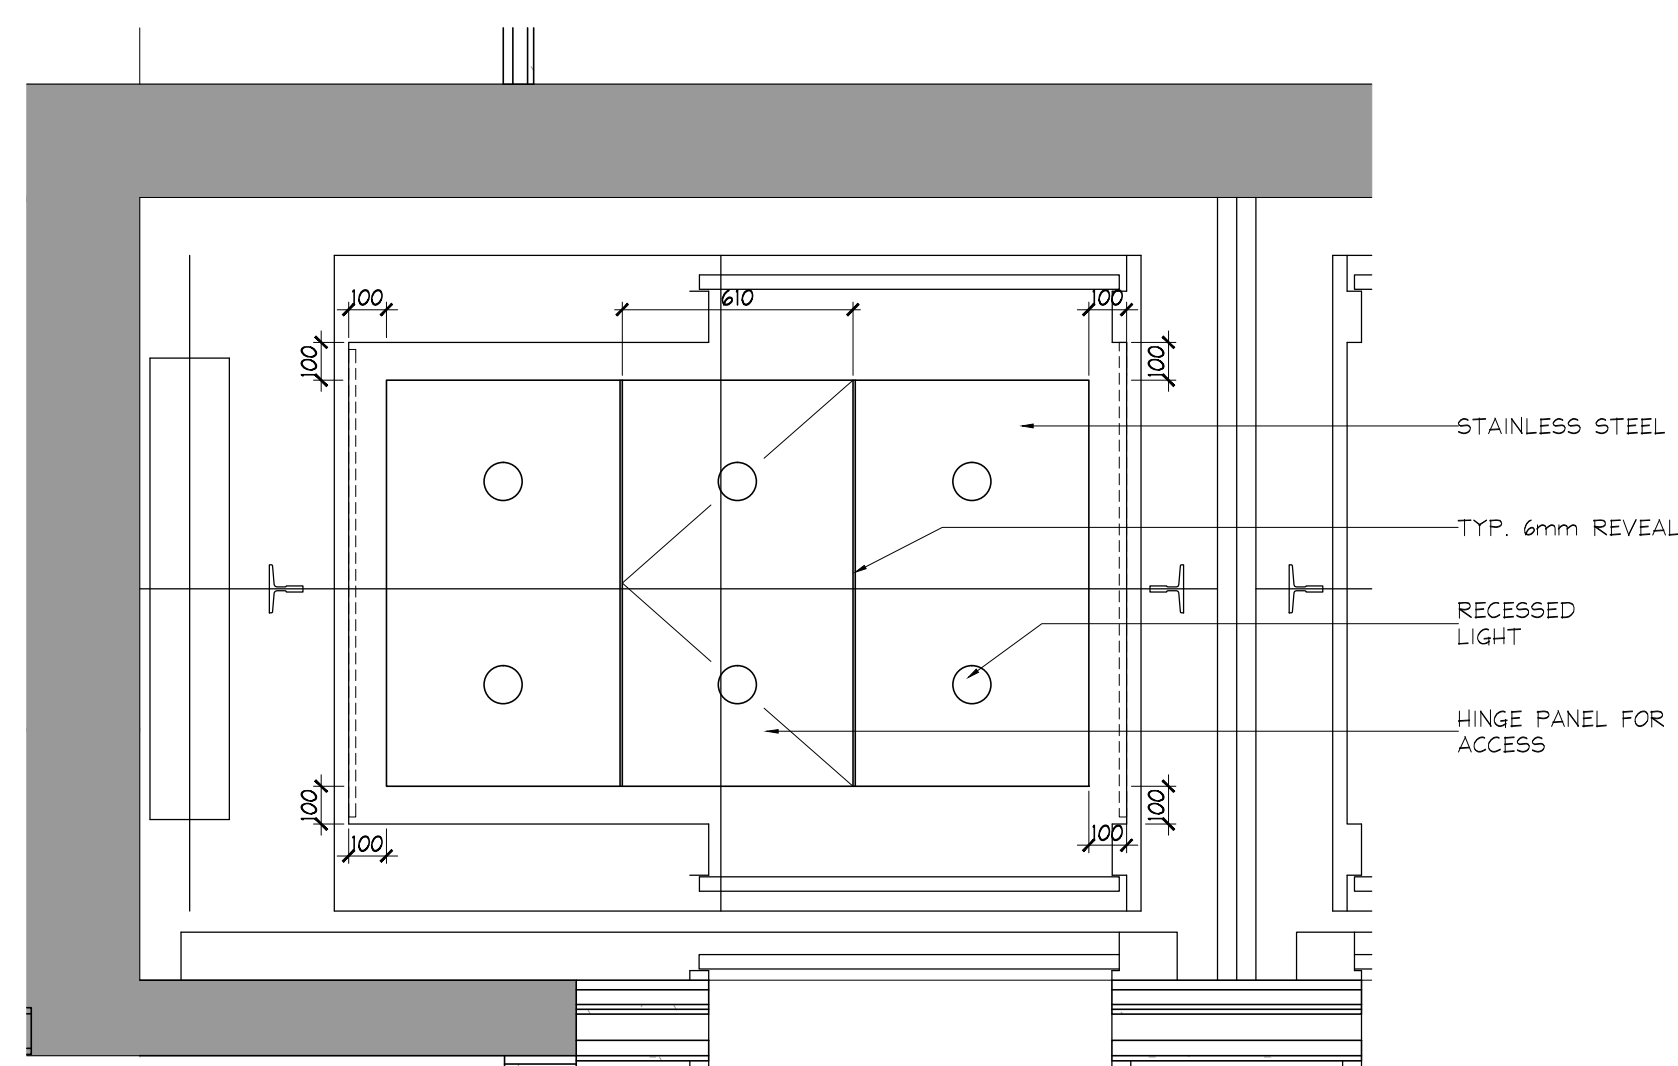


2 TYP. ELEVATOR CAB REFLECTED CEILING PLAN
ID2.5.0 SCALE 1:20

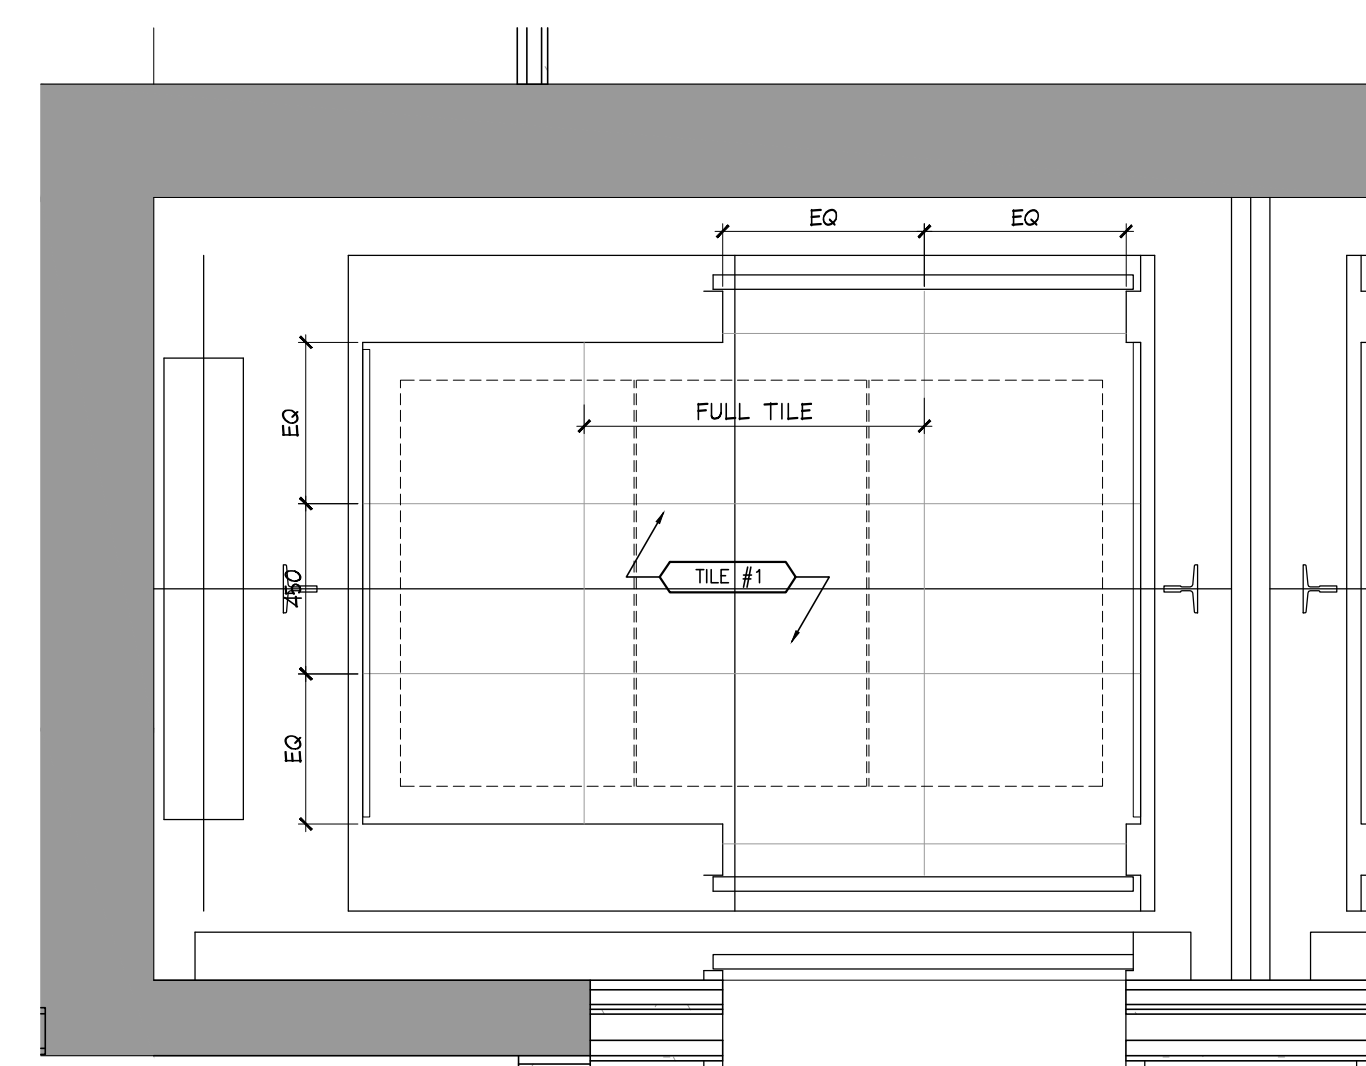


3 TYP. ELEVATOR CAB FLOOR FINISHES PLAN
ID2.5.0 SCALE 1:20

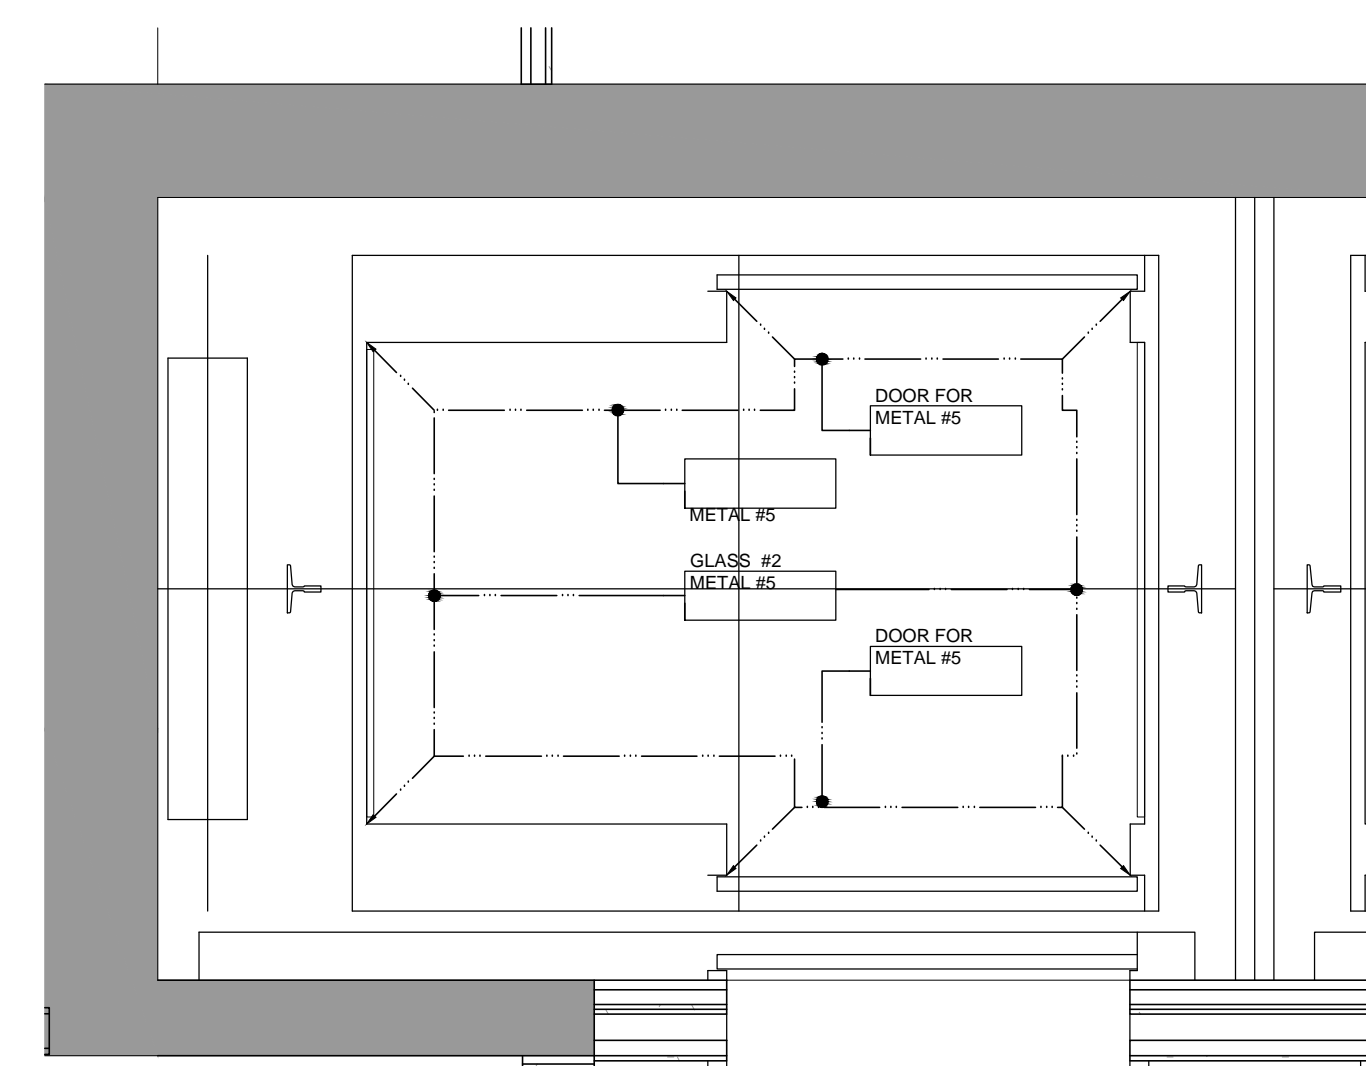


4 TYP. ELEVATOR CAB WALL FINISHES PLAN
ID2.5.0 SCALE 1:20

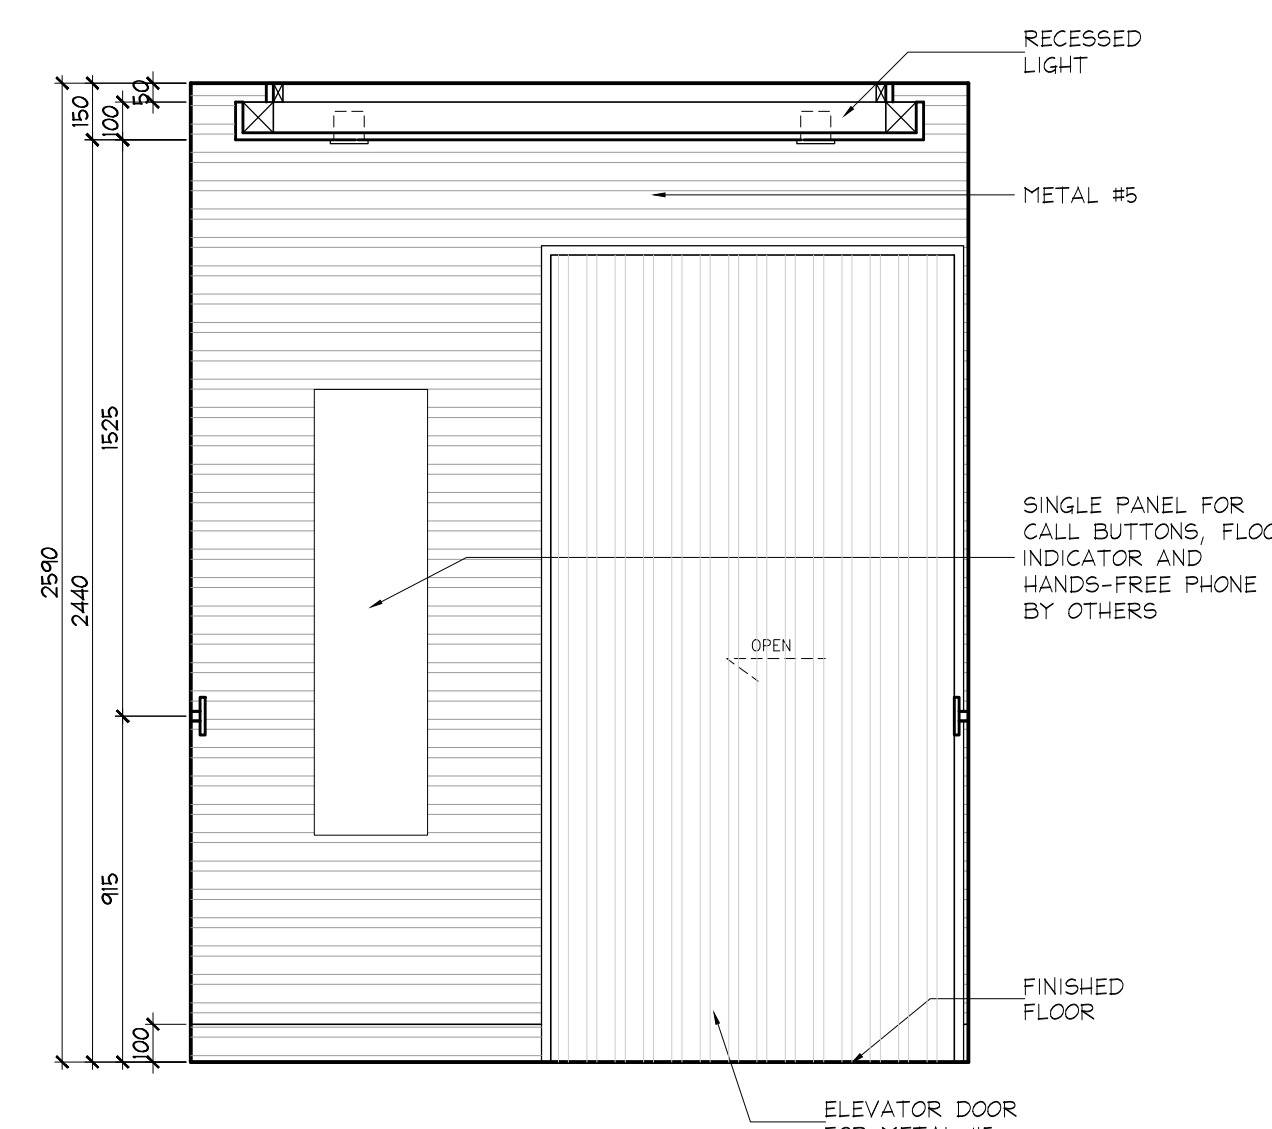


5 TYP. ELEVATOR CAB ELEVATION
ID2.5.0 SCALE 1:20

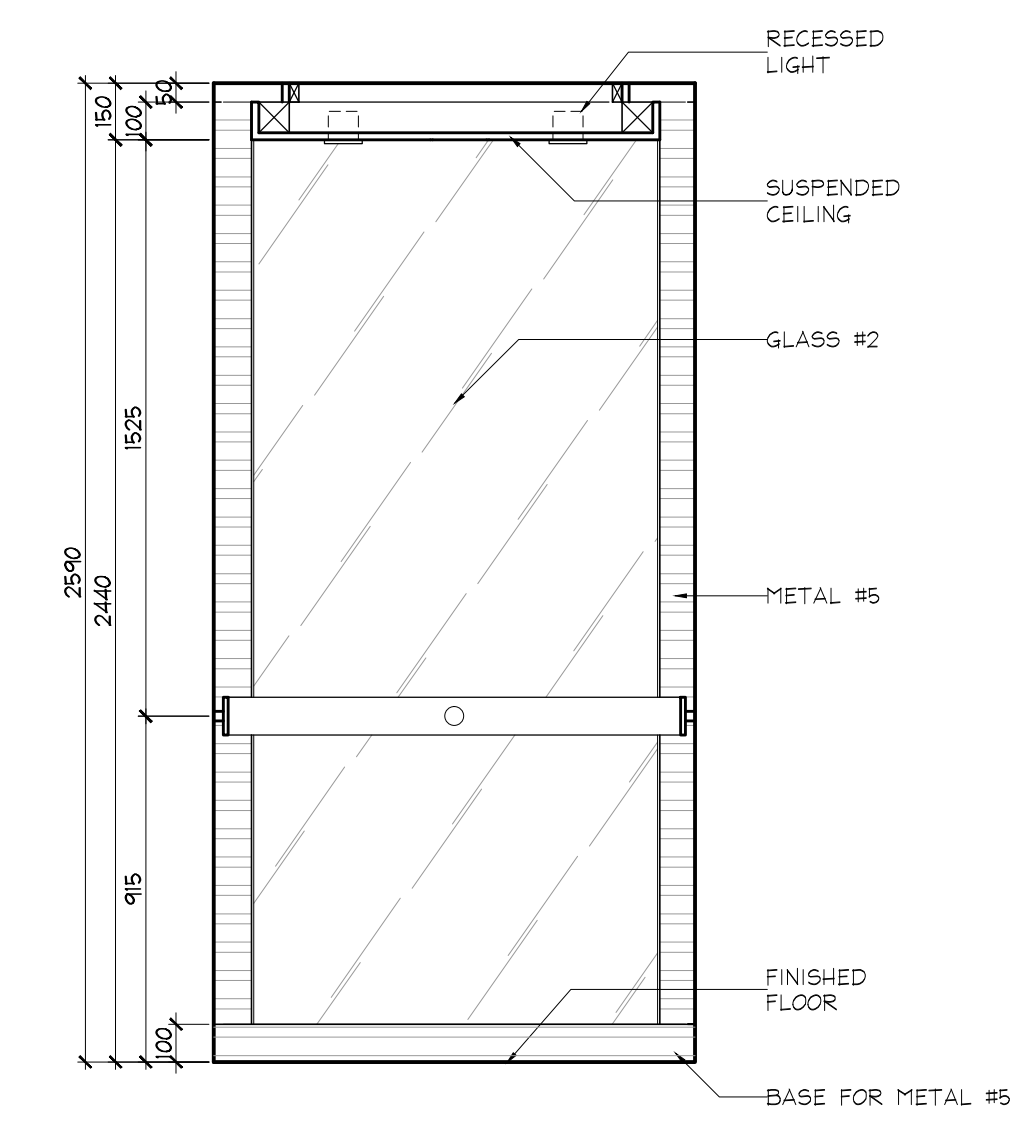


6 TYP. ELEVATOR CAB ELEVATION
ID2.5.0 SCALE 1:20

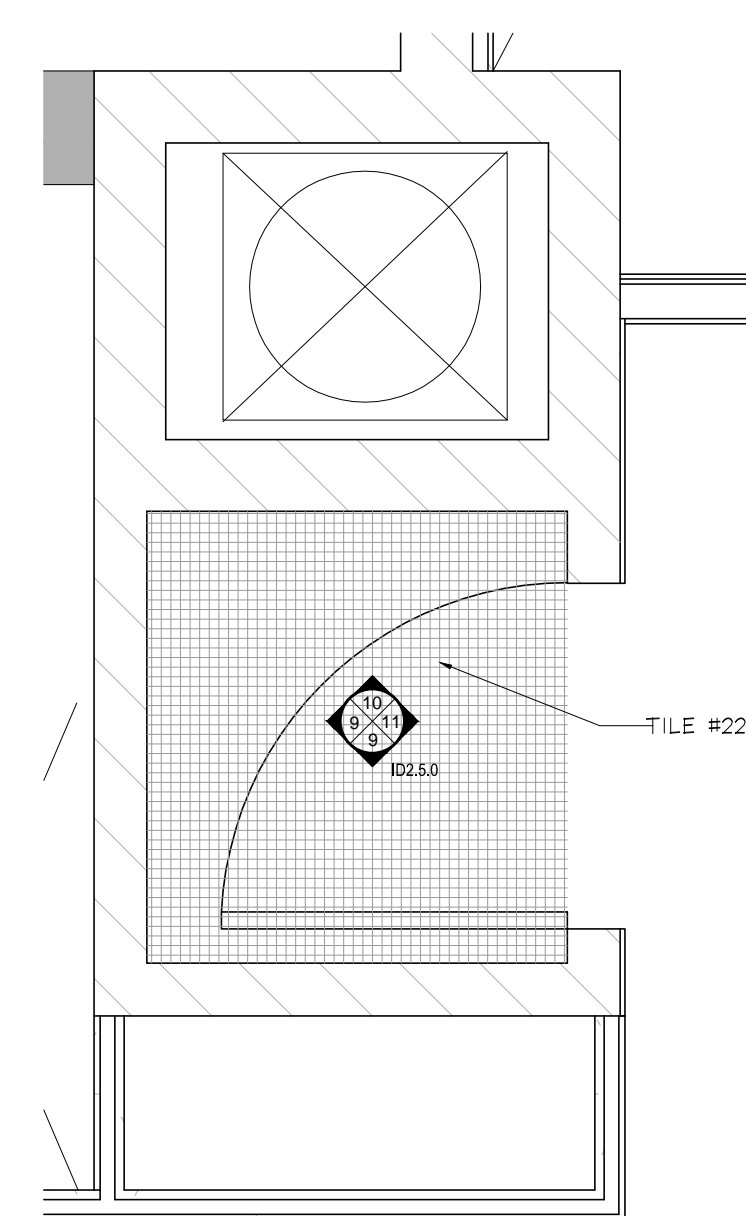


8 PLAN GARBAGE CHUTE
ID2.5.0 SCALE 1:20

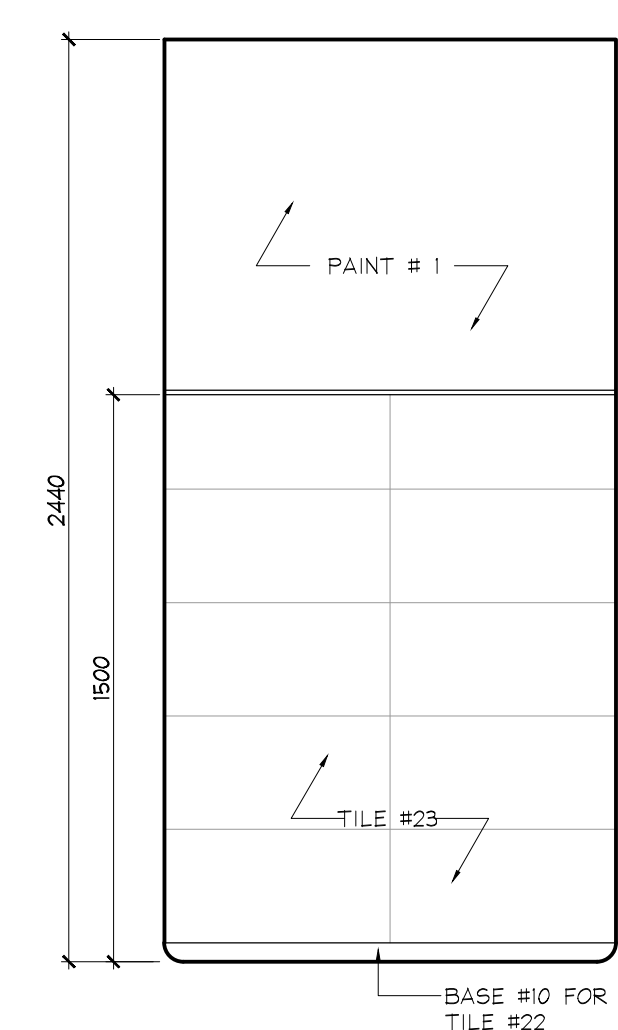

9 ELEVATION GARBAGE CHUTE
ID2.5.0 SCALE 1:20

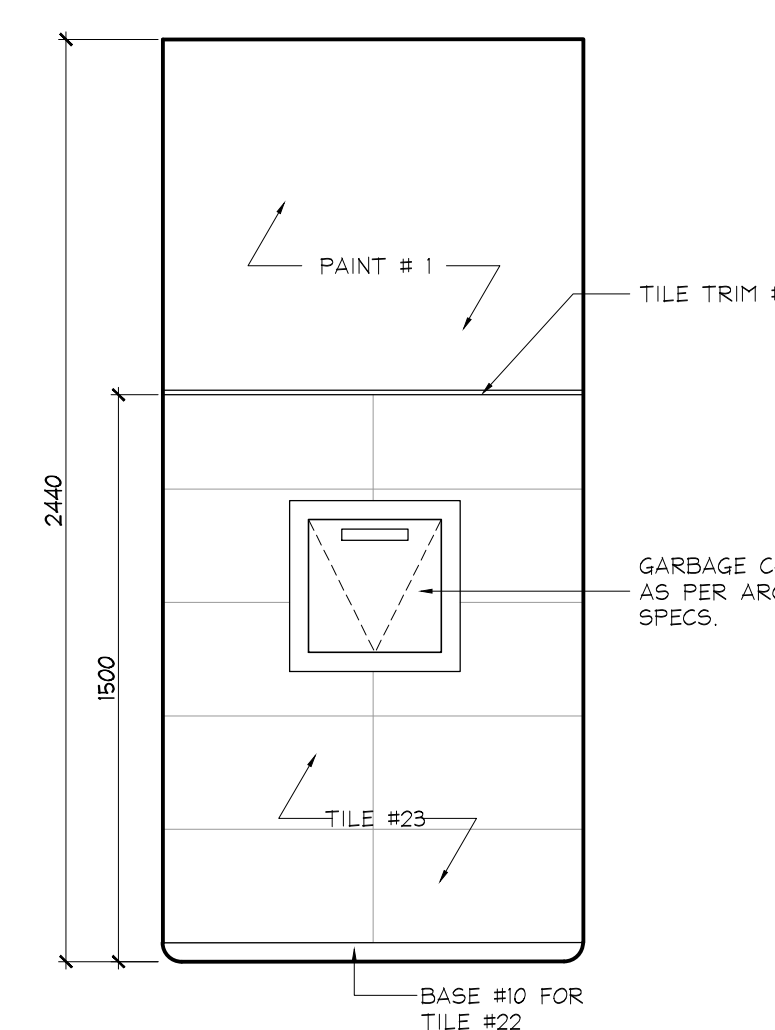

10 ELEVATION GARBAGE CHUTE
ID2.5.0 SCALE 1:20

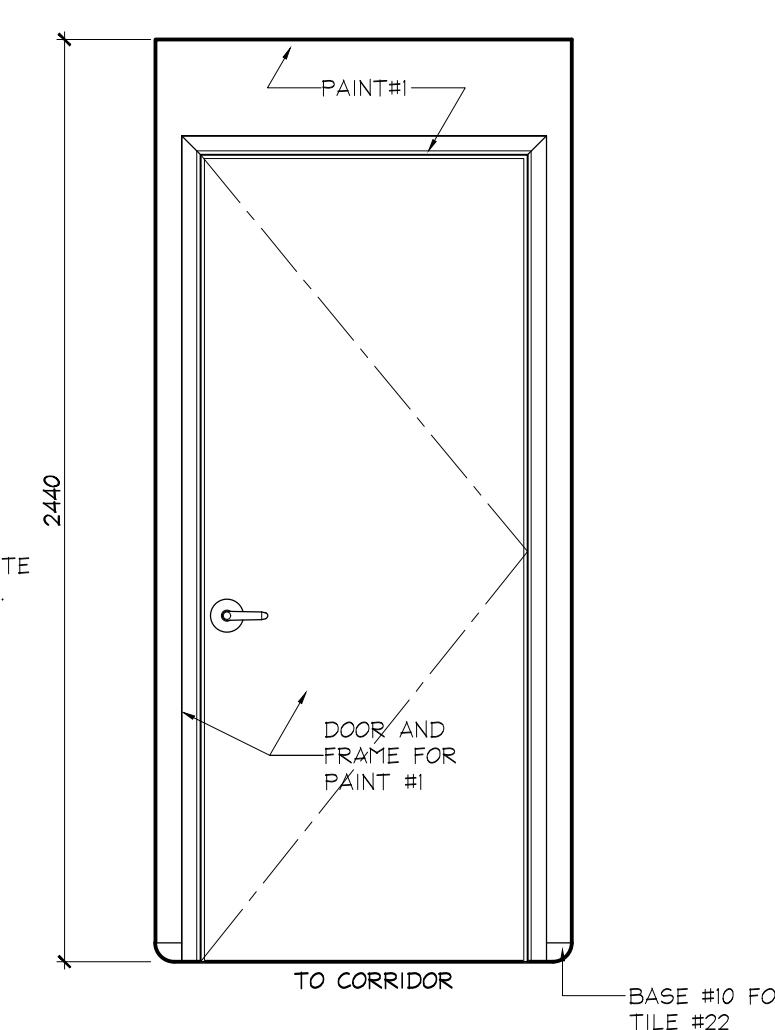

11 ELEVATION GARBAGE CHUTE
ID2.5.0 SCALE 1:20

ISSUED FOR AS-BUILT

NO.	DATE	COMMENTS	INI
01	31 MAY / 17	ISSUED FOR AS-BUILT	SV

REVISIONS:

UNION 31

UNION 31 INC.
183 BATHURST STREET, STE. 201
TORONTO, ON, M5T 2R7, CANADA
TEL: 416-597-1576 FAX: 416-597-2139

PROJECT NAME:
ALEXANDRA PARK MAIN BUILDING
BLOCK 11
ON, Canada

PROJECT NO.: 13-949

DRAWINGS:
ELEVATOR CAB & GARBAGE CHUTE PLANS, ELEVATIONS & DETAILS

DATE STARTED: 07 AUG / 13 DRAWING NO.:
SCALE: 1:20 ID
DRAWN BY: AP
APPROVED BY: KC 2.5.0