



DO NOT SCALE DRAWINGS.

CONTRACTOR MUST VERIFY ALL DRAWINGS, DIMENSIONS, DETAILS AND SPECIFICATIONS. AND REPORT ANY DISCREPANCIES TO UNOBI 31 INVC BEFORE PROCEEDING WITH WORK. MATERIALS MAY NOT BE SUBSTITUTED WITHOUT WRITTEN APPROVAL FROM UNOBI 31 INC. ALL DRAWINGS AND SPECIFICATIONS ARE INSTRUMENTS OF SERVICE AND THE PROPERTY OF UNOBI 31 INC. WHICH MUST BE RETURNED AT THE COMPLETION OF THE WORK.


PRINTED: 30-May-17

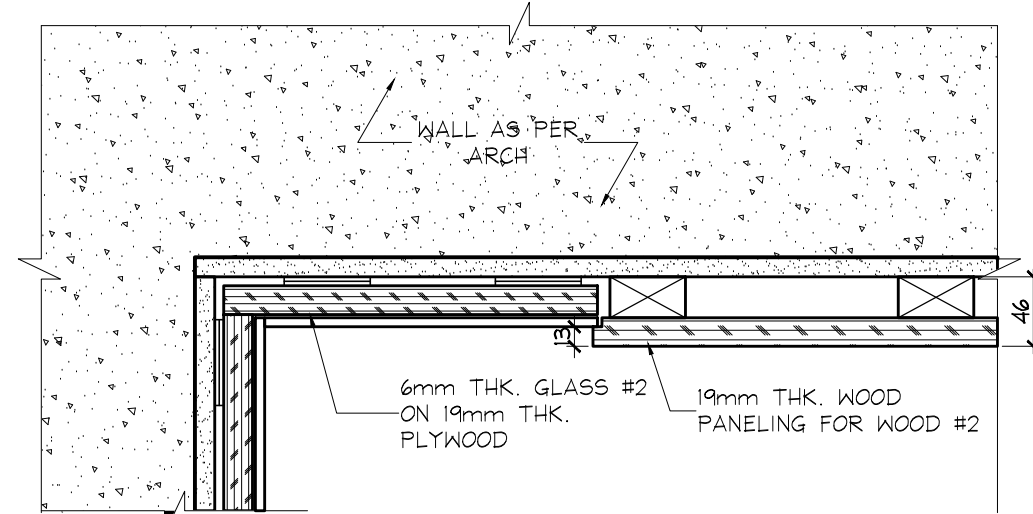


1 WALL SECTION 1ST FLOOR SCALE 1:5

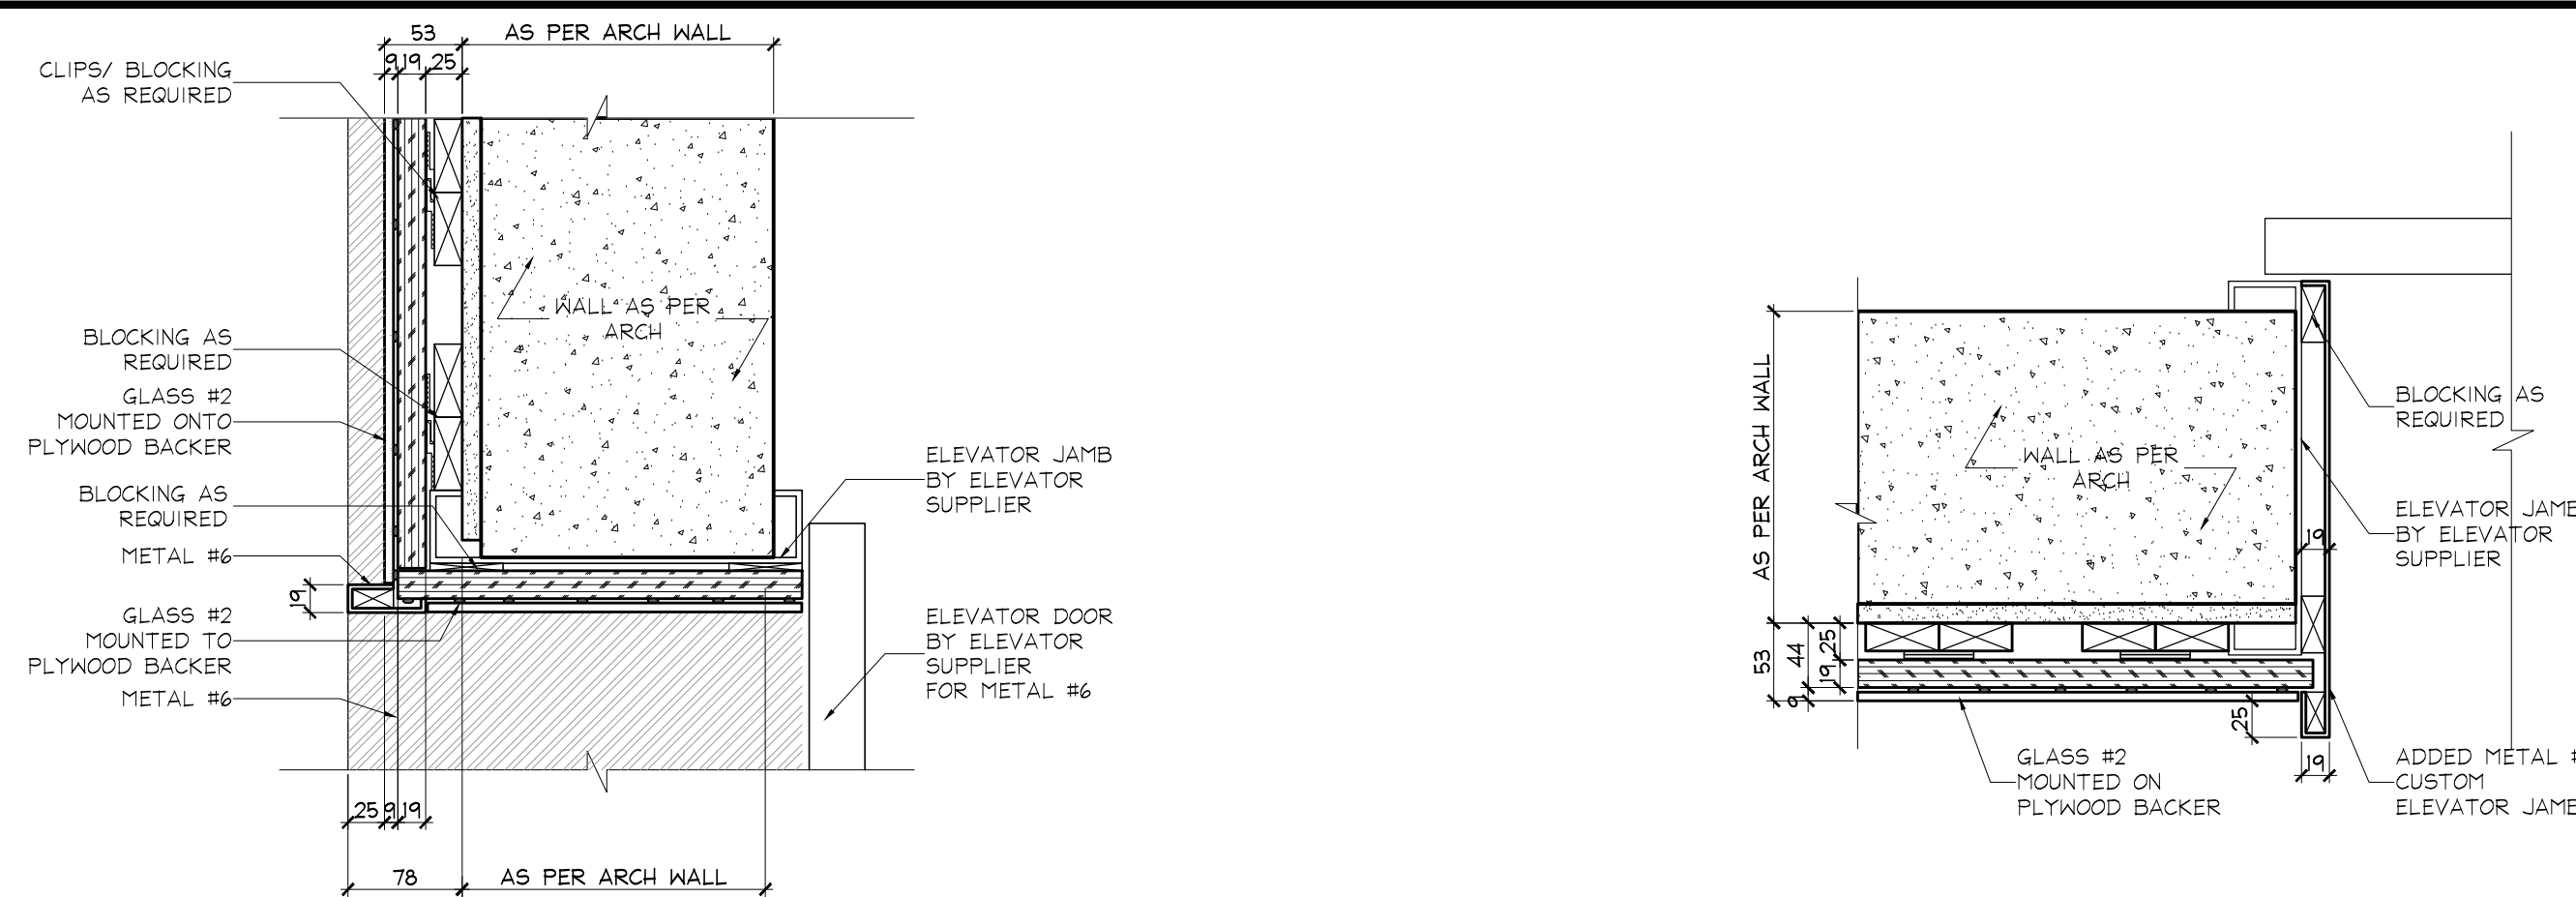


2 ELEVATOR HEADER SECTION 1ST FLOOR SCALE 1:5

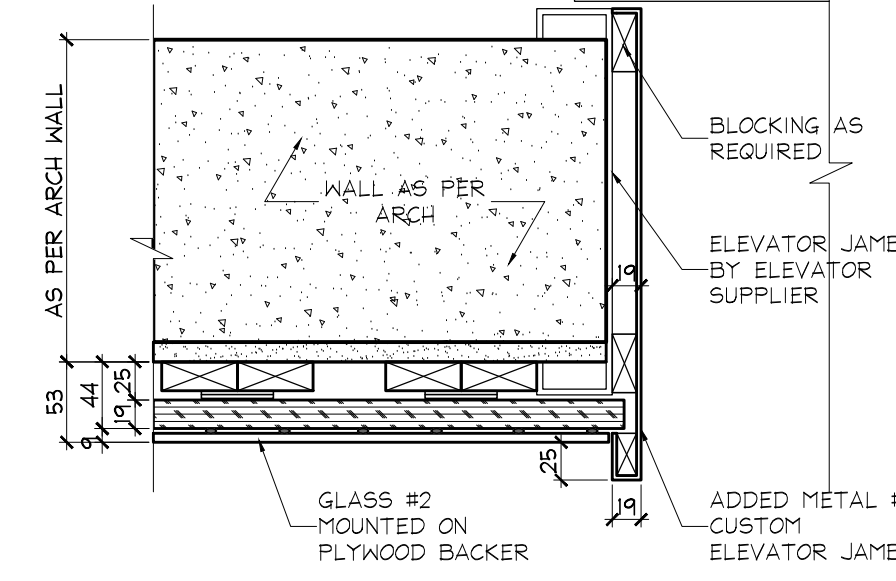


3 ELEVATOR JAMB SECTION 1ST FLOOR SCALE 1:5

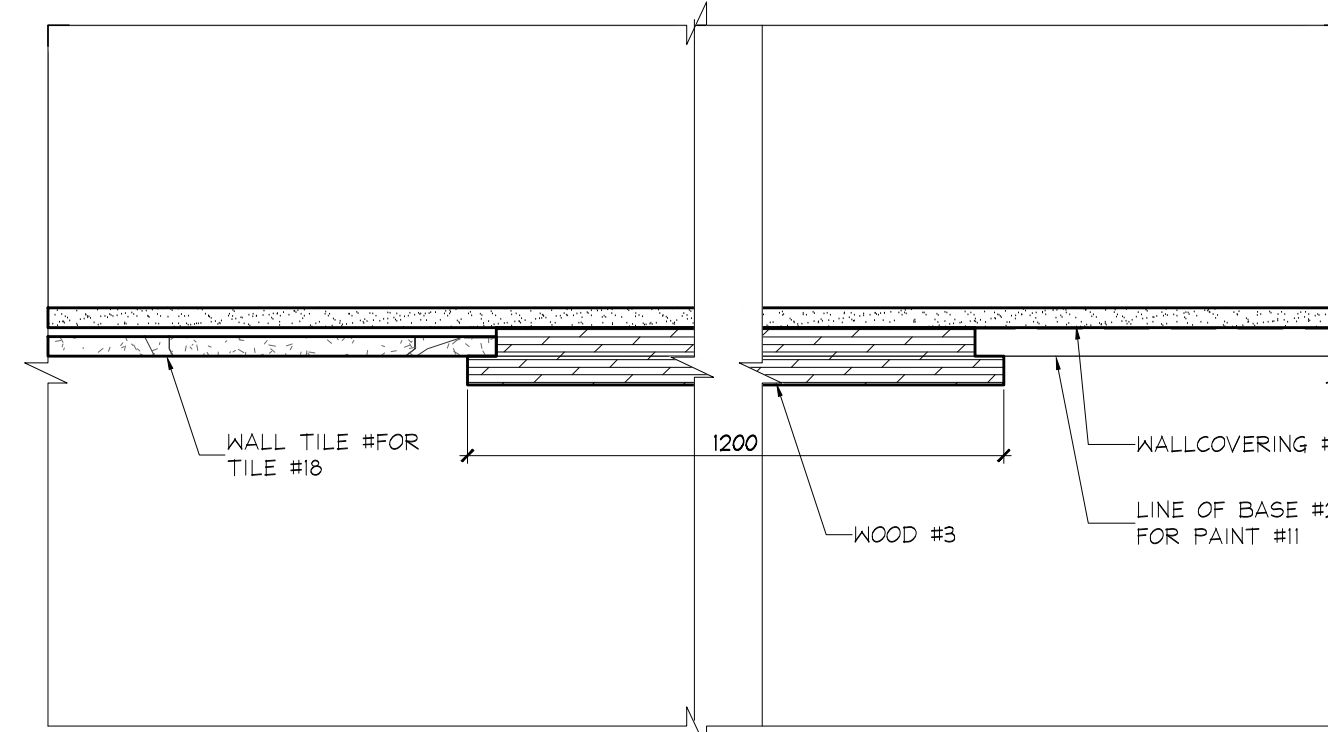


4 SECTION @ WOOD PANEL TYPICAL CORRIDOR SCALE 1:5

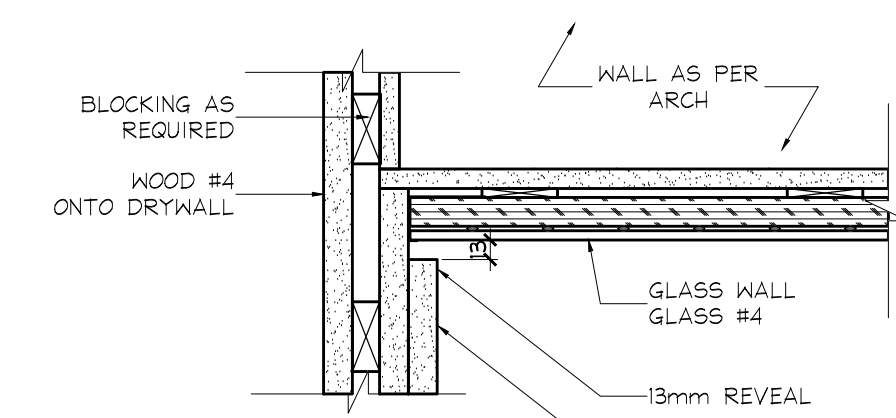


5 PLAN SECTION @ WOOD PANEL & GLASS WALL CONNECTION 1ST FLOOR LOBBY SCALE 1:5

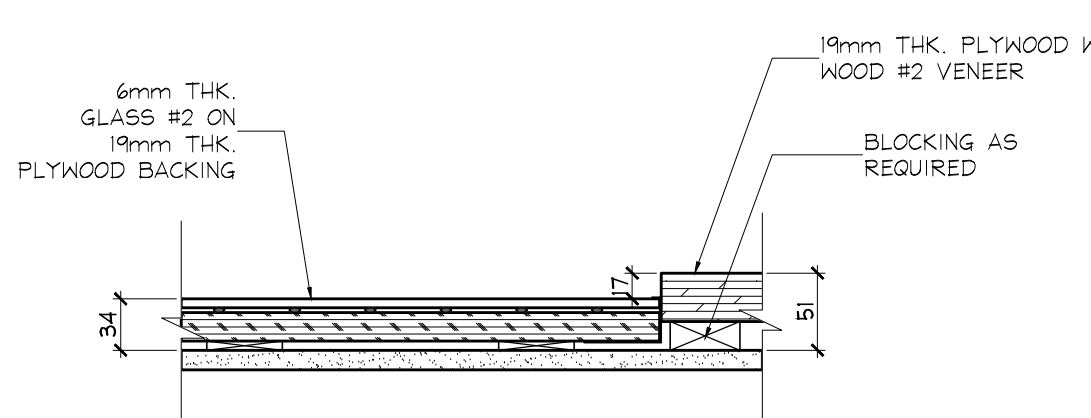


6 PLAN SECTION @ WOOD PANEL & GLASS WALL TRANSITION 1ST FLOOR LOBBY SCALE 1:5

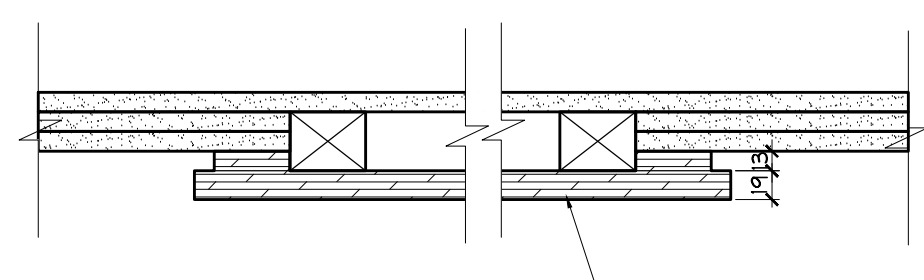


7 PLAN SECTION @ WOOD WALL 1ST FLOOR LOBBY SCALE 1:5

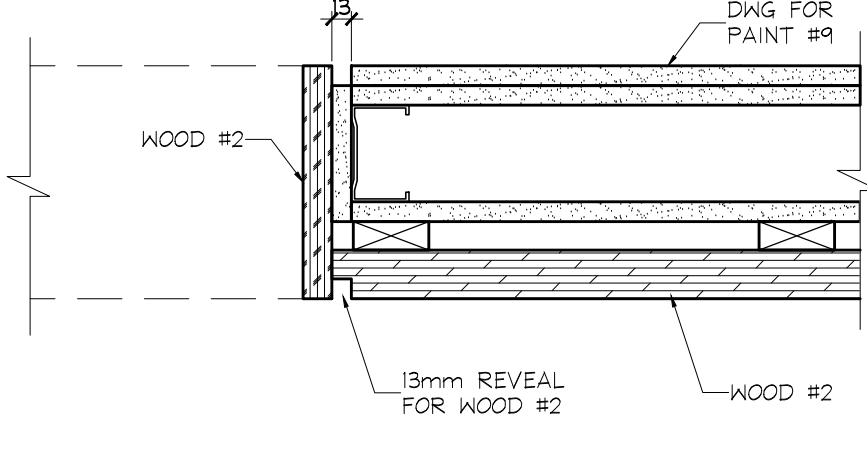


8 PLAN SECTION @ MAILROOM - JAMB 1ST FLOOR LOBBY SCALE 1:5

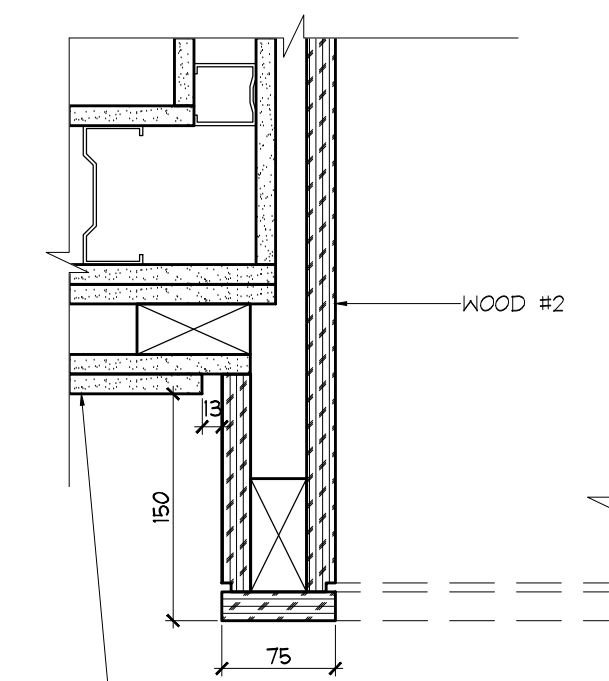


9 SECTION 1ST FLOOR ENTRANCE TO PARTY ROOM SCALE 1:5

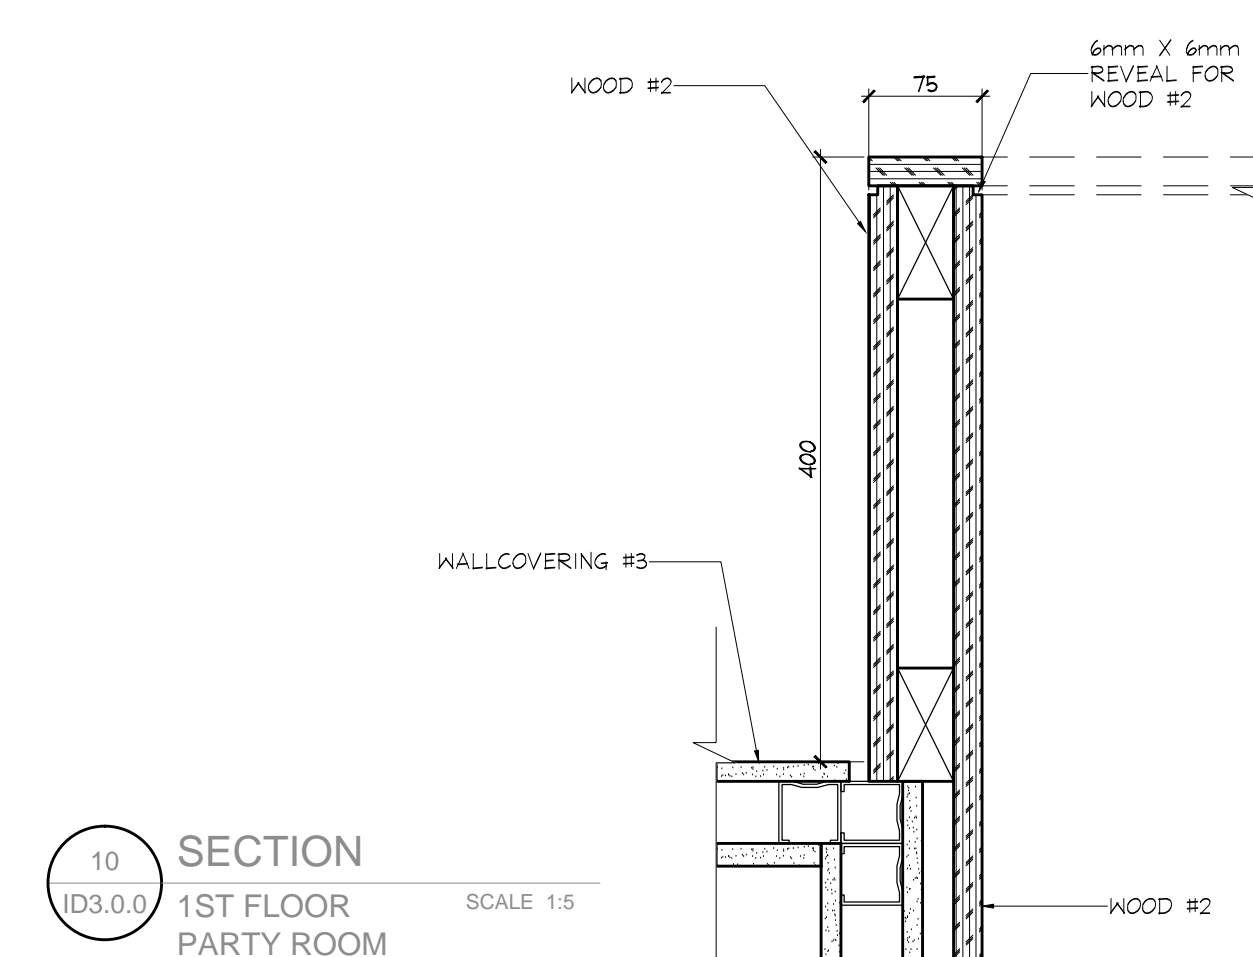


10 SECTION 1ST FLOOR PARTY ROOM SCALE 1:5

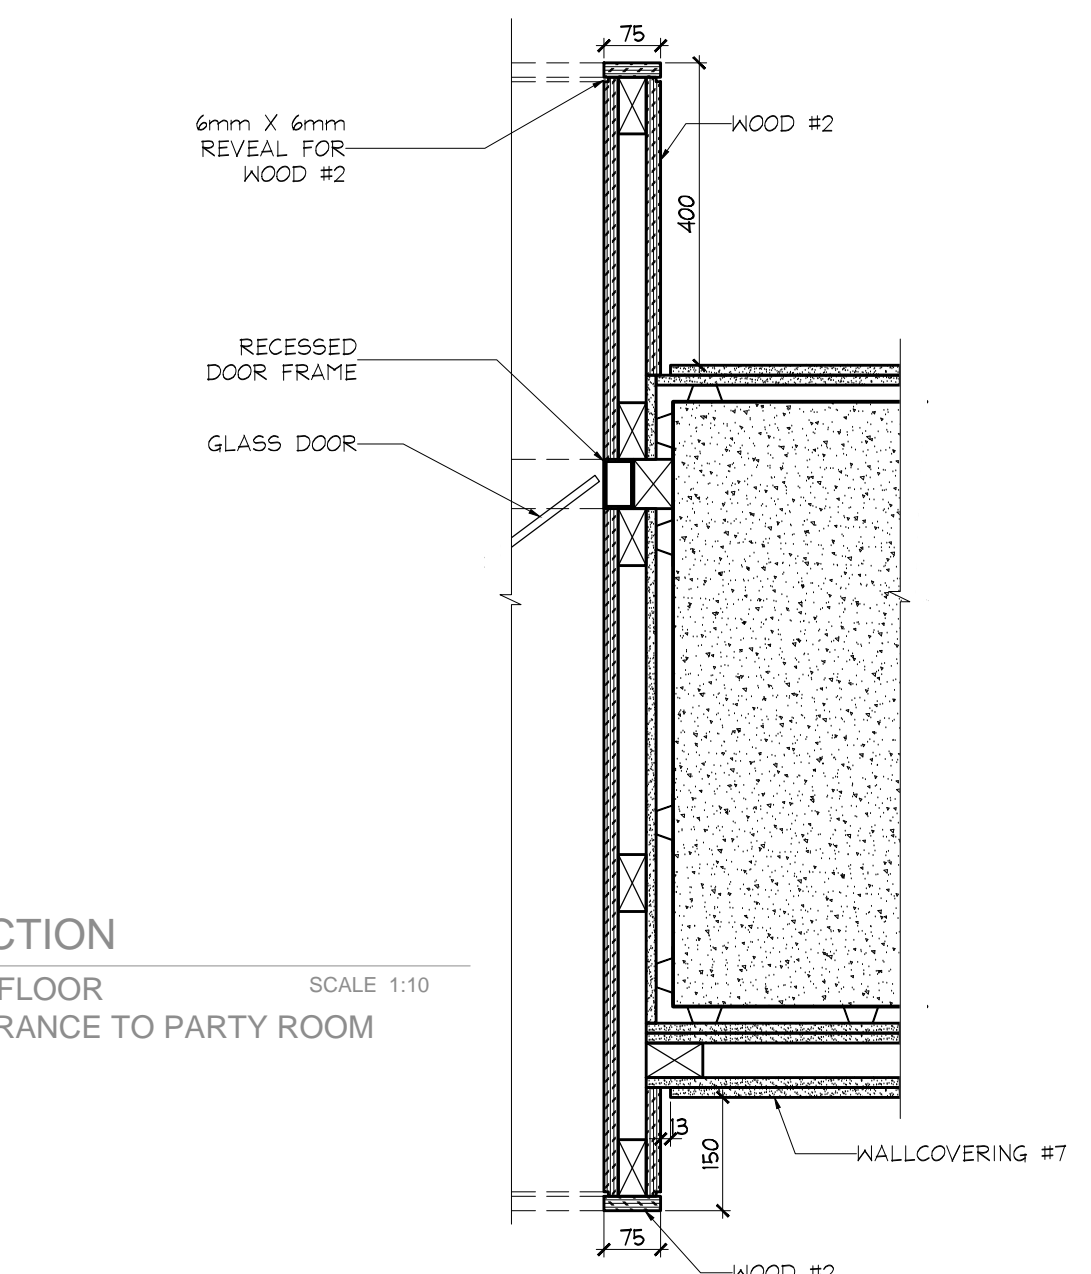


11 SECTION 1ST FLOOR ENTRANCE TO PARTY ROOM SCALE 1:10

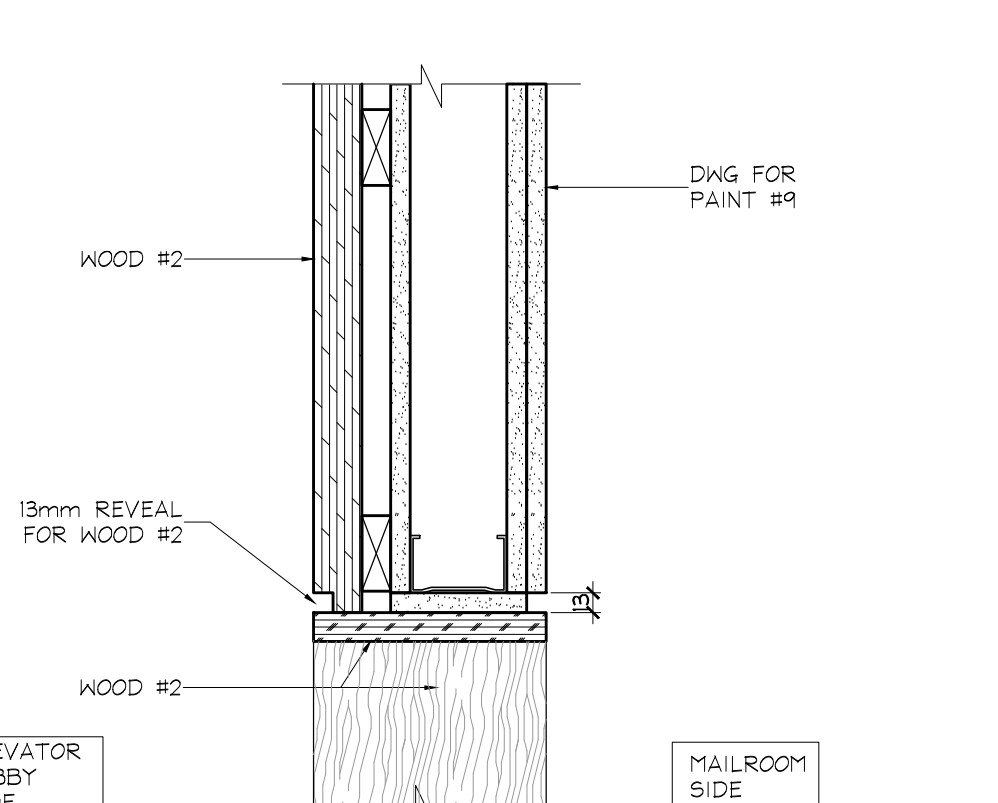


12 MAILROOM ENTRANCE HEADER SECTION 1ST FLOOR LOBBY SCALE 1:5

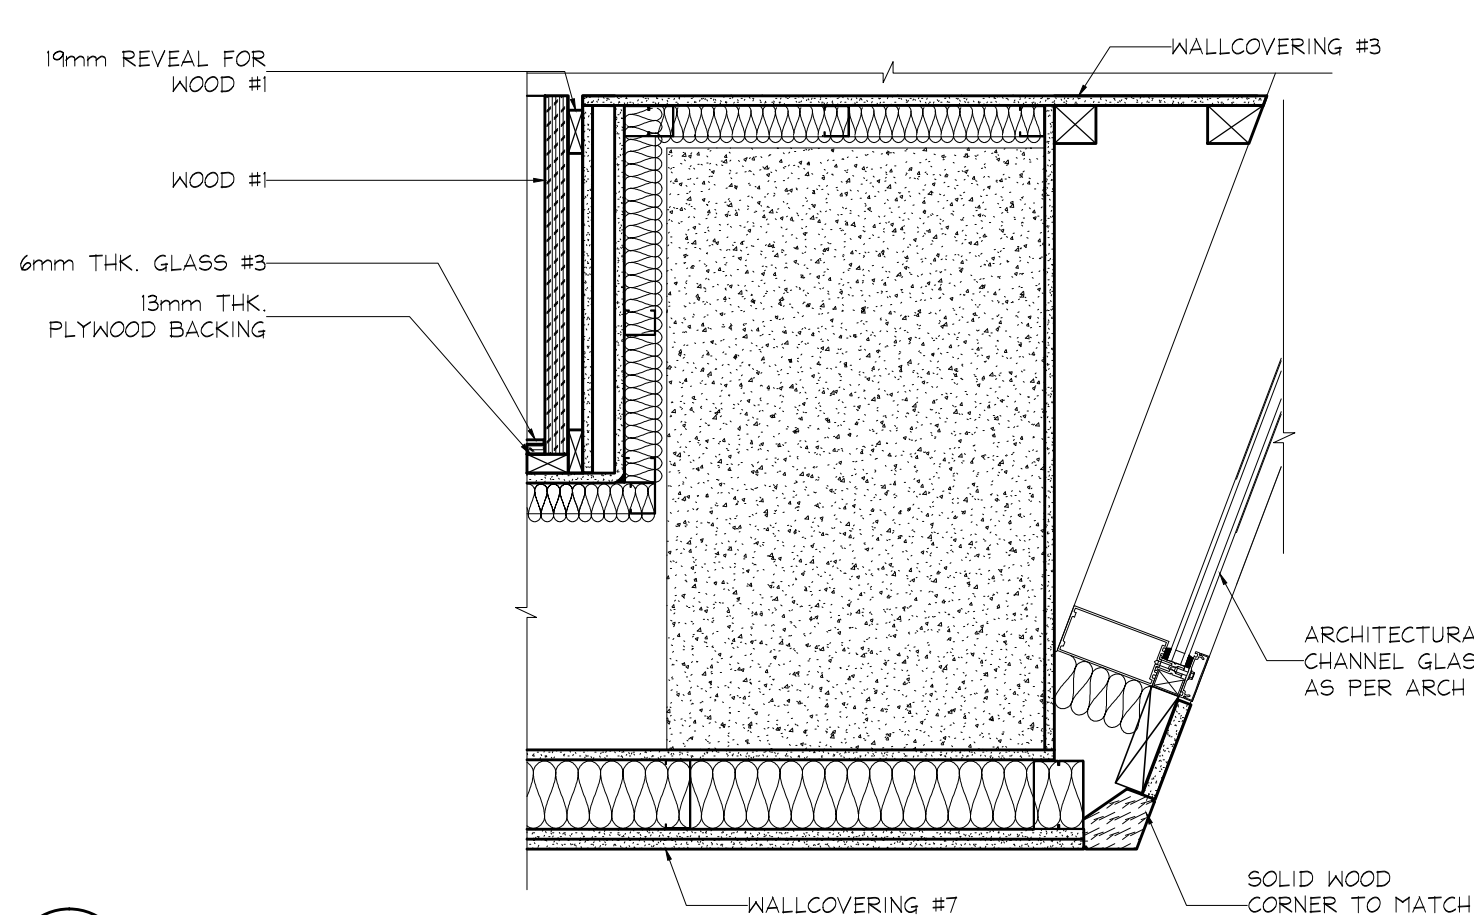


13 SECTION 1ST FLOOR LOBBY SCALE 1:10

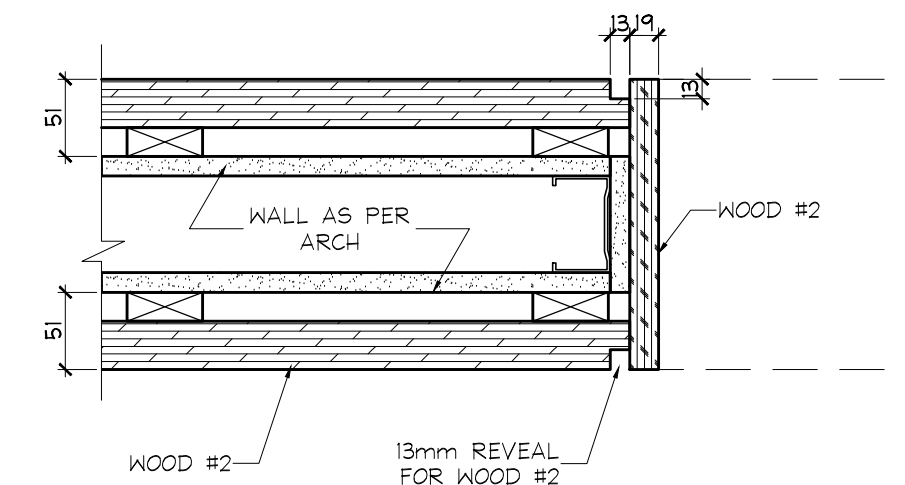


14 PLAN SECTION @ CORRIDOR 'D' & ANTIROOM 1ST FLOOR LOBBY SCALE 1:5

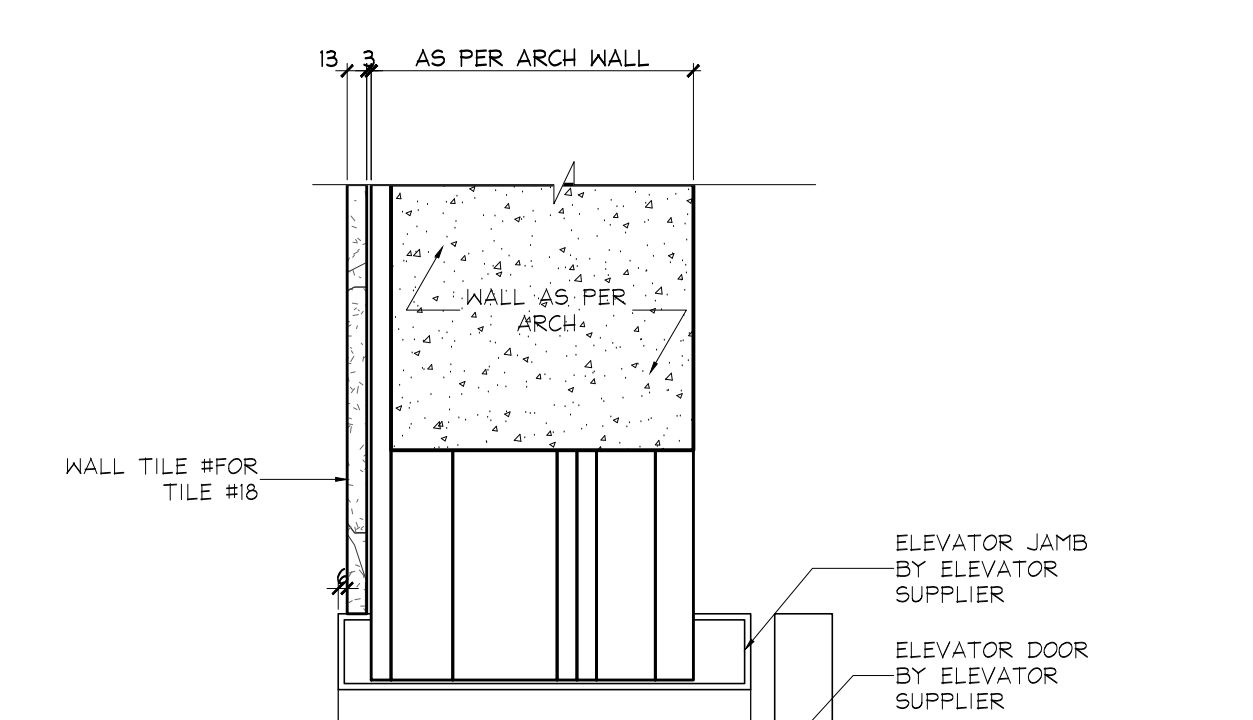


15 ELEVATOR HEADER SECTION TYPICAL SCALE 1:5

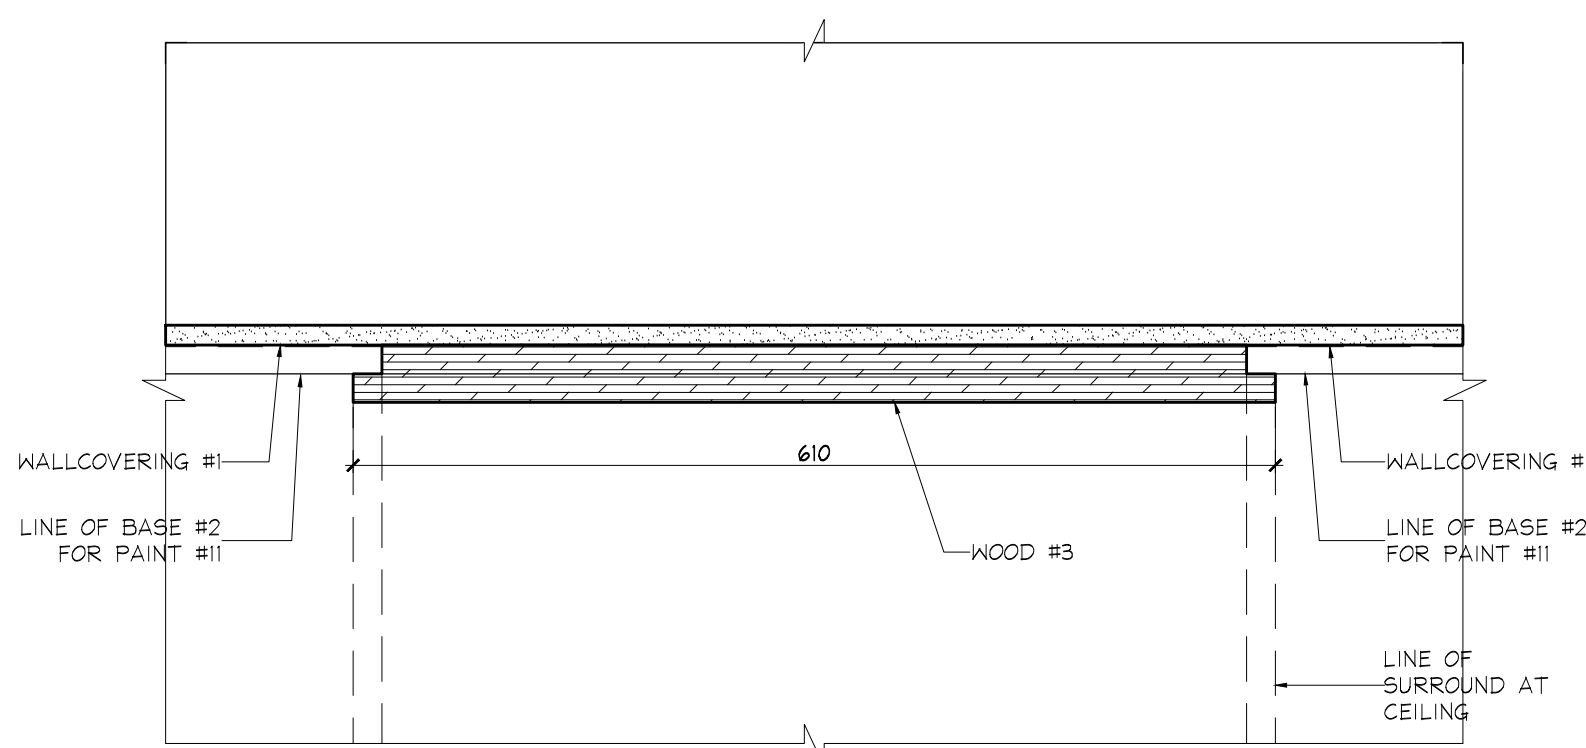


16 SECTION @ WOOD PANEL TYPICAL CORRIDOR SCALE 1:5

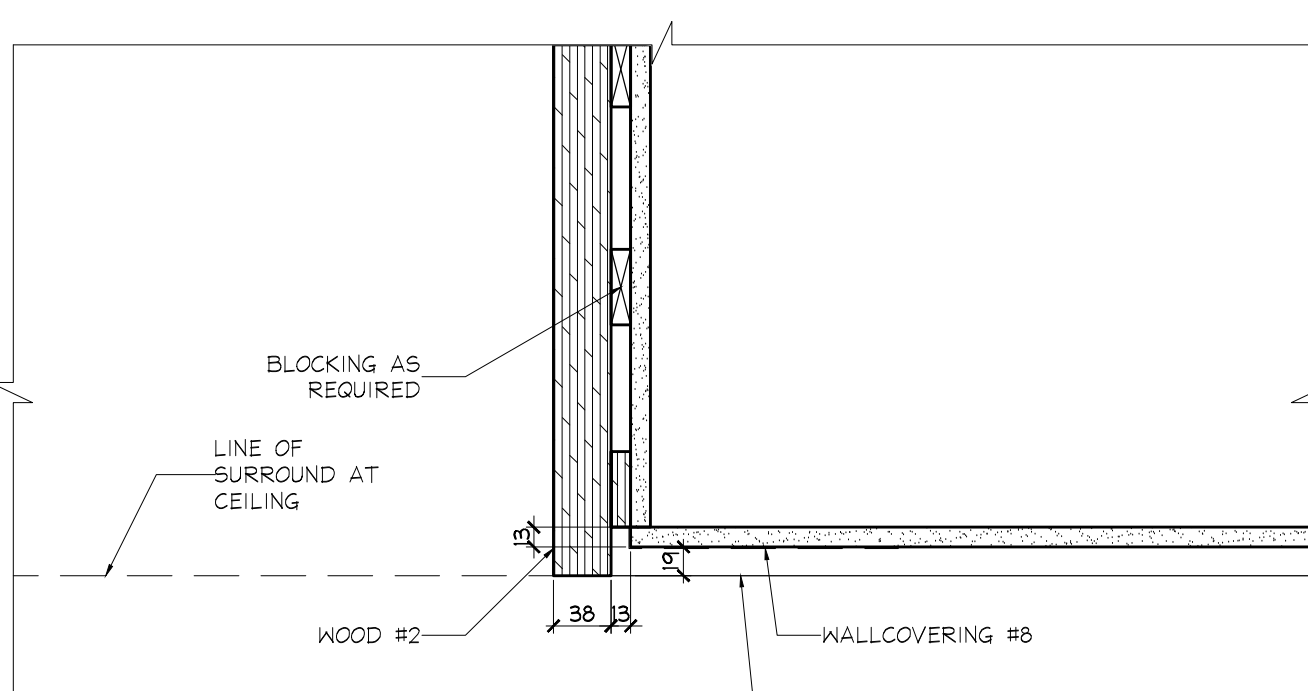


17 SECTION @ WOOD PANEL 1ST FLOOR AMENITY FITNESS SCALE 1:5

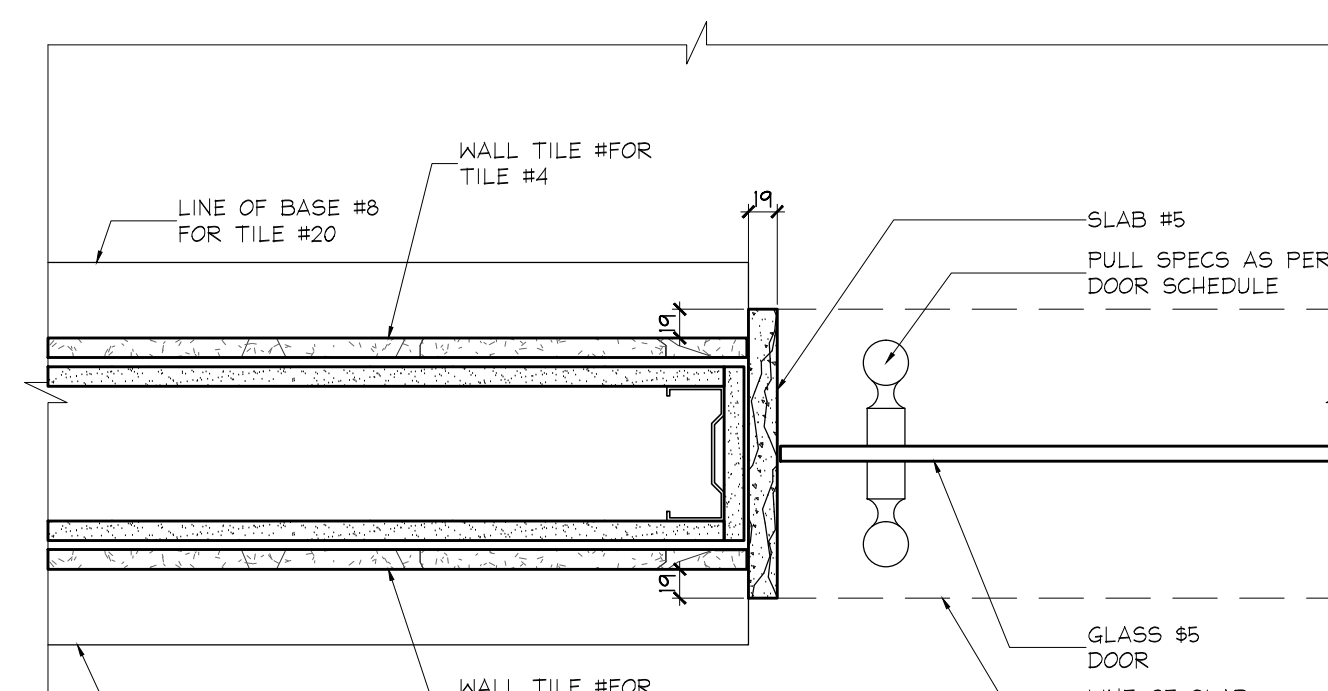


18 JAMB DETAIL 1ST FLOOR WHIRLPOOL SPA SCALE 1:5

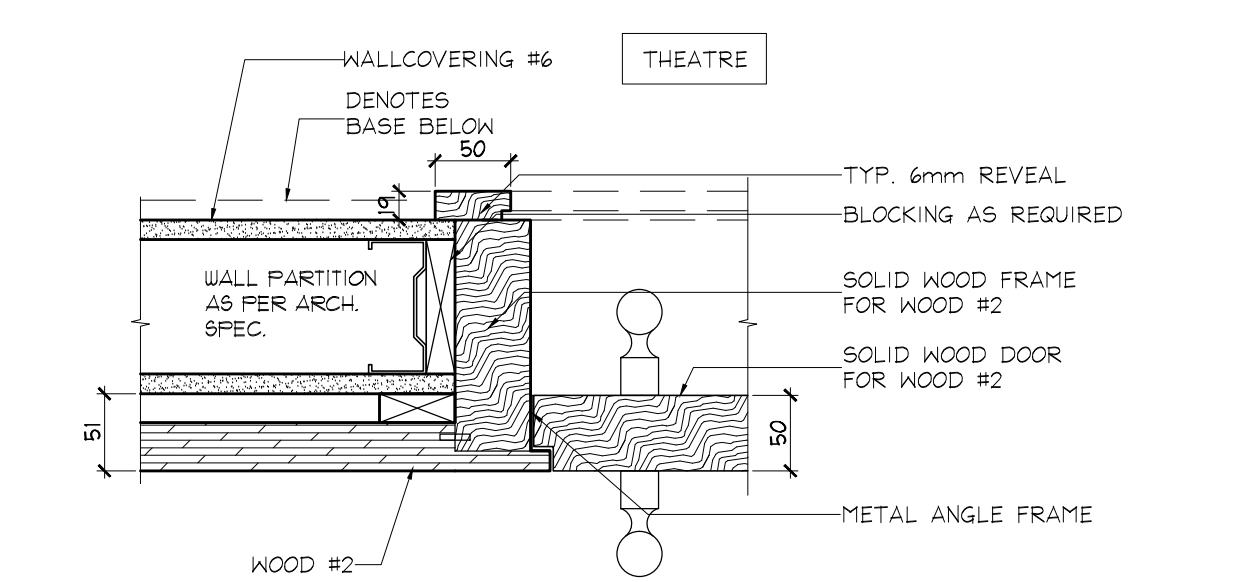


19 JAMB DETAIL 1ST FLOOR THEATRE SCALE 1:5

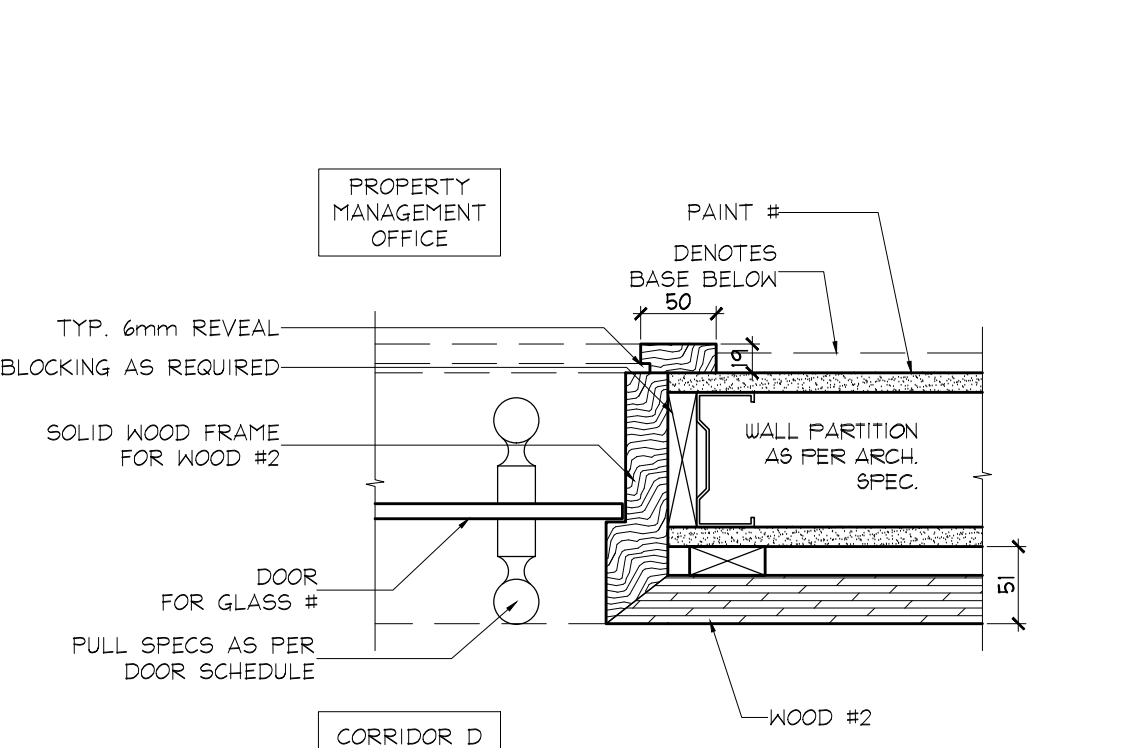


20 JAMB DETAIL 1ST FLOOR PROPERTY MANAGEMENT OFFICE SCALE 1:5

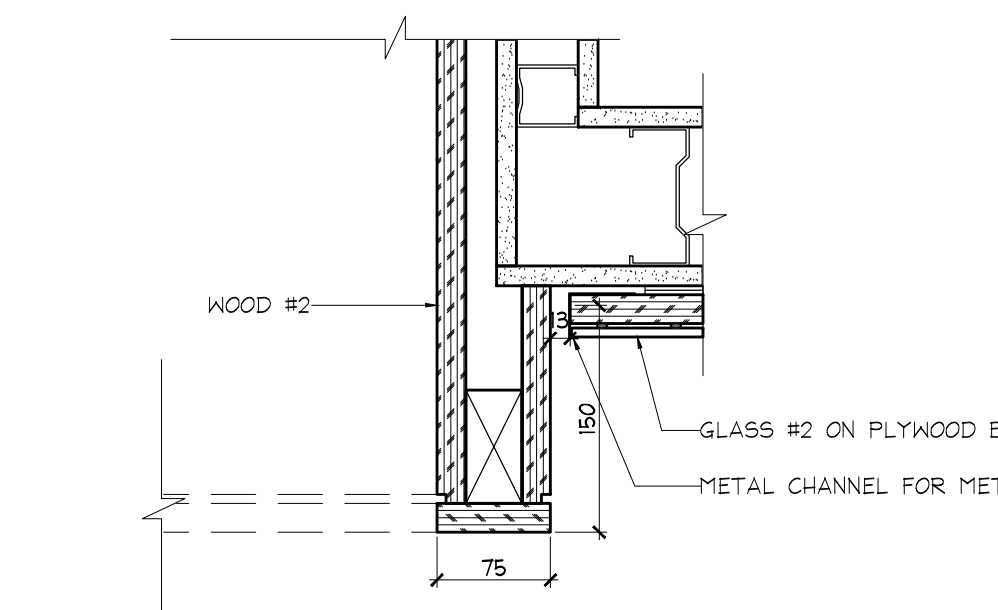


21 SECTION 1ST FLOOR ENTRANCE TO CORRIDOR 'D' SCALE 1:5

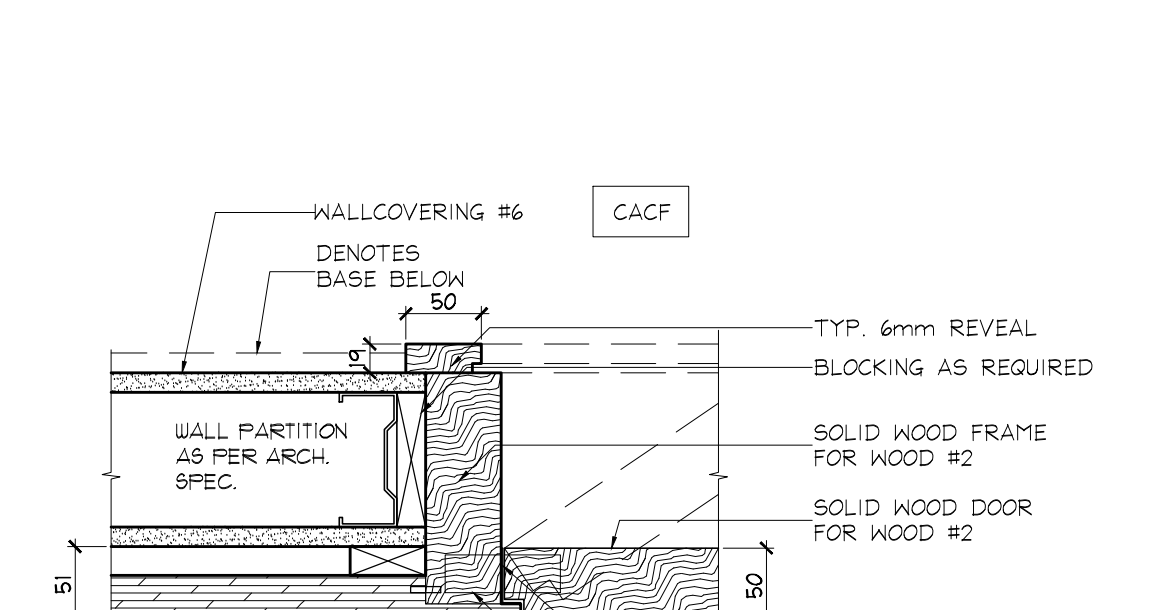


22 JAMB DETAIL 1ST FLOOR CACF SCALE 1:5

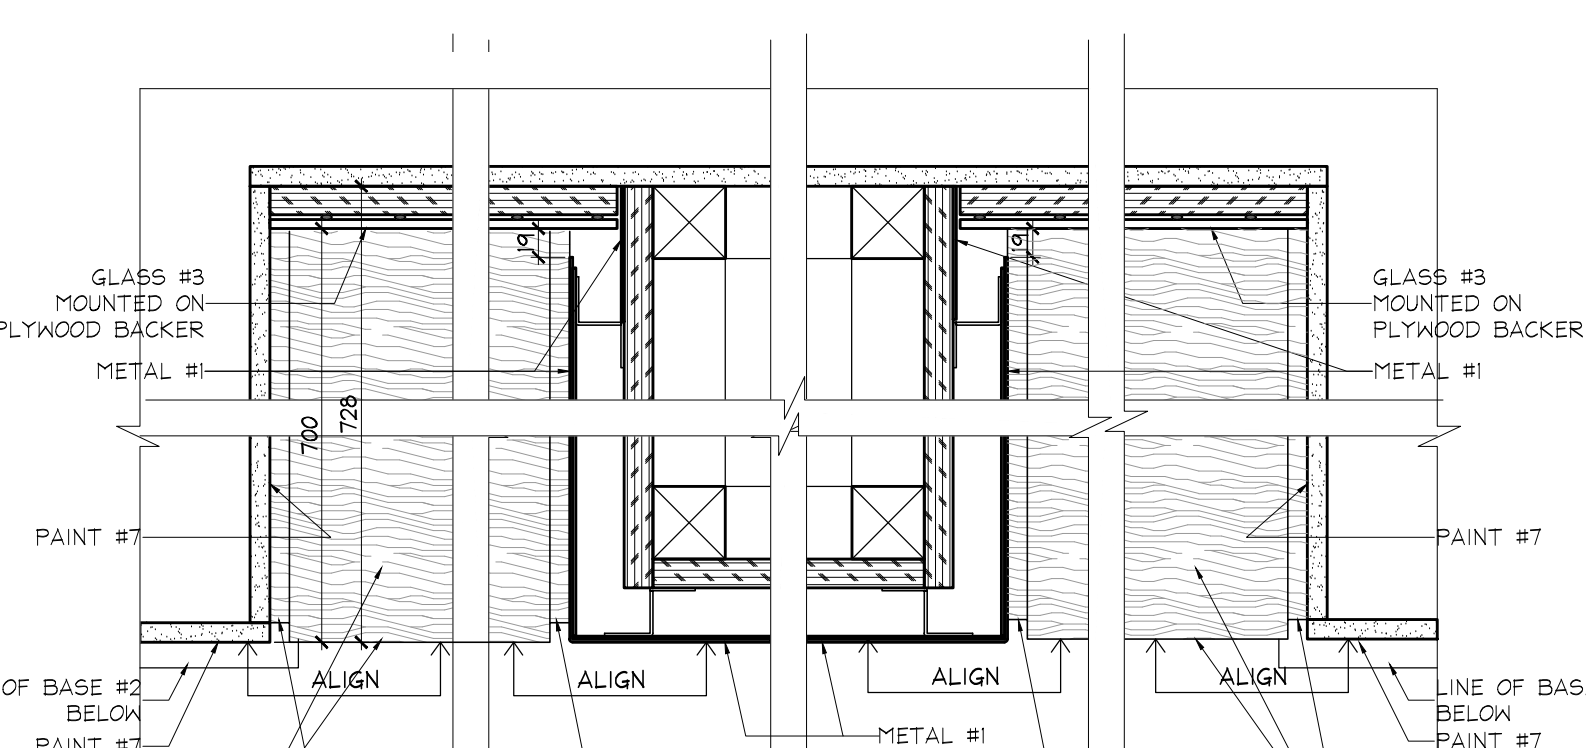


23 PLAN DETAIL 1ST FLOOR FIREPLACE @ DINING ROOM SCALE 1:5

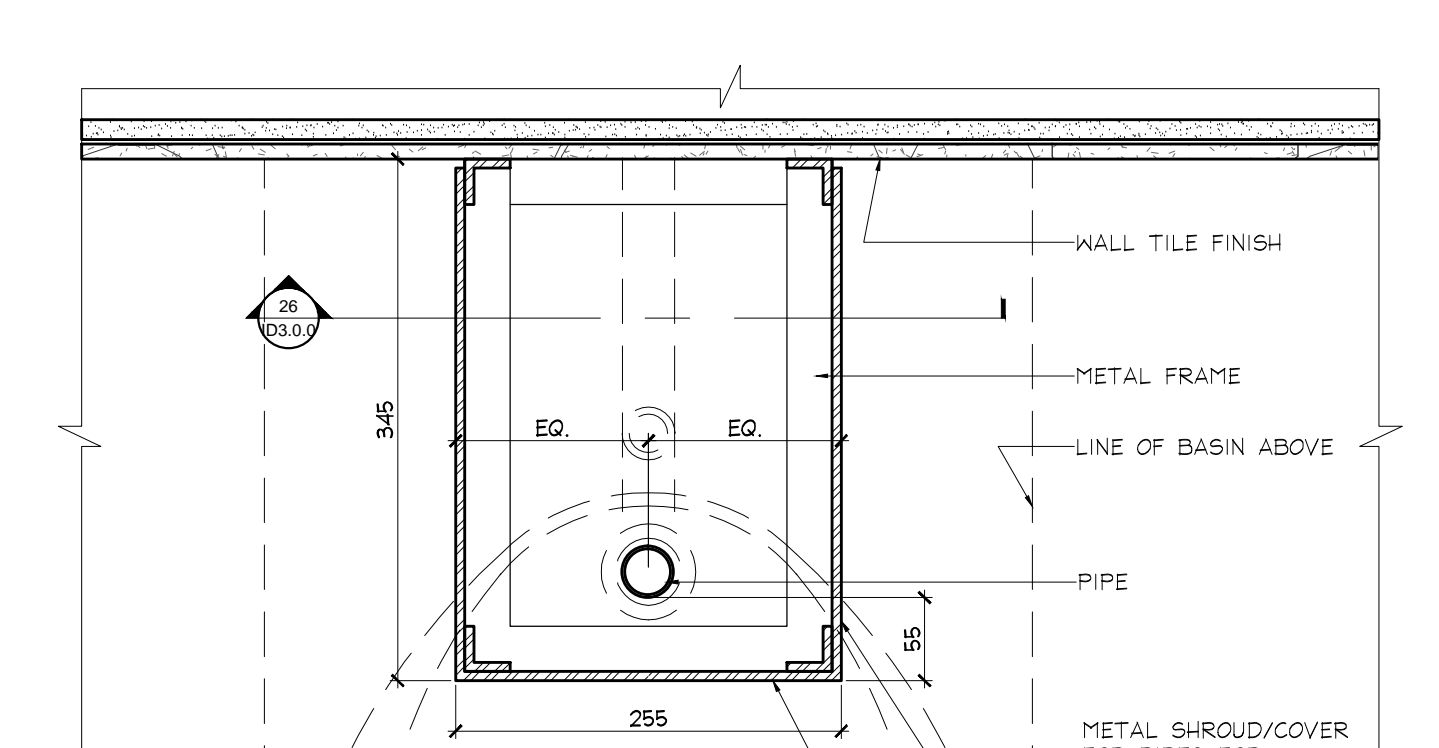


24 PLAN DETAIL TYPICAL METAL SHROUD @ B.F. WASHROOM SCALE 1:5

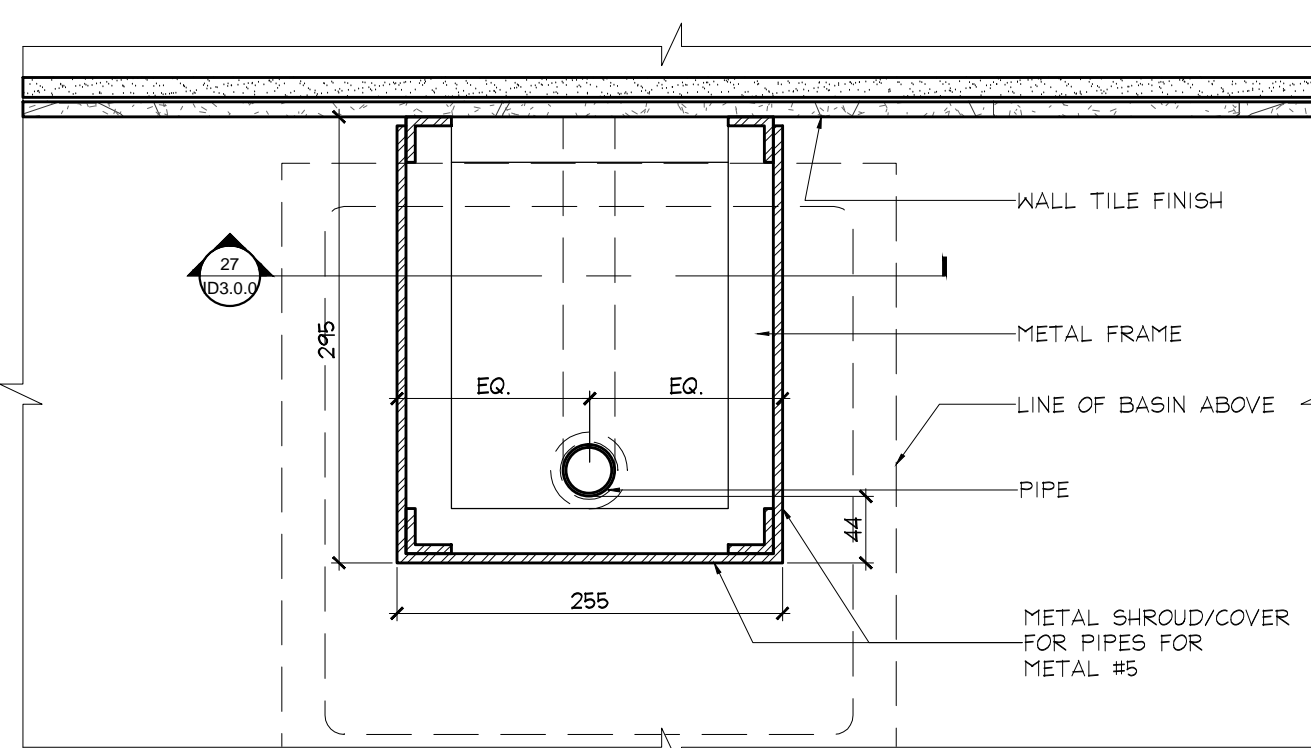

25 PLAN DETAIL 1ST FLOOR METAL SHROUD @ CHANGEROOM SCALE 1:5

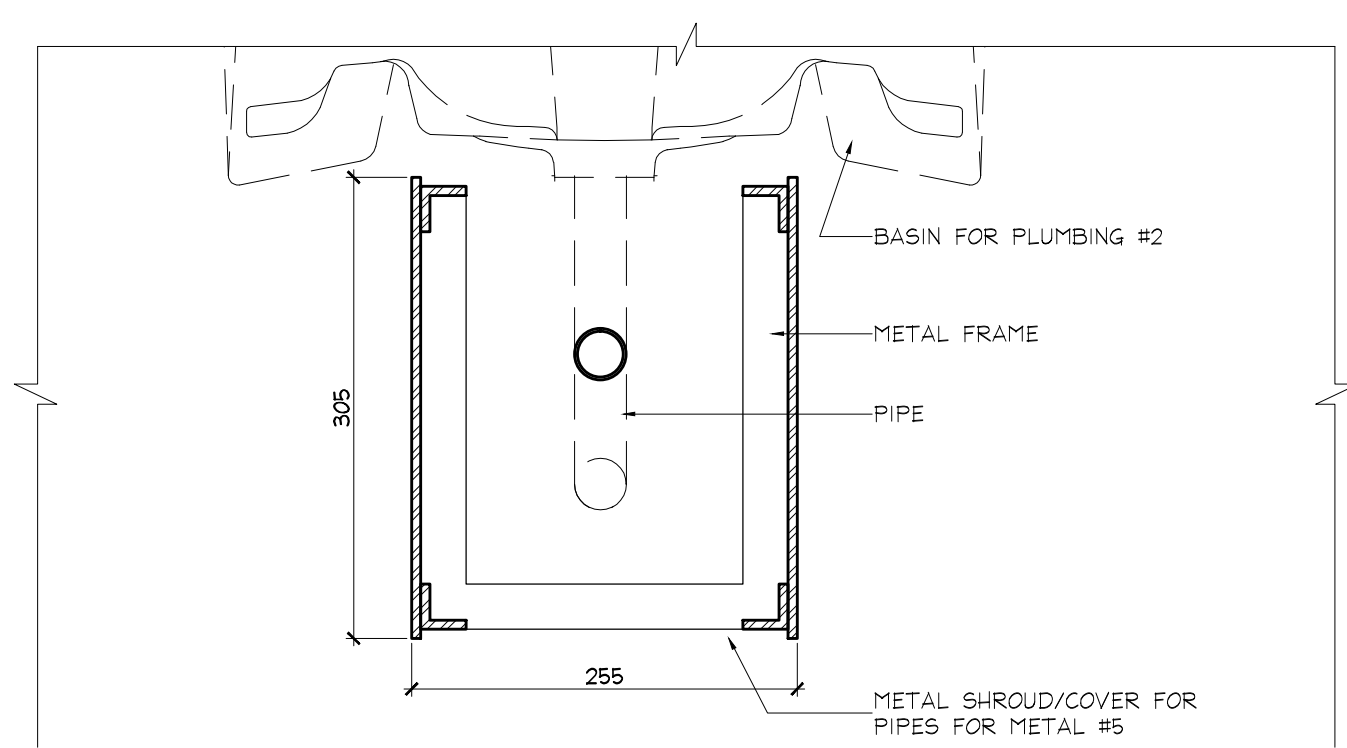

26 SECTION TYPICAL METAL SHROUD @ B.F. WASHROOM SCALE 1:5

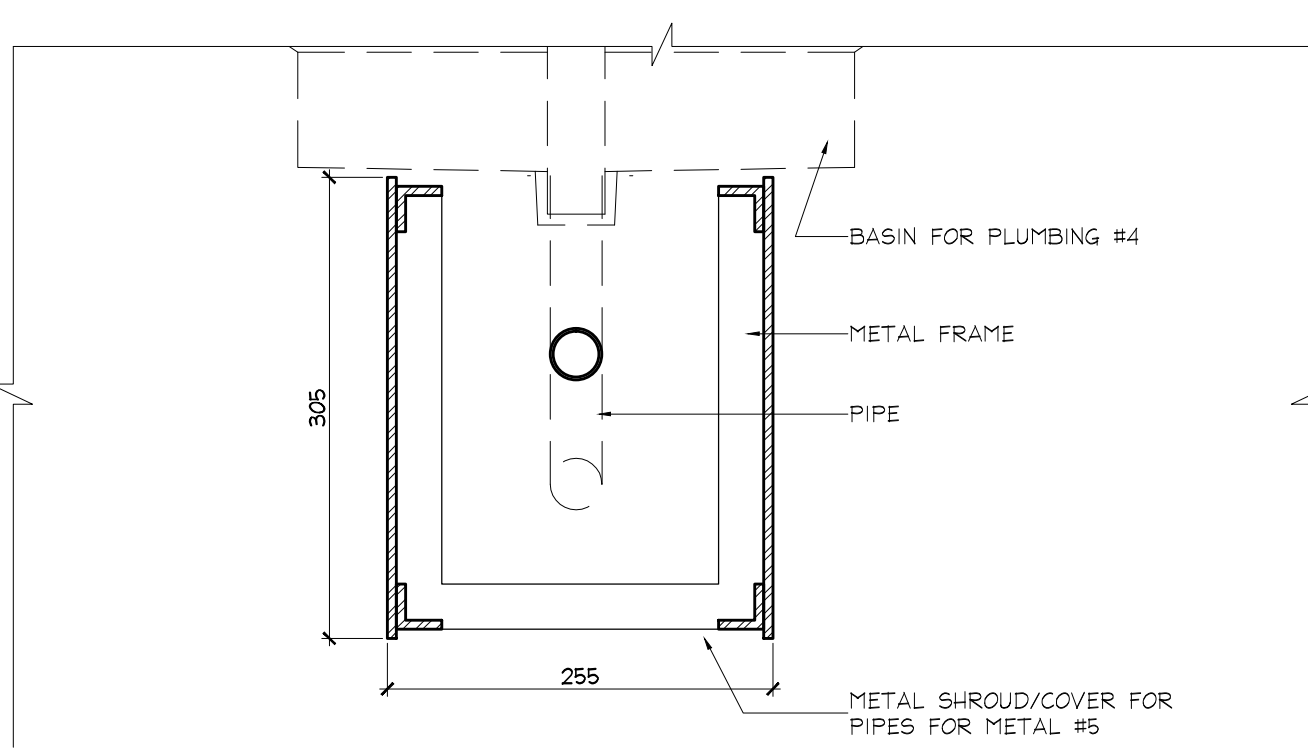

27 SECTION 1ST FLOOR METAL SHROUD @ CHANGEROOM SCALE 1:5

ISSUED FOR AS-BUILT

01	31 MAY 17	ISSUED FOR AS-BUILT	SV
NO.	DATE	COMMENTS	INI
REVISIONS:			

UNOBI

UNOBI INC. 183 BATHURST STREET, STE. 201 TORONTO, ON, M5T 2R7, CANADA TEL: 416-597-1576 FAX: 416-597-2139

PROJECT NAME:	
ALEXANDRA PARK MAIN BUILDING	
BLOCK 11 ON, Canada	
PROJECT NO.:	13-949
DRAWINGS:	
PLAN DETAILS	
DATE STARTED:	07 AUG / 13
SCALE:	AS NOTED
DRAWN BY:	SM
APPROVED BY:	KC
DRAWING NO.:	ID 3.0.0