




1 CEILING SECTION  
EAST VESTIBULE  
1ST FLOOR SCALE 1:5

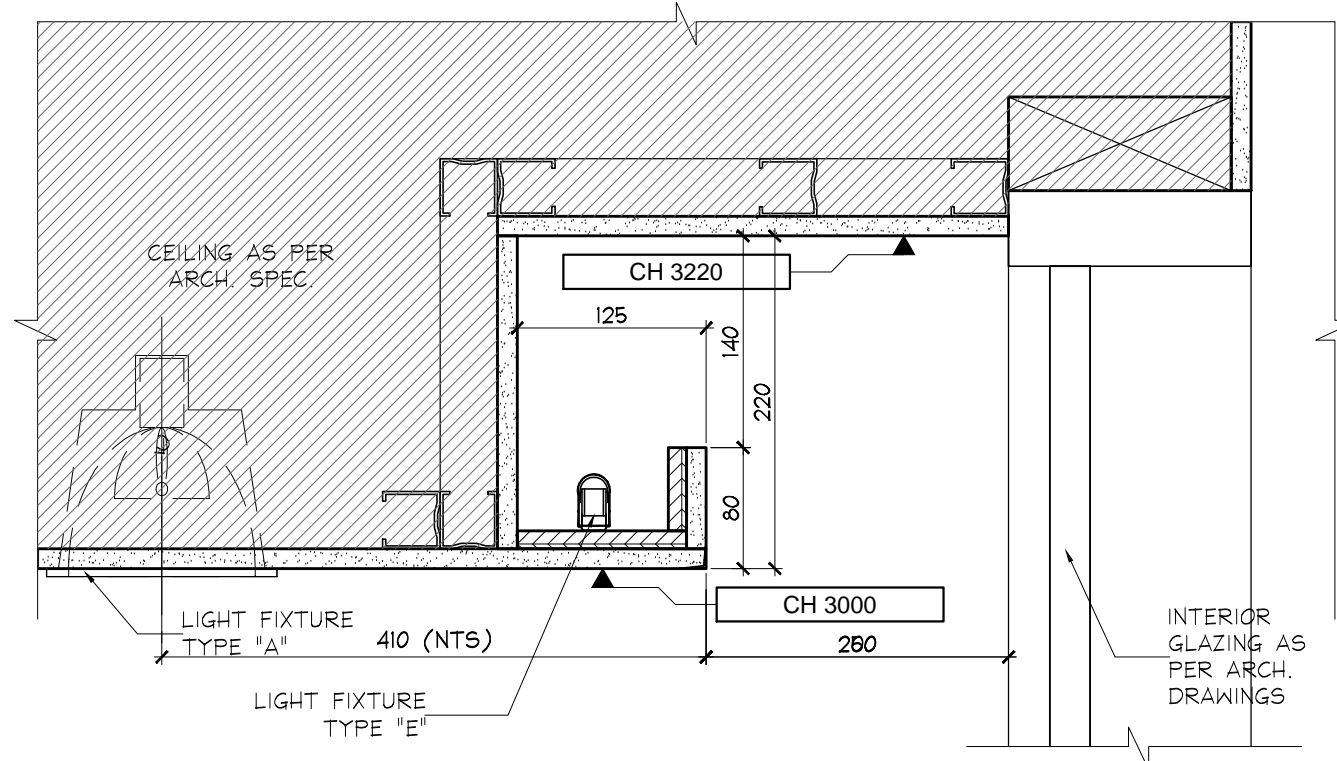


2 CEILING SECTION  
EAST VESTIBULE  
1ST FLOOR SCALE 1:5

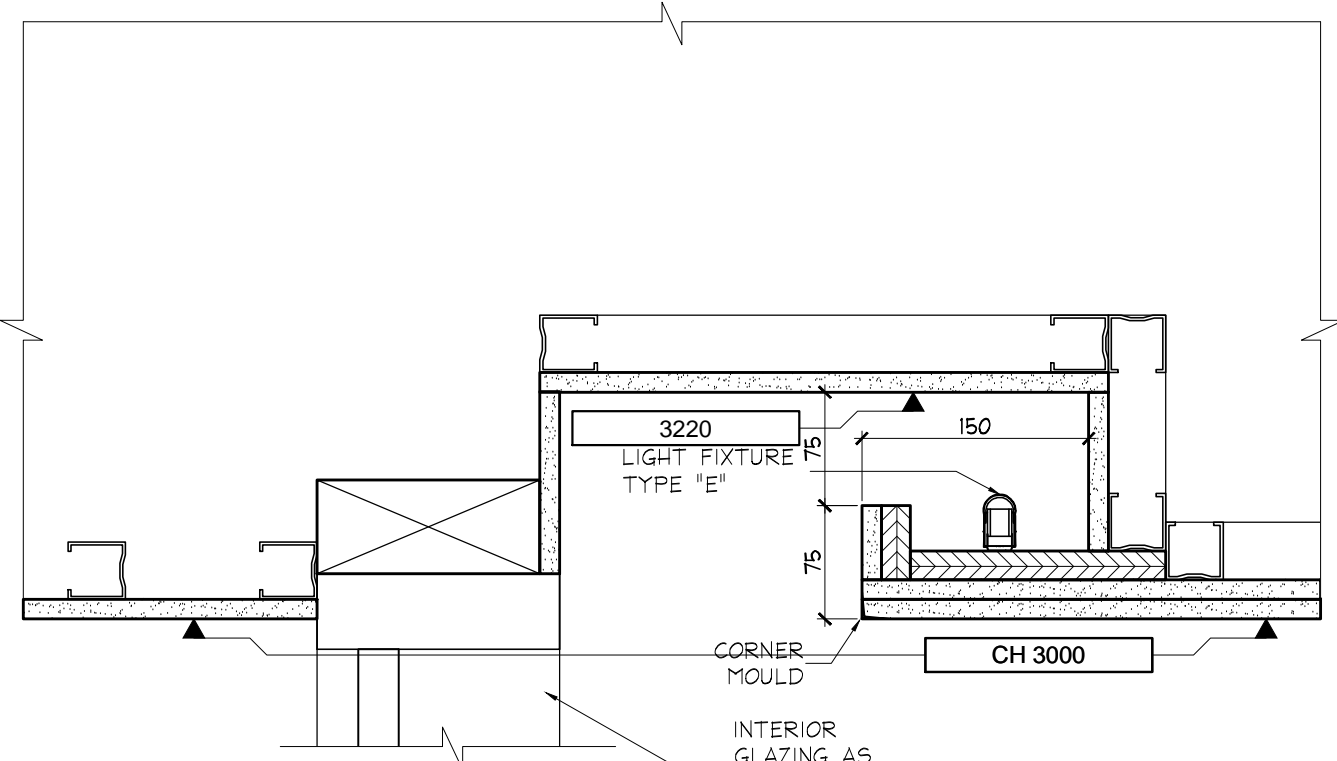


3 CEILING SECTION  
EAST VESTIBULE  
1ST FLOOR SCALE 1:5

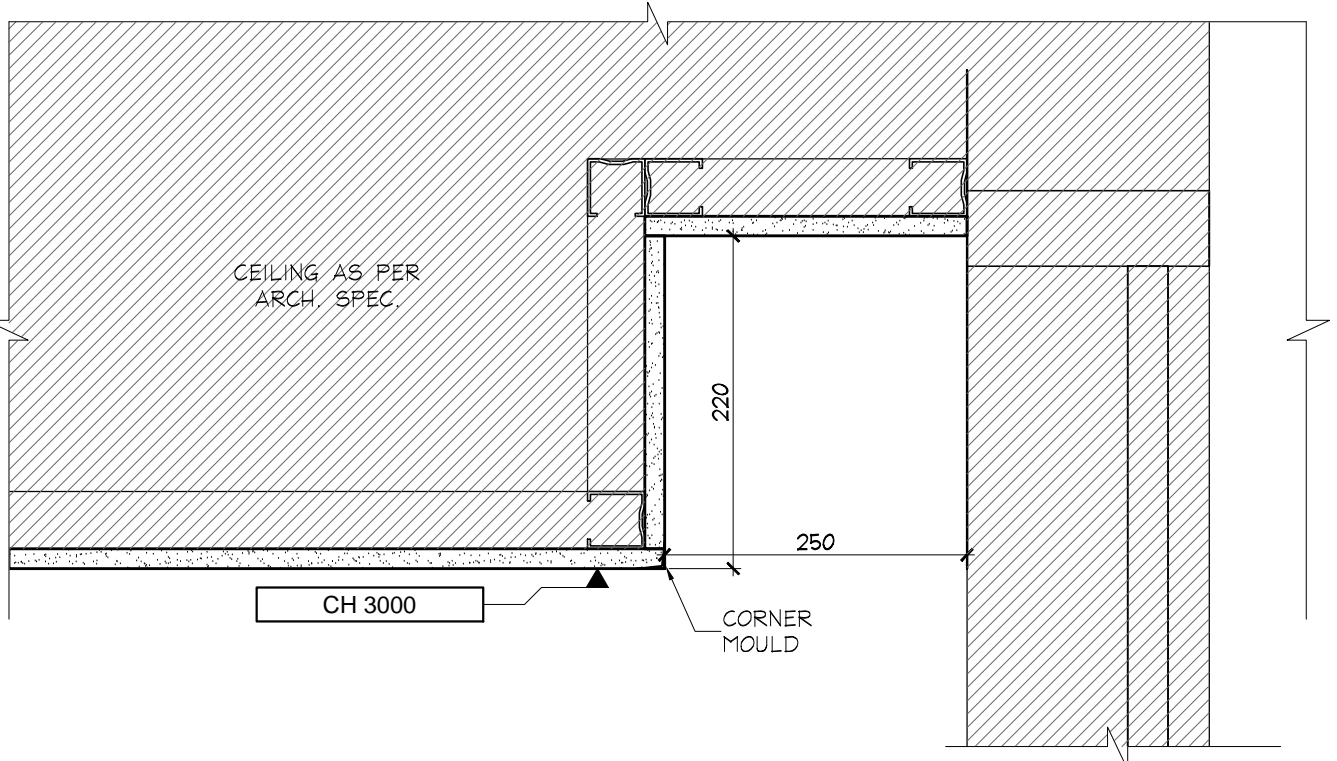


4 SECTION @ EXTERIOR GLAZ  
1ST FLOOR SCALE 1:5

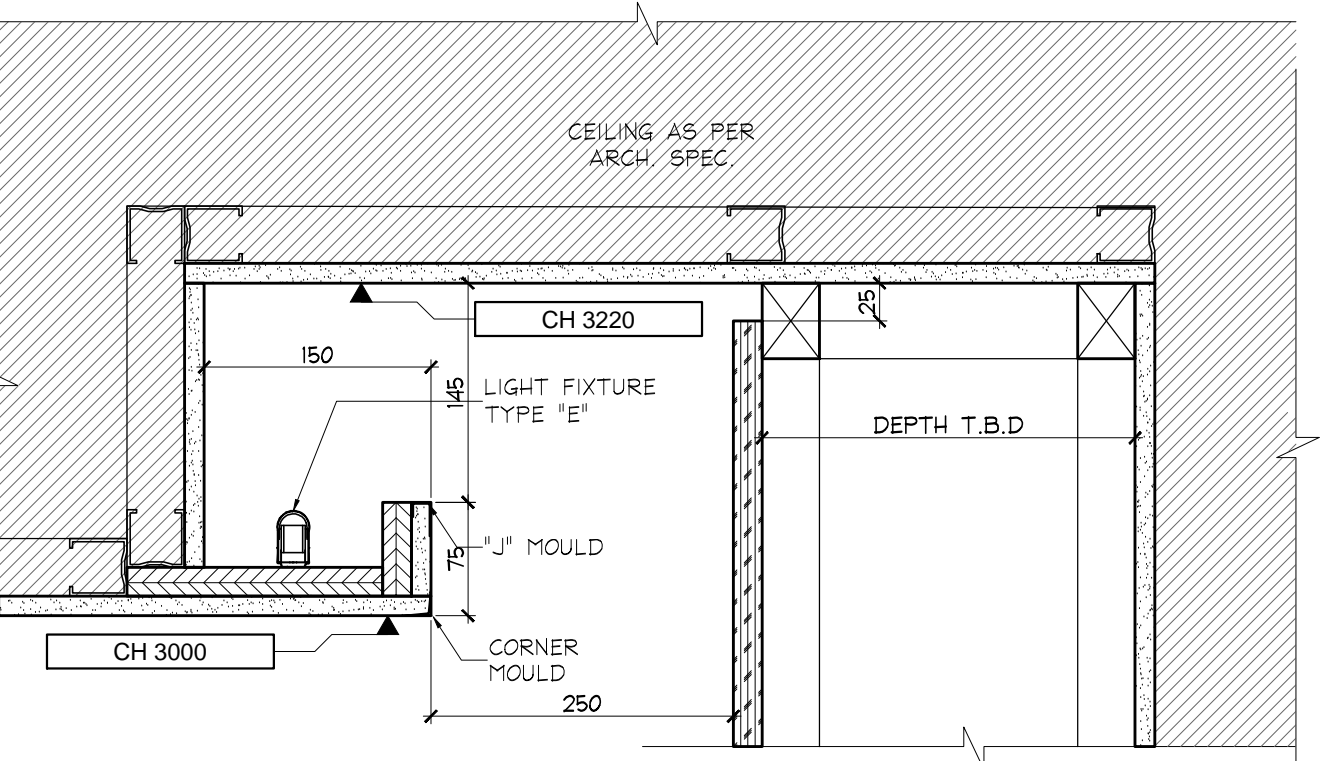


5 SECTION @ FIREPLACE  
1ST FLOOR SCALE 1:5

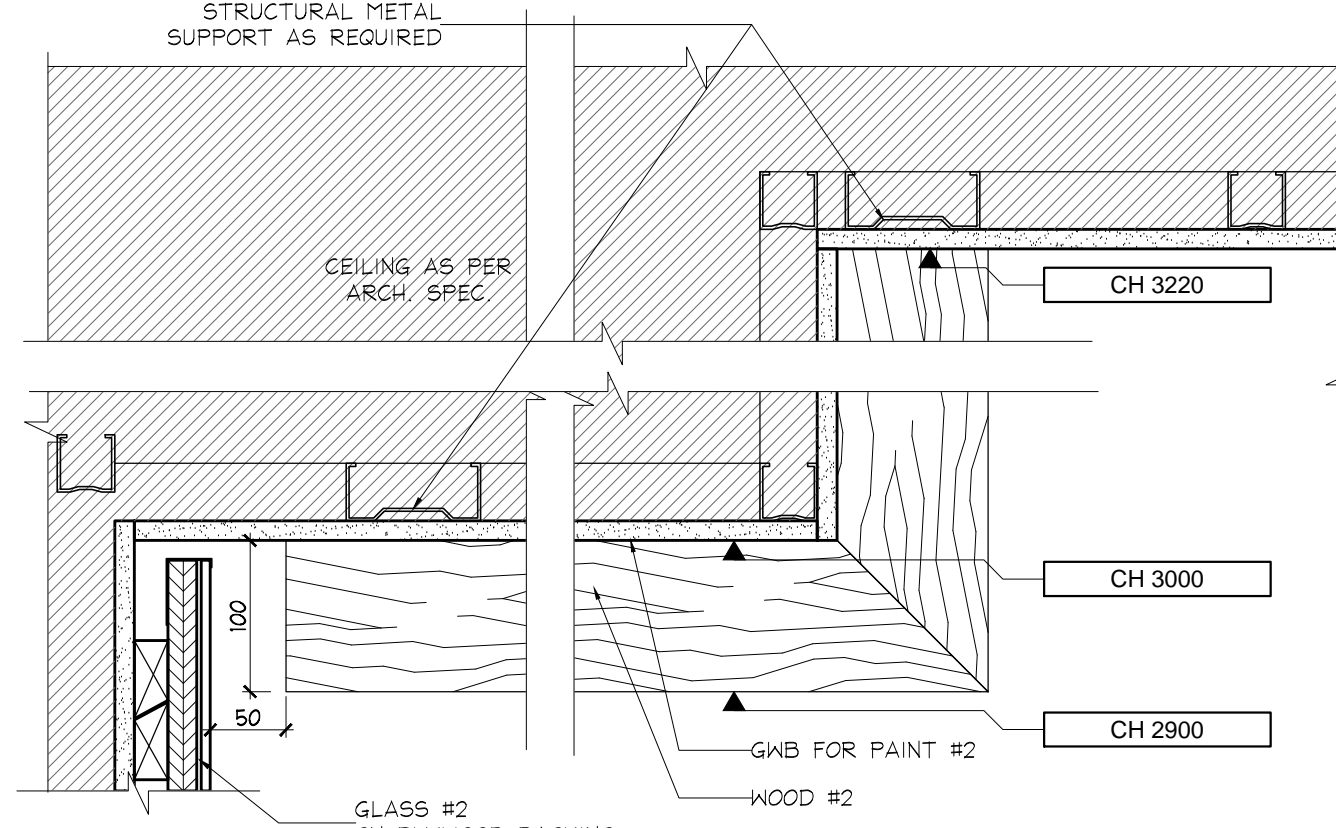


6 BULKHEAD @ CONCIERGE  
1ST FLOOR SCALE 1:5

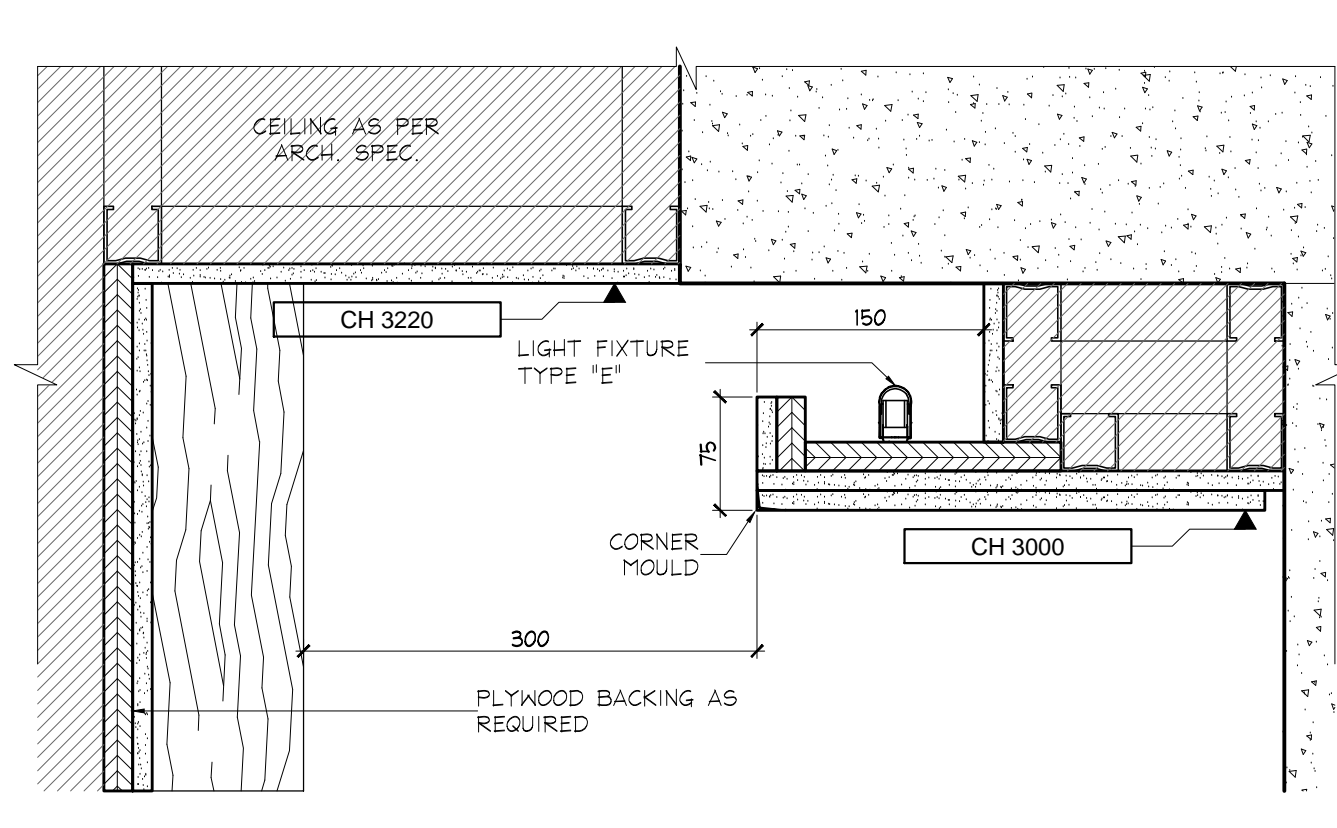


7 BULKHEAD @ CONCIERGE  
1ST FLOOR SCALE 1:5

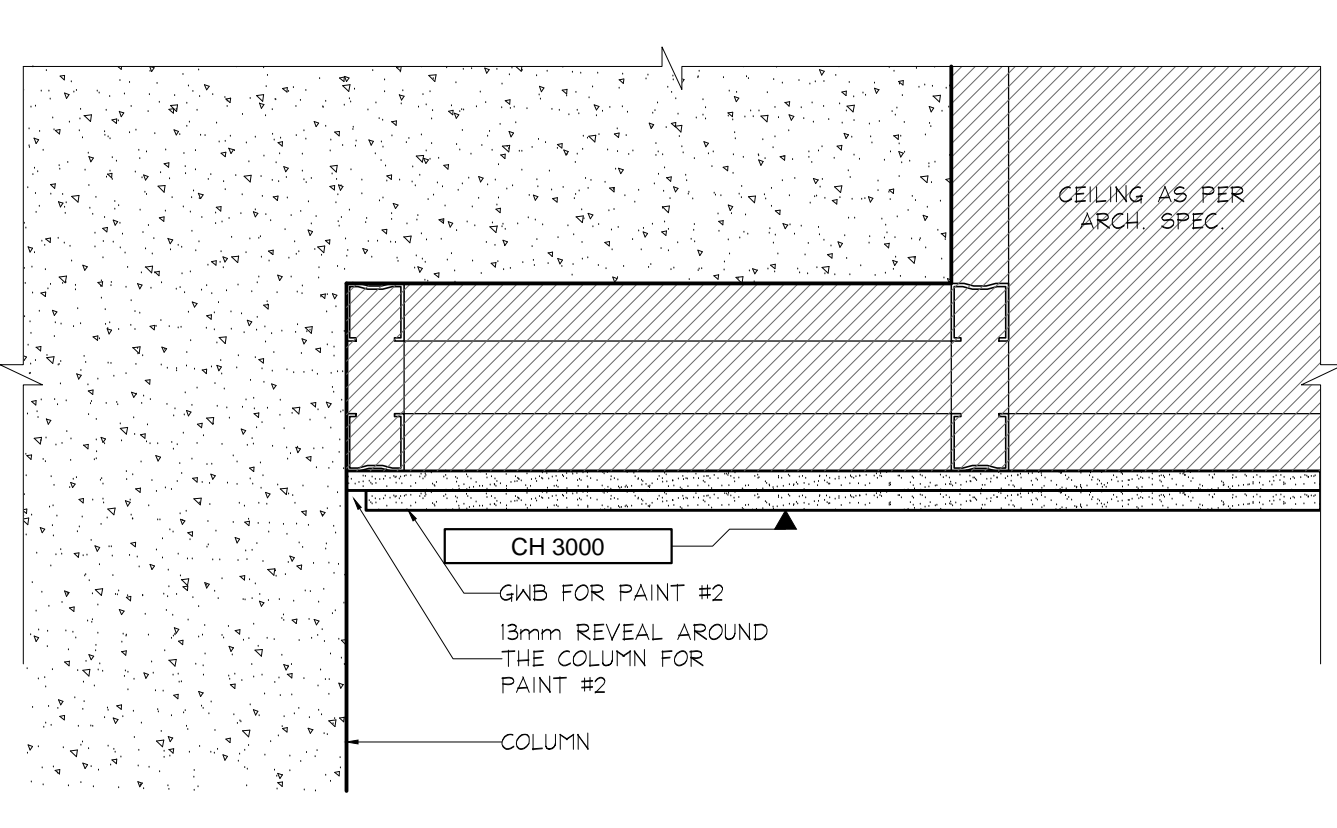


8 BULKHEAD @ CONCIERGE  
1ST FLOOR SCALE 1:5

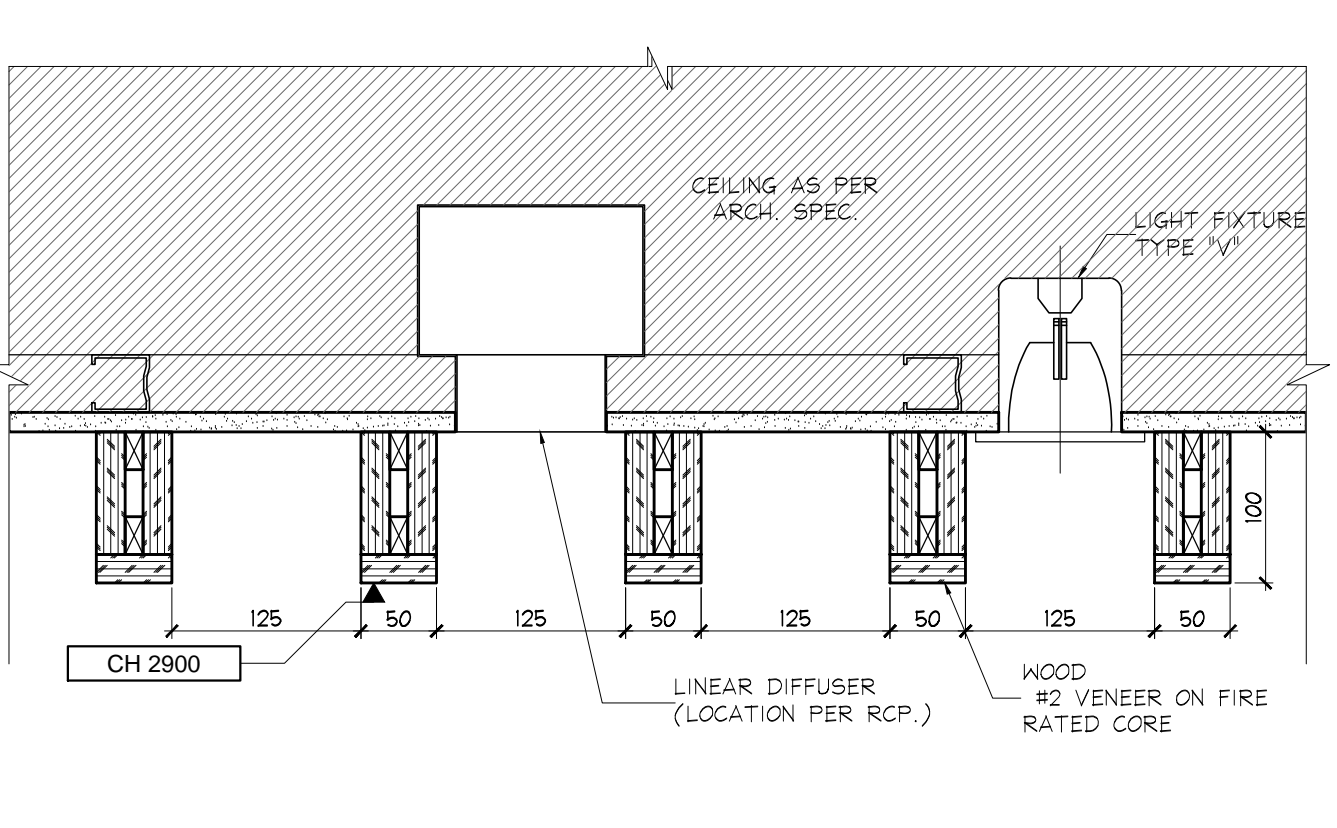


9 SECTION @ CONCIERGE  
1ST FLOOR SCALE 1:5

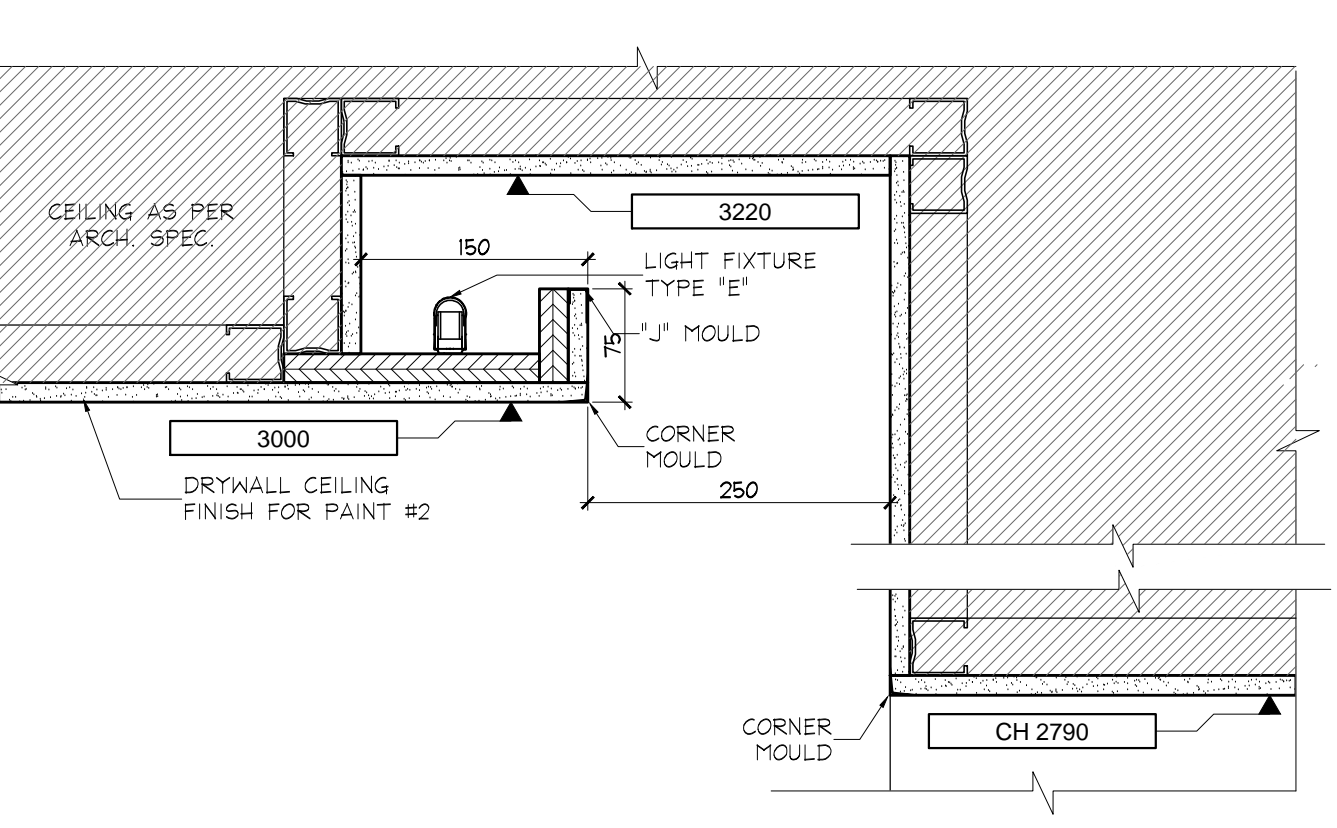


10 SECTION @ CONCIERGE  
1ST FLOOR SCALE 1:5

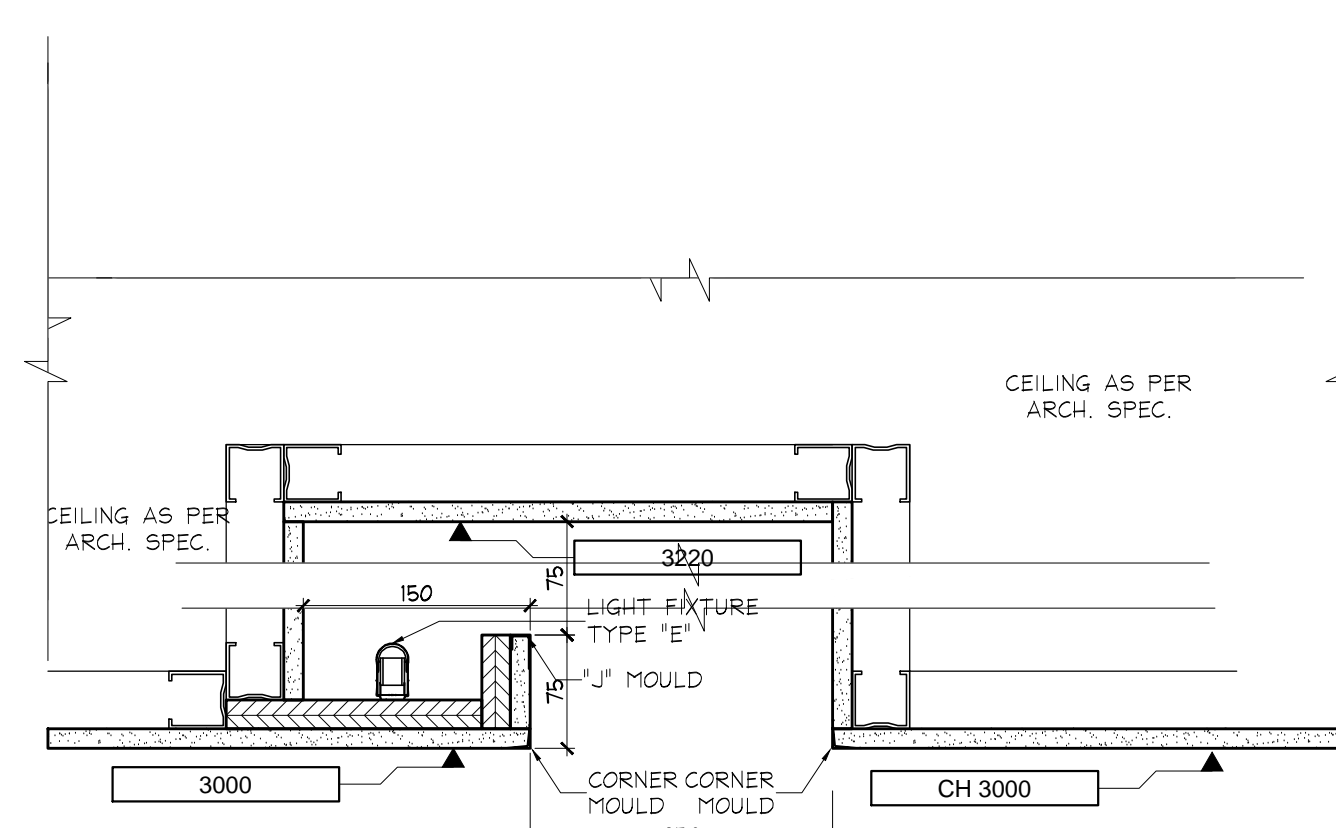


11 SECTION @ CONCIERGE  
1ST FLOOR SCALE 1:5

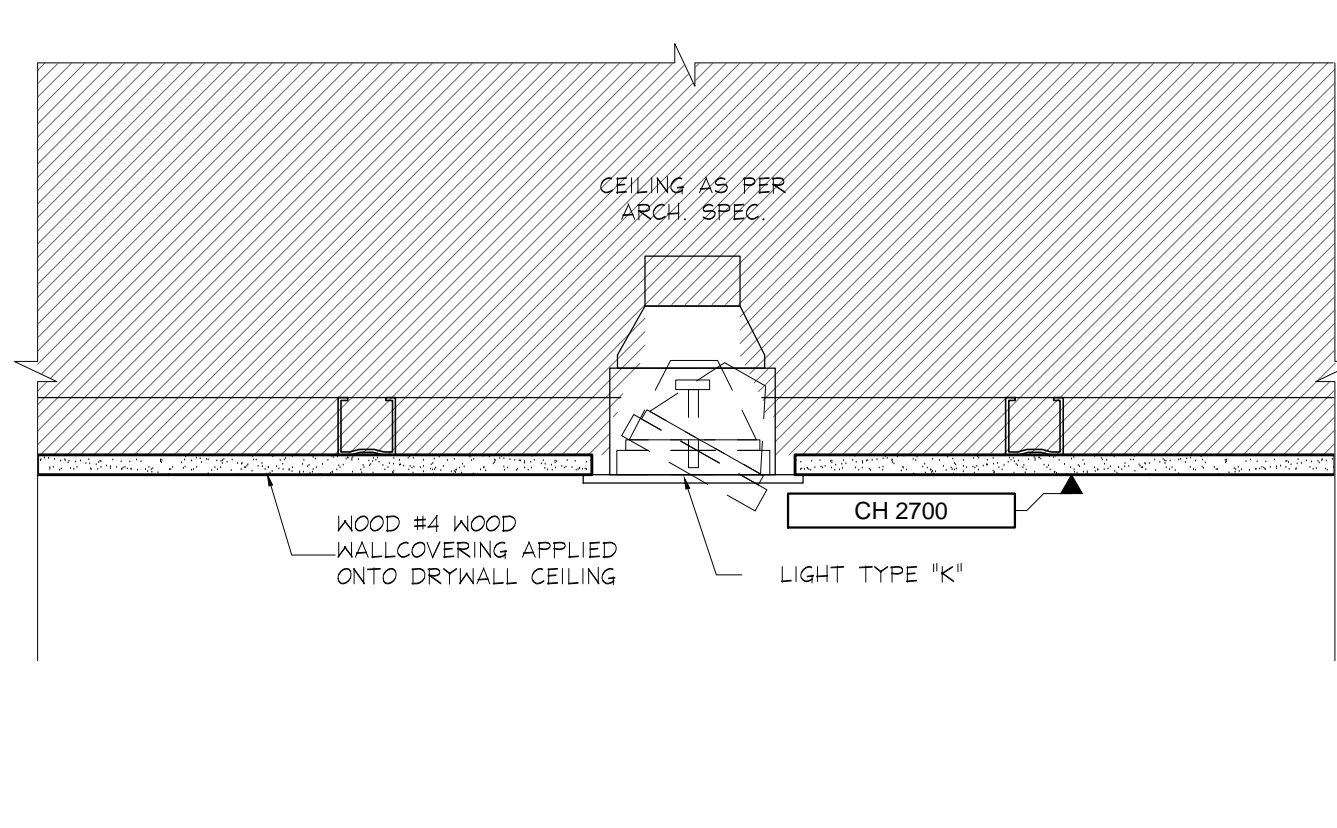


12 LIGHT DETAIL @ ELEVATOR LOBBY  
1ST FLOOR SCALE 1:5

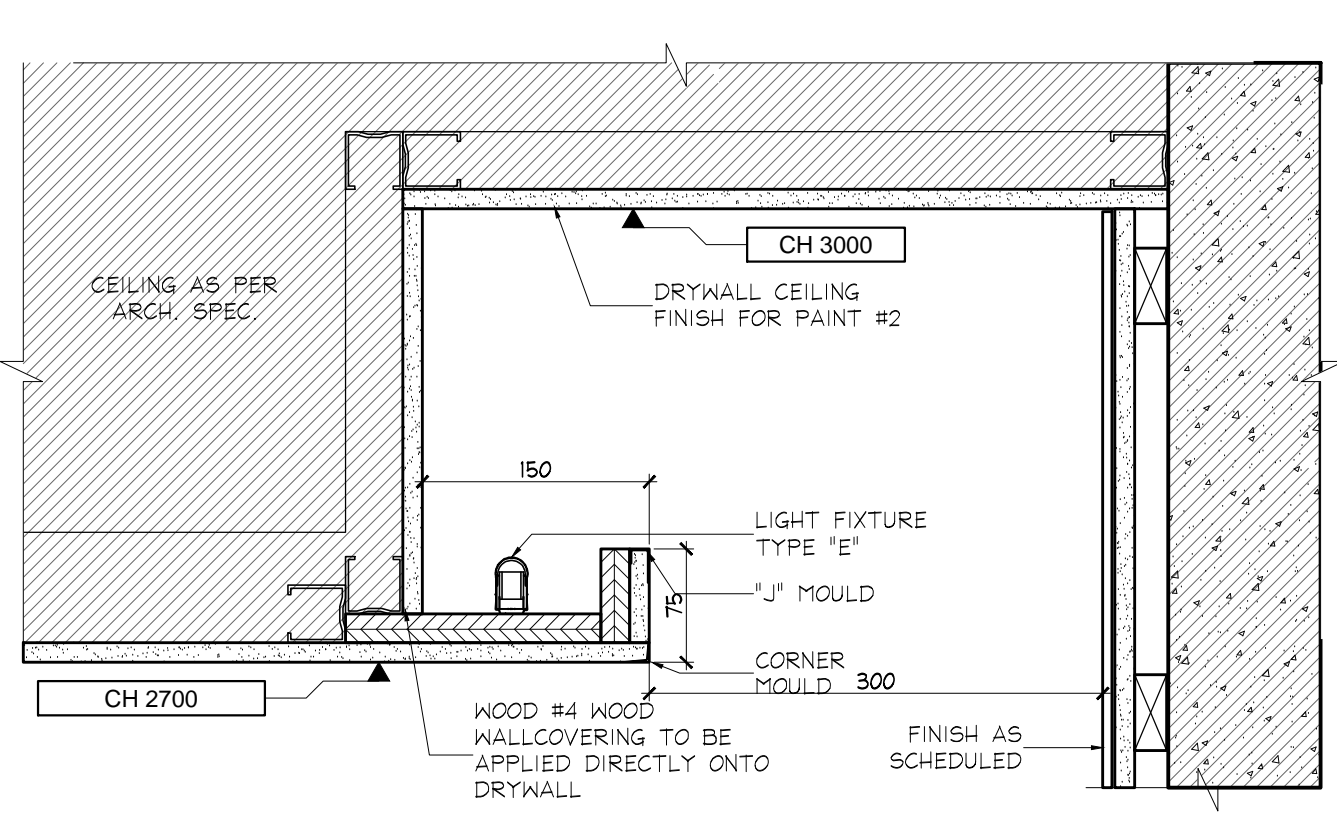


13 SECTION @ ELEVATOR COVE  
1ST FLOOR SCALE 1:5

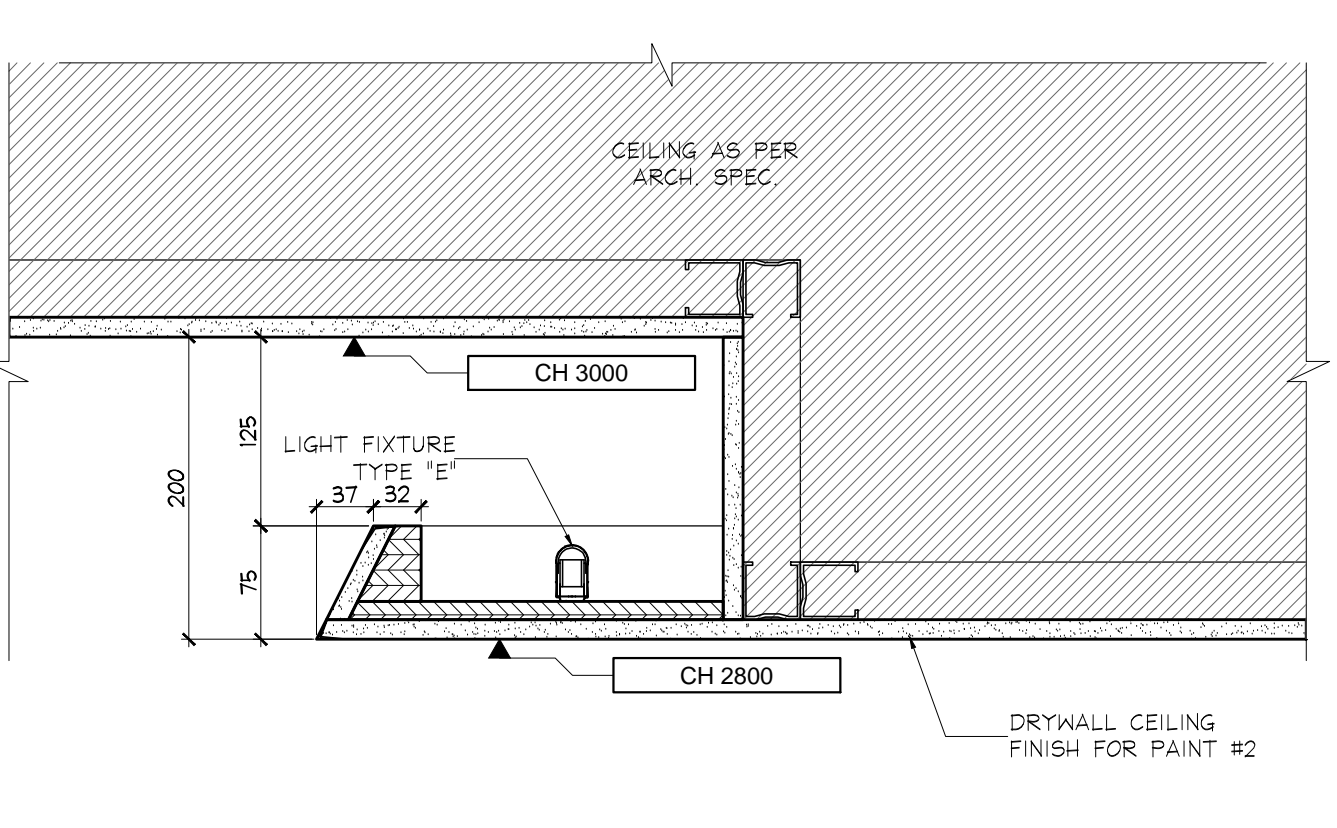


14 CEILING SECTION @ PARTY ROOM  
1ST FLOOR SCALE 1:5

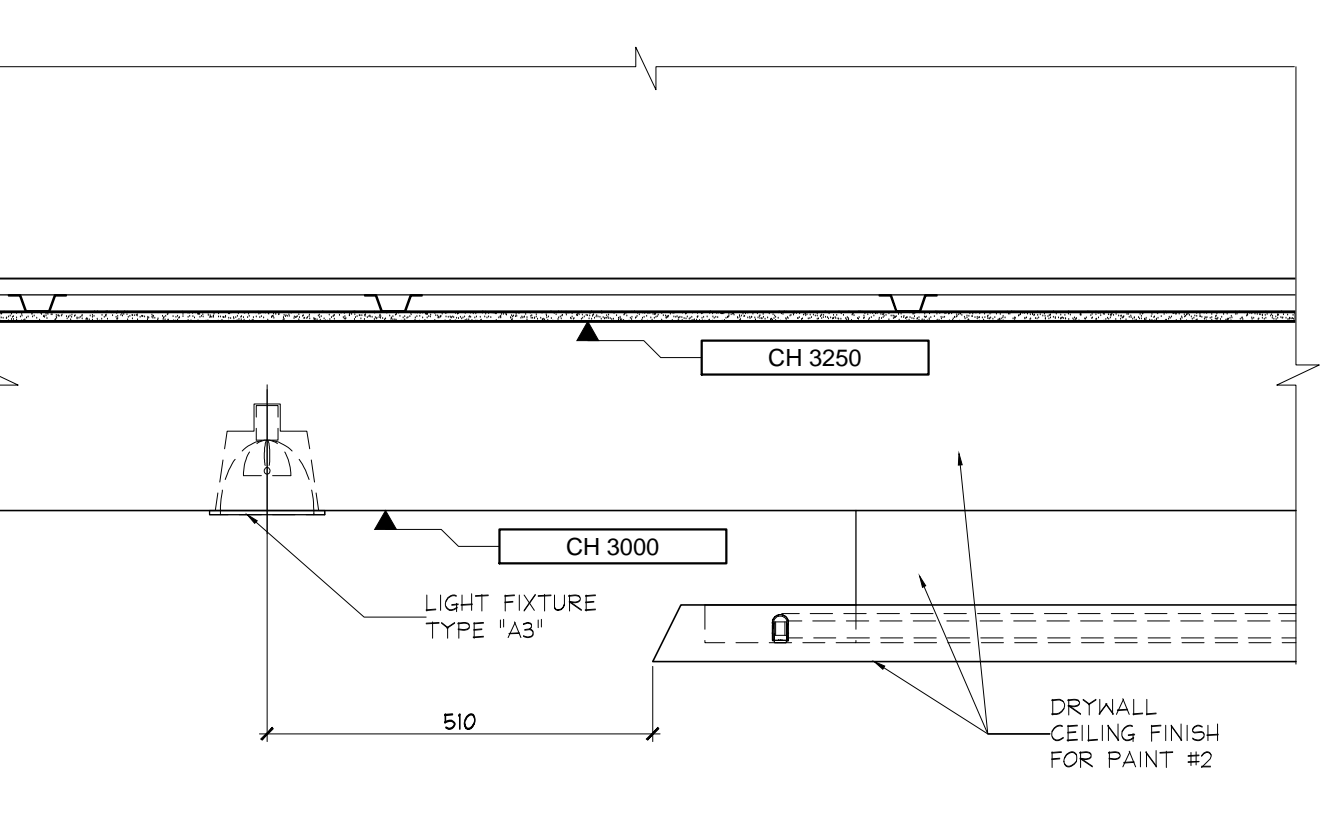


15 CEILING SECTION @ PARTY ROOM  
1ST FLOOR SCALE 1:10

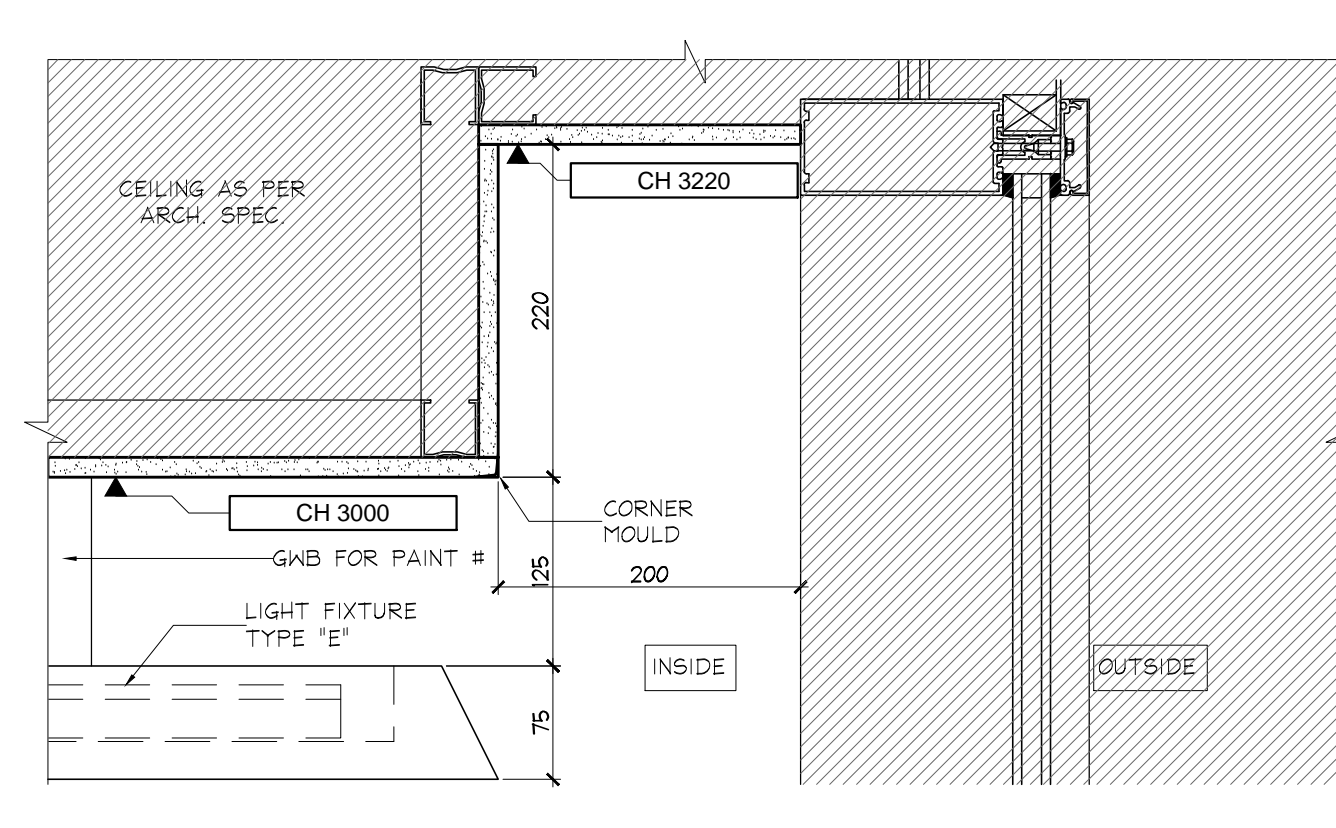


16 CEILING SECTION @ PARTY ROOM  
1ST FLOOR SCALE 1:5

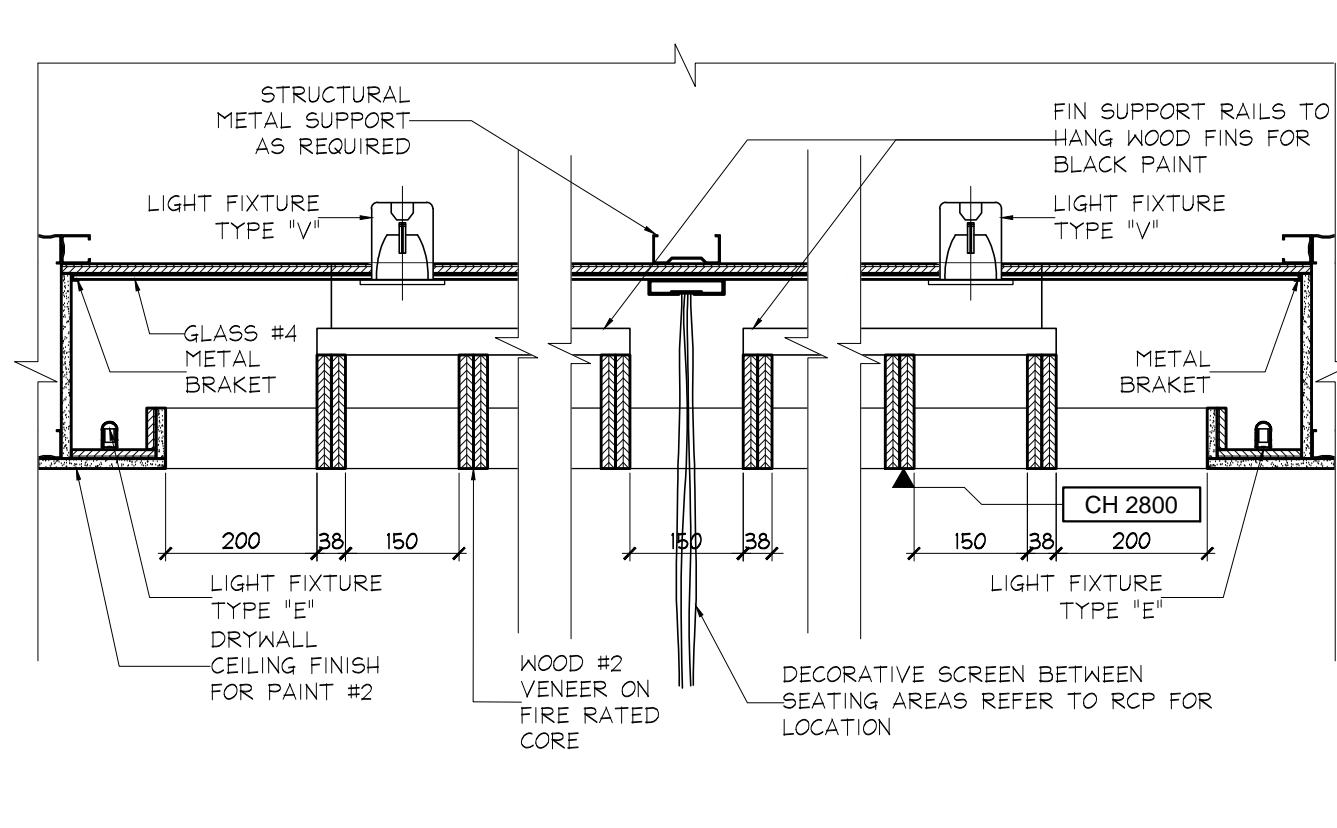


17 CEILING SECTION @ PARTY ROOM  
1ST FLOOR SCALE 1:10

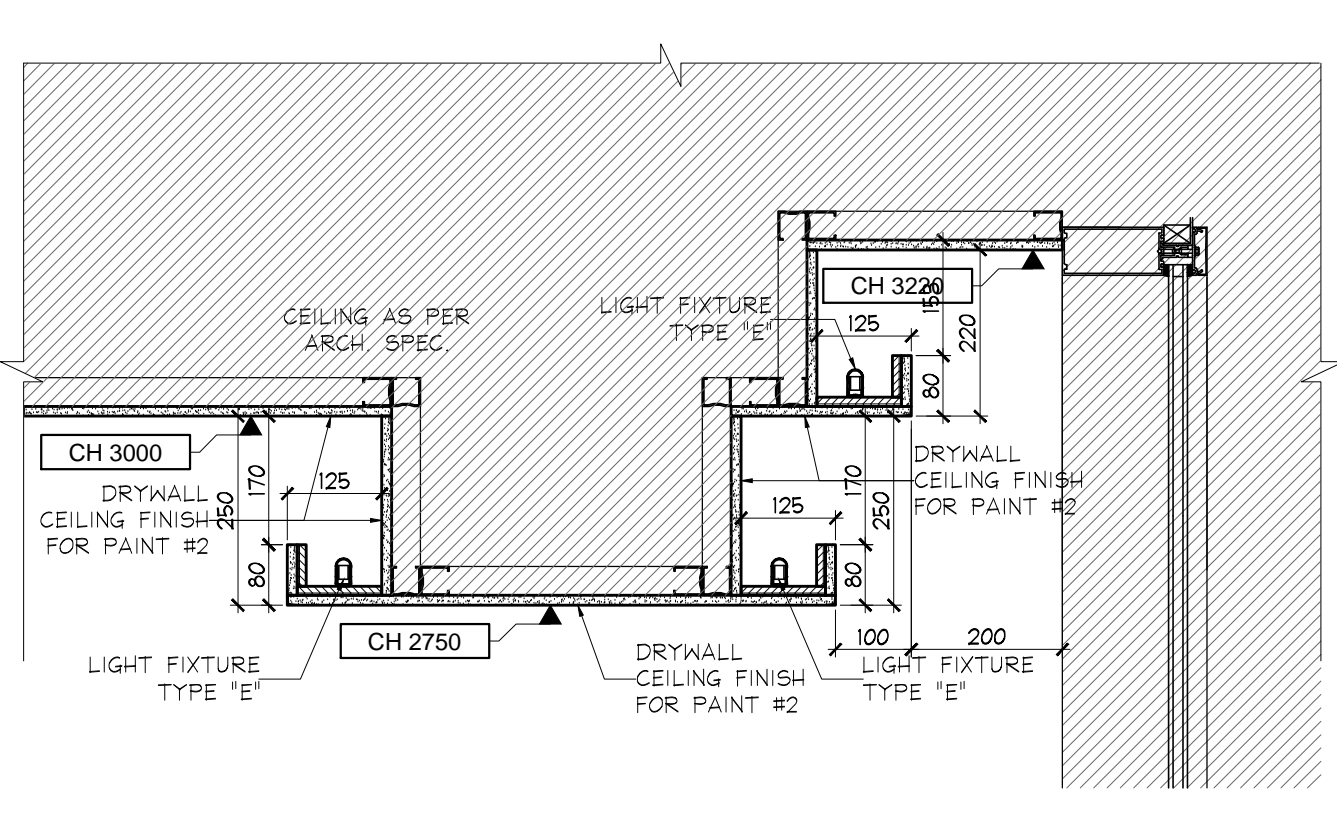


18 CEILING SECTION @ FITNESS AREA  
1ST FLOOR SCALE 1:10

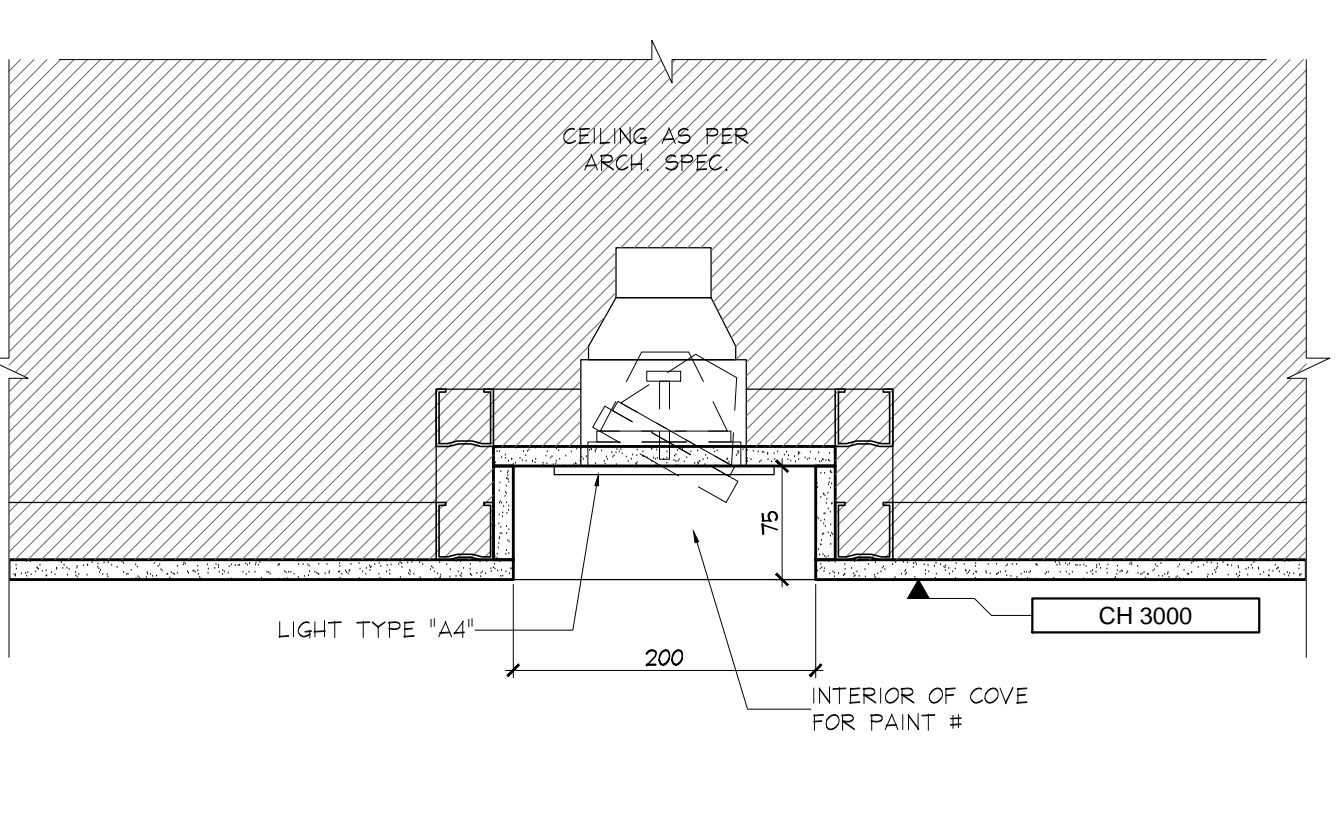


19 CEILING SECTION @ FITNESS AREA  
1ST FLOOR SCALE 1:5

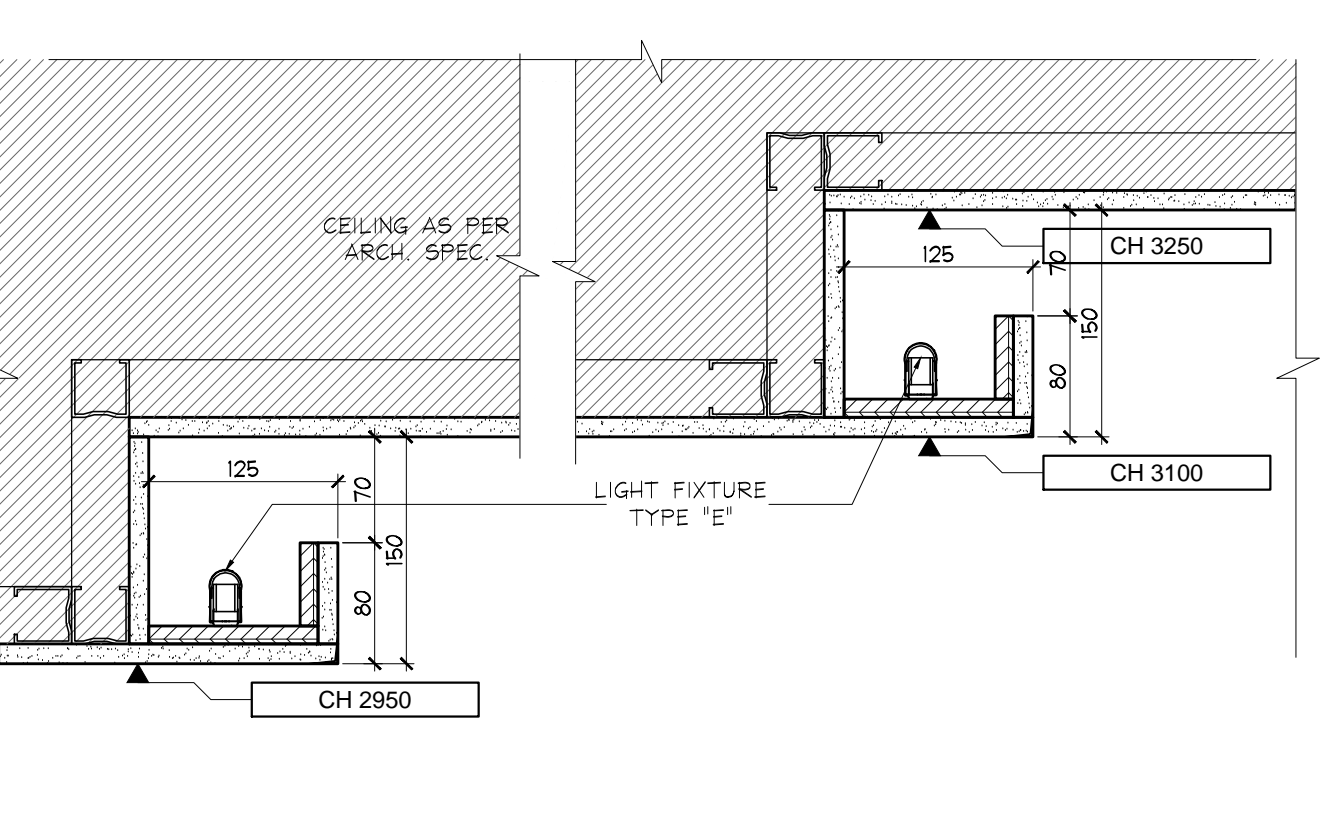

20 CEILING SECTION @ THEATRE  
1ST FLOOR SCALE 1:5

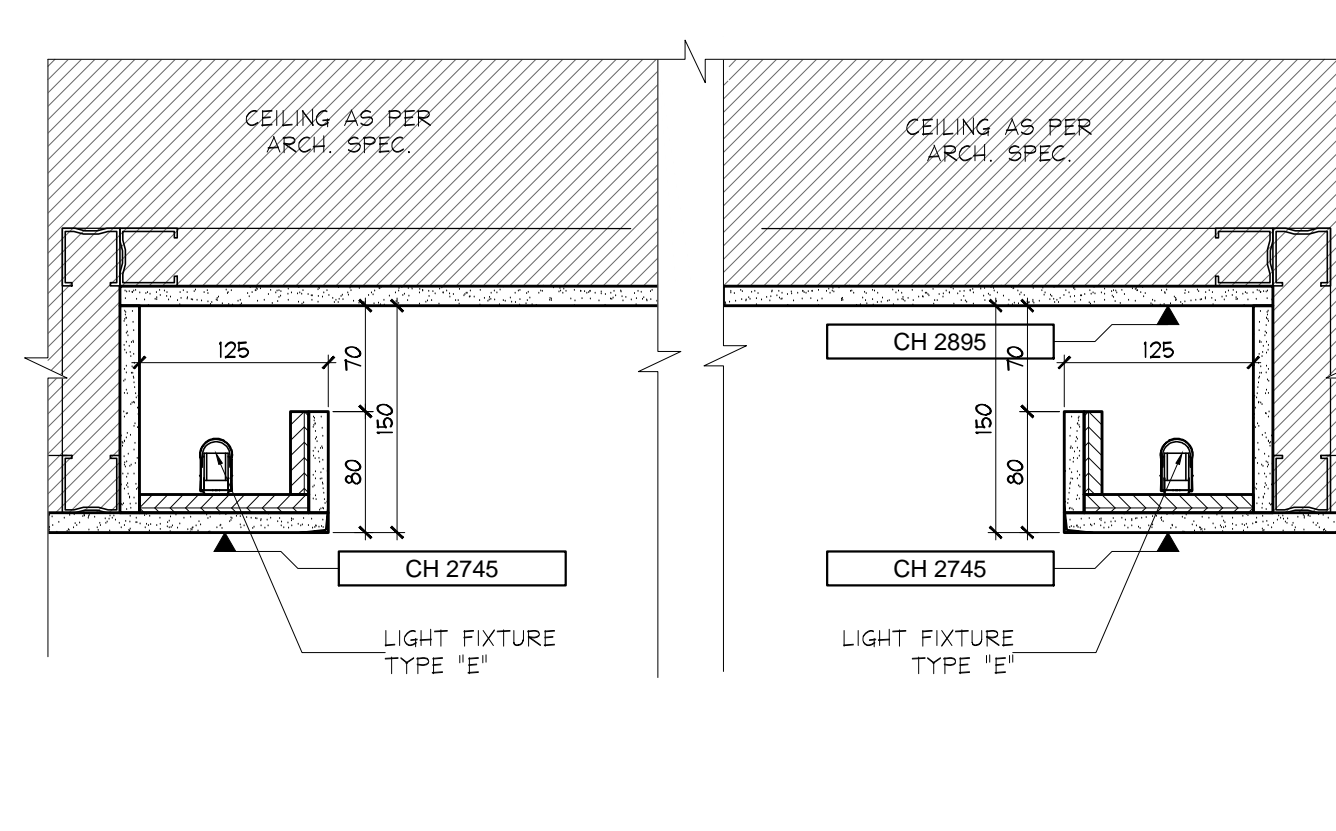

21 CEILING SECTION @ PROPERTY MANAGEMENT OFFICE  
1ST FLOOR SCALE 1:5

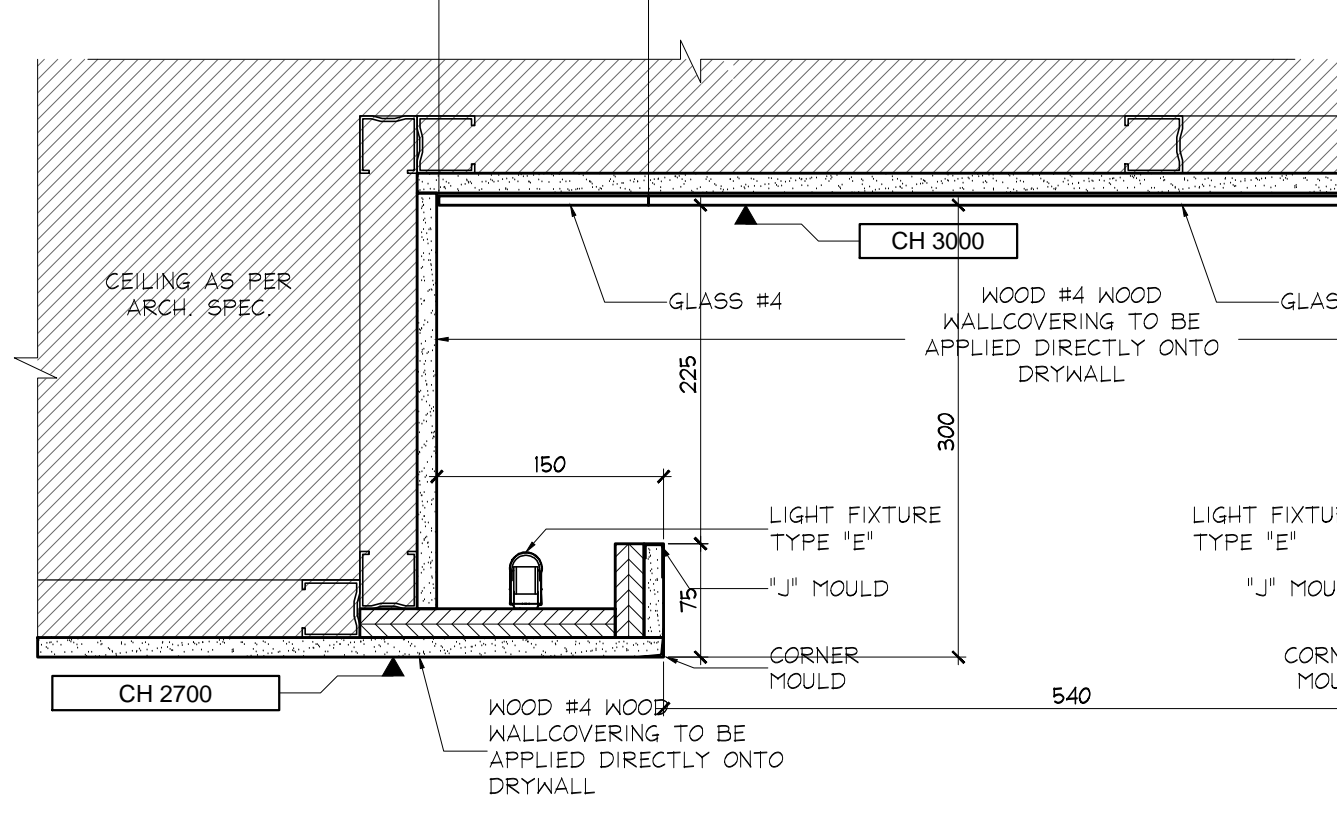

22 SECTION @ CORRIDOR 'D' COVE  
1ST FLOOR SCALE 1:5

DO NOT SCALE DRAWINGS.

CONTRACTOR MUST VERIFY ALL DRAWINGS, DIMENSIONS, DETAILS AND SPECIFICATIONS, AND REPORT ANY DISCREPANCIES TO UNICOR 31 INC. BEFORE PROCEEDING WITH WORK. MATERIALS MAY NOT BE SUBSTITUTED WITHOUT WRITTEN APPROVAL FROM UNICOR 31 INC. ALL DRAWINGS AND SPECIFICATIONS ARE INSTRUMENTS OF SERVICE AND THE PROPERTY OF UNICOR 31 INC. WHICH MUST BE RETURNED AT THE COMPLETION OF THE WORK.

PRINTED: 30-May-17

ISSUED FOR AS-BUILT

|            |             |                     |     |
|------------|-------------|---------------------|-----|
| 01         | 31 MAY / 17 | ISSUED FOR AS-BUILT | SV  |
| NO.        | DATE        | COMMENTS            | INI |
| REVISIONS: |             |                     |     |

UNICOR 31 INC.  
183 BATHURST STREET, STE. 201  
TORONTO, ON, M5T 2R7, CANADA  
TEL: 416-597-1576 FAX: 416-597-2339

PROJECT NAME:  
**ALEXANDRA PARK MAIN BUILDING**  
BLOCK 11  
ON, Canada  
PROJECT NO.: 13-949  
DRAWINGS:  
**CEILING DETAILS**

|                           |              |
|---------------------------|--------------|
| DATE STARTED: 07 AUG / 13 | DRAWING NO.: |
| SCALE: AS NOTED           | ID           |
| DRAWN BY: GG              | 3.1.0        |
| APPROVED BY: KC           |              |