


DO NOT SCALE DRAWINGS.


CONTRACTOR MUST VERIFY ALL DRAWINGS, DIMENSIONS, DETAILS AND SPECIFICATIONS, AND REPORT ANY DISCREPANCIES TO UNION 31 INC. BEFORE PROCEEDING WITH WORK. MATERIALS MAY NOT BE SUBSTITUTED WITHOUT WRITTEN APPROVAL FROM UNION 31 INC.
ALL DRAWINGS AND SPECIFICATIONS ARE INSTRUMENTS OF SERVICE AND THE PROPERTY OF UNION 31 INC. WHICH MUST BE RETURNED AT THE COMPLETION OF THE WORK.

PRINTED: 30-May-17


ISSUED FOR
AS-BUILT

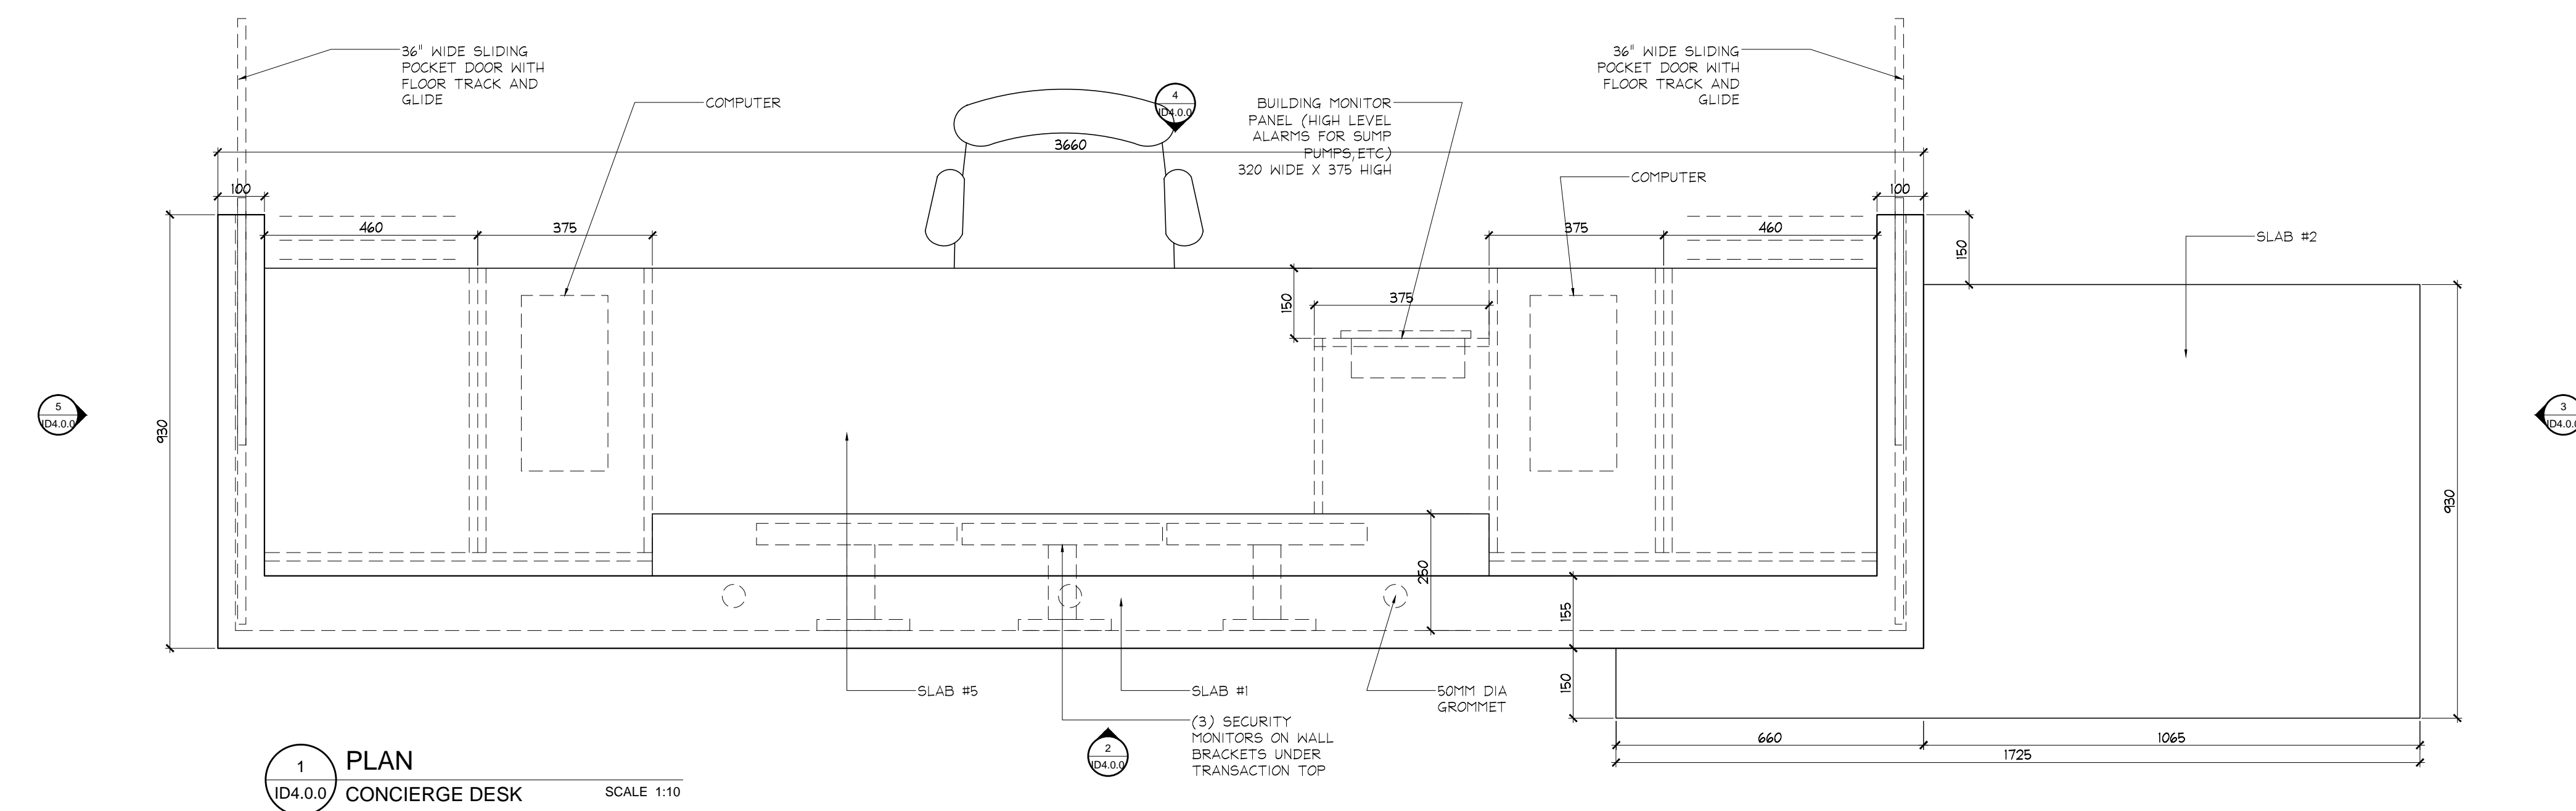


1 PLAN CONCERGE DESK SCALE 1:10

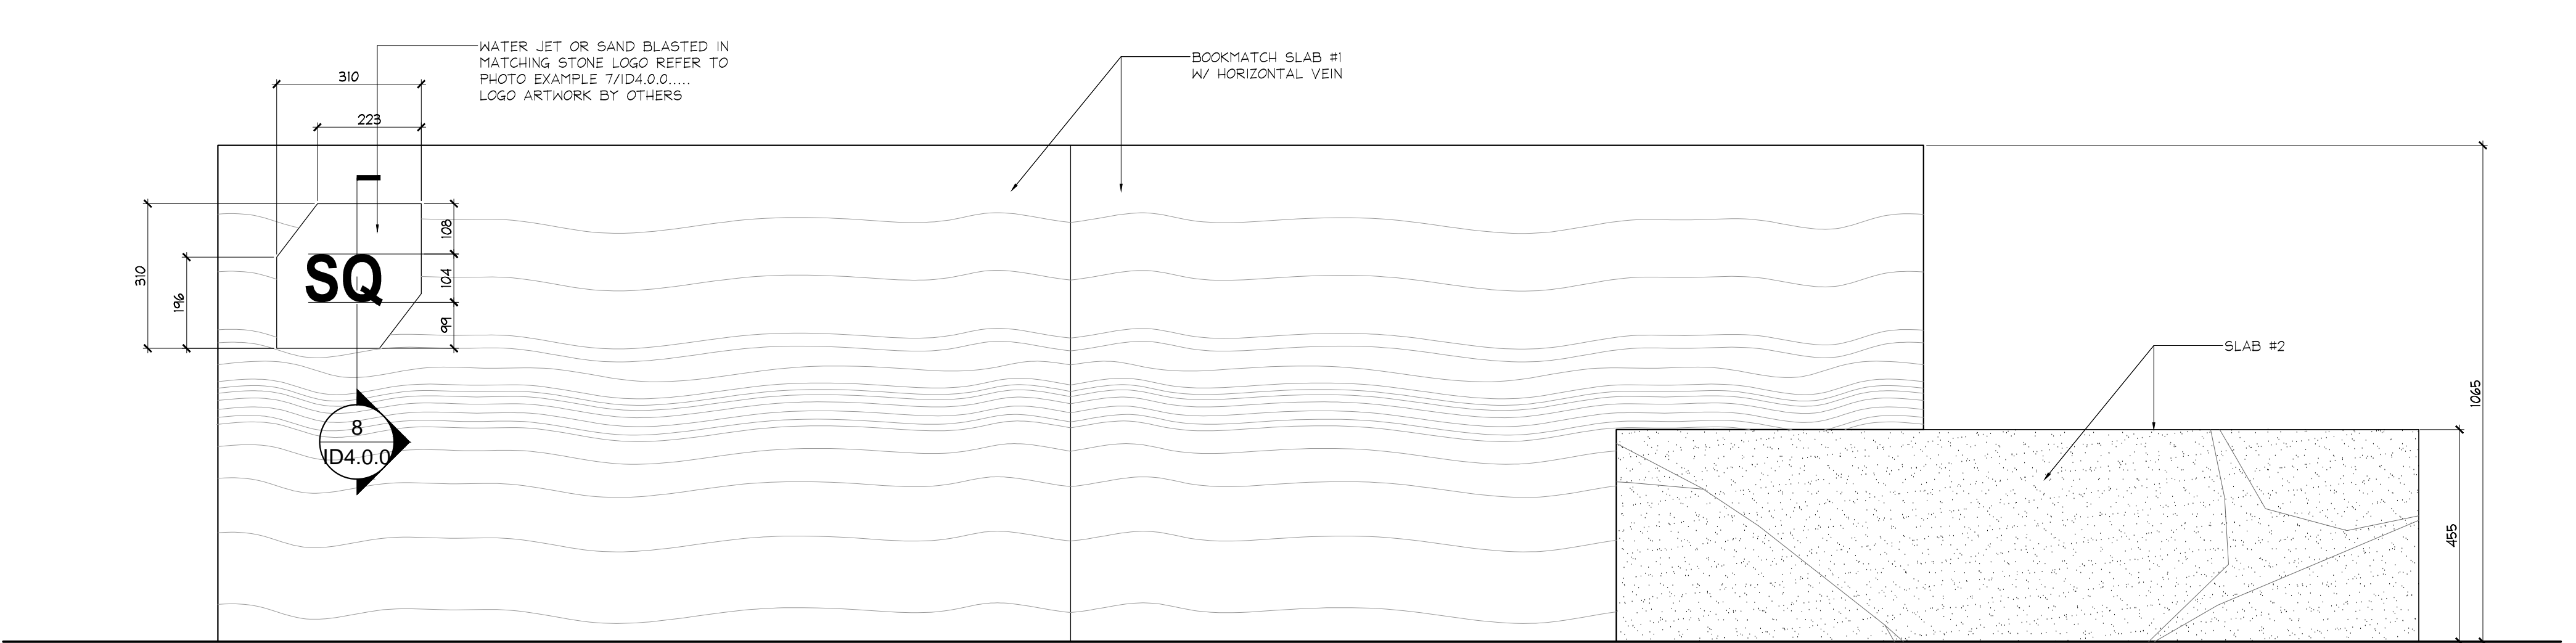


2 ELEVATION CONCERGE DESK SCALE 1:10

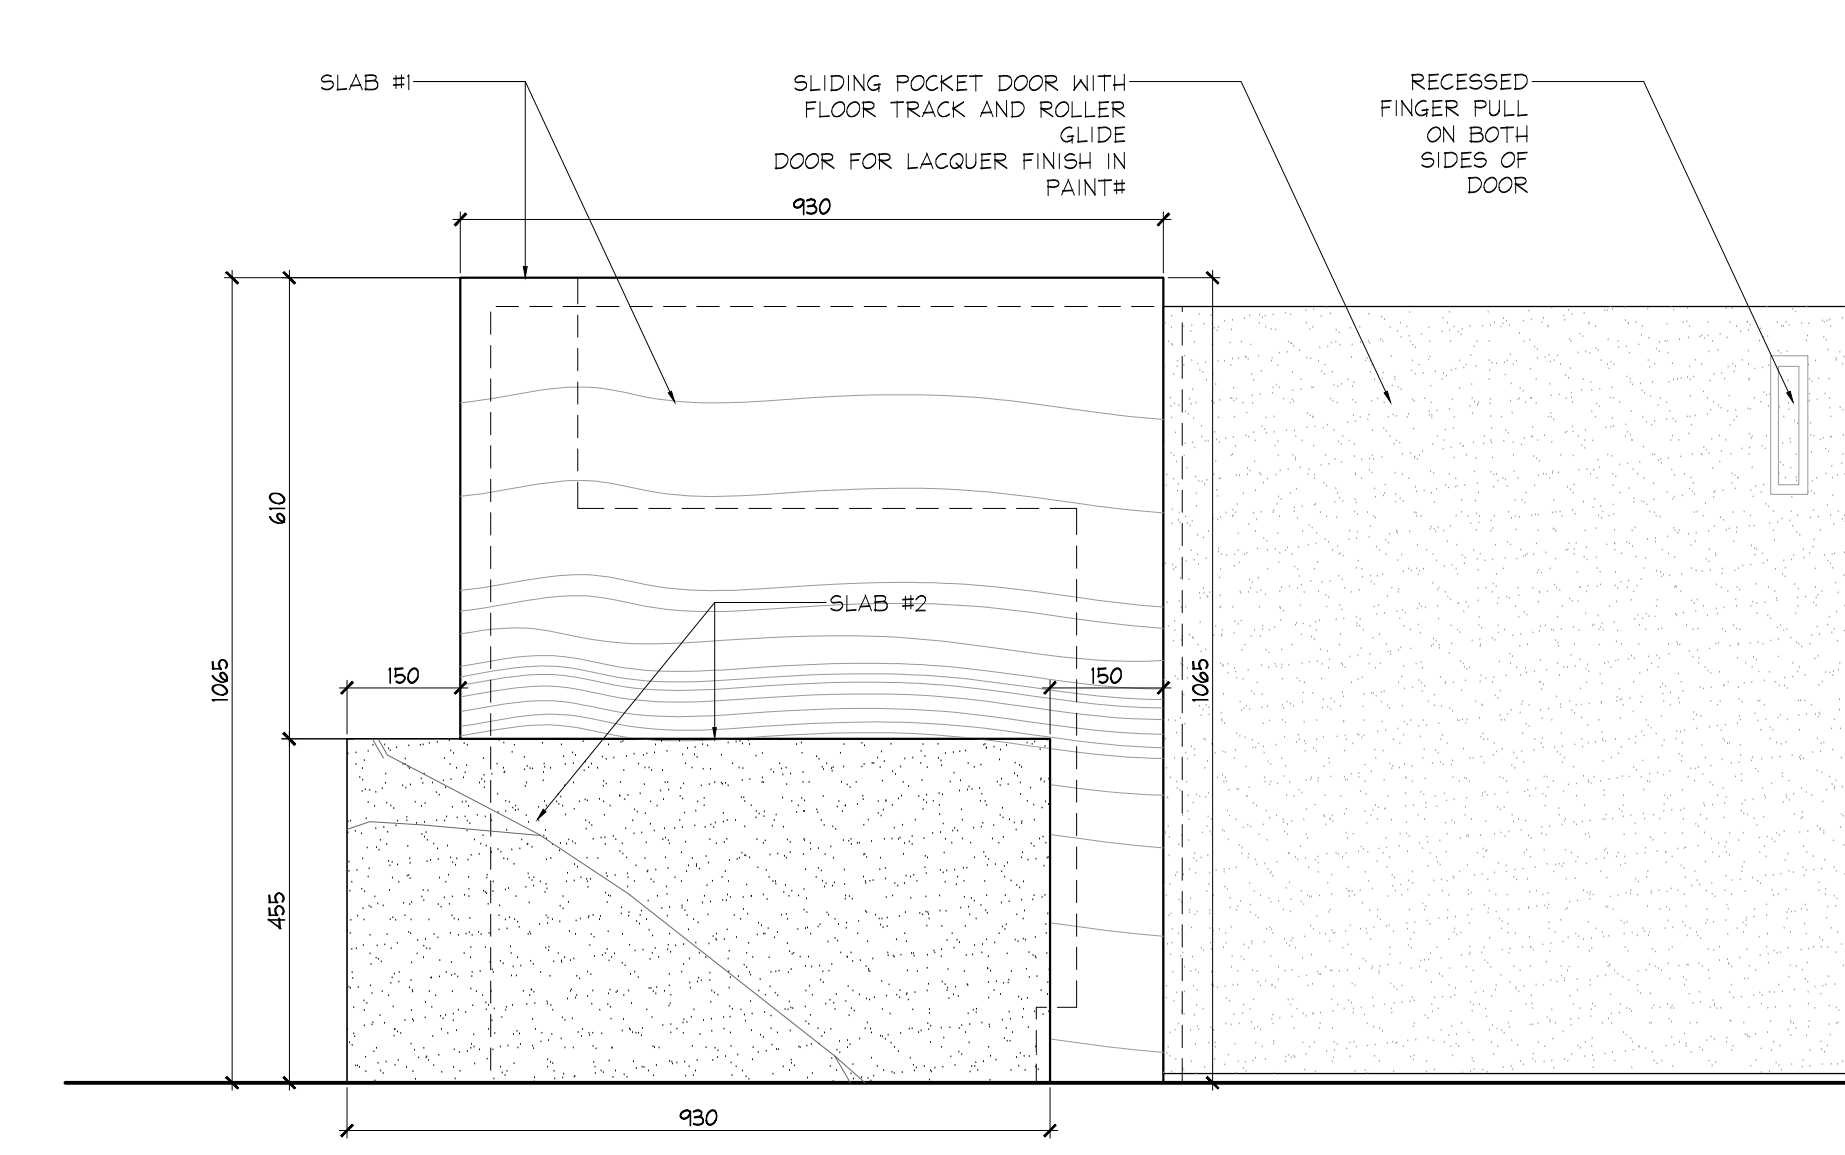


3 ELEVATION CONCERGE DESK SCALE 1:10

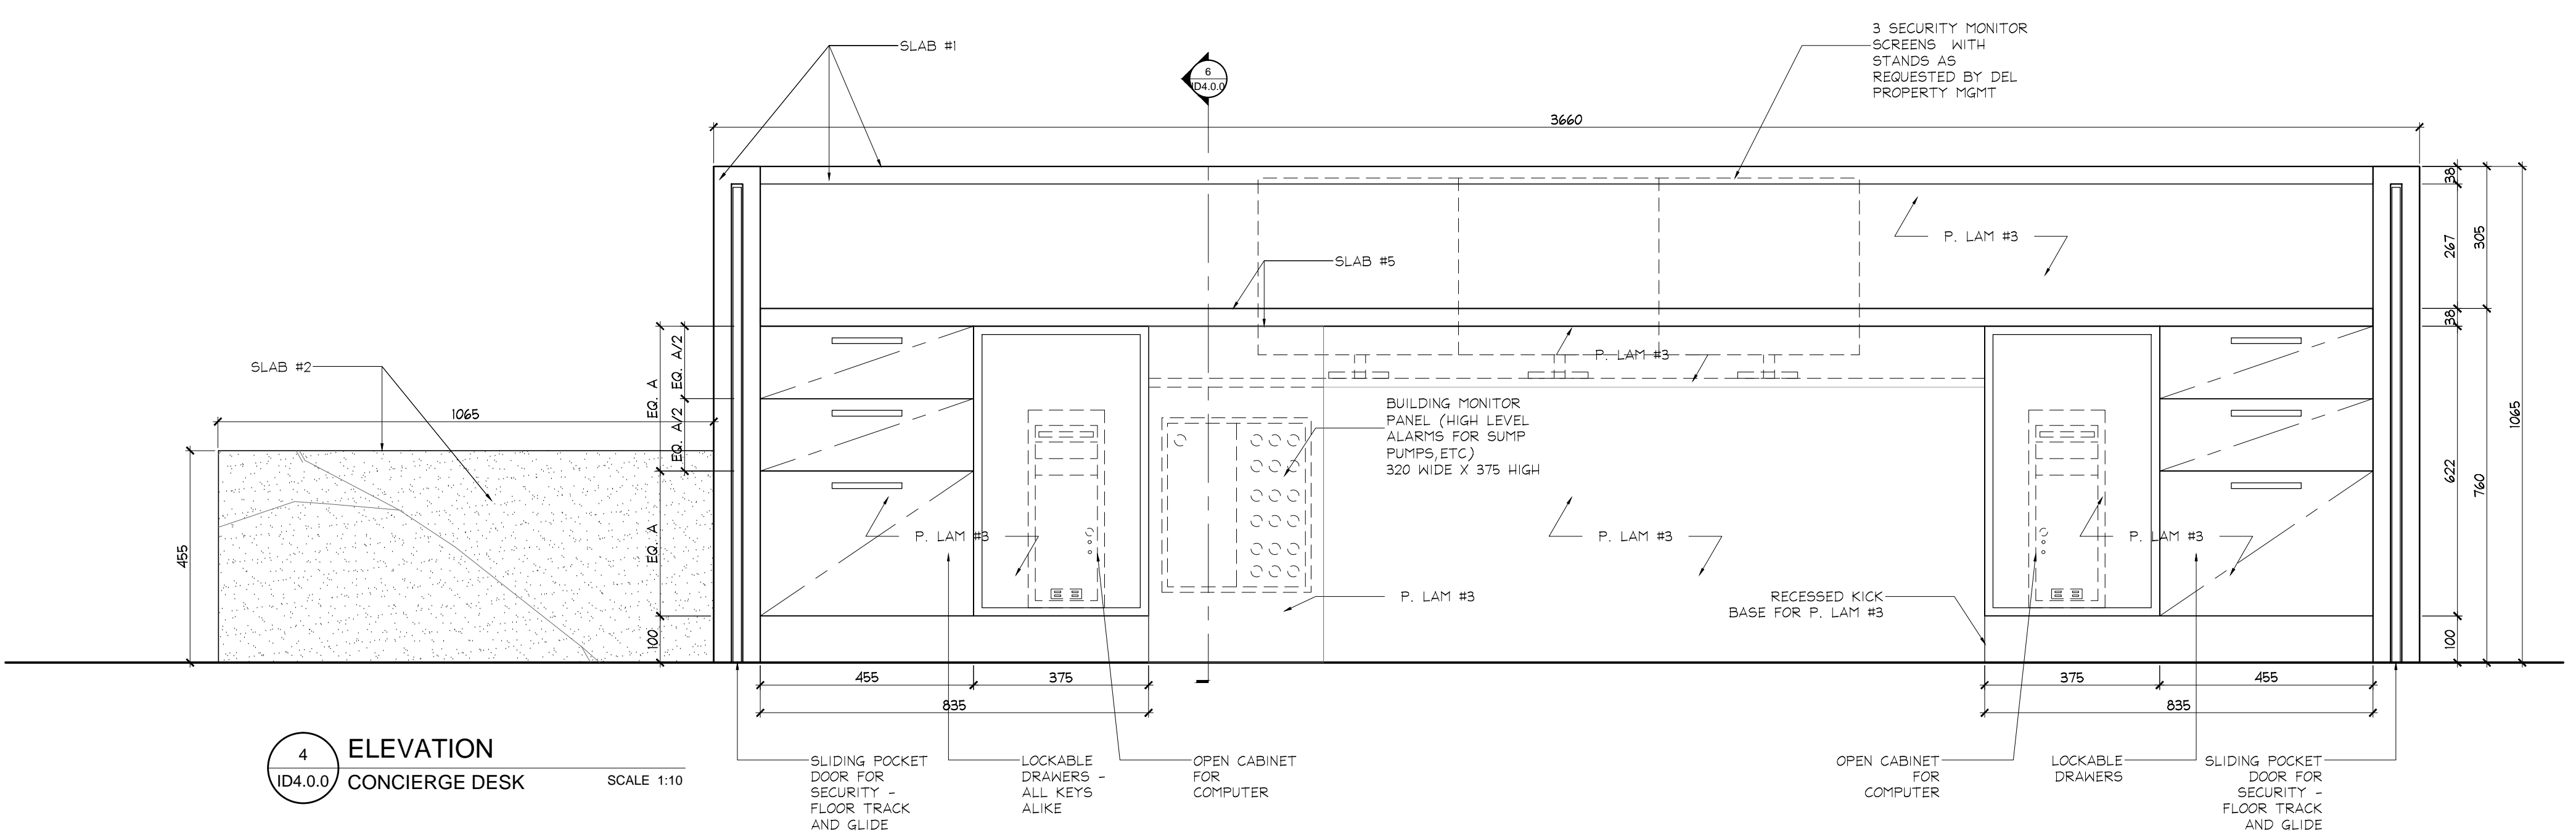

4 ELEVATION CONCERGE DESK SCALE 1:10

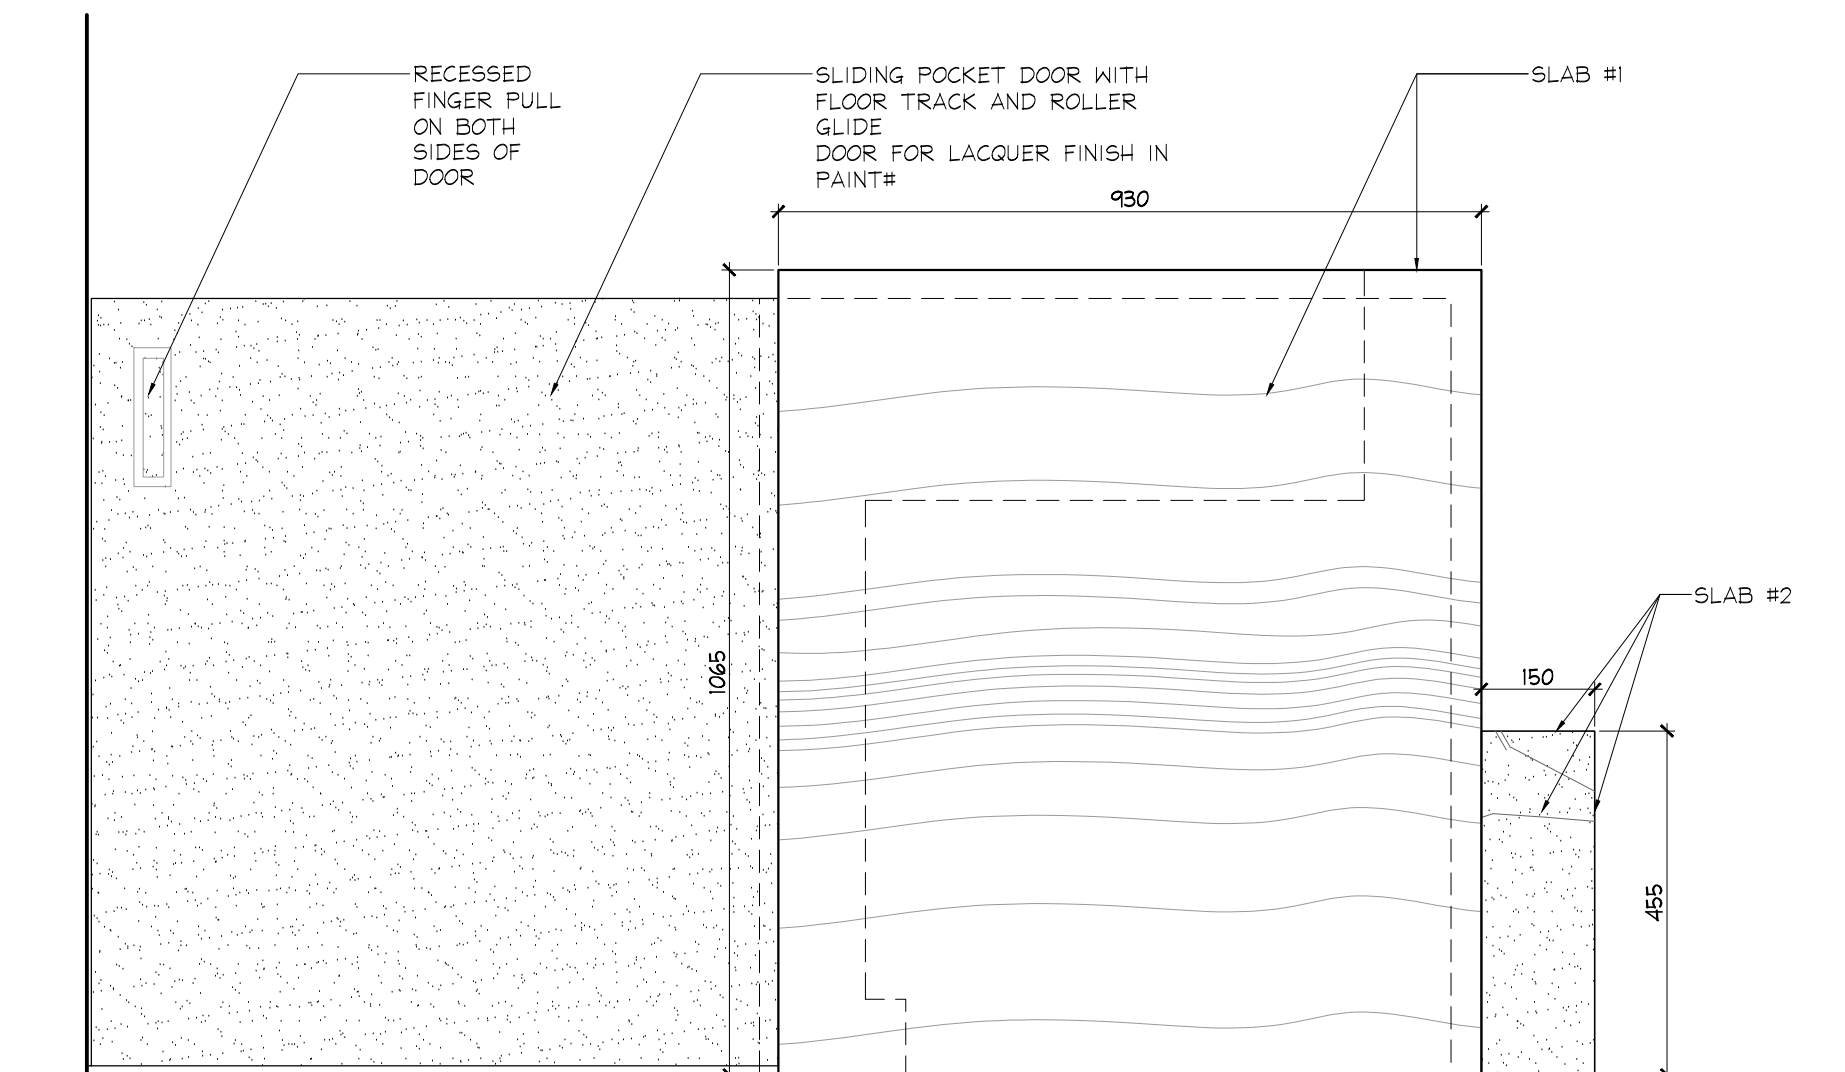


5 ELEVATION CONCERGE DESK SCALE 1:10

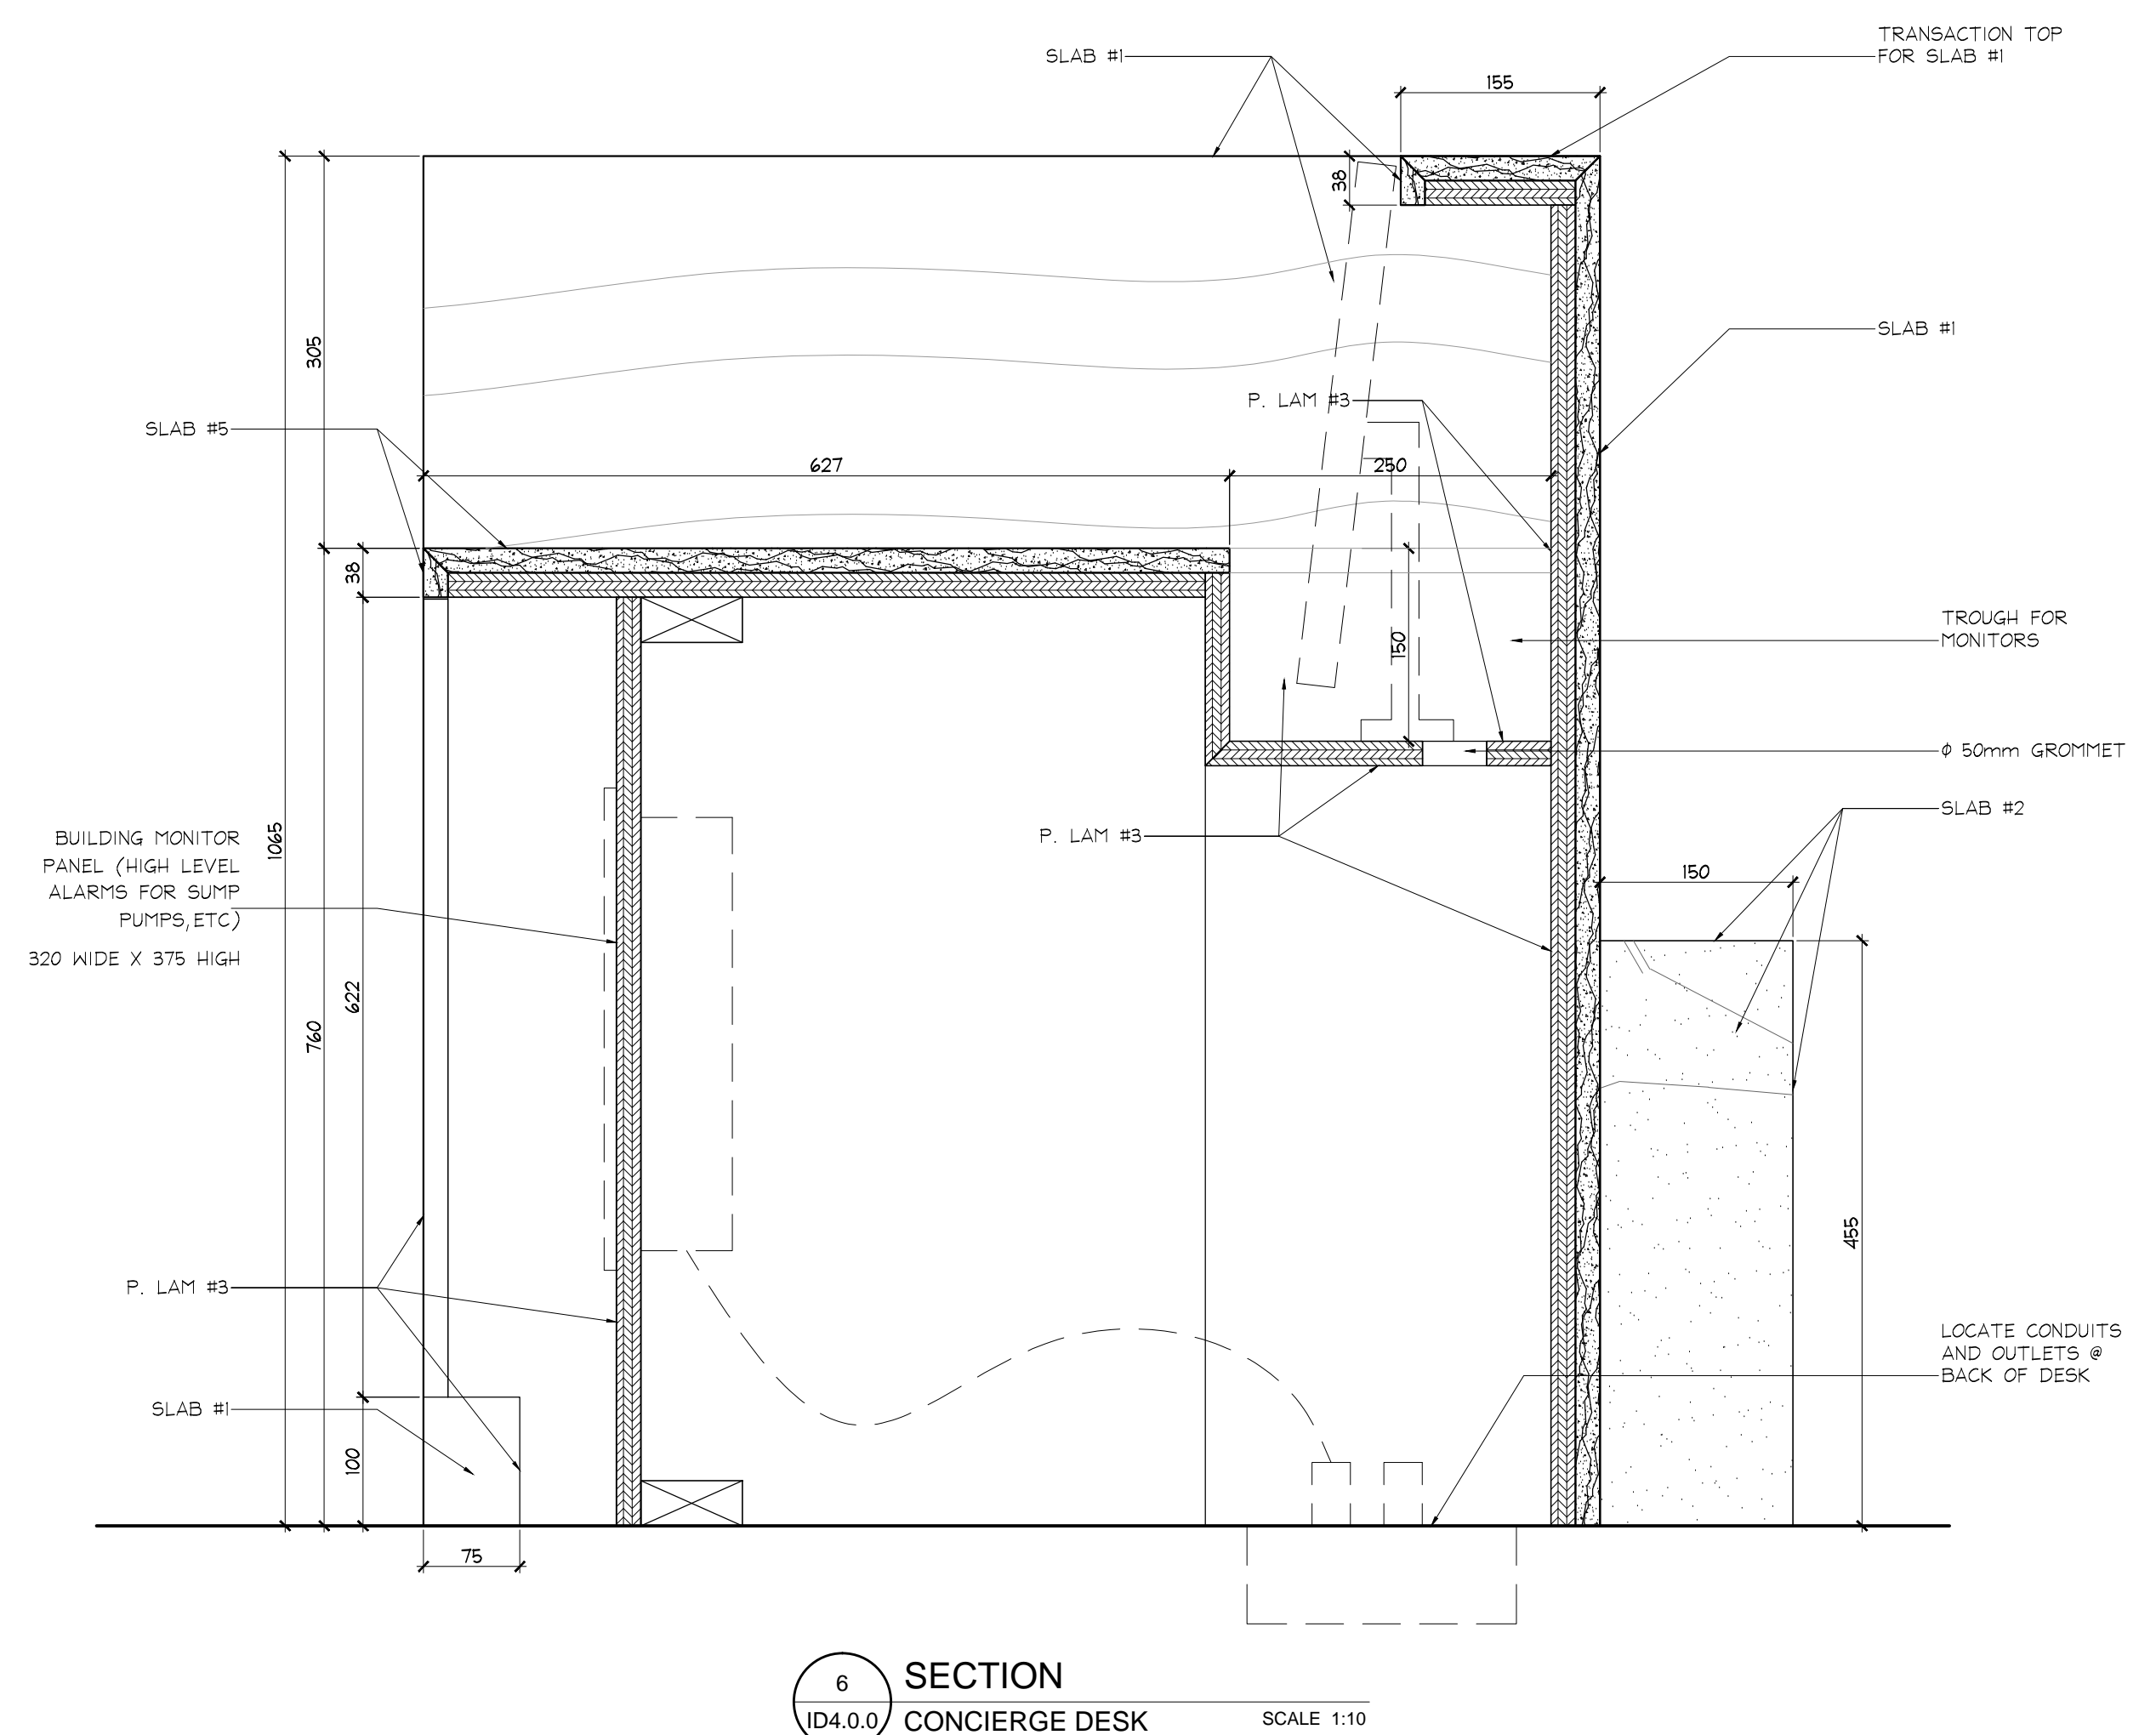

6 SECTION CONCERGE DESK SCALE 1:10



7 WATER JET CUT SAMPLE CONCERGE DESK N.T.S.

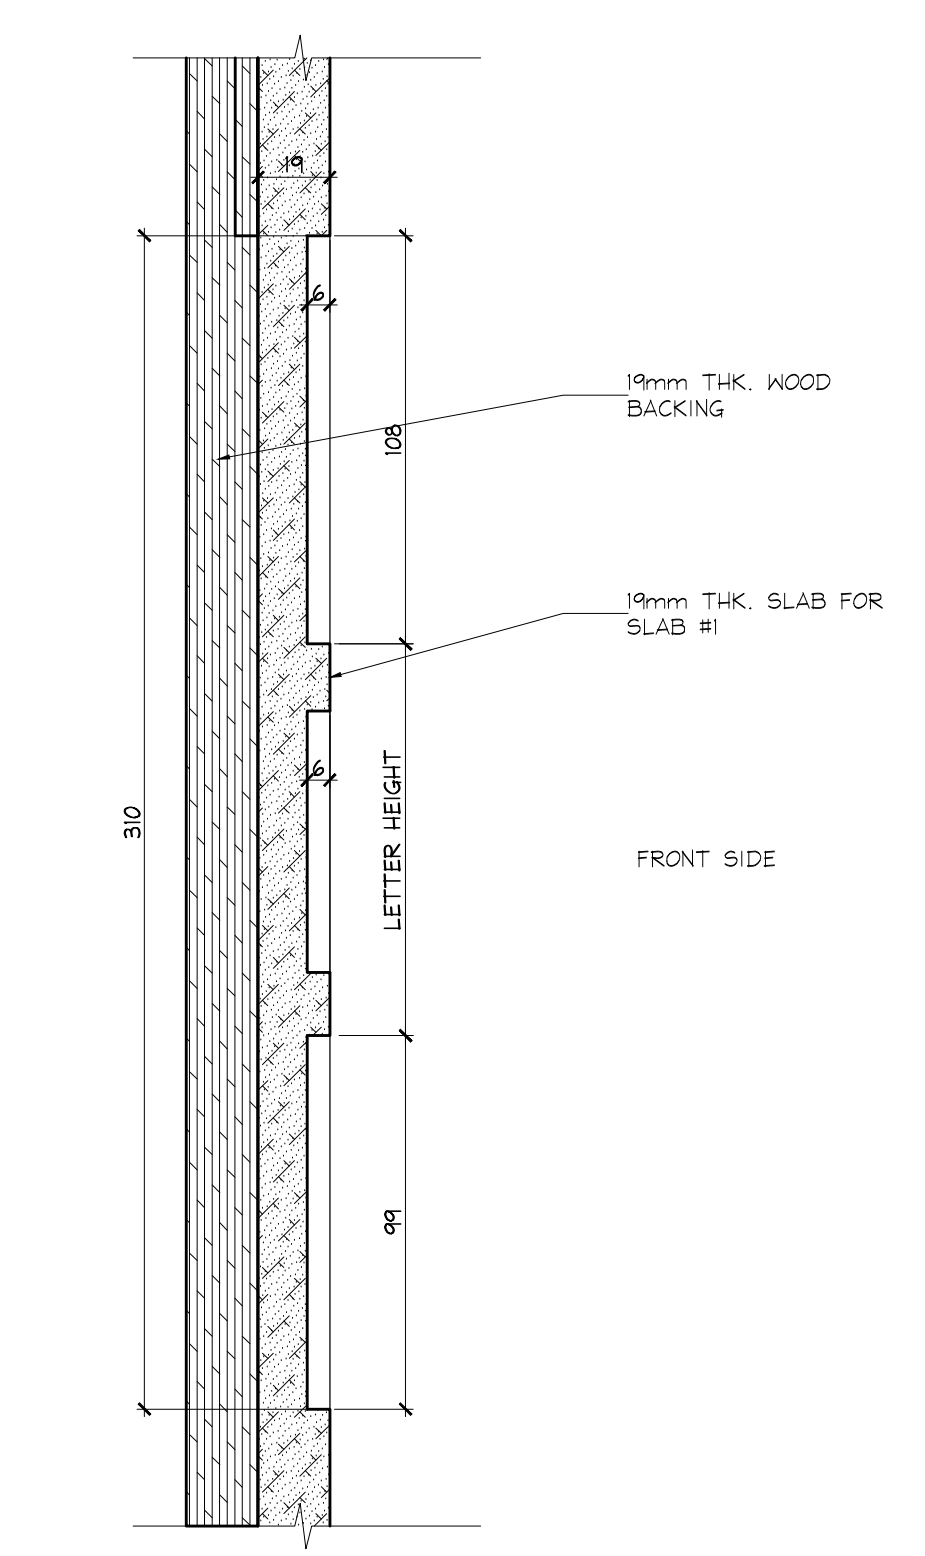

8 SECTION @ LOGO SLAB CONCERGE DESK SCALE 1:2

01	31 MAY / 17	ISSUED FOR AS-BUILT	SV
NO.	DATE	COMMENTS	INI
REVISIONS:			

UNION 31 INC.
183 BATHURST STREET, STE. 201
TORONTO, ON, M5T 2R7, CANADA
TEL: 416-597-1576 FAX: 416-597-2139

PROJECT NAME:
ALEXANDRA PARK MAIN BUILDING
BLOCK 11
ON, Canada
PROJECT NO.: 13-949
DRAWINGS:
MILLWORK DETAILS

DATE STARTED: 07 AUG / 13	DRAWING NO.:
SCALE: AS NOTED	ID
DRAWN BY: SM	4.0.0
APPROVED BY: KC	