
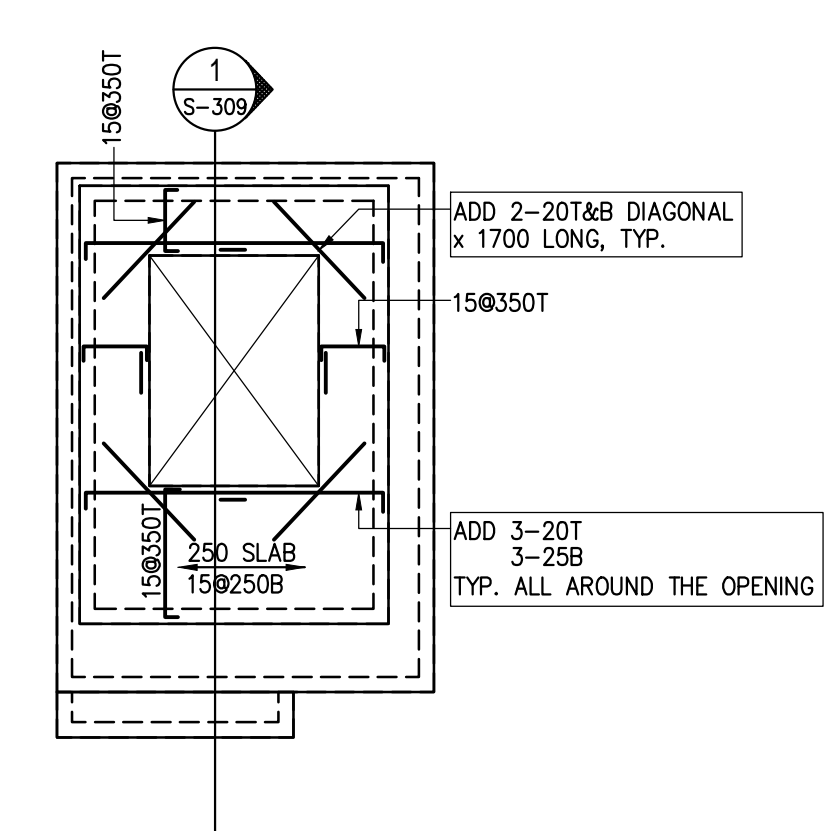


9TH FLOOR FRAMING PLAN
SCALE 1 : 100

- TOP OF SLAB IS AT ELEVATION AS SHOWN ON ARCH. DRAWINGS EXCEPT AS CROSSED AND NOTED ON PLAN.
- CONCRETE STRENGTH AT 28 DAYS SHALL BE:
FOR WALLS AND COLUMNS SEE SCHEDULE
FOR EXT. SLABS 35 MPa
FOR INTERIOR SLABS 25 MPa
FOR BEAMS 35 MPa
CONCRETE EXPOSED TO ELEMENTS SHALL BE 35 MPa WITH 6% TO 8% ENTRAINED AIR.
- FLOOR SLABS ARE DESIGNED FOR FOLLOWING LOADING CONDITIONS :

	S.L.D.	L.L.
STAIRS & BALCONIES	0.50 KPa	4.80 KPa
LOCKERS & STORAGE *	1.30 KPa	4.80 KPa
RESIDENTIAL	1.3 KPa	1.9 KPa
TOILETS	1.30 KPa	2.40 KPa
TERRACES	5.0 KPa	4.80 KPa
- MINIMUM YIELD STRESS FOR REINFORCING STEEL SHALL BE 400 MPa.
- TEMPERATURE REINFORCING FOR : 200 SLAB IS 10@250, 210 SLAB IS 10@230.
- NO OPENINGS LARGER THAN 300mm x 300mm ARE ALLOWED IN SLAB OTHER THAN THOSE SHOWN ON DRAWINGS.
- SEE TYPICAL DETAILS ON DRAWINGS S-001 TO S-006.
- SEE GENERAL NOTES ON DRAWING S-001.
- REFER TO ARCH. DRAWINGS FOR SLOPES OF SLAB.
- FOR COLUMN & WALL SCHEDULE SEE DRAWINGS S-301 TO S-306.
- COORDINATE BEAM DEPTH AT DOOR OPENINGS WITH ARCH. DRAWINGS.
- EXTEND TEMP. REINF. TO END OF BALCONIES/OVERHANGS.
- TOP BARS TERMINATING AT EDGE OF SLAB TO HAVE 180° HOOK.

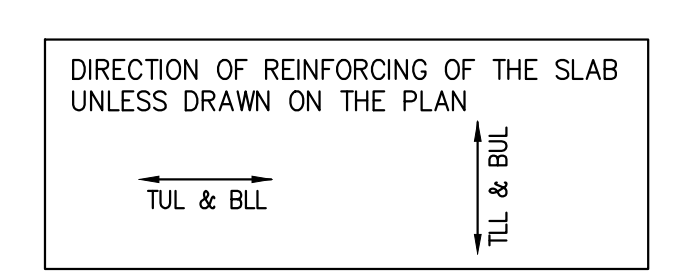

PARTIAL PLAN OF THE HOT TUB SLAB
SCALE 1 : 100

NOTE: CONCRETE STRENGTH AT 28 DAYS SHALL BE 35 MPa. CONCRETE EXPOSED TO DEICING CHEMICALS SHALL BE PROPORTIONED FOR C-1 EXPOSURE CLASSIFICATION AND HAVE 6% TO 8% ENTRAINED AIR WITH APPROVED CORROSION INHIBITOR ADDED AT A MINIMUM RATE OF 10.0 LITRES PER 1.0 CUBIC MTR OF CONCRETE.

Jablonsky, Ast and Partners
CONSULTING ENGINEERS
1120 LESLIE STREET
DOR MILLS, ON, M3C 2K5
TEL: 416-447-7400
FAX: 416-447-2771
E-mail: jsp@ast.on.ca



FIRST FLOOR ELEV. 93.60m

NO.	ISSUED / REVISED	DATE
1	ISSUED FOR PERMIT	2014-05-03
2	RE ISSUED FOR PERMIT	2014-07-01
3	ISSUED FOR FORMING TRENCH	2014-08-27
4	CONSTRUCTION REVIEW	2015-03-01
5	RE ISSUED FOR PERMIT	2015-01-07
6	ISSUED FOR CONSTRUCTION	2015-01-01
7	UPDATED - P.C.	2015-04-03
8	UPDATED - P.C.	2015-05-01
9	ISSUED FOR B.P.	2015-07-01
10	ISSUED FOR B.P.	2015-11-04
11	ISSUED FOR B.P.	2016-01-07

ALEXANDRA PARK - BLOCK 11
TORONTO, ONTARIO

project no: 13015
scale: 1:100
drawn by: H.W.
checked by: H.P.
date stamped: MARCH 2014