ALEXANDRA PARK

MAIN BUILDING BLOCK 11

INDEX

ID0.0.0	COVER SHEET AND INDEX
ID0.0.1	FINISHES SCHEDULE PLUMBING & EQUIPMENT SCHEDULE
ID0.0.2	DOOR SCHEDULE LIGHTING AND ELECTRICAL LEGEND
ID1.0.0	P2 LEVEL PLANS ALL PLANS
ID1.0.1	P1 LEVEL PLANS ALL PLANS
ID1.1.0	1 ST FLOOR CONSTRUCTION PLAN
ID1.1.1	1 ST FLOOR REFLECTED CEILING PLAN
ID1.1.2	1 ST FLOOR FURNITURE & POWER PLAN
ID1.1.3	1 ST FLOOR FLOOR FINISHES PLAN
ID1.1.4	1 ST FLOOR WALL FINISHES PLAN
ID1.1.5	1 ST FLOOR / CORRIDOR ALL PLANS
ID1.1.6	1 ST FLOOR / CORRIDOR WINTER MATTING PLAN
ID1.2.0	2ND FLOOR CONSTRUCTION PLAN & REFLECTED CEILING PLAN
ID1.2.1	2ND FLOOR FLOOR FINISHES PLAN & WALL FINISHES PLAN
ID1.3.0	3RD FLOOR CONSTRUCTION PLAN & REFLECTED CEILING PLAN
ID1.3.1	3RD FLOOR FLOOR FINISHES PLAN & WALL FINISHES PLAN
ID1.4.0	4TH FLOOR CONSTRUCTION PLAN & REFLECTED CEILING PLAN
ID1.4.1	4TH FLOOR FLOOR FINISHES PLAN & WALL FINISHES PLAN
ID1.5.0	5TH FLOOR CONSTRUCTION PLAN & REFLECTED CEILING PLAN
ID1.5.1	5TH FLOOR FLOOR FINISHES PLAN & WALL FINISHES PLAN
ID1.6.0	6TH FLOOR CONSTRUCTION PLAN & REFLECTED CEILING PLAN
ID1.6.1	6TH FLOOR FLOOR FINISHES PLAN & WALL FINISHES PLAN
ID1.7.0	7TH FLOOR CONSTRUCTION PLAN & REFLECTED CEILING PLAN
ID1.7.1	7TH FLOOR FLOOR FINISHES PLAN & WALL FINISHES PLAN
ID1.8.0	8TH FLOOR CONSTRUCTION PLAN & REFLECTED CEILING PLAN
ID1.8.1	8TH FLOOR FLOOR FINISHES PLAN & WALL FINISHES PLAN
ID1.9.0	9TH FLOOR CONSTRUCTION PLAN & REFLECTED CEILING PLAN
ID1.9.1	9TH FLOOR FURNITURE & POWER PLAN FLOOR FINISHES PLAN & WALL FINISHES PLAN
ID1.10.0	10TH FLOOR ALL PLANS
ID1.11.0	11TH FLOOR ALL PLANS
ID1.12.0	12TH FLOOR ALL PLANS
ID1.13.0	13TH FLOOR ALL PLANS
ID1.14.0	14TH FLOOR ALL PLANS
ID2.0.0	ELEVATIONS
ID2.0.1	ELEVATIONS
ID2.0.2	ELEVATIONS
ID2.1.0	ELEVATIONS
ID2.1.1	ELEVATIONS
ID2.1.2	ELEVATIONS
ID2.1.3	ELEVATIONS
ID2.1.4	ELEVATIONS
ID2.1.5	ELEVATIONS
ID2.1.6	ELEVATIONS
ID2.1.7	ELEVATIONS
ID2.1.8	ELEVATIONS
ID2.1.9	ELEVATIONS
ID2.1.10	ELEVATIONS
ID2.1.11	ELEVATIONS
ID2.2.0	ELEVATIONS
ID2.3.0	ELEVATIONS
ID2.4.0	DOOR ELEVATIONS
ID2.4.1	DOOR ELEVATIONS
ID2.5.0	ELEVATOR CAB & GARBAGE CHUTE PLANS, ELEVATIONS & DETAILS
ID3.0.0	SECTION DETAILS
ID3.1.0	CEILING DETAILS
ID3.1.1	CEILING DETAILS
ID3.2.0	WALL SECTIONS
ID3.2.1	WALL SECTIONS
ID4.0.0	MILLWORK
ID4.1.0	MILLWORK
ID4.2.0	MILLWORK
ID5.0.0	TYPICAL DETAILS

DO NOT SCALE DRAWINGS.

CONTRACTOR MUST VERIFY ALL DRAWINGS, DIMENSIONS, DETAILS AND SPECIFICATIONS, AND REPORT ANY DISCREPANCIES TO *UNION 31 INC.* BEFORE PROCEEDING WITH WORK. MATERIALS MAY NOT BE SUBSTITUTED WITHOUT WRITTEN APPROVAL FROM *UNION 31 INC.*

ALL DRAWINGS AND SPECIFICATIONS ARE INSTRUMENTS OF SERVICE AND THE PROPERTY OF *UNION 31 INC.* WHICH MUST BE RETURNED AT THE COMPLETION OF THE WORK.

PRINTED: 30-May-17

ISSUED FOR AS-BUILT

NO.	DATE	COMMENTS	INI
01	31 MAY / 17	ISSUED FOR AS-BUILT	SV

REVISIONS:

UNION31

UNION31 INC.
183 BATHURST STREET, STE 201
TORONTO, ON, M5T 2R7, CANADA
TEL: 416-597-1576 FAX: 416-597-2139

PROJECT NAME:
ALEXANDRA PARK
MAIN BUILDING
BLOCK 11
ON, Canada

PROJECT NO.: 13-949

DRAWING/S:
INDEX

DATE STARTED:	07 AUG / 13	DRAWING NO.:	ID 0.0.0
SCALE:	NTS		
DRAWN BY:	AP		
APPROVED BY:	KC		

36 x 48

FINISHES SCHEDULE

ACT#1 **Corridor Ceiling Tile**
CGC Fineline DXF ceiling grid system, 4' cross tees, flat white, grid edge: FLB, wall molding detail: MS174, CGC Mars Climaplus ceiling tile, 2'x4' x 3/4" size, white
Supplier: CGC

BASE #1 **100mm Tile Base**

BASE #2 **100mm MDF Applied Base**

BASE #3 **100mm MDF Flush Base**

BASE #4 **75mm Tile Base**

BASE #5 **100mm Tile base w/ Tile Trim #1**

BASE #6 **100mm Metal Base**

BASE #7 **50mm Recessed Base for Tile #11**

BASE #8 **50mm Cove Base**
(for Quebec Series unglazed mosaic to match adjacent floor tile)

CARPET#1 ***(Prop Management Office)***
Carpet Tile, Stack 9 #04332, Colour: Luminous #75001, 24"x24" Unidirectional Installation, 100% Solution Dyed
Supplier: Tandus Flooring
Contact: Thomas Jackson
416-768-8939

CARPET#2 ***(Theatre)***
Broadloom Carpet, Data Stream #40036, Colour: Black Metallic #01962, 12' 6" (381 cm) wide, Dynex nylon, solution dyed.
Supplier: Tandus Flooring

CARPET#3 ***(Corridors, Typical)***
Broadloom Carpet, Trace #44053, Colour: Lead Mark #01910, 100% Solution Dyed
Supplier: Tandus Flooring

CARPET#4 ***(Corridors, Typical Accent)***
Broadloom Carpet, Alpaca 51050, Colour: Ostrich 00809, 100% Solution Dyed
Supplier: Tandus Flooring

GLASS#1 ***N/A***

GLASS#2 ***(Lobby, Wall Paneling)***
1/4" or thickness as required, Back painted glass, star-fire, tempered. Contractor to provide sample for designer review and approval prior to fabrication. Refer to elevations for location.
Supplier: NGI Designer Glass

GLASS#3 ***(Dining Room/Party Room)***
1/4" or thickness as required, NGM/B Bronze Silk, star-fire, tempered. Contractor to provide sample for designer review and approval prior to fabrication. Refer to elevations for location.
Supplier: NGI Designer Glass

GLASS#4 ***(Lobby Fireplace Wall)***
1/4" or thickness as required, NGM Black Mirror, star-fire, tempered. Contractor to provide sample for designer review and approval prior to fabrication. Refer to elevations for location.
Supplier: NGI Designer Glass

GLASS#5 ***(Whirpool- glass wall into gym, glass doors)***
½" or thk as required frosted glass.
Supplier: SPS Glass and Metals

HARDWOOD#1 ***(Party Room)***
Kentwood Originals, 7.5" wide, engineered plank floor
Col: Oak Silver Creek
Random plank installation, direct glue down.
Supplier: Metropolitan Hardwood Floors
Contact: Joe Cosentino
416-389-5003

HARDWOOD#2 **N/A**

MELAMINE #1 ***(Amenity Kitchen)***
Living Art, European Wood Surface #LW-3078 or approved alternative. Contractor to provide sample for designer review and approval prior to fabrication. Refer to elevations for location.
Supplier: By Kitchen Manufacturer/Living Art
Contact: Vladik Gladilen
647-893-2767

METAL #1 Blackened Stainless Steel, gauge to be confirmed by fabricator. Refer to elevations for location.
Supplier: By Millworker/Option 3 Display
Contact: Tony Rizzo
514-333-9322

METAL #2 ***(Party Room Divider Screen)***
Steel coil mesh, antique bronze finish, 1/8-20 gauge. Refer to elevations for location.
Supplier: By Millworker/Sunbrite
Contact: 800-999-2645

METAL #3 ***(Party Room Bar Table)***
Brass to match Chemetal #325 Statuary Brass, gau ge to be confirmed by fabricator. Contractor to provide sample for designer review and approval prior to fabrication. Refer to elevations for location. Lacquered, scratch resistant finish.
Supplier: By Millworker/McFaddens
Contact: Lucia Niu

METAL #4 ***(Fitness Room - Glazing Shoe)***
Satin Chrome from standard offering.
Supplier: Glazing Supplier

METAL #5 ***(Enterphone, Metal Shroud @ sinks, Elevator Cabs, P1 and 14th Floor Elevator Doors/Frames)***
Stainless Steel, thickness as required.
Supplier: Millwork

METAL #6 ***(Throughout, Elevator Doors and Frame on Grd Flr)***
XL Black Hairline Stainless Steel
Supplier: Excelsior Metal

MIRROR#1 ***N/A***

MIRROR#2 ***(Fitness)***
1/4" or thickness as required, clear mirror, tempered. Contractor to provide sample for designer review and approval prior to fabrication. Refer to elevations for location.
Supplier: NGI Designer Glass

PEDIMAT#1 ***(All Vestibules)***
Construction Specialties Gridline G6. Install according to LEED requirements, as shown on floor finishes plan. Install flush to adjacent floor finishes.
Supplier: Construction Specialties

PAINT#1 ***(General Walls, Throughout)***
Dulux, Song Porcelain #00NN 83/000, latex flat washable finish. Refer to elevations and wall finishes plan for location.
Supplier: Dulux

PAINT #2 ***(Ceiling, Throughout)***
Dulux, Song Porcelain #00NN 83/000, latex, flat finish. Refer to elevations and wall finishes plan for location..
Supplier: Dulux

PAINT #3 ***(P Mgmt Office Wall and Base)***
Dulux, Designer Grey, 50YY 63/041, latex, semi gloss for base and eggshell finish for walls. Refer to elevations and wall finishes plan for location.
Supplier: Dulux

PAINT #4 ***(Parking Level Elevator Doors and Frames)***
Dulux, Forest Black #30YY 10/038, latex, semi gloss finish. Refer to elevations and wall finishes plan for location.
Supplier: Dulux

PAINT #5 ***(Party Room Base)***
Dulux, Song Porcelain #00NN 83/000, latex, semi gloss finish. Refer to elevations and wall finishes plan for location.
Supplier: Dulux

PAINT #6 ***(Theatre Base)***
Dulux, Obsidian Glass, #00NN 13/ 000, latex, semi gloss finish. Refer to elevations and wall finishes plan for location.
Supplier: Dulux

PAINT #7 ***(Dining Room - Wall and Base)***
Dulux, Mansard Stone, #30YY 20/ 029, latex, flat washable finish for walls and semi gloss finish for base. Refer to elevations and wall finishes plan for location.
Supplier: Dulux

PAINT #8 ***(Changeroom Water Closet Walls)***
Dulux, Zeppelin, #30YY 46/ 036, latex, flat washable finish. Refer to elevations and wall finishes plan for location.
Supplier: Dulux

PAINT #9 ***(Lobby General)***
Refer to Paint #1.

PAINT #10 ***(Suite Entry/typ doors and Frames)***
Dulux, Forest Black #30YY 10/038, latex, flat finish. Refer to elevations and wall finishes plan for location.
Supplier: Dulux

PAINT #11 ***(Typ Corridors Base)***
Dulux, Forest Black #30YY 10/038, flat finish. Refer to elevations and wall finishes plan for location.
Supplier: Dulux

PAINT #12 ***(Fitness Room Base)***
Refer to Paint #7.

PAINT #13 ***(Changeroom Water Closet Walls)***
Refer to Paint #8.

PAINT #14 ***(Typ Corridor Utility doors - Electrical Closet, Garbage Chute, Exit Stairs)***
Dulux, Stratosphere, #40YY 73/ 028, latex, semi gloss finish. Refer to elevations and wall finishes plan for location.
Supplier: Dulux

PAINT #15 ***(HM Door Frame paint to match the walnut wood surround for the common area doors)***
Benjamin Moor CC - 514 Hiking Trail, Refer to Typical Details

PAINT #16 ***(Amenity Fitness, Utility Doors)***
Benjamin Moor, Simply White, 2143-70, latex semi gloss finish. Refer to elevations and wall finishes plan for location.

PAINT #17 ***(Railing finish in stairwell from P level to ground floor & from 2nd floor to PH level)***
to match paint #7

PAINT #18 ***(Janitor room Door)***
Benjamin Moor, HC-166,

PAINT #19 ***(FCU Access Door in kitchen)***
Dulux 30YY 11/076, [A1861], Burnwood, Refer to elevations and wall finishes plan for location.
Supplier: Dulux

P.LAM#1 ***(Prop Management Kitchen/Admin)***
Arborite, Cordova Brown, #S-508-SR. Refer to elevations for location.
Supplier: Wilsonart
Contact: Janet Bascoe-Spencer
905.565.1255 x5731

P.LAM#2 ***(Prop Management Kitchen/Admin)***
Arborite, Fumed American Elm, #W-468 EV. Refer to elevations for location.
Supplier: Wilsonart

P.LAM#3 ***(Concierge Millwork / Parcel Storage)***
Arborite, Snow White, #S-417 CA. Refer to elevations for location.
Supplier: Wilsonart

P.LAM#4 ***(Party Room Island)***
Arborite, Cordova Brown, #S-508-SR. Refer to elevations for location.
Supplier: Wilsonart

RUBBER #1 ***(Gym Floor)***
Johnsonite Triumph, 610mm x 610mm x 9.5mm, Colour: #29 Moon Rock, square edge tiles, hammered surface texture (SMH). Install as per manufacturer's directions. Refer to floor finish plan for location.
Supplier: Johnsonite
Contact: Tom Joyce
905.886.8081

SP. MATERIAL #1 ***(Lobby Column Covers)***
16ga Black hairline stainless steel. Refer to elevations for location.
Supplier: Formnuovo

SLAB#1 ***(Millwork, Concierge Desk)***
Cipollino, polished.
Supplier: Ciot
Contact: Aaron Huynh
416.739.8000 x8888

SLAB#2 ***(Millwork, Concierge Desk)***
Nero Voda, cross cut, honed.
Supplier: Ciot

SLAB#3 ***(Lobby, Elevator surround)***
N/A
Supplier: Ciot

SLAB#4 ***(Amenity Kitchen Counter, Party Room Bar Table)***
¾" Slab, Caesarstone #5110 Alpine Mist, edges to be polished.
Supplier: Caesarstone
Contact: Michelle Greco
416-476-6949

SLAB#5 ***(Prop Management Kitchen/Admin)***
¾" Slab, Caesarstone #2141 Blizzard, edges to be polished.
Supplier: Caesarstone

SLAB#6 ***(Changeroom)***
¾" Slab, Caesarstone #4003 Sleek Concrete, edges to be polished.
Supplier: Caesarstone

SLAB#7 ***(Party Room & Theatre Kitchen Counter)***
¾" Slab, Paragon Black, polished, edges to be polished.
Supplier: Ciot

SLAB#8 ***(Party Room Bar Counter)***
¾" Slab, same as slab #7
Supplier: Ciot

TILE #1 ***(Lobby Flooring)***
60x120cm porcelain tile, Stone Project, Grey Falda Naturale, 60x120, grout colour TBD. Refer to floor finish plan for location.
Supplier: Stone Tile
Contact: Debra Rubin
416-515-9000 x245

TILE #2A ***(Lobby Flooring Accent)***
20x120cm porcelain tile, Stone Project, Grey Falda Naturale, grout colour TBD
Refer to floor finish plan for location.
Supplier: Stone Tile

TILE #2B ***(Lobby Flooring Accent)***
20x120cm porcelain tile, Stone Project, Grey Falda Lappato, grout colour TBD
Refer to floor finish plan for location.
Supplier: Stone Tile

TILE #3 ***(Changerooms Flooring)***
15x90cm porcelain tile - ***cut down to 15x15cm square format***, StoneBox, Colour: Bright Grey, natural finish, grout colour TBD. Install as per manufacturer's directions. Refer to floor finish plan for location.
Supplier: Stone Tile
Contact: Debra Rubin
416.515.9000 x299

TILE #3a ***(Washroom Walls)***
Same as tile #3, size: 150mmx300mm
Supplier: Stone Tile
Contact: Debra Rubin
416.515.9000 x299

TILE #4 ***(Changeroom Walls)***
4x16" ceramic tile, Colour & Dimensions Collection, Arctic White Bright, #QT.CD.ARW.0416.BR, grout TBD. Install as per manufacturer's directions. Refer to wall finishes plan for location. Ensure grout lines align as per wall finishes plan.
Supplier: Olympia Tile
Contact: Lucy Capobianco
416-785-9555 x254

TILE #5 ***(Staff W/C Shower Changeroom Walls)***
Same as Tile #4

TILE #6 ***(Kitchen Flooring)***
24"x24" porcelain tile, Metal Gloss, Steel Wool, #MAR0349MGFL02, grout TBD. Install as per manufacturer's directions. Refer to floor finish plan for location.
Supplier: Division 9
Contact: Mary Kouros
905.789.3756 x2544

TILE #7 **N/A**

TILE #8 ***(Mail Room Flooring)***
60x120cm porcelain tile, Stone Project, Grey Falda Naturale, 60x120, grout colour TBD. Refer to floor finish plan for location.
Supplier: Stone Tile

TILE #9 ***(Prop Management Kitchen/Admin)***
Porcelain tile, Versus, Ice Natural #VEIC1224, 12"x24", grout colour TBD.
Install as per manufacturer's directions. Refer to floor finish plan for location.
Supplier: Centura

TILE #10 ***(Whirlpool Room Flooring)***
Refer to Tile #3
Supplier: Stone Tile

TILE #11 ***(Lobby Recessed Base)***
Unicolor Super Black Polished BY.UN.BLK.1224, cut to size per detail. Install as per manufacturer's directions. Refer to floor finish plan for location.
Supplier: Olympia Tile

TILE #12 ***(Changerooms, Showers)***
Mosaic tile, Quebec, Dark Grey FS, 2"x2", unglazed, #OO.QC.STR.0202.FS
Refer to floor finish plan for location.
Supplier: Olympia Tile

TILE #13 ***(P Level Elevator Lobby Walls)***
12x24" porcelain tile, Montecassino Matte, vein cut, Grey, natural finish, #ZS.MC.GRY.1224.MT.VC, grout colour TBD. Install as per manufacturer's directions. Refer to floor finish plan for location.
Supplier: Olympia Tile

TILE #14 ***(P Level Elevator Lobby Flooring)***
12x24" porcelain tile, Evolve Night Black #WA.EV.NHT.1224, grout colour TBD. Install as per manufacturer's directions. Refer to floor finishes plan for location.
Supplier: Olympia Tile

TILE #15 ***(Staff WC Changeroom Floor)***
12x24" porcelain tile, Evolve, Color: Night (Black), natural finish, #WA.EV.NHT.1224, grout colour TBD. Install as per manufacturer's directions. Refer to floor finish plan for location.
Supplier: Olympia Tile

TILE #15a ***(Staff WC Changeroom Cove Base)***
Quebec Series unglazed mosaic 2x2 cove base, to match Tile #15 (colour TBD)
Supplier: Olympia Tile

TILE #16 ***(Whirlpool Room Walls)***
15x90cm porcelain tile, StoneBox, Colour: Bright Grey, natural finish, grout colour TBD. Install as per manufacturer's directions. Refer to elevations for location.
Supplier: Stone Tile

TILE #17 ***(Elevator Lobby Wall Ground Floor)***
Changed to Glass #2
Supplier: Stone Tile

TILE #18 ***(Typ Corridor Walls @ Elevator)***
15x90cm porcelain tile, StoneBox, Colour:, polished finish, grout colour TBD. Install as per manufacturer's directions. Refer to floor finish plan for location.
Supplier: Stone Tile

TILE #19 ***(Public Barrier Free Washroom Walls)***
3"x10" ceramic tile, Liverpool, col: Portland, glossy grout TBD. Install as per manufacturer's directions. Refer to floor/wall finishes plan for location. Ensure grout lines align as per floor finishes plan/elevations..
Supplier: Cera Gres
Contact: Jessica Cano
416-286-3553

TILE #20 ***(Changerooms - Cove Base)***
Quebec Series unglazed mosaic 2x2 cove base, to match Tile #3 (colour TBD)
Supplier: Olympia Tile

TILE #21 **(Barrier Free Washroom Mural)**
Bisazza mosaic mural. 10mm x 10mm, Sfumature shading blend, colour: Gelsomino. Install as per manufacturer's directions. Refer to wall finishes plan for location. Ensure grout lines align as per floor finishes plan/elevations..
Supplier: Stone Tile Stone Tile

TILE #22 **(Garbage Room Floor)**
50mm x 50mm Quebec Series Black FS, Grout Flextile, Col; Charcoal . Install as per manufacturer's directions. Refer to floor/wall finishes plan for location. Ensure grout lines align as per floor finishes plan/elevations..
Supplier: Olympia

TILE #23 **(Garbage Room Walls)**
300mm x 600mm porcelain tile, Eiger Antracite, Grout Flextile, Col; Charcoal . Install as per manufacturer's directions. Refer to floor/wall finishes plan for location. Ensure grout lines align as per floor finishes plan/elevations..
Supplier: Ciot

TILE# 24 ***(Ground Flr Interior Whirlpool)***
1" x 1" unglazed porcelain tile, Quebec Series, col: black
Refer to floor finish plan for location.
Supplier: Olympia Tile
Contact: Lucy Capobianco
(416)785-9555

TILE# 25 ***(Ground Flr Interior Whirlpool Nosing)***
1" x 1" unglazed porcelain tile, Quebec Series, col: arctic white
Refer to floor finish plan for location.
Supplier: Olympia Tile

TILE# 26 ***(Ground Flr Fitness Wall Tile)***
2"x 8" glazed cermaic tile, Colour and Dimension Series, col: arctic white
Refer to floor finish plan for location.
Supplier: Olympia Tile

TILE TRIM #1 **(Exposed Wall Tile Edges)**
Schluter Jolly, Brushed Nickel, size to suit tile.

TILE TRIM #2 **(Laminate to Laminate)**
Schluter Schiene, Brushed Nickel, size to suit laminate floor.

WALLCOVERING #1 ***(Corridors)***
Vinyl Wallcovering, Custom Type II wallcovering based on Vescom 05 - Tempe #766.12. Refer to wall finishes plan and elevations for location.
Supplier: Metro Wallcovering
Contact: Charley Binder
905.738.7461

WALLCOVERING #2 ***(P Level Elevator Lobby)***
Vinyl Wallcovering, Custom Type II wallcovering based on Vescom 05 - Albert #778.09. Refer to wall finishes plan and elevations for location.
Supplier: Metro Wallcovering

WALLCOVERING #3 ***(Party Room)***
Vinyl Wallcovering, Vescom 05 Tessera 770.11, 52" wide, 20oz. Type II, Class A. Refer to wall finishes plan and elevations for location.
Supplier: Metro Wallcovering

WALLCOVERING #4 ***(Dining Room Accent)***
Custom Vinyl Mural Wallcovering, image/graphic to be selected by designer and printed on vinyl substrate, Type II, Class A. Refer to wall finishes plan and elevations for location.
Supplier: Metro Wallcovering

WALLCOVERING #5 ***(Amenity Dining Room & Kitchen)***
Vinyl Wallcovering, Koroseal, Montage, Café Noir 8721-85, 54" wide, Type II, Class A. Refer to wall finishes plan and elevations for location.
Supplier: Metro Wallcovering

WALLCOVERING #6 ***(Theatre)***
Vinyl Wallcovering, Colour and Design, Obana Glint, CD2-OBG-45, Black Mica, 54" wide, Type II, Class A. Refer to wall finishes plan and elevations for location.
Supplier: Metro Wallcovering

WALLCOVERING #7 ***(Gr Floor Public Spaces)***
Refer to Wallcovering #3.

WALLCOVERING #8 ***(Gr Floor Fitness)***
Vinyl Wallcovering, Koroseal, Patana, Cotton, 0721-03, 54" wide, Type II, Class A. Refer to wall finishes plan and elevations for location.
Supplier: Metro Wallcovering

WALLCOVERING #9 ***(Gr Public Washroom)***
Vinyl Wallcovering, Colour and Design, Canton Rainsilk, CD2-CTR-13, Clean Slate, 54" wide, Type II, Class A. Refer to wall finishes plan and elevations for location.
Supplier: Metro Wallcovering

WOOD#1 ***(Party Room Millwork - Throughout)***
TAY (KOTO) 04.005 veneer, clear coat 10% sheen of high quality urethane to be applied for protection, solids as required. Contractor to provide sample for designer review and approval prior to fabrication. Refer to elevations for location.
Supplier: By Millworker/Materials Inc.
Contact: Leonardo Fiaschi
201.968.0101

WOOD#2 ***(Lobby Millwork Throughout - Fin Detail)***
Walnut, flat cut, MI-C3216, veneer, oiled finish. Contractor to provide sample for designer review and approval prior to fabrication. Refer to elevations for location.
Supplier: By Millworker/Materials Inc.

WOOD#3 ***(Typ Suite Door Surrounds)***
Walnut, flat cut, MI-C3216, veneer, oiled finish. Contractor to provide sample for designer review and approval prior to fabrication. Refer to elevations for location.
Supplier: By Millworker/Materials Inc.

WOOD#4 ***(Lobby Millwork - Ceiling)***
Koroseal Arbor Series Wood wallcovering, Walnut, flat cut, veneer applied directly onto drywall ceiling, Flame Spread rating: 10, Class A fire rating. Supplier to create install pattern. Book matched as required. Contractor to provide sample for designer review and approval prior to fabrication. Refer to elevations for location.
Supplier: Metro Wallcovering
Contact: Charley Binder

WINTER MATTING#1 ***(Lobby, P Levels, 9th Flr - To Outdoor Amenity)***
Vi-Floor, Super Series, Col: 1172, Solution dyed Polypropylene fibers
Total Thickness:12.5mm (0.5")
Supplier: Vi Floor
Contact: Bob Doherty
(416)521-9014

FABRICS

FAB#7 ***(Drapery)***
Charcoal fabric. Ultrasoft - 21, Colour: Charcoal, 45" W
Supplier: Kravet
Contact: Brenda Bradley
905.607.0706 x811

FAB#8 ***(Theatre Acoustic Panels)***
Charcoal fabric, Liam, Colour: #98S6601, 55" W.
Supplier: Joanne Fabrics
Contact: 905.491.3900

PLUMBING SCHEDULE

P1 - TOILET ***(Ground Flr W/C / 2nd floor change room, 6th floor changeroom, Ground Floor Fitness)***
Kohler HighCliff toilet bowl K-4368, white finish, c/w Lustra open front seat K-4368; col: White. Exposed toilet flushometer, 1.28 gpf, K-13516, polished chrome finish. Refer to Furniture & Power plan for locations.
Supplier: Kohler
Contact: Arnel Go
416-716-0536

P2 - BASIN ***(Ground Floor W/C/P1 WC)***
American Standard Wheelchair Users Lavatory. Vitreous china, 9140.047 Center Hole Only. 20"x27" Colour: White
Supplier: American Standard
Contact:

P3 - FAUCET ***(Ground Floor W/C)***
Hansgrohe Metris S Single Hole Faucet c/w pop up. 31060001, Chrome Finish. Install according to CBC requirements for Barrier Free.
Supplier: Amati Plumbing

P4 - SINK ***(Ground Floor Changerooms)***
White vitreous china under counter sink # PS-105 , 16" x16" x 6-3/4"h, c/w recommended drain. Refer to Furniture & Power plan for locations.
Supplier: Cantrio Koncepts

P5 - SHOWER HEAD ***(Ground Floor Changerooms)***
Hansgrohe, Raindance Connect Shower System, wall mounted shower head and hand shower, model #27164001, chrome finish. Complete with required rough-ins, wall outlets and temp control trims.
Supplied By: Amati

P6 - FAUCET ***(Ground floor Changerooms)***
Hansgrohe Metris S Faucet # 31163001 with Preset Temperature control. Battery operated (included), Chrome Finish.
Supplier: Amati

P7 - SINK ***(Ground Floor Amenity Bar)***
Stainless steel undermount sink KSS-003, c/w mtg hardware and all parts. Refer to Furniture & Power plan for locations.
Supplier: Cantrio Koncepts

P8 - SINK ***(Ground Floor Amenity Kitchen)***
Stainless steel undermount sink KSS-005, 18"x23"x10.5" c/w mtg hardware and all parts. Refer to Furniture & Power plan for locations.
Supplier: Cantrio Koncepts

P9 - FAUCET ***(Ground Floor Amenity Kitchen)***
Blanco Culina Mini Pull Down Kitchen Faucet, 441624, pull out single spray, swivel spout, chrome finish, 1.8gpm. Refer to Furniture & Power plan for locations.

P10 - FAUCET ***(Ground Floor Bar)***
Blanco Culina Mini Pull Down Kitchen Faucet, 441624, pull out single spray, swivel spout, chrome finish, 1.8gpm. Refer to Furniture & Power plan for locations.

P11 - LINEAR FLOOR DRAIN ***(Amenity Showers)***
Infinity drain, S-AS 65 , complete kit, site sizable. Size per plan. Polished Stainless finish. Complete with all necessary components. Refer to Furniture and Power plan for locations. Consult with landscape architect.
Supplier: Infinity Drain

P12 - SINK ***(P1 Level Kitchenette)***
Stainless steel undermount sink KSS-2018, 20"x18"x8" c/w sound dampening pads, hardware and all parts. Refer to Furniture & Power plan for locations
Supplier: Cantrio Concepts

P13 - FAUCET ***(P1 Level Kitchenette)***
American Standard Collina Single Control kitchen faucet, pull down spray, chrome finish, 4717 300, 1.8gpm. Refer to Furniture & Power plan for locations.

P14 - BOTTLE FILLING STN ***(Fitness Area Ground Floor)***
Elkay EZH20 Bottle filling station with Bi-Level EZ Cooler Model LZSTL8WS . Refer to Furniture & Power plan for locations.
Supplier: Elkay

P15 - SHOWER HEAD **(P1 Level Changeroom)**
American Standard, Serin Shower System Kit, model # 2064.724, 3 function adjustable hand shower, hose, wall supply, and slide bar, chrome finish. Complete with required rough-ins, control valves, trim kit and accessories.
Supplied By: American Standard
Contact: Fedele Rossi
(647)201-6633

P16 - BASIN **(P1 Level Changeroom)**
Same as P2

P17 - FAUCET **(P1 Level Changeroom)**
American Standard Serin Single hole faucet, chrome finish, 2064 101, with pop up drain, 1.8gpm. Refer to Furniture & Power plan for locations.

P18 - BARRIER ADJ SHOWER KIT **(Ground floor/P1 barrier free washroom)**
Cabano 75101 Build a Shower Stilo Shower rail kit. Incl Bar, hose and hand shower, Chrome. Mounting height according to OBC Barrier free requirements.

P19 - FOOT SHOWER ***(9th Floor Pool (outdoors))***
Foot shower at deck floor level c/w ADA metered push valve 32" free-standing foot shower, FSFS-200-ADA, polished chrome finish. Refer to Furniture and Power plan for locations. Consult with landscape architect.
Supplier:

P20 - JANITOR SINK ***(Ground floor)***
Molded stone mop service basin, MSB2424, 24"x24"x10" deep, refer to furniture and power plan for location

P21- JANITOR SINK FAUCET ***(Ground floor)***
Delta sink faucet wall mount, Model no: 28T9, refer to furniture and power plan for location

EQUIPMENT SCHEDULE

E1 - INTEGRAL SOAP DISPENSER (washrooms)
Stern Engineering Commercial Electronic smart touch free soap dispenser. Ref # 235900
Supplier: Stern Engineering

E2 - TOWEL DISPENSER (washrooms)
Bobrick surface mount dispenser/disposal fixture B-43699, stainless steel satin finish
Supplier: Citywide door and hardware

E3 - TOILET TISSUE DISPENSER (washrooms)
Bobrick surface mount multi roll toilet tissue dispenser, model B-2888 stainless steel satin finish
Supplier: Citywide door and hardware

E4 - FEMININE NAPKIN DISPOSAL (washrooms)
Bobrick surface mount feminine napkin disposal model#B-254 stasinless steel satin finish
Supplier: citywide door and hardware

E5 - GRAB BARS (washrooms)
Bobrick grab bar system B-6206 series, complete with concealed mounting, contractor to ensure system complies with OBC, stainless steel finish
Supplier: citywide door and hardware

E6 - HOOK (washrooms)
Bobrick surface mounted robe hook model#B-6717 stainless steel satin finish, refer to plans for location
Supplier: Citywide door and hardware

E7 - MAILBOXES (Mailroom)
Riopel, model 4500-D192, rear loading horizontal mailboxes, refer to elevation for location
Supplier: Riopel
Contact: Order desk
1-514-934-0385

E8 - FRIDGE (Party room Kitchen)
24" integrated refrigerator, per building standard. Panel colour TBD.
Supplier: Appliance Canada
Contact: John Oulahen
905-660-2424

E9 - DISHWASHER (Party room Kitchen)
24" fully integrated dishwasher, per building standard. Panel colour TBD.
Supplier: Appliance Canada

E10 - MICROWAVE (Party room kitchen)
Panasonic NN ST7655
Supplier: Appliance Canada

E11 - ENTERPHONE (entry)
By client

E12 - LOCKERS
Hadrian "Emperor" Locker System, double tier, 72" high x 12" wide x 12" deep, col: Dovetail, 828
Supplier: Hadrian
Contact : Order Desk/ 905- 333-0300

E13 - WATER FOUNTAIN (Exercise Room)
Refer to P14 for spec.

E14 - TV (Billiards Room)
46",By client

E15 - TV (Dining Room)
46" By client

E16 - TV (Bar)
46" TV mounted behind mirrored wall paneling. TBD

E17 - TV (Party Room)
65", by client

E18 - B.F. Mirror (B.F washroom - P1 Level, 9th Floor)
Bobrick B293 1836, fixed position tilt mirror
Supplier: Citywide door and hardware

E19 - TBD

E20 - Photocopier (Management Office)
By client

E24 - Warming Drawer (Kitchen)
Porter and Charles WD60-14 24" stainless steel warming drawer, 5.5" high
Supplier: Appliance Canada

E25 - Warming Drawer (Kitchen)
Porter and Charles WD60-21 24" stainless steel warming drawer, 8.2" high
Supplier: Appliance Canada

E26 - Elec Fireplace (Dining Room)
Dimplex IgniteXL XLF50

E27 - Whirlpool (Changerooms)
Custom Concrete Whirlpool, with jets, as per pool supplier specifications.
Supplier: Advanced Commercial Pool and Spa

E28 - WALL MNT SOAP DISPENSER (P1 and 9th Floor Washrooms)
Bobrick Contura series recessed soap dispenser, model #B-4063, chrome finish
Supplier: Citywide Door & Hardware

E29 - UNDER COUNTER FRIDGE (Prop Management/Bar Area)
Panel ready - 24" under counter fridge. Marvel ML24BRF3LP, handing as per elevation.
Supplier: Appliance Canada

E30 - ELEC FIREPLACE (Lobby)
Dimplex IgniteXL XLF100

DO NOT SCALE DRAWINGS.

CONTRACTOR MUST VERIFY ALL DRAWINGS, DIMENSIONS, DETAILS AND SPECIFICATIONS, AND REPORT ANY DISCREPANCIES TO *UNION 31 INC.* BEFORE PROCEEDING WITH WORK. MATERIALS MAY NOT BE SUBSTITUTED WITHOUT WRITTEN APPROVAL FROM *UNION 31 INC.*

ALL DRAWINGS AND SPECIFICATIONS ARE INSTRUMENTS OF SERVICE AND THE PROPERTY OF *UNION 31 INC.* WHICH MUST BE RETURNED AT THE COMPLETION OF THE WORK.

PRINTED: 30-May-17

ISSUED FOR AS-BUILT

NO.	DATE	COMMENTS	INI
01	31 MAY / 17	ISSUED FOR AS-BUILT	SV

REVISIONS:

UNION31

UNION31 INC.
183 BATHURST STREET, STE 201
TORONTO, ON, M5T 2R7, CANADA
TEL: 416-597-1576 FAX: 416-597-2139

PROJECT NAME:
ALEXANDRA PARK
MAIN BUILDING
BLOCK 11
ON, Canada

PROJECT NO.: 13-949

DRAWING/S:
FINISHES SCHEDULE
PLUMBING & EQUIPMENT SCHEDULE

DATE STARTED:	07 AUG / 13
SCALE:	NTS
DRAWN BY:	AP
APPROVED BY:	KC

DRAWING NO.: ID 0.0.1

28 x 48

DOOR SCHEDULE

Where Applicable:

- All doors, frames, and hardware are Designer's suggestions only. Specifications are to be confirmed by the Architect and door supplier in accordance with all applicable building codes.

TYPICAL

S01 **(Suite Entry)**
2135mm high solid core slab wood door for paint finish, hardware to be signature series, Detroit, satin chrome finish, complete with mortise lock assembly to match, provide standard peep hole, hinges, spring hinge, all in satin chrome finish, door frame to be rediframe metal door framing complete with 90 minute fire rating, suite casing as per developers specification on unit side, refer to elevation for corridor side.

**GF, 2F, and 13F will have 2440mm high suite entry door height to match interior suite doors.
Supplier: **Citywide Door and hardware**
Tony Bancheri
(905) 264-4401

(Typical floors - electrical closet door, mechanical doors, refuse doors)
2135mm high hollow core metal doors as per architects specifications, for paint finish as per wall finishes plan, hardware to be Schlage Architectural hardware, lever style pulls, S Series model Jupiter, IN #626 finish (satin chrome), provide hinges, self closer all in satin chrome finish.

**GF, 2F, and 13F will have 2440mm high door height to match suite entry doors.
Supplier: **Citywide Door & Hardware**

(Typical Exit Stairs)
2135mm high hollow core metal doors as per architects specifications, for paint finish as per wall finishes plan, hardware to be Schlage Architectural hardware, lever style pulls, S Series model Jupiter, IN #626 finish (satin chrome), provide hinges, self closer all in satin chrome finish.

**GF, 2F, and 13F will have 2440mm high door height to match suite entry doors.
Supplier: **Citywide Door & Hardware**

PARKING LEVEL 2

P201.1, P201.3 ***(P2 Elevator Lobby)***
2135mm high aluminium door, complete with vision glass as per architect's specifications, for paint finish as per curtain wall finish, hardware to be Schlage Architectural Hardware, lever style pulls, S series model Jupiter, In#626 (satin chrome), provide hinges self closer all in satin chrome finish.
Supplier: **Citywide Door and Hardware**

P201.2 ***(Elevator Lobby to Vestibule)***
2135mm high 90 min rated hollow core metal door, complete with vision lite as per architect's specifications, for paint finish as per wall finishes plan, hardware to be Schlage Architectural Hardware, lever style pulls, S series model Jupiter, In#626 (satin chrome), provide hinges self closer all in satin chrome finish. Electronic strike TBD as per architects specification.
Supplier: **Citywide Door and Hardware**

PARKING LEVEL 1

P110.2, P101 ***(P1 Lobby Vestibules)***
2135mm high aluminium door, complete with vision glass as per architect's specifications, for paint finish as per curtain wall finish (TBD), hardware to be Schlage Architectural Hardware, lever style pulls, S series model Jupiter, In#626 (satin chrome), provide hinges self closer all in satin chrome finish.
Supplier: **Citywide Door and Hardware**

P110.1, P130 ***(Elevator Lobby to Vestibule)***
2135mm high 90 min rated hollow core metal door, complete with vision lite as per architect's specifications, for paint finish as per wall finishes plan, hardware to be Schlage Architectural Hardware, lever style pulls, S series model Jupiter, In#626 (satin chrome), provide hinges self closer all in satin chrome finish. Electronic strike TBD as per architects specification.
Supplier: **Citywide Door and Hardware**

P117 ***(Staff Room)***
2135mm high 90 min rated hollow core metal door, complete with vision lite and sidelight as per architect's specifications, for paint finish as per wall finishes plan, hardware to be Schlage Architectural Hardware, lever style pulls, S series model Jupiter, In#626 (satin chrome), provide hinges self closer all in satin chrome finish. Electronic strike TBD as per architects specification.
Supplier: **Citywide Door and Hardware**

GROUND FLOOR

131.1 **CORRIDOR A TO EXTERIOR**
2185mm high, as per architect's specifications.

133 **CORRIDOR B (GARBAGE ACCESS)**
2139mm high as per architect's specifications.

138 **MAIL SORTING**
2440mm high custom solid core wood door for wood finish and base as per wall finishes plan and elevations, concealed casing, hardware to be flush hidden door pull, satin chrome finish, provide CRL concealed hold open door closers - concealed in transom, concealed Soss hinges, satin chrome finish. Ensure veneer matches exactly to adjacent wall paneling. Consult with millworker as required. Coordinate locking mechanism with Canada Post guidelines.
Supplier: **Citywide Door and Hardware**

140.1 **Omitted**

140.2 **CORRIDOR B**
2440mm high 45 min rated wood door & hollow metal frame, complete with vision lite as per architect's specifications, for wood veneer finish as per wall finishes plan, hardware to be Schlage Architectural Hardware, lever style pulls, S series model Jupiter, In#626 (satin chrome), provide hinges self closer all in satin chrome finish. Electronic strike TBD as per architects specification.
Supplier: **Citywide Door and Hardware**

141.1 **EAST VESTIBULE INTERIOR SIDE**
Double glazed bi parting doors as per architect's specifications, hardware to be by Canadian builders Hardware.
Supplier: **Toro Aluminum**

141.2 **EAST VESTIBULE TO EXTERIOR**
Double glazed automatic bi parting breakaway storefront door with sidelights as per architects specification.
Supplier: **Toro Aluminum**

142.1 **RESIDENTIAL LOBBY**
2745mm high double glazed doors, as per architect's specifications, c/w exit hardware, electronic operator.
Supplier: **Citywide Door and Hardware**

142.2 **WEST VESTIBULE**
2745mm high frameless double glazed doors, as per architect's specifications, c/w exit hardware, electronic operator. Electronic strike as per architects specification.
Supplier: **Citywide Door and Hardware**

143A **FITNESS ROOM VFCU ACCESS DOOR**
2440mm high wood door , type L with louver, HM frame, hardware to be Schlage Architectural Hardware, lever style pulls, S series model Jupiter, #626 (satin chrome), as per architects specification, finish as per wall finishes plan.
Supplier: **Citywide Door and Hardware**

143B **FITNESS ROOM VFCU ACCESS**
2440mm high custom millwork vertical fan coil unit access door with louver, HM frame, hardware to be Schlage Architectural Hardware, lever style pulls, S series model Jupiter, #626 (satin chrome), as per architects specification, Finish as per wall finishes plan. Refer to detail # 4/ID2.4.1

Supplier: **Citywide Door and Hardware**

143C **FITNESS ROOM VFCU ACCESS**
2440mm high custom millwork vertical fan coil unit access door with louver, HM frame, hardware to be Schlage Architectural Hardware, lever style pulls, S series model Jupiter, #626 (satin chrome), as per architects specification, Finish as per wall finishes plan. Refer to detail # 4/ID2.4.1
Supplier: **Citywide Door and Hardware**

144 **VESTIBULE**
2440mm high 90 min rated hollow metal door & frame, type A with no vision, for paint finish as per wall finishes plan, hardware to be Schlage Architectural Hardware, lever style pulls, S series model Jupiter, In#626 (satin chrome), provide hinges, and concealed self closer all in satin chrome finish.
Supplier: **Citywide Door and Hardware**

145.2 **RESIDENTIAL BIKE STORAGE**
2440 mm high 45 min rated hollow core metal door, complete with vision lite as per architect's specifications, for paint finish as per wall finishes plan, hardware to be Schlage Architectural Hardware, lever style pulls, S series model Jupiter, In#626 (satin chrome), provide hinges self closer all in satin chrome finish. Electronic strike TBD as per architects specification.
Supplier: **Citywide Door and Hardware**

146 **MEN'S CHANGEROOM VESTIBULE**
2440mm high solid core wood door for wood veneer finish as per wall finishes plan, hardware to be Elmes full length pull #G999-01-130 P1925 (1830mm L) both sides, provide concealed self closer, strike plate, hinges satin chrome finish.
Supplier: **Citywide door & hardware**

146A **MEN'S CHANGEROOM VESTIBULE**
Same as 146.

146B **MEN'S CHANGEROOM STEAM ROOM**
2440mm high frameless frosted glass door with weather stripping.
Refer to architects specification.

147 **MEN'S CHANGEROOM WC**
2440mm high solid core wood door for wood finish as per wall finishes plan, hardware to be Elmes full length pull #G999-01-130-P1925 (1830mm L), provide self closer, strike plate, hinges, privacy set (inside only), satin chrome finish, refer to elevation.
Supplier: **Citywide door & hardware**

148 **MEN'S WC BF**
2440mm high solid core wood door for wood finish as per wall finishes plan, hardware to be Elmes full length pull #G999-01-130-P1925 (1830mm L), provide self closer, strike plate, hinges, privacy set (inside only), satin chrome finish, refer to elevation.

149.1 **MENS CHANGEROOM TO WHIRLPOOL SPA**
2440mm high frameless frosted glazed door, thickness as required, tempered as required, hardware to be Elmes full length pull, #G999-01-130 P1925, (1830mm L), to match elevation, back to back installation, provide patch fittings, pivot hinges all in satin chrome finish, rubber stripping to be used as required.
Contact: **Toro Aluminum**

149.2 **WOMEN'S CHANGEROOM TO WHIRLPOOL SPA**
2440mm high frameless frosted glazed door, thickness as required, tempered as required, hardware to be Elmes full length pull, #G999-01-130 P1925, (1830mm L), to match elevation, back to back installation, provide patch fittings, pivot hinges all in satin chrome finish, rubber stripping to be used as required.
Contact: **Toro Aluminum**

150 **JANITOR CLOSET IN WOMEN'S CHANGEROOM**
2440mm high hollow core metal door for paint finish as per wall finishes plan, hardware to be lever style handles by Schlage, AL-Series Jupiter, satin chrome finish, provide self closer, strike plate, hinges, satin chrome finish.

151 **WOMEN'S CHANGEROOM VESTIBULE**
2440mm high solid core wood door for wood veneer finish as per wall finishes plan, hardware to be Elmes full length pull #G999-01-130 P1925 (1830mm L) both sides, provide concealed self closer, strike plate, hinges satin chrome finish.
Supplier: **Citywide door & hardware**

151B **WOMEN'S CHANGEROOM STEAM ROOM**
2440mm high frameless frosted glass door with weather stripping.
Refer to architects specification.

151A **WOMEN'S CHANGEROOM VESTIBULE**
Same as 151

152 **WOMEN'S CHANGEROOM WC**
2440mm high solid core wood door for wood finish as per wall finishes plan, hardware to be Elmes full length pull #G999-01-130-P1925 (1830mm L), provide self closer, strike plate, hinges, privacy set (inside only), satin chrome finish, refer to elevation.
Supplier: **Citywide door & hardware**

153 **WOMEN'S CHANGEROOM BF WC**
2440mm high solid core wood door for wood finish as per wall finishes plan, hardware to be Elmes full length pull #G999-01-130-P1925 (1830mm L), provide self closer, strike plate, hinges, privacy set (inside only), satin chrome finish, refer to elevation.
Supplier: **Citywide door & hardware**

154 **CORRIDOR D TO FITNESS AREA**
2700mm high frameless double clear glazed door, thickness as req'd, tempered as req'd, hardware to be lever style handles by Schlage, s-series Jupitor, satin chrome finish, lockset, provide concealed self closer, strike plate, power assist HA-8, Concealed automatic operator, refer to elevations.
Supplier: **Toro Aluminum**

156 **BARRIER FREE WC**
2440mm high solid core wood door for wood finish as per wall finishes plan, hardware to be Elmes full length pull #G999-01-130-P1925 (1830mm L) (corridor side only), provide self closer, strike plate, hinges, privacy set (inside only), satin chrome finish, refer to elevation.
Supplier: **Citywide door & hardware**

157 **BARRIER FREE WC**
2440mm high solid core wood door for wood finish as per wall finishes plan, hardware to be Elmes full length pull #G999-01-130-P1925 (1830mm L) (corridor side only), provide self closer, strike plate, hinges, privacy set (inside only), satin chrome finish, refer to elevation.
Supplier: **Citywide door & hardware**

158 **THEATRE**
2440 mm high solid core wood door complete with flush concealed Soss hinges and provide concealed self closer, strike plate hardware to be Elmes full length pull # G999-01-130 P1925 (2135mm L), both sides, refer to elevation.
Supplier: **Citywide door & hardware**

158A **THEATRE VFCU PANEL**
2440mm high custom millwork vertical fan coil unit access frameless door panel with louver on piano hinges. Clip system to be similar to spec or a suitable alternate: Button Fix 2 supplied by Lee Valley. Finish as per wall finishes plan. Refer to detail # 4/ID2.4.1
Supplier: **Millworker**

158C **THEATRE EQUIPMENT ROOM**
2440mm high solid core wood door for paint finish as per wall finishes plan, hardware to be lever style handles by Schlage, s-series Jupiter, satin chrome finish, lockset, provide self closer, strike plate, hinges, satin chrome finish.
Supplier: **Citywide door & hardware**

159 **CORRIDOR D ELECTRICAL CLOSET**
2440mm high 90 min rated wood door for wood finish per wall finishes plan, hardware to be lever style handles by Schlage, s-series Jupitor, satin chrome finish, lockset, provide self closer, strike plate, hinges, satin chrome finish. Install flush with corridor walls.
Supplier: **Citywide door & hardware**

160.1 **CORRIDOR C TO CORRIDOR A**
2440mm high 45 min rated wood door & hollow metal frame, complete with vision lite as per architect's specifications, for wood veneer finish as per wall finishes plan, hardware to be Schlage Architectural Hardware, lever style pulls, S series model Jupiter, In#626 (satin chrome), provide hinges self closer all in satin chrome finish. Electronic strike TBD as per architects specification..
Supplier: **Citywide Door and Hardware**

160.2 **PARTY ROOM AMENITY ENTRANCE**
2700mm high Type H frameless clear glazed pivot door with side lite, thickness as req'd, tempered as req'd, hardware to be lever style handles by Schlage, s-series Jupitor, satin chrome finish, lockset, provide concealed self closer, strike plate, power assist, refer to elevations. Concealed strike in header. Glazing film by designer.
Supplier: **Toro Aluminum**

161.1 **CORRIDOR TO DINING ROOM**
2440mm high solid core wood door for wood #1, hardware to be Elmes full length pull # G999-01-130 P1925 (1830mm L), both sides, satin chrome finish, provide concealed self closer, strike plate, hinges, satin chrome finish with no vision type A
Supplier: **Citywide door & hardware**

161.2 **KITCHEN TO DINING ROOM**
2440mm high solid core wood door for wood #1, hardware to be Elmes full length pull # G999-01-130 P1925 (1830mm L), both sides, satin chrome finish, provide concealed self closer, strike plate, hinges, satin chrome finish with no vision type A

161A **DINING ROOM VFCU PANEL**
2440mm high custom millwork vertical fan coil unit access frameless door panel with louver on piano hinges. Clip system to be similar to spec or a suitable alternate: Button Fix 2 supplied by Lee Valley. Finish as per wall finishes plan. Refer to detail # 4/ID2.4.1
Supplier: **Millworker**

162 **AMENITY KITCHENETTE**
2440mm high solid core wood door for wood #1, hardware to be Elmes full length pull # G999-01-130 P1925 (1830mm L), both sides, satin chrome finish, provide concealed self closer, strike plate, hinges, satin chrome finish
Supplier: **Citywide door & hardware**

162A **AMENITY KITCHENETTE VFCU**
2440mm high wood door & frame, type T with louver, as per architects specification finish as per wall finishes plan.
Supplier: **Citywide Door and Hardware**

163 **AMENITY - PARTY ROOM EXIT TO TERRACE**
2675 mm high, as per architectural specification.

163A **AMENITY PARTY ROOM VFCU**
2440mm high wood door & frame, type T with louver, as per architects specification finish as per wall finishes plan.
Supplier: **Citywide Door and Hardware**

163B **AMENITY PARTY CLOSET**
2 X 2440mm high wood doors by millworker to match cabinetry in party room bar.
Supplier: **Citywide Door and Hardware**

164 **PROPERTY MANAGEMENT OFFICE**
2440mm high frameless clear glazed door, thickness as req'd, tempered as req'd, privacy film to be applied to glass- design to be determined by designer, hardware to be lever style handles by Schlage, s-series Jupitor, satin chrome finish, lockset, provide concealed self closer, strike plate, dull chrome finish, refer to elevations.
Supplier: **Toro Aluminum**

166.1 **MANAGEMENT OFFICE**
2440mm solid core wood door for paint finish as per wall finishes plan, hardware to be lever style handles by Schlage, s-series Jupitor, satin chrome finish, lockset with privacy from inside, provide self closer, strike plate, hinges, satin chrome finish, refer to elevation.
Supplier: **Citywide door & hardware**

166.2 **MANAGEMENT OFFICE MECH. CL.**
2440mm high hollow core metal door for paint finish as per wall finishes plan, hardware to be lever style handles by Schlage, s-series Jupitor, dull chrome finish, lockset, provide self closer, strike plate, hinges, satin chrome finish.
Supplier: **Citywide door & hardware**

167 **KITCHEN / COPY**
2440mm solid core wood door for paint finish as per wall finishes plan, hardware to be lever style handles by Schlage, s-series Jupitor, satin chrome finish, lockset, provide self closer, strike plate, hinges, satin chrome finish, refer to elevation.
Supplier: **Citywide door & hardware**

167.1 **KITCHEN/COPY ROOM VFCU ACCESS**
2440mm solid core wood door for paint finish as per wall finishes plan, hardware to be lever style handles by Schlage, s-series Jupitor, satin chrome finish, lockset, provide strike plate, hinges, satin chrome finish, refer to elevation.
Supplier: **Citywide door & hardware**

168 **CACF ROOM**
2440mm high 180 degree opening 90min rated solid core slab wood pivot door for wood#2, HW frame, wood to be treated for fire rating, hardware to be Schlage Architectural hardware, lever style pulls, S Series model Jupiter, IN #626 finish (satin chrome), provide concealed Soss hinges, provide self-closer all in satin chrome finish, refer to elevations
Supplier: **Citywide door & hardware**

169 **PARCEL ROOM**
2440 mm high solid core slab wood door for wood#2, HM frame, wood to be treated for fire rating, hardware to be Schlage Architectural hardware, lever style pulls, S Series model Jupiter, IN #626 finish (satin chrome), provide concealed Soss hinges, self closer all in satin chrome finish, electronic strike TBD as per architects specifications, refer to elevations
Supplier: **Citywide door & hardware**

172.2 **GROUND FLOOR RESIDENTIAL GARBAGE**
2440mm high 90 min rated hollow core metal door for paint finish as per wall finishes plan, hardware to be lever style handles by Schlage, s-series Jupitor, dull chrome finish, provide self closer, strike plate, hinges, satin chrome finish.
Supplier: **Citywide door & hardware**

173.1 **RESIDENTIAL MOVING**
2440mm high 45 min rated hollow core metal door for paint finish as per wall finishes plan, hardware to be lever style handles by Schlage, s-series Jupitor, dull chrome finish, provide self closer, strike plate, hinges, satin chrome finish.
Supplier: **Citywide door & hardware**

935 **9th FLOOR BF WC**
2135mm high solid core wood door for paint finish as per wall finishes plan, hardware to be Elmes full length pull #G999-01-130-P1925 (1830mm L), provide self closer, strike plate, hinges, privacy set (inside only), satin chrome finish, refer to elevation.
Supplier: **Citywide door & hardware**

LIGHTING AND ELECTRICAL LEGEND

A — **TYPE A** ***(Throughout)***
Recessed rectangular directional down light fixture
Eurofase- 1LT Trimless Multiple Recessed LED w/ driver
Size: 4" x 4"
Lamp: 3 x 9w LED, warm white 3000k
Finish: White
Specification: # TE211LED-02
Suitable housing as required. Plaster kit as required.
Refer to RCP for location.

Supplier: Litemode
Contact:

A2 — **TYPE A2** ***(Throughout)***
Recessed rectangular directional downlight fixture
Eurofase- 2LT Trimless Multiple Recessed LED w/ driver
Size: 8.5" x 4"
Lamp: 6 x 9w LED, warm white 3000k
Finish: White
Specification: #TE212LED-02
Suitable housing as required. Plaster kit as required.
Refer to RCP for location.

Supplier: Litemode

A3 — **TYPE A3** ***(Throughout)***
Multiple trimless LED recessed
Eurofase- 3 Light Trimless Multiple Recessed LED w/ driver
Size: 12-1/16"x4"w x 5-3/16"h
Lamp: 9 x 9w LED Osram
Finish: White
Specification: #TE213LED
Suitable housing as required. Plaster kit as required.
Refer to RCP for location.

Supplier: Litemode

A4 — **TYPE A4** ***(Fitness Area)***
Recessed Rectangular directional downlight fixture
Eurofase 4-light trimlessss Multiple Recessed LED w/ driver
Size: 18.5" x 6.5" x6"h
Lamp: 4x9w LED Osram
Finish: 01 Black/Black
Specification: TE114ALED
Suitable housing as required. Refer to RCP for location.

A5 — **TYPE A5** ***(Management Office, Management Kitchen/ Copy Room)***
Indy 2x2 Led Low-profile Recessed Luminarie with Basket Diffuser
Size: 23.75" x 23.75" x4"h
3000K Watt LED light
Finish: White
Specification: S2X2BL-3930U-WH3
Refer to RCP for location.

B — **TYPE B** ***(Lobby, Beside Fireplace)***
Pendant
Vibia Slim one light pendant
Size: 39.25"l x 1"dia x 6-1/4" canopy
Lamp: 1x3w LED
Finish: Black
Specification: Slim 0920
Suitable housing as required.
Refer to RCP for location.

C — **TYPE C** ***(Lobby Lounge)***
Concentric ring chandelier
Paul Loebach Halo Chandelier - 3 Rings
Roll and Hill
42" dia x 34" h
12 Week Lead Time**
Complete with Rigid aluminum channel with frosted polycarbonate diffuser.
Corner connectors as required. Length per RCP/Elevation (field cuttable)
Supplier: WAC lighting

D — **TYPE D** ***(Throughout)***
Same as Type A, to be aimed and adjusted on site with designer.

E — **TYPE E** ***(Cove Lighting Throughout)***
InvisiLED Pro 2 High Output Tape Light LED-TX24X0-5-WT
4w per foot, 90 CRI
Complete with Rigid aluminum channel with frosted polycarbonate diffuser.
Corner connectors as required. Length per RCP/Elevation (field cuttable)
Supplier: WAC lighting

F — **TYPE F** ***(Amenity, Bar)***
Pendant fixture
Vibia Rhythm 2113-14 by Arik Levy
40x 8W LED Strip, 116W total
Fin: 14 (Black)
Supplier: Lightform

G — **TYPE G** ***(Throughout, Millwork)***
Under cabinet light
Feelux Slimlamp LED w flat milky lens
Model #LSL1530
15W, 3000K
c/w SL-Bracket, connectors and power supply as required.
Refer to RCP and elevations for lengths.
Supplier: Lightform

H — **TYPE H** **(Dining Room Wall Niches)**
Pendant Light
Delightfull Brubeck pendant light.
Finish to match type H
Refer to RCP and elevations for qty and location.
Supplier: Studio 1112

J — **TYPE J** ***(Dining Room)***
Pendant light
Delightfull Coltrane Suspension Light. Black Matte exterior, Gold powder interior. 2x G9 Halogen Bulbs per tube (Confirm compatible LED replacement). Cord length TBD on site. 1000mm L x 80mm Dia
Qty per RCP/Elevation.
Supplier: Studio1112

K — **TYPE K** **(Fitness Area, Millwork)**
Recessed Adjustable Downlight
Eurofase TE111LED
01 Black/Black Trim
1x9W LED
Refer to RCP for location.
Supplier: Litemode

L — **TYPE L** **(Spa)**
Recessed Shower Light
Contrast lighting A2450S
Size: 4" dia
Lamp: 1 x26w compact fluorescent
Finish: shower trim with frosted lens, brushed nickel
Refer to RCP for qty and location.
Supplier: Studio1112

M — **TYPE M** **(Barrier Free Washroom - grd and 9th floor)**
Surface Mounted Light
Eureka Lap 3151
Size: 18"L
Lamp: 5W LED, 3000K,
Chrome structure, matte white diffuser
Refer to RCP for qty and location.
Supplier: Studio1112

N — **TYPE N**
N/A

P — **TYPE P** **(Showers)**
Element 3 Inch Adjustable downlight
E3R- 3 in Round, Flanged Bevel Shower trim.
Finish: White
Supplier: Litemode

Q — **TYPE Q** **(Theatre)**
Wall Sconce
Slickbulb Vertical Sconce
4'-0" length
Walnut/Blackened Steel
3000K Watt LED light
Refer to RCP and Elevations for location.
Supplier: Studio1112

R — **TYPE R** **(Suite Entry)**
Wall Sconce
Eurofase Apt 2-Light Wall Sconce
Matt Black finish for body with clear acrylic for shade
2x1W LED light
Refer to RCP and Elevations for location.
Supplier: Litemode

S — **TYPE S** **(Typical Corridors)**
Surface Mounted Fixture
Eureka Spin 3036-WH
LED.22.30.DP, 3000k 22W
Supplier: Litemode

T — **TYPE T** **(Party Room - TV unit)**
Low Profile Recessed Display Light
MP Lighting, L64
2.5W, 3000K, narrow flood
Black anodized alum.
Supplier: Studio1112

U — **TYPE U** **(Parking Levels)**
Eurofase
TE111LED-22 Finish: Black ; Shade: White
9W LED, 3000k
Refer to RCP for locations.
Supplier: Litemode

V — **TYPE V** **(Lobby, Between Wood Fins)**
Eurofase Beam-SW, 10ft LED EXTRUSION, Black
EF-APC353S-LED BLK
88W LED, 3000k
1.38" W x 10 'Length as per RCP - to align with wood fins.
Refer to RCP for locations.
Supplier: Litemode

W — **TYPE W** **(Elevator Lobby)**
Eurofase Inground 3X1W LED
Floor Mounted Accent Lighting
23816-015
Stainless Steel trim, flush mounted
3x 1w LED 3000K
Refer to RCP for locations.
Supplier: Eurolite

X — **TYPE X** **(Lobby- over concierge desk)**
Pendant Light
Eurofase
Black carbon fiber for hanging lights
and ceiling plate
7x 3w LED , 3000K
Refer to RCP for locations.
Supplier: Litemode

Y — **TYPE Y** **(Property Management Office and Concierge Task Lamps)**
Table Lamp- Task
Modern Forms, Boxie TL-1210
Black finish
12WLED , 3000K, dimmable
Refer to Furniture plan for locations.
Supplier: Studio 1112

Z — **TYPE Z** **(P1 Level Vestibule)**
Surface mounted fixture, Eurofase, Avon Large square LED, satin nickel finish.
19.5WLED , 3000K
Refer to Furniture plan for locations.
Supplier: Studio 1112

Z1 — **TYPE Z1** **(8th Floor Corridor)**
Liteline
SLM6S SLIMLED
6" Square LED Slim Profile Recess Retrofit 12W, Airtight
Brushed nickel finish.
12WLED , 3000K
Refer to Furniture plan for locations.
Supplier: Studio 1112

Duplex receptacle outlet (for specialty usage in addition to Electrical Drawings)

FLR — Floor mounted duplex receptacle outlet (for specialty usage in addition to Electrical Drawings)

Communication for voice (phone) outlet (for specialty usage in addition to Electrical Drawings)

Communication for fax outlet (for specialty usage in addition to Electrical Drawings)

Communication for data (internet) outlet (for specialty usage in addition to Electrical Drawings)

Powerline as noted (for specialty usage in addition to Electrical Drawings)

TV — Cable / satellite TV outlet

DO NOT SCALE DRAWINGS.

CONTRACTOR MUST VERIFY ALL DRAWINGS, DIMENSIONS, DETAILS AND SPECIFICATIONS, AND REPORT ANY DISCREPANCIES TO *UNION 31 INC.* BEFORE PROCEEDING WITH WORK. MATERIALS MAY NOT BE SUBSTITUTED WITHOUT WRITTEN APPROVAL FROM *UNION 31 INC.*

ALL DRAWINGS AND SPECIFICATIONS ARE INSTRUMENTS OF SERVICE AND THE PROPERTY OF *UNION 31 INC.* WHICH MUST BE RETURNED AT THE COMPLETION OF THE WORK.

PRINTED: 30-May-17

ISSUED FOR AS-BUILT

NO.	DATE	COMMENTS	INI
01	31 MAY / 17	ISSUED FOR AS-BUILT	SV

REVISIONS:

UNION31

UNION31 INC.
183 BATHURST STREET, STE 201
TORONTO, ON, M5T 2R7, CANADA
TEL: 416-597-1576 FAX: 416-597-2139

PROJECT NAME:
ALEXANDRA PARK
MAIN BUILDING
BLOCK 11
ON, Canada

PROJECT NO.: 13-949

DRAWING/S:
DOOR SCHEDULE
LIGHTING & ELECTRICAL LEGEND

DATE STARTED: 07 AUG / 13	DRAWING NO.:
SCALE: NTS	ID 0.0.2
DRAWN BY: AP	
APPROVED BY: KC	

36 x 48

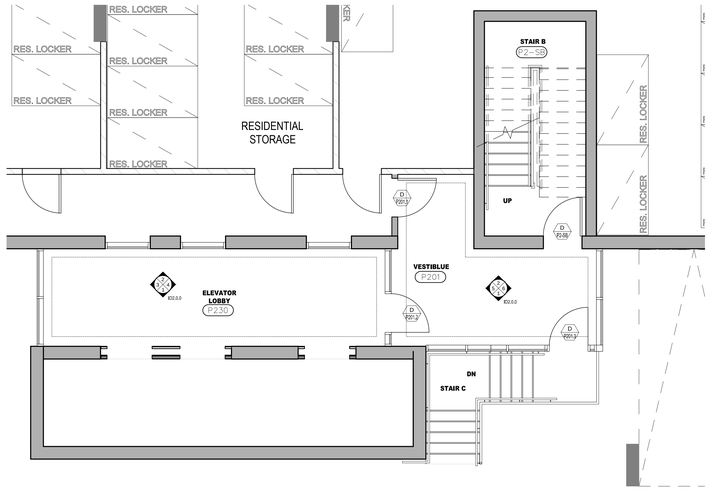

1 ID1.0.0 CONSTRUCTION PLAN
P2 LEVEL
SCALE 1:50

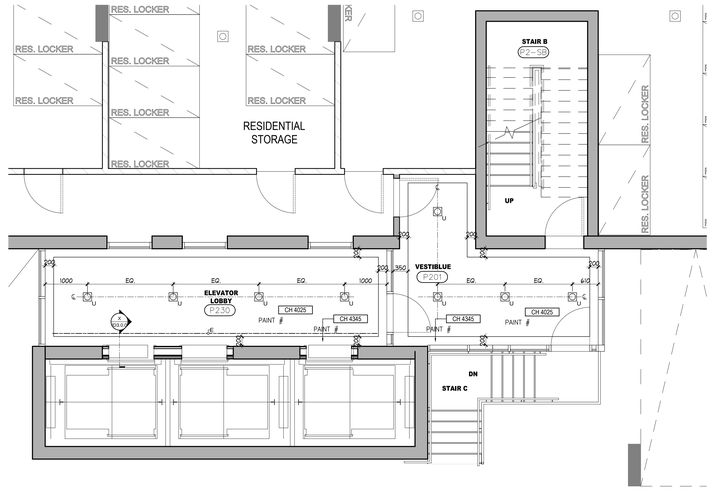

2 ID1.0.0 REFLECTED CEILING PLAN
P2 LEVEL
SCALE 1:50

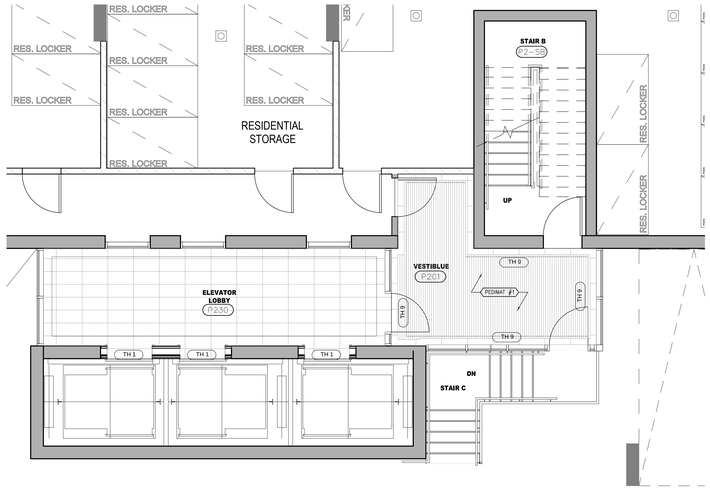

3 ID1.0.0 FLOOR FINISHES PLAN
P2 LEVEL
SCALE 1:50

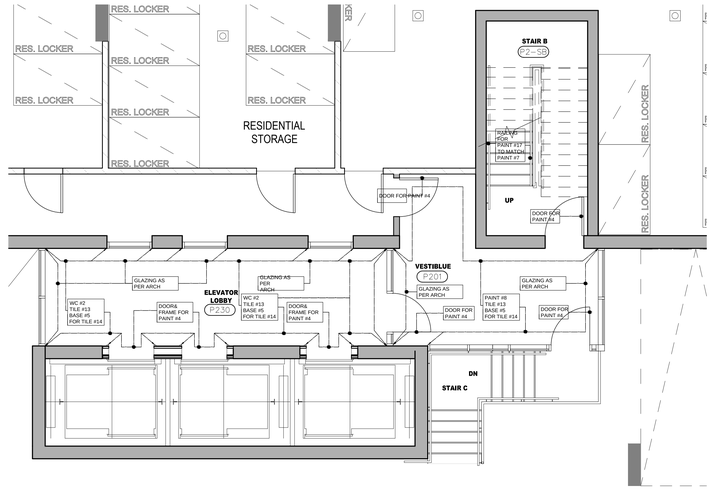

4 ID1.0.0 WALL FINISHES PLAN
P2 LEVEL
SCALE 1:50

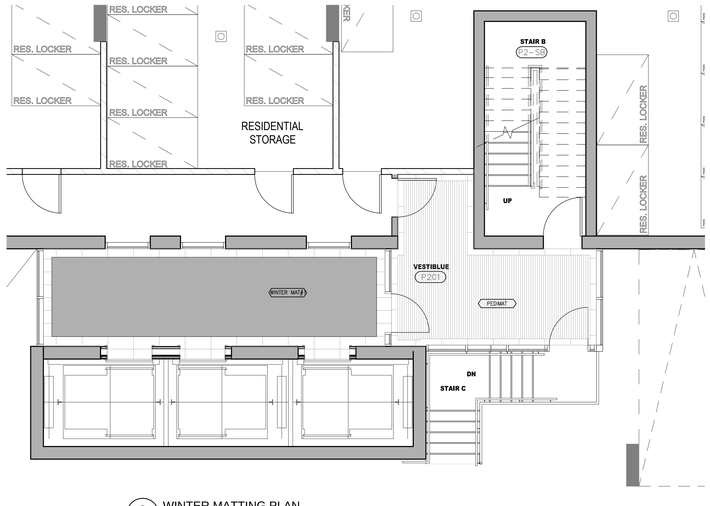

5 ID1.0.0 WINTER MATTING PLAN
P2 LEVEL
SCALE 1:50

DO NOT SCALE DRAWINGS.

CONTRACTOR MUST VERIFY ALL DRAWINGS, DIMENSIONS, DETAILS AND SPECIFICATIONS, AND REPORT ANY DISCREPANCIES TO *UNION 31 INC.* BEFORE PROCEEDING WITH WORK. MATERIALS MAY NOT BE SUBSTITUTED WITHOUT WRITTEN APPROVAL FROM *UNION 31 INC.*

ALL DRAWINGS AND SPECIFICATIONS ARE INSTRUMENTS OF SERVICE AND THE PROPERTY OF *UNION 31 INC.* WHICH MUST BE RETURNED AT THE COMPLETION OF THE WORK.

PRINTED: 30-May-17

ISSUED FOR AS-BUILT

NO.	DATE	COMMENTS	INI
01	31 MAY / 17	ISSUED FOR AS-BUILT	SV

REVISIONS:

UNION31

UNION31 INC.
183 BATHURST STREET, STE 201
TORONTO, ON, M5T 2R7, CANADA
TEL: 416-597-1576 FAX: 416-597-2139

PROJECT NAME:
ALEXANDRA PARK
MAIN BUILDING
BLOCK 11
ON, Canada

PROJECT NO.: 13-949

DRAWING/S:
P 2 LEVEL
CONSTRUCTION PLAN &
REFLECTED CEILING PLAN
FLOOR & WALL FINISHES PLANS

DATE STARTED:	07 AUG / 13	DRAWING NO.:	ID 1.0.0
SCALE:	1 : 50		
DRAWN BY:	AP		
APPROVED BY:	KC		

36 of 48

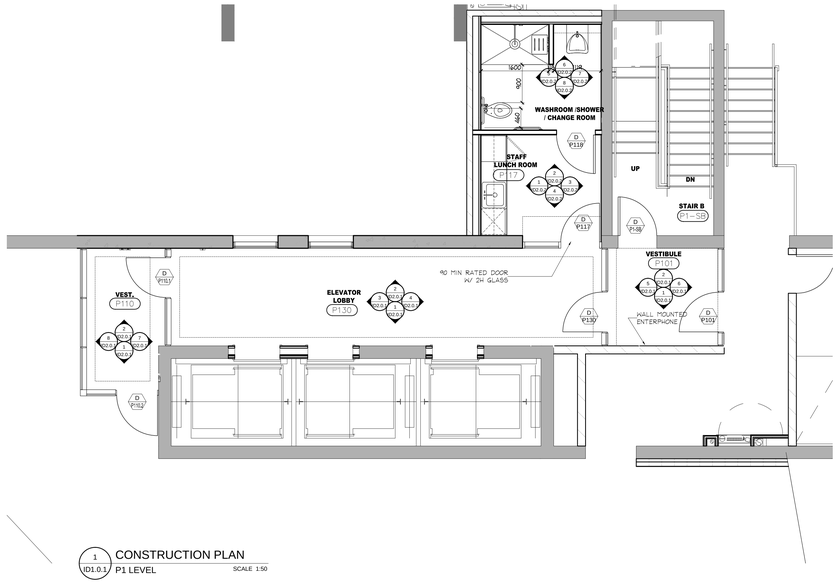

1 CONSTRUCTION PLAN
ID1.0.1 P1 LEVEL SCALE 1:50

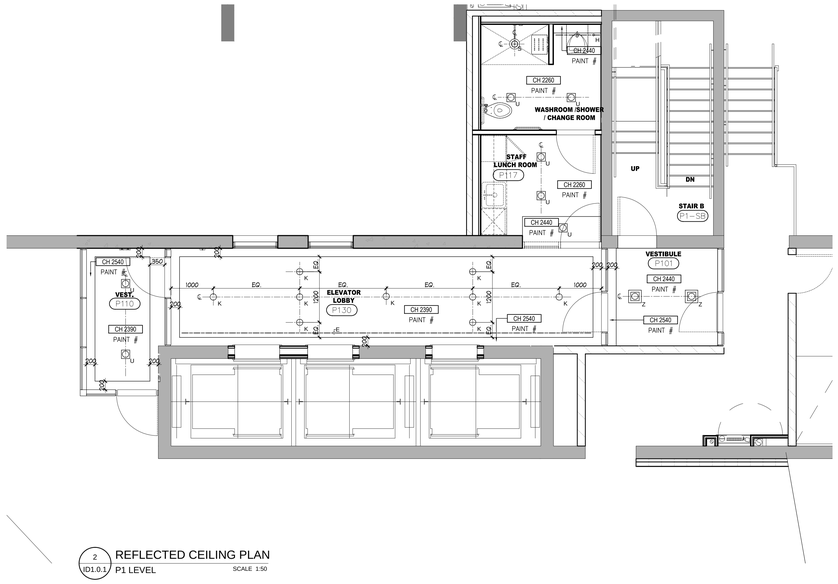

2 REFLECTED CEILING PLAN
ID1.0.1 P1 LEVEL SCALE 1:50

3 POWER & FUNITURE PLAN
ID1.0.1 P1 LEVEL SCALE 1:50

4 FLOOR FINISHES PLAN
ID1.0.1 P1 LEVEL SCALE 1:50

5 WALL FINISHES PLAN
ID1.0.1 P1 LEVEL SCALE 1:50

6 WINTER MATTING PLAN
ID1.0.1 P1 LEVEL SCALE 1:50

DO NOT SCALE DRAWINGS.

CONTRACTOR MUST VERIFY ALL DRAWINGS, DIMENSIONS, DETAILS AND SPECIFICATIONS, AND REPORT ANY DISCREPANCIES TO *UNION 31 INC.* BEFORE PROCEEDING WITH WORK. MATERIALS MAY NOT BE SUBSTITUTED WITHOUT WRITTEN APPROVAL FROM *UNION 31 INC.*

ALL DRAWINGS AND SPECIFICATIONS ARE INSTRUMENTS OF SERVICE AND THE PROPERTY OF *UNION 31 INC.* WHICH MUST BE RETURNED AT THE COMPLETION OF THE WORK.

PRINTED: 30-May-17

ISSUED FOR AS-BUILT

NO.	DATE	COMMENTS	INI
01	31 MAY / 17	ISSUED FOR AS-BUILT	SV

REVISIONS:

UNION31

UNION31 INC.
183 BATHURST STREET, STE 201
TORONTO, ON, M5T 2R7, CANADA
TEL: 416-597-1576 FAX: 416-597-2139

PROJECT NAME:
ALEXANDRA PARK
MAIN BUILDING
BLOCK 11
ON, Canada

PROJECT NO.: 13-949

DRAWING/S:
P 1 LEVEL
CONSTRUCTION PLAN &
REFLECTED CEILING PLAN
FLOOR & WALL FINISHES PLANS

DATE STARTED:	07 AUG / 13
SCALE:	1 : 50
DRAWN BY:	AP
APPROVED BY:	KC

DRAWING NO.: ID 1.0.1

36 x 48

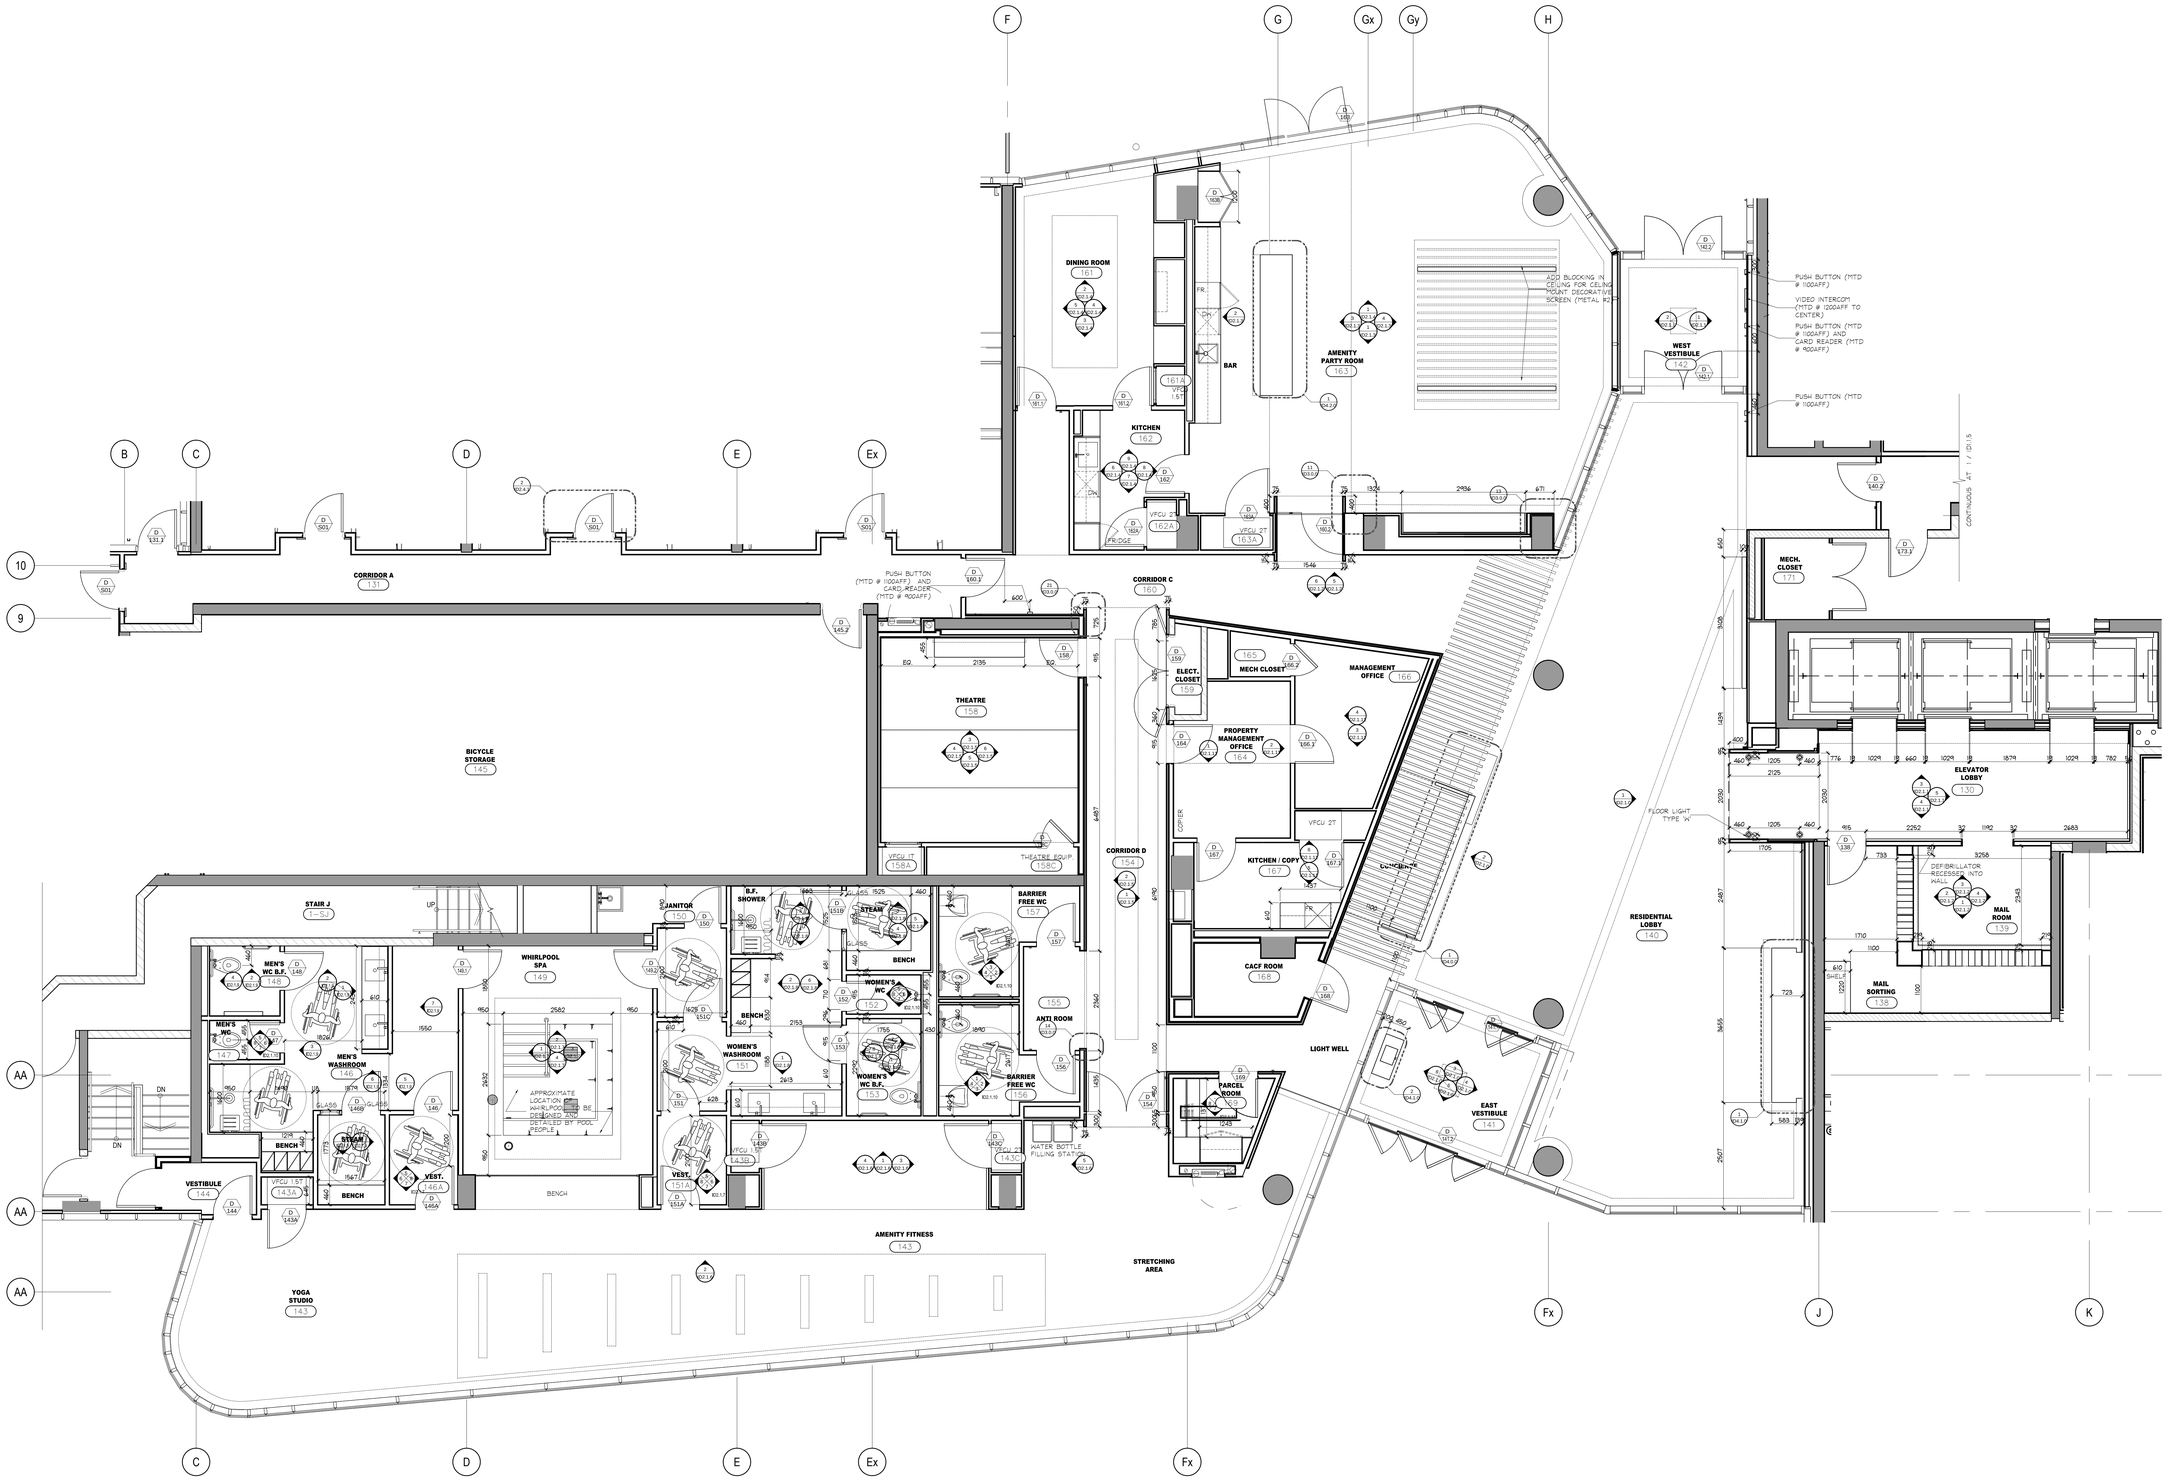

1 / ID1.1.0 CONSTRUCTION PLAN
GROUND FLOOR SCALE 1:50

DO NOT SCALE DRAWINGS.

CONTRACTOR MUST VERIFY ALL DRAWINGS, DIMENSIONS, DETAILS AND SPECIFICATIONS, AND REPORT ANY DISCREPANCIES TO *UNION 31 INC.* BEFORE PROCEEDING WITH WORK. MATERIALS MAY NOT BE SUBSTITUTED WITHOUT WRITTEN APPROVAL FROM *UNION 31 INC.*

ALL DRAWINGS AND SPECIFICATIONS ARE INSTRUMENTS OF SERVICE AND THE PROPERTY OF *UNION 31 INC.* WHICH MUST BE RETURNED AT THE COMPLETION OF THE WORK.

PRINTED: 30-May-17

ISSUED FOR AS-BUILT

NO.	DATE	COMMENTS	INI
01	31 MAY / 17	ISSUED FOR AS-BUILT	SV

REVISIONS:

UNION31

UNION31 INC.
183 BATHURST STREET, STE 201
TORONTO, ON, M5T 2R7, CANADA
TEL: 416-597-1576 FAX: 416-597-2139

PROJECT NAME:
ALEXANDRA PARK
MAIN BUILDING
BLOCK 11
ON, Canada

PROJECT NO.: 13-949

DRAWING/S:
GROUND FLOOR
CONSTRUCTION PLAN

DATE STARTED: 07 AUG / 13	DRAWING NO.:
SCALE: 1 : 50	ID 1.1.0
DRAWN BY: AP	
APPROVED BY: KC	

36 x 48

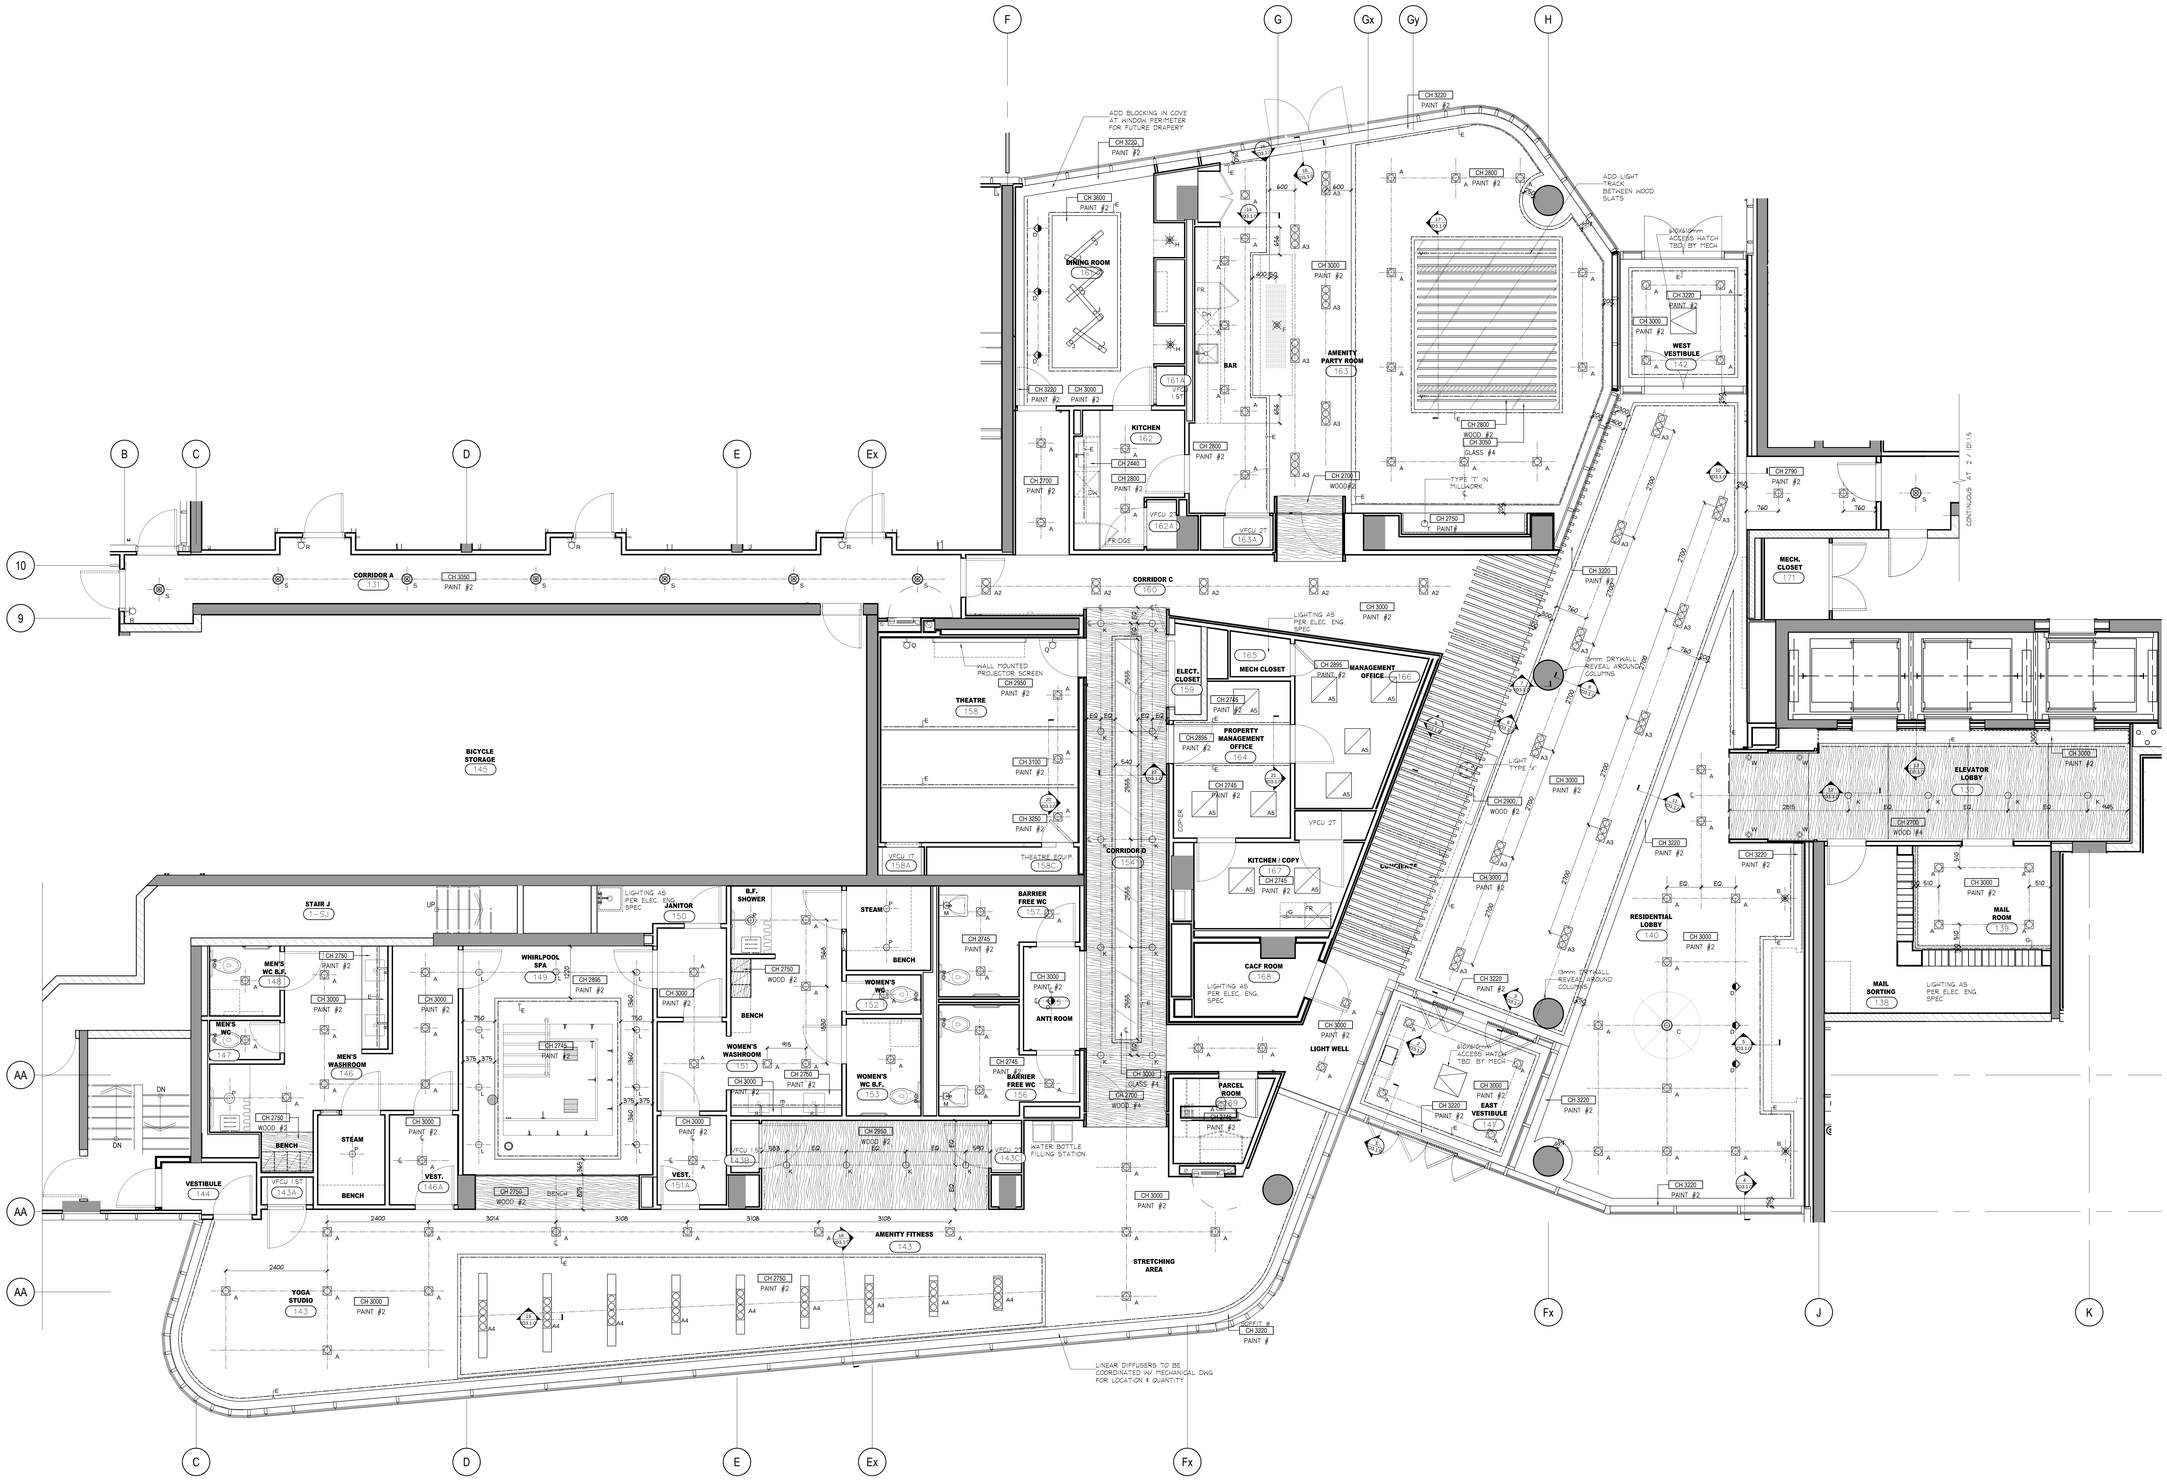

DO NOT SCALE DRAWINGS.

CONTRACTOR MUST VERIFY ALL DRAWINGS, DIMENSIONS, DETAILS AND SPECIFICATIONS, AND REPORT ANY DISCREPANCIES TO *UNION 31 INC.* BEFORE PROCEEDING WITH WORK. MATERIALS MAY NOT BE SUBSTITUTED WITHOUT WRITTEN APPROVAL FROM *UNION 31 INC.*

ALL DRAWINGS AND SPECIFICATIONS ARE INSTRUMENTS OF SERVICE AND THE PROPERTY OF *UNION 31 INC.* WHICH MUST BE RETURNED AT THE COMPLETION OF THE WORK.

PRINTED: 30-May-17

ISSUED FOR AS-BUILT

NO.	DATE	COMMENTS	INI
01	31 MAY / 17	ISSUED FOR AS-BUILT	SV

REVISIONS:

UNION31

UNION31 INC.
183 BATHURST STREET, STE 201
TORONTO, ON, M5T 2R7, CANADA
TEL: 416-597-1576 FAX: 416-597-2139

PROJECT NAME:
ALEXANDRA PARK
MAIN BUILDING
BLOCK 11
ON, Canada

PROJECT NO.: 13-949

DRAWING/S:
GROUND FLOOR
REFLECTED CEILING PLAN

DATE STARTED: 07 AUG / 13	DRAWING NO.:
SCALE: 1 : 50	ID 1.1.1
DRAWN BY: AP	
APPROVED BY: KC	

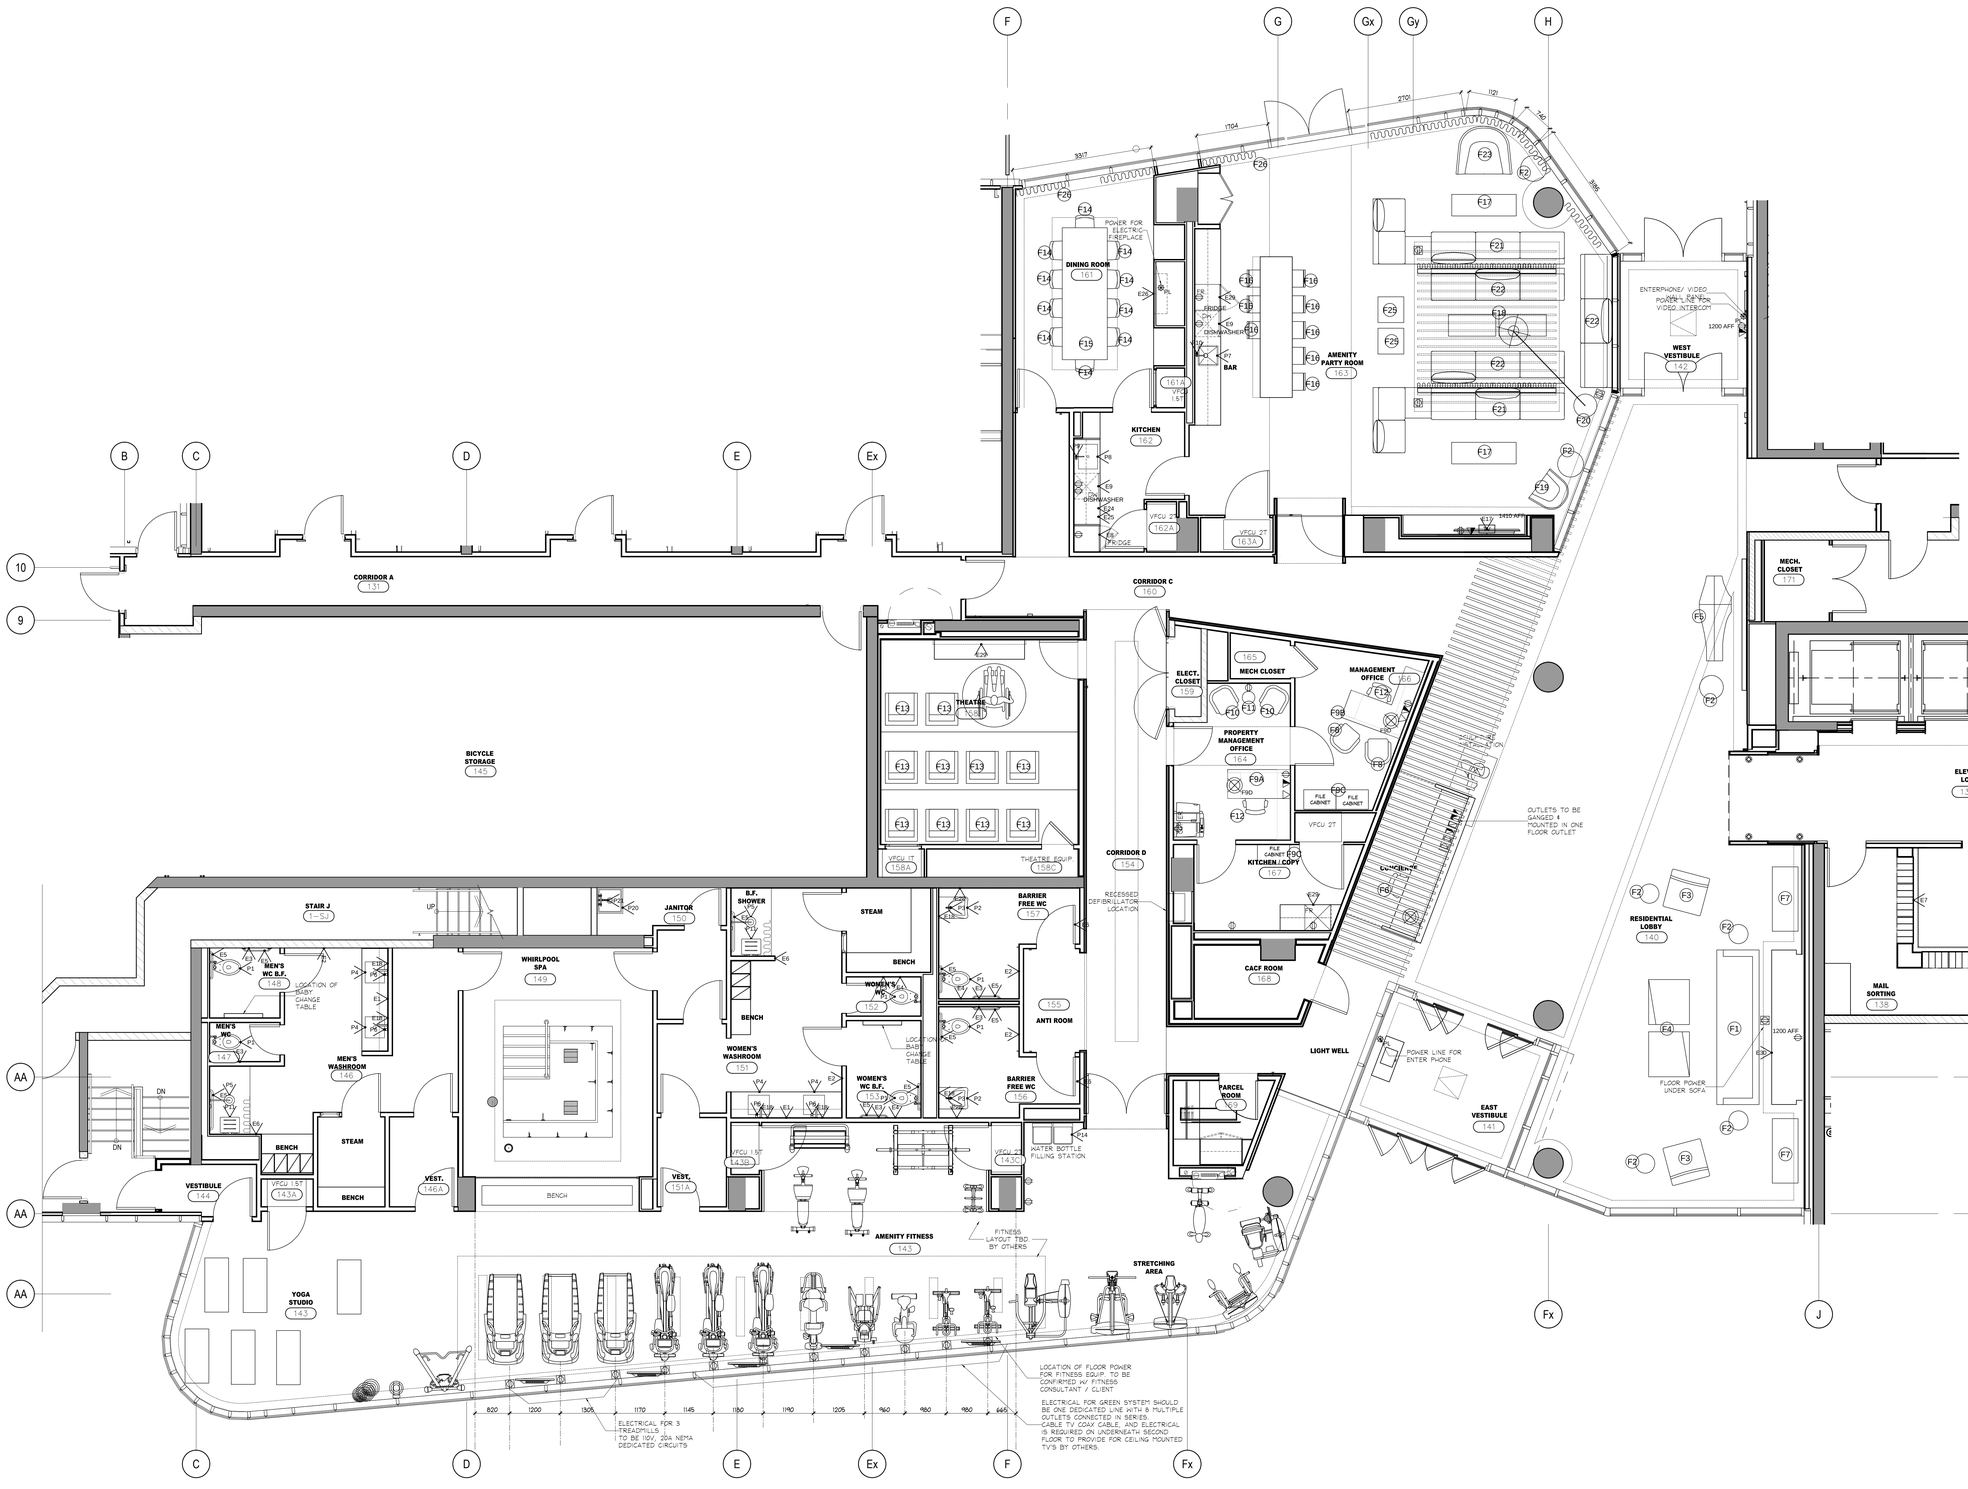

1 / ID1.1.2 FURNITURE & POWER PLAN
GROUND FLOOR SCALE 1:50

DO NOT SCALE DRAWINGS.

CONTRACTOR MUST VERIFY ALL DRAWINGS, DIMENSIONS, DETAILS AND SPECIFICATIONS, AND REPORT ANY DISCREPANCIES TO *UNION 31 INC.* BEFORE PROCEEDING WITH WORK. MATERIALS MAY NOT BE SUBSTITUTED WITHOUT WRITTEN APPROVAL FROM *UNION 31 INC.*

ALL DRAWINGS AND SPECIFICATIONS ARE INSTRUMENTS OF SERVICE AND THE PROPERTY OF *UNION 31 INC.* WHICH MUST BE RETURNED AT THE COMPLETION OF THE WORK.

PRINTED: 30-May-17

ISSUED FOR AS-BUILT

NO.	DATE	COMMENTS	INI
01	31 MAY / 17	ISSUED FOR AS-BUILT	SV

REVISIONS:

UNION31

UNION31 INC.
183 BATHURST STREET, STE 201
TORONTO, ON, M5T 2R7, CANADA
TEL: 416-597-1576 FAX: 416-597-2139

PROJECT NAME:
ALEXANDRA PARK
MAIN BUILDING
BLOCK 11
ON, Canada

PROJECT NO.: 13-949

DRAWING/S:
GROUND FLOOR
FURNITURE & POWER PLAN

DATE STARTED:	07 AUG / 13	DRAWING NO.:	ID 1.1.2
SCALE:	1 : 50		
DRAWN BY:	AP		
APPROVED BY:	KC		

38 of 48

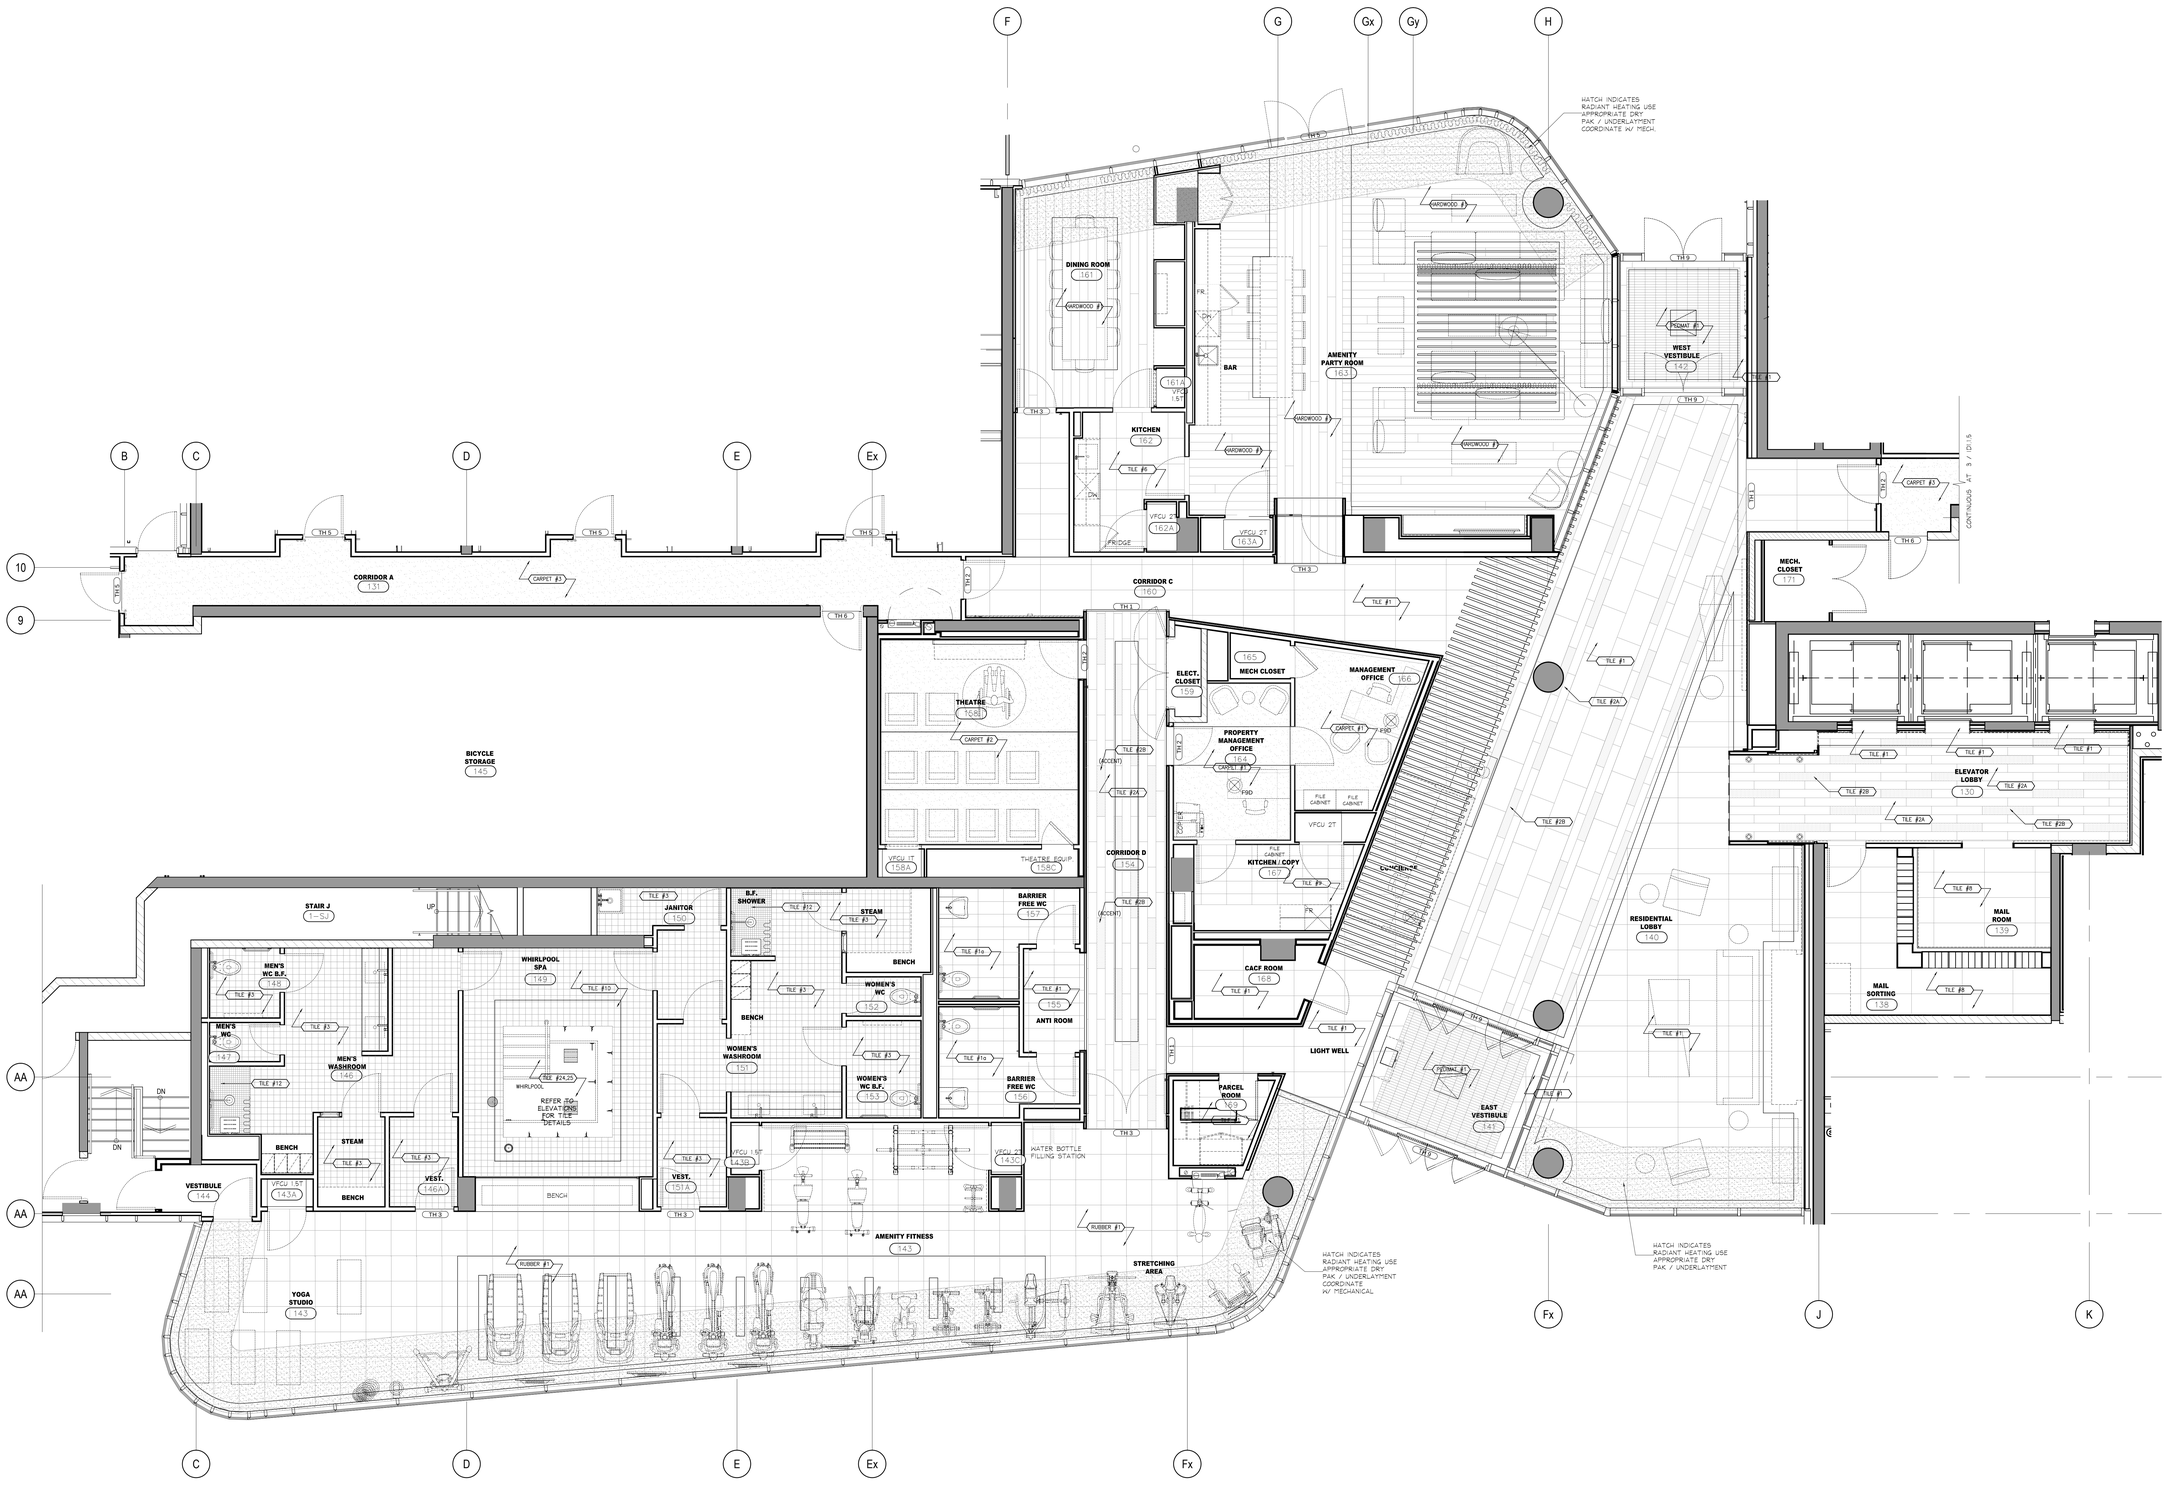

1 / ID1.1.3 FLOOR FINISHES PLAN
GROUND FLOOR SCALE 1:50

DO NOT SCALE DRAWINGS.

CONTRACTOR MUST VERIFY ALL DRAWINGS, DIMENSIONS, DETAILS AND SPECIFICATIONS, AND REPORT ANY DISCREPANCIES TO *UNION 31 INC.* BEFORE PROCEEDING WITH WORK. MATERIALS MAY NOT BE SUBSTITUTED WITHOUT WRITTEN APPROVAL FROM *UNION 31 INC.*

ALL DRAWINGS AND SPECIFICATIONS ARE INSTRUMENTS OF SERVICE AND THE PROPERTY OF *UNION 31 INC.* WHICH MUST BE RETURNED AT THE COMPLETION OF THE WORK.

PRINTED: 30-May-17

ISSUED FOR AS-BUILT

NO.	DATE	COMMENTS	INI
01	31 MAY / 17	ISSUED FOR AS-BUILT	SV

REVISIONS:

UNION31

UNION31 INC.
183 BATHURST STREET, STE 201
TORONTO, ON, M5T 2R7, CANADA
TEL: 416-597-1576 FAX: 416-597-2139

PROJECT NAME:
ALEXANDRA PARK
MAIN BUILDING
BLOCK 11
ON, Canada

PROJECT NO.: 13-949

DRAWING/S:
GROUND FLOOR
FLOOR FINISHES PLAN

DATE STARTED:	07 AUG / 13	DRAWING NO.:	ID 1.1.3
SCALE:	1 : 50		
DRAWN BY:	AP		
APPROVED BY:	KC		

38 X 48

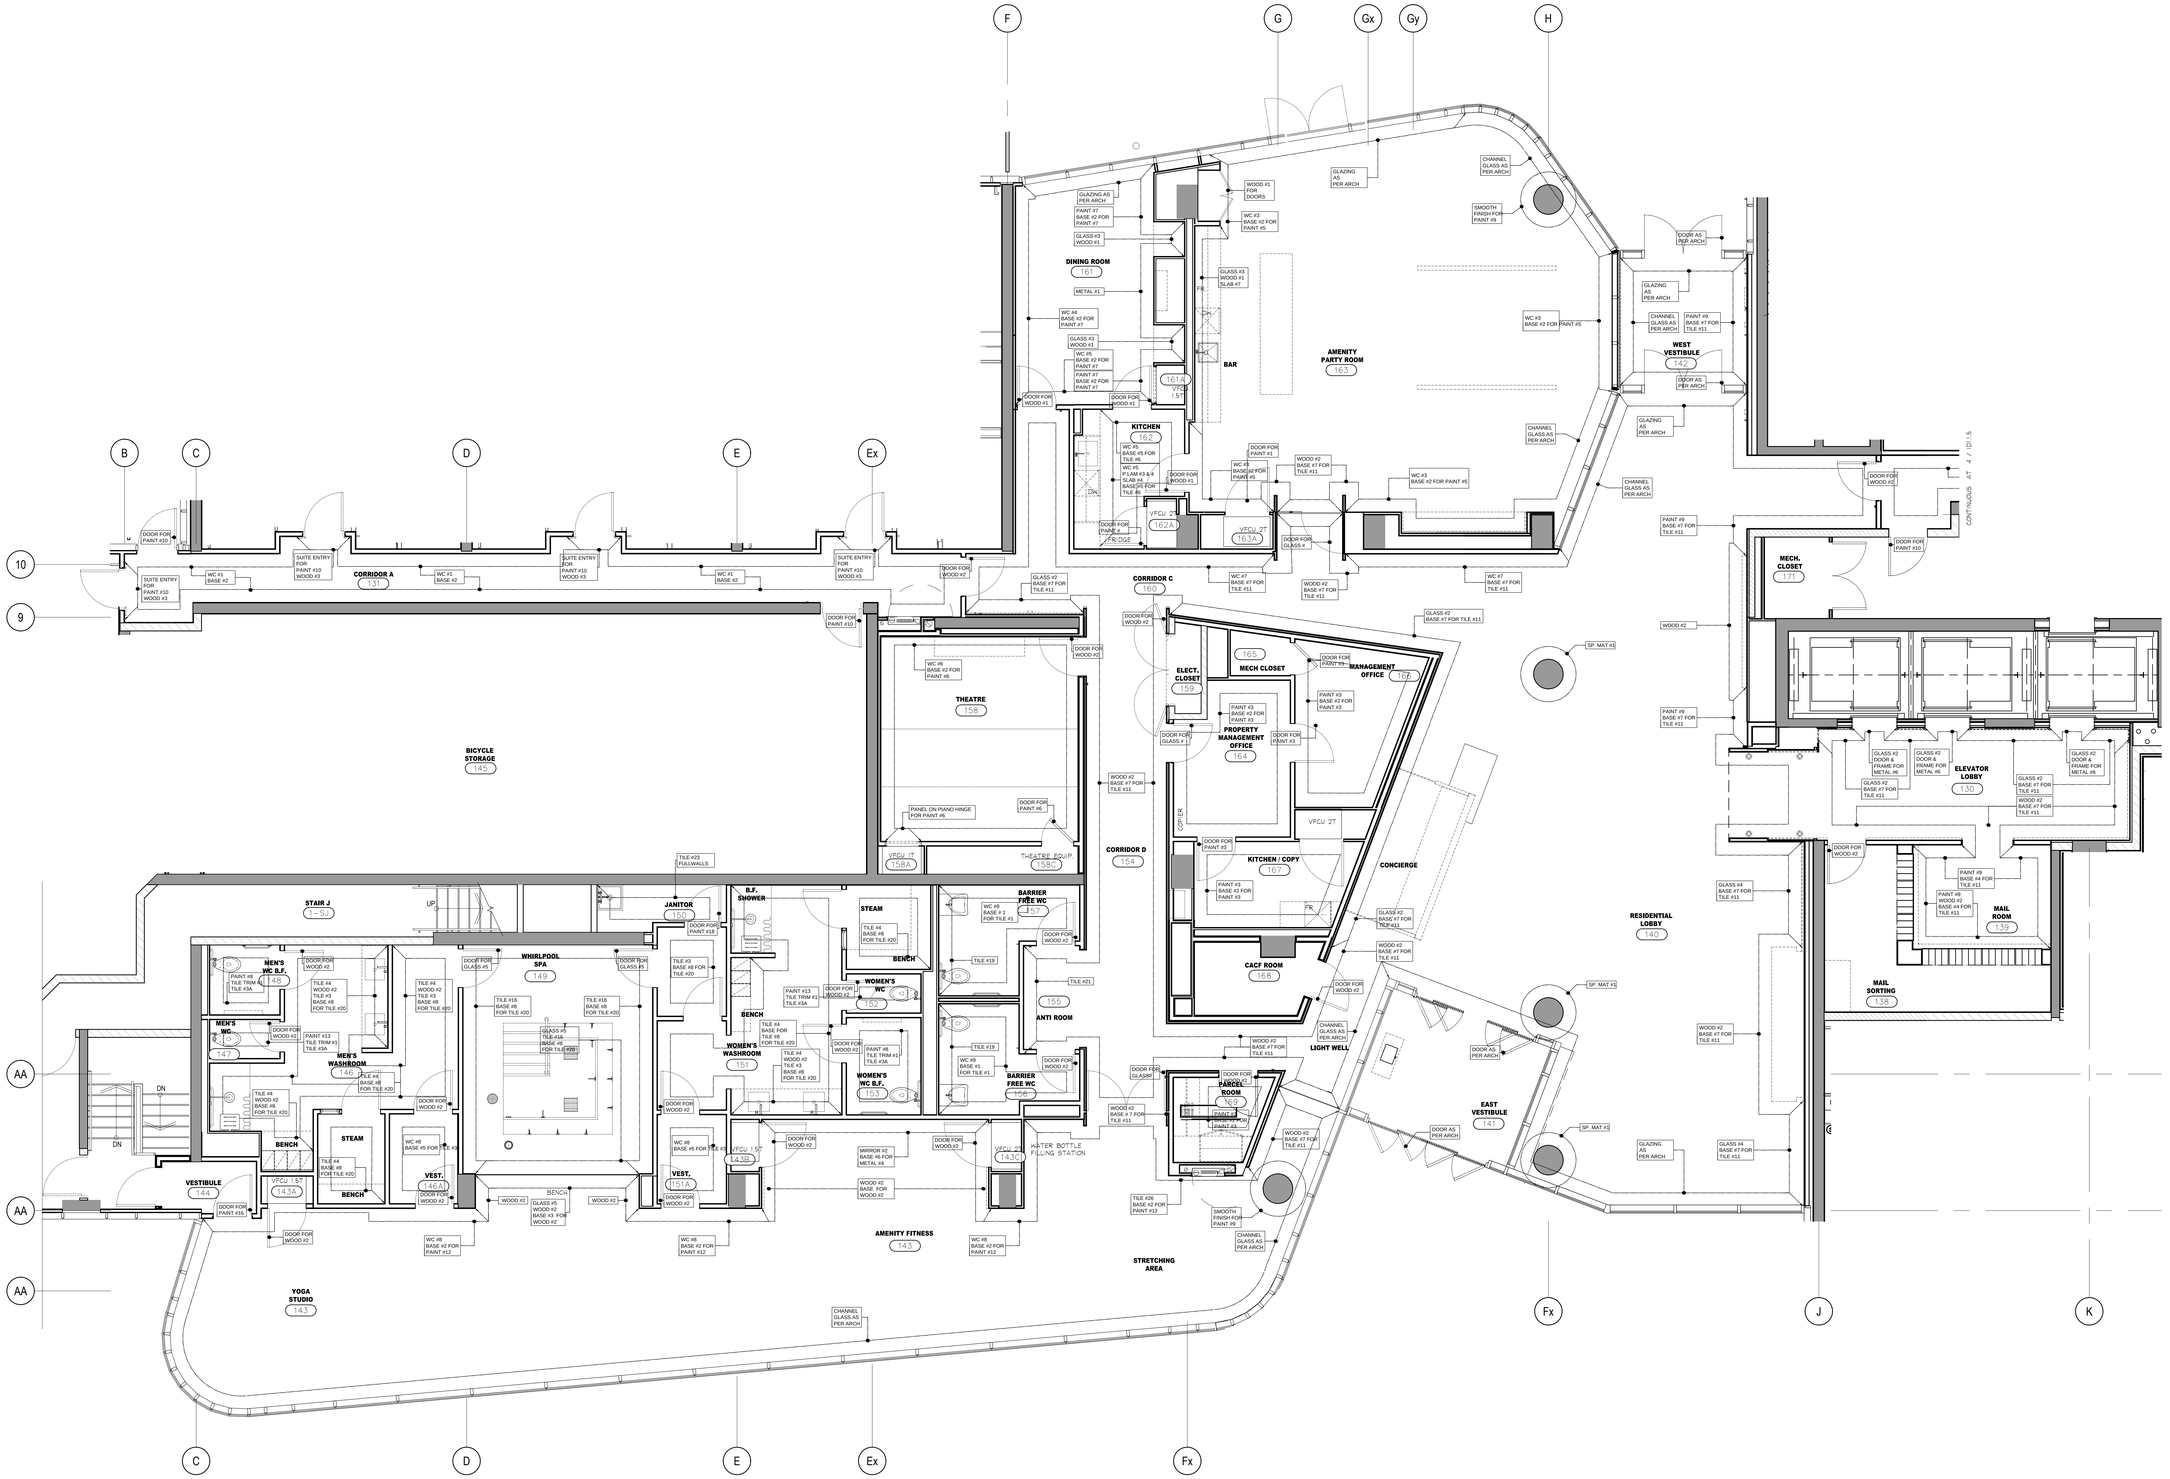
F
G
Gx
Gy
H
B
C
D
E
Ex
Fx
J
K
10
9
AA
DINING ROOM
161
KITCHEN
162
AMENITY
PARTY ROOM
163
BAR
161A
WEST
VESTIBULE
142
CORRIDOR A
131
CORRIDOR C
160
CORRIDOR D
154
THEATRE
158
BICYCLE
STORAGE
145
ELECT.
CLOSET
159
MECH CLOSET
165
MANAGEMENT
OFFICE
167
PROPERTY
MANAGEMENT
OFFICE
164
KITCHEN / COPY
167
CONCIERGE
CACF ROOM
168
LIGHT WELL
169
EAST
VESTIBULE
141
MECH.
CLOSET
171
ELEVATOR
LOBBY
130
RESIDENTIAL
LOBBY
140
MAIL
ROOM
139
MAIL
SORTING
138
STAIR J
1 - 32
JANITOR
150
B.F.
SHOWER
WHIRLPOOL
SPA
149
MEN'S
WC B.F.
148
MEN'S
WC
147
MEN'S
WASHROOM
146
VESTIBULE
144
VEST.
143A
VEST.
146A
VEST.
151A
YOGA
STUDIO
143
STEAM
BENCH
WOMEN'S
WC
152
WOMEN'S
WASHROOM
151
WOMEN'S
WC B.F.
153
BARRIER
FREE WC
157
ANTI ROOM
155
BARRIER
FREE WC
156
AMENITY FITNESS
143
VFCU 1ST
143A
VFCU 1ST
143B
VFCU 2T
143C
VFCU 1T
158A
THEATRE EQUIP.
158C
VFCU 2T
162A
VFCU 2T
163A
VFCU 2T
167
WATER BOTTLE
FILLING STATION
STRETCHING
AREA
SUITE ENTRY
FOR
PAINT #10
WOOD #3
DOOR FOR
PAINT #10
DOOR FOR
WOOD #2
DOOR FOR
WOOD #1
DOOR FOR
PAINT #1
DOOR FOR
GLASS #
DOOR FOR
PAINT #18
DOOR FOR
GLASS #5
DOOR FOR
PAINT #6
DOOR FOR
PAINT #3
DOOR AS
PER ARCH
GLAZING
AS
PER ARCH
CHANNEL
GLASS AS
PER ARCH
WC #1
BASE #2
WC #2
BASE #2
WC #3
BASE #2 FOR
PAINT #5
WC #5
BASE #2 FOR
PAINT #7
WC #6
BASE #2 FOR
PAINT #6
WC #7
BASE #7 FOR
TILE #11
WC #8
BASE #2 FOR
PAINT #12
WC #9
BASE #1
FOR TILE #1
WOOD #1
FOR
DOORS
GLASS #3
WOOD #1
SLAB #7
GLASS #3
WOOD #3
METAL #1
WC #4
BASE #7 FOR
PAINT #7
WC #5
BASE #2 FOR
PAINT #7
PAINT #7
BASE #2 FOR
PAINT #7
WC #6
P LAM #3 &4
SLAB #6
BASE#5 FOR
TILE #6
WOOD #2
BASE #7 FOR
TILE #11
WOOD #2
BASE #7 FOR
TILE #11
GLASS #2
BASE #7 FOR TILE #11
SMOOTH
FINISH FOR
PAINT #9
PAINT #9
BASE #7 FOR
TILE #11
GLASS #2
DOOR &
FRAME FOR
METAL #6
GLASS #2
BASE #7 FOR
TILE #11
GLASS #2
BASE #7 FOR
TILE #11
WOOD #2
BASE #7 FOR
TILE #11
PAINT #9
BASE #4 FOR
TILE #11
WOOD #2
BASE #4 FOR
TILE #11
GLASS #4
BASE #7 FOR
TILE #11
PAINT #3
BASE #2 FOR
PAINT #3
PAINT #3
BASE #2 FOR
PAINT #3
PAINT #3
BASE #2 FOR
PAINT #3
WOOD #2
BASE #7 FOR
TILE #11
WOOD #2
BASE #7 FOR
TILE #11
WOOD #2
BASE #7 FOR
TILE #11

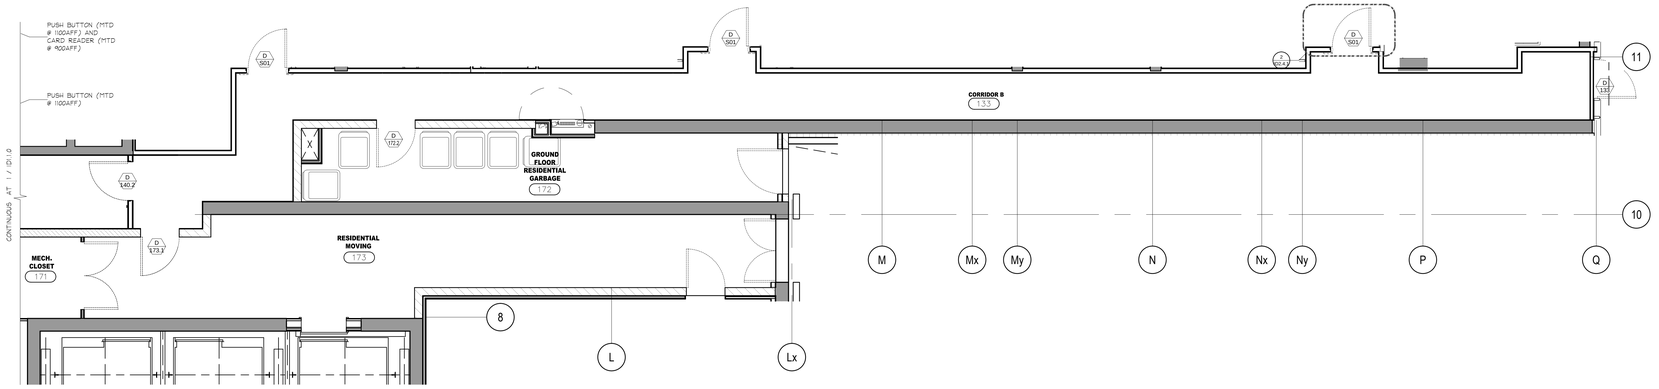

1 ID1.1.5 CONSTRUCTION PLAN GROUND FLOOR SCALE 1:50

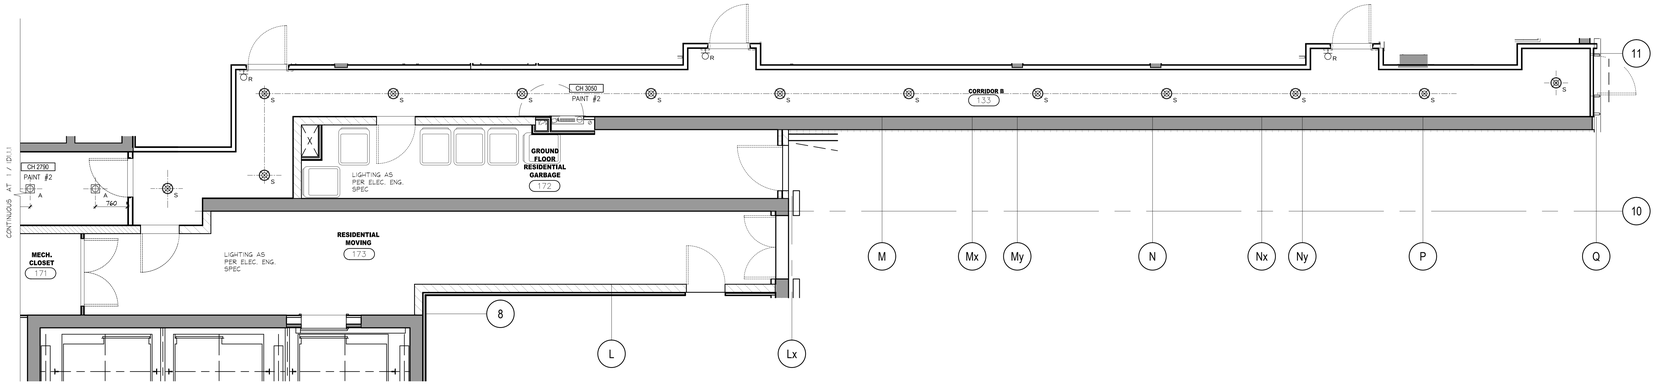

2 ID1.1.5 REFLECTED CEILING PLAN GROUND FLOOR SCALE 1:50

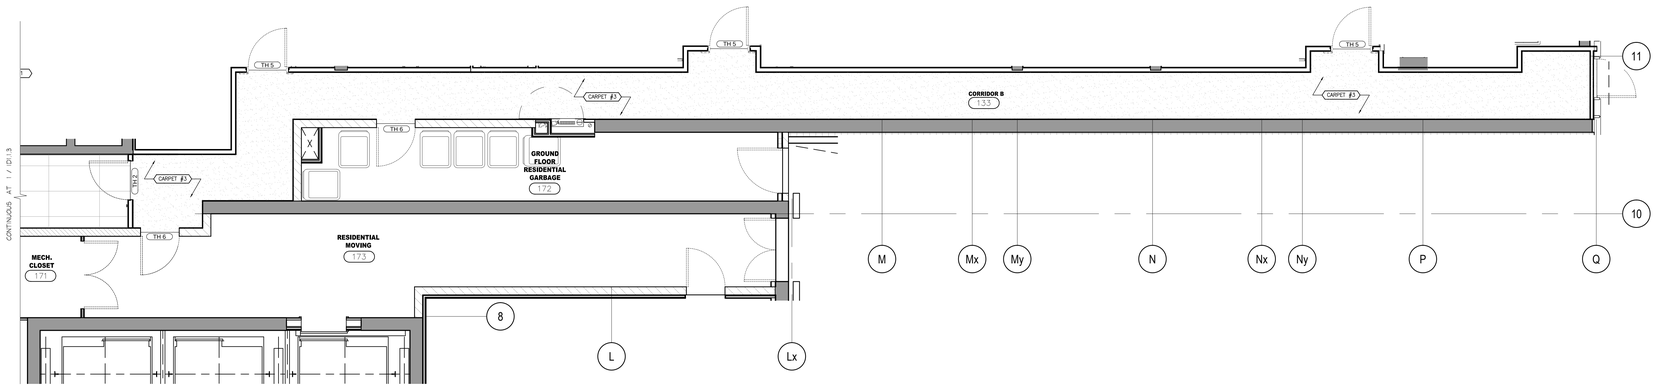

3 ID1.1.5 FLOOR FINISHES PLAN GROUND FLOOR SCALE 1:50

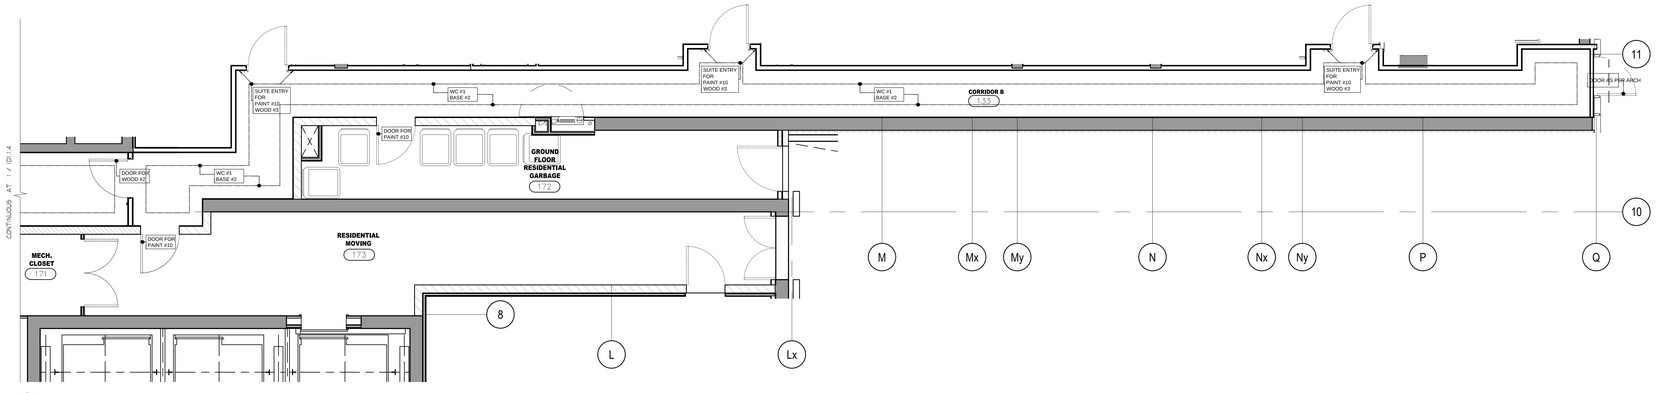

4 ID1.1.5 WALL FINISHES PLAN GROUND FLOOR SCALE 1:50

DO NOT SCALE DRAWINGS.

CONTRACTOR MUST VERIFY ALL DRAWINGS, DIMENSIONS, DETAILS AND SPECIFICATIONS, AND REPORT ANY DISCREPANCIES TO *UNION 31 INC.* BEFORE PROCEEDING WITH WORK. MATERIALS MAY NOT BE SUBSTITUTED WITHOUT WRITTEN APPROVAL FROM *UNION 31 INC.*

ALL DRAWINGS AND SPECIFICATIONS ARE INSTRUMENTS OF SERVICE AND THE PROPERTY OF *UNION 31 INC.* WHICH MUST BE RETURNED AT THE COMPLETION OF THE WORK.

PRINTED: 30-May-17

ISSUED FOR AS-BUILT

NO.	DATE	COMMENTS	INI
01	31 MAY / 17	ISSUED FOR AS-BUILT	SV

REVISIONS:

UNION31

UNION31 INC.
183 BATHURST STREET, STE 201
TORONTO, ON, M5T 2R7, CANADA
TEL: 416-597-1576 FAX: 416-597-2139

PROJECT NAME:
ALEXANDRA PARK
MAIN BUILDING
BLOCK 11
ON, Canada

PROJECT NO.: 13-949

DRAWING/S:
GROUND FLOOR / CORRIDOR CONSTRUCTION PLAN & REFLECTED CEILING PLAN
FLOOR & WALL FINISHES PLANS

DATE STARTED:	07 AUG / 13	DRAWING NO.:	ID 1.1.5
SCALE:	1 : 50		
DRAWN BY:	AP		
APPROVED BY:	KC		

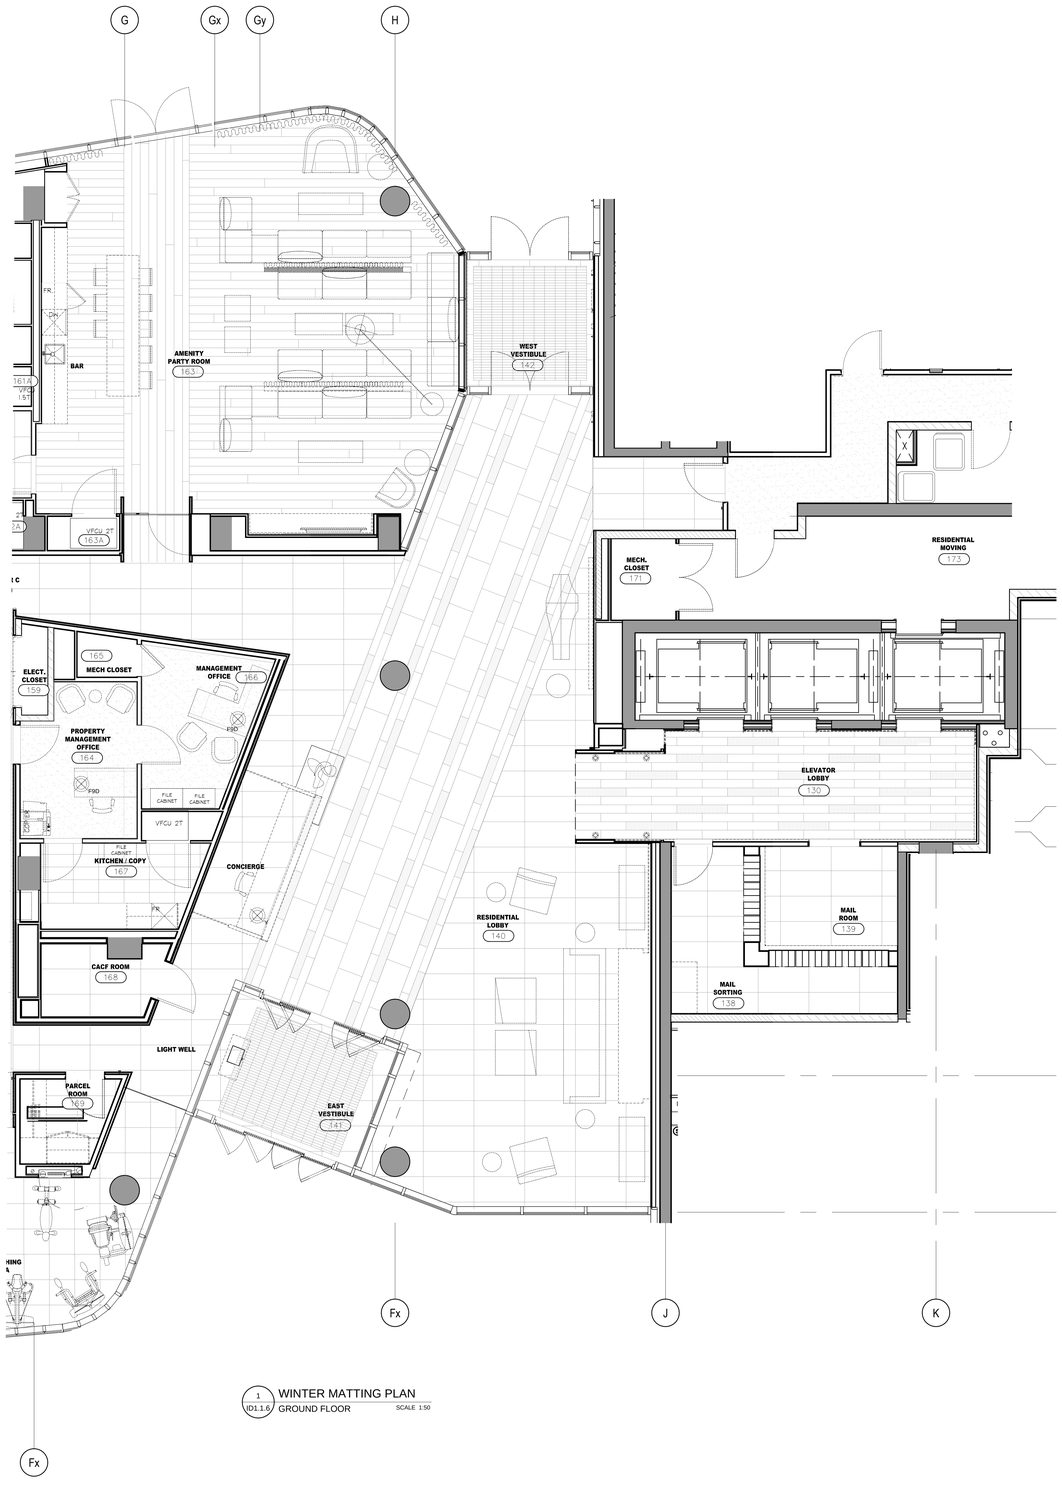

1 / ID1.1.6 WINTER MATTING PLAN
GROUND FLOOR
SCALE 1:50

DO NOT SCALE DRAWINGS.

CONTRACTOR MUST VERIFY ALL DRAWINGS, DIMENSIONS, DETAILS AND SPECIFICATIONS, AND REPORT ANY DISCREPANCIES TO *UNION 31 INC.* BEFORE PROCEEDING WITH WORK. MATERIALS MAY NOT BE SUBSTITUTED WITHOUT WRITTEN APPROVAL FROM *UNION 31 INC.*

ALL DRAWINGS AND SPECIFICATIONS ARE INSTRUMENTS OF SERVICE AND THE PROPERTY OF *UNION 31 INC.* WHICH MUST BE RETURNED AT THE COMPLETION OF THE WORK.

PRINTED: 30-May-17

ISSUED FOR AS-BUILT

NO.	DATE	COMMENTS	INI
01	31 MAY / 17	ISSUED FOR AS-BUILT	SV

REVISIONS:

UNION31

UNION31 INC.
183 BATHURST STREET, STE 201
TORONTO, ON, M5T 2R7, CANADA
TEL: 416-597-1576 FAX: 416-597-2139

PROJECT NAME:
ALEXANDRA PARK
MAIN BUILDING
BLOCK 11
ON, Canada

PROJECT NO.: 13-949

DRAWING/S:
GROUND FLOOR
WINTER MATTING PLAN

DATE STARTED:	07 AUG / 13	DRAWING NO.:
SCALE:	1 : 50	ID 1.1.6
DRAWN BY:	AP	
APPROVED BY:	KC	

36 of 48

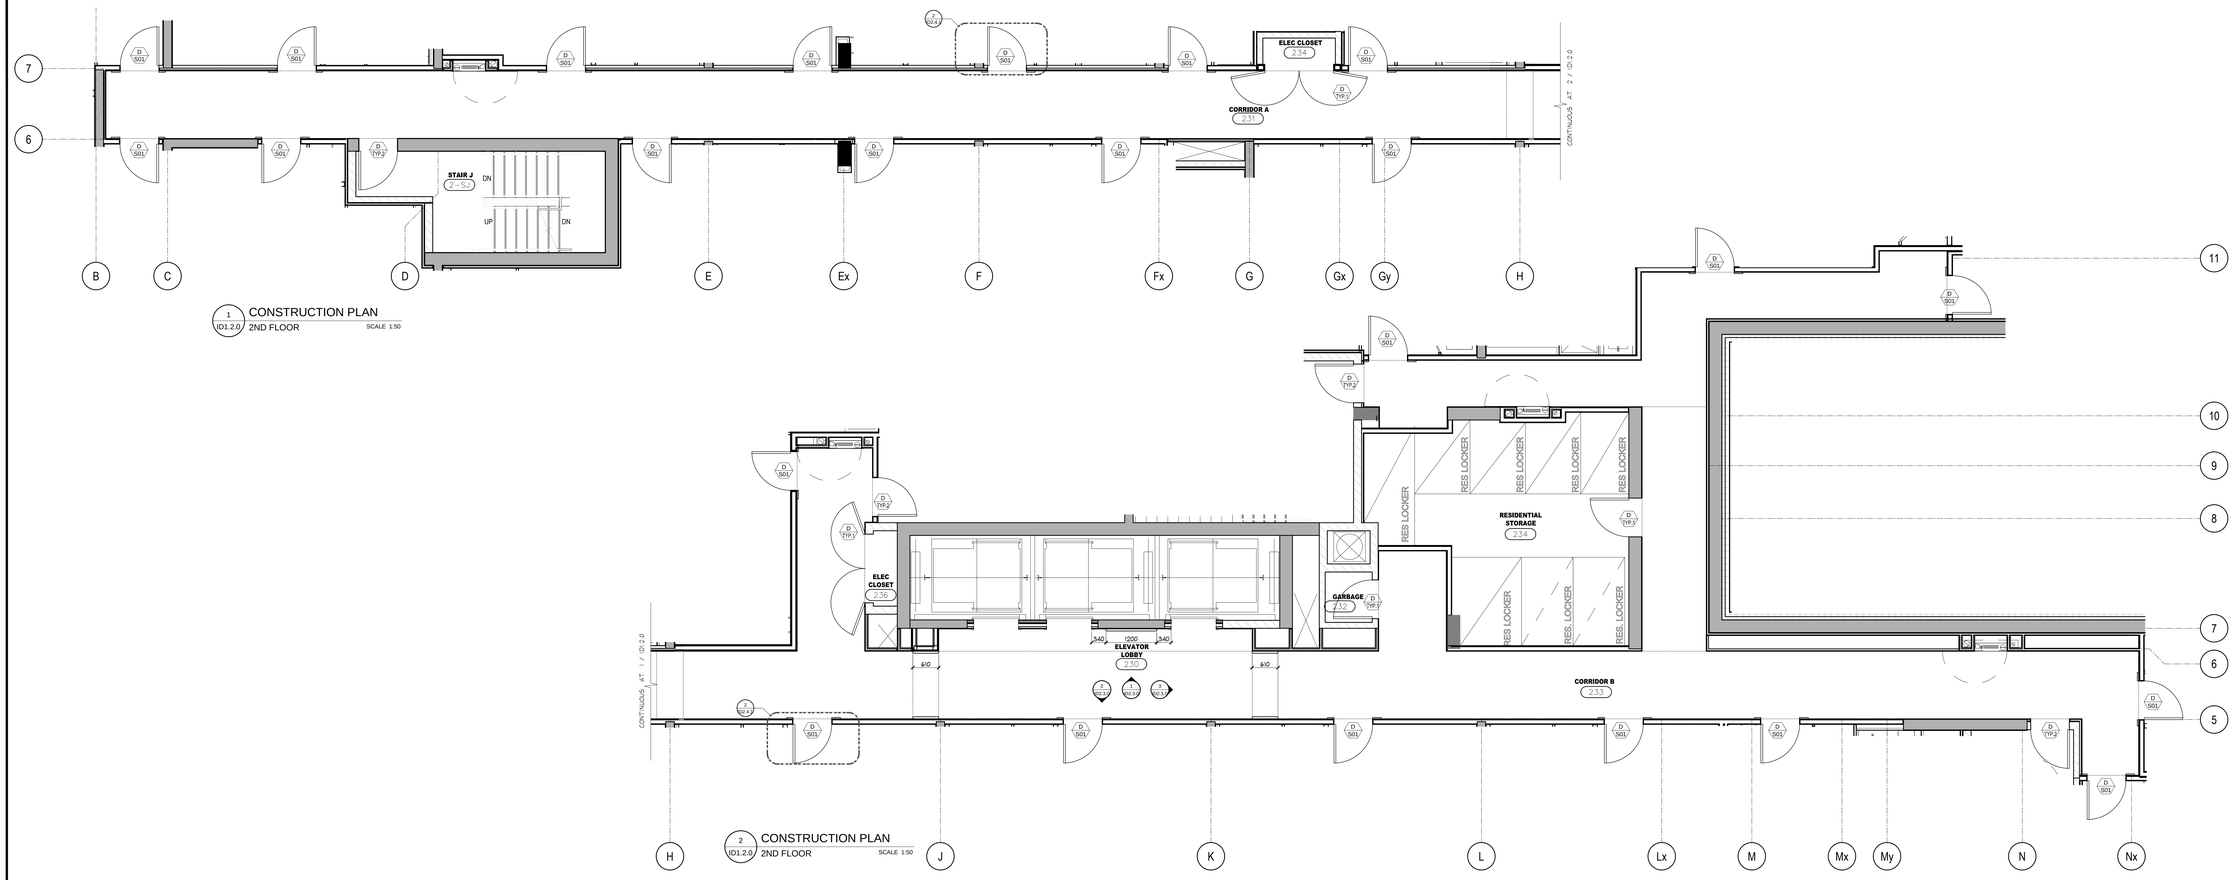

1 ID1.2.0 CONSTRUCTION PLAN
2ND FLOOR SCALE 1:50

2 ID1.2.0 CONSTRUCTION PLAN
2ND FLOOR SCALE 1:50

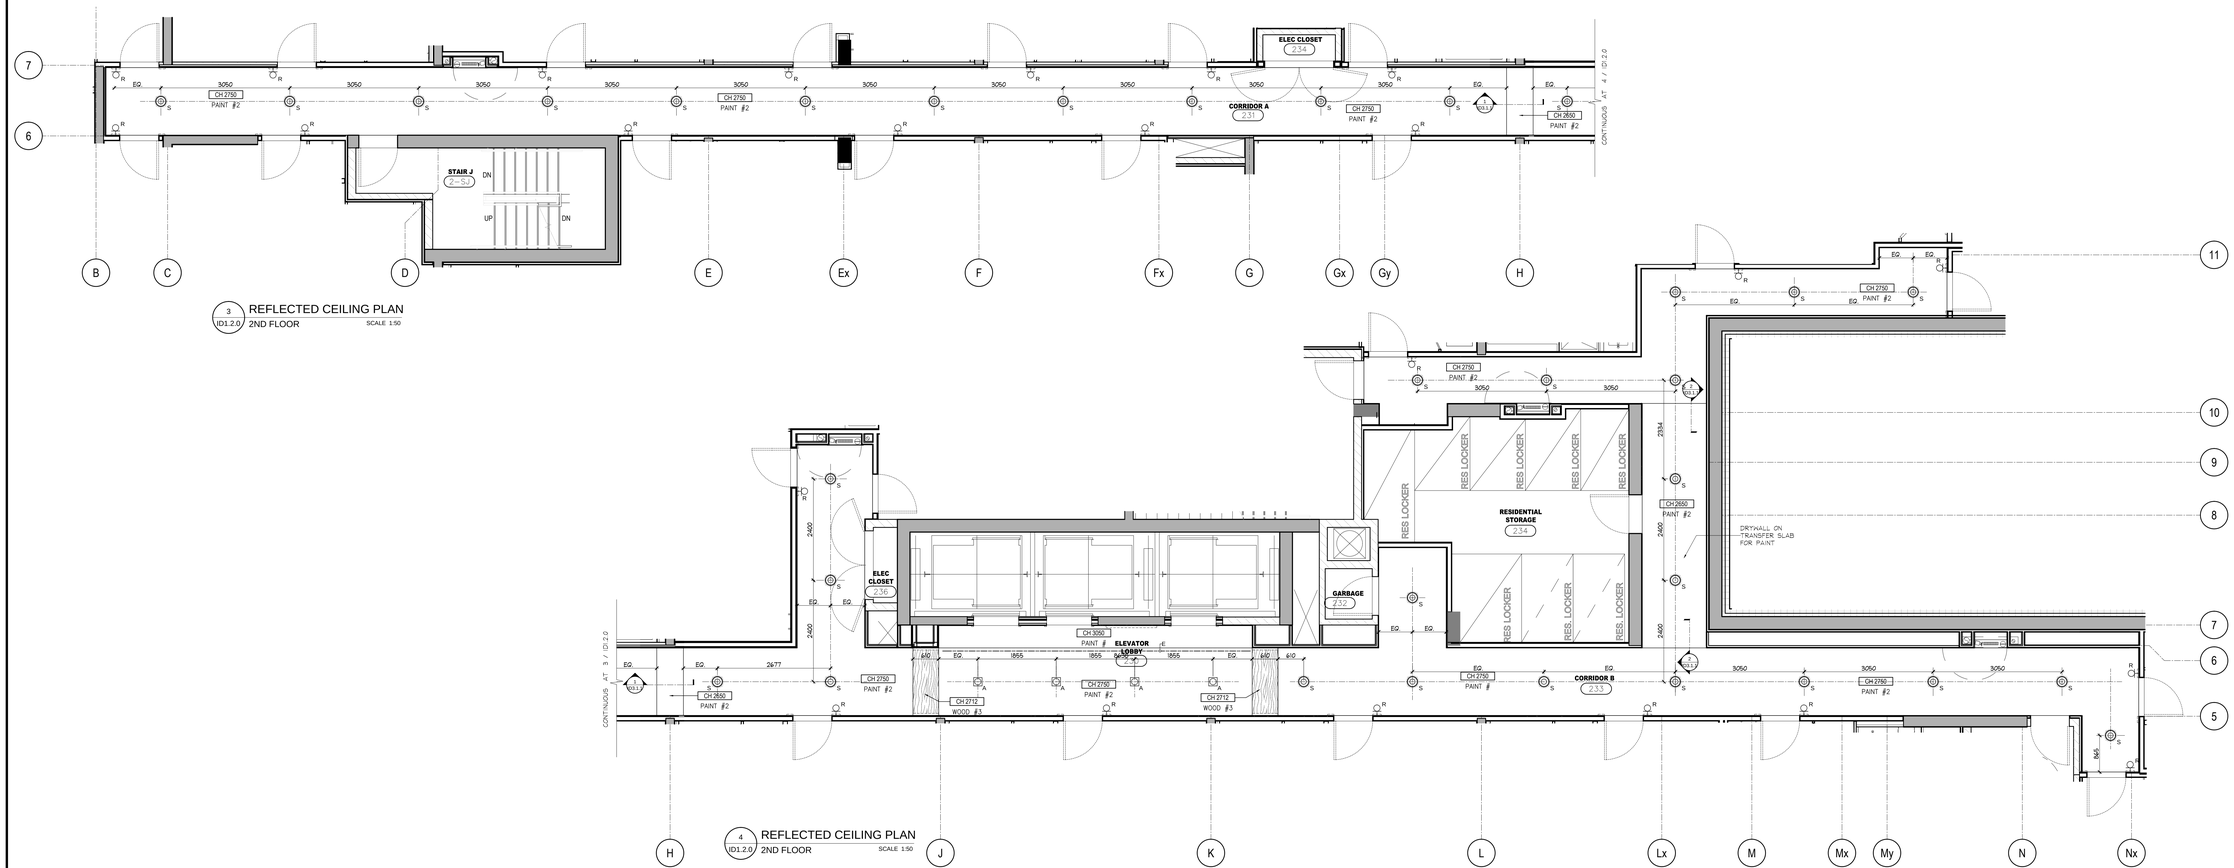

3 ID1.2.0 REFLECTED CEILING PLAN
2ND FLOOR SCALE 1:50

4 ID1.2.0 REFLECTED CEILING PLAN
2ND FLOOR SCALE 1:50

DO NOT SCALE DRAWINGS.

CONTRACTOR MUST VERIFY ALL DRAWINGS, DIMENSIONS, DETAILS AND SPECIFICATIONS, AND REPORT ANY DISCREPANCIES TO *UNION 31 INC.* BEFORE PROCEEDING WITH WORK. MATERIALS MAY NOT BE SUBSTITUTED WITHOUT WRITTEN APPROVAL FROM *UNION 31 INC.*

ALL DRAWINGS AND SPECIFICATIONS ARE INSTRUMENTS OF SERVICE AND THE PROPERTY OF *UNION 31 INC.* WHICH MUST BE RETURNED AT THE COMPLETION OF THE WORK.

PRINTED: 30-May-17

ISSUED FOR AS-BUILT

NO.	DATE	COMMENTS	INI
01	31 MAY / 17	ISSUED FOR AS-BUILT	SV

REVISIONS:

UNION31

UNION31 INC.
183 BATHURST STREET, STE 201
TORONTO, ON, M5T 2R7, CANADA
TEL: 416-597-1576 FAX: 416-597-2139

PROJECT NAME:
ALEXANDRA PARK
MAIN BUILDING
BLOCK 11
ON, Canada

PROJECT NO.: 13-949

DRAWING/S:
2ND FLOOR
CONSTRUCTION PLAN &
REFLECTED CEILING PLAN

DATE STARTED:	07 AUG / 13
SCALE:	1 : 50
DRAWN BY:	AP
APPROVED BY:	KC

DRAWING NO.: ID 1.2.0

36 x 48

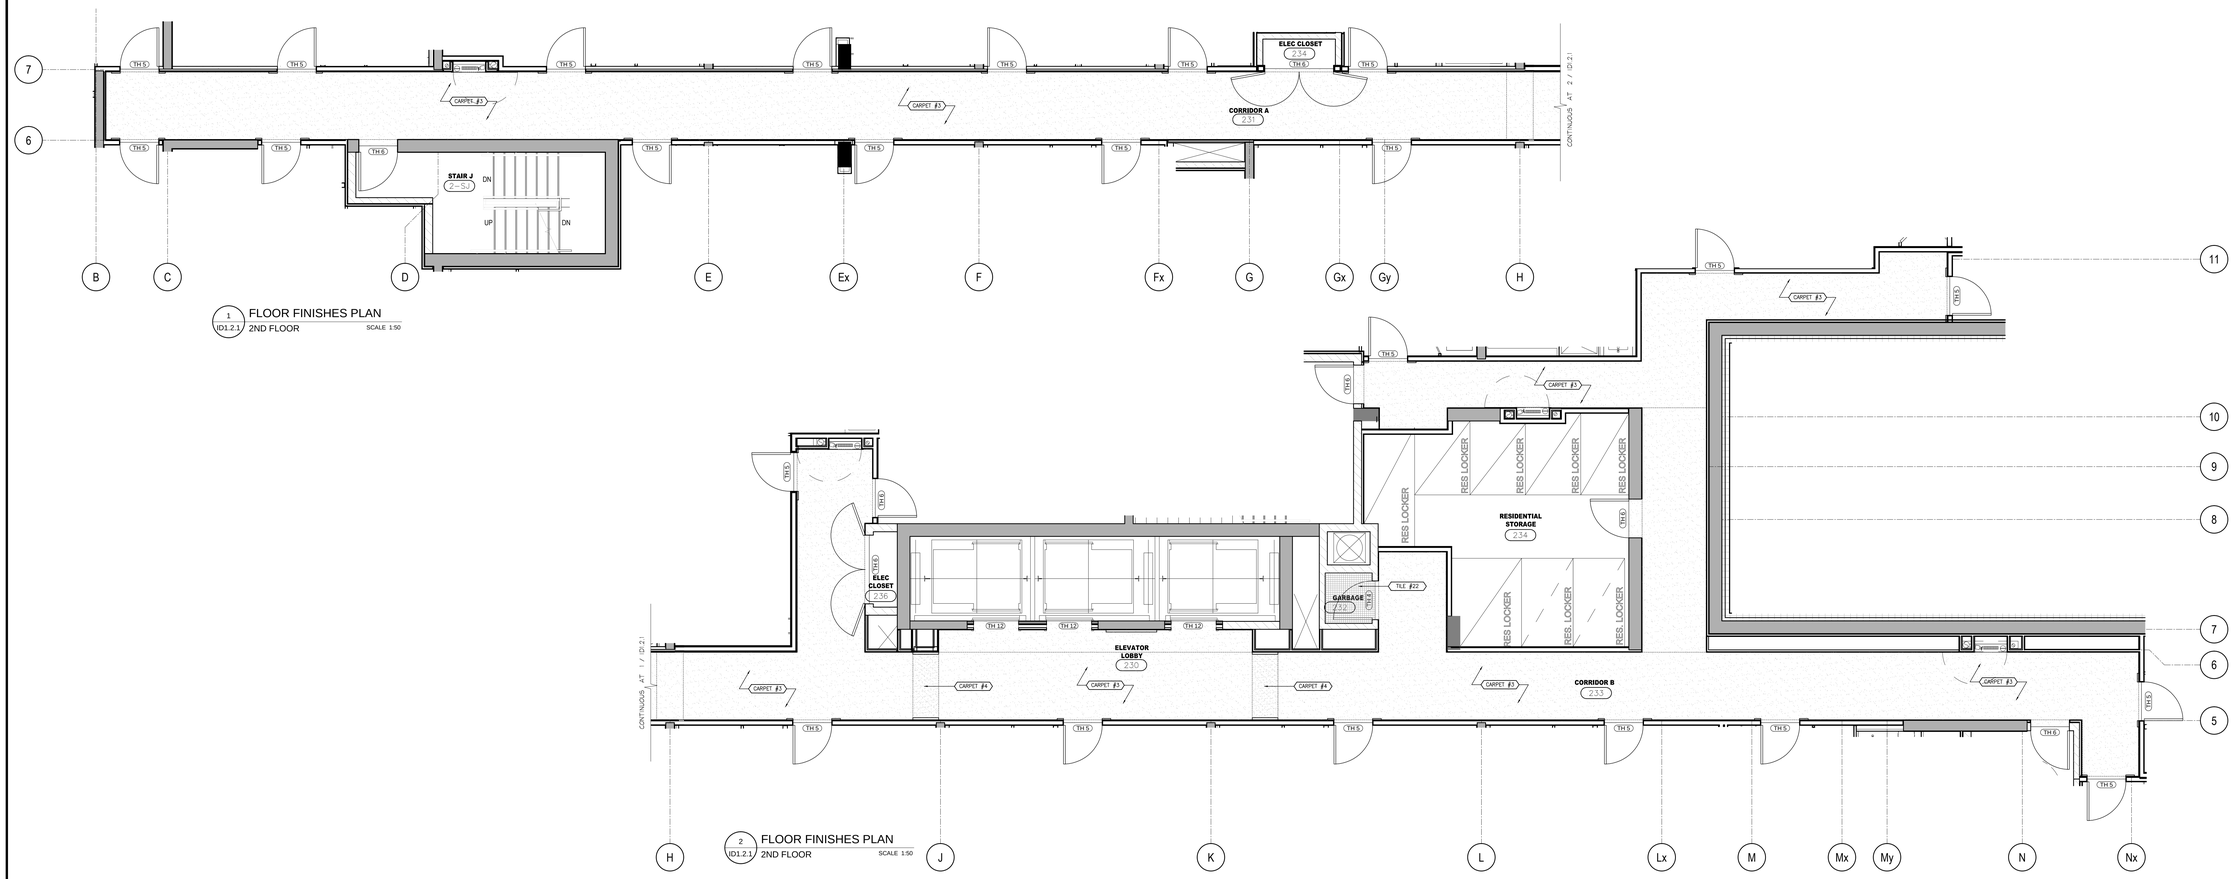

1 ID1.2.1 FLOOR FINISHES PLAN
2ND FLOOR SCALE 1:50

2 ID1.2.1 FLOOR FINISHES PLAN
2ND FLOOR SCALE 1:50

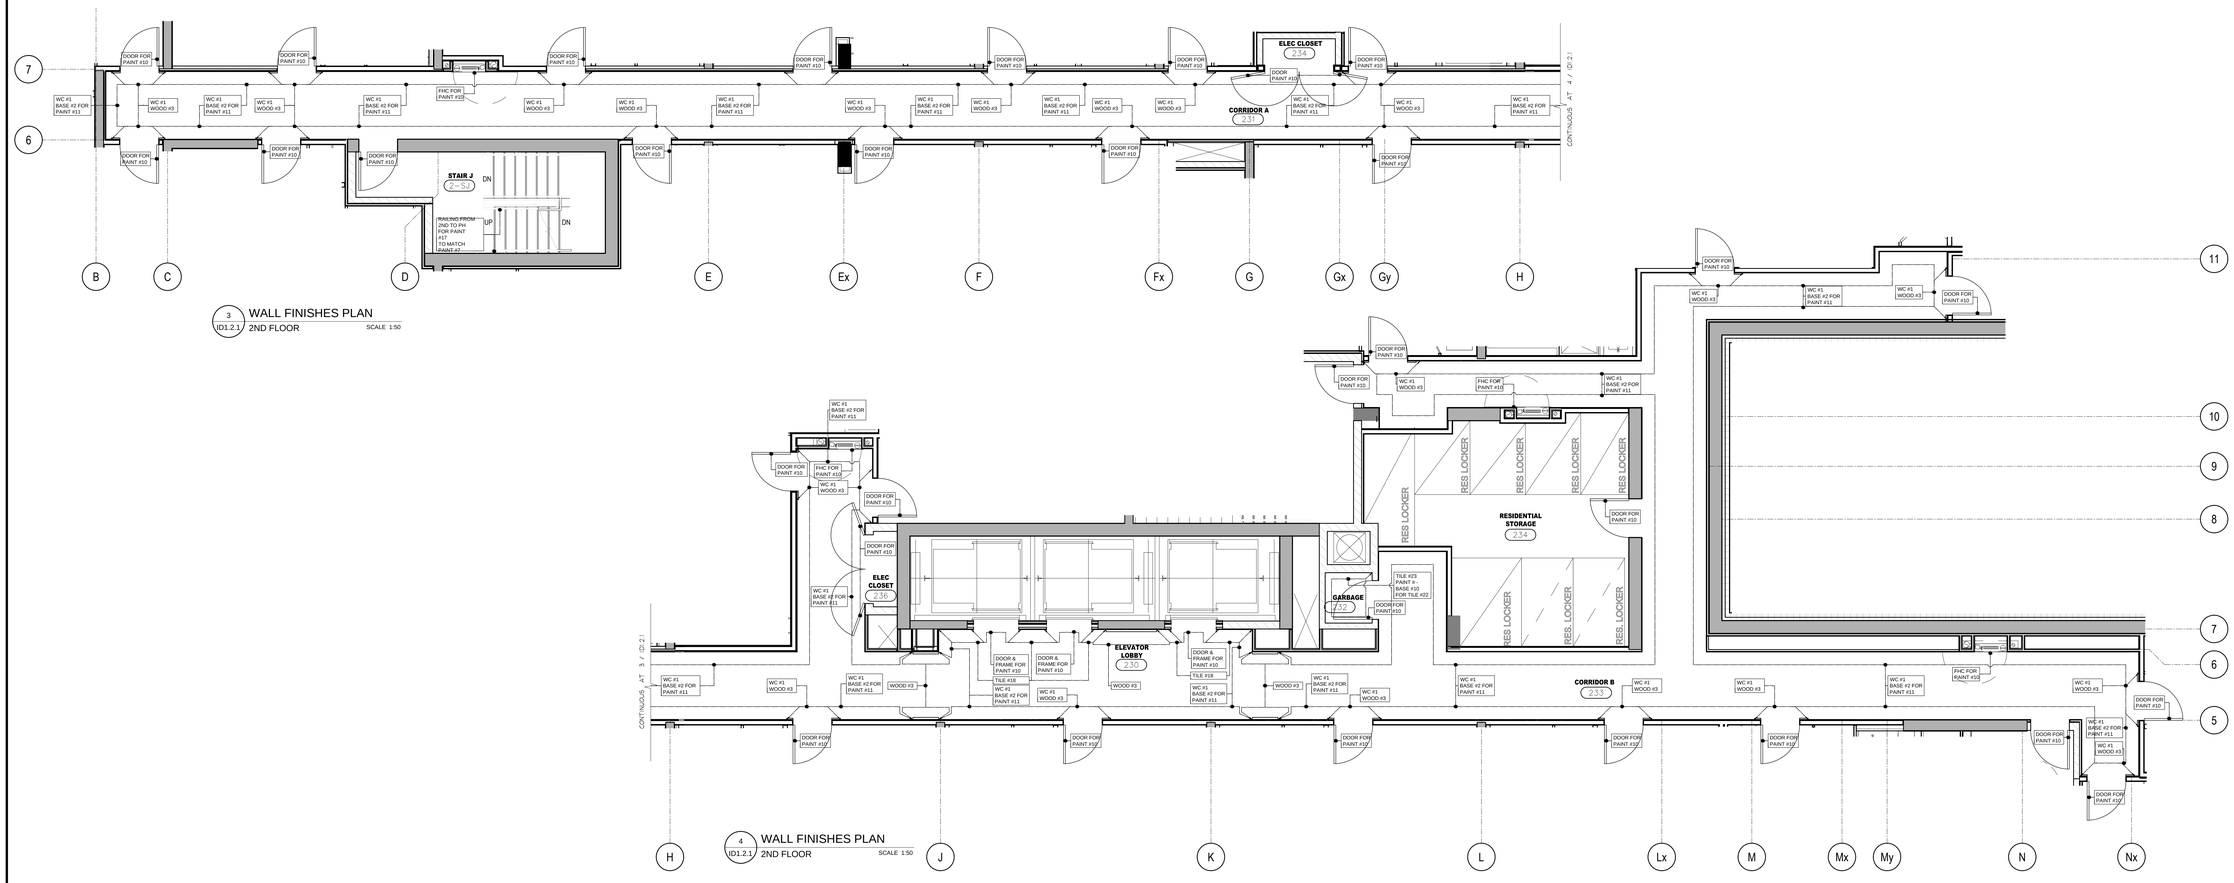

3 ID1.2.1 WALL FINISHES PLAN
2ND FLOOR SCALE 1:50

4 ID1.2.1 WALL FINISHES PLAN
2ND FLOOR SCALE 1:50

DO NOT SCALE DRAWINGS.

CONTRACTOR MUST VERIFY ALL DRAWINGS, DIMENSIONS, DETAILS AND SPECIFICATIONS, AND REPORT ANY DISCREPANCIES TO *UNION 31 INC.* BEFORE PROCEEDING WITH WORK. MATERIALS MAY NOT BE SUBSTITUTED WITHOUT WRITTEN APPROVAL FROM *UNION 31 INC.*

ALL DRAWINGS AND SPECIFICATIONS ARE INSTRUMENTS OF SERVICE AND THE PROPERTY OF *UNION 31 INC.* WHICH MUST BE RETURNED AT THE COMPLETION OF THE WORK.

PRINTED: 30-May-17

ISSUED FOR AS-BUILT

NO.	DATE	COMMENTS	INI
01	31 MAY / 17	ISSUED FOR AS-BUILT	SV

REVISIONS:

UNION31

UNION31 INC.
183 BATHURST STREET, STE 201
TORONTO, ON, M5T 2R7, CANADA
TEL: 416-597-1576 FAX: 416-597-2139

PROJECT NAME:
ALEXANDRA PARK
MAIN BUILDING
BLOCK 11
ON, Canada

PROJECT NO.: 13-949

DRAWING/S:
2ND FLOOR
FLOOR FINISHES PLAN &
WALL FINISHES PLAN

DATE STARTED:	07 AUG / 13
SCALE:	1 : 50
DRAWN BY:	AP
APPROVED BY:	KC

DRAWING NO.: ID 1.2.1

36 x 48

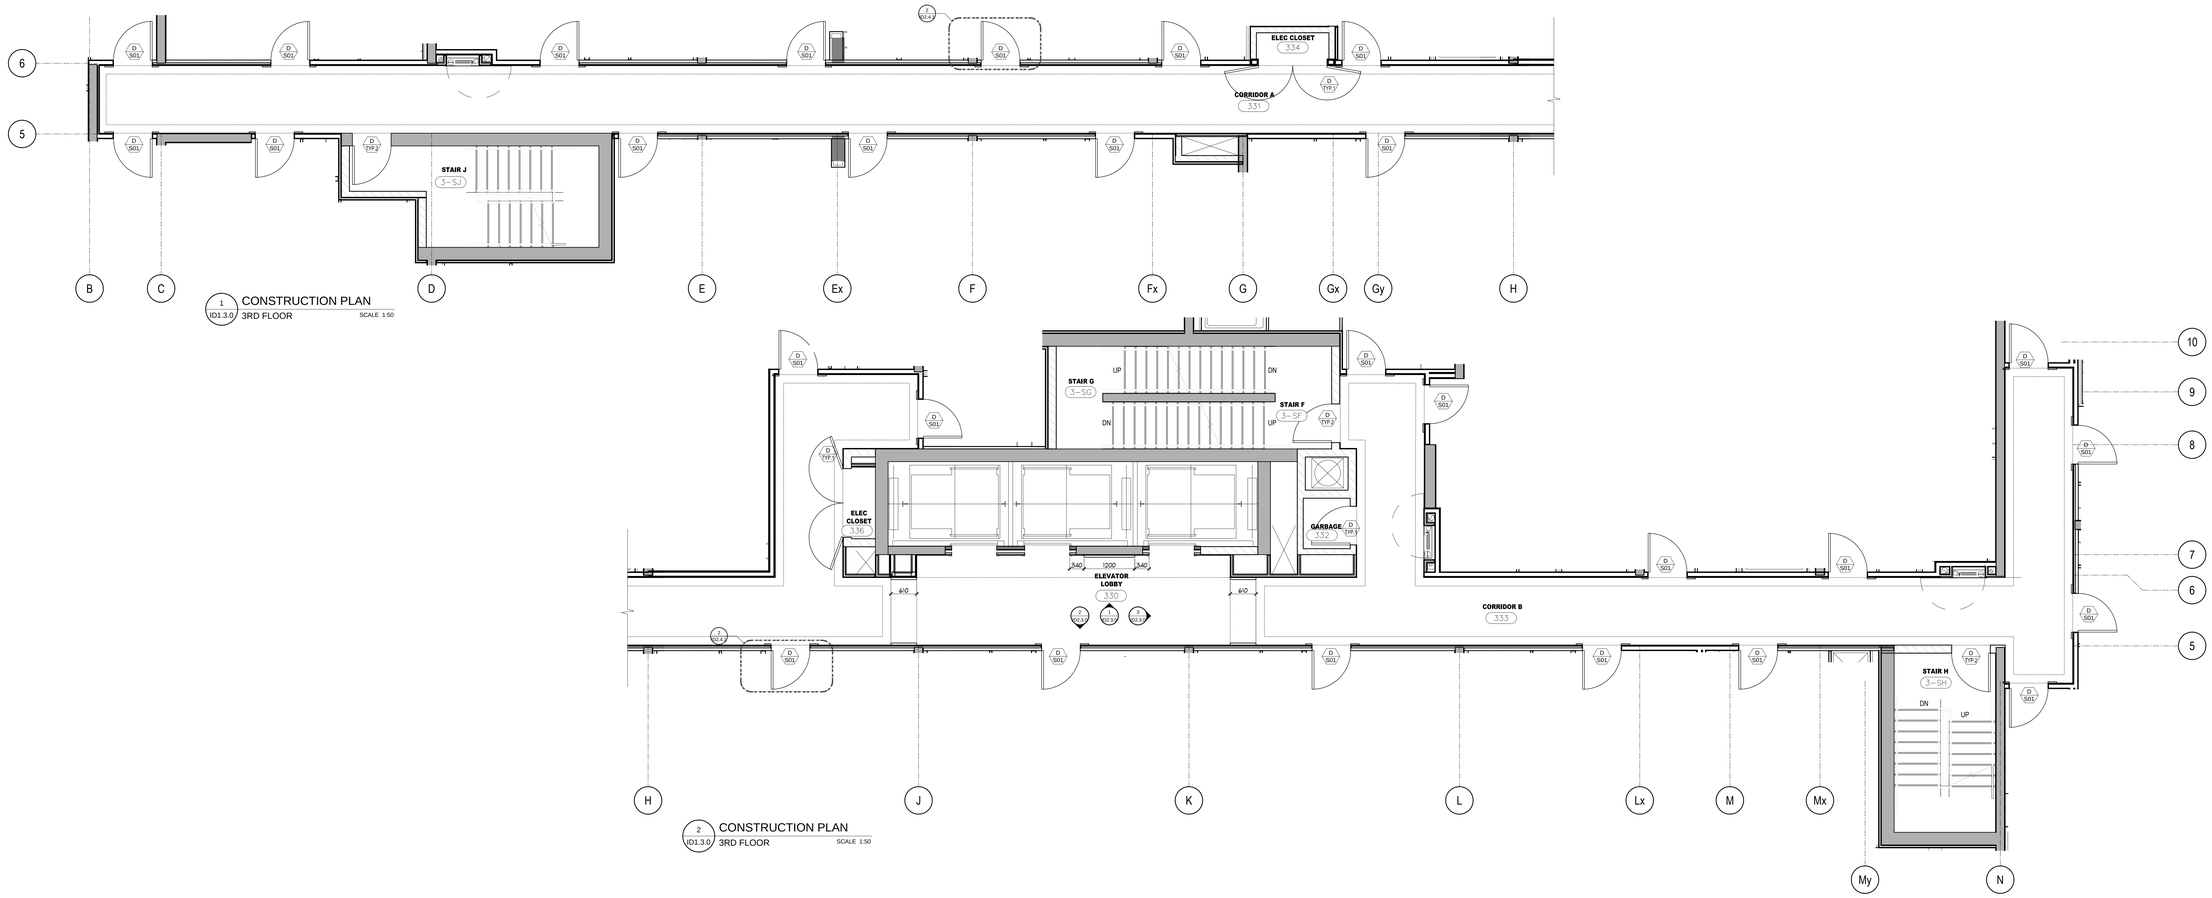

1 ID1.3.0 CONSTRUCTION PLAN
3RD FLOOR SCALE 1:50

2 ID1.3.0 CONSTRUCTION PLAN
3RD FLOOR SCALE 1:50

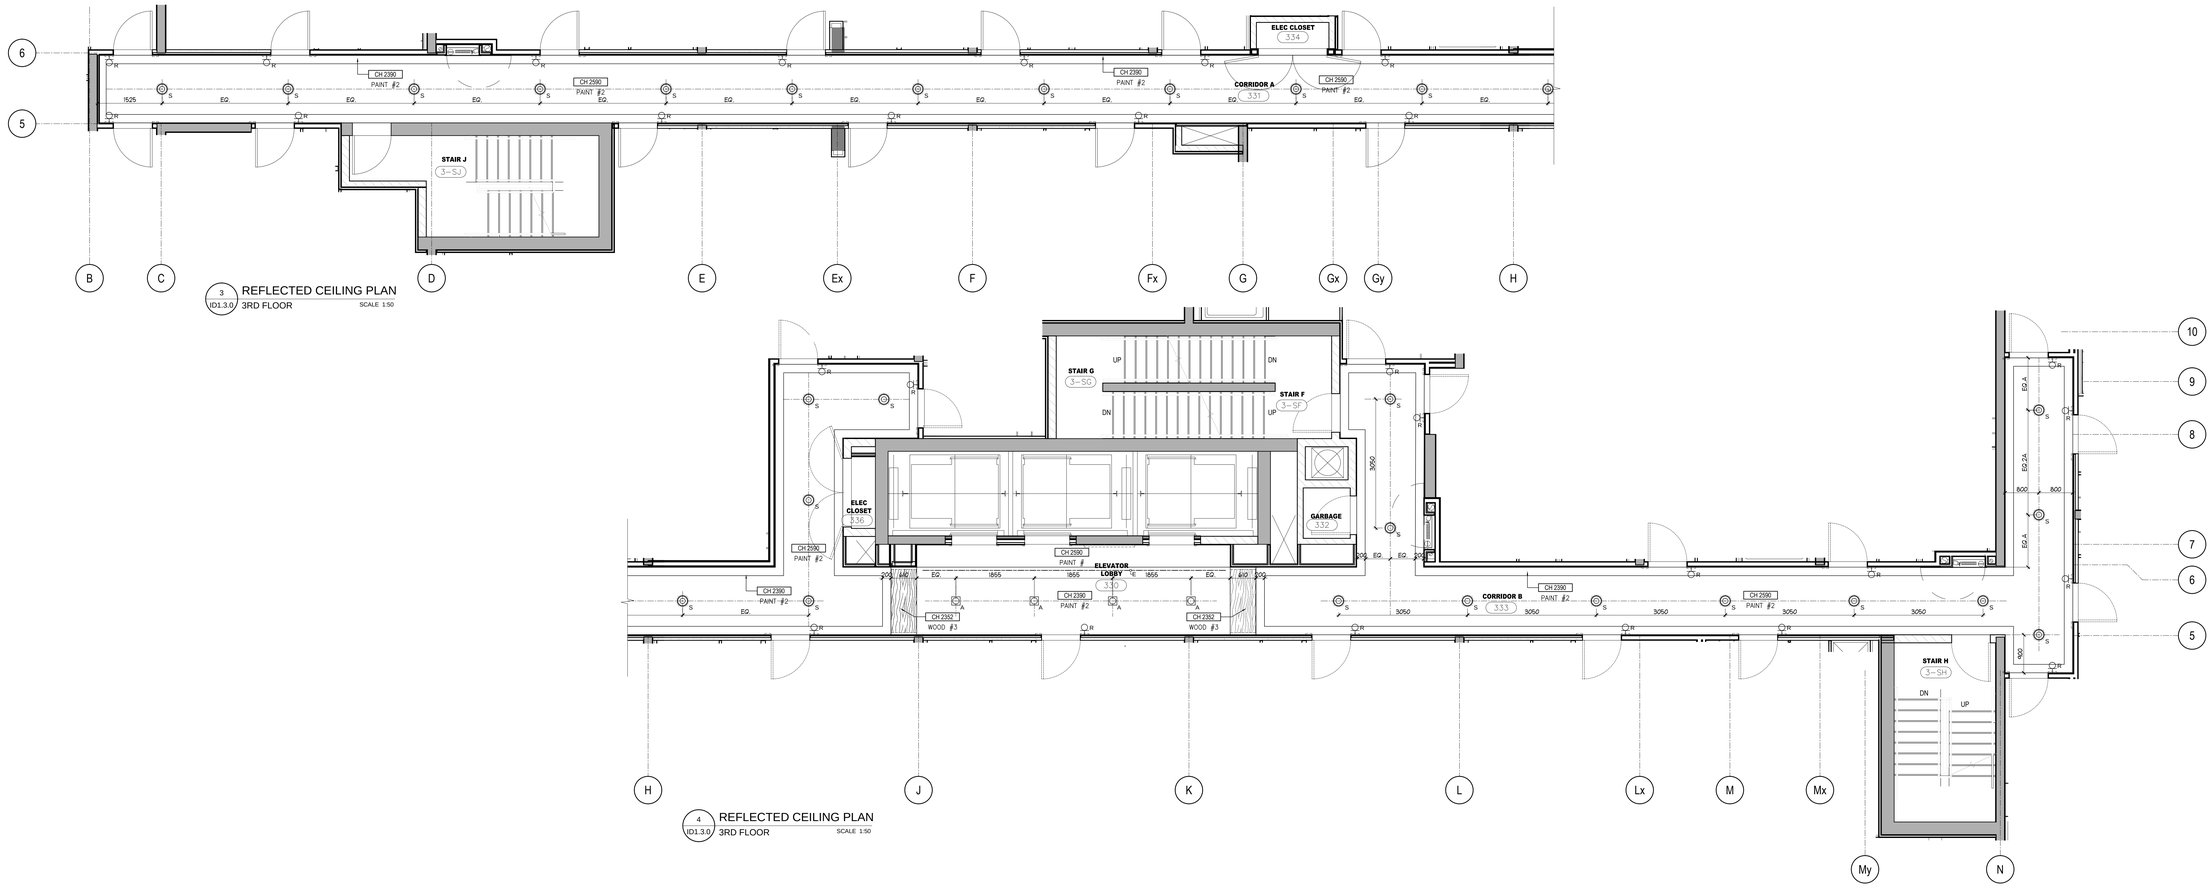

3 ID1.3.0 REFLECTED CEILING PLAN
3RD FLOOR SCALE 1:50

4 ID1.3.0 REFLECTED CEILING PLAN
3RD FLOOR SCALE 1:50

DO NOT SCALE DRAWINGS.

CONTRACTOR MUST VERIFY ALL DRAWINGS, DIMENSIONS, DETAILS AND SPECIFICATIONS, AND REPORT ANY DISCREPANCIES TO *UNION 31 INC.* BEFORE PROCEEDING WITH WORK. MATERIALS MAY NOT BE SUBSTITUTED WITHOUT WRITTEN APPROVAL FROM *UNION 31 INC.*

ALL DRAWINGS AND SPECIFICATIONS ARE INSTRUMENTS OF SERVICE AND THE PROPERTY OF *UNION 31 INC.* WHICH MUST BE RETURNED AT THE COMPLETION OF THE WORK.

PRINTED: 30-May-17

ISSUED FOR AS-BUILT

NO.	DATE	COMMENTS	INI
01	31 MAY / 17	ISSUED FOR AS-BUILT	SV

REVISIONS:

UNION31

UNION31 INC.
183 BATHURST STREET, STE 201
TORONTO, ON, M5T 2R7, CANADA
TEL: 416-597-1576 FAX: 416-597-2139

PROJECT NAME:
ALEXANDRA PARK
MAIN BUILDING
BLOCK 11
ON, Canada

PROJECT NO.: 13-949

DRAWING/S:
3RD FLOOR
CONSTRUCTION PLAN &
REFLECTED CEILING PLAN

DATE STARTED:	07 AUG / 13	DRAWING NO.:	ID 1.3.0
SCALE:	1 : 50		
DRAWN BY:	AP		
APPROVED BY:	KC		

36 x 48

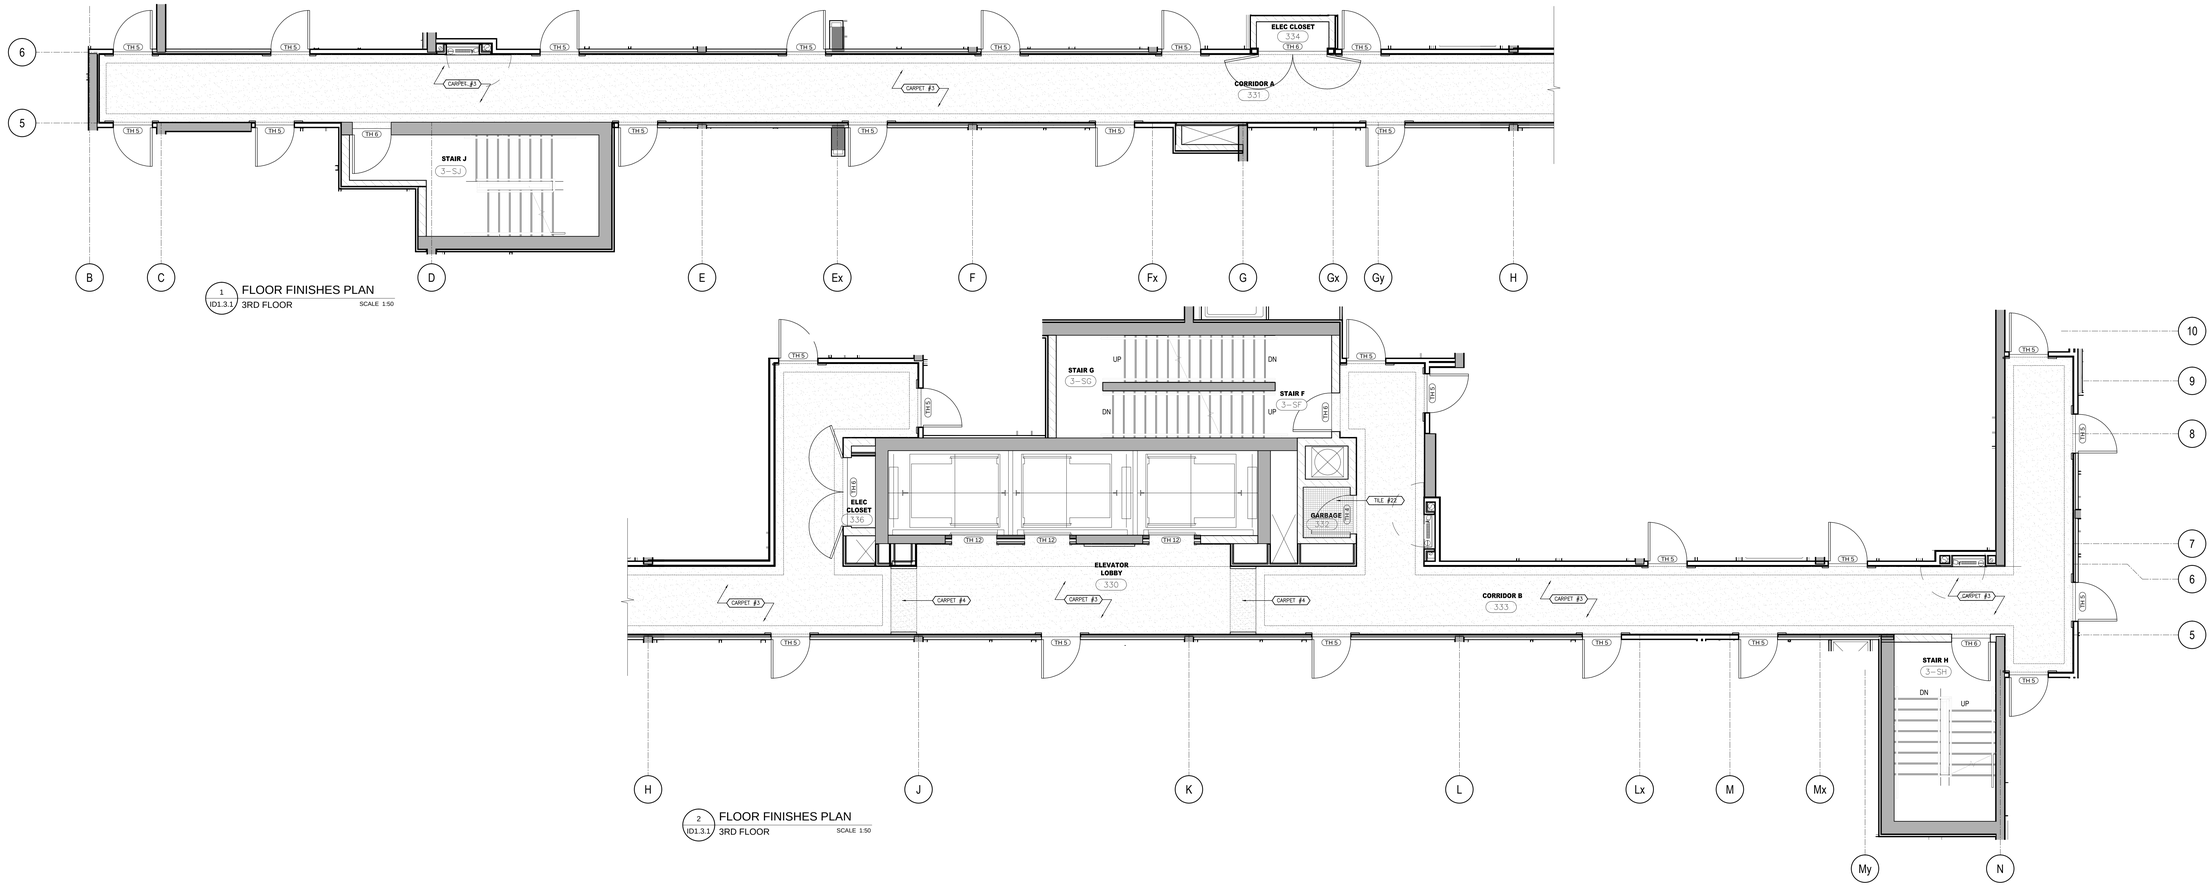

1 ID1.3.1 FLOOR FINISHES PLAN — 3RD FLOOR — SCALE 1:50

2 ID1.3.1 FLOOR FINISHES PLAN — 3RD FLOOR — SCALE 1:50

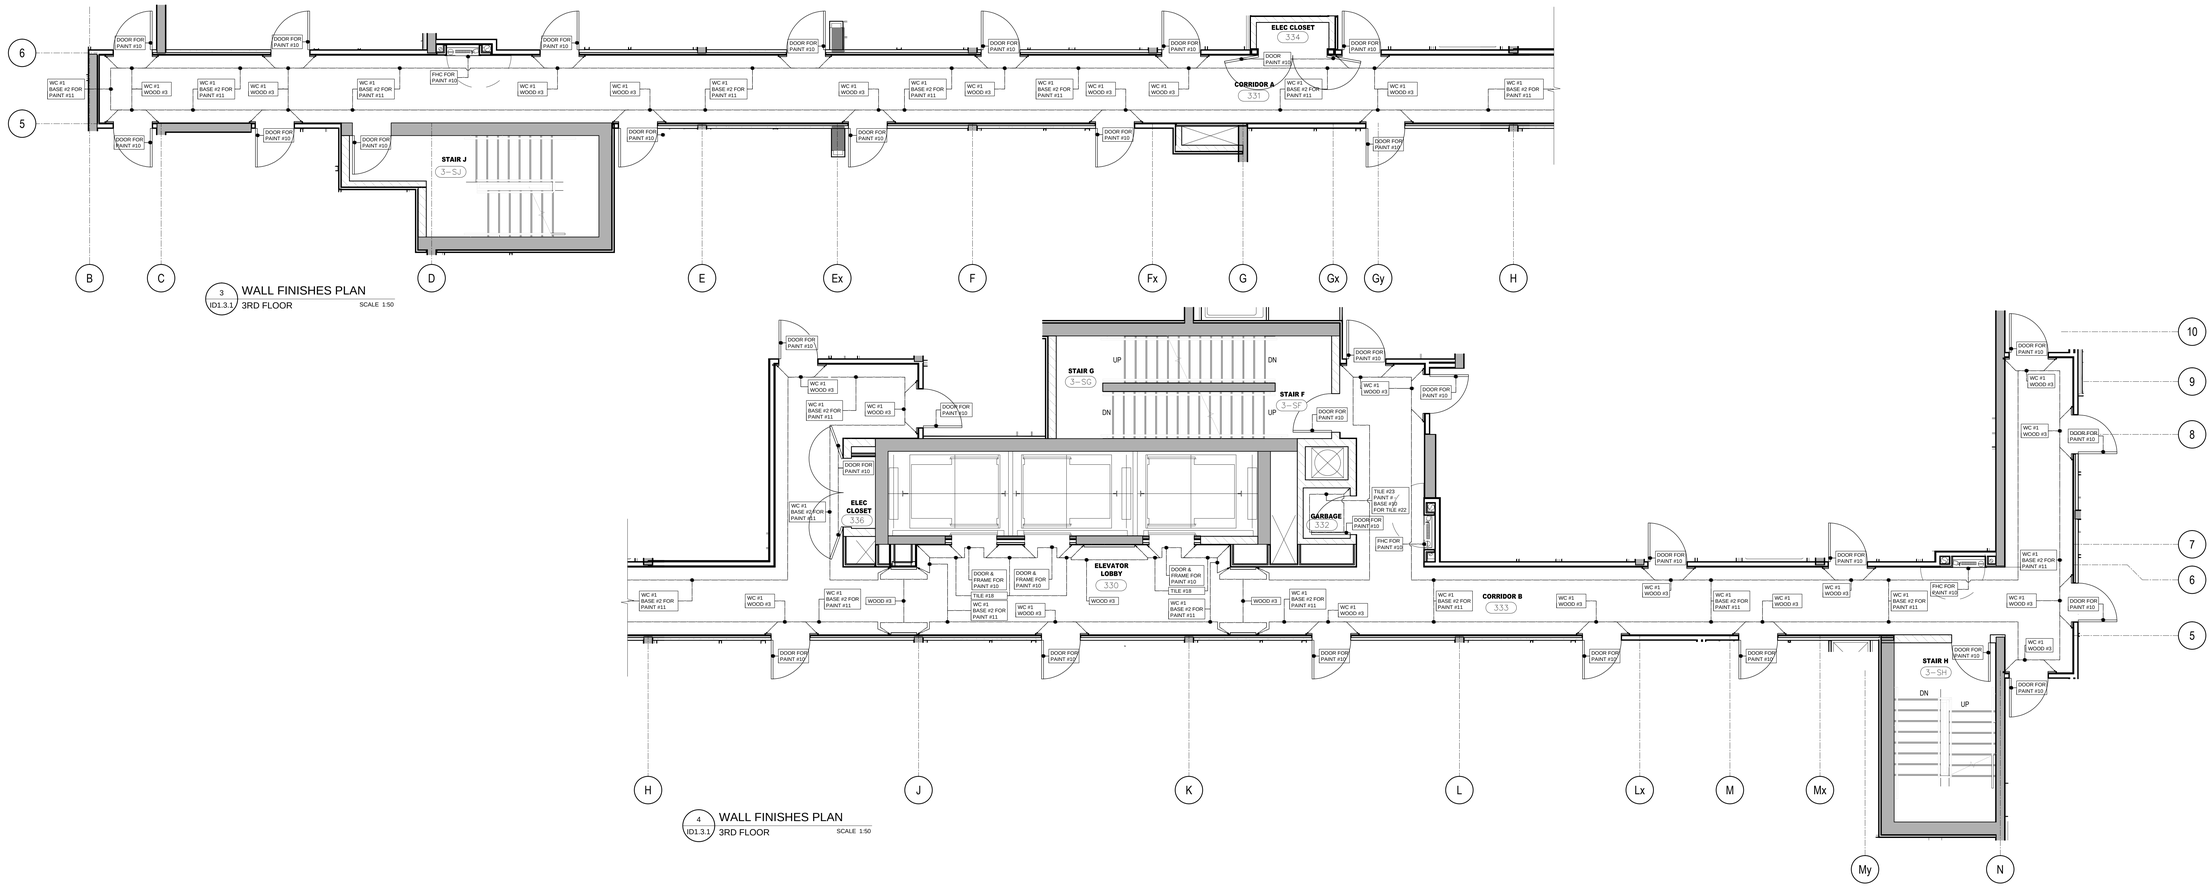

3 ID1.3.1 WALL FINISHES PLAN — 3RD FLOOR — SCALE 1:50

4 ID1.3.1 WALL FINISHES PLAN — 3RD FLOOR — SCALE 1:50

DO NOT SCALE DRAWINGS.

CONTRACTOR MUST VERIFY ALL DRAWINGS, DIMENSIONS, DETAILS AND SPECIFICATIONS, AND REPORT ANY DISCREPANCIES TO *UNION 31 INC.* BEFORE PROCEEDING WITH WORK. MATERIALS MAY NOT BE SUBSTITUTED WITHOUT WRITTEN APPROVAL FROM *UNION 31 INC.*

ALL DRAWINGS AND SPECIFICATIONS ARE INSTRUMENTS OF SERVICE AND THE PROPERTY OF *UNION 31 INC.* WHICH MUST BE RETURNED AT THE COMPLETION OF THE WORK.

PRINTED: 30-May-17

ISSUED FOR AS-BUILT

NO.	DATE	COMMENTS	INI
01	31 MAY / 17	ISSUED FOR AS-BUILT	SV

REVISIONS:

UNION31

UNION31 INC.
183 BATHURST STREET, STE 201
TORONTO, ON, M5T 2R7, CANADA
TEL: 416-597-1576 FAX: 416-597-2139

PROJECT NAME:
ALEXANDRA PARK
MAIN BUILDING
BLOCK 11
ON, Canada

PROJECT NO.: 13-949

DRAWING/S:
3RD FLOOR
FLOOR FINISHES PLAN &
WALL FINISHES PLAN

DATE STARTED:	07 AUG / 13	DRAWING NO.:	ID 1.3.1
SCALE:	1 : 50		
DRAWN BY:	AP		
APPROVED BY:	KC		

36 x 48

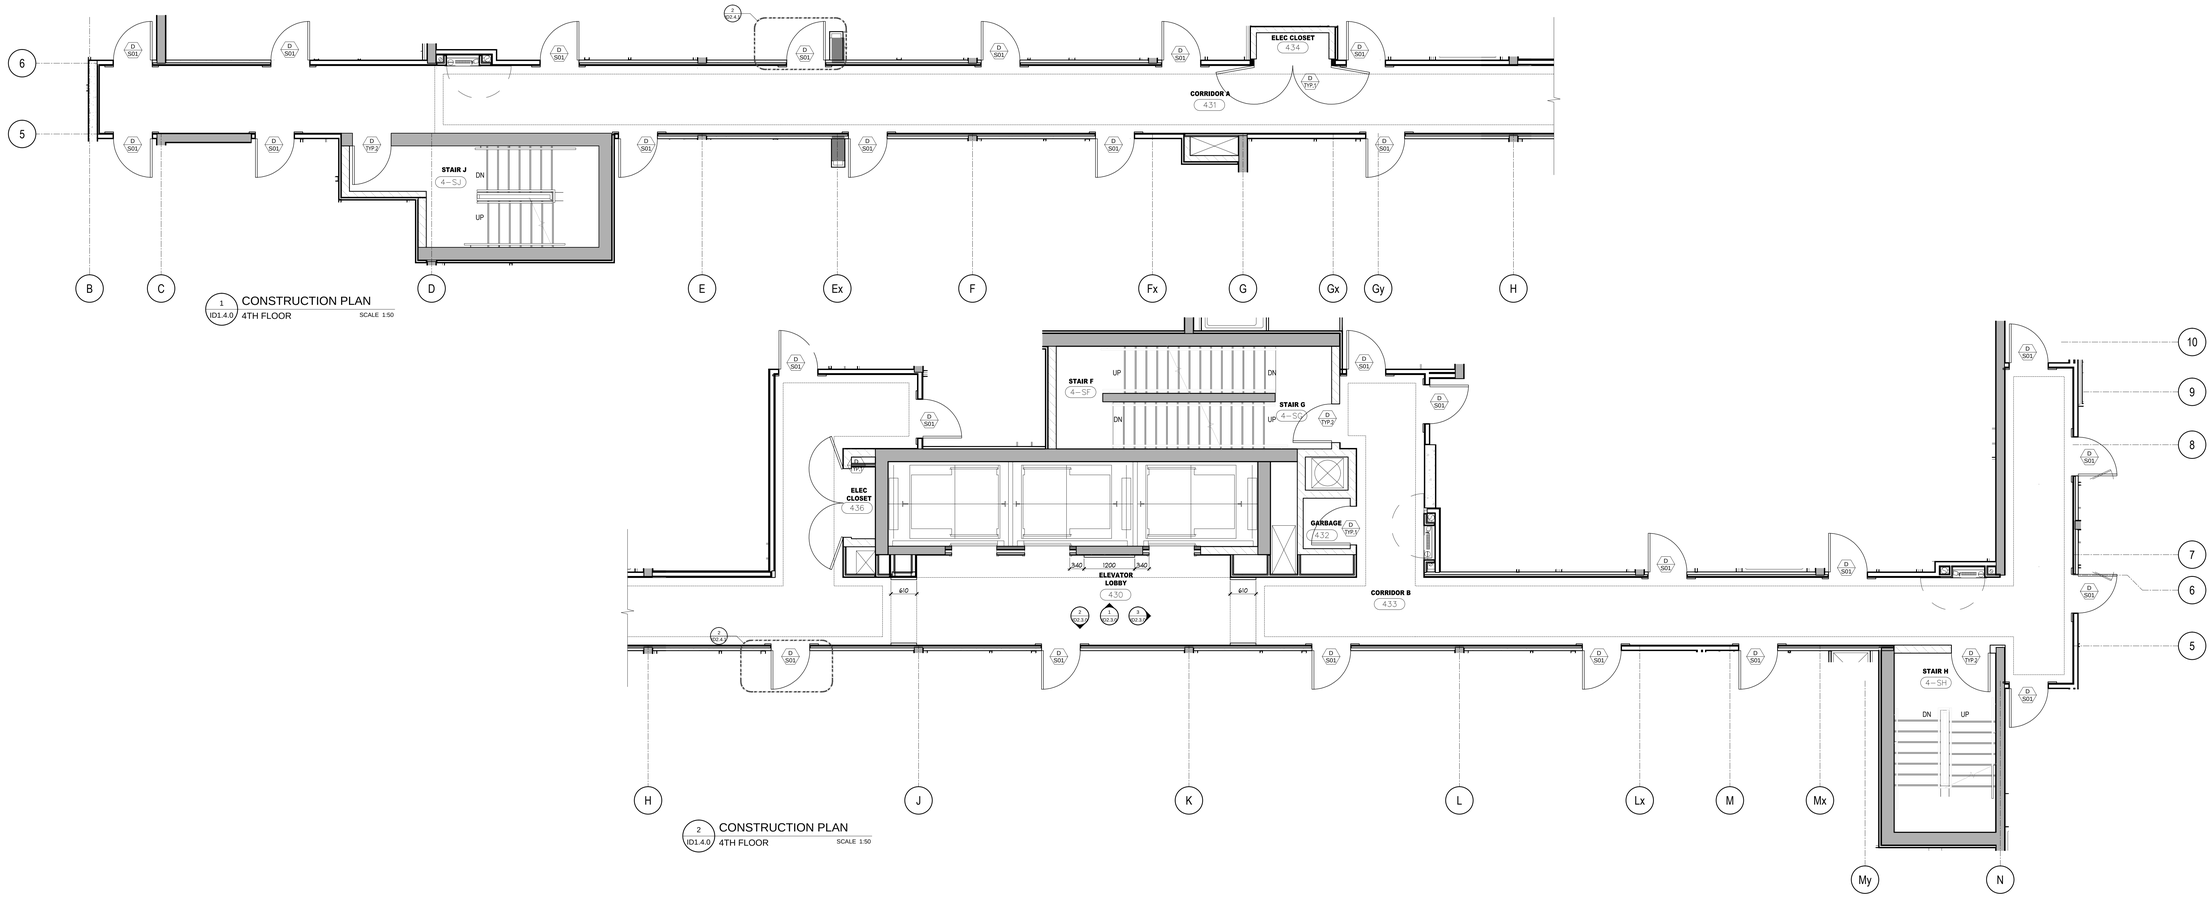

1 ID1.4.0 CONSTRUCTION PLAN 4TH FLOOR SCALE 1:50

2 ID1.4.0 CONSTRUCTION PLAN 4TH FLOOR SCALE 1:50

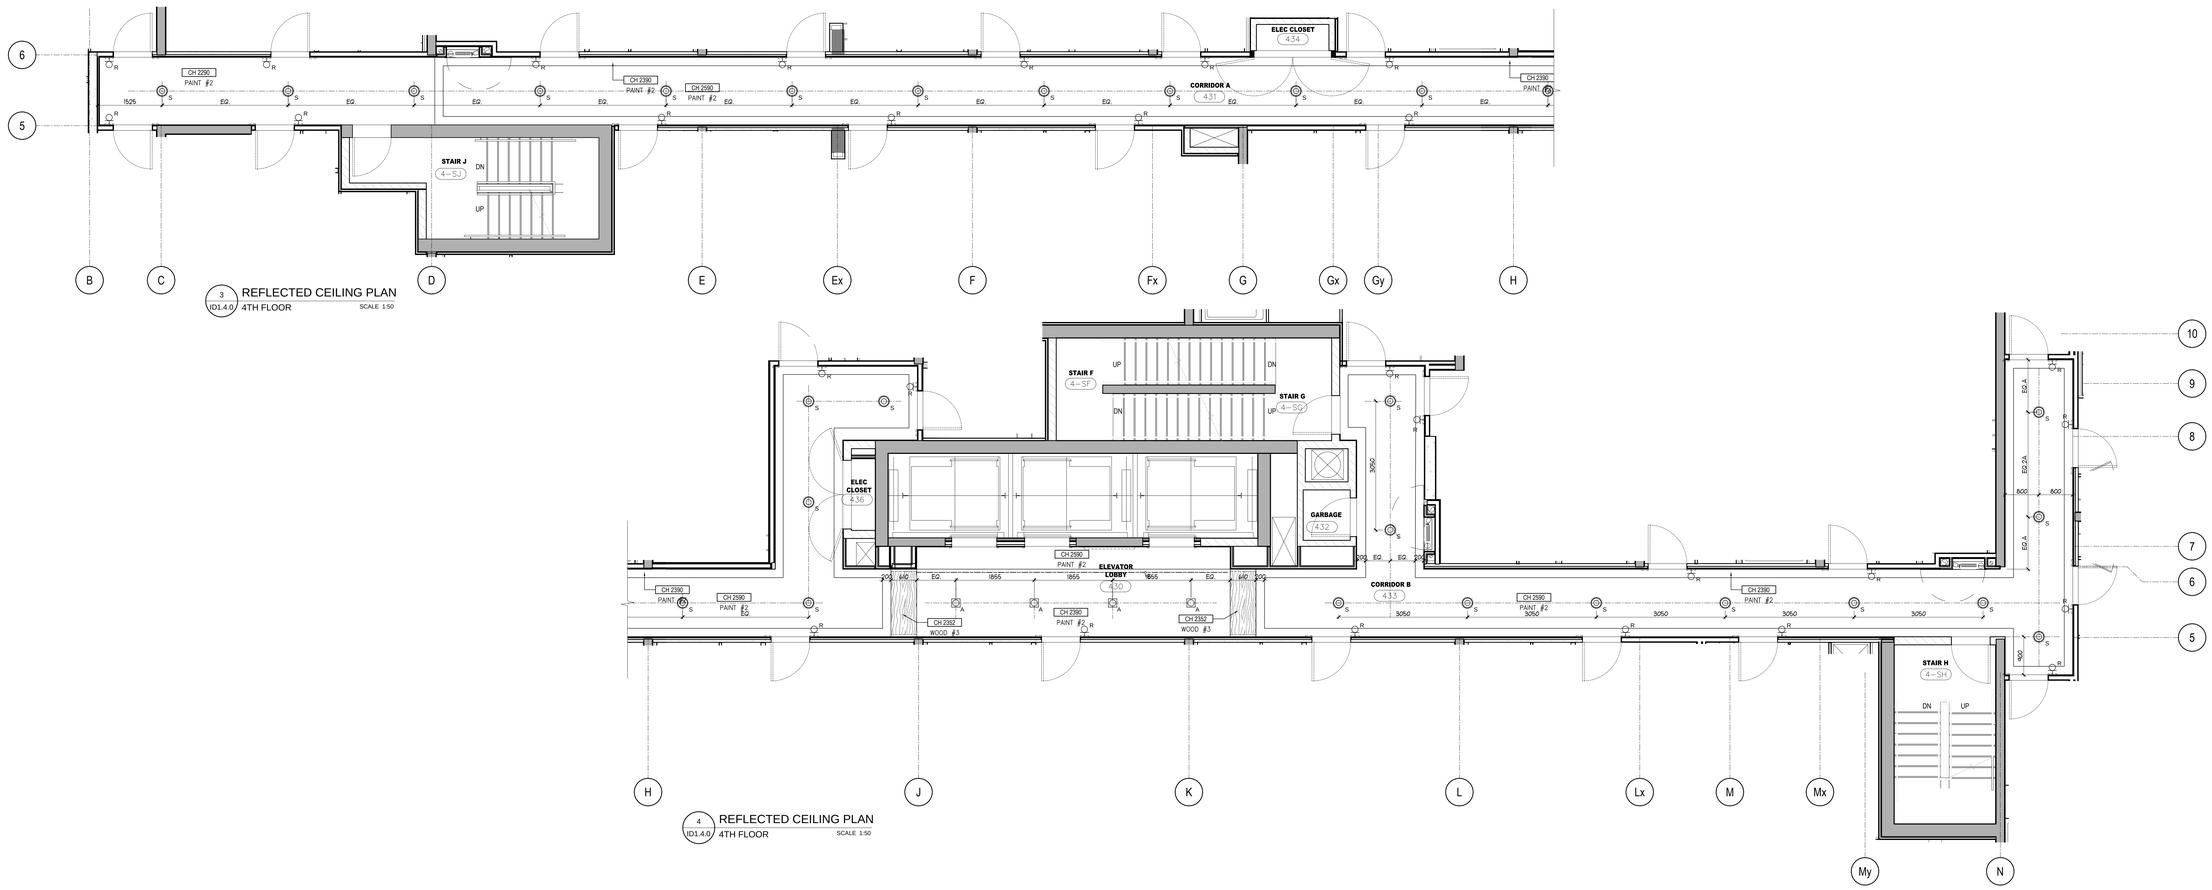

3 ID1.4.0 REFLECTED CEILING PLAN 4TH FLOOR SCALE 1:50

4 ID1.4.0 REFLECTED CEILING PLAN 4TH FLOOR SCALE 1:50

DO NOT SCALE DRAWINGS.

CONTRACTOR MUST VERIFY ALL DRAWINGS, DIMENSIONS, DETAILS AND SPECIFICATIONS, AND REPORT ANY DISCREPANCIES TO *UNION 31 INC.* BEFORE PROCEEDING WITH WORK. MATERIALS MAY NOT BE SUBSTITUTED WITHOUT WRITTEN APPROVAL FROM *UNION 31 INC.*

ALL DRAWINGS AND SPECIFICATIONS ARE INSTRUMENTS OF SERVICE AND THE PROPERTY OF *UNION 31 INC.* WHICH MUST BE RETURNED AT THE COMPLETION OF THE WORK.

PRINTED: 30-May-17

ISSUED FOR AS-BUILT

NO.	DATE	COMMENTS	INI
01	31 MAY / 17	ISSUED FOR AS-BUILT	SV

REVISIONS:

UNION31

UNION31 INC.
183 BATHURST STREET, STE 201
TORONTO, ON, M5T 2R7, CANADA
TEL: 416-597-1576 FAX: 416-597-2139

PROJECT NAME:
ALEXANDRA PARK
MAIN BUILDING
BLOCK 11
ON, Canada

PROJECT NO.: 13-949

DRAWING/S:
4TH FLOOR
CONSTRUCTION PLAN &
REFLECTED CEILING PLAN

DATE STARTED:	07 AUG / 13	DRAWING NO.:	ID 1.4.0
SCALE:	1 : 50		
DRAWN BY:	AP		
APPROVED BY:	KC		

36 x 48

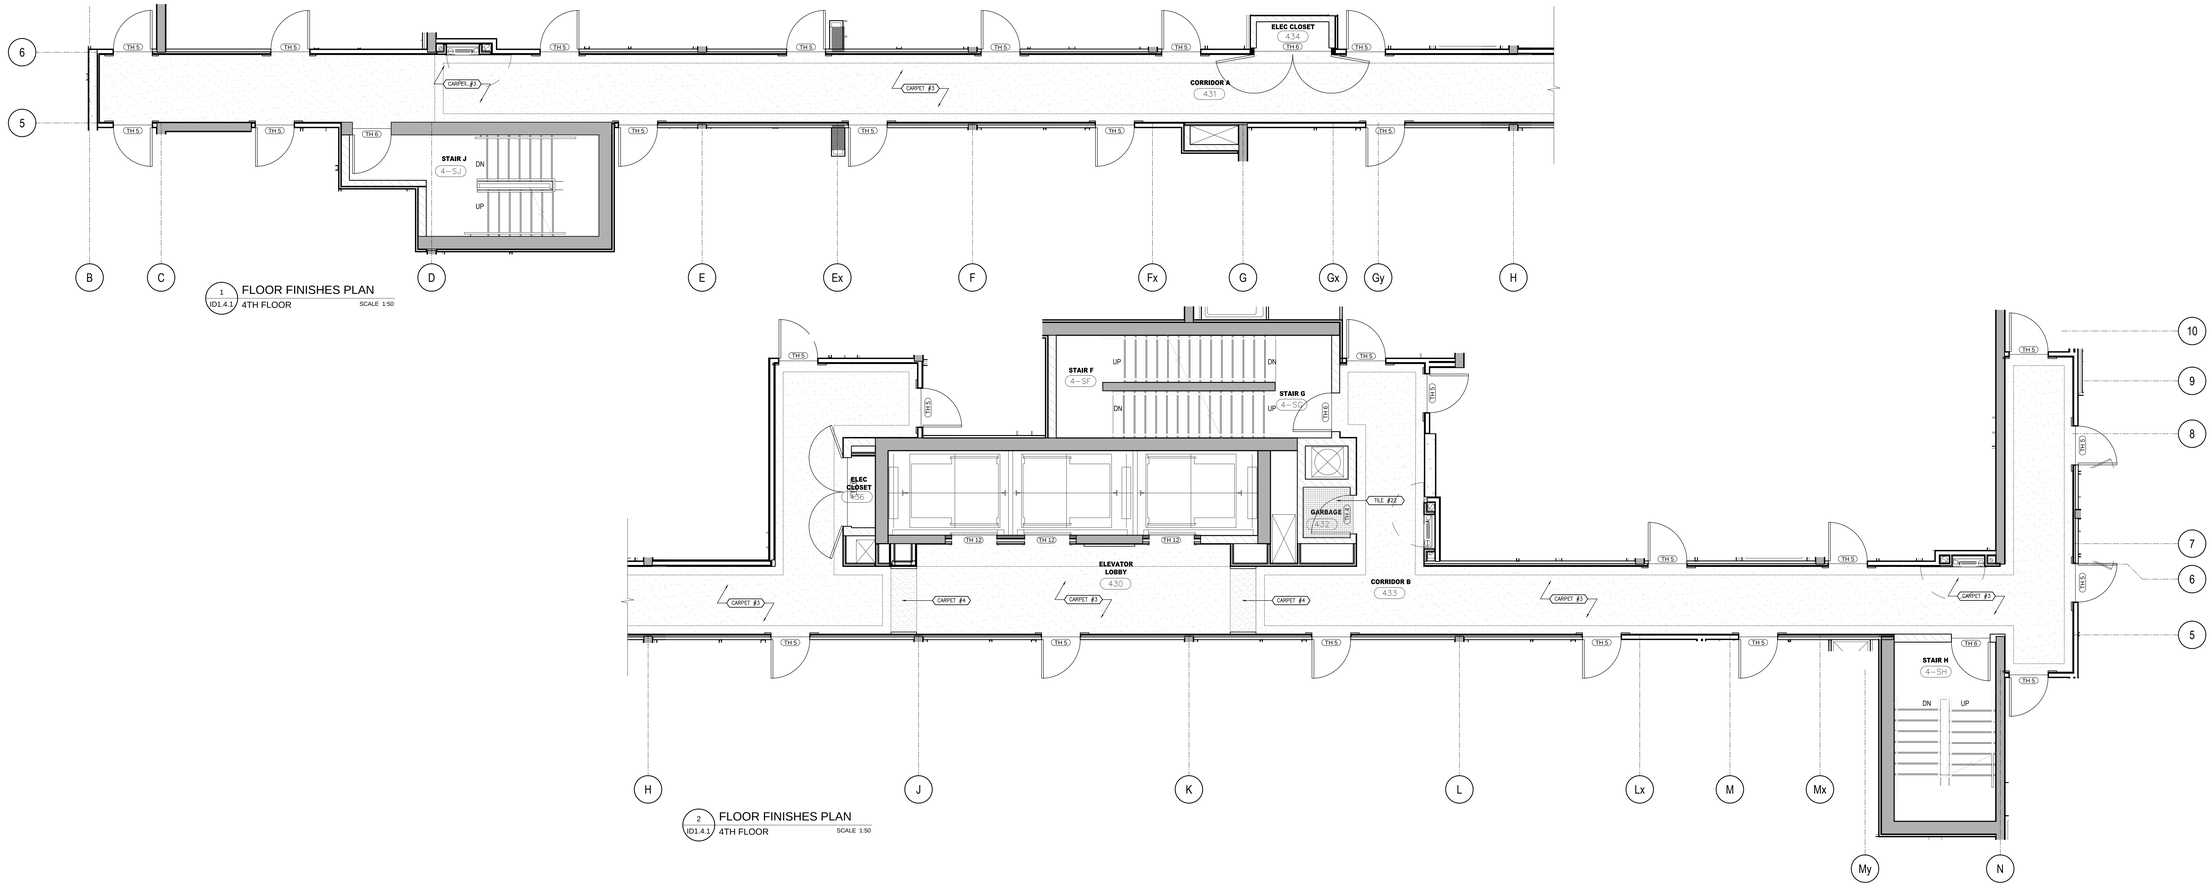

1 / ID1.4.1 FLOOR FINISHES PLAN — 4TH FLOOR — SCALE 1:50

2 / ID1.4.1 FLOOR FINISHES PLAN — 4TH FLOOR — SCALE 1:50

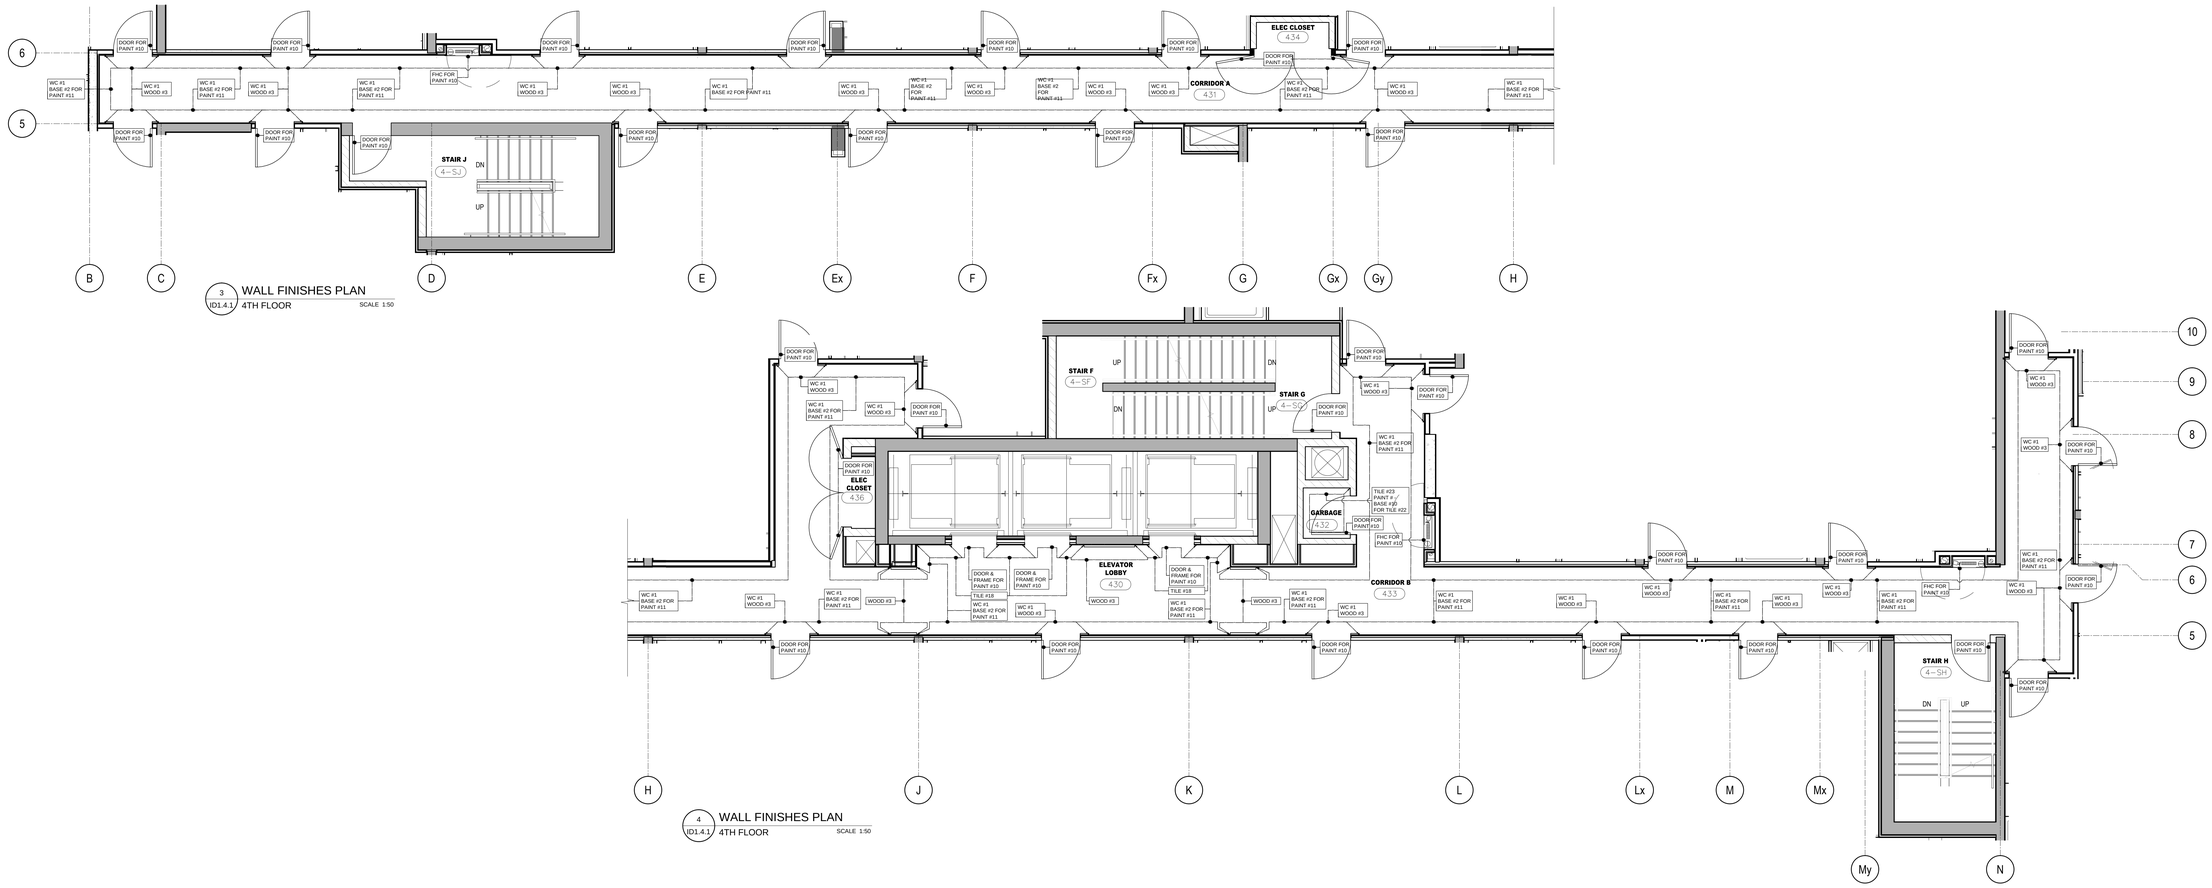

3 / ID1.4.1 WALL FINISHES PLAN — 4TH FLOOR — SCALE 1:50

4 / ID1.4.1 WALL FINISHES PLAN — 4TH FLOOR — SCALE 1:50

DO NOT SCALE DRAWINGS.

CONTRACTOR MUST VERIFY ALL DRAWINGS, DIMENSIONS, DETAILS AND SPECIFICATIONS, AND REPORT ANY DISCREPANCIES TO *UNION 31 INC.* BEFORE PROCEEDING WITH WORK. MATERIALS MAY NOT BE SUBSTITUTED WITHOUT WRITTEN APPROVAL FROM *UNION 31 INC.*

ALL DRAWINGS AND SPECIFICATIONS ARE INSTRUMENTS OF SERVICE AND THE PROPERTY OF *UNION 31 INC.* WHICH MUST BE RETURNED AT THE COMPLETION OF THE WORK.

PRINTED: 30-May-17

ISSUED FOR AS-BUILT

NO.	DATE	COMMENTS	INI
01	31 MAY / 17	ISSUED FOR AS-BUILT	SV

REVISIONS:

UNION31

UNION31 INC.
183 BATHURST STREET, STE 201
TORONTO, ON, M5T 2R7, CANADA
TEL: 416-597-1576 FAX: 416-597-2139

PROJECT NAME:
ALEXANDRA PARK
MAIN BUILDING
BLOCK 11
ON, Canada

PROJECT NO.: 13-949

DRAWING/S:
4TH FLOOR
FLOOR FINISHES PLAN &
WALL FINISHES PLAN

DATE STARTED:	07 AUG / 13	DRAWING NO.:	ID 1.4.1
SCALE:	1 : 50		
DRAWN BY:	AP		
APPROVED BY:	KC		

36 x 48

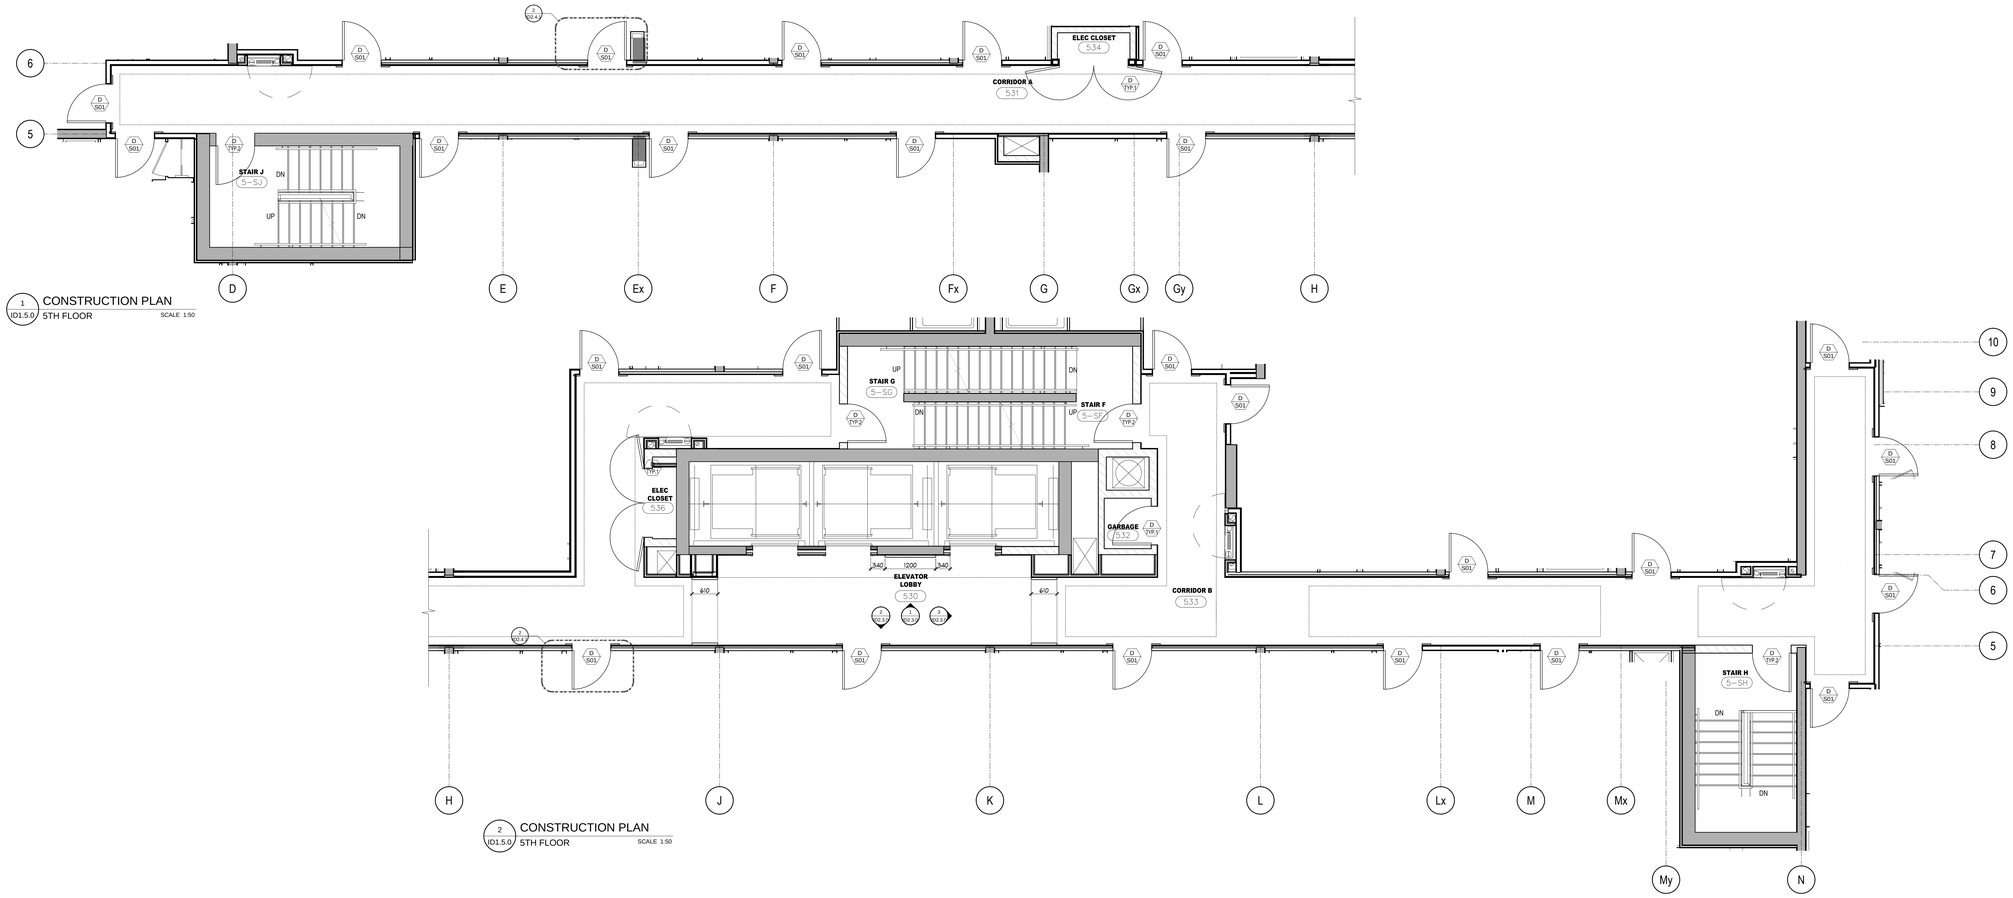

1 ID1.5.0 CONSTRUCTION PLAN
5TH FLOOR
SCALE 1:50

2 ID1.5.0 CONSTRUCTION PLAN
5TH FLOOR
SCALE 1:50

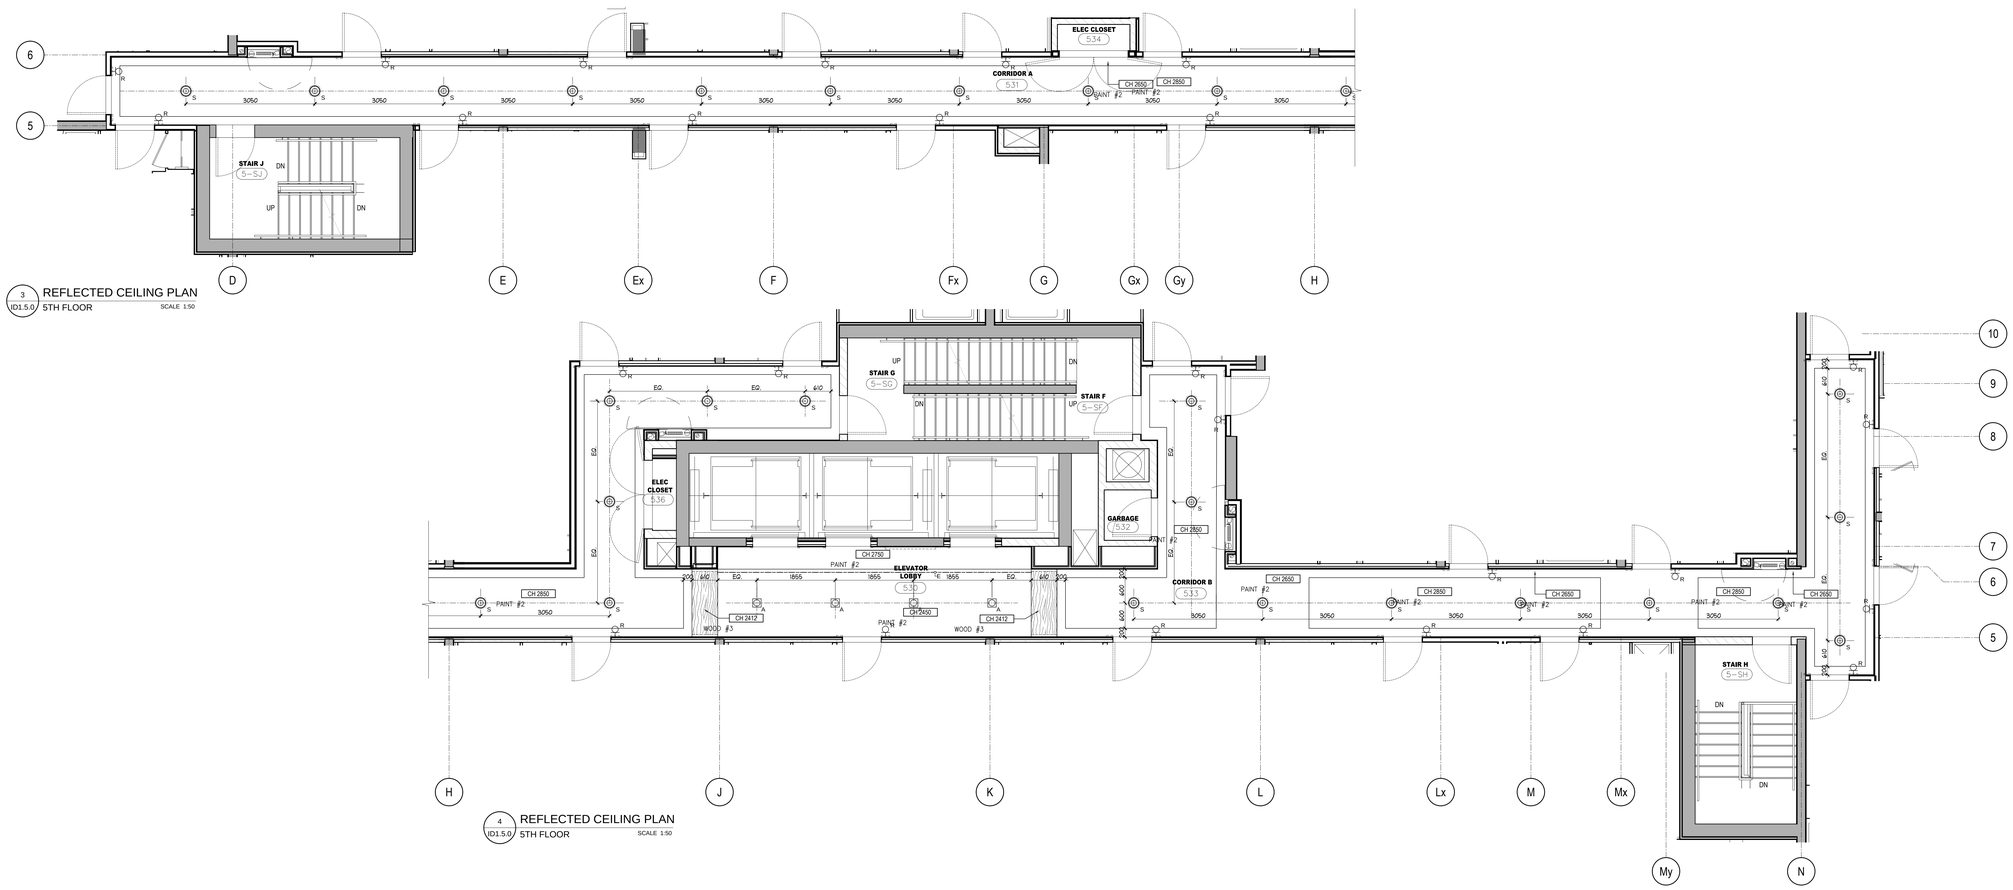

3 ID1.5.0 REFLECTED CEILING PLAN
5TH FLOOR
SCALE 1:50

4 ID1.5.0 REFLECTED CEILING PLAN
5TH FLOOR
SCALE 1:50

DO NOT SCALE DRAWINGS.

CONTRACTOR MUST VERIFY ALL DRAWINGS, DIMENSIONS, DETAILS AND SPECIFICATIONS, AND REPORT ANY DISCREPANCIES TO *UNION 31 INC.* BEFORE PROCEEDING WITH WORK. MATERIALS MAY NOT BE SUBSTITUTED WITHOUT WRITTEN APPROVAL FROM *UNION 31 INC.*

ALL DRAWINGS AND SPECIFICATIONS ARE INSTRUMENTS OF SERVICE AND THE PROPERTY OF *UNION 31 INC.* WHICH MUST BE RETURNED AT THE COMPLETION OF THE WORK.

PRINTED: 30-May-17

ISSUED FOR AS-BUILT

NO.	DATE	COMMENTS	INI
01	31 MAY / 17	ISSUED FOR AS-BUILT	SV

REVISIONS:

UNION31

UNION31 INC.
183 BATHURST STREET, STE 201
TORONTO, ON, M5T 2R7, CANADA
TEL: 416-597-1576 FAX: 416-597-2139

PROJECT NAME:
ALEXANDRA PARK
MAIN BUILDING
BLOCK 11
ON, Canada

PROJECT NO.: 13-949

DRAWING/S:
5TH FLOOR
CONSTRUCTION PLAN &
REFLECTED CEILING PLAN

DATE STARTED:	07 AUG / 13	DRAWING NO.:	ID 1.5.0
SCALE:	1 : 50		
DRAWN BY:	AP		
APPROVED BY:	KC		

36 x 48

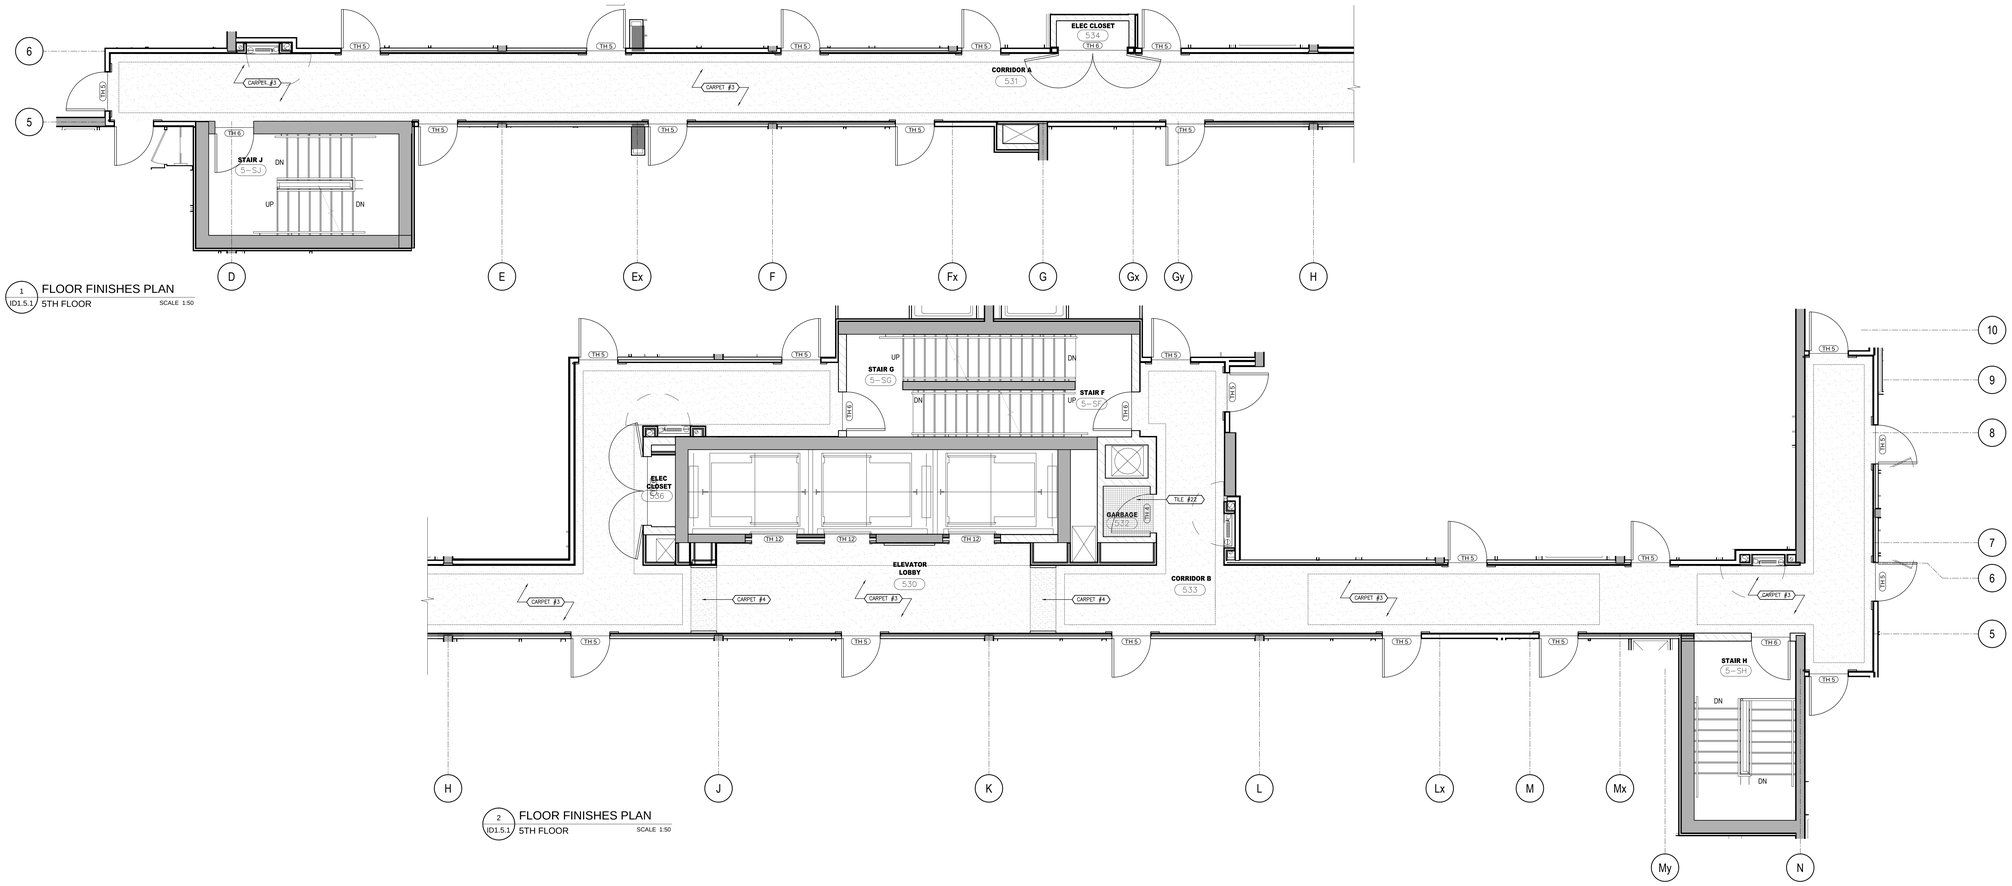

1 ID1.5.1 FLOOR FINISHES PLAN
5TH FLOOR SCALE 1:50

2 ID1.5.1 FLOOR FINISHES PLAN
5TH FLOOR SCALE 1:50

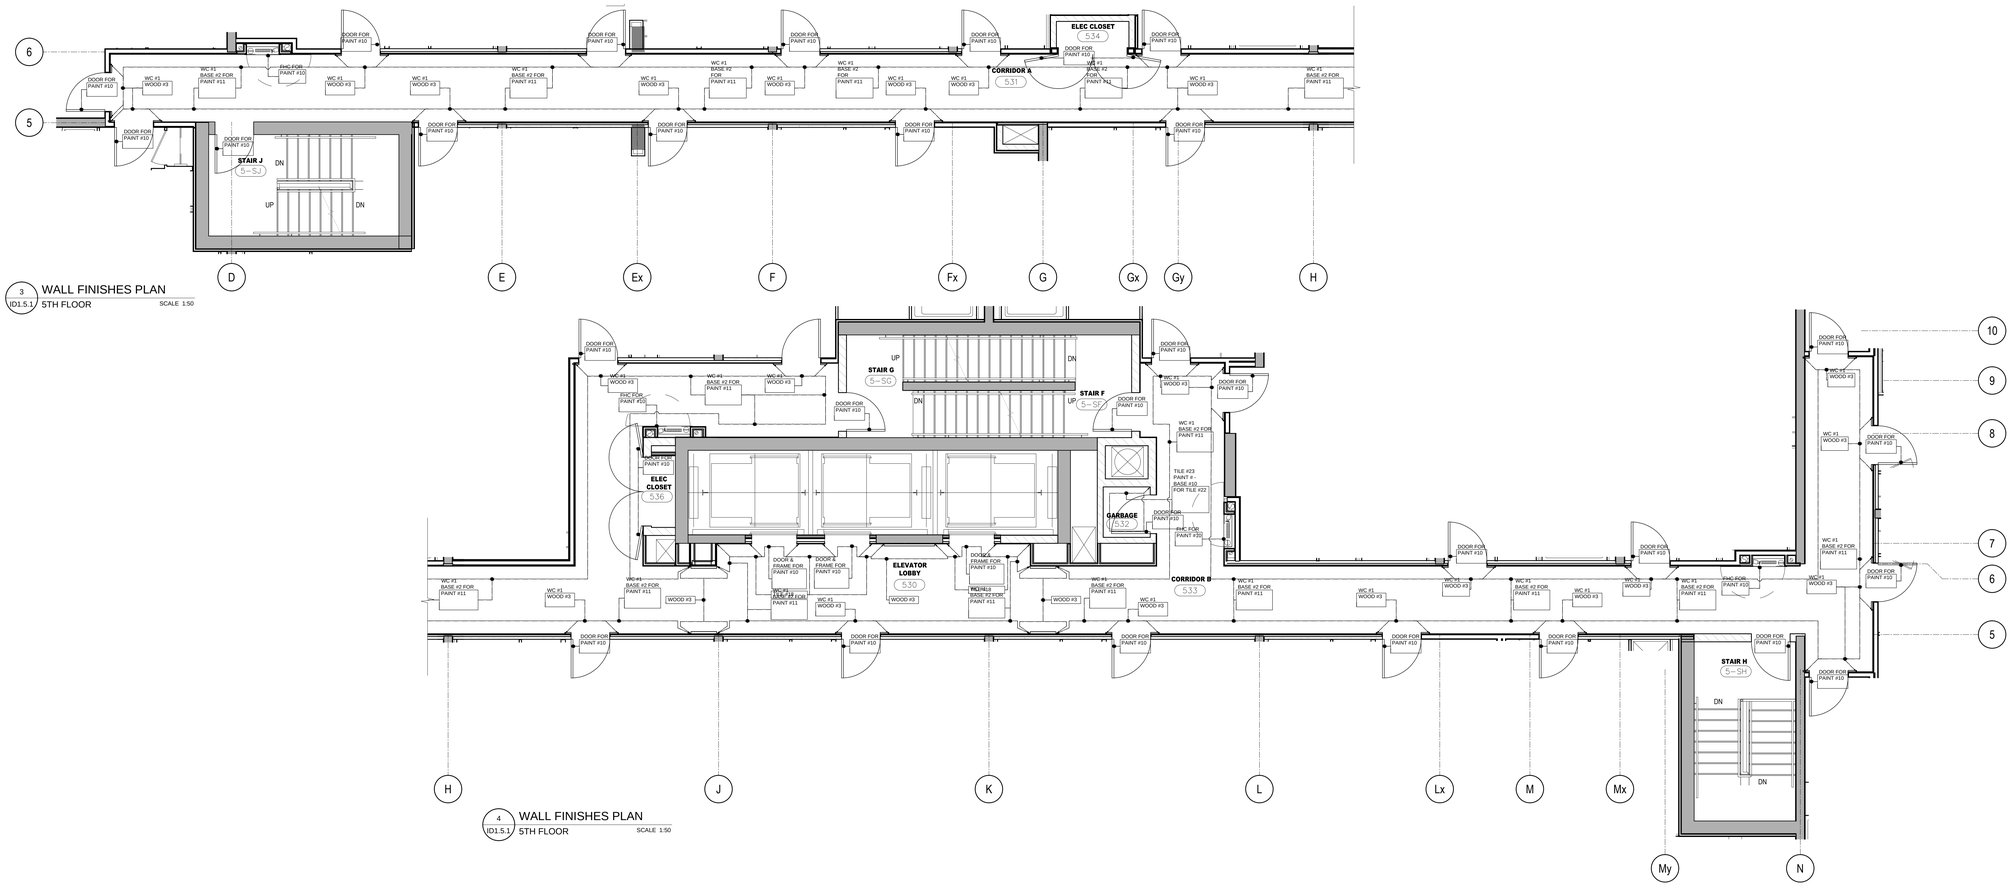

3 ID1.5.1 WALL FINISHES PLAN
5TH FLOOR SCALE 1:50

4 ID1.5.1 WALL FINISHES PLAN
5TH FLOOR SCALE 1:50

DO NOT SCALE DRAWINGS.

CONTRACTOR MUST VERIFY ALL DRAWINGS, DIMENSIONS, DETAILS AND SPECIFICATIONS, AND REPORT ANY DISCREPANCIES TO *UNION 31 INC.* BEFORE PROCEEDING WITH WORK. MATERIALS MAY NOT BE SUBSTITUTED WITHOUT WRITTEN APPROVAL FROM *UNION 31 INC.*

ALL DRAWINGS AND SPECIFICATIONS ARE INSTRUMENTS OF SERVICE AND THE PROPERTY OF *UNION 31 INC.* WHICH MUST BE RETURNED AT THE COMPLETION OF THE WORK.

PRINTED: 30-May-17

ISSUED FOR AS-BUILT

NO.	DATE	COMMENTS	INI
01	31 MAY / 17	ISSUED FOR AS-BUILT	SV

REVISIONS:

UNION31

UNION31 INC.
183 BATHURST STREET, STE 201
TORONTO, ON, M5T 2R7, CANADA
TEL: 416-597-1576 FAX: 416-597-2139

PROJECT NAME:
ALEXANDRA PARK
MAIN BUILDING
BLOCK 11
ON, Canada

PROJECT NO.: 13-949

DRAWING/S:
5TH FLOOR
FLOOR FINISHES PLAN &
WALL FINISHES PLAN

DATE STARTED:	07 AUG / 13	DRAWING NO.:	ID 1.5.1
SCALE:	1 : 50		
DRAWN BY:	AP		
APPROVED BY:	KC		

36 x 48

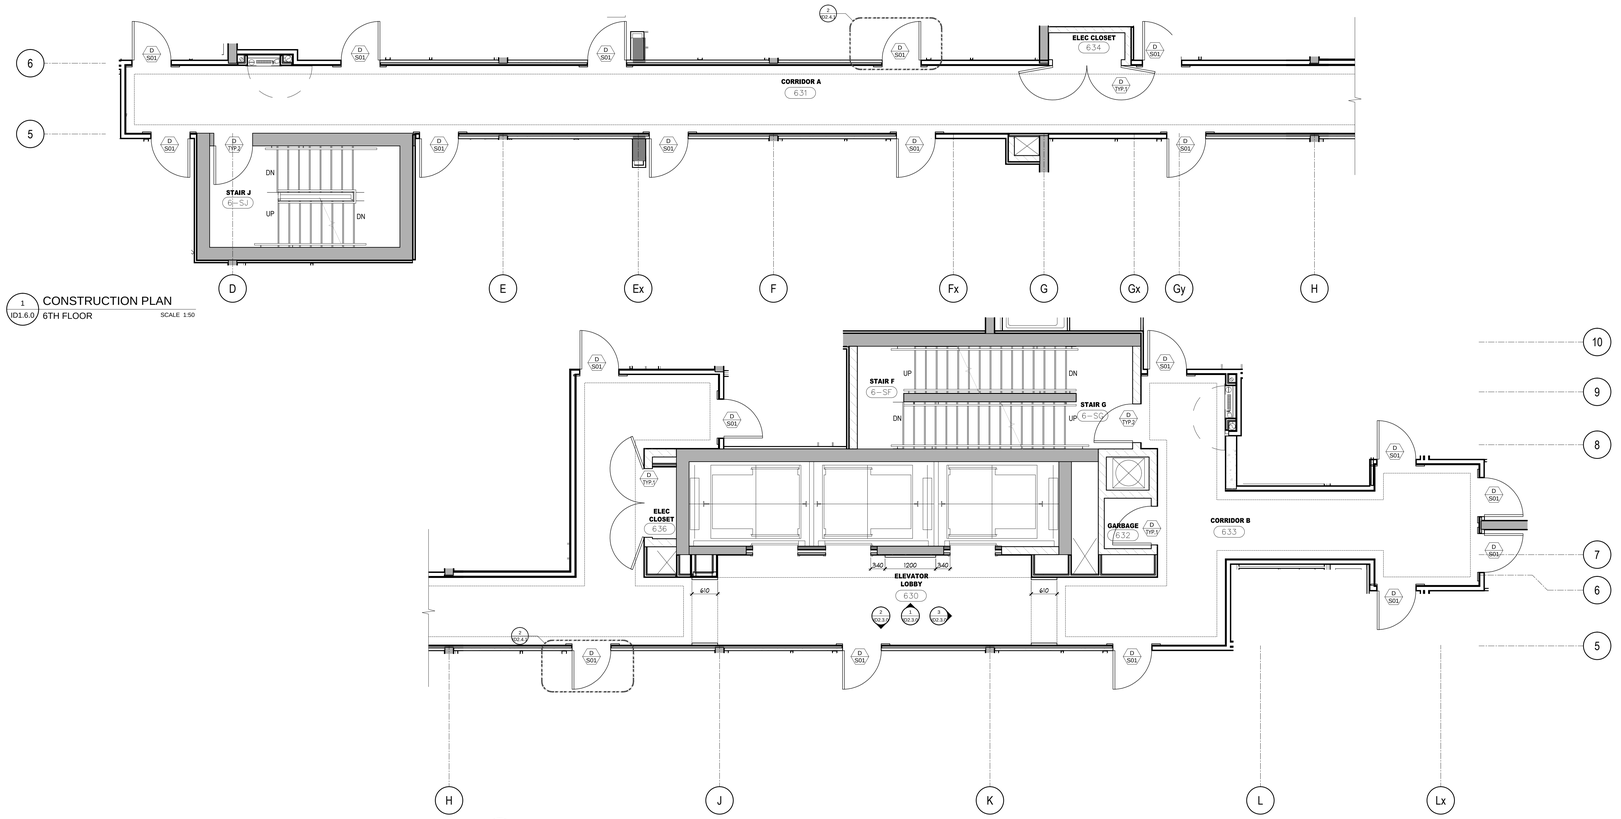

1 ID1.6.0 CONSTRUCTION PLAN 6TH FLOOR SCALE 1:50

2 ID1.6.0 CONSTRUCTION PLAN 6TH FLOOR SCALE 1:50

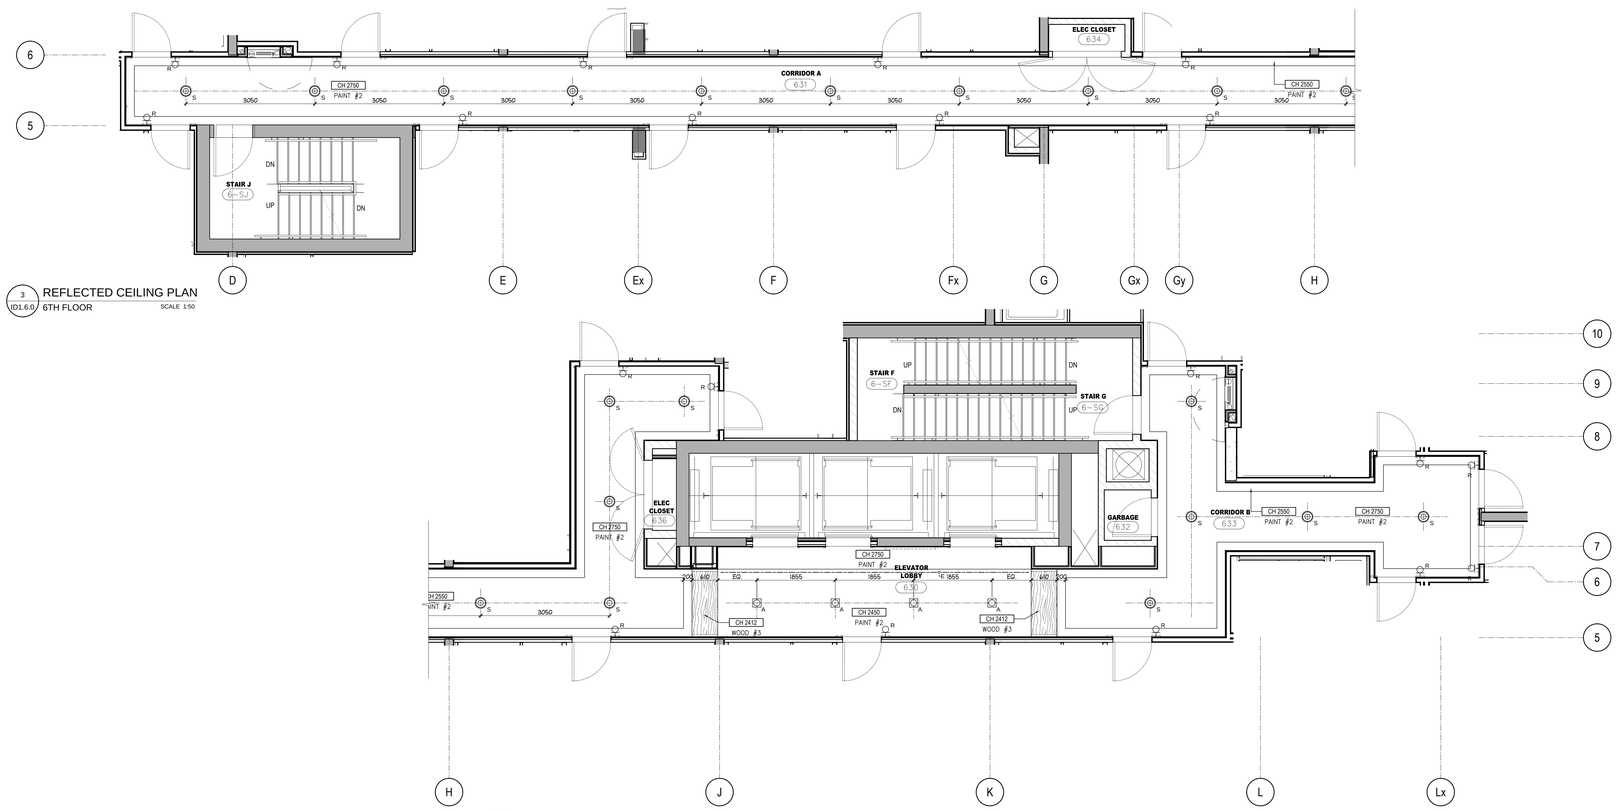

3 ID1.6.0 REFLECTED CEILING PLAN 6TH FLOOR SCALE 1:50

4 ID1.6.0 REFLECTED CEILING PLAN 6TH FLOOR SCALE 1:50

DO NOT SCALE DRAWINGS.

CONTRACTOR MUST VERIFY ALL DRAWINGS, DIMENSIONS, DETAILS AND SPECIFICATIONS, AND REPORT ANY DISCREPANCIES TO *UNION 31 INC.* BEFORE PROCEEDING WITH WORK. MATERIALS MAY NOT BE SUBSTITUTED WITHOUT WRITTEN APPROVAL FROM *UNION 31 INC.*

ALL DRAWINGS AND SPECIFICATIONS ARE INSTRUMENTS OF SERVICE AND THE PROPERTY OF *UNION 31 INC.* WHICH MUST BE RETURNED AT THE COMPLETION OF THE WORK.

PRINTED: 30-May-17

ISSUED FOR AS-BUILT

NO.	DATE	COMMENTS	INI
01	31 MAY / 17	ISSUED FOR AS-BUILT	SV

REVISIONS:

UNION31

UNION31 INC.
183 BATHURST STREET, STE 201
TORONTO, ON, M5T 2R7, CANADA
TEL: 416-597-1576 FAX: 416-597-2139

PROJECT NAME:
ALEXANDRA PARK
MAIN BUILDING
BLOCK 11
ON, Canada

PROJECT NO.: 13-949

DRAWING/S:
6TH FLOOR
CONSTRUCTION PLAN &
REFLECTED CEILING PLAN

DATE STARTED:	07 AUG / 13	DRAWING NO.:	ID 1.6.0
SCALE:	1 : 50		
DRAWN BY:	AP		
APPROVED BY:	KC		

36 x 48

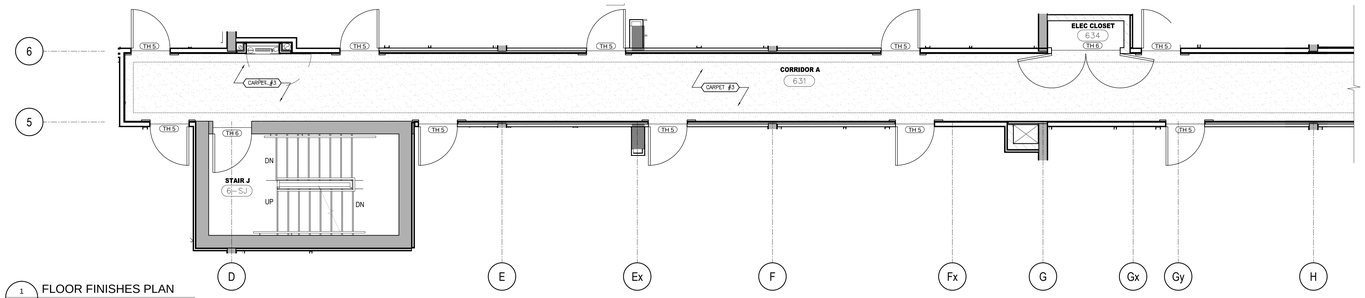

1 ID1.6.1 FLOOR FINISHES PLAN
6TH FLOOR
SCALE 1:50

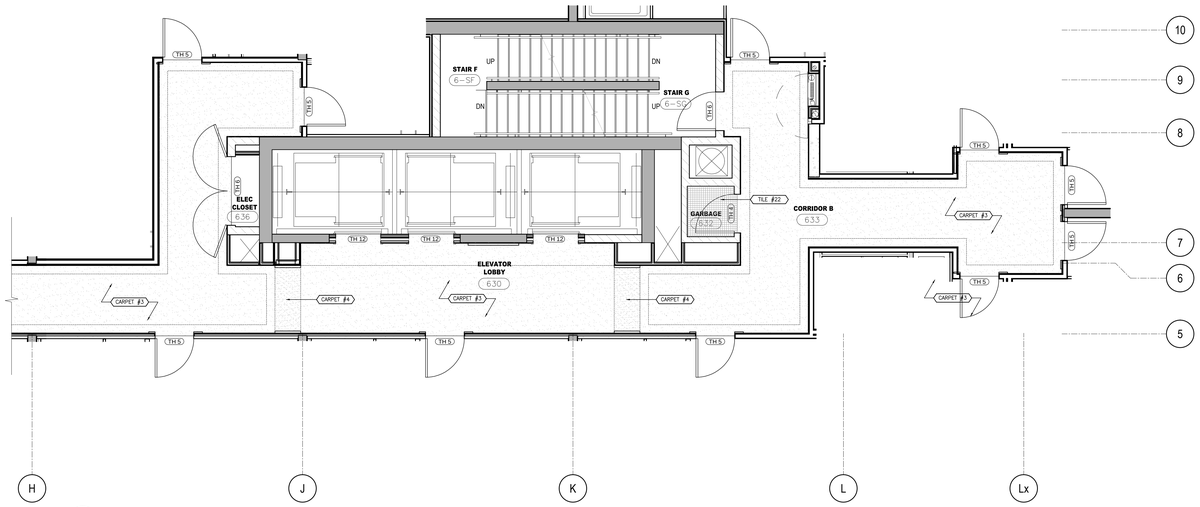

2 ID1.6.1 FLOOR FINISHES PLAN
6TH FLOOR
SCALE 1:50

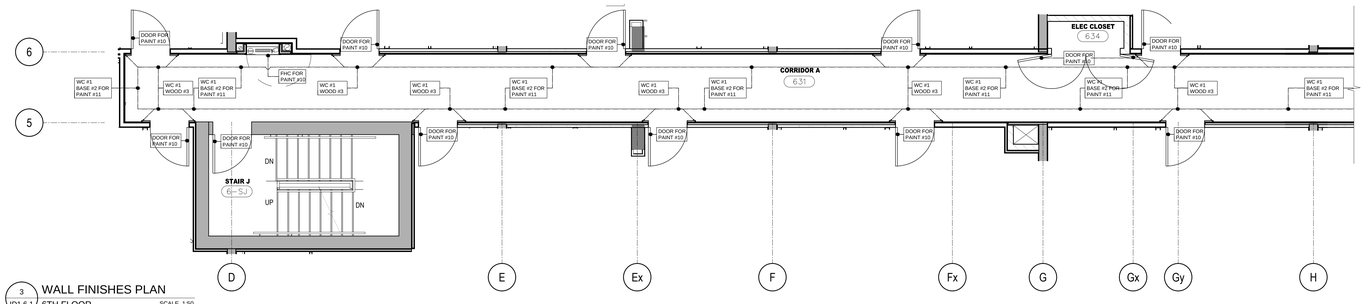

3 ID1.6.1 WALL FINISHES PLAN
6TH FLOOR
SCALE 1:50

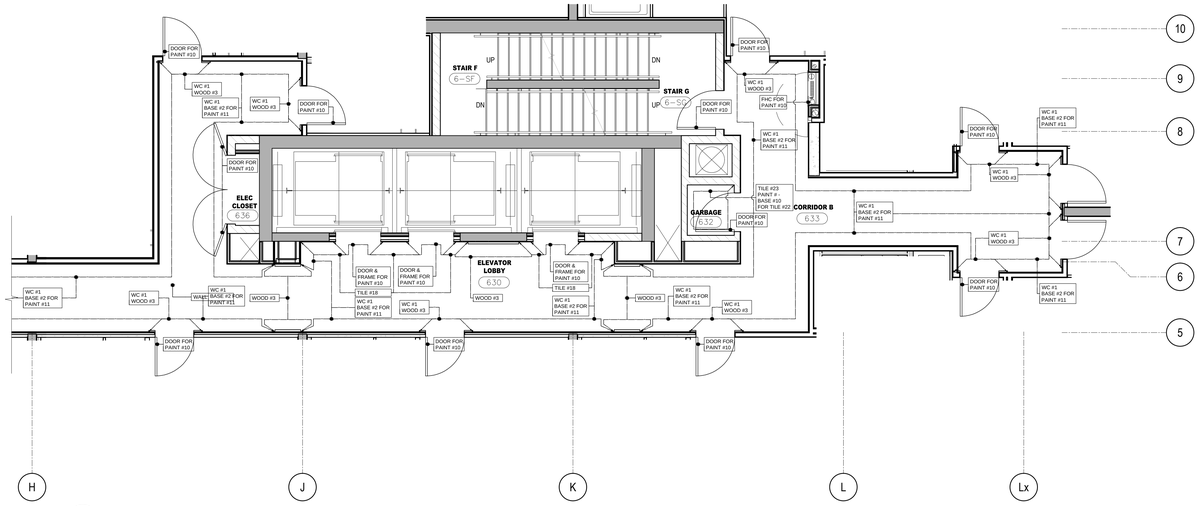

4 ID1.6.1 WALL FINISHES PLAN
6TH FLOOR
SCALE 1:50

DO NOT SCALE DRAWINGS.

CONTRACTOR MUST VERIFY ALL DRAWINGS, DIMENSIONS, DETAILS AND SPECIFICATIONS, AND REPORT ANY DISCREPANCIES TO *UNION 31 INC.* BEFORE PROCEEDING WITH WORK. MATERIALS MAY NOT BE SUBSTITUTED WITHOUT WRITTEN APPROVAL FROM *UNION 31 INC.*

ALL DRAWINGS AND SPECIFICATIONS ARE INSTRUMENTS OF SERVICE AND THE PROPERTY OF *UNION 31 INC.* WHICH MUST BE RETURNED AT THE COMPLETION OF THE WORK.

PRINTED: 30-May-17

ISSUED FOR AS-BUILT

NO.	DATE	COMMENTS	INI
01	31 MAY / 17	ISSUED FOR AS-BUILT	SV

REVISIONS:

UNION31

UNION31 INC.
183 BATHURST STREET, STE 201
TORONTO, ON, M5T 2R7, CANADA
TEL: 416-597-1576 FAX: 416-597-2139

PROJECT NAME:
ALEXANDRA PARK
MAIN BUILDING
BLOCK 11
ON, Canada

PROJECT NO.: 13-949

DRAWING/S:
6TH FLOOR
FLOOR FINISHES PLAN &
WALL FINISHES PLAN

DATE STARTED:	07 AUG / 13	DRAWING NO.:	ID 1.6.1
SCALE:	1 : 50		
DRAWN BY:	AP		
APPROVED BY:	KC		

36 x 48

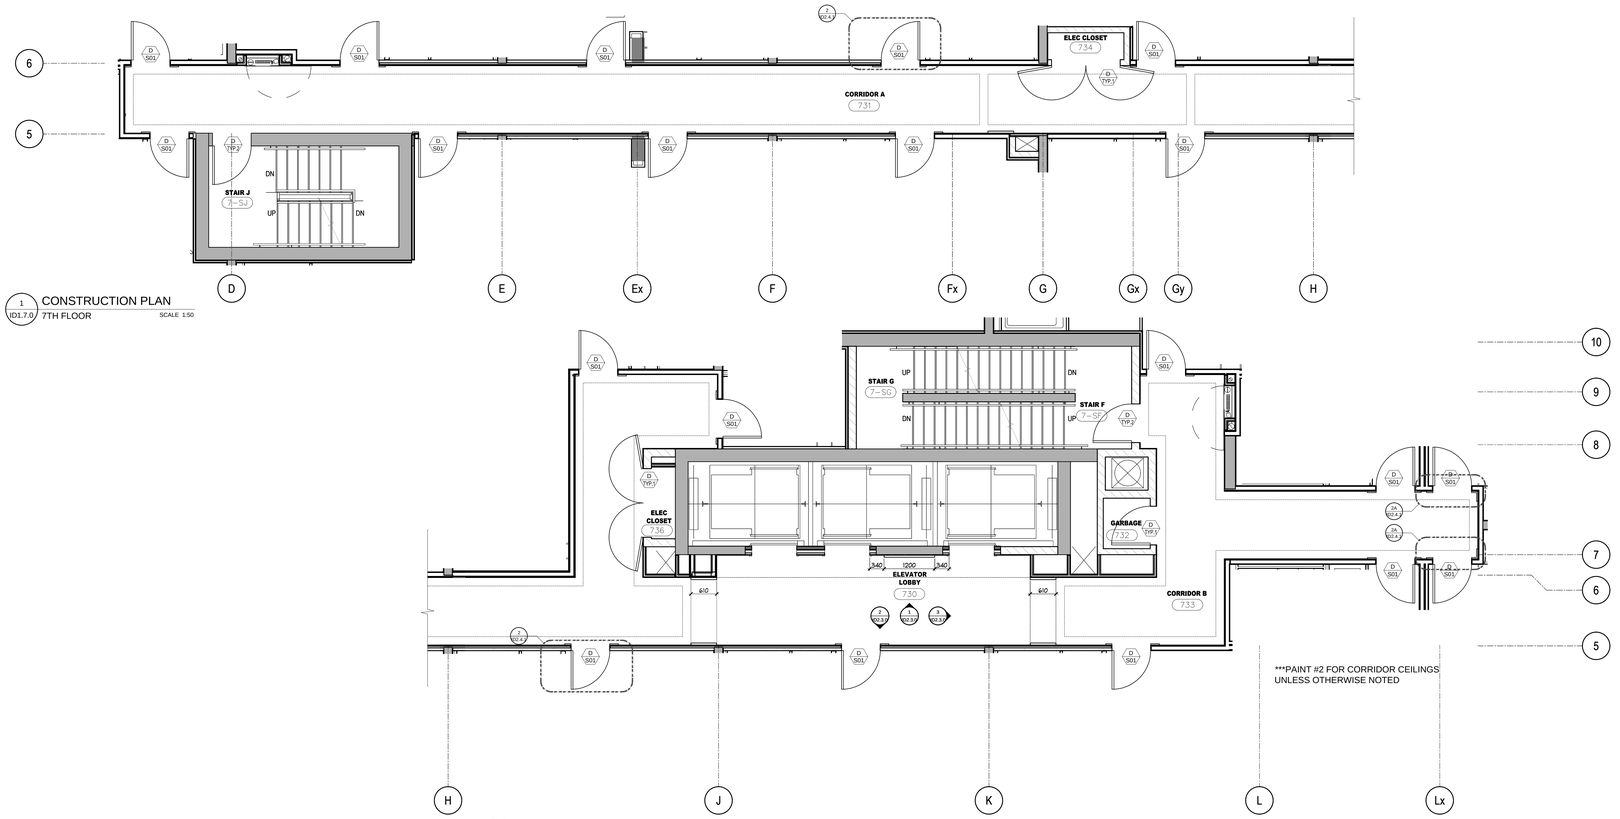

1 / ID1.7.0 CONSTRUCTION PLAN
7TH FLOOR SCALE 1:50

2 / ID1.7.0 CONSTRUCTION PLAN
7TH FLOOR SCALE 1:50

***PAINT #2 FOR CORRIDOR CEILINGS
UNLESS OTHERWISE NOTED

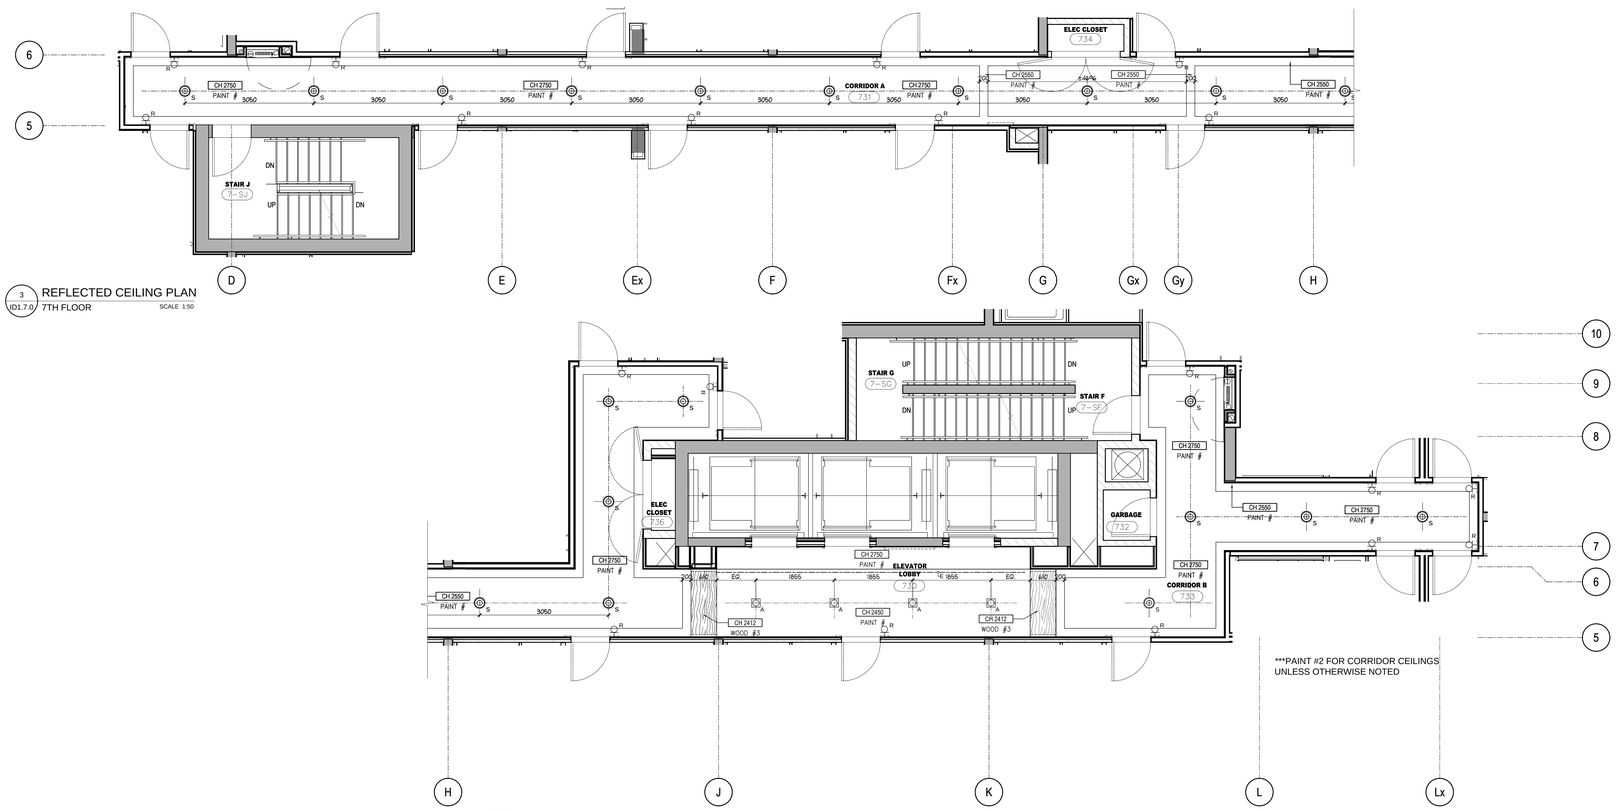

3 / ID1.7.0 REFLECTED CEILING PLAN
7TH FLOOR SCALE 1:50

4 / ID1.7.0 REFLECTED CEILING PLAN
7TH FLOOR SCALE 1:50

***PAINT #2 FOR CORRIDOR CEILINGS
UNLESS OTHERWISE NOTED

DO NOT SCALE DRAWINGS.

CONTRACTOR MUST VERIFY ALL DRAWINGS, DIMENSIONS, DETAILS AND SPECIFICATIONS, AND REPORT ANY DISCREPANCIES TO *UNION 31 INC.* BEFORE PROCEEDING WITH WORK. MATERIALS MAY NOT BE SUBSTITUTED WITHOUT WRITTEN APPROVAL FROM *UNION 31 INC.*

ALL DRAWINGS AND SPECIFICATIONS ARE INSTRUMENTS OF SERVICE AND THE PROPERTY OF *UNION 31 INC.* WHICH MUST BE RETURNED AT THE COMPLETION OF THE WORK.

PRINTED: 30-May-17

ISSUED FOR AS-BUILT

NO.	DATE	COMMENTS	INI
01	31 MAY / 17	ISSUED FOR AS-BUILT	SV

REVISIONS:

UNION31

UNION31 INC.
183 BATHURST STREET, STE 201
TORONTO, ON, M5T 2R7, CANADA
TEL: 416-597-1576 FAX: 416-597-2139

PROJECT NAME:
ALEXANDRA PARK
MAIN BUILDING
BLOCK 11
ON, Canada

PROJECT NO.: 13-949

DRAWING/S:
7TH FLOOR
CONSTRUCTION PLAN &
REFLECTED CEILING PLAN

DATE STARTED:	07 AUG / 13	DRAWING NO.:
SCALE:	1 : 50	ID 1.7.0
DRAWN BY:	AP	
APPROVED BY:	KC	

36 x 48

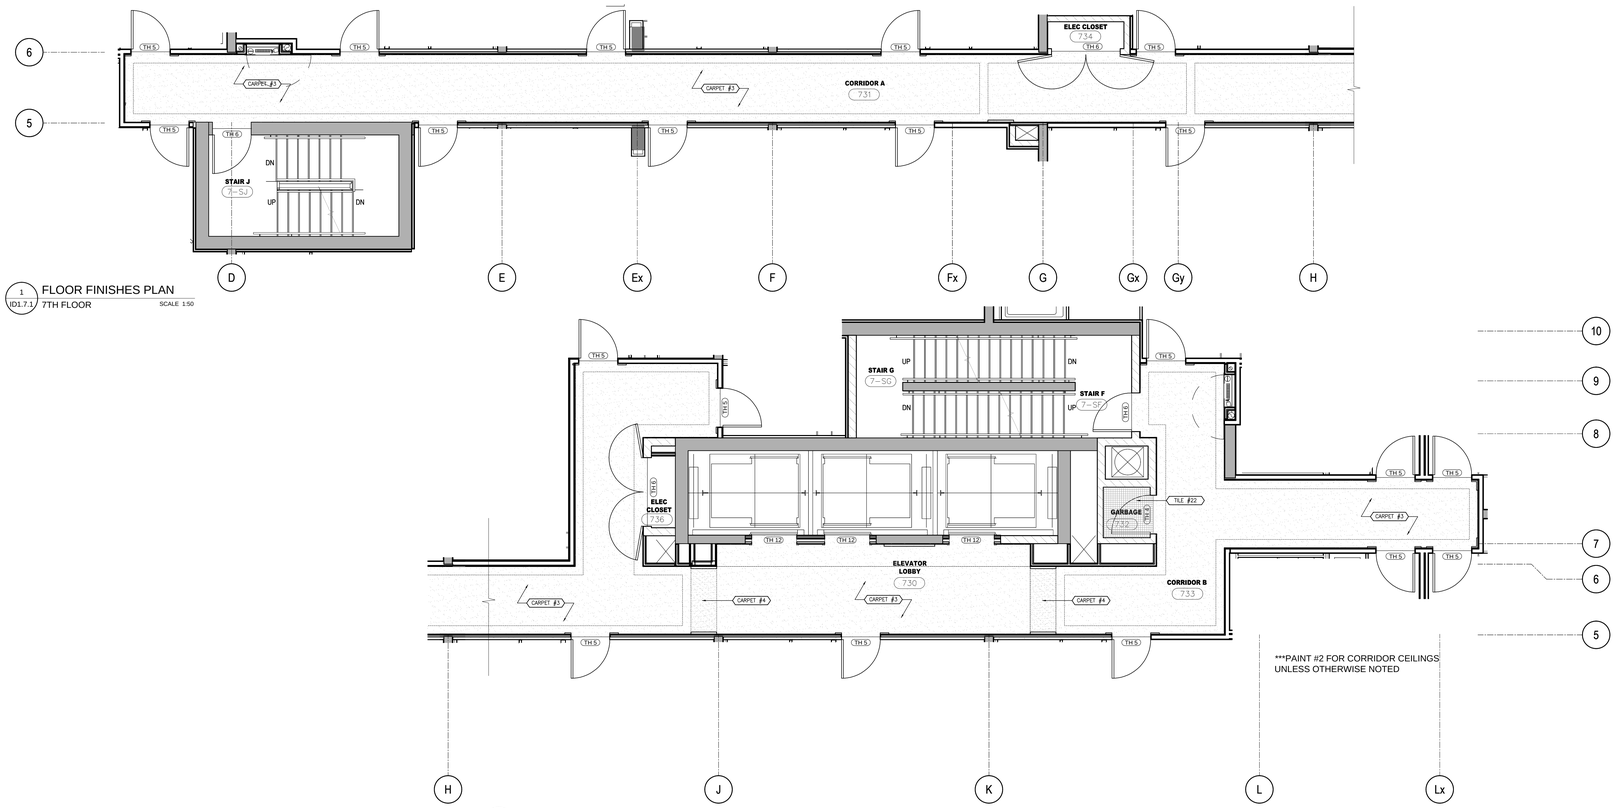

1 ID1.7.1 FLOOR FINISHES PLAN — 7TH FLOOR — SCALE 1:50

2 ID1.7.1 FLOOR FINISHES PLAN — 7TH FLOOR — SCALE 1:50

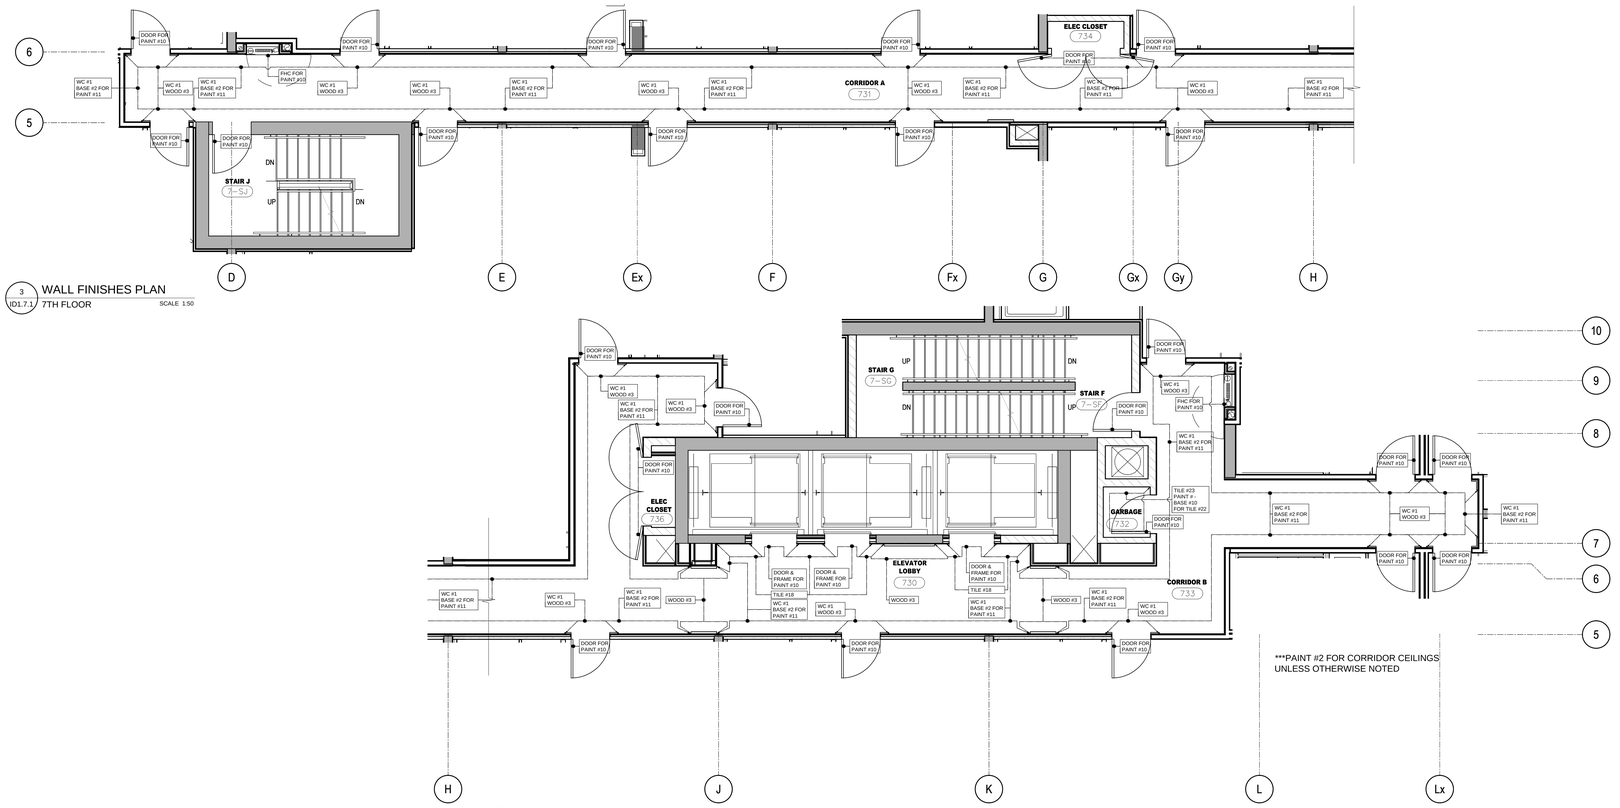

3 ID1.7.1 WALL FINISHES PLAN — 7TH FLOOR — SCALE 1:50

4 ID1.7.1 WALL FINISHES PLAN — 7TH FLOOR — SCALE 1:50

DO NOT SCALE DRAWINGS.

CONTRACTOR MUST VERIFY ALL DRAWINGS, DIMENSIONS, DETAILS AND SPECIFICATIONS, AND REPORT ANY DISCREPANCIES TO *UNION 31 INC.* BEFORE PROCEEDING WITH WORK. MATERIALS MAY NOT BE SUBSTITUTED WITHOUT WRITTEN APPROVAL FROM *UNION 31 INC.*

ALL DRAWINGS AND SPECIFICATIONS ARE INSTRUMENTS OF SERVICE AND THE PROPERTY OF *UNION 31 INC.* WHICH MUST BE RETURNED AT THE COMPLETION OF THE WORK.

PRINTED: 30-May-17

ISSUED FOR AS-BUILT

NO.	DATE	COMMENTS	INI
01	31 MAY / 17	ISSUED FOR AS-BUILT	SV

REVISIONS:

UNION31

UNION31 INC.
183 BATHURST STREET, STE 201
TORONTO, ON, M5T 2R7, CANADA
TEL: 416-597-1576 FAX: 416-597-2139

PROJECT NAME:
ALEXANDRA PARK
MAIN BUILDING
BLOCK 11
ON, Canada

PROJECT NO.: 13-949

DRAWING/S:
7TH FLOOR
FLOOR FINISHES PLAN &
WALL FINISHES PLAN

DATE STARTED:	07 AUG / 13	DRAWING NO.:	ID 1.7.1
SCALE:	1 : 50		
DRAWN BY:	AP		
APPROVED BY:	KC		

36 x 48

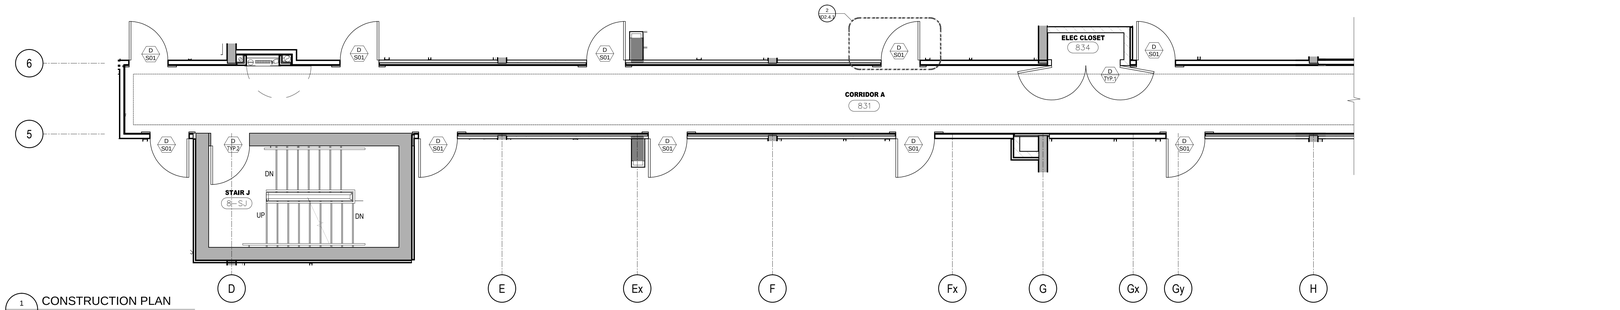

1 ID1.8.0 CONSTRUCTION PLAN
8TH FLOOR
SCALE 1:50

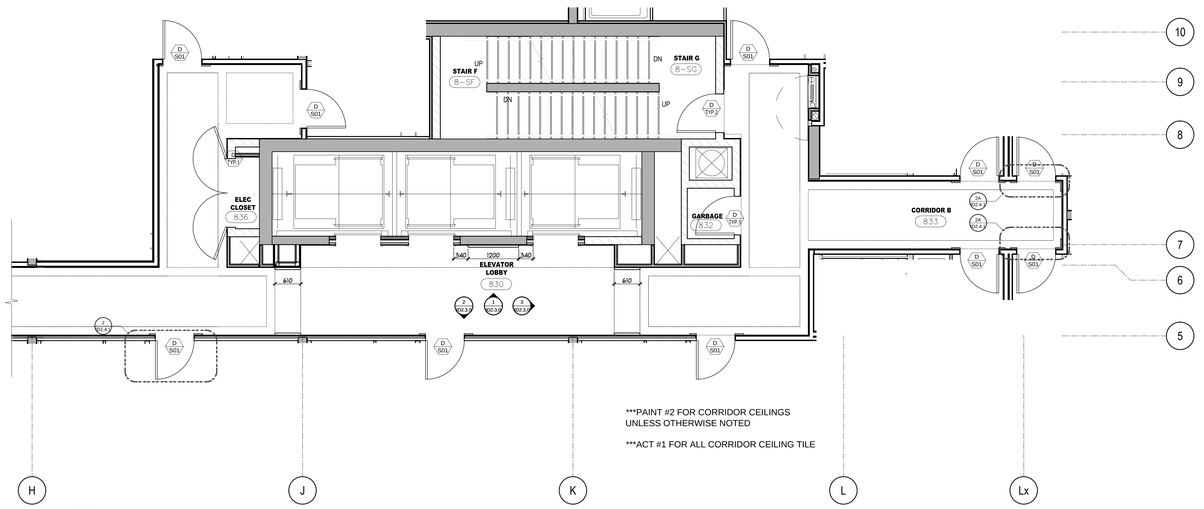

***PAINT #2 FOR CORRIDOR CEILINGS
UNLESS OTHERWISE NOTED

***ACT #1 FOR ALL CORRIDOR CEILING TILE

2 ID1.8.0 CONSTRUCTION PLAN
8TH FLOOR
SCALE 1:50

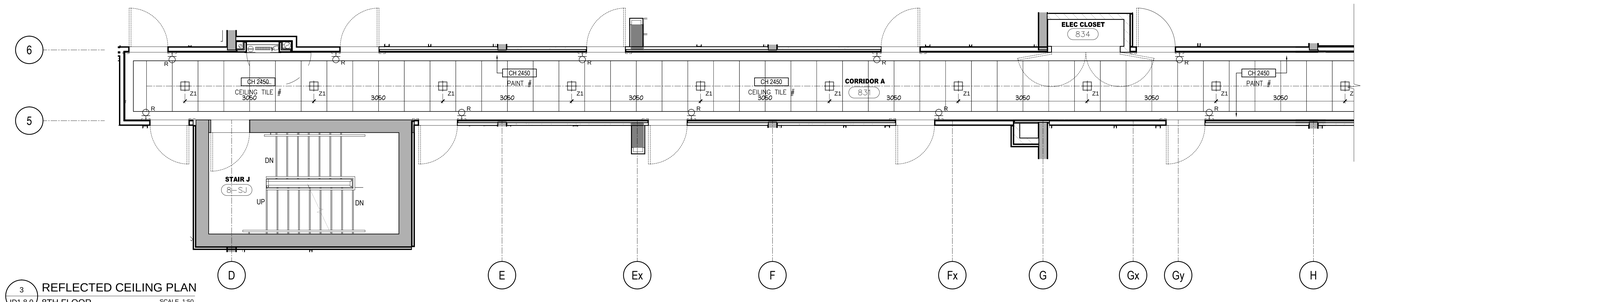

3 ID1.8.0 REFLECTED CEILING PLAN
8TH FLOOR
SCALE 1:50

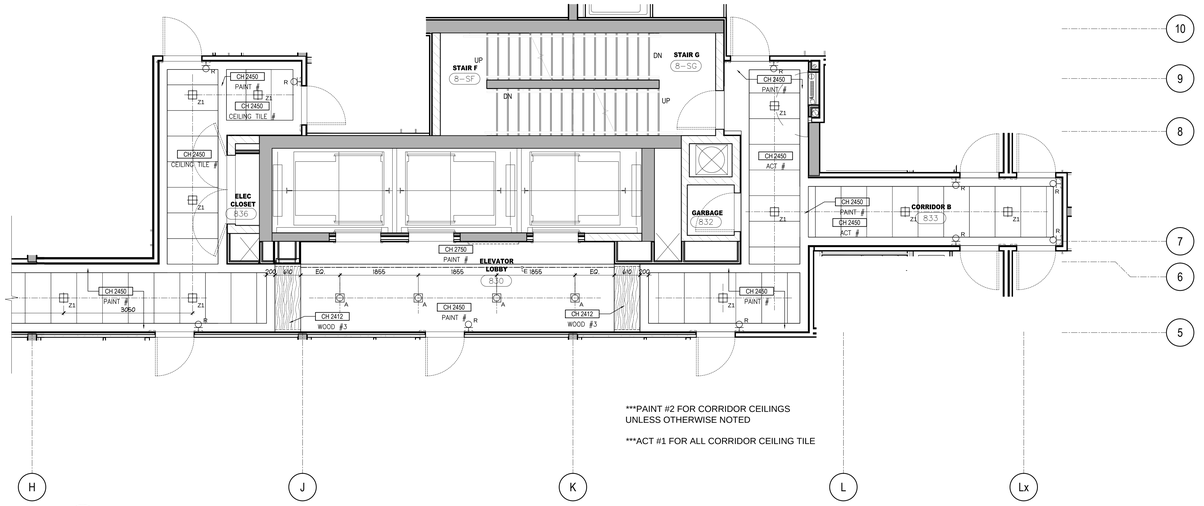

***PAINT #2 FOR CORRIDOR CEILINGS
UNLESS OTHERWISE NOTED

***ACT #1 FOR ALL CORRIDOR CEILING TILE

4 ID1.8.0 REFLECTED CEILING PLAN
8TH FLOOR
SCALE 1:50

DO NOT SCALE DRAWINGS.

CONTRACTOR MUST VERIFY ALL DRAWINGS, DIMENSIONS, DETAILS AND SPECIFICATIONS, AND REPORT ANY DISCREPANCIES TO *UNION 31 INC.* BEFORE PROCEEDING WITH WORK. MATERIALS MAY NOT BE SUBSTITUTED WITHOUT WRITTEN APPROVAL FROM *UNION 31 INC.*

ALL DRAWINGS AND SPECIFICATIONS ARE INSTRUMENTS OF SERVICE AND THE PROPERTY OF *UNION 31 INC.* WHICH MUST BE RETURNED AT THE COMPLETION OF THE WORK.

PRINTED: 30-May-17

ISSUED FOR AS-BUILT

NO.	DATE	COMMENTS	INI
01	31 MAY / 17	ISSUED FOR AS-BUILT	SV

REVISIONS:

UNION31

UNION31 INC.
183 BATHURST STREET, STE 201
TORONTO, ON, M5T 2R7, CANADA
TEL: 416-597-1576 FAX: 416-597-2139

PROJECT NAME:
ALEXANDRA PARK
MAIN BUILDING
BLOCK 11
ON, Canada

PROJECT NO.: 13-949

DRAWING/S:
8TH FLOOR
CONSTRUCTION PLAN &
REFLECTED CEILING PLAN

DATE STARTED:	07 AUG / 13	DRAWING NO.:	ID 1.8.0
SCALE:	1 : 50		
DRAWN BY:	AP		
APPROVED BY:	KC		

36 x 48

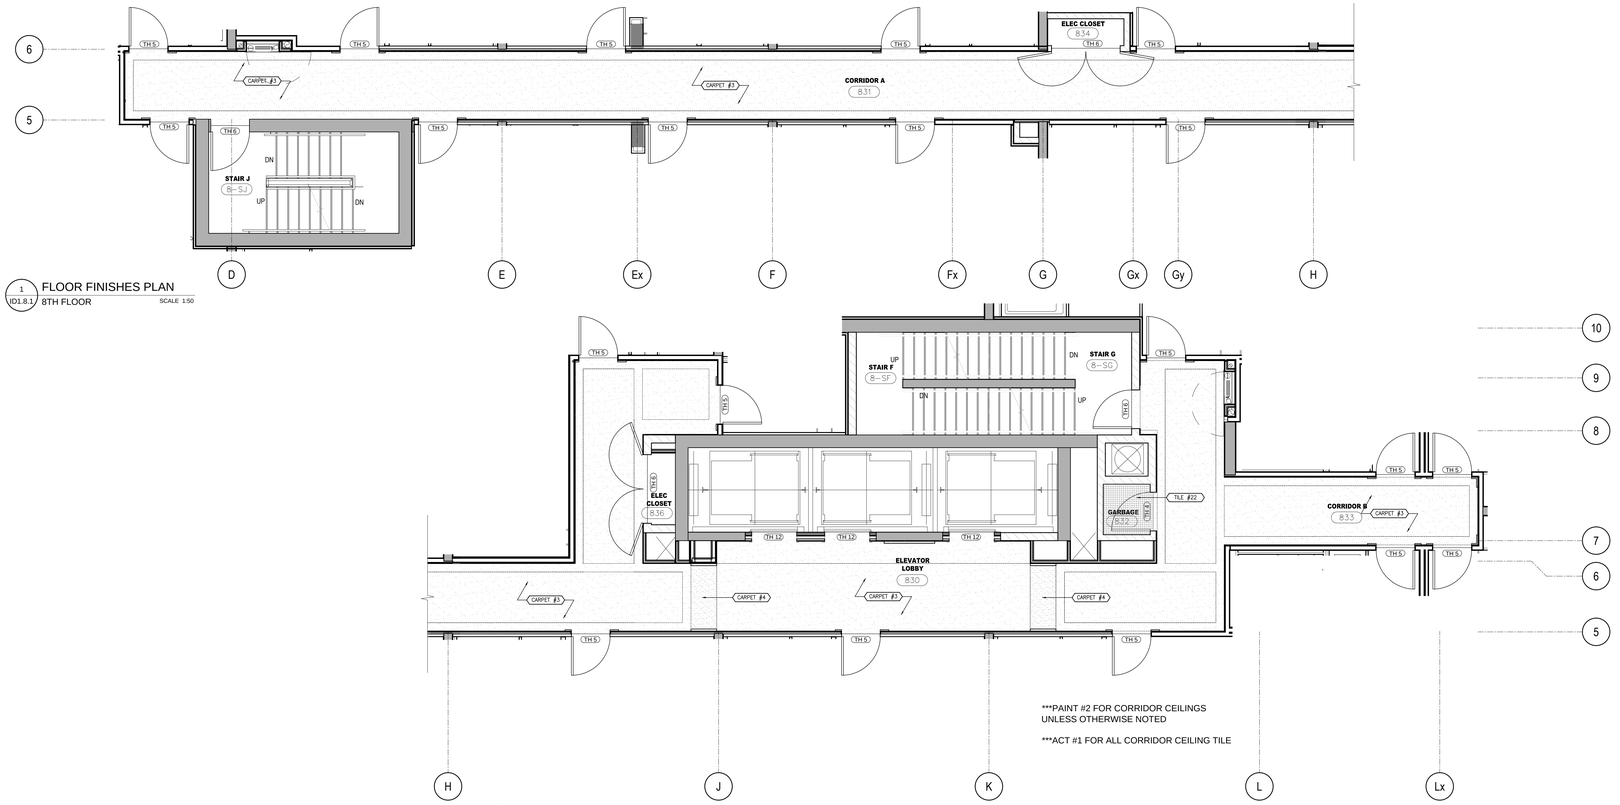

1 ID1.8.1 FLOOR FINISHES PLAN — 8TH FLOOR — SCALE 1:50

2 ID1.8.1 FLOOR FINISHES PLAN — 8TH FLOOR — SCALE 1:50

***PAINT #2 FOR CORRIDOR CEILINGS UNLESS OTHERWISE NOTED

***ACT #1 FOR ALL CORRIDOR CEILING TILE

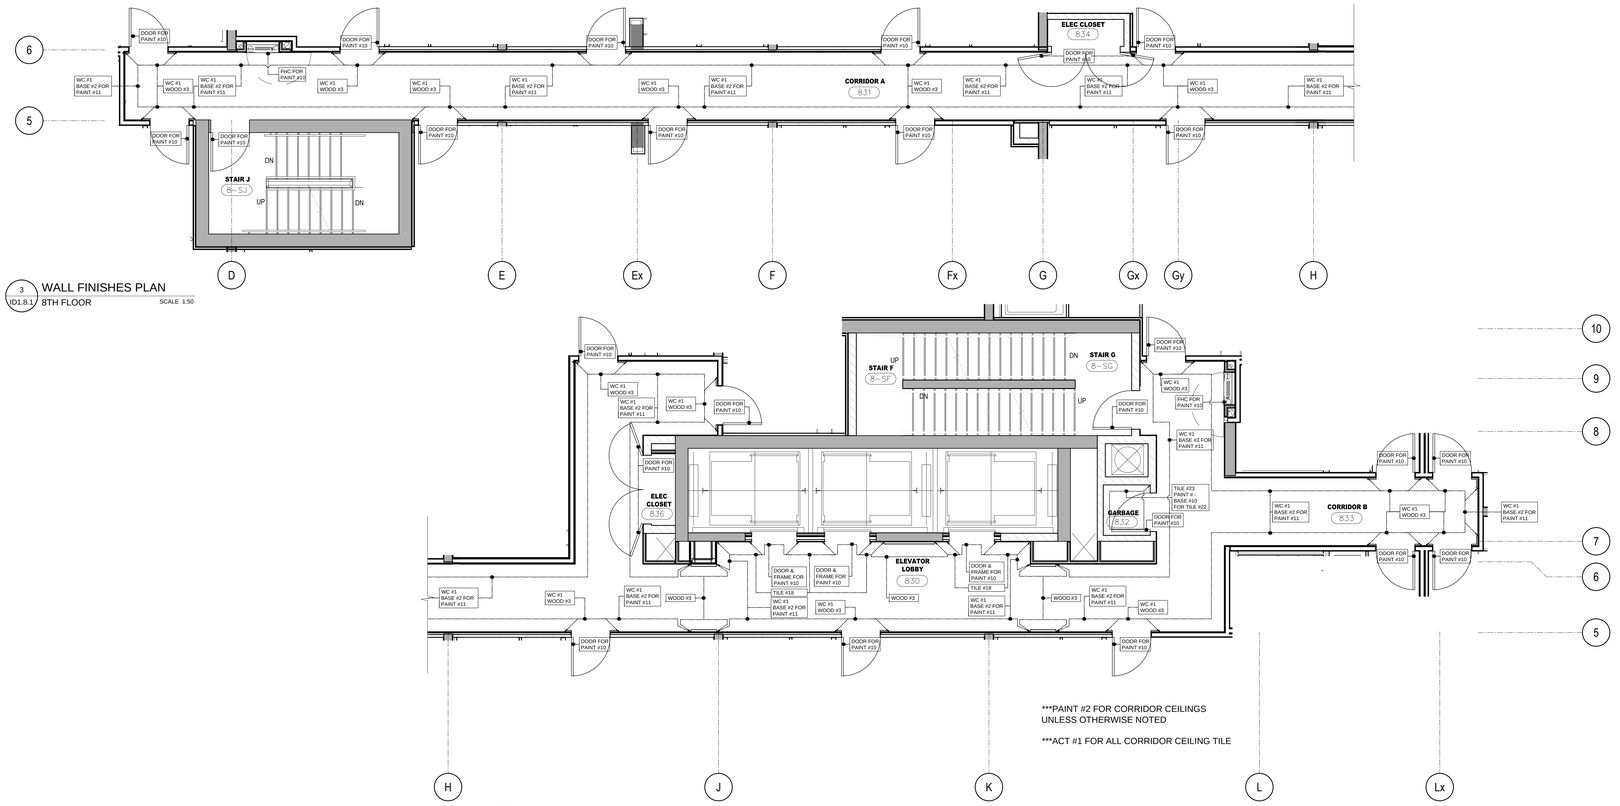

3 ID1.8.1 WALL FINISHES PLAN — 8TH FLOOR — SCALE 1:50

4 ID1.8.1 WALL FINISHES PLAN — 8TH FLOOR — SCALE 1:50

***PAINT #2 FOR CORRIDOR CEILINGS UNLESS OTHERWISE NOTED

***ACT #1 FOR ALL CORRIDOR CEILING TILE

DO NOT SCALE DRAWINGS.

CONTRACTOR MUST VERIFY ALL DRAWINGS, DIMENSIONS, DETAILS AND SPECIFICATIONS, AND REPORT ANY DISCREPANCIES TO *UNION 31 INC.* BEFORE PROCEEDING WITH WORK. MATERIALS MAY NOT BE SUBSTITUTED WITHOUT WRITTEN APPROVAL FROM *UNION 31 INC.*

ALL DRAWINGS AND SPECIFICATIONS ARE INSTRUMENTS OF SERVICE AND THE PROPERTY OF *UNION 31 INC.* WHICH MUST BE RETURNED AT THE COMPLETION OF THE WORK.

PRINTED: 30-May-17

ISSUED FOR AS-BUILT

NO.	DATE	COMMENTS	INI
01	31 MAY / 17	ISSUED FOR AS-BUILT	SV

REVISIONS:

UNION31

UNION31 INC.
183 BATHURST STREET, STE 201
TORONTO, ON, M5T 2R7, CANADA
TEL: 416-597-1576 FAX: 416-597-2139

PROJECT NAME:
ALEXANDRA PARK
MAIN BUILDING
BLOCK 11
ON, Canada

PROJECT NO.: 13-949

DRAWING/S:
8TH FLOOR
FLOOR FINISHES PLAN &
WALL FINISHES PLAN

DATE STARTED:	07 AUG / 13	DRAWING NO.:	ID 1.8.1
SCALE:	1 : 50		
DRAWN BY:	AP		
APPROVED BY:	KC		

36 x 48

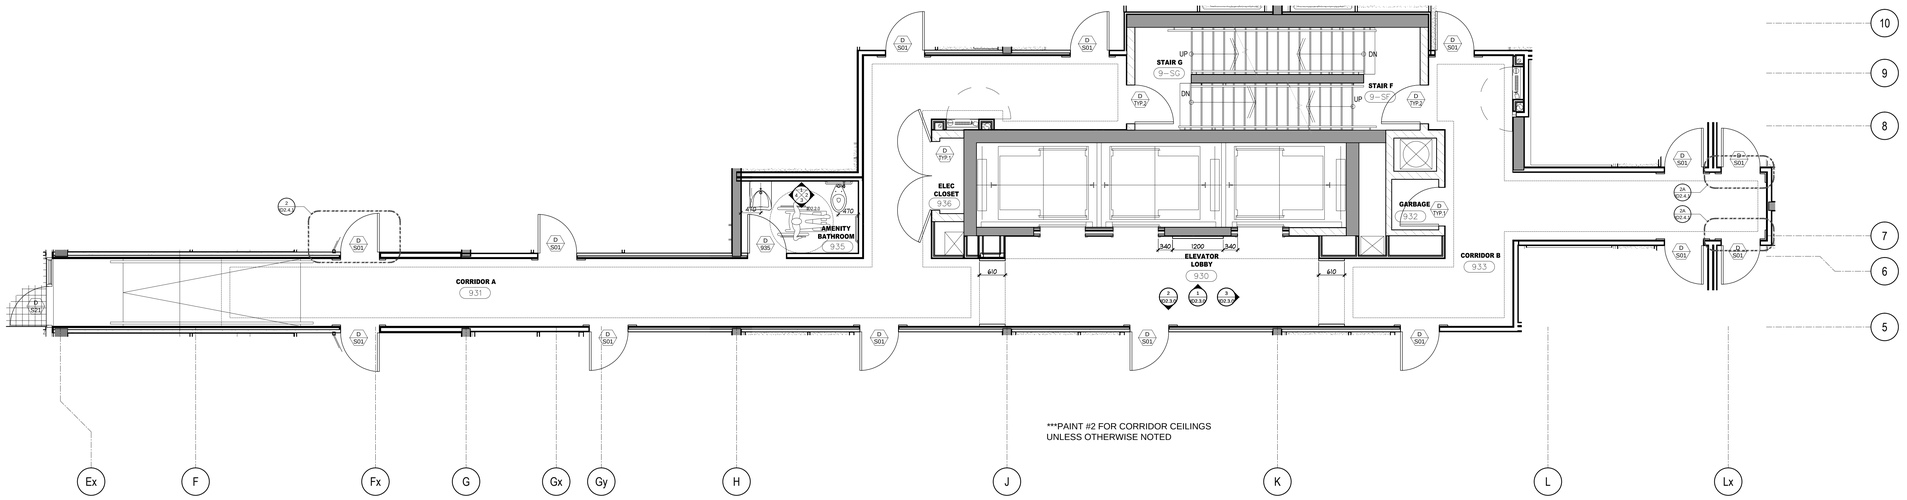

1 / ID1.9.0 CONSTRUCTION PLAN
9TH FLOOR
SCALE 1:50

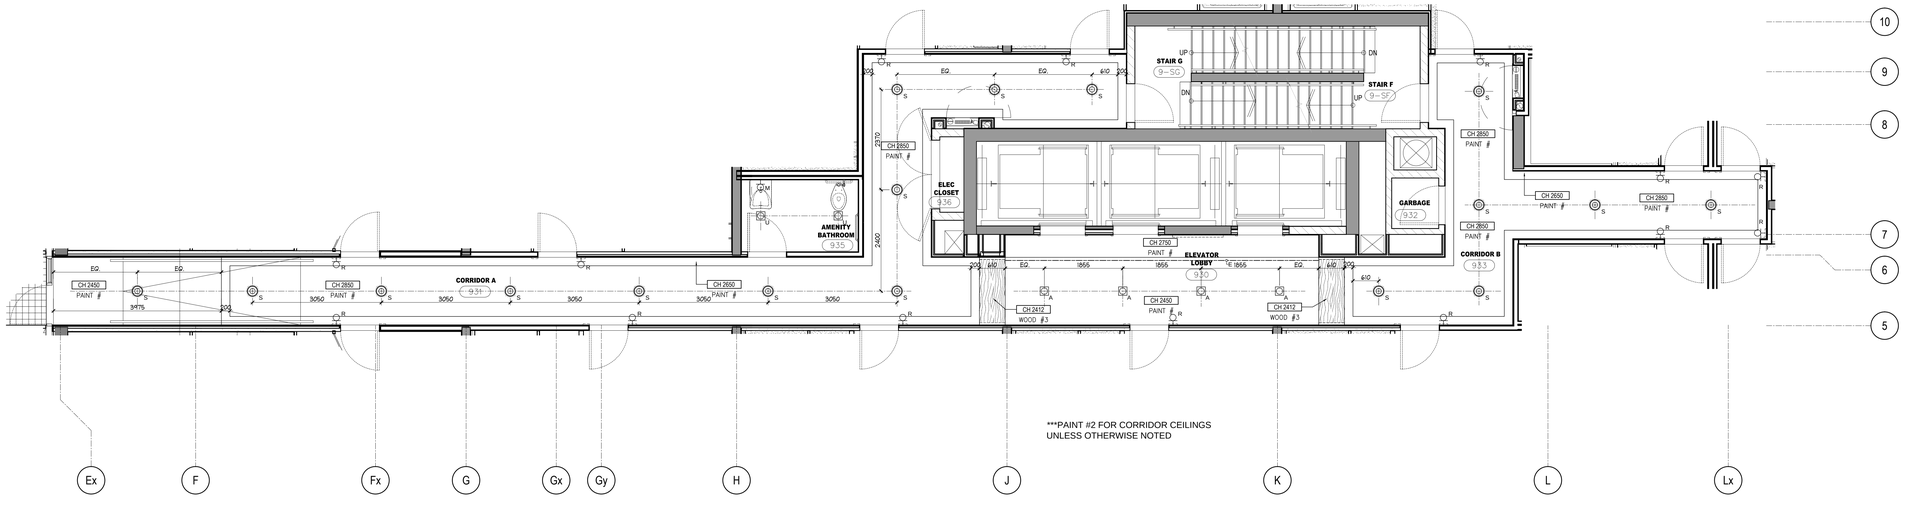

2 / ID1.9.0 REFLECTED CEILING PLAN
9TH FLOOR
SCALE 1:50

DO NOT SCALE DRAWINGS.

CONTRACTOR MUST VERIFY ALL DRAWINGS, DIMENSIONS, DETAILS AND SPECIFICATIONS, AND REPORT ANY DISCREPANCIES TO *UNION 31 INC.* BEFORE PROCEEDING WITH WORK. MATERIALS MAY NOT BE SUBSTITUTED WITHOUT WRITTEN APPROVAL FROM *UNION 31 INC.*

ALL DRAWINGS AND SPECIFICATIONS ARE INSTRUMENTS OF SERVICE AND THE PROPERTY OF *UNION 31 INC.* WHICH MUST BE RETURNED AT THE COMPLETION OF THE WORK.

PRINTED: 30-May-17

ISSUED FOR AS-BUILT

NO.	DATE	COMMENTS	INI
01	31 MAY / 17	ISSUED FOR AS-BUILT	SV

REVISIONS:

UNION31

UNION31 INC.
183 BATHURST STREET, STE 201
TORONTO, ON, M5T 2R7, CANADA
TEL: 416-597-1576 FAX: 416-597-2139

PROJECT NAME:
ALEXANDRA PARK
MAIN BUILDING
BLOCK 11
ON, Canada

PROJECT NO.: 13-949

DRAWING/S:
9TH FLOOR
CONSTRUCTION PLAN &
REFLECTED CEILING PLAN

DATE STARTED:	07 AUG / 13	DRAWING NO.:	ID 1.9.0
SCALE:	1 : 50		
DRAWN BY:	AP		
APPROVED BY:	KC		

36 x 48

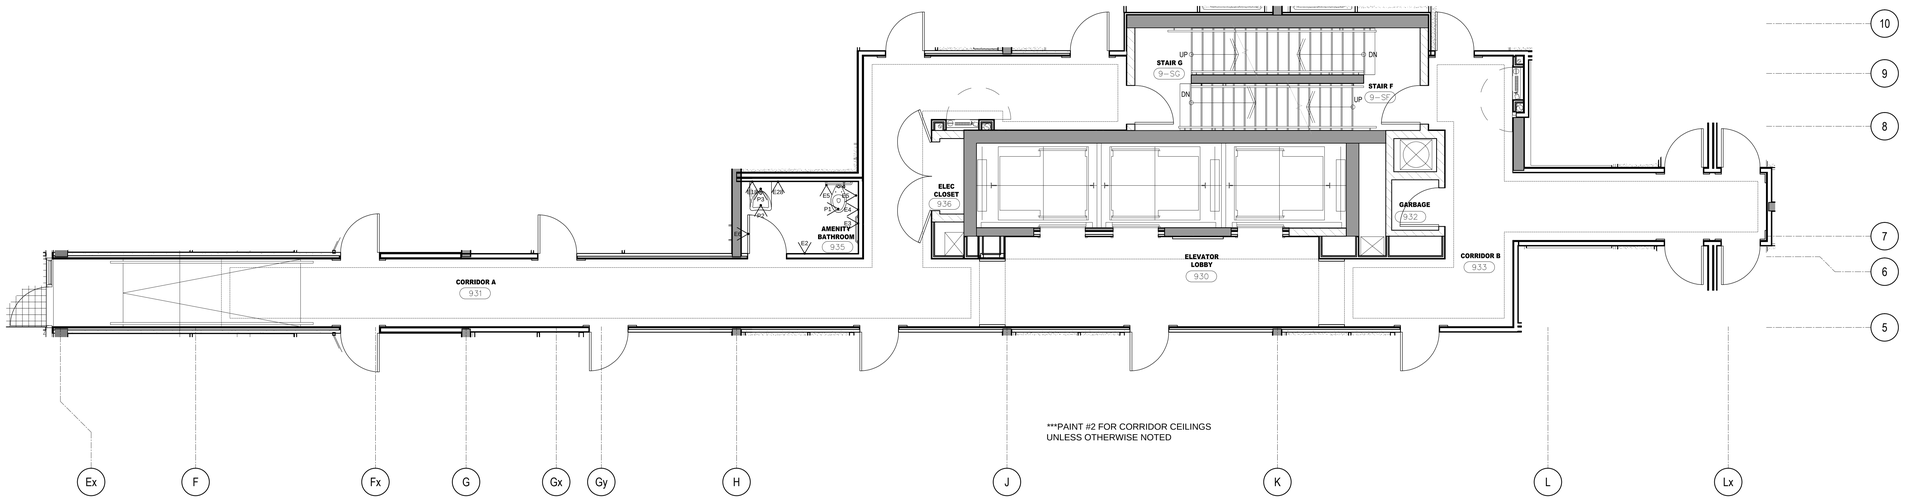

***PAINT #2 FOR CORRIDOR CEILINGS
UNLESS OTHERWISE NOTED

1 / ID1.9.1 FURNITURE & POWER PLAN
9TH FLOOR SCALE 1:50

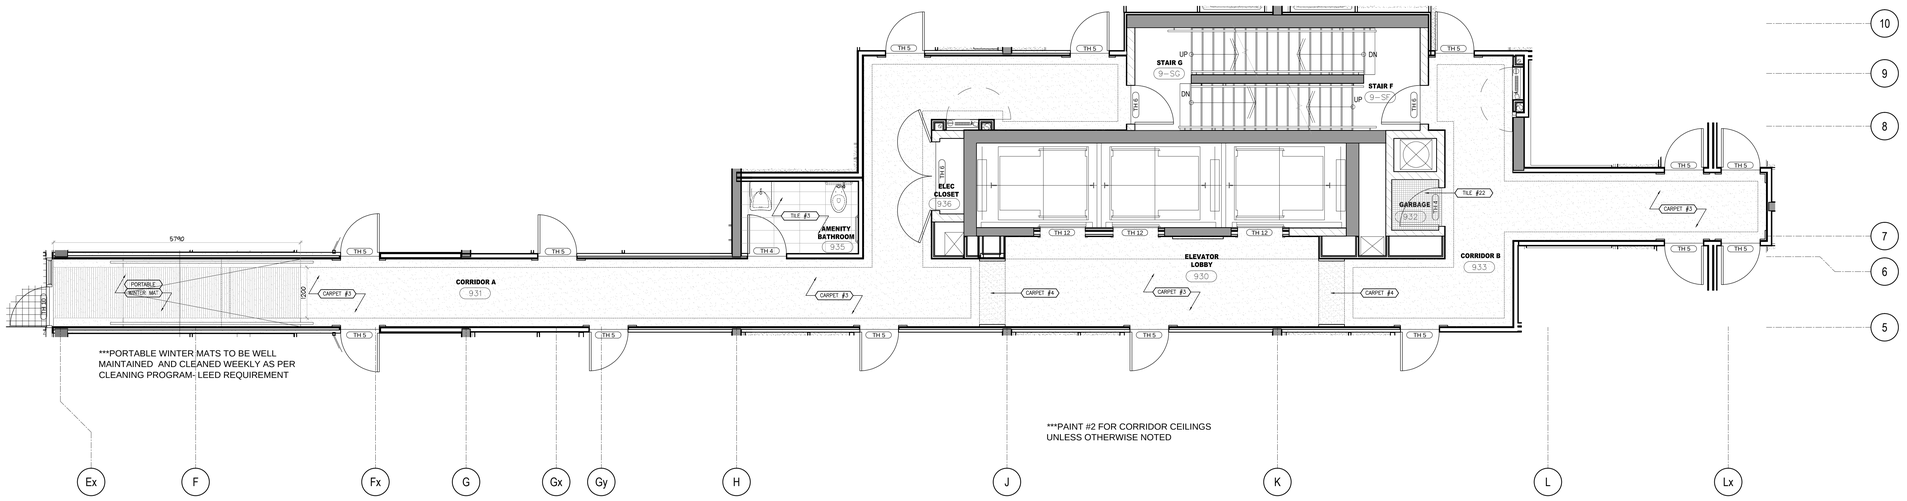

***PORTABLE WINTER MATS TO BE WELL MAINTAINED AND CLEANED WEEKLY AS PER CLEANING PROGRAM- LEED REQUIREMENT

***PAINT #2 FOR CORRIDOR CEILINGS
UNLESS OTHERWISE NOTED

2 / ID1.9.1 FLOOR FINISHES PLAN
9TH FLOOR SCALE 1:50

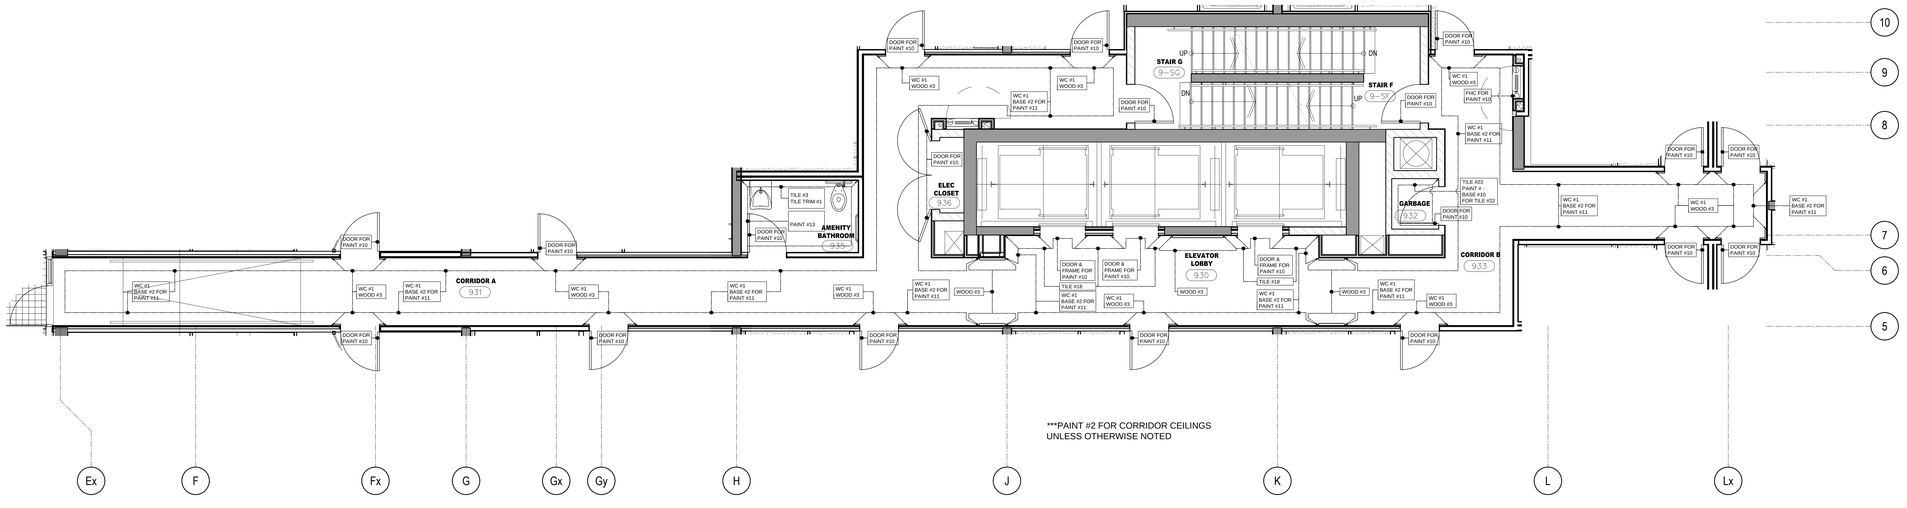

***PAINT #2 FOR CORRIDOR CEILINGS
UNLESS OTHERWISE NOTED

3 / ID1.9.1 WALL FINISHES PLAN
9TH FLOOR SCALE 1:50

DO NOT SCALE DRAWINGS.

CONTRACTOR MUST VERIFY ALL DRAWINGS, DIMENSIONS, DETAILS AND SPECIFICATIONS, AND REPORT ANY DISCREPANCIES TO *UNION 31 INC.* BEFORE PROCEEDING WITH WORK. MATERIALS MAY NOT BE SUBSTITUTED WITHOUT WRITTEN APPROVAL FROM *UNION 31 INC.*

ALL DRAWINGS AND SPECIFICATIONS ARE INSTRUMENTS OF SERVICE AND THE PROPERTY OF *UNION 31 INC.* WHICH MUST BE RETURNED AT THE COMPLETION OF THE WORK.

PRINTED: 30-May-17

ISSUED FOR AS-BUILT

NO.	DATE	COMMENTS	INI
01	31 MAY / 17	ISSUED FOR AS-BUILT	SV

REVISIONS:

UNION31

UNION31 INC.
183 BATHURST STREET, STE 201
TORONTO, ON, M5T 2R7, CANADA
TEL: 416-597-1576 FAX: 416-597-2139

PROJECT NAME:
ALEXANDRA PARK
MAIN BUILDING
BLOCK 11
ON, Canada

PROJECT NO.: 13-949

DRAWING/S:
9TH FLOOR
FURNITURE & POWER PLAN
FLOOR FINISHES PLAN &
WALL FINISHES PLAN

DATE STARTED: 07 AUG / 13	DRAWING NO.:
SCALE: 1 : 50	ID 1.9.1
DRAWN BY: AP	
APPROVED BY: KC	

36 x 48

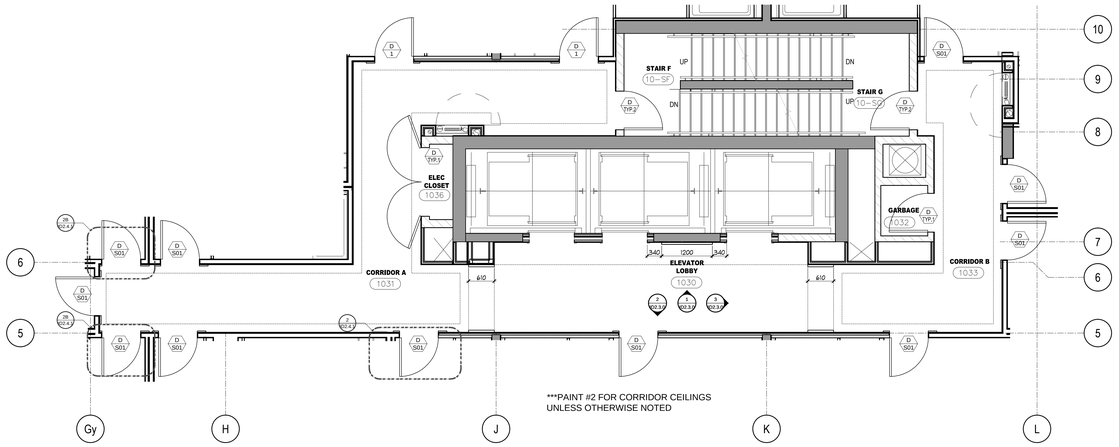

***PAINT #2 FOR CORRIDOR CEILINGS
UNLESS OTHERWISE NOTED

1 CONSTRUCTION PLAN
ID1.10.0 10TH FLOOR SCALE 1:50

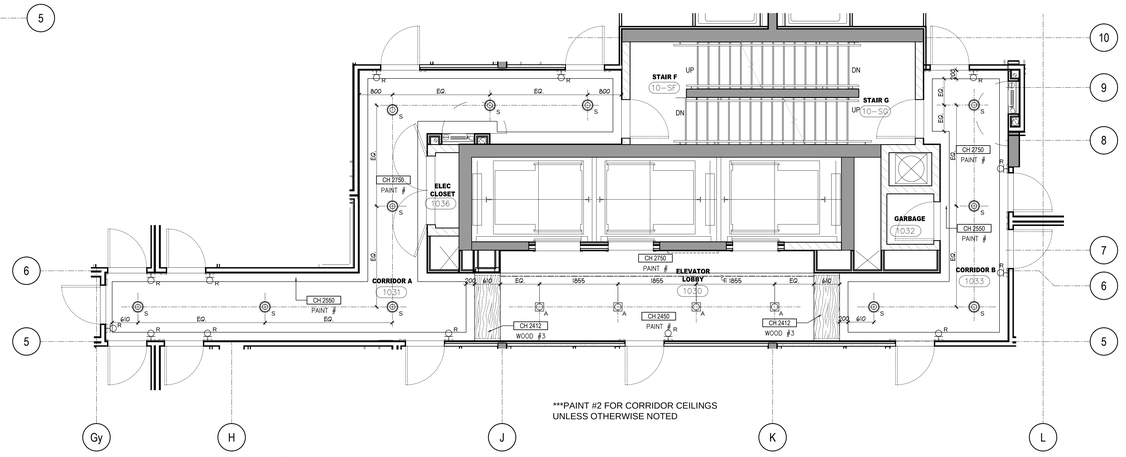

***PAINT #2 FOR CORRIDOR CEILINGS
UNLESS OTHERWISE NOTED

2 REFLECTED CEILING PLAN
ID1.10.0 10TH FLOOR SCALE 1:50

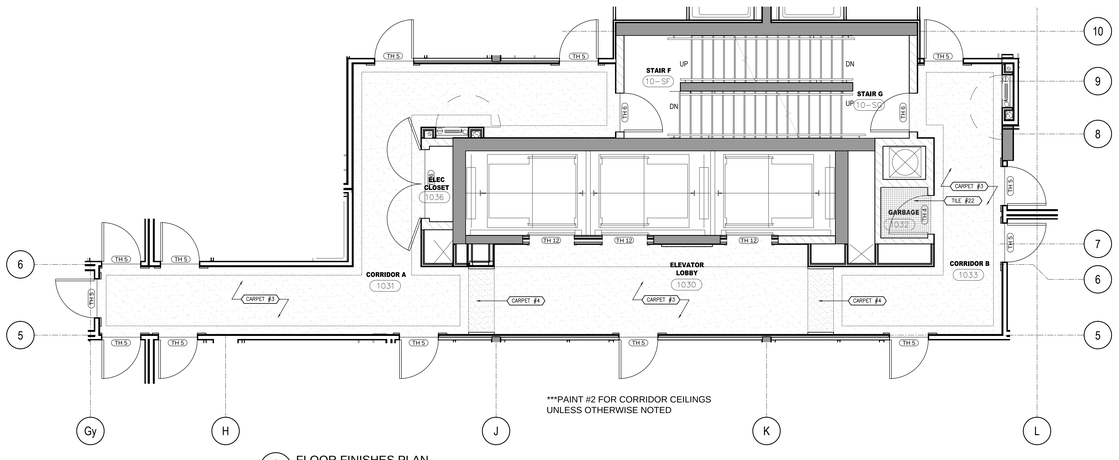

***PAINT #2 FOR CORRIDOR CEILINGS
UNLESS OTHERWISE NOTED

3 FLOOR FINISHES PLAN
ID1.10.0 10TH FLOOR SCALE 1:50

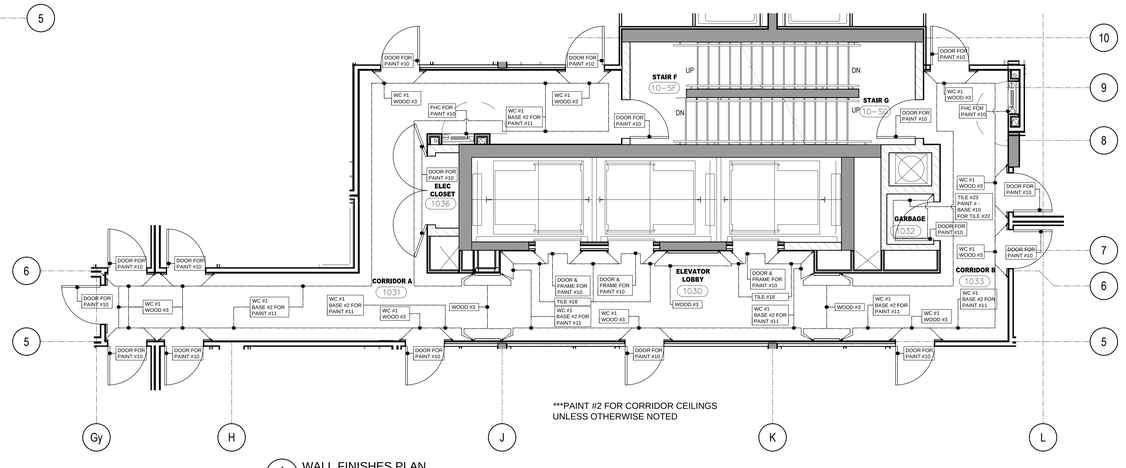

***PAINT #2 FOR CORRIDOR CEILINGS
UNLESS OTHERWISE NOTED

4 WALL FINISHES PLAN
ID1.10.0 10TH FLOOR SCALE 1:50

DO NOT SCALE DRAWINGS.

CONTRACTOR MUST VERIFY ALL DRAWINGS, DIMENSIONS, DETAILS AND SPECIFICATIONS, AND REPORT ANY DISCREPANCIES TO *UNION 31 INC.* BEFORE PROCEEDING WITH WORK. MATERIALS MAY NOT BE SUBSTITUTED WITHOUT WRITTEN APPROVAL FROM *UNION 31 INC.*

ALL DRAWINGS AND SPECIFICATIONS ARE INSTRUMENTS OF SERVICE AND THE PROPERTY OF *UNION 31 INC.* WHICH MUST BE RETURNED AT THE COMPLETION OF THE WORK.

PRINTED: 30-May-17

ISSUED FOR AS-BUILT

NO.	DATE	COMMENTS	INI
01	31 MAY / 17	ISSUED FOR AS-BUILT	SV

REVISIONS:

UNION31

UNION31 INC.
183 BATHURST STREET, STE 201
TORONTO, ON, M5T 2R7, CANADA
TEL: 416-597-1576 FAX: 416-597-2139

PROJECT NAME:
ALEXANDRA PARK
MAIN BUILDING
BLOCK 11
ON, Canada

PROJECT NO.: 13-949

DRAWING/S:
10TH FLOOR
CONSTRUCTION PLAN &
REFLECTED CEILING PLAN &
FLOOR & WALL FINISHES PLANS

DATE STARTED:	07 AUG / 13	DRAWING NO.:	ID 1.10.0
SCALE:	1 : 50		
DRAWN BY:	AP		
APPROVED BY:	KC		

36 x 48

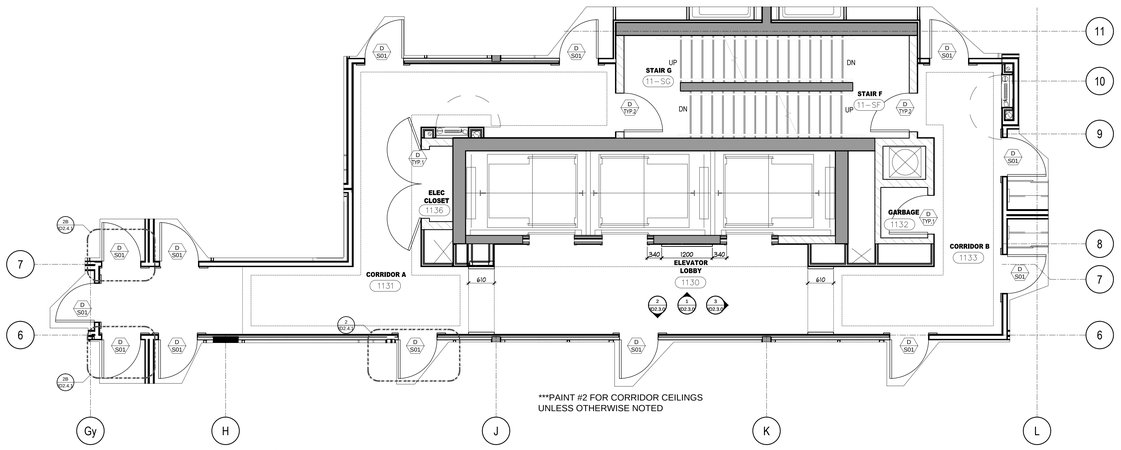

***PAINT #2 FOR CORRIDOR CEILINGS
UNLESS OTHERWISE NOTED

1 CONSTRUCTION PLAN
ID1.11.0 11TH FLOOR SCALE 1:50

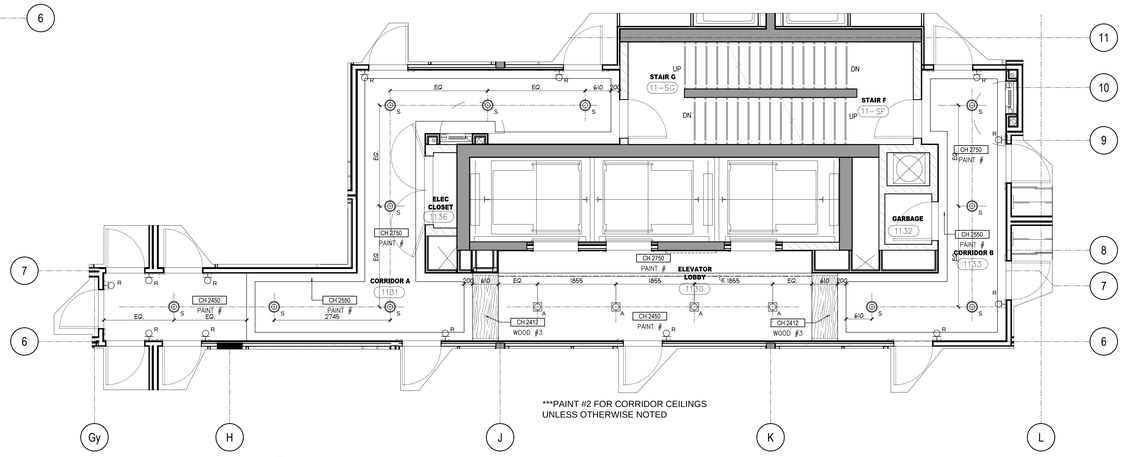

***PAINT #2 FOR CORRIDOR CEILINGS
UNLESS OTHERWISE NOTED

2 REFLECTED CEILING PLAN
ID1.11.0 11TH FLOOR SCALE 1:50

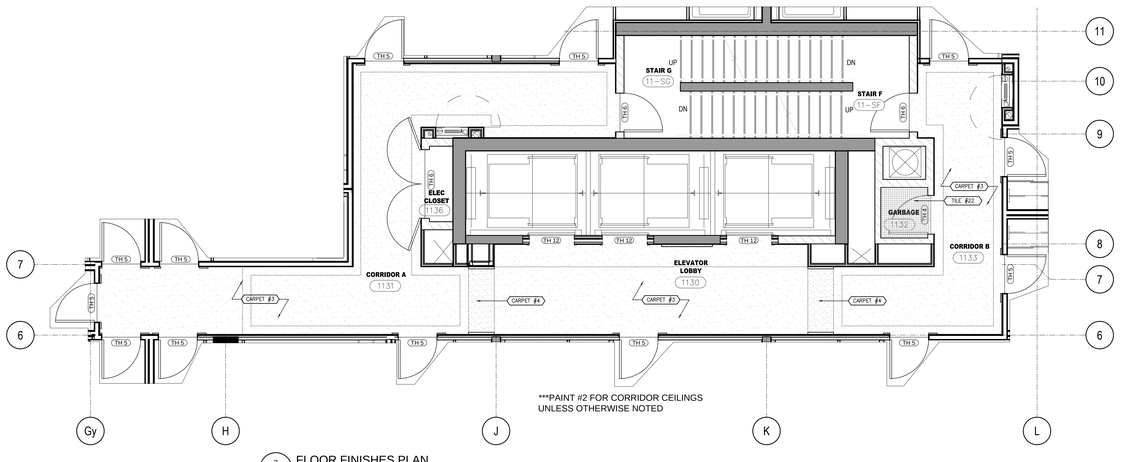

***PAINT #2 FOR CORRIDOR CEILINGS
UNLESS OTHERWISE NOTED

3 FLOOR FINISHES PLAN
ID1.11.0 11TH FLOOR SCALE 1:50

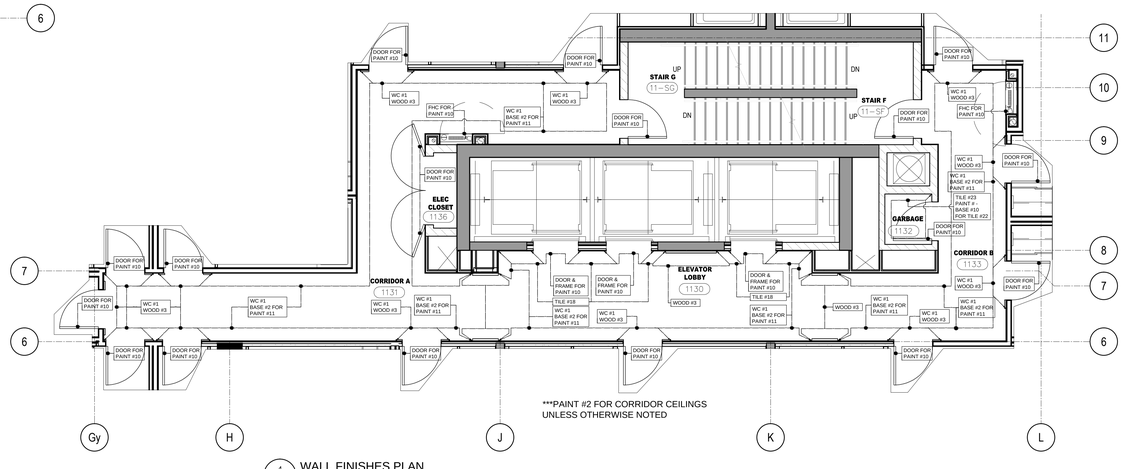

***PAINT #2 FOR CORRIDOR CEILINGS
UNLESS OTHERWISE NOTED

4 WALL FINISHES PLAN
ID1.11.0 11TH FLOOR SCALE 1:50

DO NOT SCALE DRAWINGS.

CONTRACTOR MUST VERIFY ALL DRAWINGS, DIMENSIONS, DETAILS AND SPECIFICATIONS, AND REPORT ANY DISCREPANCIES TO *UNION 31 INC.* BEFORE PROCEEDING WITH WORK. MATERIALS MAY NOT BE SUBSTITUTED WITHOUT WRITTEN APPROVAL FROM *UNION 31 INC.*

ALL DRAWINGS AND SPECIFICATIONS ARE INSTRUMENTS OF SERVICE AND THE PROPERTY OF *UNION 31 INC.* WHICH MUST BE RETURNED AT THE COMPLETION OF THE WORK.

PRINTED: 30-May-17

ISSUED FOR AS-BUILT

NO.	DATE	COMMENTS	INI
01	31 MAY / 17	ISSUED FOR AS-BUILT	SV

REVISIONS:

UNION31

UNION31 INC.
183 BATHURST STREET, STE 201
TORONTO, ON, M5T 2R7, CANADA
TEL: 416-597-1576 FAX: 416-597-2139

PROJECT NAME:
ALEXANDRA PARK
MAIN BUILDING
BLOCK 11
ON, Canada

PROJECT NO.: 13-949

DRAWING/S:
11TH FLOOR
CONSTRUCTION PLAN &
REFLECTED CEILING PLAN &
FLOOR & WALL FINISHES PLANS

DATE STARTED:	07 AUG / 13	DRAWING NO.:	ID 1.11.0
SCALE:	1 : 50		
DRAWN BY:	AP		
APPROVED BY:	KC		

36 x 48

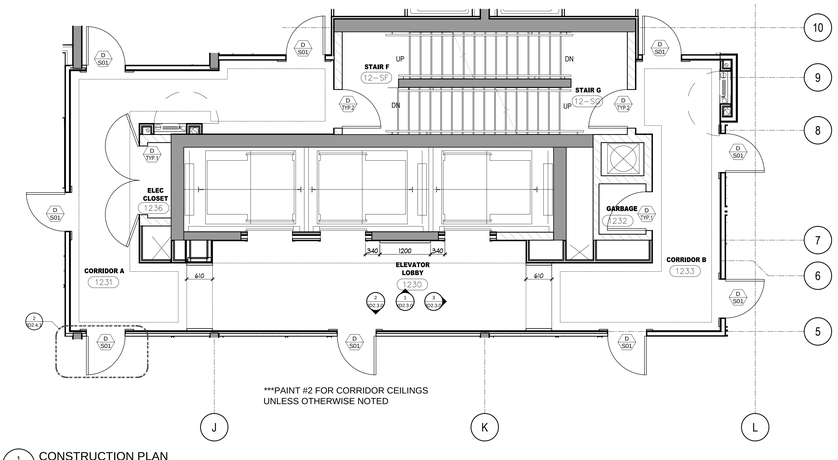

***PAINT #2 FOR CORRIDOR CEILINGS
UNLESS OTHERWISE NOTED

1 / ID1.12.0 CONSTRUCTION PLAN
12TH FLOOR SCALE 1:50

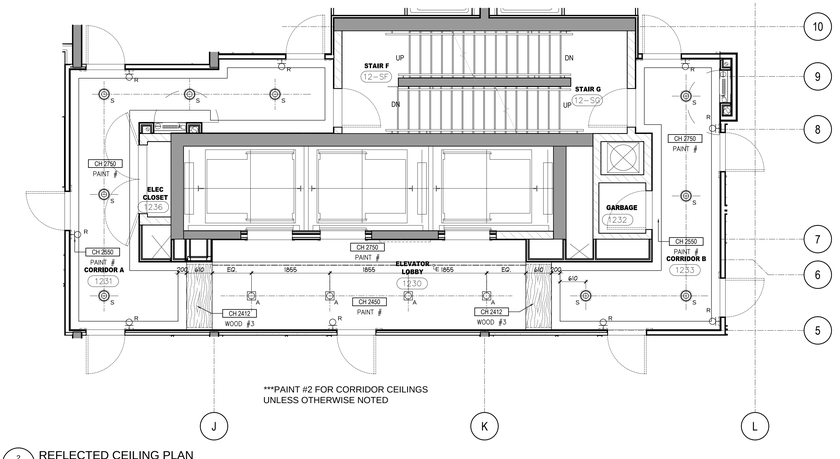

***PAINT #2 FOR CORRIDOR CEILINGS
UNLESS OTHERWISE NOTED

2 / ID1.12.0 REFLECTED CEILING PLAN
12TH FLOOR SCALE 1:50

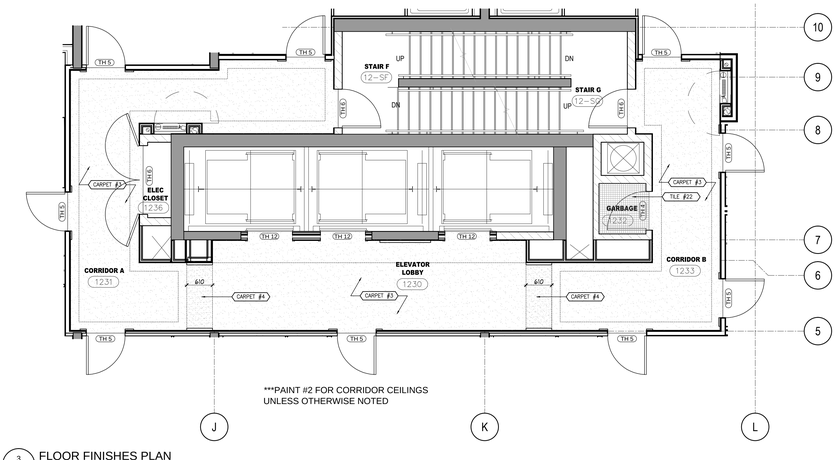

***PAINT #2 FOR CORRIDOR CEILINGS
UNLESS OTHERWISE NOTED

3 / ID1.12.0 FLOOR FINISHES PLAN
12TH FLOOR SCALE 1:50

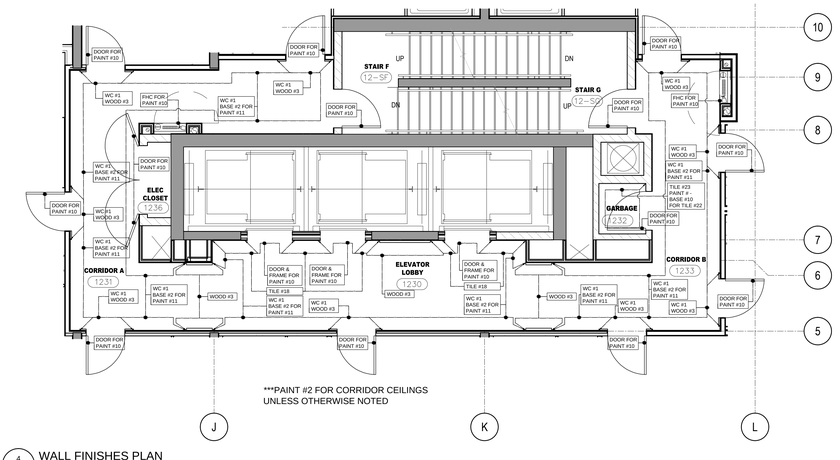

***PAINT #2 FOR CORRIDOR CEILINGS
UNLESS OTHERWISE NOTED

4 / ID1.12.0 WALL FINISHES PLAN
12TH FLOOR SCALE 1:50

DO NOT SCALE DRAWINGS.

CONTRACTOR MUST VERIFY ALL DRAWINGS, DIMENSIONS, DETAILS AND SPECIFICATIONS, AND REPORT ANY DISCREPANCIES TO *UNION 31 INC.* BEFORE PROCEEDING WITH WORK. MATERIALS MAY NOT BE SUBSTITUTED WITHOUT WRITTEN APPROVAL FROM *UNION 31 INC.*

ALL DRAWINGS AND SPECIFICATIONS ARE INSTRUMENTS OF SERVICE AND THE PROPERTY OF *UNION 31 INC.* WHICH MUST BE RETURNED AT THE COMPLETION OF THE WORK.

PRINTED: 30-May-17

ISSUED FOR AS-BUILT

NO.	DATE	COMMENTS	INI
01	31 MAY / 17	ISSUED FOR AS-BUILT	SV

REVISIONS:

UNION31

UNION31 INC.
183 BATHURST STREET, STE 201
TORONTO, ON, M5T 2R7, CANADA
TEL: 416-597-1576 FAX: 416-597-2139

PROJECT NAME:
ALEXANDRA PARK
MAIN BUILDING
BLOCK 11
ON, Canada

PROJECT NO.: 13-949

DRAWING/S:
12TH FLOOR
CONSTRUCTION PLAN &
REFLECTED CEILING PLAN &
FLOOR & WALL FINISHES PLANS

DATE STARTED:	07 AUG / 13	DRAWING NO.:	ID 1.12.0
SCALE:	1 : 50		
DRAWN BY:	AP		
APPROVED BY:	KC		

36 x 48

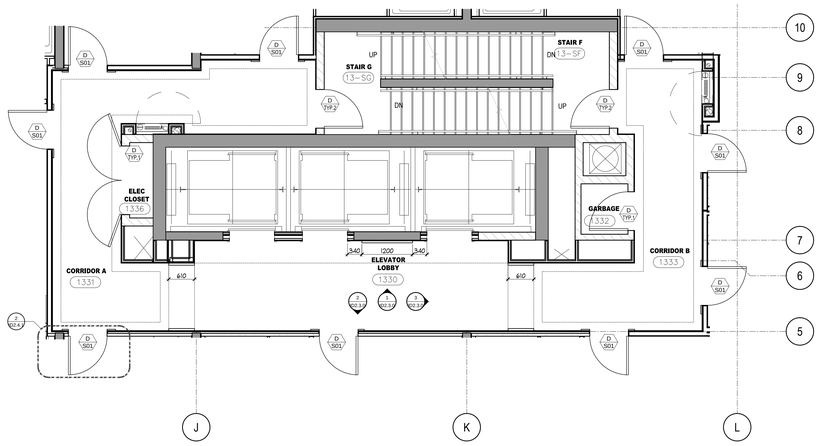

1 / ID1.13.0 CONSTRUCTION PLAN
13TH FLOOR SCALE 1:50

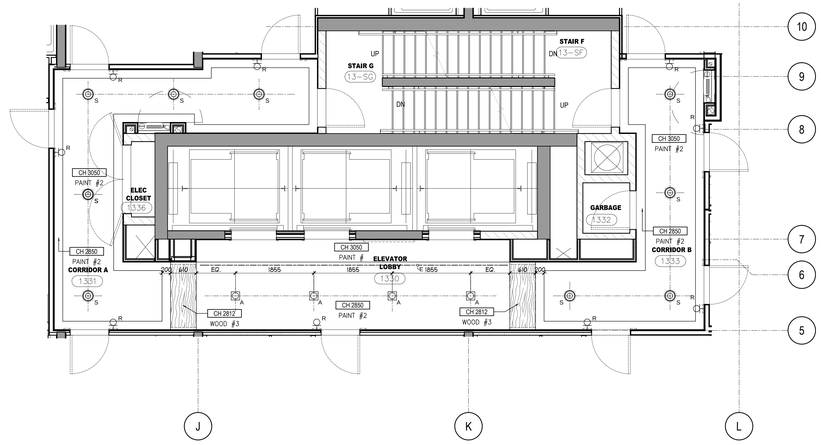

2 / ID1.13.0 REFLECTED CEILING PLAN
13TH FLOOR SCALE 1:50

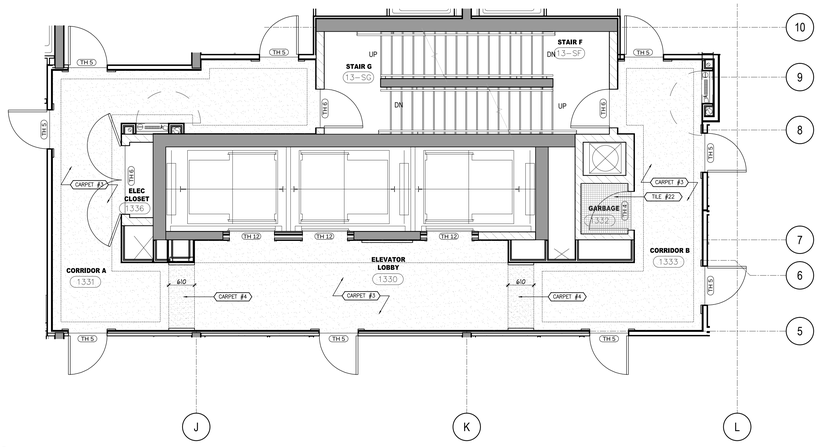

3 / ID1.13.0 FLOOR FINISHES PLAN
13TH FLOOR SCALE 1:50

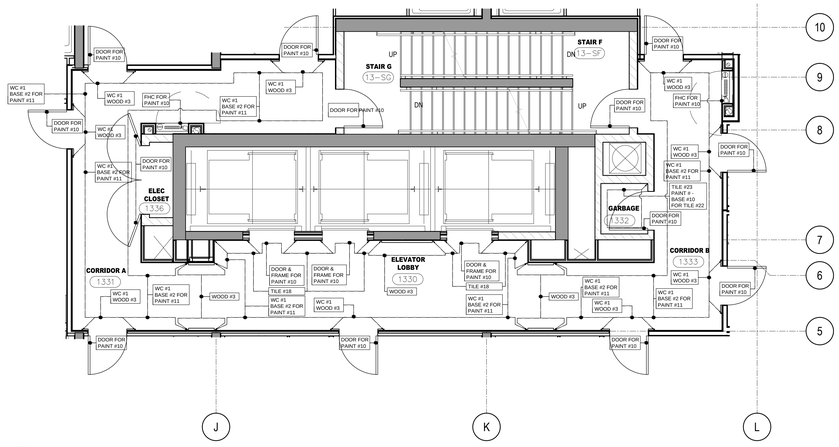

4 / ID1.13.0 WALL FINISHES PLAN
13TH FLOOR SCALE 1:50

DO NOT SCALE DRAWINGS.

CONTRACTOR MUST VERIFY ALL DRAWINGS, DIMENSIONS, DETAILS AND SPECIFICATIONS, AND REPORT ANY DISCREPANCIES TO *UNION 31 INC.* BEFORE PROCEEDING WITH WORK. MATERIALS MAY NOT BE SUBSTITUTED WITHOUT WRITTEN APPROVAL FROM *UNION 31 INC.*

ALL DRAWINGS AND SPECIFICATIONS ARE INSTRUMENTS OF SERVICE AND THE PROPERTY OF *UNION 31 INC.* WHICH MUST BE RETURNED AT THE COMPLETION OF THE WORK.

PRINTED: 30-May-17

ISSUED FOR AS-BUILT

NO.	DATE	COMMENTS	INI
01	31 MAY / 17	ISSUED FOR AS-BUILT	SV

REVISIONS:

UNION31

UNION31 INC.
183 BATHURST STREET, STE 201
TORONTO, ON, M5T 2R7, CANADA
TEL: 416-597-1576 FAX: 416-597-2139

PROJECT NAME:
ALEXANDRA PARK
MAIN BUILDING
BLOCK 11
ON, Canada

PROJECT NO.: 13-949

DRAWING/S:
13TH FLOOR
CONSTRUCTION PLAN &
REFLECTED CEILING PLAN &
FLOOR & WALL FINISHES PLANS

DATE STARTED:	07 AUG / 13	DRAWING NO.:	ID 1.13.0
SCALE:	1 : 50		
DRAWN BY:	AP		
APPROVED BY:	KC		

36 x 48

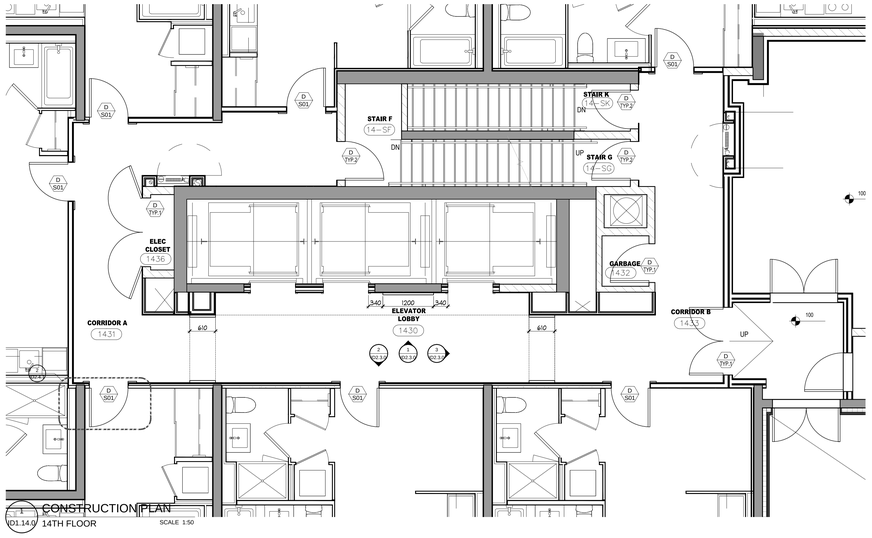

1 CONSTRUCTION PLAN
ID1.14.0 14TH FLOOR SCALE 1:50

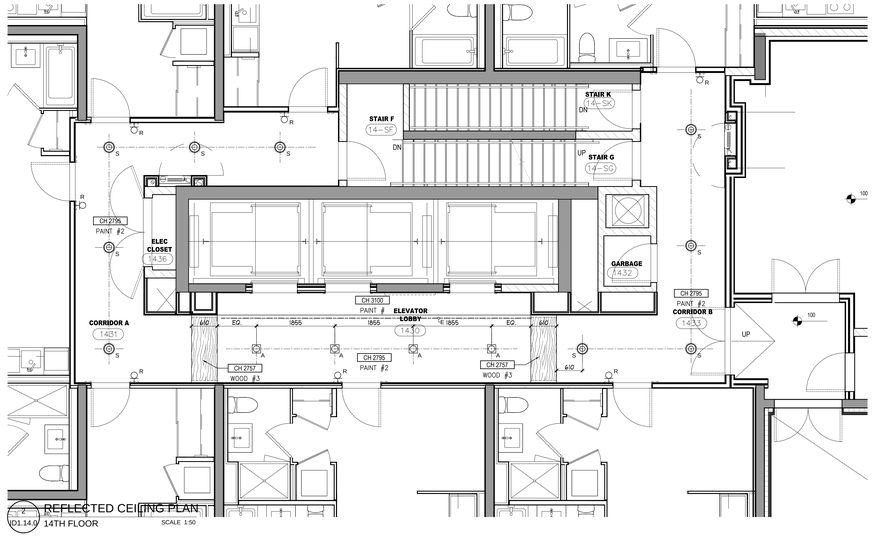

2 REFLECTED CEILING PLAN
ID1.14.0 14TH FLOOR SCALE 1:50

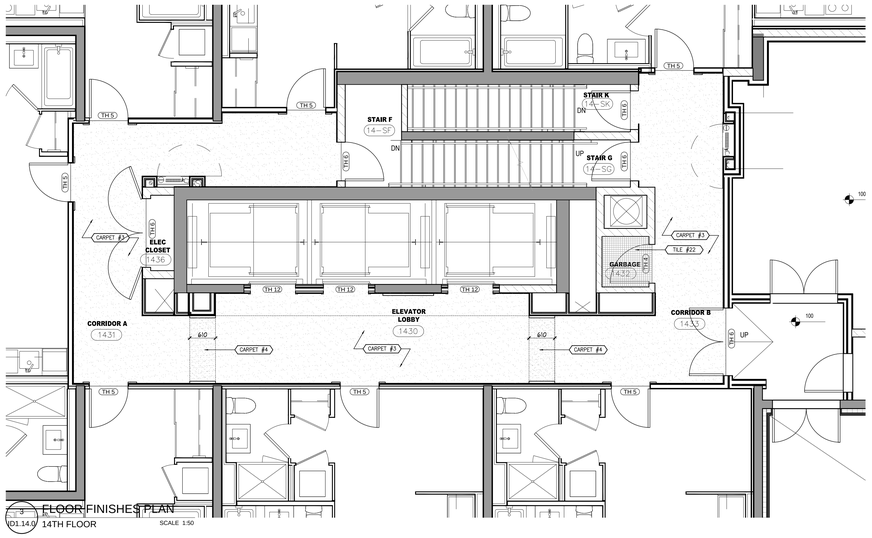

3 FLOOR FINISHES PLAN
ID1.14.0 14TH FLOOR SCALE 1:50

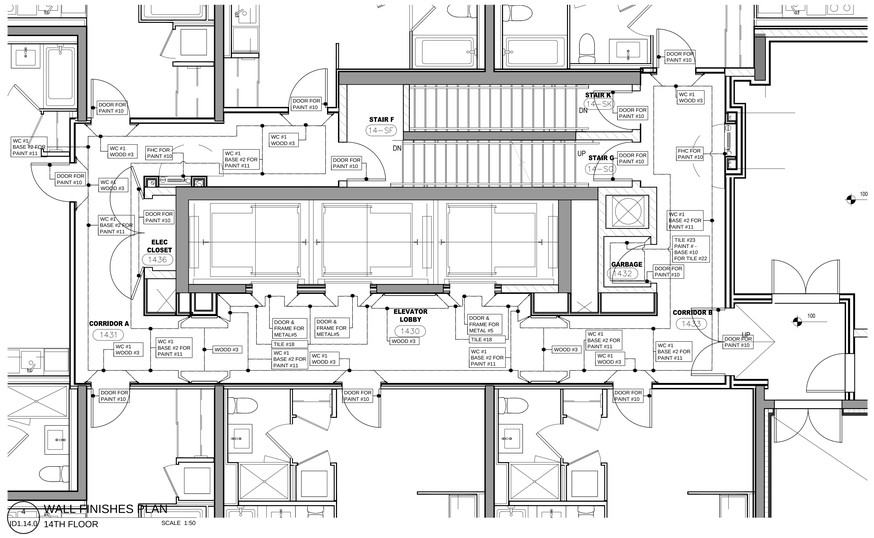

4 WALL FINISHES PLAN
ID1.14.0 14TH FLOOR SCALE 1:50

DO NOT SCALE DRAWINGS.

CONTRACTOR MUST VERIFY ALL DRAWINGS, DIMENSIONS, DETAILS AND SPECIFICATIONS, AND REPORT ANY DISCREPANCIES TO *UNION 31 INC.* BEFORE PROCEEDING WITH WORK. MATERIALS MAY NOT BE SUBSTITUTED WITHOUT WRITTEN APPROVAL FROM *UNION 31 INC.*

ALL DRAWINGS AND SPECIFICATIONS ARE INSTRUMENTS OF SERVICE AND THE PROPERTY OF *UNION 31 INC.* WHICH MUST BE RETURNED AT THE COMPLETION OF THE WORK.

PRINTED: 30-May-17

ISSUED FOR AS-BUILT

NO.	DATE	COMMENTS	INI
01	31 MAY / 17	ISSUED FOR AS-BUILT	SV

REVISIONS:

UNION31

UNION31 INC.
183 BATHURST STREET, STE 201
TORONTO, ON, M5T 2R7, CANADA
TEL: 416-597-1576 FAX: 416-597-2139

PROJECT NAME:
ALEXANDRA PARK
MAIN BUILDING
BLOCK 11
ON, Canada

PROJECT NO.: 13-949

DRAWING/S:
14TH FLOOR
CONSTRUCTION PLAN &
REFLECTED CEILING PLAN &
FLOOR & WALL FINISHES PLANS

DATE STARTED:	07 AUG / 13	DRAWING NO.:	ID 1.14.0
SCALE:	1 : 50		
DRAWN BY:	AP		
APPROVED BY:	KC		

36 x 48

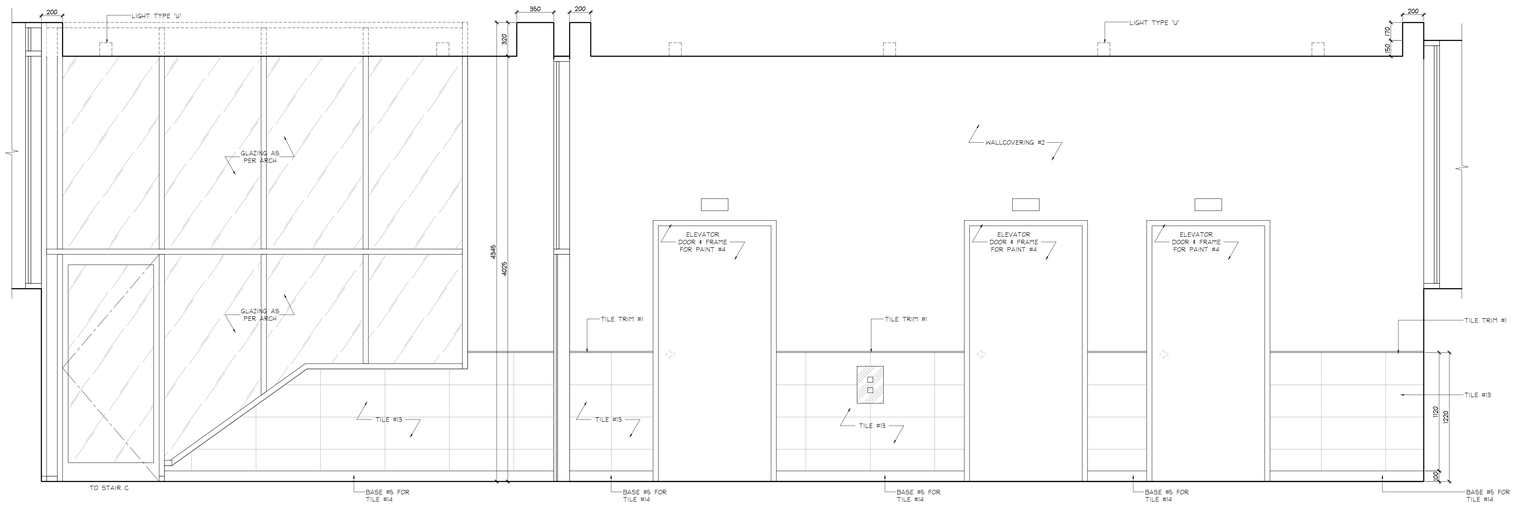

1 / ID2.0.0 ELEVATION
P2 LEVEL
ELEVATOR LOBBY
SCALE 1:20

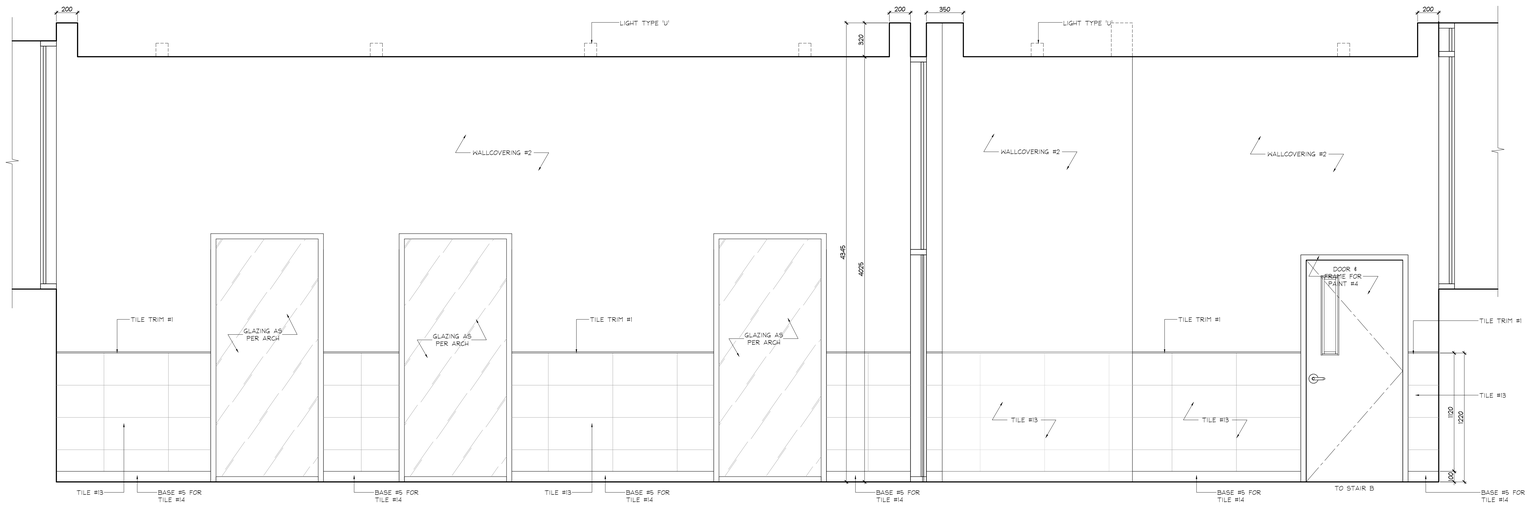

2 / ID2.0.0 ELEVATION
P2 LEVEL
ELEVATOR LOBBY
SCALE 1:20

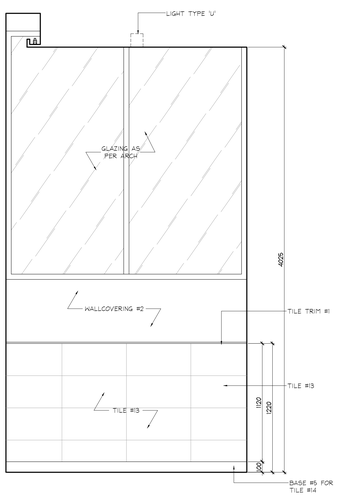

3 / ID2.0.0 ELEVATION
P2 LEVEL
ELEVATOR LOBBY
SCALE 1:20

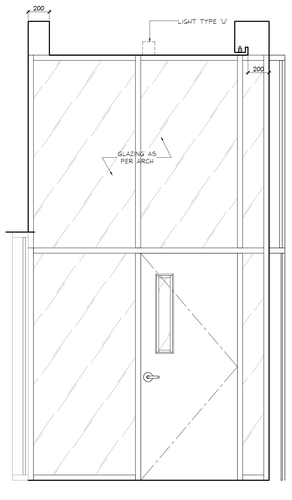

4 / ID2.0.0 ELEVATION
P2 LEVEL
ELEVATOR LOBBY
SCALE 1:20

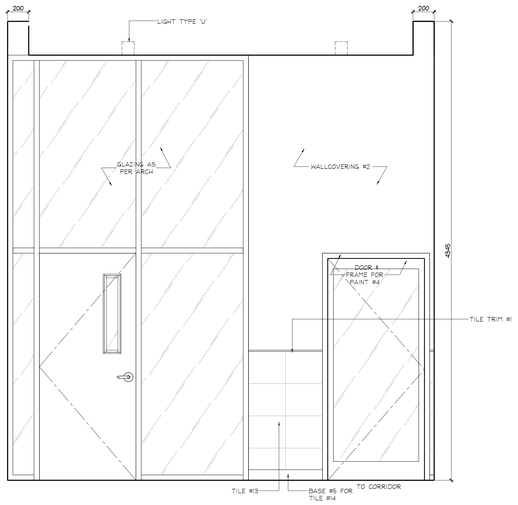

5 / ID2.0.0 ELEVATION
P2 LEVEL
VESTIBULE
SCALE 1:20

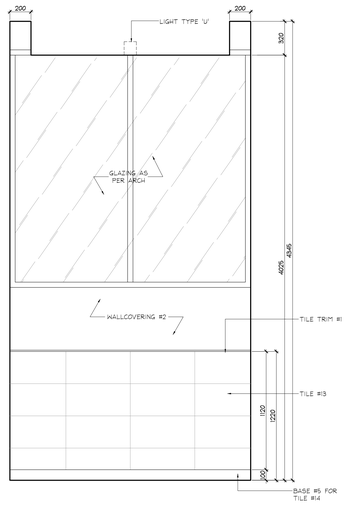

6 / ID2.0.0 ELEVATION
P2 LEVEL
VESTIBULE
SCALE 1:20

DO NOT SCALE DRAWINGS.

CONTRACTOR MUST VERIFY ALL DRAWINGS, DIMENSIONS, DETAILS AND SPECIFICATIONS, AND REPORT ANY DISCREPANCIES TO *UNION 31 INC.* BEFORE PROCEEDING WITH WORK. MATERIALS MAY NOT BE SUBSTITUTED WITHOUT WRITTEN APPROVAL FROM *UNION 31 INC.*

ALL DRAWINGS AND SPECIFICATIONS ARE INSTRUMENTS OF SERVICE AND THE PROPERTY OF *UNION 31 INC.* WHICH MUST BE RETURNED AT THE COMPLETION OF THE WORK.

PRINTED: 30-May-17

ISSUED FOR AS-BUILT

NO.	DATE	COMMENTS	INI
01	31 MAY / 17	ISSUED FOR AS-BUILT	SV

REVISIONS:

UNION31

UNION31 INC.
183 BATHURST STREET, STE 201
TORONTO, ON, M5T 2R7, CANADA
TEL: 416-597-1576 FAX: 416-597-2139

PROJECT NAME:
ALEXANDRA PARK
MAIN BUILDING
BLOCK 11
ON, Canada

PROJECT NO.: 13-949

DRAWING/S:
TYPICAL ELEVATIONS

DATE STARTED: 07 AUG / 13	DRAWING NO.:
SCALE: 1 : 20	ID 2.0.0
DRAWN BY: AP	
APPROVED BY: KC	

36 of 48

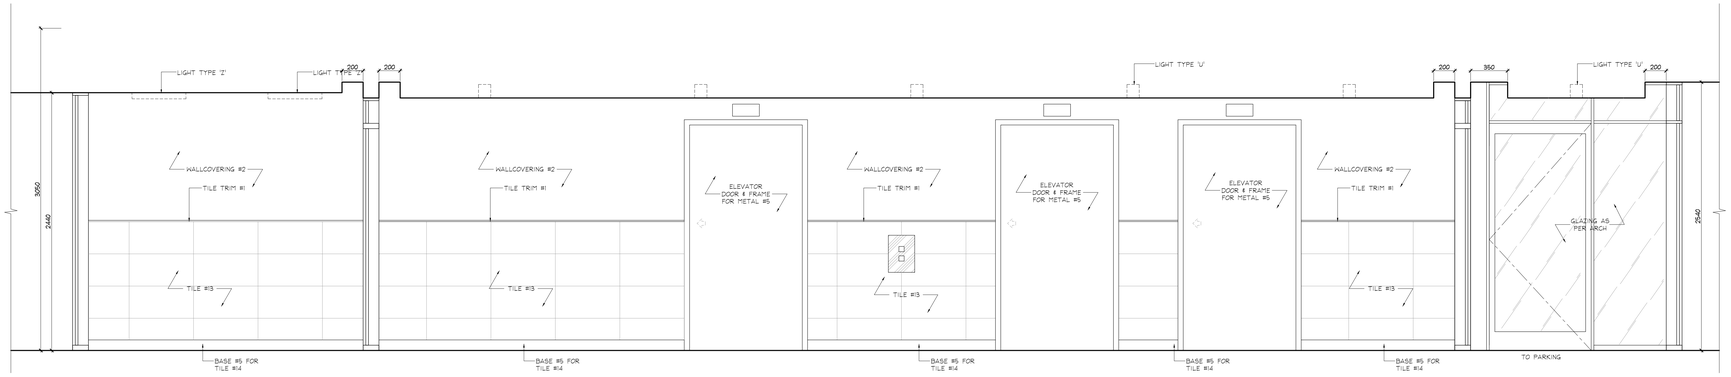

1 / ID2.0.1 ELEVATION
P1 LEVEL
ELEVATOR LOBBY
SCALE 1:20

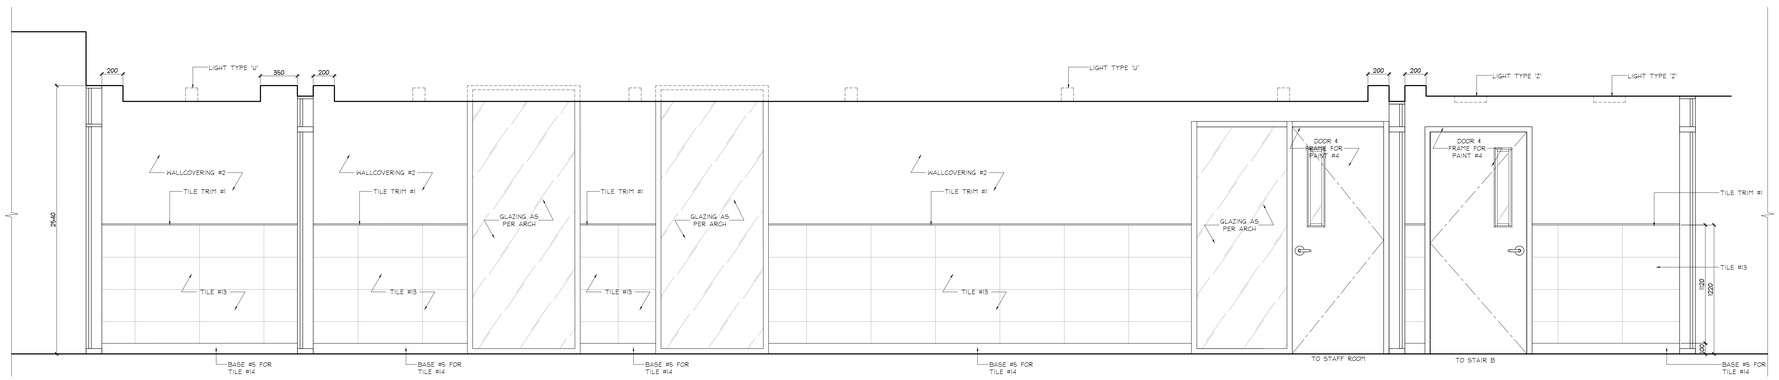

2 / ID2.0.1 ELEVATION
P1 LEVEL
ELEVATOR LOBBY
SCALE 1:20

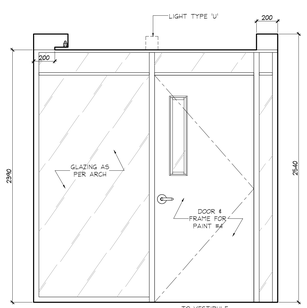

3 / ID2.0.1 ELEVATION
P1 LEVEL
ELEVATOR LOBBY
SCALE 1:20

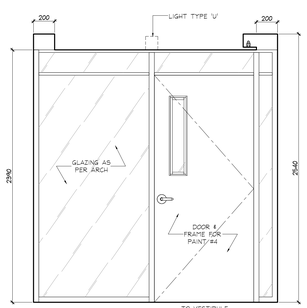

4 / ID2.0.1 ELEVATION
P1 LEVEL
ELEVATOR LOBBY
SCALE 1:20

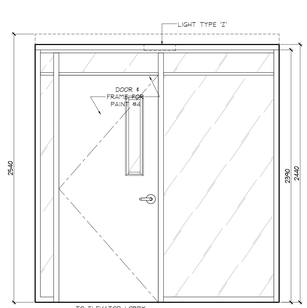

5 / ID2.0.1 ELEVATION
P1 LEVEL
VESTIBULE
SCALE 1:20

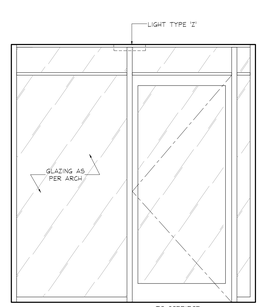

6 / ID2.0.1 ELEVATION
P1 LEVEL
VESTIBULE
SCALE 1:20

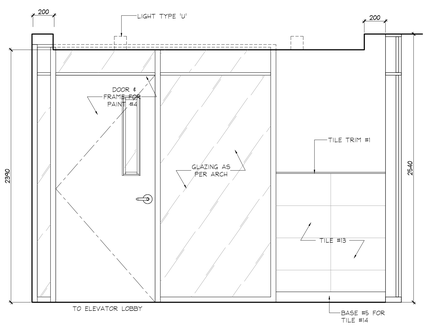

7 / ID2.0.1 ELEVATION
P1 LEVEL
VESTIBULE
SCALE 1:20

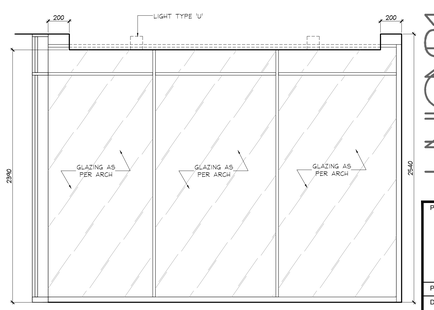

8 / ID2.0.1 ELEVATION
P1 LEVEL
VESTIBULE
SCALE 1:20

DO NOT SCALE DRAWINGS.

CONTRACTOR MUST VERIFY ALL DRAWINGS, DIMENSIONS, DETAILS AND SPECIFICATIONS, AND REPORT ANY DISCREPANCIES TO *UNION 31 INC.* BEFORE PROCEEDING WITH WORK. MATERIALS MAY NOT BE SUBSTITUTED WITHOUT WRITTEN APPROVAL FROM *UNION 31 INC.*

ALL DRAWINGS AND SPECIFICATIONS ARE INSTRUMENTS OF SERVICE AND THE PROPERTY OF *UNION 31 INC.* WHICH MUST BE RETURNED AT THE COMPLETION OF THE WORK.

PRINTED: 30-May-17

ISSUED FOR AS-BUILT

NO	DATE	COMMENTS	INI
01	31 MAY / 17	ISSUED FOR AS-BUILT	SV

REVISIONS:

UNION31

UNION31 INC.
183 BATHURST STREET, STE 201
TORONTO, ON, M5T 2R7, CANADA
TEL: 416-597-1576 FAX: 416-597-2139

PROJECT NAME:
ALEXANDRA PARK
MAIN BUILDING
BLOCK 11
ON, Canada

PROJECT NO.: 13-949

DRAWING/S:
PARKING LEVEL
ELEVATIONS

DATE STARTED: 07 AUG / 13	DRAWING NO.:
SCALE: 1 : 20	ID 2.0.1
DRAWN BY: AP	
APPROVED BY: KC	

38 of 48

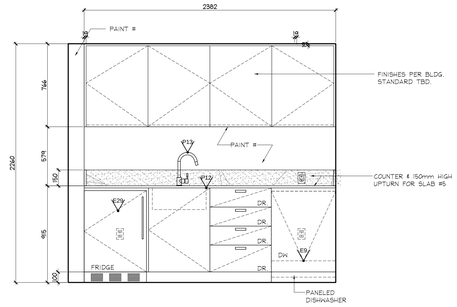

1 ID2.0.2 ELEVATION
P1 LEVEL
STAFF LUNCH ROOM
SCALE 1:20

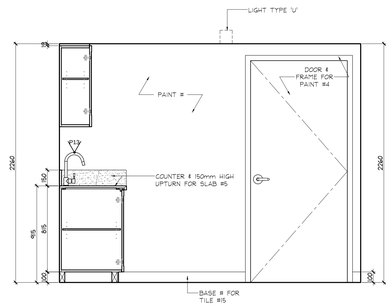

2 ID2.0.2 ELEVATION
P1 LEVEL
STAFF LUNCH ROOM
SCALE 1:20

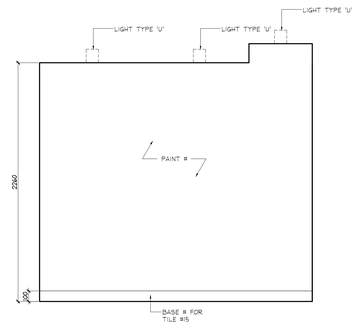

3 ID2.0.2 ELEVATION
P1 LEVEL
STAFF LUNCH ROOM
SCALE 1:20

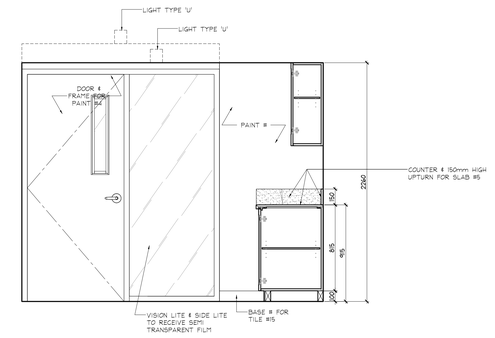

4 ID2.0.2 ELEVATION
P1 LEVEL
STAFF LUNCH ROOM
SCALE 1:20

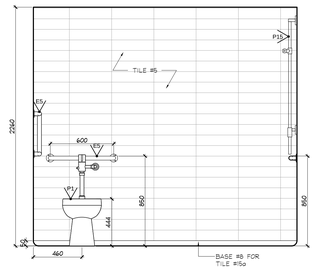

5 ID2.0.2 ELEVATION
P1 LEVEL
STAFF W./ CH./ SHOWER ROOM
SCALE 1:20

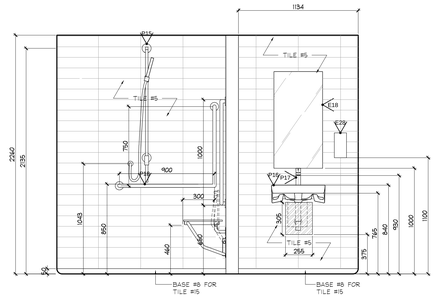

6 ID2.0.2 ELEVATION
P1 LEVEL
STAFF W./ CH./ SHOWER ROOM
SCALE 1:20

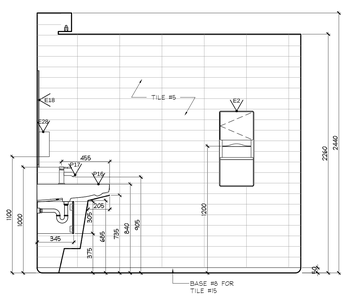

7 ID2.0.2 ELEVATION
P1 LEVEL
STAFF W./ CH./ SHOWER ROOM
SCALE 1:20

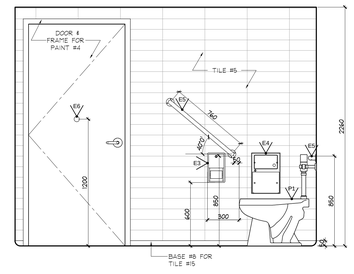

8 ID2.0.2 ELEVATION
P1 LEVEL
STAFF W./ CH./ SHOWER ROOM
SCALE 1:20

NOTE:
INSTALL ALL BARRIER FREE WASHROOM COMPONENTS ACCORDING TO OBC. REQUIREMENTS

DO NOT SCALE DRAWINGS.

CONTRACTOR MUST VERIFY ALL DRAWINGS, DIMENSIONS, DETAILS AND SPECIFICATIONS, AND REPORT ANY DISCREPANCIES TO *UNION 31 INC.* BEFORE PROCEEDING WITH WORK. MATERIALS MAY NOT BE SUBSTITUTED WITHOUT WRITTEN APPROVAL FROM *UNION 31 INC.*

ALL DRAWINGS AND SPECIFICATIONS ARE INSTRUMENTS OF SERVICE AND THE PROPERTY OF *UNION 31 INC.* WHICH MUST BE RETURNED AT THE COMPLETION OF THE WORK.

PRINTED: 30-May-17

ISSUED FOR AS-BUILT

NO.	DATE	COMMENTS	INI
01	31 MAY / 17	ISSUED FOR AS-BUILT	SV

REVISIONS:

UNION31

UNION31 INC.
183 BATHURST STREET, STE 201
TORONTO, ON, M5T 2R7, CANADA
TEL: 416-597-1576 FAX: 416-597-2139

PROJECT NAME:
ALEXANDRA PARK
MAIN BUILDING
BLOCK 11
ON, Canada

PROJECT NO.: 13-949

DRAWING/S:
PARKING LEVEL
ELEVATIONS

DATE STARTED:	07 AUG / 13	DRAWING NO.:	ID 2.0.2
SCALE:	1 : 20		
DRAWN BY:	AP		
APPROVED BY:	KC		

36 x 48

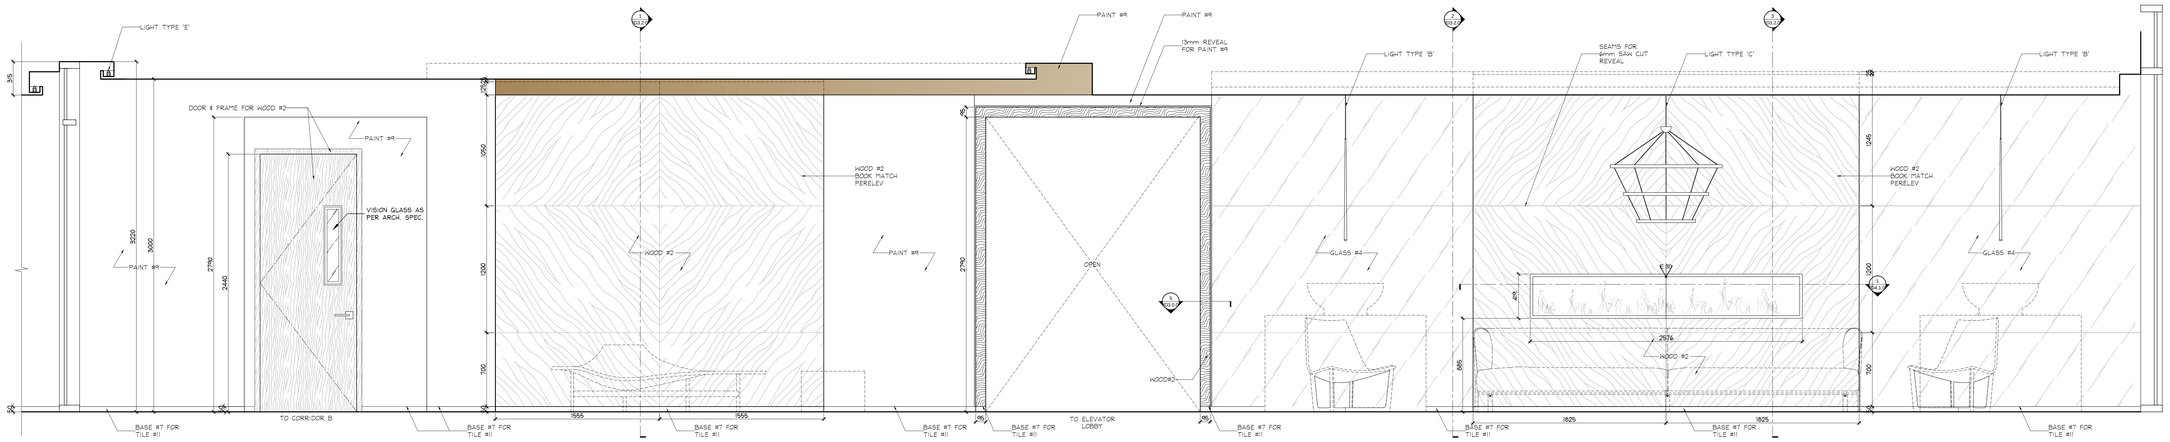

1 / ID2.1.0 ELEVATION
GROUND FLOOR
RESIDENTIAL LOBBY
SCALE 1:20

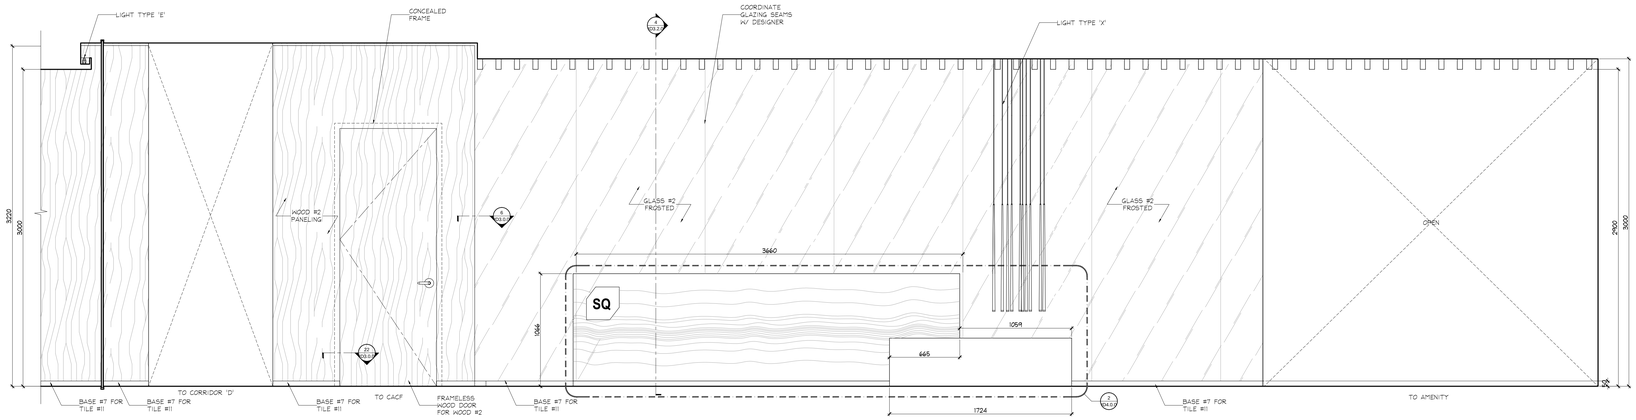

2 / ID2.1.0 ELEVATION
GROUND FLOOR
RESIDENTIAL LOBBY
SCALE 1:20

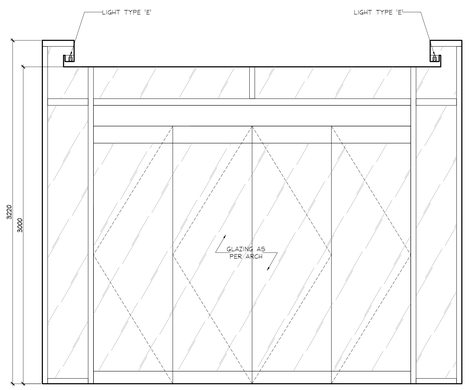

3 / ID2.1.0 ELEVATION
GROUND FLOOR
EAST VESTIBULE
SCALE 1:20

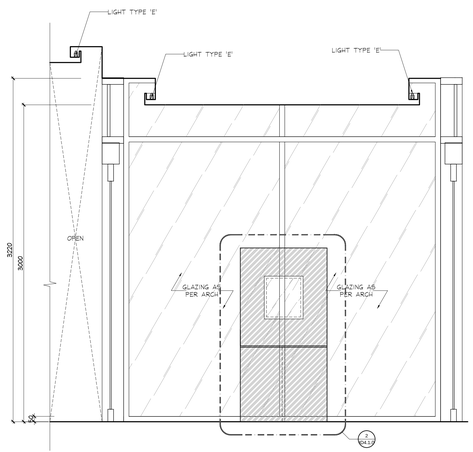

4 / ID2.1.0 ELEVATION
GROUND FLOOR
EAST VESTIBULE
SCALE 1:20

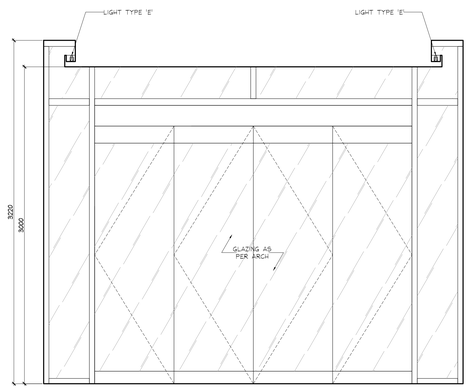

5 / ID2.1.0 ELEVATION
GROUND FLOOR
EAST VESTIBULE
SCALE 1:20

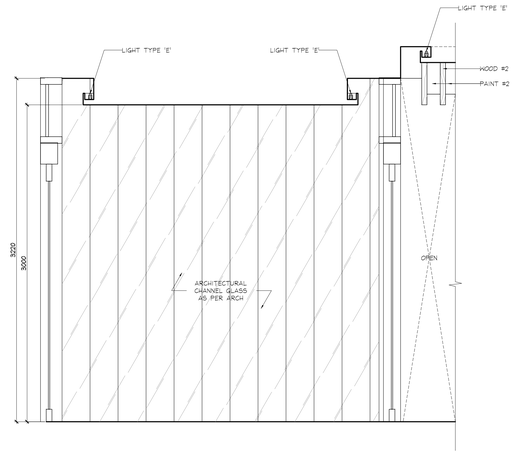

6 / ID2.1.0 ELEVATION
GROUND FLOOR
EAST VESTIBULE
SCALE 1:20

DO NOT SCALE DRAWINGS.

CONTRACTOR MUST VERIFY ALL DRAWINGS, DIMENSIONS, DETAILS AND SPECIFICATIONS, AND REPORT ANY DISCREPANCIES TO *UNION 31 INC.* BEFORE PROCEEDING WITH WORK. MATERIALS MAY NOT BE SUBSTITUTED WITHOUT WRITTEN APPROVAL FROM *UNION 31 INC.*

ALL DRAWINGS AND SPECIFICATIONS ARE INSTRUMENTS OF SERVICE AND THE PROPERTY OF *UNION 31 INC.* WHICH MUST BE RETURNED AT THE COMPLETION OF THE WORK.

PRINTED: 30-May-17

ISSUED FOR AS-BUILT

NO.	DATE	COMMENTS	INI
01	31 MAY / 17	ISSUED FOR AS-BUILT	SV

REVISIONS:

UNION31

UNION31 INC.
183 BATHURST STREET, STE 201
TORONTO, ON, M5T 2R7, CANADA
TEL: 416-597-1576 FAX: 416-597-2139

PROJECT NAME:
ALEXANDRA PARK
MAIN BUILDING
BLOCK 11
ON, Canada

PROJECT NO.: 13-949

DRAWING/S:
GROUND FLOOR ELEVATIONS

DATE STARTED: 07 AUG / 13	DRAWING NO.:
SCALE: 1 : 20	ID 2.1.0
DRAWN BY: AP	
APPROVED BY: KC	

36 x 48

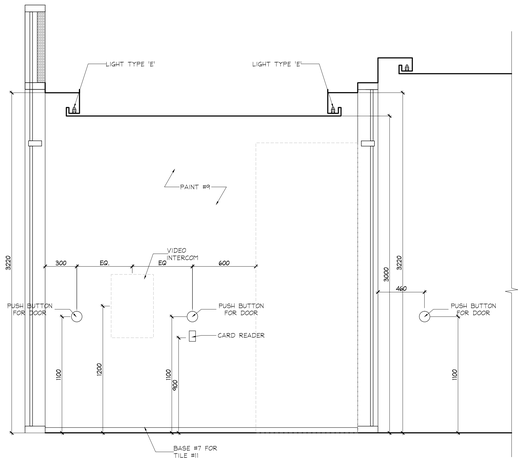

1 / ID2.1.1 ELEVATION
GROUND FLOOR
WEST VESTIBULE
SCALE 1:20

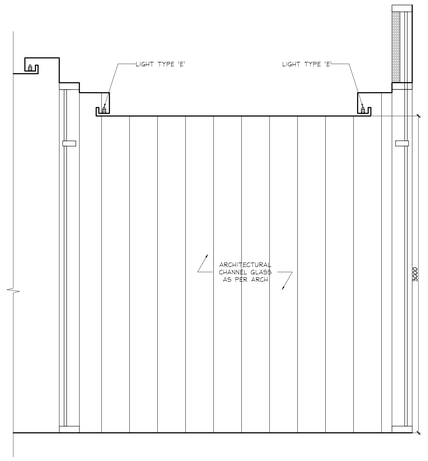

2 / ID2.1.1 ELEVATION
GROUND FLOOR
WEST VESTIBULE
SCALE 1:20

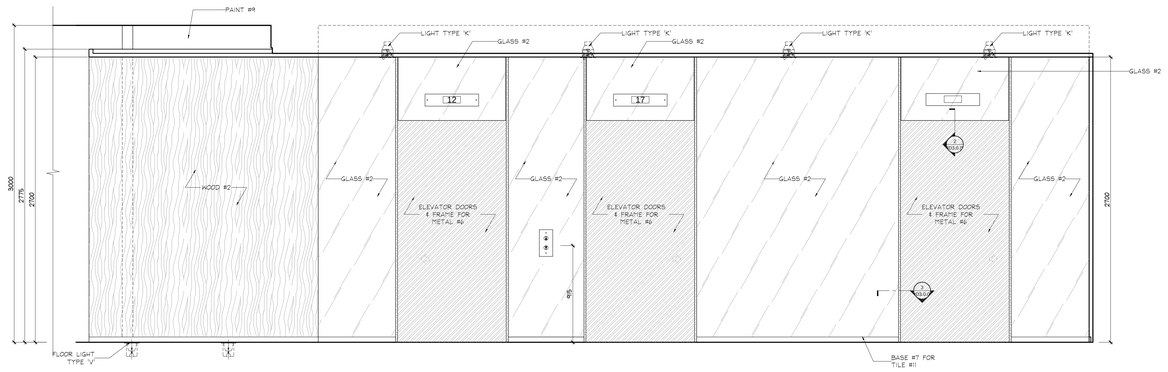

3 / ID2.1.1 ELEVATION
GROUND FLOOR
ELEVATOR LOBBY
SCALE 1:20

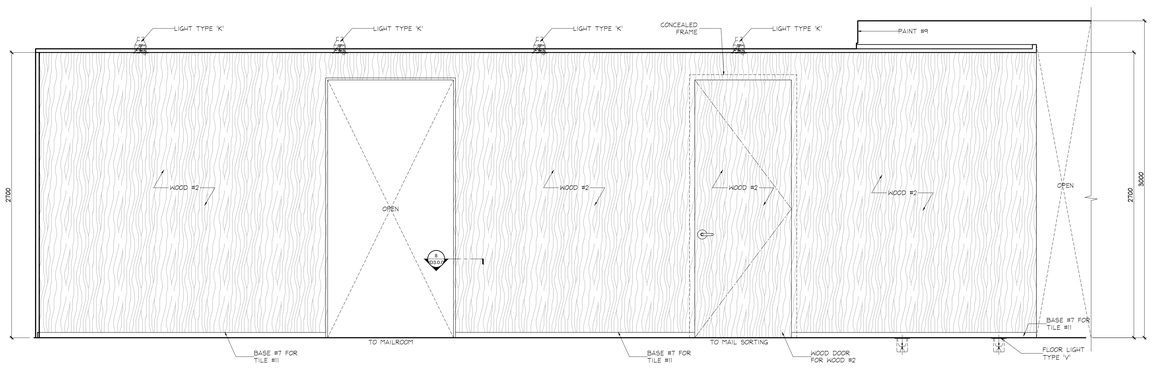

4 / ID2.1.1 ELEVATION
GROUND FLOOR
RESIDENTIAL LOBBY
SCALE 1:20

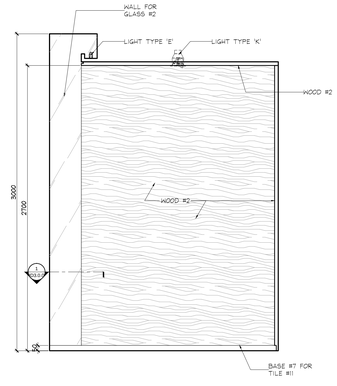

5 / ID2.1.1 ELEVATION
GROUND FLOOR
RESIDENTIAL LOBBY
SCALE 1:20

DO NOT SCALE DRAWINGS.

CONTRACTOR MUST VERIFY ALL DRAWINGS, DIMENSIONS, DETAILS AND SPECIFICATIONS, AND REPORT ANY DISCREPANCIES TO *UNION 31 INC.* BEFORE PROCEEDING WITH WORK. MATERIALS MAY NOT BE SUBSTITUTED WITHOUT WRITTEN APPROVAL FROM *UNION 31 INC.*

ALL DRAWINGS AND SPECIFICATIONS ARE INSTRUMENTS OF SERVICE AND THE PROPERTY OF *UNION 31 INC.* WHICH MUST BE RETURNED AT THE COMPLETION OF THE WORK.

PRINTED: 30-May-17

ISSUED FOR AS-BUILT

NO.	DATE	COMMENTS	INI
01.	31 MAY / 17	ISSUED FOR AS-BUILT	SV

REVISIONS:

UNION31

UNION31 INC.
183 BATHURST STREET, STE 201
TORONTO, ON, M5T 2R7, CANADA
TEL: 416-597-1576 FAX: 416-597-2139

PROJECT NAME:
ALEXANDRA PARK
MAIN BUILDING
BLOCK 11
ON, Canada

PROJECT NO.: 13-949

DRAWING/S:
GROUND FLOOR
ELEVATIONS

DATE STARTED:	07 AUG / 13	DRAWING NO.:	ID 2.1.1
SCALE:	1 : 20		
DRAWN BY:	AP		
APPROVED BY:	KC		

35 x 48

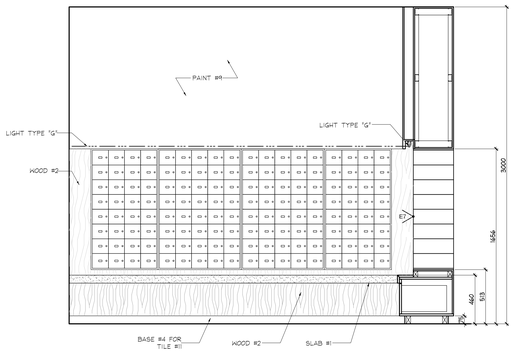

1 ID2.1.2 ELEVATION
GROUND FLOOR
MAILROOM
SCALE 1:20

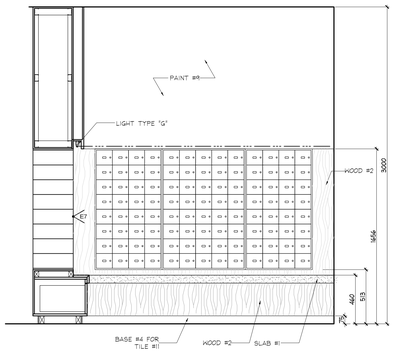

2 ID2.1.2 ELEVATION
GROUND FLOOR
MAILROOM
SCALE 1:20

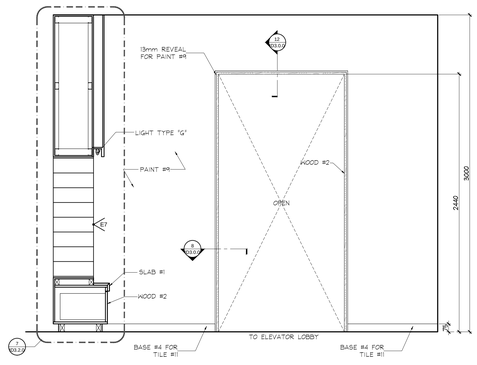

3 ID2.1.2 ELEVATION
GROUND FLOOR
MAILROOM
SCALE 1:20

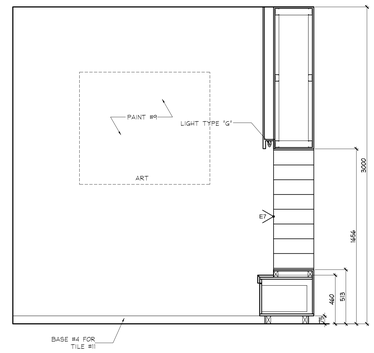

4 ID2.1.2 ELEVATION
GROUND FLOOR
MAILROOM
SCALE 1:20

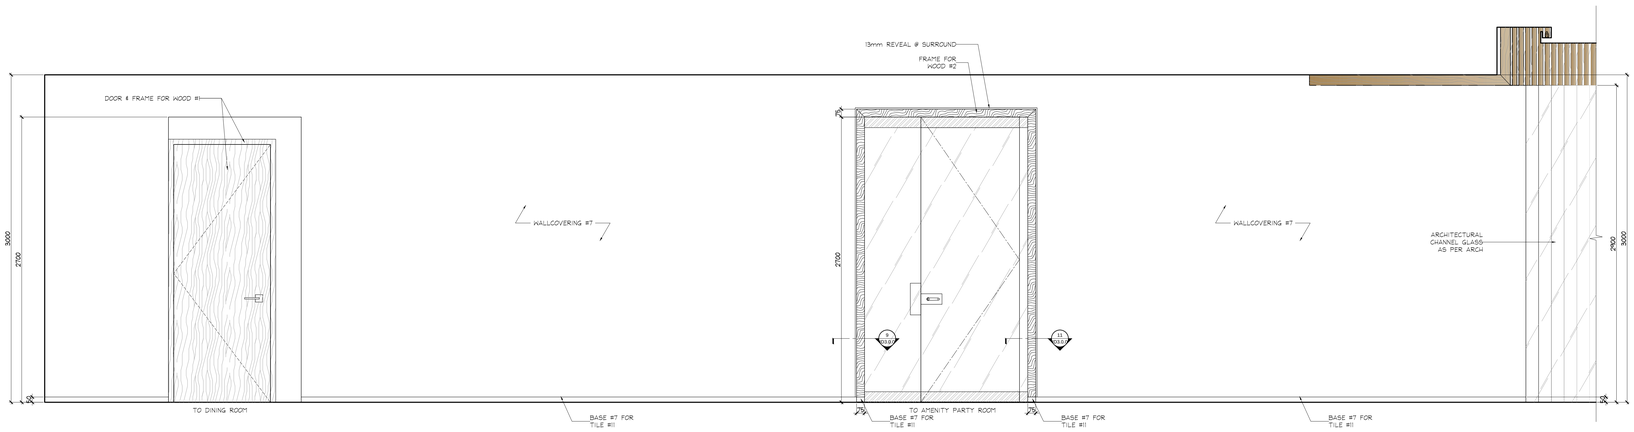

5 ID2.1.2 ELEVATION
GROUND FLOOR
CORRIDOR C
SCALE 1:20

6 ID2.1.2 ELEVATION
GROUND FLOOR
CORRIDOR C
SCALE 1:20

DO NOT SCALE DRAWINGS.

CONTRACTOR MUST VERIFY ALL DRAWINGS, DIMENSIONS, DETAILS AND SPECIFICATIONS, AND REPORT ANY DISCREPANCIES TO *UNION 31 INC.* BEFORE PROCEEDING WITH WORK. MATERIALS MAY NOT BE SUBSTITUTED WITHOUT WRITTEN APPROVAL FROM *UNION 31 INC.*

ALL DRAWINGS AND SPECIFICATIONS ARE INSTRUMENTS OF SERVICE AND THE PROPERTY OF *UNION 31 INC.* WHICH MUST BE RETURNED AT THE COMPLETION OF THE WORK.

PRINTED: 30-May-17

ISSUED FOR AS-BUILT

NO.	DATE	COMMENTS	INI
01	31 MAY / 17	ISSUED FOR AS-BUILT	SV

REVISIONS:

UNION31

UNION31 INC.
183 BATHURST STREET, STE 201
TORONTO, ON, M5T 2R7, CANADA
TEL: 416-597-1576 FAX: 416-597-2139

PROJECT NAME:
ALEXANDRA PARK
MAIN BUILDING
BLOCK 11
ON, Canada

PROJECT NO.: 13-949

DRAWINGS:
GROUND FLOOR
ELEVATIONS

DATE STARTED:	07 AUG / 13	DRAWING NO.:	ID 2.1.2
SCALE:	1 : 20		
DRAWN BY:	AP		
APPROVED BY:	KC		

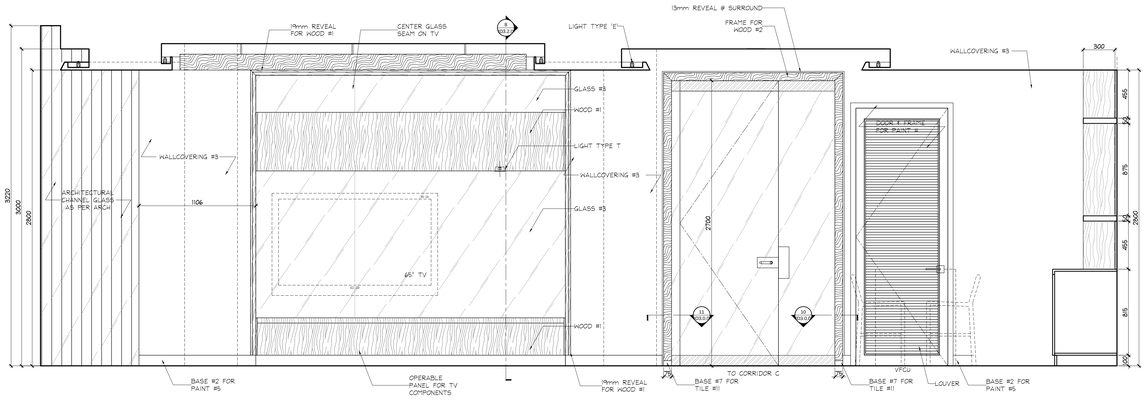

1 ID2.1.3 ELEVATION
GROUND FLOOR
AMENITY PARTY ROOM
SCALE 1:20

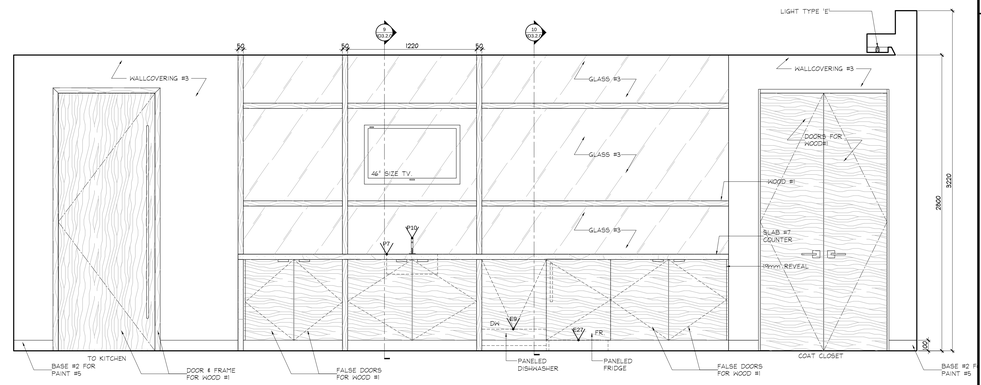

2 ID2.1.3 ELEVATION
GROUND FLOOR
AMENITY PARTY ROOM
SCALE 1:20

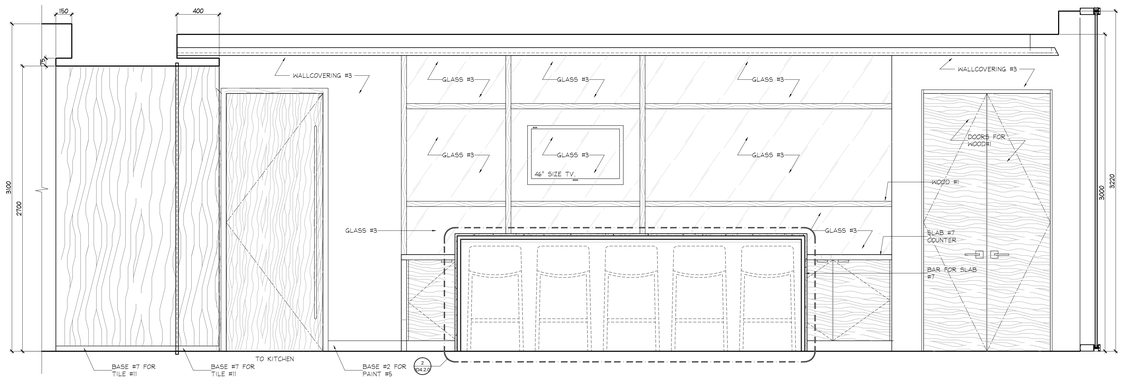

3 ID2.1.3 ELEVATION
GROUND FLOOR
AMENITY PARTY ROOM
SCALE 1:20

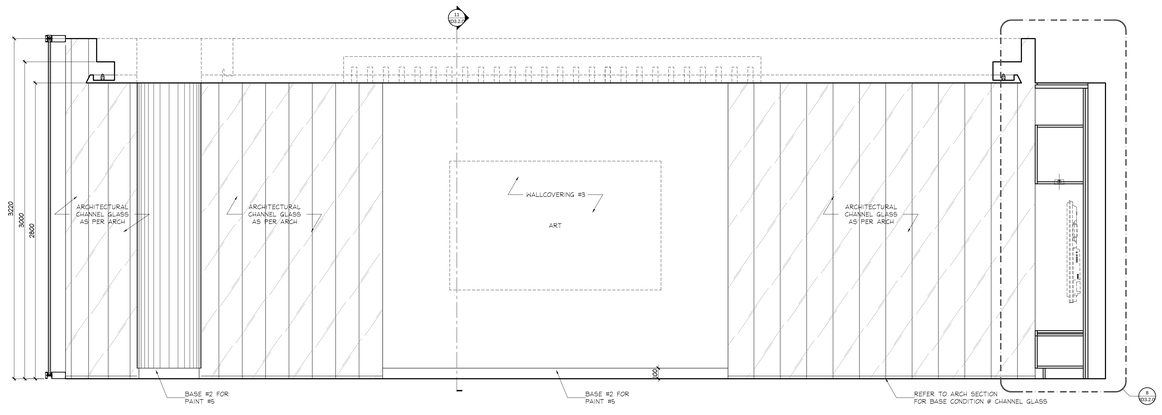

4 ID2.1.3 ELEVATION
GROUND FLOOR
AMENITY PARTY ROOM
SCALE 1:20

DO NOT SCALE DRAWINGS.

CONTRACTOR MUST VERIFY ALL DRAWINGS, DIMENSIONS, DETAILS AND SPECIFICATIONS, AND REPORT ANY DISCREPANCIES TO *UNION 31 INC.* BEFORE PROCEEDING WITH WORK. MATERIALS MAY NOT BE SUBSTITUTED WITHOUT WRITTEN APPROVAL FROM *UNION 31 INC.*

ALL DRAWINGS AND SPECIFICATIONS ARE INSTRUMENTS OF SERVICE AND THE PROPERTY OF *UNION 31 INC.* WHICH MUST BE RETURNED AT THE COMPLETION OF THE WORK.

PRINTED: 30-May-17

ISSUED FOR AS-BUILT

NO.	DATE	COMMENTS	INI
01	31 MAY / 17	ISSUED FOR AS-BUILT	SV

REVISIONS:

UNION31

UNION31 INC.
183 BATHURST STREET, STE 201
TORONTO, ON, M5T 2R7, CANADA
TEL: 416-597-1576 FAX: 416-597-2139

PROJECT NAME:
ALEXANDRA PARK
MAIN BUILDING
BLOCK 11
ON, Canada

PROJECT NO.: 13-949

DRAWING/S:
GROUND FLOOR
ELEVATIONS

DATE STARTED: 07 AUG / 13	DRAWING NO.:
SCALE: 1 : 20	ID 2.1.3
DRAWN BY: AP	
APPROVED BY: KC	

36 x 48

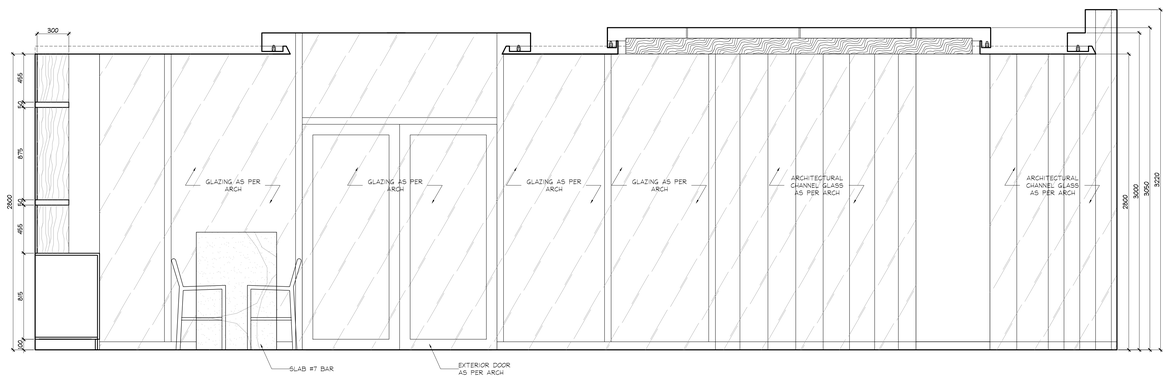

1 ID2.1.4 ELEVATION
GROUND FLOOR
AMENITY PARTY ROOM
SCALE 1:20

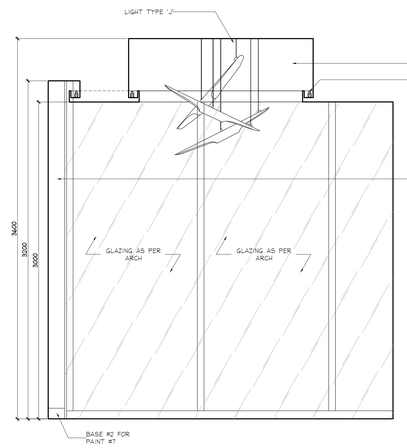

2 ID2.1.4 ELEVATION
GROUND FLOOR
DINING ROOM
SCALE 1:20

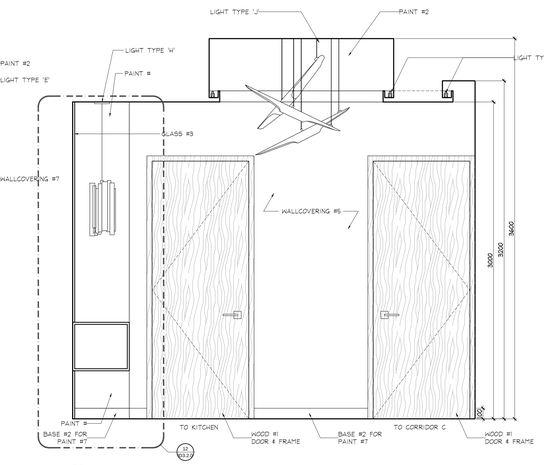

3 ID2.1.4 ELEVATION
GROUND FLOOR
DINING ROOM
SCALE 1:20

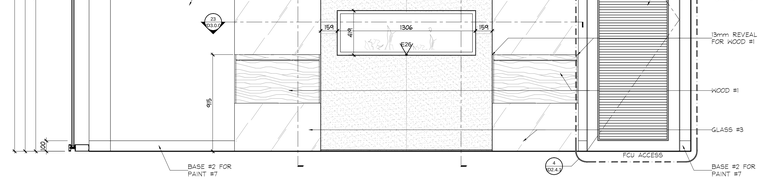

4 ID2.1.4 ELEVATION
GROUND FLOOR
DINING ROOM
SCALE 1:20

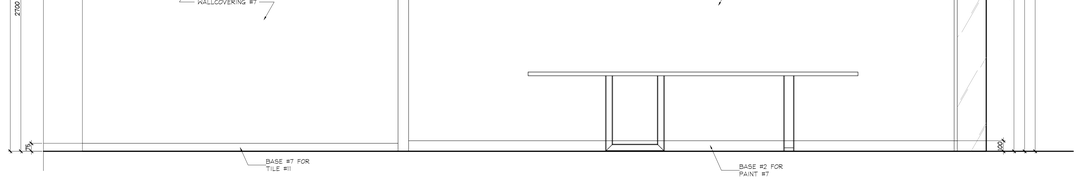

5 ID2.1.4 ELEVATION
GROUND FLOOR
DINING ROOM
SCALE 1:20

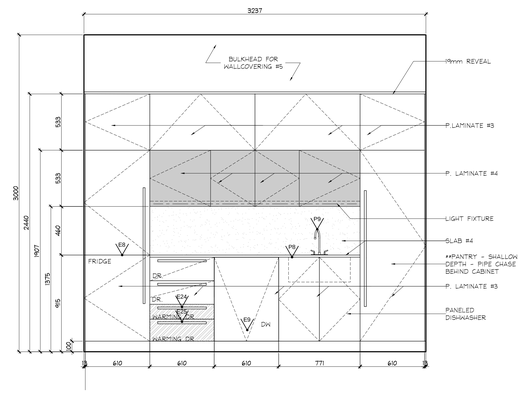

6 ID2.1.4 ELEVATION
GROUND FLOOR
KITCHEN
SCALE 1:20

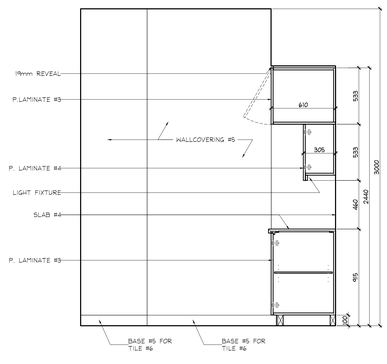

7 ID2.1.4 ELEVATION
GROUND FLOOR
KITCHEN
SCALE 1:20

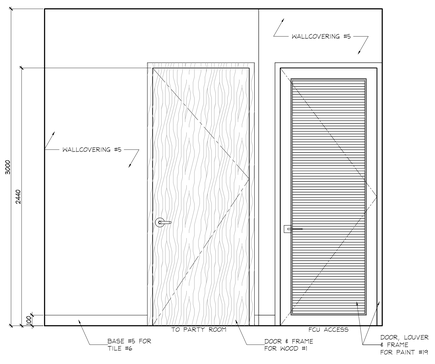

8 ID2.1.4 ELEVATION
GROUND FLOOR
KITCHEN
SCALE 1:20

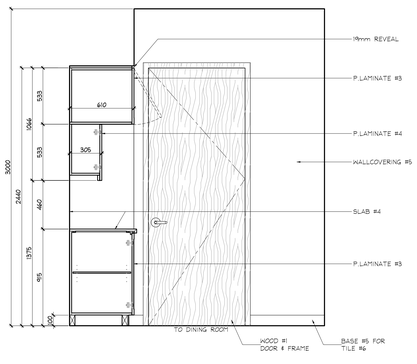

9 ID2.1.4 ELEVATION
GROUND FLOOR
KITCHEN
SCALE 1:20

DO NOT SCALE DRAWINGS.

CONTRACTOR MUST VERIFY ALL DRAWINGS, DIMENSIONS, DETAILS AND SPECIFICATIONS, AND REPORT ANY DISCREPANCIES TO *UNION 31 INC.* BEFORE PROCEEDING WITH WORK. MATERIALS MAY NOT BE SUBSTITUTED WITHOUT WRITTEN APPROVAL FROM *UNION 31 INC.*

ALL DRAWINGS AND SPECIFICATIONS ARE INSTRUMENTS OF SERVICE AND THE PROPERTY OF *UNION 31 INC.* WHICH MUST BE RETURNED AT THE COMPLETION OF THE WORK.

PRINTED: 30-May-17

ISSUED FOR AS-BUILT

NO	DATE	COMMENTS	INI
01	31 MAY / 17	ISSUED FOR AS-BUILT	SV

REVISIONS:

UNION31

UNION31 INC.
183 BATHURST STREET, STE 201
TORONTO, ON, M5T 2R7, CANADA
TEL: 416-597-1576 FAX: 416-597-2139

PROJECT NAME:
ALEXANDRA PARK
MAIN BUILDING
BLOCK 11
ON, Canada

PROJECT NO.: 13-949

DRAWING/S:
GROUND FLOOR
ELEVATIONS

DATE STARTED: 07 AUG / 13	DRAWING NO.:
SCALE: 1 : 20	ID 2.1.4
DRAWN BY: AP	
APPROVED BY: KC	

38 of 48

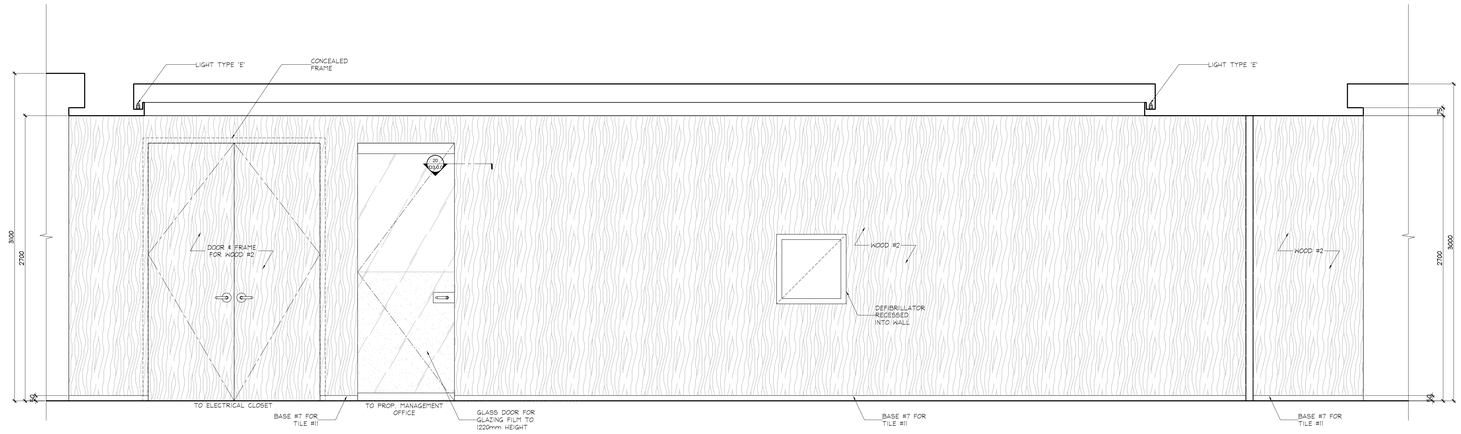

2 / ID2.1.5 ELEVATION
GROUND FLOOR
CORRIDOR D
SCALE 1:20

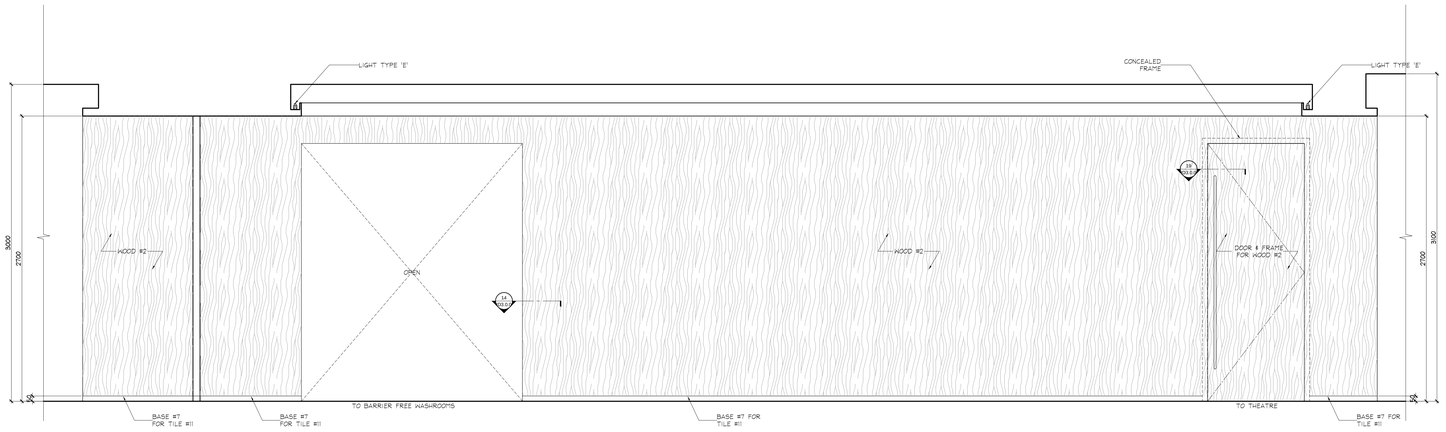

2 / ID2.1.5 ELEVATION
GROUND FLOOR
CORRIDOR D
SCALE 1:20

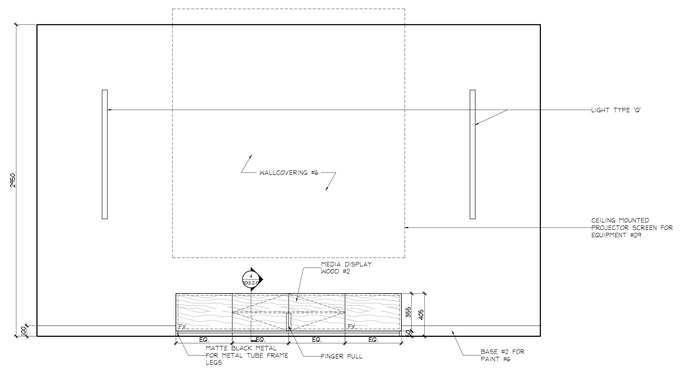

3 / ID2.1.5 ELEVATION
GROUND FLOOR
THEATRE
SCALE 1:20

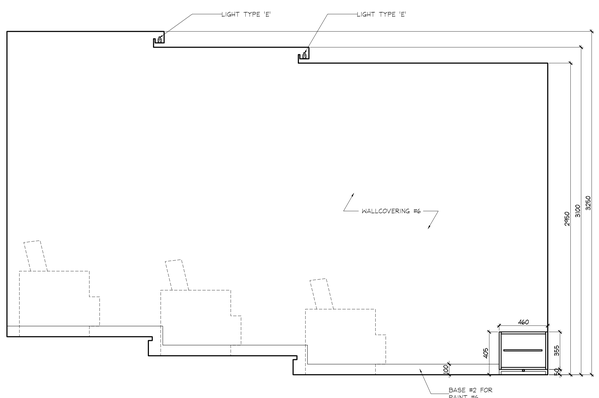

4 / ID2.1.5 ELEVATION
GROUND FLOOR
THEATRE
SCALE 1:20

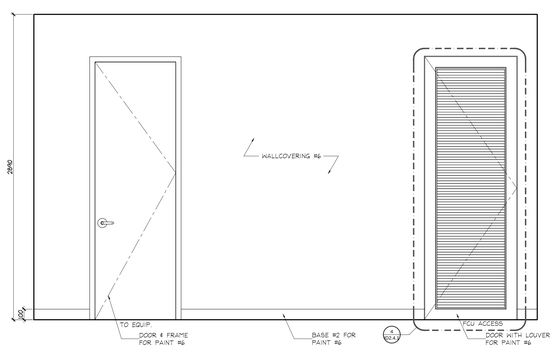

5 / ID2.1.5 ELEVATION
GROUND FLOOR
THEATRE
SCALE 1:20

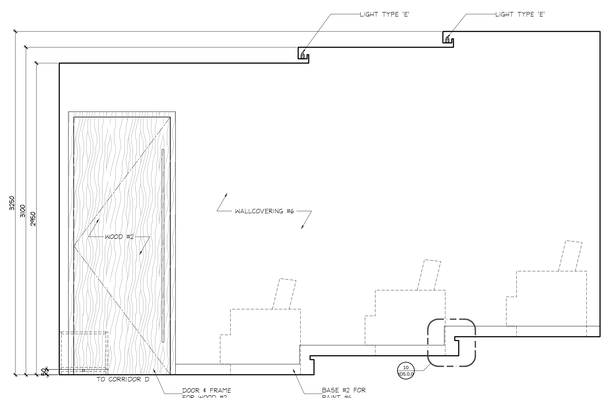

6 / ID2.1.5 ELEVATION
GROUND FLOOR
THEATRE
SCALE 1:20

DO NOT SCALE DRAWINGS.

CONTRACTOR MUST VERIFY ALL DRAWINGS, DIMENSIONS, DETAILS AND SPECIFICATIONS, AND REPORT ANY DISCREPANCIES TO *UNION 31 INC.* BEFORE PROCEEDING WITH WORK. MATERIALS MAY NOT BE SUBSTITUTED WITHOUT WRITTEN APPROVAL FROM *UNION 31 INC.*

ALL DRAWINGS AND SPECIFICATIONS ARE INSTRUMENTS OF SERVICE AND THE PROPERTY OF *UNION 31 INC.* WHICH MUST BE RETURNED AT THE COMPLETION OF THE WORK.

PRINTED: 30-May-17

ISSUED FOR AS-BUILT

NO.	DATE	COMMENTS	INI
01	31 MAY / 17	ISSUED FOR AS-BUILT	SV

REVISIONS:

UNION31

UNION31 INC.
183 BATHURST STREET, STE 201
TORONTO, ON, M5T 2R7, CANADA
TEL: 416-597-1576 FAX: 416-597-2139

PROJECT NAME:
ALEXANDRA PARK
MAIN BUILDING
BLOCK 11
ON, Canada

PROJECT NO.: 13-949

DRAWING/S:
GROUND FLOOR
ELEVATIONS

DATE STARTED:	07 AUG / 13	DRAWING NO.:	ID 2.1.5
SCALE:	1 : 20		
DRAWN BY:	AP		
APPROVED BY:	KC		

ARCH D

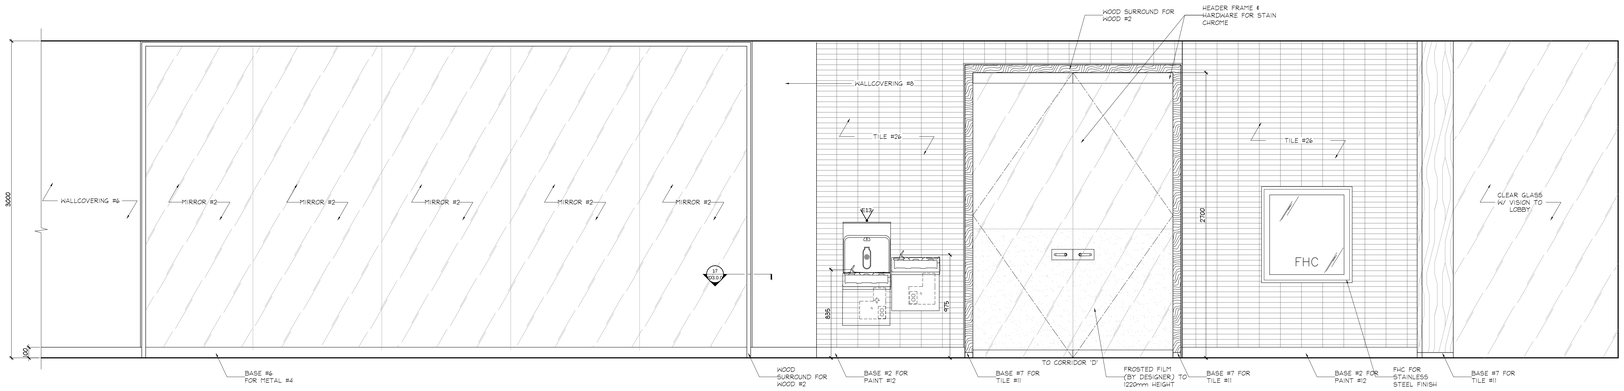

1 ID2.1.6 ELEVATION
GROUND FLOOR
STRETCHING AREA
SCALE 1:20

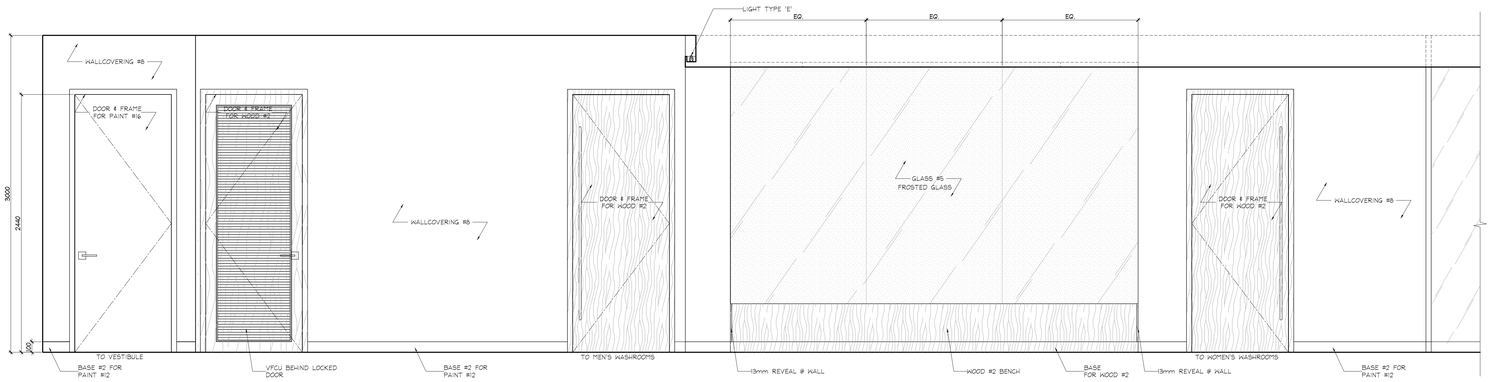

2 ID2.1.6 ELEVATION
GROUND FLOOR
WEIGHT ROOM
SCALE 1:20

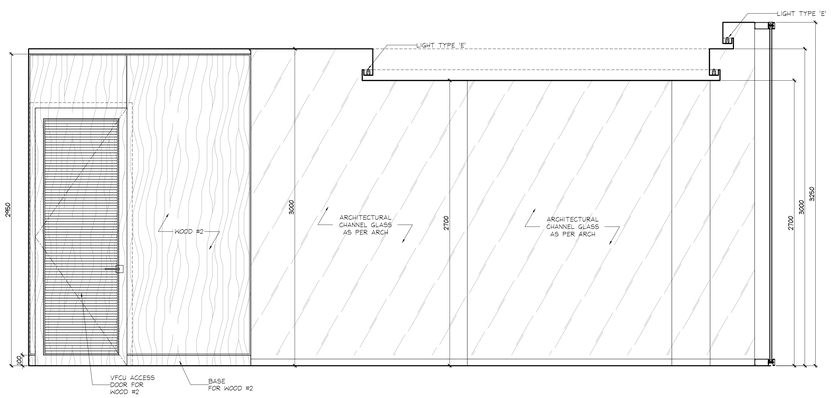

3 ID2.1.6 ELEVATION
GROUND FLOOR
WEIGHT ROOM
SCALE 1:20

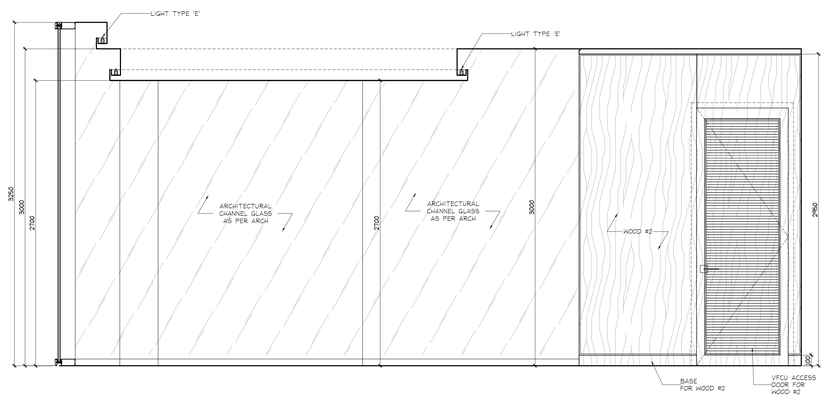

4 ID2.1.6 ELEVATION
GROUND FLOOR
WEIGHT ROOM
SCALE 1:20

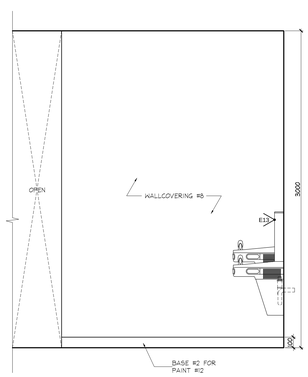

5 ID2.1.6 ELEVATION
GROUND FLOOR
WEIGHT ROOM
SCALE 1:20

DO NOT SCALE DRAWINGS.

CONTRACTOR MUST VERIFY ALL DRAWINGS, DIMENSIONS, DETAILS AND SPECIFICATIONS, AND REPORT ANY DISCREPANCIES TO *UNION 31 INC.* BEFORE PROCEEDING WITH WORK. MATERIALS MAY NOT BE SUBSTITUTED WITHOUT WRITTEN APPROVAL FROM *UNION 31 INC.*

ALL DRAWINGS AND SPECIFICATIONS ARE INSTRUMENTS OF SERVICE AND THE PROPERTY OF *UNION 31 INC.* WHICH MUST BE RETURNED AT THE COMPLETION OF THE WORK.

PRINTED: 30-May-17

ISSUED FOR AS-BUILT

NO.	DATE	COMMENTS	INI
01	31 MAY / 17	ISSUED FOR AS-BUILT	SV

REVISIONS:

UNION31

UNION31 INC.
183 BATHURST STREET, STE 201
TORONTO, ON, M5T 2R7, CANADA
TEL: 416-597-1576 FAX: 416-597-2139

PROJECT NAME:
ALEXANDRA PARK
MAIN BUILDING
BLOCK 11
ON, Canada

PROJECT NO.: 13-949

DRAWING/S:
GROUND FLOOR
ELEVATIONS

DATE STARTED: 07 AUG / 13	DRAWING NO.:
SCALE: 1 : 20	ID 2.1.6
DRAWN BY: AP	
APPROVED BY: KC	

36 x 48

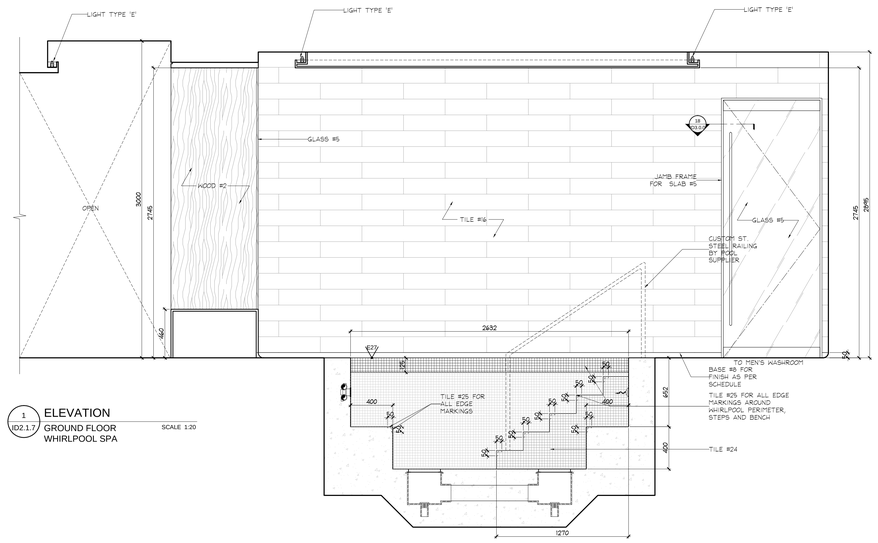

1 ID2.1.7 ELEVATION
GROUND FLOOR WHIRLPOOL SPA
SCALE 1:20

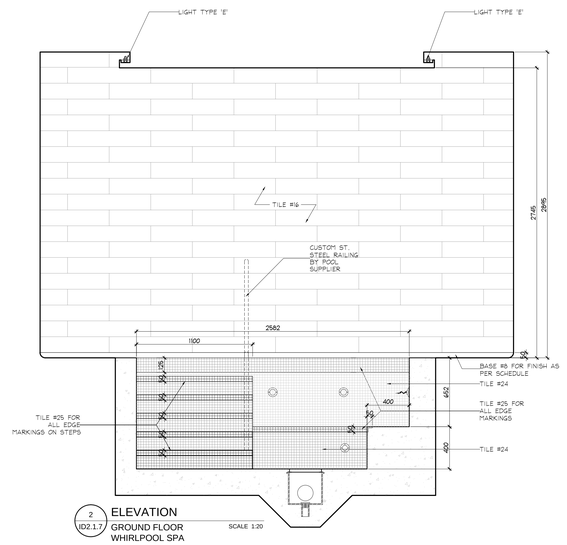

2 ID2.1.7 ELEVATION
GROUND FLOOR WHIRLPOOL SPA
SCALE 1:20

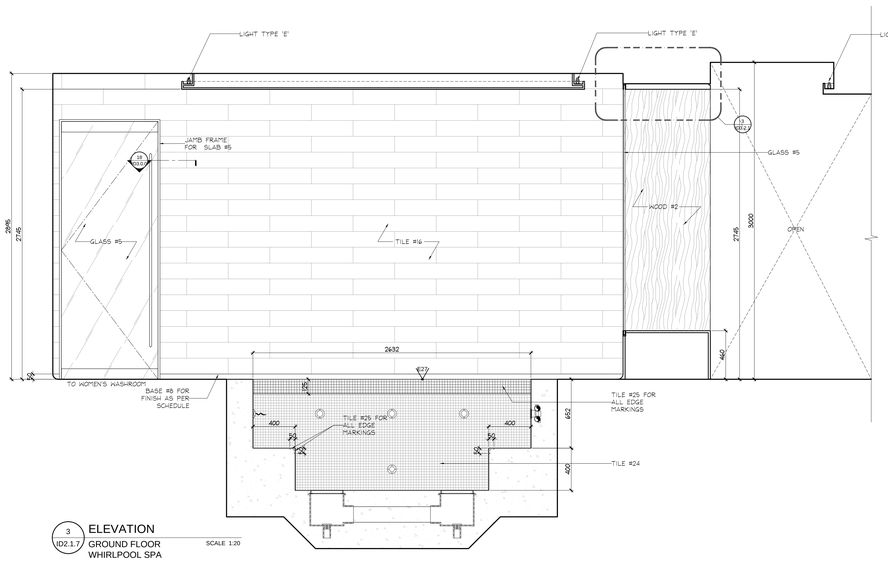

3 ID2.1.7 ELEVATION
GROUND FLOOR WHIRLPOOL SPA
SCALE 1:20

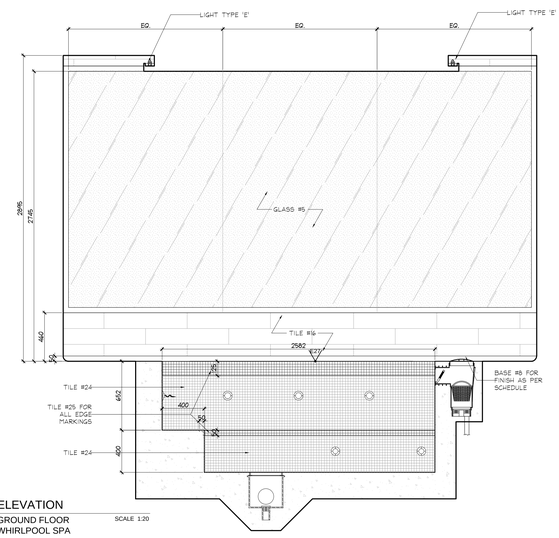

4 ID2.1.7 ELEVATION
GROUND FLOOR WHIRLPOOL SPA
SCALE 1:20

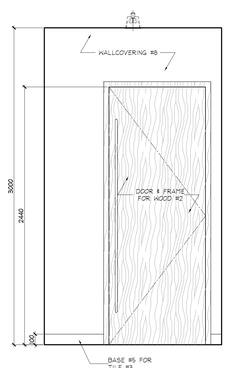

5 ID2.1.7 ELEVATION
GROUND FLOOR WOMEN'S/ MEN'S W.R. VESTIBULE
SCALE 1:20

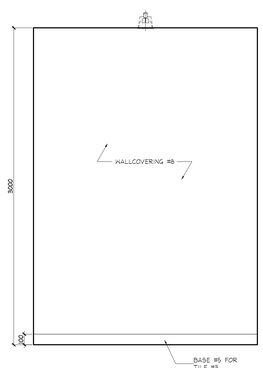

6 ID2.1.7 ELEVATION
GROUND FLOOR WOMEN'S/ MEN'S W.R. VESTIBULE
SCALE 1:20

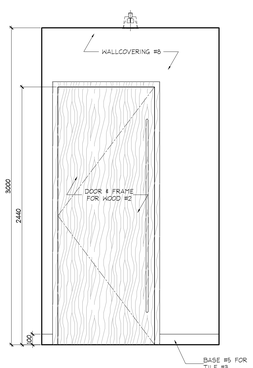

7 ID2.1.7 ELEVATION
GROUND FLOOR WOMEN'S/ MEN'S W.R. VESTIBULE
SCALE 1:20

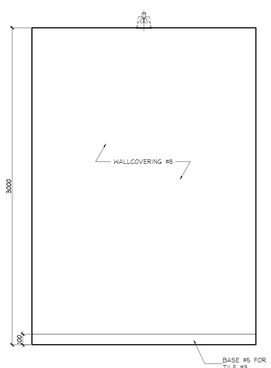

8 ID2.1.7 ELEVATION
GROUND FLOOR WOMEN'S/ MEN'S W.R. VESTIBULE
SCALE 1:20

DO NOT SCALE DRAWINGS.

CONTRACTOR MUST VERIFY ALL DRAWINGS, DIMENSIONS, DETAILS AND SPECIFICATIONS, AND REPORT ANY DISCREPANCIES TO *UNION 31 INC.* BEFORE PROCEEDING WITH WORK. MATERIALS MAY NOT BE SUBSTITUTED WITHOUT WRITTEN APPROVAL FROM *UNION 31 INC.*

ALL DRAWINGS AND SPECIFICATIONS ARE INSTRUMENTS OF SERVICE AND THE PROPERTY OF *UNION 31 INC.* WHICH MUST BE RETURNED AT THE COMPLETION OF THE WORK.

PRINTED: 30-May-17

ISSUED FOR AS-BUILT

NO.	DATE	COMMENTS	INI
01	31 MAY / 17	ISSUED FOR AS-BUILT	SV

REVISIONS:

UNION31

UNION31 INC.
183 BATHURST STREET, STE 201
TORONTO, ON, M5T 2R7, CANADA
TEL: 416-597-1576 FAX: 416-597-2139

PROJECT NAME:
ALEXANDRA PARK
MAIN BUILDING
BLOCK 11
ON, Canada

PROJECT NO.: 13-949

DRAWING/S:
GROUND FLOOR ELEVATIONS

DATE STARTED: 07 AUG / 13	DRAWING NO.:
SCALE: 1 : 20	ID 2.1.7
DRAWN BY: AP	
APPROVED BY: KC	

36 x 48

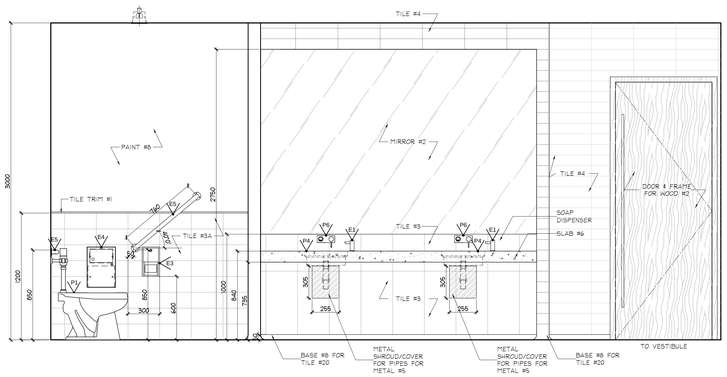

1 ID2.1.8 ELEVATION
GROUND FLOOR SCALE 1:20
WOMEN'S CHANGE ROOM

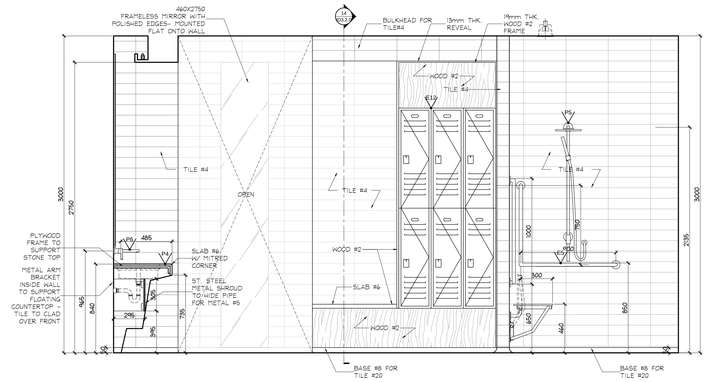

2 ID2.1.8 ELEVATION
GROUND FLOOR SCALE 1:20
WOMEN'S CHANGE ROOM

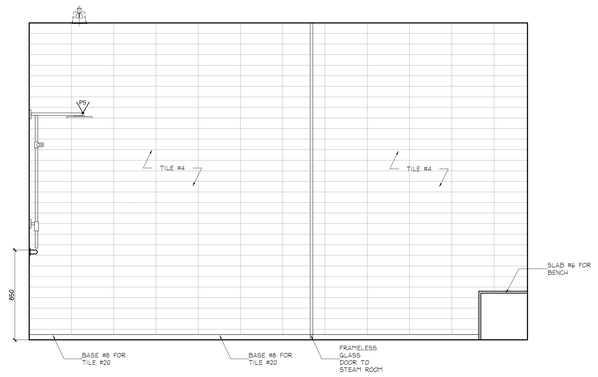

3 ID2.1.8 ELEVATION
GROUND FLOOR SCALE 1:20
WOMEN'S CHANGE ROOM

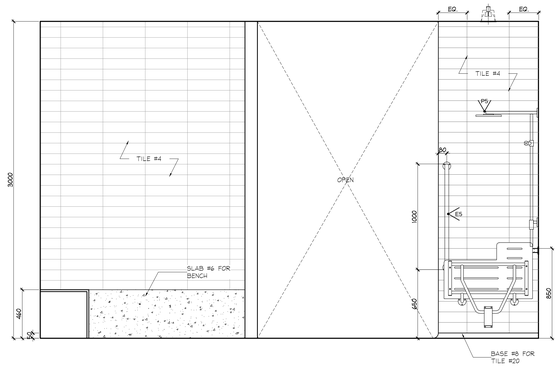

4 ID2.1.8 ELEVATION
GROUND FLOOR SCALE 1:20
WOMEN'S CHANGE ROOM

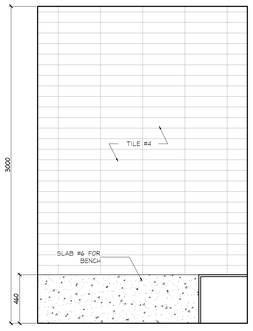

5 ID2.1.8 ELEVATION
GROUND FLOOR SCALE 1:20
WOMEN'S CHANGE ROOM -STEAM

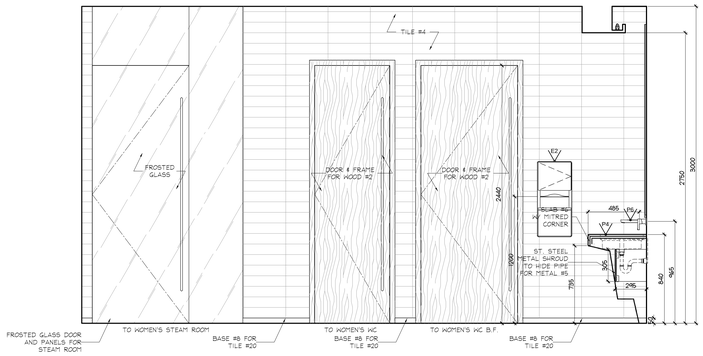

6 ID2.1.8 ELEVATION
GROUND FLOOR SCALE 1:20
WOMEN'S CHANGE ROOM

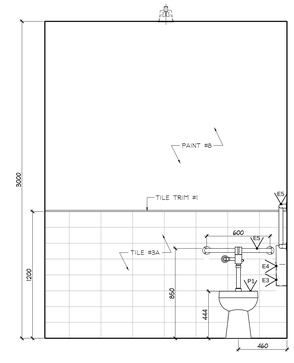

7 ID2.1.8 ELEVATION
GROUND FLOOR SCALE 1:20
WOMEN'S CHANGE ROOM

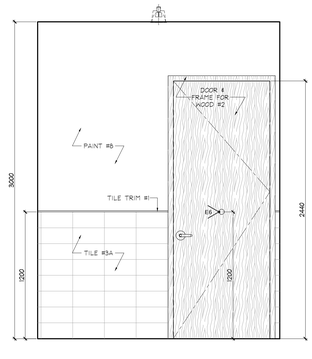

8 ID2.1.8 ELEVATION
GROUND FLOOR SCALE 1:20
WOMEN'S CHANGE ROOM

DO NOT SCALE DRAWINGS.

CONTRACTOR MUST VERIFY ALL DRAWINGS, DIMENSIONS, DETAILS AND SPECIFICATIONS, AND REPORT ANY DISCREPANCIES TO *UNION 31 INC.* BEFORE PROCEEDING WITH WORK. MATERIALS MAY NOT BE SUBSTITUTED WITHOUT WRITTEN APPROVAL FROM *UNION 31 INC.*

ALL DRAWINGS AND SPECIFICATIONS ARE INSTRUMENTS OF SERVICE AND THE PROPERTY OF *UNION 31 INC.* WHICH MUST BE RETURNED AT THE COMPLETION OF THE WORK.

PRINTED: 30-May-17

ISSUED FOR AS-BUILT

NO.	DATE	COMMENTS	INI
01	31 MAY / 17	ISSUED FOR AS-BUILT	SV

REVISIONS:

UNION31

UNION31 INC.
183 BATHURST STREET, STE 201
TORONTO, ON, M5T 2R7, CANADA
TEL: 416-597-1576 FAX: 416-597-2139

PROJECT NAME:
ALEXANDRA PARK
MAIN BUILDING
BLOCK 11
ON, Canada

PROJECT NO.: 13-949

DRAWING/S:
GROUND FLOOR
ELEVATIONS

DATE STARTED:	07 AUG / 13	DRAWING NO.:	ID 2.1.8
SCALE:	1 : 20		
DRAWN BY:	AP		
APPROVED BY:	KC		

38 X 48

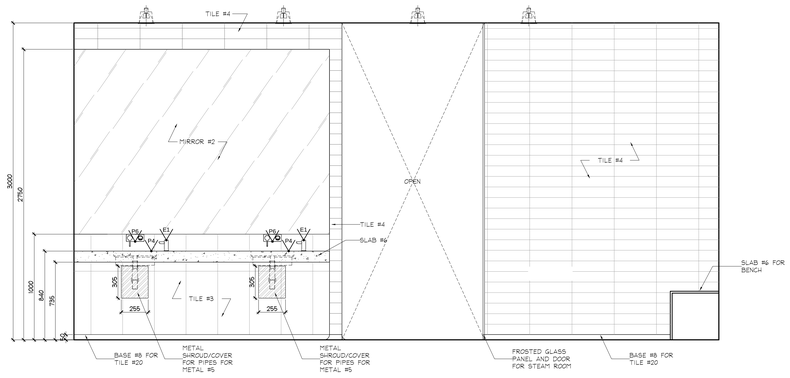

1 ID2.1.9 ELEVATION
GROUND FLOOR
MEN'S CHANGE ROOM
SCALE 1:20

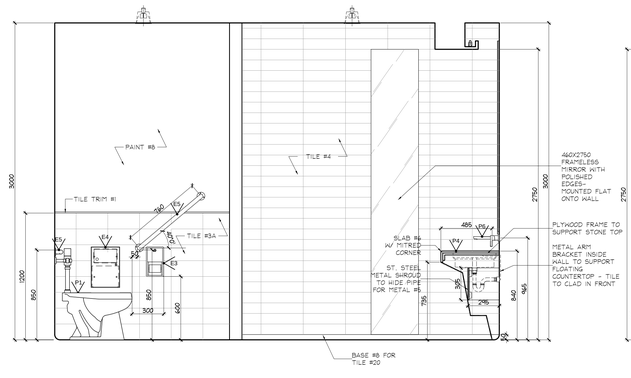

2 ID2.1.9 ELEVATION
GROUND FLOOR
MEN'S CHANGE ROOM
SCALE 1:20

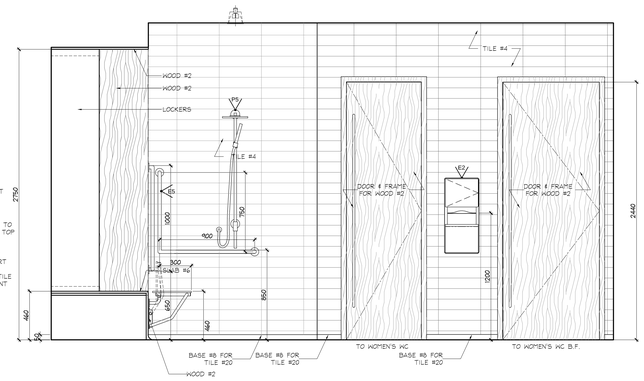

3 ID2.1.9 ELEVATION
GROUND FLOOR
MEN'S CHANGE ROOM
SCALE 1:20

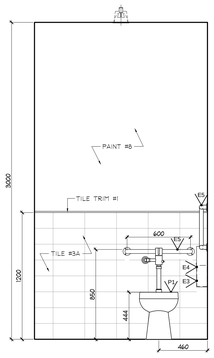

4 ID2.1.9 ELEVATION
GROUND FLOOR
MEN'S CHANGE ROOM
SCALE 1:20

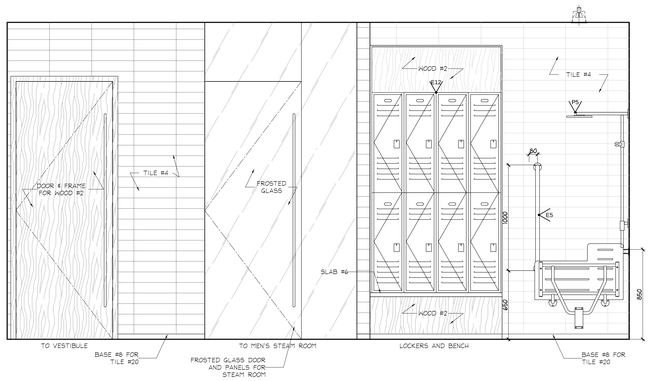

5 ID2.1.9 ELEVATION
GROUND FLOOR
MEN'S CHANGE ROOM
SCALE 1:20

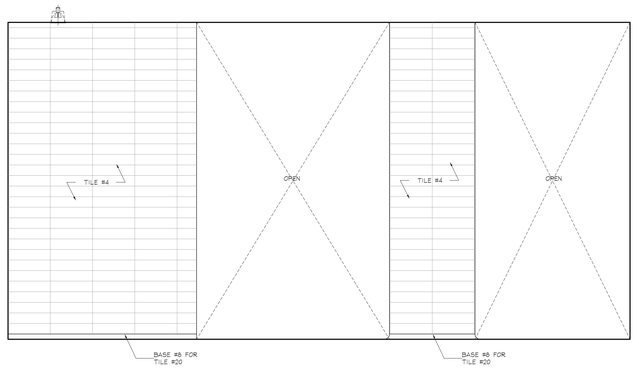

6 ID2.1.9 ELEVATION
GROUND FLOOR
MEN'S CHANGE ROOM
SCALE 1:20

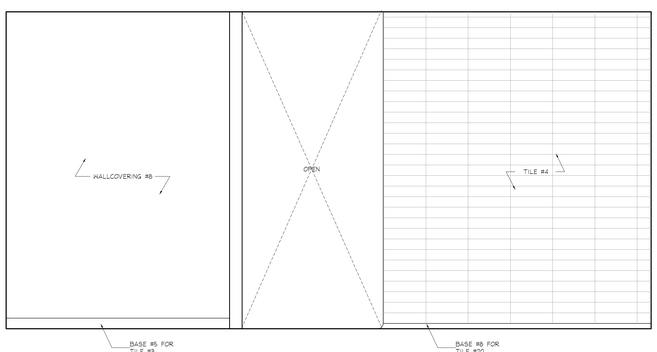

7 ID2.1.9 ELEVATION
GROUND FLOOR
MEN'S CHANGE ROOM
SCALE 1:20

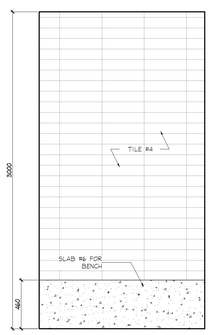

8 ID2.1.9 ELEVATION
GROUND FLOOR
MEN'S CHANGE ROOM
SCALE 1:20

DO NOT SCALE DRAWINGS.

CONTRACTOR MUST VERIFY ALL DRAWINGS, DIMENSIONS, DETAILS AND SPECIFICATIONS, AND REPORT ANY DISCREPANCIES TO *UNION 31 INC.* BEFORE PROCEEDING WITH WORK. MATERIALS MAY NOT BE SUBSTITUTED WITHOUT WRITTEN APPROVAL FROM *UNION 31 INC.*

ALL DRAWINGS AND SPECIFICATIONS ARE INSTRUMENTS OF SERVICE AND THE PROPERTY OF *UNION 31 INC.* WHICH MUST BE RETURNED AT THE COMPLETION OF THE WORK.

PRINTED: 30-May-17

ISSUED FOR AS-BUILT

NO.	DATE	COMMENTS	INI
01	31 MAY / 17	ISSUED FOR AS-BUILT	SV

REVISIONS:

UNION31

UNION31 INC.
183 BATHURST STREET, STE 201
TORONTO, ON, M5T 2R7, CANADA
TEL: 416-597-1576 FAX: 416-597-2139

PROJECT NAME:
ALEXANDRA PARK
MAIN BUILDING
BLOCK 11
ON, Canada

PROJECT NO.: 13-949

DRAWING/S:
GROUND FLOOR ELEVATIONS

DATE STARTED: 07 AUG / 13	DRAWING NO.:
SCALE: 1 : 20	ID 2.1.9
DRAWN BY: AP	
APPROVED BY: KC	

36 x 48

NOTE:
INSTALL ALL BARRIER FREE WASHROOM COMPONENTS ACCORDING TO OBC. REQUIREMENTS

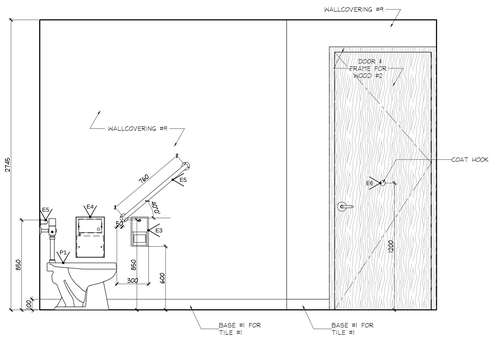

1 ID2.1.10 ELEVATION
GROUND FLOOR
B.F. WASHROOM
SCALE 1:20

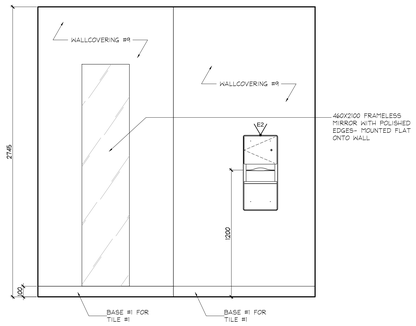

2 ID2.1.10 ELEVATION
GROUND FLOOR
B.F. WASHROOM
SCALE 1:20

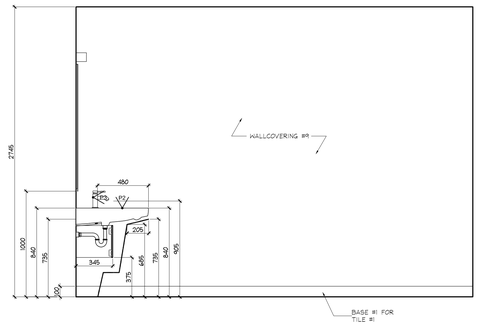

3 ID2.1.10 ELEVATION
GROUND FLOOR
B.F. WASHROOM
SCALE 1:20

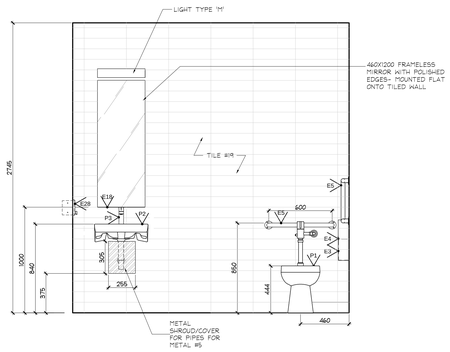

4 ID2.1.10 ELEVATION
GROUND FLOOR
B.F. WASHROOM
SCALE 1:20

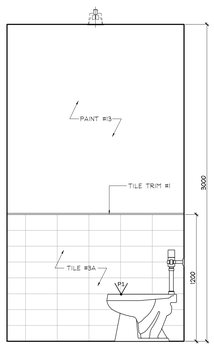

5 ID2.1.10 ELEVATION
GROUND FLOOR
WOMEN'S & MEN'S WASHROOM
SCALE 1:20

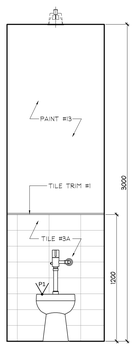

6 ID2.1.10 ELEVATION
GROUND FLOOR
WOMEN'S / MEN'S WASHROOM
SCALE 1:20

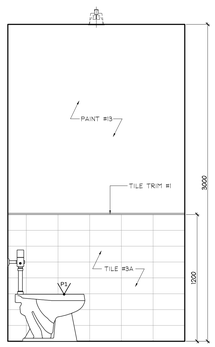

7 ID2.1.10 ELEVATION
GROUND FLOOR
WOMEN'S & MEN'S WASHROOM
SCALE 1:20

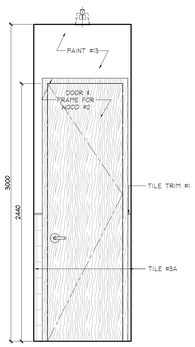

8 ID2.1.10 ELEVATION
GROUND FLOOR
WOMEN'S & MEN'S WASHROOM
SCALE 1:20

DO NOT SCALE DRAWINGS.

CONTRACTOR MUST VERIFY ALL DRAWINGS, DIMENSIONS, DETAILS AND SPECIFICATIONS, AND REPORT ANY DISCREPANCIES TO *UNION 31 INC.* BEFORE PROCEEDING WITH WORK. MATERIALS MAY NOT BE SUBSTITUTED WITHOUT WRITTEN APPROVAL FROM *UNION 31 INC.*

ALL DRAWINGS AND SPECIFICATIONS ARE INSTRUMENTS OF SERVICE AND THE PROPERTY OF *UNION 31 INC.* WHICH MUST BE RETURNED AT THE COMPLETION OF THE WORK.

PRINTED: 30-May-17

ISSUED FOR AS-BUILT

NO.	DATE	COMMENTS	INI
01	31 MAY / 17	ISSUED FOR AS-BUILT	SV

REVISIONS:

UNION31

UNION31 INC.
183 BATHURST STREET, STE 201
TORONTO, ON, M5T 2R7, CANADA
TEL: 416-597-1576 FAX: 416-597-2139

PROJECT NAME:
ALEXANDRA PARK
MAIN BUILDING
BLOCK 11
ON, Canada

PROJECT NO.: 13-949

DRAWING/S:
GROUND FLOOR
ELEVATIONS

DATE STARTED:	07 AUG / 13	DRAWING NO.:
SCALE:	1 : 20	ID 2.1.10
DRAWN BY:	AP	
APPROVED BY:	KC	

30 x 48

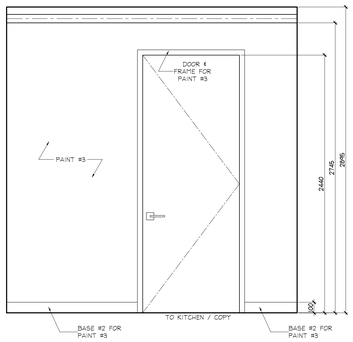

1 ID2.1.11 ELEVATION
GROUND FLOOR
PROPERTY MANAGEMENT OFFICE
SCALE 1:20

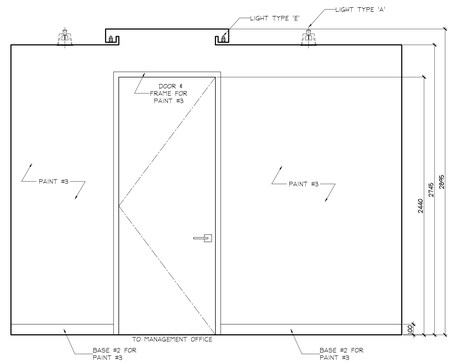

2 ID2.1.11 ELEVATION
GROUND FLOOR
PROPERTY MANAGEMENT OFFICE
SCALE 1:20

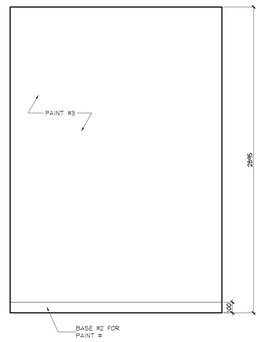

3 ID2.1.11 ELEVATION
GROUND FLOOR
MANAGEMENT OFFICE
SCALE 1:20

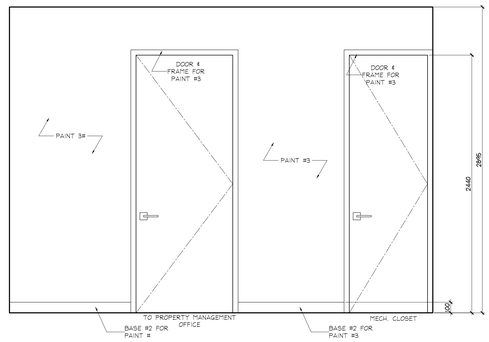

4 ID2.1.11 ELEVATION
GROUND FLOOR
MANAGEMENT OFFICE
SCALE 1:20

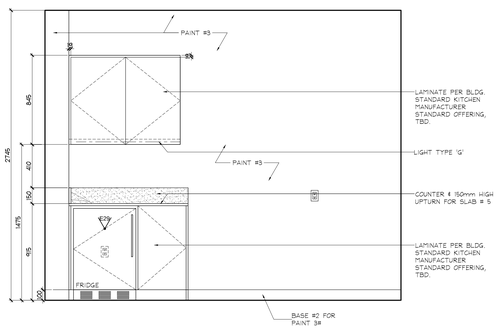

5 ID2.1.11 ELEVATION
GROUND FLOOR
MANAGEMENT KITCHEN
SCALE 1:20

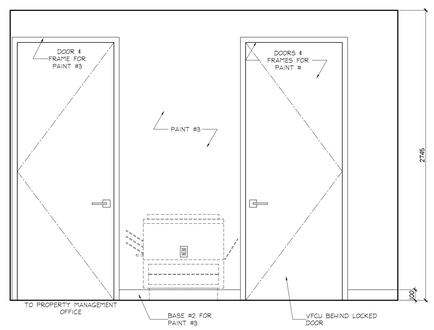

6 ID2.1.11 ELEVATION
GROUND FLOOR
MANAGEMENT KITCHEN
SCALE 1:20

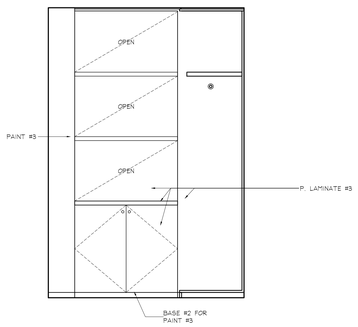

7 ID2.1.11 ELEVATION
GROUND FLOOR
PARCEL ROOM
SCALE 1:20

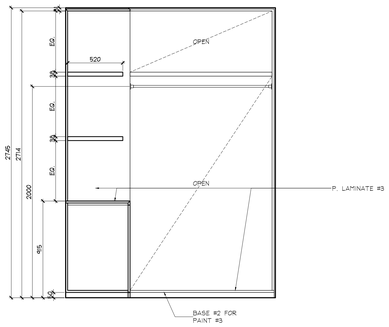

8 ID2.1.11 ELEVATION
GROUND FLOOR
PARCEL ROOM
SCALE 1:20

DO NOT SCALE DRAWINGS.

CONTRACTOR MUST VERIFY ALL DRAWINGS, DIMENSIONS, DETAILS AND SPECIFICATIONS, AND REPORT ANY DISCREPANCIES TO *UNION 31 INC.* BEFORE PROCEEDING WITH WORK. MATERIALS MAY NOT BE SUBSTITUTED WITHOUT WRITTEN APPROVAL FROM *UNION 31 INC.*

ALL DRAWINGS AND SPECIFICATIONS ARE INSTRUMENTS OF SERVICE AND THE PROPERTY OF *UNION 31 INC.* WHICH MUST BE RETURNED AT THE COMPLETION OF THE WORK.

PRINTED: 30-May-17

ISSUED FOR AS-BUILT

NO.	DATE	COMMENTS	INI
01	31 MAY / 17	ISSUED FOR AS-BUILT	SV

REVISIONS:

UNION31

UNION31 INC.
183 BATHURST STREET, STE 201
TORONTO, ON, M5T 2R7, CANADA
TEL: 416-597-1576 FAX: 416-597-2139

PROJECT NAME:
ALEXANDRA PARK
MAIN BUILDING
BLOCK 11
ON, Canada

PROJECT NO.: 13-949

DRAWING/S:
GROUND FLOOR
ELEVATIONS

DATE STARTED:	07 AUG / 13	DRAWING NO.:	ID 2.1.11
SCALE:	1 : 20		
DRAWN BY:	AP		
APPROVED BY:	KC		

36 x 48

NOTE:
INSTALL ALL BARRIER FREE WASHROOM COMPONENTS ACCORDING TO OBC REQUIREMENTS

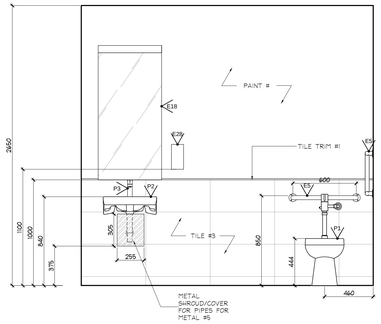

1 ID2.2.0 ELEVATION
9 TH FLOOR
AMENITY BATHROOM
SCALE 1:20

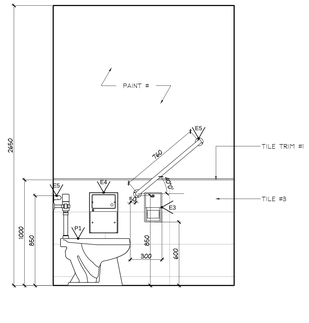

2 ID2.2.0 ELEVATION
9 TH FLOOR
AMENITY
SCALE 1:20

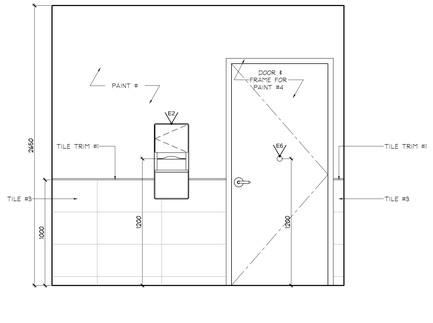

3 ID2.2.0 ELEVATION
9 TH FLOOR
AMENITY
SCALE 1:20

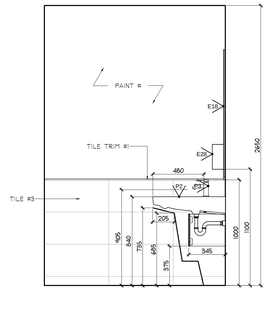

4 ID2.2.0 ELEVATION
9 TH FLOOR
AMENITY
SCALE 1:20

DO NOT SCALE DRAWINGS.

CONTRACTOR MUST VERIFY ALL DRAWINGS, DIMENSIONS, DETAILS AND SPECIFICATIONS, AND REPORT ANY DISCREPANCIES TO *UNION 31 INC.* BEFORE PROCEEDING WITH WORK. MATERIALS MAY NOT BE SUBSTITUTED WITHOUT WRITTEN APPROVAL FROM *UNION 31 INC.*

ALL DRAWINGS AND SPECIFICATIONS ARE INSTRUMENTS OF SERVICE AND THE PROPERTY OF *UNION 31 INC.* WHICH MUST BE RETURNED AT THE COMPLETION OF THE WORK.

PRINTED: 30-May-17

ISSUED FOR AS-BUILT

NO.	DATE	COMMENTS	INI
01	31 MAY / 17	ISSUED FOR AS-BUILT	SV

REVISIONS:

UNION31

UNION31 INC.
183 BATHURST STREET, STE 201
TORONTO, ON, M5T 2R7, CANADA
TEL: 416-597-1576 FAX: 416-597-2139

PROJECT NAME:
ALEXANDRA PARK
MAIN BUILDING
BLOCK 11
ON, Canada

PROJECT NO.: 13-949

DRAWING/S:
9 TH FLOOR
ELEVATIONS

DATE STARTED:	07 AUG / 13	DRAWING NO.:	ID 2.2.0
SCALE:	1 : 20		
DRAWN BY:	AP		
APPROVED BY:	KC		

36 x 48

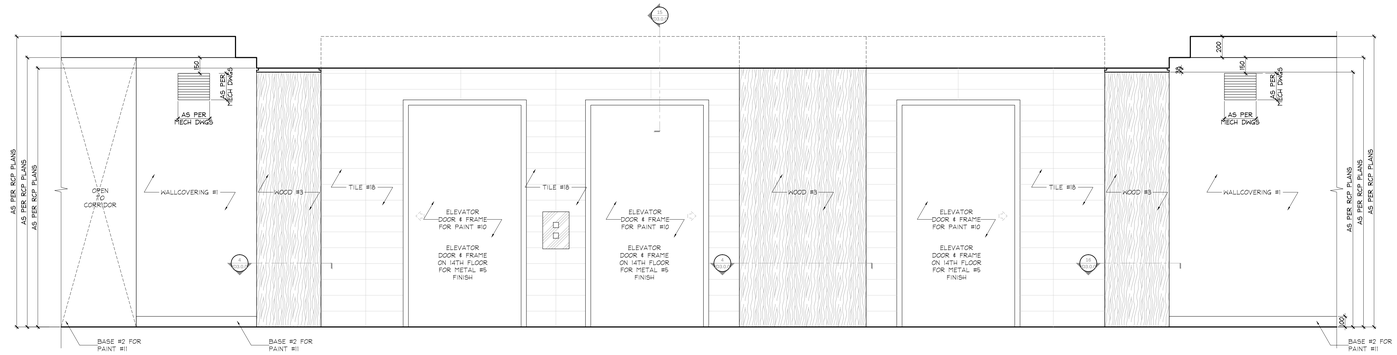

1 / ID2.3.0 ELEVATION
TYPICAL CORRIDOR
ELEVATOR LOBBY
SCALE 1:20

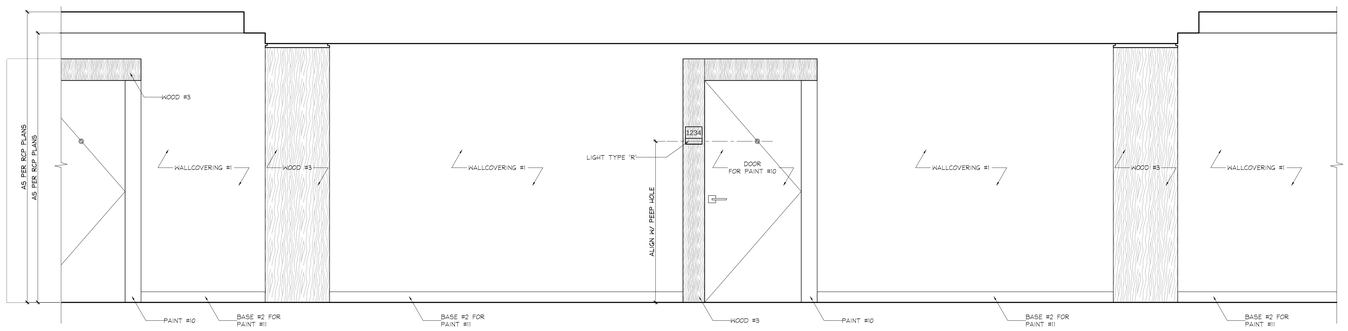

2 / ID2.3.0 ELEVATION
TYPICAL CORRIDOR
ELEVATOR LOBBY
SCALE 1:20

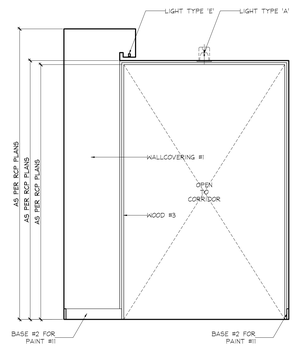

3 / ID2.3.0 ELEVATION
TYPICAL CORRIDOR
ELEVATOR LOBBY
SCALE 1:20

DO NOT SCALE DRAWINGS.

CONTRACTOR MUST VERIFY ALL DRAWINGS, DIMENSIONS, DETAILS AND SPECIFICATIONS, AND REPORT ANY DISCREPANCIES TO *UNION 31 INC.* BEFORE PROCEEDING WITH WORK. MATERIALS MAY NOT BE SUBSTITUTED WITHOUT WRITTEN APPROVAL FROM *UNION 31 INC.*

ALL DRAWINGS AND SPECIFICATIONS ARE INSTRUMENTS OF SERVICE AND THE PROPERTY OF *UNION 31 INC.* WHICH MUST BE RETURNED AT THE COMPLETION OF THE WORK.

PRINTED: 30-May-17

ISSUED FOR AS-BUILT

NO.	DATE	COMMENTS	INI
01	31 MAY / 17	ISSUED FOR AS-BUILT	SV

REVISIONS:

UNION31

UNION31 INC.
183 BATHURST STREET, STE 201
TORONTO, ON, M5T 2R7, CANADA
TEL: 416-597-1576 FAX: 416-597-2139

PROJECT NAME:
ALEXANDRA PARK
MAIN BUILDING
BLOCK 11
ON, Canada

PROJECT NO.: 13-949

DRAWING/S:
TYPICAL ELEVATIONS

DATE STARTED:	07 AUG / 13
SCALE:	1 : 20
DRAWN BY:	AP
APPROVED BY:	KC

DRAWING NO.:
ID 2.3.0

35 x 43

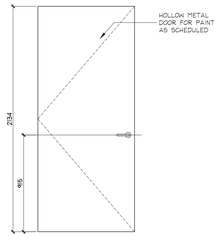

TYPICAL
TYPE "TYP.1"
LOCKER DOORS

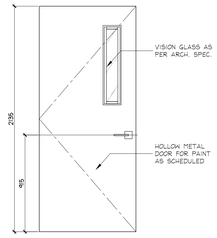

TYP. EXIT STAIR
DOORS "TYP.2"

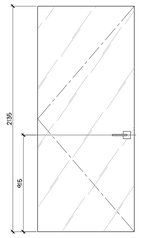

PARKING LEVEL 2
DOORS P201.1, P201.X, P201.3

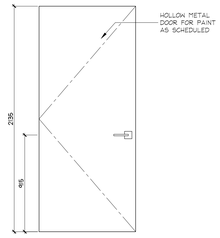

PARKING LEVEL 2
DOOR P201.2

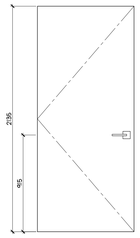

PARKING LEVEL 1
DOORS P110.1, P101

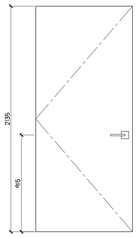

PARKING LEVEL 1
DOORS P110.1, P130

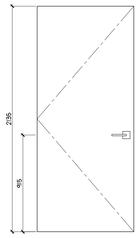

PARKING LEVEL 1
DOOR P117

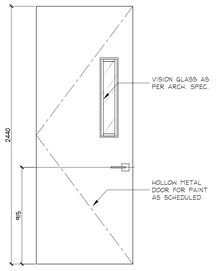

GROUND FLOOR
DOOR 145.2

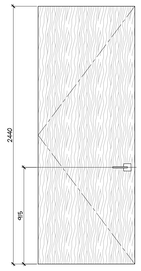

GROUND FLOOR
DOOR 138
MAIL SORTING

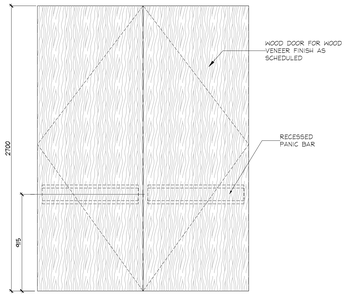

GROUND FLOOR
DOOR 140.1
ELEVATOR LOBBY

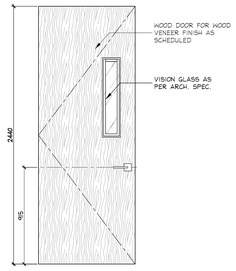

GROUND FLOOR
DOOR 140.2
CORRIDOR B TO LOBBY

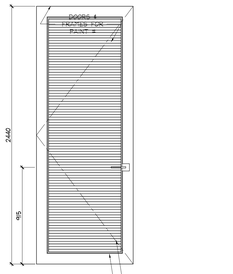

GROUND FLOOR
DOORS 143A
VFCU ACCESS DOOR

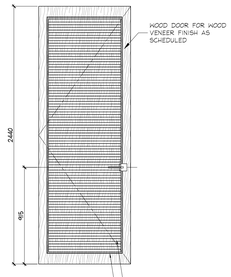

GROUND FLOOR
DOORS 143B, 143C
VFCU ACCESS DOOR

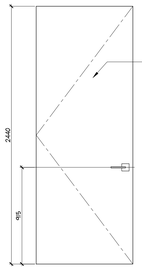

GROUND FLOOR
DOOR 144

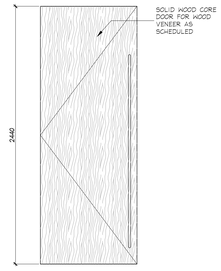

GROUND FLOOR
DOORS 146A, 146B, 151A, 151B, 148, 153
MEN'S / WOMEN'S CHANGEROOM VESTIBULE
AMENITY KITCHENETTE

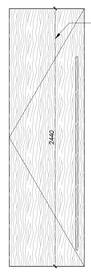

GROUND FLOOR
DOORS 147, 152
MEN'S / WOMEN'S WC

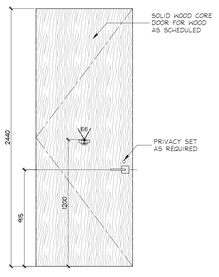

GROUND FLOOR
DOORS 148, 153
(INTERIOR)
MEN'S / WOMEN'S WC BF

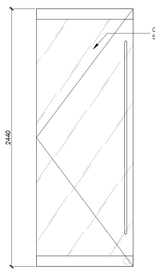

GROUND FLOOR
DOORS 149.1, 149.2
MEN'S/ WOMEN'S CHANGEROOM TO
WHIRLPOOL SPA

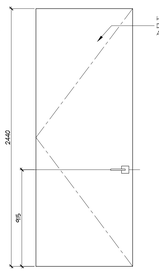

GROUND FLOOR
DOOR 150
JANITOR CLOSET IN WOMEN'S
CHANGEROOM

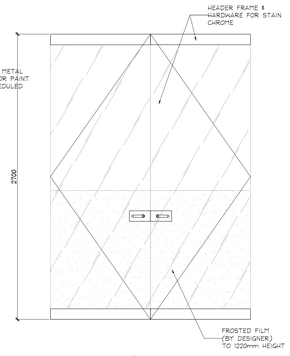

GROUND FLOOR
DOOR 154
CORRIDOR D TO FITNESS AREA

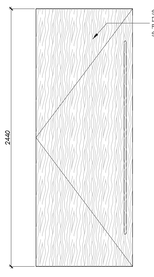

GROUND FLOOR
DOORS 156, 157
BARRIER FREE WC

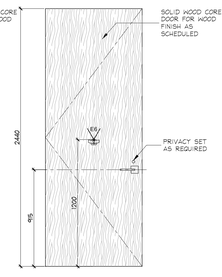

GROUND FLOOR
DOORS 156, 157
(INTERIOR)
BARRIER FREE WC

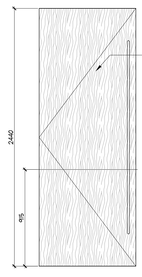

GROUND FLOOR
DOOR 158
THEATRE

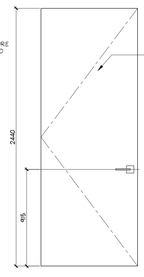

GROUND FLOOR
DOOR 158C
THEATRE EQUIP.

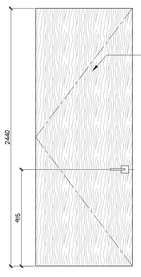

GROUND FLOOR
DOORS 168, 169
CACF & PARCEL ROOM

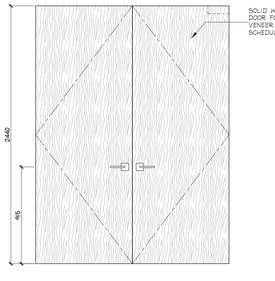

GROUND FLOOR
DOOR 159
CORRIDOR D ELECTRICAL CLOSET

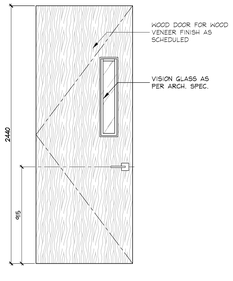

GROUND FLOOR
DOOR 160.1
CORRIDOR C TO CORRIDOR A

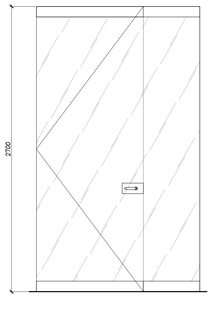

GROUND FLOOR
DOOR 160.2
PARTY ROOM AMENITY

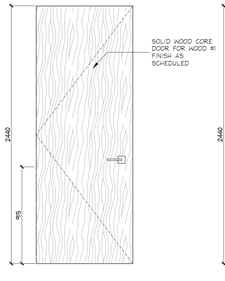

GROUND FLOOR
DOORS 161.1, 161.2
DINING ROOM

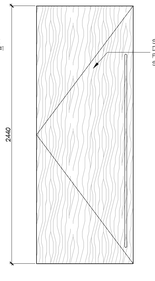

GROUND FLOOR
DOORS 162
KITCHEN

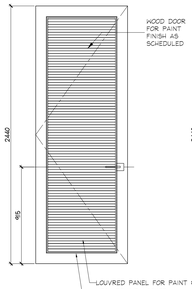

GROUND FLOOR
DOORS 162A, 163A
VFCU ACCESS DOOR

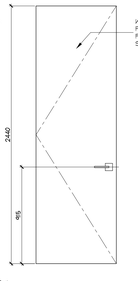

GROUND FLOOR
DOOR 163B
CLOSET DOOR

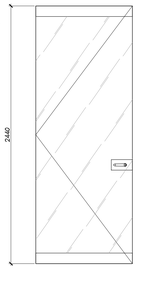

GROUND FLOOR
DOOR 164
PROPERTY MANAGEMENT
OFFICE

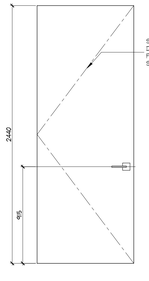

GROUND FLOOR
DOORS 166.1, 167
PROPERTY MANAGEMENT
OFFICE

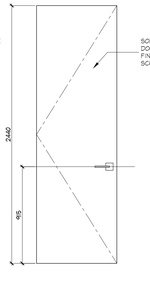

GROUND FLOOR
DOOR 166.2
MANAGEMENT OFFICE
(MECHANICAL CLOSET)

DO NOT SCALE DRAWINGS.

CONTRACTOR MUST VERIFY ALL DRAWINGS, DIMENSIONS, DETAILS AND SPECIFICATIONS, AND REPORT ANY DISCREPANCIES TO *UNION 31 INC.* BEFORE PROCEEDING WITH WORK. MATERIALS MAY NOT BE SUBSTITUTED WITHOUT WRITTEN APPROVAL FROM *UNION 31 INC.*

ALL DRAWINGS AND SPECIFICATIONS ARE INSTRUMENTS OF SERVICE AND THE PROPERTY OF *UNION 31 INC.* WHICH MUST BE RETURNED AT THE COMPLETION OF THE WORK.

PRINTED: 30-May-17

ISSUED FOR
AS-BUILT

NO.	DATE	COMMENTS	INI
01	31 MAY / 17	ISSUED FOR AS-BUILT	SV

REVISIONS:

UNION31

UNION31 INC.
183 BATHURST STREET, STE 201
TORONTO, ON, M5T 2R7, CANADA
TEL: 416-597-1576 FAX: 416-597-2139

PROJECT NAME:
ALEXANDRA PARK
MAIN BUILDING
BLOCK 11
ON, Canada

PROJECT NO.: 13-949

DRAWING/S:
DOOR ELEVATIONS

DATE STARTED:	07 AUG / 13	DRAWING NO.:	ID 2.4.0
SCALE:	AS NOTED		
DRAWN BY:	SM		
APPROVED BY:	KC		

36 x 48

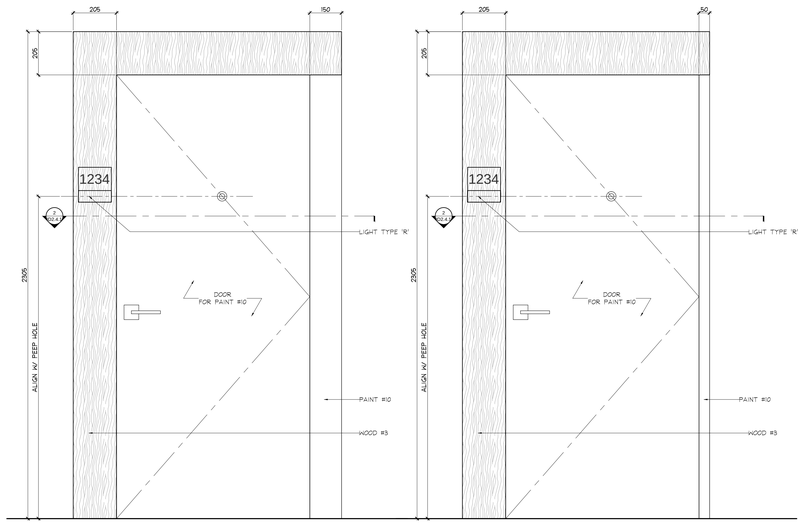

1 ELEVATION
ID2.4.1 TYPICAL SUITE ENTRY SCALE 1:10

1A ELEVATION
ID2.4.1 ATYPICAL SUITE ENTRY SCALE 1:10

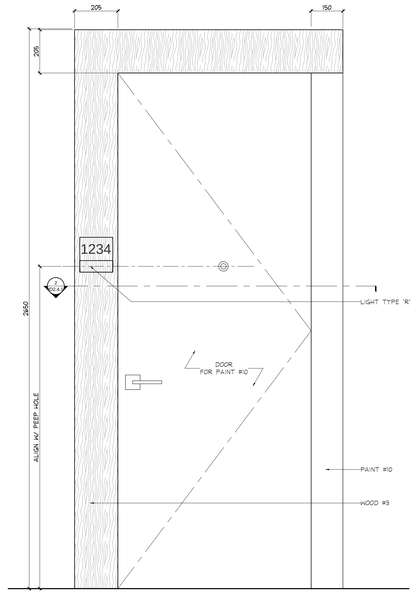

3 ELEVATION
ID2.4.1 TYPICAL SUITE ENTRY FOR 10'-0" CH SCALE 1:10

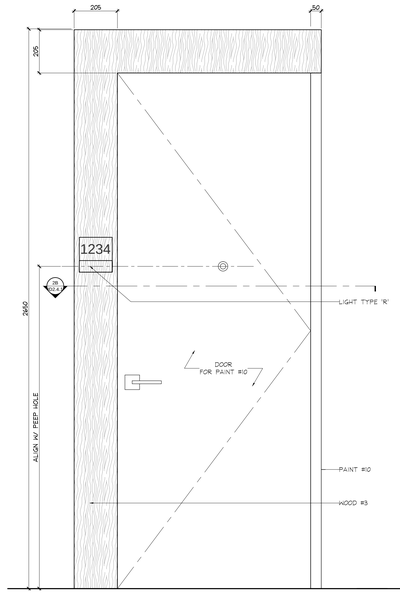

3A ELEVATION
ID2.4.1 ATYPICAL SUITE ENTRY FOR 10'-0" CH SCALE 1:10

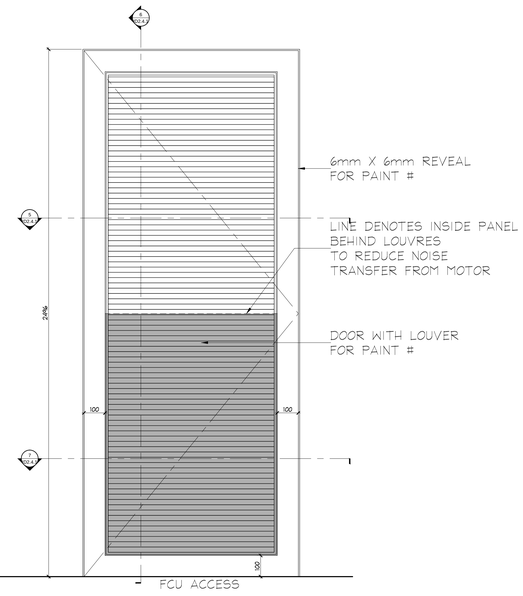

4 ELEVATION
ID2.4.1 FCU ACCESS DOOR SCALE 1:10

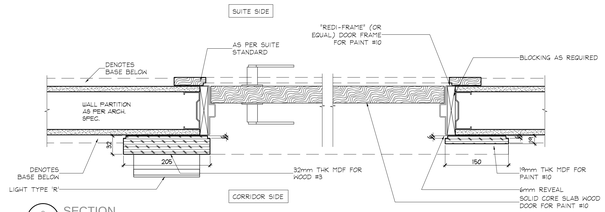

2 SECTION
ID2.4.1 TYPICAL SUITE ENTRY SCALE 1:5

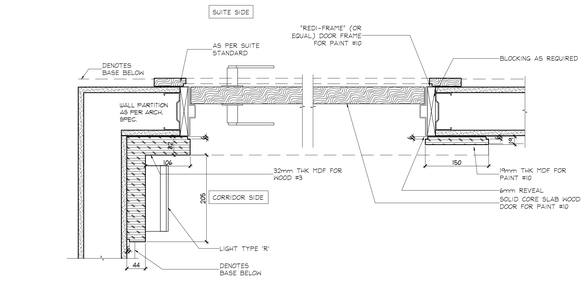

2A SECTION
ID2.4.1 TYPICAL SUITE ENTRY FOR COORIDOR END UNIT SCALE 1:5

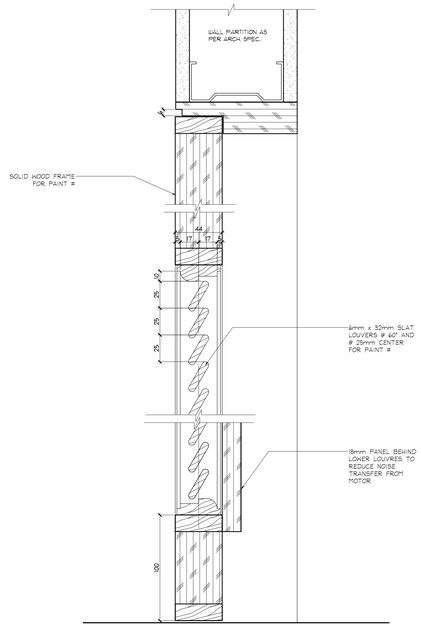

6 SECTION
ID2.4.1 TYPICAL LOUVER DETAIL SCALE 1:2

5 SECTION
ID2.4.1 TYPICAL LOUVRE PANEL SCALE 1:5

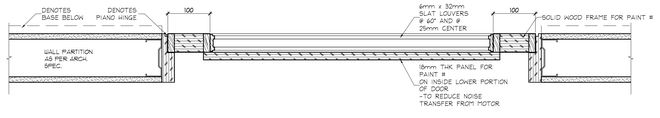

7 SECTION
ID2.4.1 TYPICAL LOUVRE PANEL SCALE 1:5

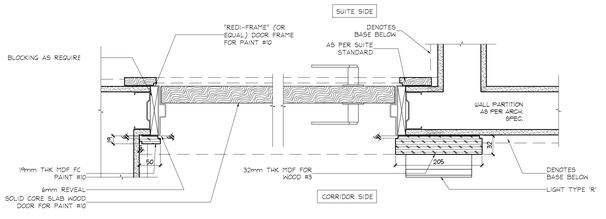

2B SECTION
ID2.4.1 SUITE ENTRY SCALE 1:5
NOS.1019,1021,1119,1121

DO NOT SCALE DRAWINGS.

CONTRACTOR MUST VERIFY ALL DRAWINGS, DIMENSIONS, DETAILS AND SPECIFICATIONS, AND REPORT ANY DISCREPANCIES TO *UNION 31 INC.* BEFORE PROCEEDING WITH WORK. MATERIALS MAY NOT BE SUBSTITUTED WITHOUT WRITTEN APPROVAL FROM *UNION 31 INC.*

ALL DRAWINGS AND SPECIFICATIONS ARE INSTRUMENTS OF SERVICE AND THE PROPERTY OF *UNION 31 INC.* WHICH MUST BE RETURNED AT THE COMPLETION OF THE WORK.

PRINTED: 30-May-17

ISSUED FOR AS-BUILT

NO.	DATE	COMMENTS	INI
01	31 MAY / 17	ISSUED FOR AS-BUILT	SV

REVISIONS:

UNION 31

UNION31 INC.
183 BATHURST STREET, STE 201
TORONTO, ON, M5T 2R7, CANADA
TEL: 416-597-1576 FAX: 416-597-2139

PROJECT NAME:
ALEXANDRA PARK
MAIN BUILDING
BLOCK 11
ON, Canada

PROJECT NO.: 13-949

DRAWING/S:
DOOR ELEVATIONS

DATE STARTED:	07 AUG / 13	DRAWING NO.:	ID 2.4.1
SCALE:	AS NOTED		
DRAWN BY:	SM		
APPROVED BY:	KC		

36 x 48

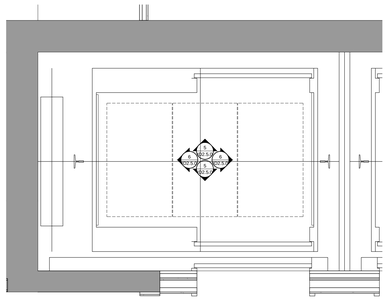

1 ID2.5.0 TYP. ELEVATOR CAB CONSTRUCTION PLAN

SCALE 1:20

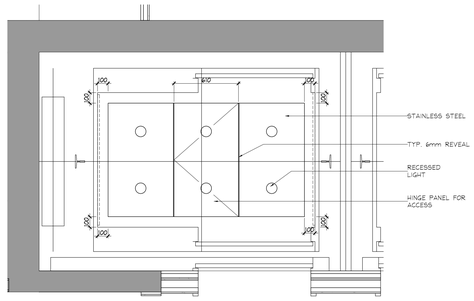

2 ID2.5.0 TYP. ELEVATOR CAB REFLECTED CEILING PLAN

SCALE 1:20

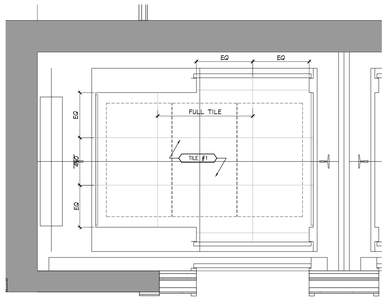

3 ID2.5.0 TYP. ELEVATOR CAB FLOOR FINISHES PLAN

SCALE 1:20

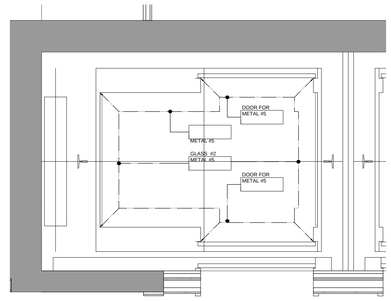

4 ID2.5.0 TYP. ELEVATOR CAB WALL FINISHES PLAN

SCALE 1:20

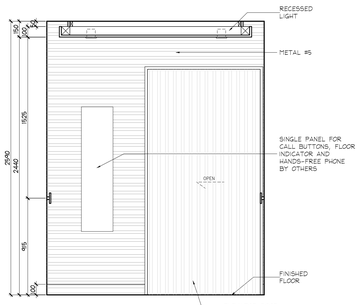

5 ID2.5.0 TYP. ELEVATOR CAB ELEVATION

SCALE 1:20

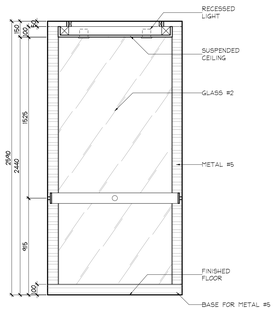

6 ID2.5.0 TYP. ELEVATOR CAB ELEVATION

SCALE 1:20

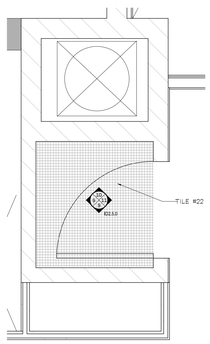

8 ID2.5.0 PLAN GARBAGE CHUTE

SCALE 1:20

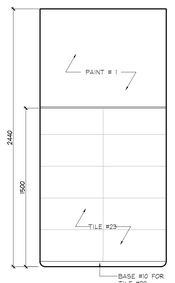

9 ID2.5.0 ELEVATION GARBAGE CHUTE

SCALE 1:20

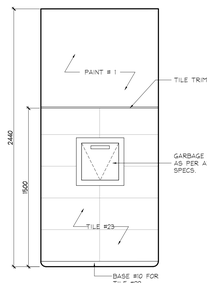

10 ID2.5.0 ELEVATION GARBAGE CHUTE

SCALE 1:20

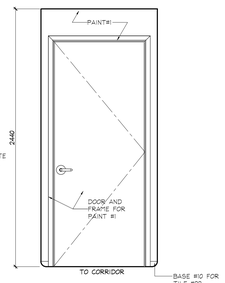

11 ID2.5.0 ELEVATION GARBAGE CHUTE

SCALE 1:20

DO NOT SCALE DRAWINGS.

CONTRACTOR MUST VERIFY ALL DRAWINGS, DIMENSIONS, DETAILS AND SPECIFICATIONS, AND REPORT ANY DISCREPANCIES TO *UNION 31 INC.* BEFORE PROCEEDING WITH WORK. MATERIALS MAY NOT BE SUBSTITUTED WITHOUT WRITTEN APPROVAL FROM *UNION 31 INC.*

ALL DRAWINGS AND SPECIFICATIONS ARE INSTRUMENTS OF SERVICE AND THE PROPERTY OF *UNION 31 INC.* WHICH MUST BE RETURNED AT THE COMPLETION OF THE WORK.

PRINTED: 30-May-17

ISSUED FOR AS-BUILT

NO	DATE	COMMENTS	INI
01	31 MAY / 17	ISSUED FOR AS-BUILT	SV

REVISIONS:

UNION31

UNION31 INC.
183 BATHURST STREET, STE 201
TORONTO, ON, M5T 2R7, CANADA
TEL: 416-597-1576 FAX: 416-597-2139

PROJECT NAME:
ALEXANDRA PARK
MAIN BUILDING
BLOCK 11
ON, Canada

PROJECT NO.: 13-949

DRAWING/S:
ELEVATOR CAB & GARBAGE CHUTE
PLANS, ELEVATIONS & DETAILS

DATE STARTED: 07 AUG / 13	DRAWING NO.:
SCALE: 1:20	ID 2.5.0
DRAWN BY: AP	
APPROVED BY: KC	

36 x 48

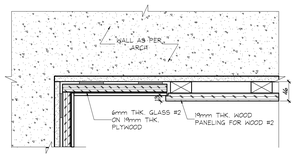

1 ID3.0.0 WALL SECTION
1ST FLOOR SCALE 1:5

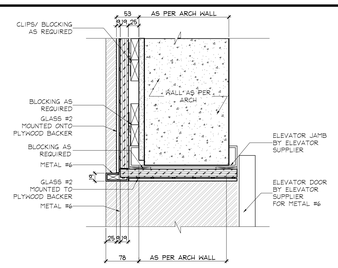

2 ID3.0.0 ELEVATOR HEADER SECTION
1ST FLOOR SCALE 1:5

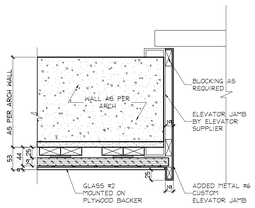

3 ID3.0.0 ELEVATOR JAMB SECTION
1ST FLOOR SCALE 1:5

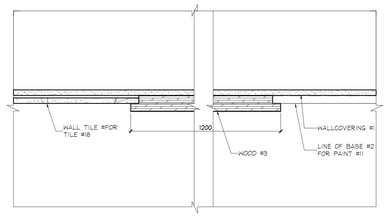

4 ID3.0.0 SECTION @ WOOD PANEL
TYPICAL CORRIDOR SCALE 1:5

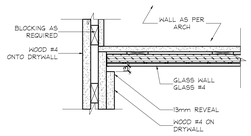

5 ID3.0.0 PLAN SECTION @ WOOD PANEL & GLASS WALL CONNECTION
1ST FLOOR SCALE 1:5
LOBBY

6 ID3.0.0 PLAN SECTION @ WOOD PANEL & GLASS WALL TRANSITION
1ST FLOOR SCALE 1:5
LOBBY

7 ID3.0.0 PLAN SECTION @ WOOD WALL
1ST FLOOR SCALE 1:5
LOBBY

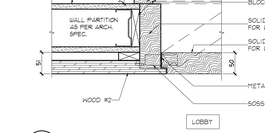

8 ID3.0.0 PLAN SECTION @ MAILROOM - JAMB
1ST FLOOR SCALE 1:5
LOBBY

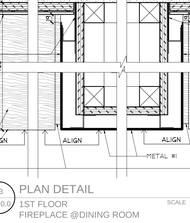

9 ID3.0.0 SECTION
1ST FLOOR SCALE 1:5
ENTRANCE TO PARTY ROOM

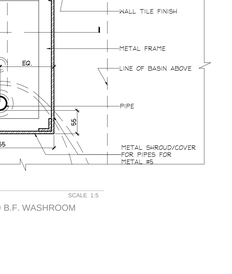

10 ID3.0.0 SECTION
1ST FLOOR SCALE 1:5
PARTY ROOM

11 ID3.0.0 SECTION
1ST FLOOR SCALE 1:10
ENTRANCE TO PARTY ROOM

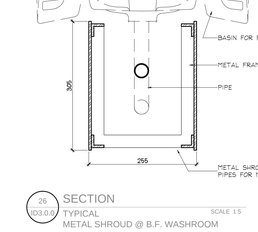

12 ID3.0.0 MAILROOM ENTRANCE HEADER SECTION
1ST FLOOR SCALE 1:5
LOBBY

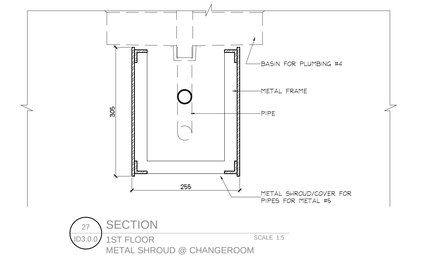

13 ID3.0.0 SECTION
1ST FLOOR SCALE 1:10
LOBBY

14 ID3.0.0 PLAN SECTION @ CORRIDOR 'D & ANTIROOM
1ST FLOOR SCALE 1:5
LOBBY

15 ID3.0.0 ELEVATOR HEADER SECTION
TYPICAL SCALE 1:5

16 ID3.0.0 SECTION @ WOOD PANEL
TYPICAL CORRIDOR SCALE 1:5

17 ID3.0.0 SECTION @ WOOD PANEL
1ST FLOOR SCALE 1:5
AMENITY FITNESS

18 ID3.0.0 JAMB DETAIL
1ST FLOOR SCALE 1:5
WHIRLPOOL SPA

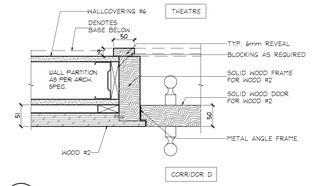

19 ID3.0.0 JAMB DETAIL
1ST FLOOR SCALE 1:5
THEATRE

20 ID3.0.0 JAMB DETAIL
1ST FLOOR SCALE 1:5
PROPERTY MANAGEMENT OFFICE

21 ID3.0.0 SECTION
1ST FLOOR SCALE 1:5
ENTRANCE TO CORRIDOR 'D'

22 ID3.0.0 JAMB DETAIL
1ST FLOOR SCALE 1:5
CACF

23 ID3.0.0 PLAN DETAIL
1ST FLOOR SCALE 1:5
FIREPLACE @DINING ROOM

24 ID3.0.0 PLAN DETAIL
TYPICAL SCALE 1:5
METAL SHROUD @ B.F. WASHROOM

25 ID3.0.0 PLAN DETAIL
1ST FLOOR SCALE 1:5
METAL SHROUD @ CHANGEROOM

26 ID3.0.0 SECTION
TYPICAL SCALE 1:5
METAL SHROUD @ B.F. WASHROOM

27 ID3.0.0 SECTION
1ST FLOOR SCALE 1:5
METAL SHROUD @ CHANGEROOM

DO NOT SCALE DRAWINGS.

CONTRACTOR MUST VERIFY ALL DRAWINGS, DIMENSIONS, DETAILS AND SPECIFICATIONS, AND REPORT ANY DISCREPANCIES TO *UNION 31 INC.* BEFORE PROCEEDING WITH WORK. MATERIALS MAY NOT BE SUBSTITUTED WITHOUT WRITTEN APPROVAL FROM *UNION 31 INC.*

ALL DRAWINGS AND SPECIFICATIONS ARE INSTRUMENTS OF SERVICE AND THE PROPERTY OF *UNION 31 INC.* WHICH MUST BE RETURNED AT THE COMPLETION OF THE WORK.

PRINTED: 30-May-17

ISSUED FOR AS-BUILT

NO.	DATE	COMMENTS	INI
01	31 MAY / 17	ISSUED FOR AS-BUILT	SV

REVISIONS:

UNION31

UNION31 INC.
183 BATHURST STREET, STE 201
TORONTO, ON, M5T 2R7, CANADA
TEL: 416-597-1576 FAX: 416-597-2139

PROJECT NAME:
ALEXANDRA PARK
MAIN BUILDING
BLOCK 11
ON, Canada

PROJECT NO.: 13-949

DRAWING/S:
PLAN DETAILS

DATE STARTED: 07 AUG / 13	DRAWING NO.:
SCALE: AS NOTED	ID 3.0.0
DRAWN BY: SM	
APPROVED BY: KC	

36 x 48

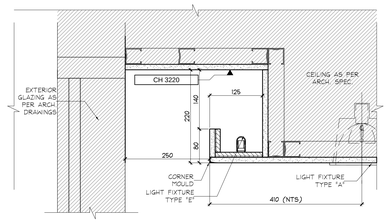

1 ID3.1.0 CEILNG SECTION
EAST VESTIBULE
1ST FLOOR
SCALE 1:5

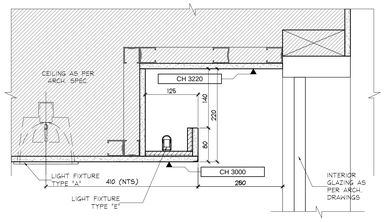

2 ID3.1.0 CEILING SECTION
EAST VESTIBULE
1ST FLOOR
SCALE 1:5

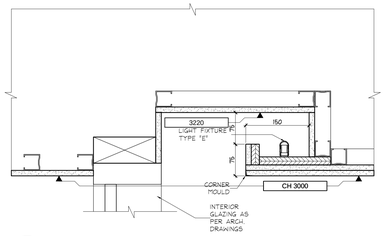

3 ID3.1.0 CEILNG SECTION
EAST VESTIBULE
1ST FLOOR
SCALE 1:5

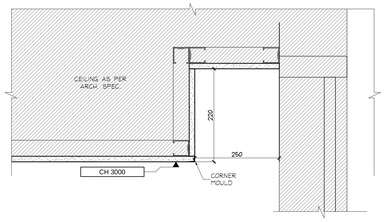

4 ID3.1.0 SECTION @ EXTERIOR GLAZ
1ST FLOOR
SCALE 1:5

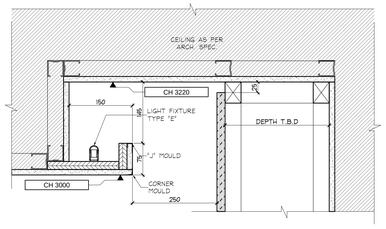

5 ID3.1.0 SECTION @ FIREPLACE
1ST FLOOR
SCALE 1:5

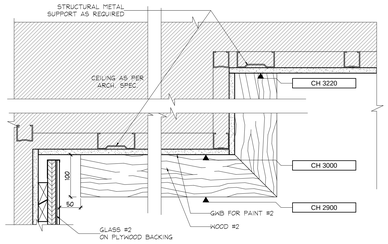

6 ID3.1.0 BULKHEAD @ CONCIERGE
1ST FLOOR
SCALE 1:5

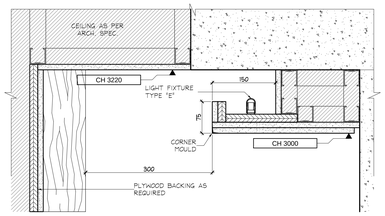

7 ID3.1.0 BULKHEAD @ CONCIERGE
1ST FLOOR
SCALE 1:5

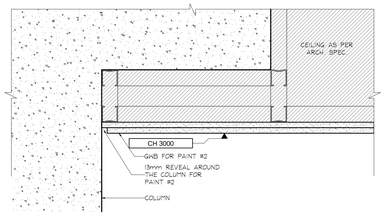

8 ID3.1.0 BULKHEAD @ CONCIERGE
1ST FLOOR
SCALE 1:5

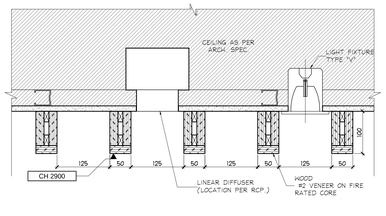

9 ID3.1.0 SECTION
CEILING DETAIL @ CONCIERGE
1ST FLOOR
SCALE 1:5

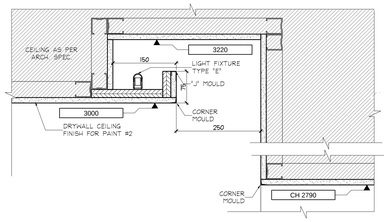

10 ID3.1.0 SECTION
1ST FLOOR
SCALE 1:5

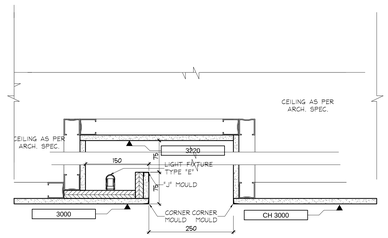

11 ID3.1.0 SECTION
1ST FLOOR
SCALE 1:5

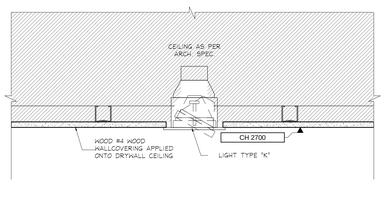

12 ID3.1.0 LIGHT DETAIL
ELEVATOR LOBBY
1ST FLOOR
SCALE 1:5

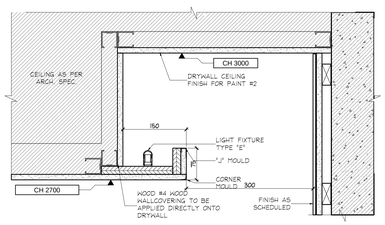

13 ID3.1.0 SECTION @ ELEVATOR COVE
1ST FLOOR
SCALE 1:5

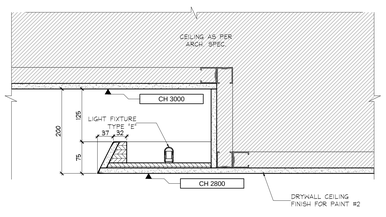

14 ID3.1.0 CEILING SECTION
PARTY ROOM
1ST FLOOR
SCALE 1:5

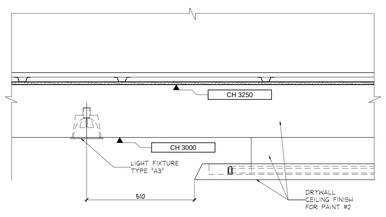

15 ID3.1.0 CEILING SECTION
PARTY ROOM
1ST FLOOR
SCALE 1:10

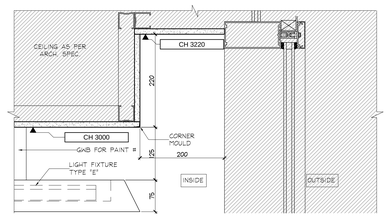

16 ID3.1.0 CEILING SECTION
PARTY ROOM
1ST FLOOR
SCALE 1:5

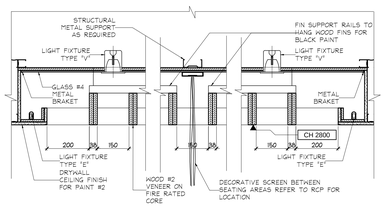

17 ID3.1.0 CEILING SECTION
PARTY ROOM
1ST FLOOR
SCALE 1:10

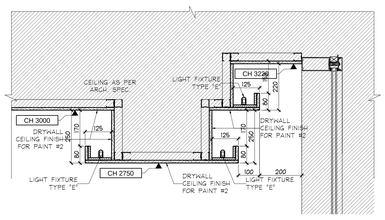

18 ID3.1.0 CEILING SECTION
FITNESS AREA
1ST FLOOR
SCALE 1:10

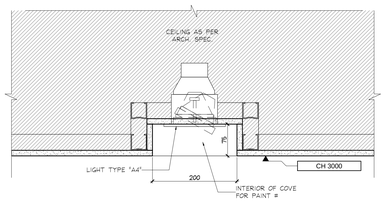

19 ID3.1.0 CEILING SECTION
FITNESS AREA
1ST FLOOR
SCALE 1:5

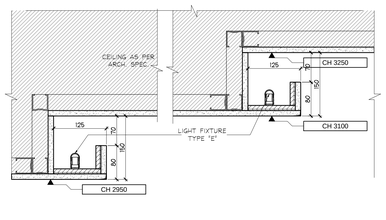

20 ID3.1.0 CEILING SECTION
THEATRE
1ST FLOOR
SCALE 1:5

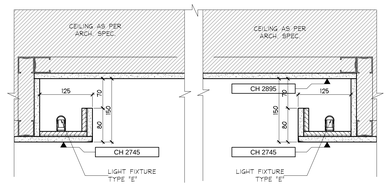

21 ID3.1.0 CEILING SECTION
PROPERTY MANAGEMENT OFFICE
1ST FLOOR
SCALE 1:5

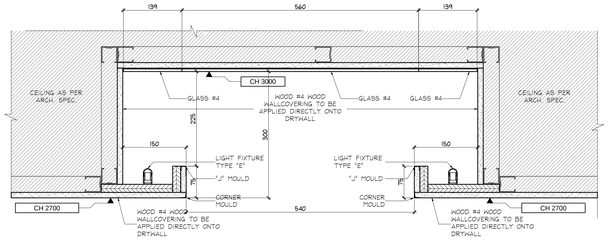

22 ID3.1.0 SECTION @ CORRIDOR 'D' COVE
1ST FLOOR
SCALE 1:5

DO NOT SCALE DRAWINGS.

CONTRACTOR MUST VERIFY ALL DRAWINGS, DIMENSIONS, DETAILS AND SPECIFICATIONS, AND REPORT ANY DISCREPANCIES TO *UNION 31 INC.* BEFORE PROCEEDING WITH WORK. MATERIALS MAY NOT BE SUBSTITUTED WITHOUT WRITTEN APPROVAL FROM *UNION 31 INC.*

ALL DRAWINGS AND SPECIFICATIONS ARE INSTRUMENTS OF SERVICE AND THE PROPERTY OF *UNION 31 INC.* WHICH MUST BE RETURNED AT THE COMPLETION OF THE WORK.

PRINTED: 30-May-17

ISSUED FOR AS-BUILT

NO.	DATE	COMMENTS	INI
01	31 MAY / 17	ISSUED FOR AS-BUILT	SV

REVISIONS:

UNION31

UNION31 INC.
183 BATHURST STREET, STE 201
TORONTO, ON, M5T 2R7, CANADA
TEL: 416-597-1576 FAX: 416-597-2139

PROJECT NAME:
ALEXANDRA PARK
MAIN BUILDING
BLOCK 11
ON, Canada

PROJECT NO.: 13-949

DRAWING/S:
CEILING DETAILS

DATE STARTED:	07 AUG / 13	DRAWING NO.:	ID 3.1.0
SCALE:	AS NOTED		
DRAWN BY:	GG		
APPROVED BY:	KC		

36 x 48

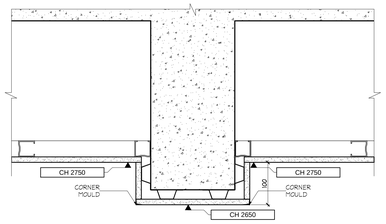

1 / ID3.1.1 CEILNG SECTION
CORRIDOR A @ GRIDLINE 'H' SCALE 1:5
2ND FLOOR

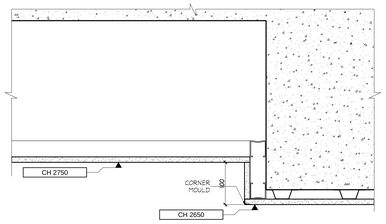

2 / ID3.1.1 CEILNG SECTION
CORRIDOR B @ GRIDLINE 'G' SCALE 1:5
2ND FLOOR

DO NOT SCALE DRAWINGS.

CONTRACTOR MUST VERIFY ALL DRAWINGS, DIMENSIONS, DETAILS AND SPECIFICATIONS, AND REPORT ANY DISCREPANCIES TO *UNION 31 INC.* BEFORE PROCEEDING WITH WORK. MATERIALS MAY NOT BE SUBSTITUTED WITHOUT WRITTEN APPROVAL FROM *UNION 31 INC.*

ALL DRAWINGS AND SPECIFICATIONS ARE INSTRUMENTS OF SERVICE AND THE PROPERTY OF *UNION 31 INC.* WHICH MUST BE RETURNED AT THE COMPLETION OF THE WORK.

PRINTED: 30-May-17

ISSUED FOR AS-BUILT

NO.	DATE	COMMENTS	INI
01	31 MAY / 17	ISSUED FOR AS-BUILT	SV

REVISIONS:

UNION31

UNION31 INC.
183 BATHURST STREET, STE 201
TORONTO, ON, M5T 2R7, CANADA
TEL: 416-597-1576 FAX: 416-597-2139

PROJECT NAME:
ALEXANDRA PARK
MAIN BUILDING
BLOCK 11
ON, Canada

PROJECT NO.: 13-949

DRAWING/S:
CEILING DETAILS

DATE STARTED:	07 AUG / 13	DRAWING NO.:	ID 3.1.1
SCALE:	AS NOTED		
DRAWN BY:	GG		
APPROVED BY:	KC		

36 x 48

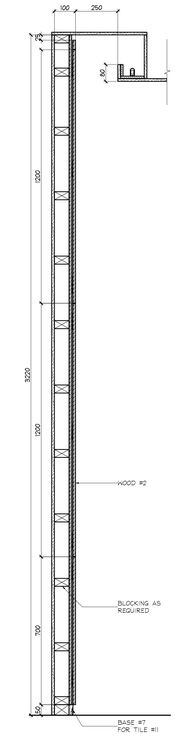

1 (ID3.2.0) WALL SECTION
1ST FLOOR
LOBBY
SCALE 1:10

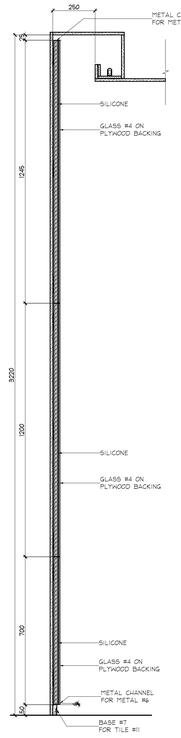

2 (ID3.2.0) WALL SECTION
1ST FLOOR
LOBBY
SCALE 1:10

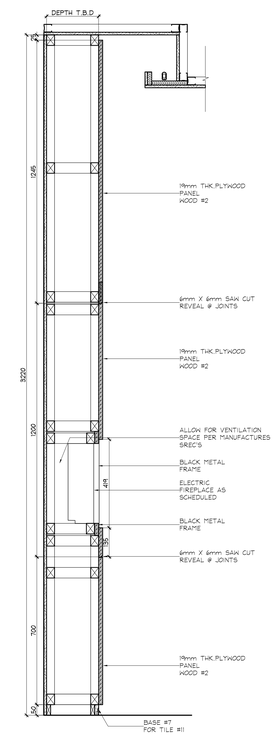

3 (ID3.2.0) WALL SECTION @ LOBBY FIREPLACE
1ST FLOOR
LOBBY
SCALE 1:10

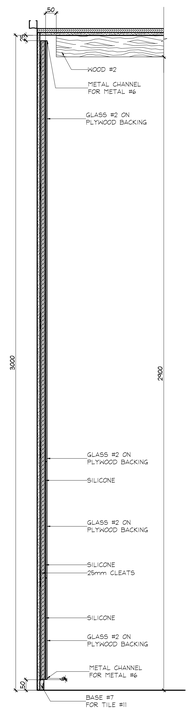

4 (ID3.2.0) WALL SECTION
1ST FLOOR
LOBBY
SCALE 1:10

OMITTED

5 (ID3.2.0) WALL SECTION @ TV BEHIND CONCERGE
1ST FLOOR
LOBBY
SCALE 1:10

OMITTED

6 (ID3.2.0) WALL SECTION
1ST FLOOR
MAILROOM
SCALE 1:10

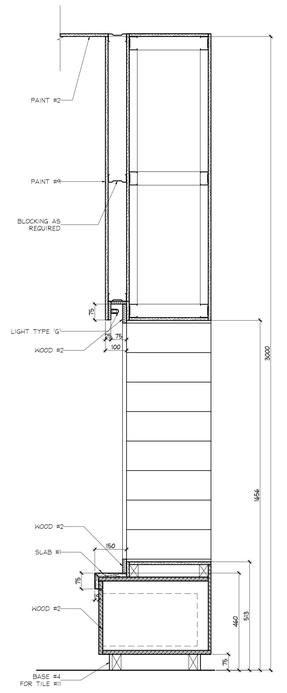

7 (ID3.2.0) WALL SECTION
1ST FLOOR
MAILROOM
SCALE 1:10

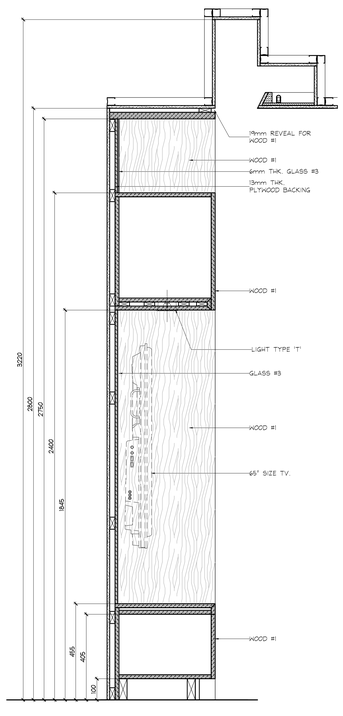

8 (ID3.2.0) WALL SECTION
1ST FLOOR
PARTY ROOM
SCALE 1:10

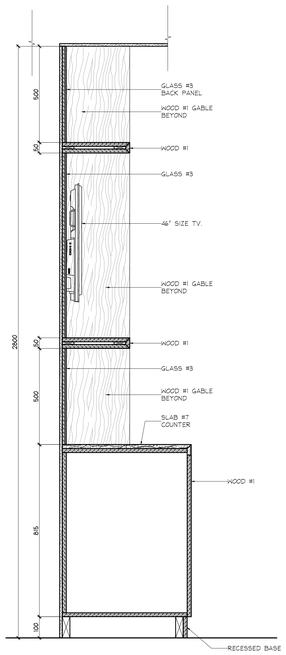

9 (ID3.2.0) WALL SECTION @ TV
1ST FLOOR
PARTY ROOM
SCALE 1:10

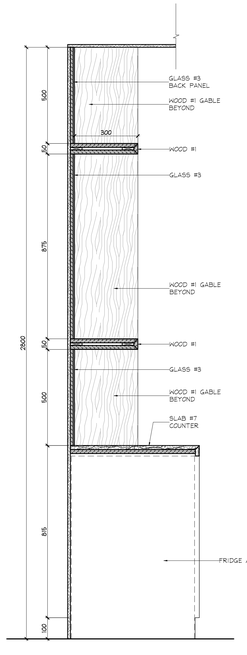

10 (ID3.2.0) WALL SECTION
1ST FLOOR
PARTY ROOM
SCALE 1:10

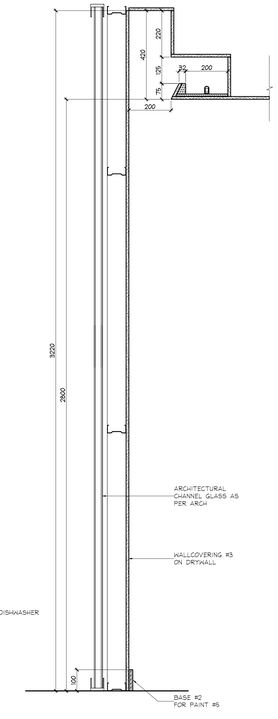

11 (ID3.2.0) WALL SECTION
1ST FLOOR
PARTY ROOM
SCALE 1:10

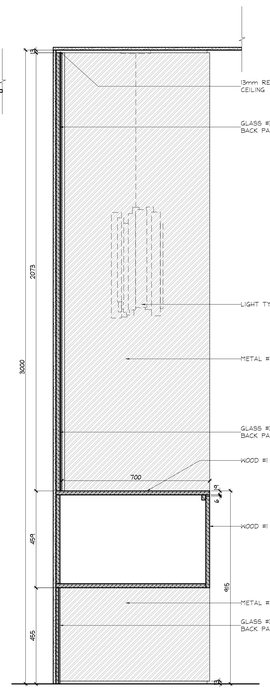

12 (ID3.2.0) SECTION @ MIRROR
1ST FLOOR
DINING ROOM
SCALE 1:10

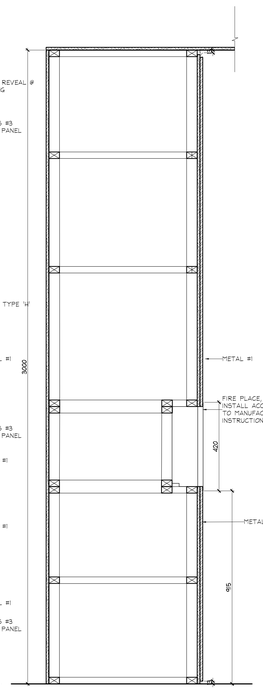

13 (ID3.2.0) SECTION @ FIRE PLACE
1ST FLOOR
DINING ROOM
SCALE 1:10

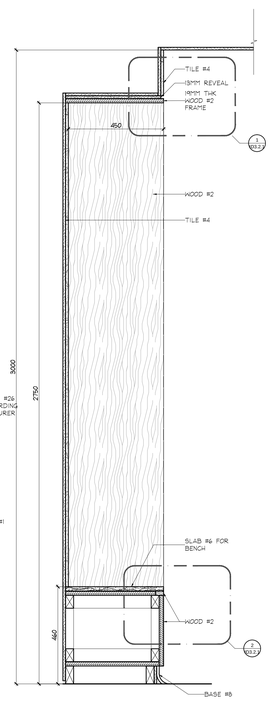

14 (ID3.2.0) SECTION @ BENCH
1ST FLOOR
CHANGE ROOMS
SCALE 1:10

OMITTED

15 (ID3.2.0) SECTION @ BENCH
1ST FLOOR
CHANGE ROOMS
SCALE 1:10

DO NOT SCALE DRAWINGS.

CONTRACTOR MUST VERIFY ALL DRAWINGS, DIMENSIONS, DETAILS AND SPECIFICATIONS, AND REPORT ANY DISCREPANCIES TO *UNION 31 INC.* BEFORE PROCEEDING WITH WORK. MATERIALS MAY NOT BE SUBSTITUTED WITHOUT WRITTEN APPROVAL FROM *UNION 31 INC.*

ALL DRAWINGS AND SPECIFICATIONS ARE INSTRUMENTS OF SERVICE AND THE PROPERTY OF *UNION 31 INC.* WHICH MUST BE RETURNED AT THE COMPLETION OF THE WORK.

PRINTED: 30-May-17

ISSUED FOR AS-BUILT

NO.	DATE	COMMENTS	INI
01	31 MAY / 17	ISSUED FOR AS-BUILT	SV

REVISIONS:

UNION31

UNION31 INC.
183 BATHURST STREET, STE 201
TORONTO, ON, M5T 2R7, CANADA
TEL: 416-597-1576 FAX: 416-597-2139

PROJECT NAME:
ALEXANDRA PARK
MAIN BUILDING
BLOCK 11
ON, Canada

PROJECT NO.: 13-949

DRAWING/S:
WALL SECTIONS

DATE STARTED:	07 AUG / 13	DRAWING NO.:	ID 3.2.0
SCALE:	AS NOTED		
DRAWN BY:	SM		
APPROVED BY:	KC		

36 x 48

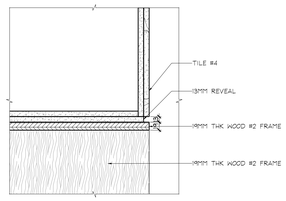

1 ID3.2.1 DETAIL
BENCH
CHANGE ROOMS
SCALE 1:5

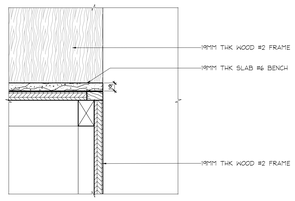

2 ID3.2.1 DETAIL
BENCH
CHANGE ROOMS
SCALE 1:5

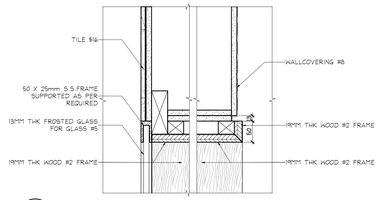

3 ID3.2.1 DETAIL
BENCH
FITNESS
SCALE 1:5

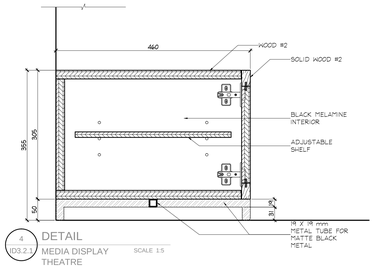

4 ID3.2.1 DETAIL
MEDIA DISPLAY
THEATRE
SCALE 1:5

DO NOT SCALE DRAWINGS.

CONTRACTOR MUST VERIFY ALL DRAWINGS, DIMENSIONS, DETAILS AND SPECIFICATIONS, AND REPORT ANY DISCREPANCIES TO *UNION 31 INC.* BEFORE PROCEEDING WITH WORK. MATERIALS MAY NOT BE SUBSTITUTED WITHOUT WRITTEN APPROVAL FROM *UNION 31 INC.*

ALL DRAWINGS AND SPECIFICATIONS ARE INSTRUMENTS OF SERVICE AND THE PROPERTY OF *UNION 31 INC.* WHICH MUST BE RETURNED AT THE COMPLETION OF THE WORK.

PRINTED: 30-May-17

ISSUED FOR AS-BUILT

NO.	DATE	COMMENTS	INI
01	31 MAY / 17	ISSUED FOR AS-BUILT	SV

REVISIONS:

UNION31

UNION31 INC.
183 BATHURST STREET, STE 201
TORONTO, ON, M5T 2R7, CANADA
TEL: 416-597-1576 FAX: 416-597-2139

PROJECT NAME:
ALEXANDRA PARK
MAIN BUILDING
BLOCK 11
ON, Canada

PROJECT NO.: 13-949

DRAWING/S:
WALL SECTIONS

DATE STARTED:	07 AUG / 13	DRAWING NO.:	ID 3.2.1
SCALE:	AS NOTED		
DRAWN BY:	SM		
APPROVED BY:	KC		

36 x 48

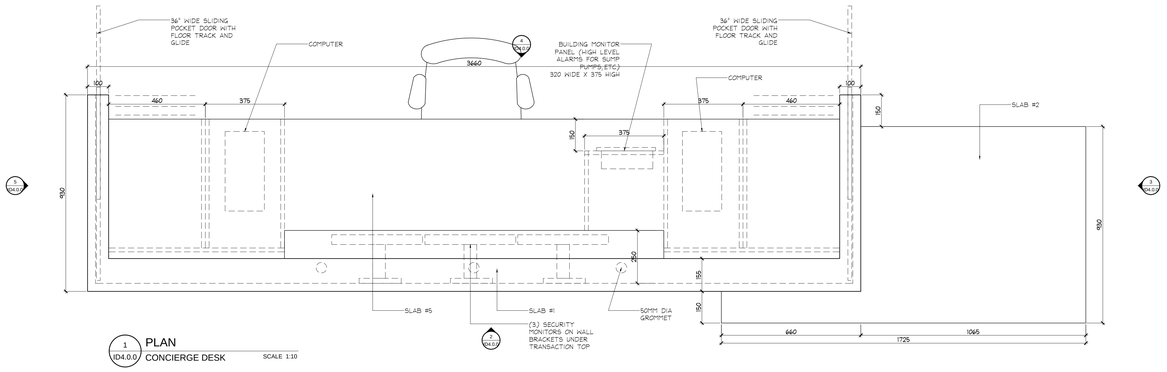

1 ID4.0.0 PLAN
CONCIERGE DESK SCALE 1:10

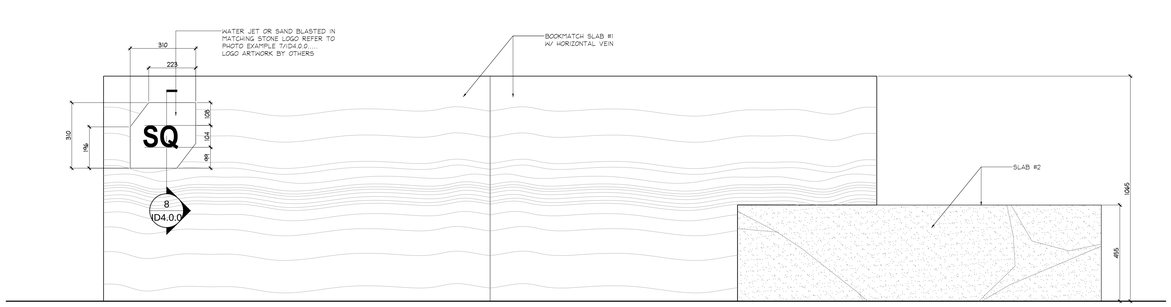

2 ID4.0.0 ELEVATION
CONCIERGE DESK SCALE 1:10

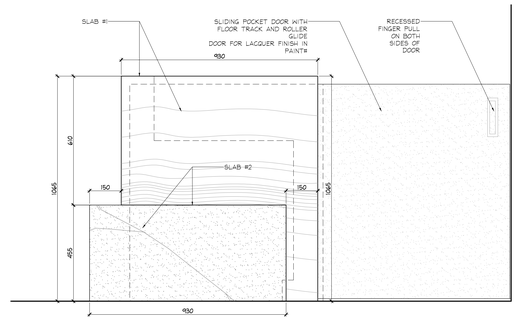

3 ID4.0.0 ELEVATION
CONCIERGE DESK SCALE 1:10

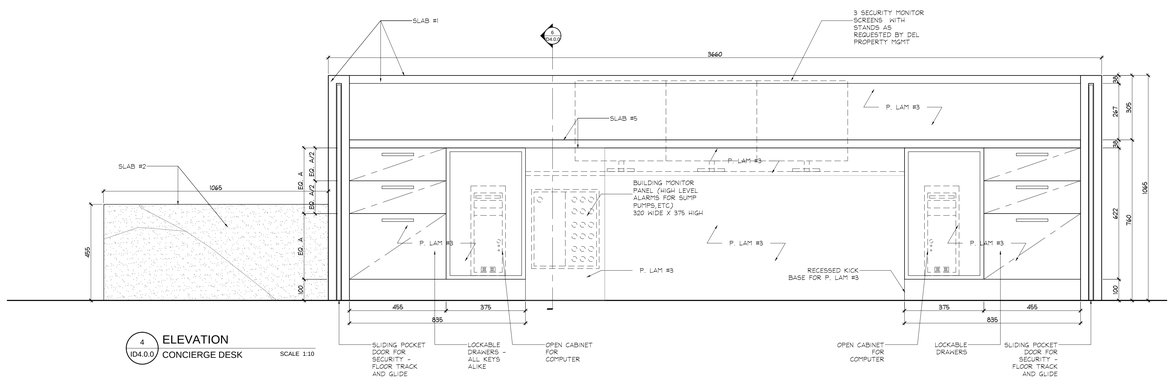

4 ID4.0.0 ELEVATION
CONCIERGE DESK SCALE 1:10

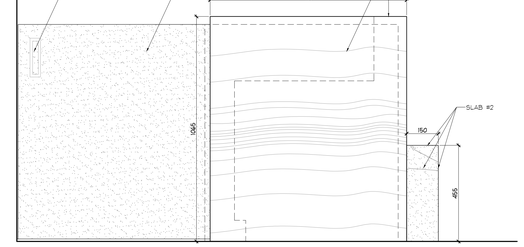

5 ID4.0.0 ELEVATION
CONCIERGE DESK SCALE 1:10

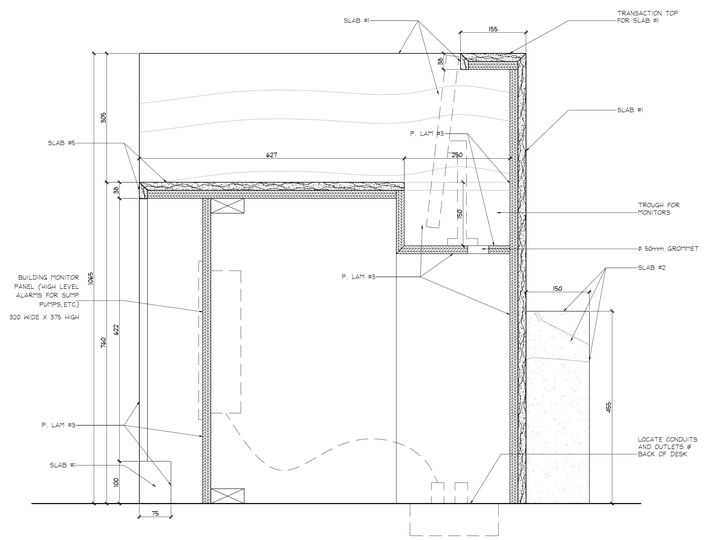

6 ID4.0.0 SECTION
CONCIERGE DESK SCALE 1:10

7 ID4.0.0 WATER JET CUT SAMPLE
CONCIERGE DESK N.T.S.

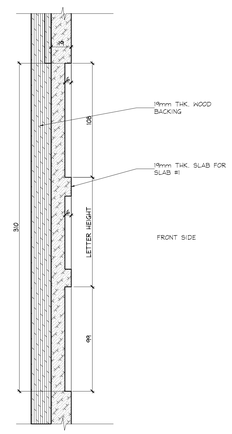

8 ID4.0.0 SECTION @ LOGO SLAB
CONCIERGE DESK SCALE 1:2

DO NOT SCALE DRAWINGS.

CONTRACTOR MUST VERIFY ALL DRAWINGS, DIMENSIONS, DETAILS AND SPECIFICATIONS, AND REPORT ANY DISCREPANCIES TO *UNION 31 INC.* BEFORE PROCEEDING WITH WORK. MATERIALS MAY NOT BE SUBSTITUTED WITHOUT WRITTEN APPROVAL FROM *UNION 31 INC.*

ALL DRAWINGS AND SPECIFICATIONS ARE INSTRUMENTS OF SERVICE AND THE PROPERTY OF *UNION 31 INC.* WHICH MUST BE RETURNED AT THE COMPLETION OF THE WORK.

PRINTED: 30-May-17

ISSUED FOR AS-BUILT

NO.	DATE	COMMENTS	INI
01	31 MAY / 17	ISSUED FOR AS-BUILT	SV

REVISIONS:

UNION31

UNION31 INC.
183 BATHURST STREET, STE 201
TORONTO, ON, M5T 2R7, CANADA
TEL: 416-597-1576 FAX: 416-597-2139

PROJECT NAME:
ALEXANDRA PARK
MAIN BUILDING
BLOCK 11
ON, Canada

PROJECT NO.: 13-949

DRAWING/S:
MILLWORK DETAILS

DATE STARTED: 07 AUG / 13	DRAWING NO.:
SCALE: AS NOTED	ID 4.0.0
DRAWN BY: SM	
APPROVED BY: KC	

36 x 48

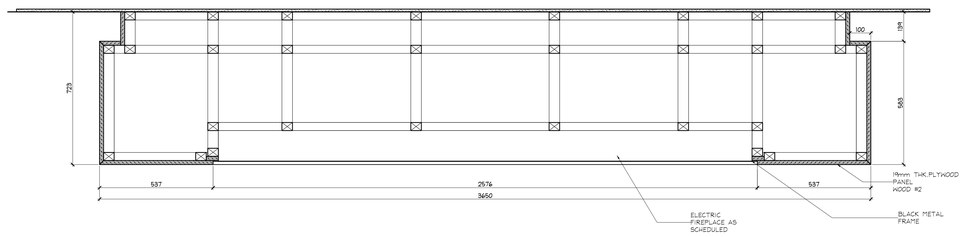

1 ID4.1.0 PLAN
FIREPLACE @ LOBBY
1ST FLOOR
SCALE 1:10

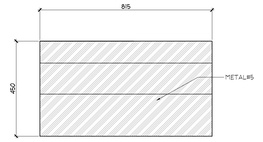

2 ID4.1.0 PLAN
ENTER PHONE
SCALE 1:10

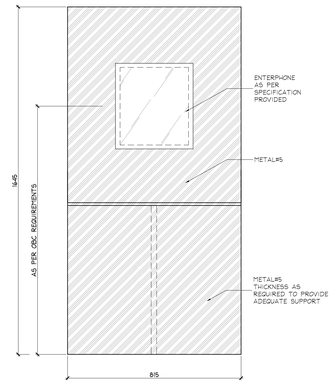

3 ID4.1.0 ELEVATION
ENTER PHONE
SCALE 1:10

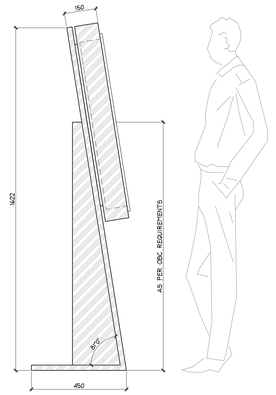

4 ID4.1.0 ELEVATION
ENTER PHONE
SCALE 1:10

DO NOT SCALE DRAWINGS.

CONTRACTOR MUST VERIFY ALL DRAWINGS, DIMENSIONS, DETAILS AND SPECIFICATIONS, AND REPORT ANY DISCREPANCIES TO *UNION 31 INC.* BEFORE PROCEEDING WITH WORK. MATERIALS MAY NOT BE SUBSTITUTED WITHOUT WRITTEN APPROVAL FROM *UNION 31 INC.*

ALL DRAWINGS AND SPECIFICATIONS ARE INSTRUMENTS OF SERVICE AND THE PROPERTY OF *UNION 31 INC.* WHICH MUST BE RETURNED AT THE COMPLETION OF THE WORK.

PRINTED: 30-May-17

ISSUED FOR AS-BUILT

NO.	DATE	COMMENTS	INI
01	31 MAY / 17	ISSUED FOR AS-BUILT	SV

REVISIONS:

UNION31

UNION31 INC.
183 BATHURST STREET, STE 201
TORONTO, ON, M5T 2R7, CANADA
TEL: 416-597-1576 FAX: 416-597-2139

PROJECT NAME:
ALEXANDRA PARK
MAIN BUILDING
BLOCK 11
ON, Canada

PROJECT NO.: 13-949

DRAWING/S:
MILLWORK DETAILS

DATE STARTED:	07 AUG / 13	DRAWING NO.:	ID 4.1.0
SCALE:	AS NOTED		
DRAWN BY:	SM		
APPROVED BY:	KC		

36 x 48

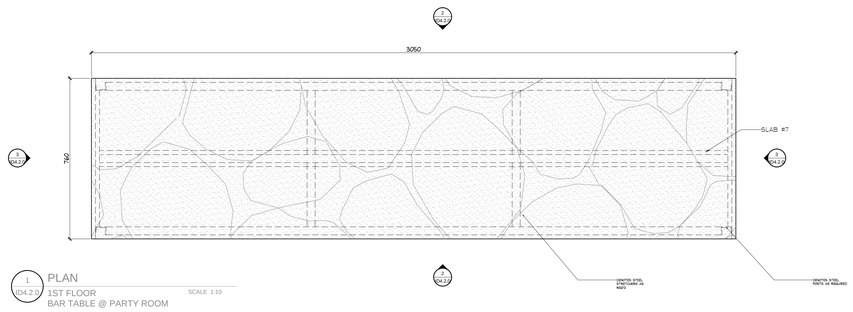

1 ID4.2.0 PLAN
1ST FLOOR
BAR TABLE @ PARTY ROOM
SCALE 1:10

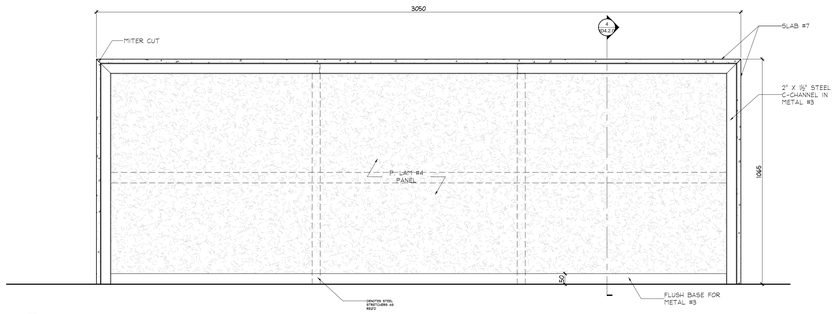

2 ID4.2.0 ELEVATION
1ST FLOOR
BAR TABLE @ PARTY ROOM
SCALE 1:10

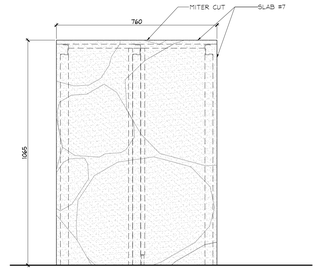

3 ID4.2.0 SIDE ELEVATION
1ST FLOOR
BAR TABLE @ PARTY ROOM
SCALE 1:10

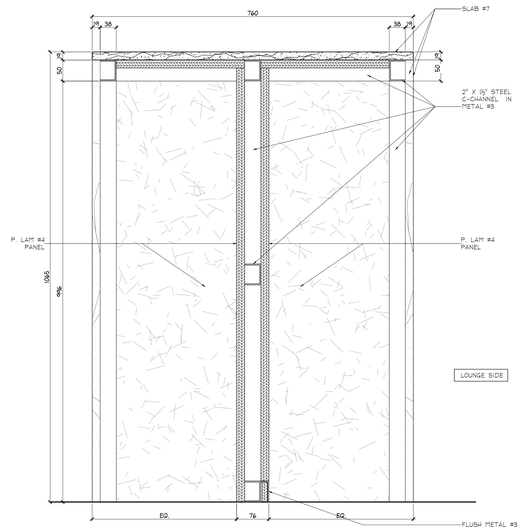

4 ID4.2.0 SECTION @ BAR TABLE
1ST FLOOR
PARTY ROOM
SCALE 1:5

DO NOT SCALE DRAWINGS.

CONTRACTOR MUST VERIFY ALL DRAWINGS, DIMENSIONS, DETAILS AND SPECIFICATIONS, AND REPORT ANY DISCREPANCIES TO *UNION 31 INC.* BEFORE PROCEEDING WITH WORK. MATERIALS MAY NOT BE SUBSTITUTED WITHOUT WRITTEN APPROVAL FROM *UNION 31 INC.*

ALL DRAWINGS AND SPECIFICATIONS ARE INSTRUMENTS OF SERVICE AND THE PROPERTY OF *UNION 31 INC.* WHICH MUST BE RETURNED AT THE COMPLETION OF THE WORK.

PRINTED: 30-May-17

ISSUED FOR AS-BUILT

NO.	DATE	COMMENTS	INI
01	31 MAY / 17	ISSUED FOR AS-BUILT	SV

REVISIONS:

UNION31

UNION31 INC.
183 BATHURST STREET, STE 201
TORONTO, ON, M5T 2R7, CANADA
TEL: 416-597-1576 FAX: 416-597-2139

PROJECT NAME:
ALEXANDRA PARK
MAIN BUILDING
BLOCK 11
ON, Canada

PROJECT NO.: 13-949

DRAWING/S:
MILLWORK DETAILS

DATE STARTED:	07 AUG / 13	DRAWING NO.:
SCALE:	AS NOTED	ID 4.2.0
DRAWN BY:	SM	
APPROVED BY:	KC	

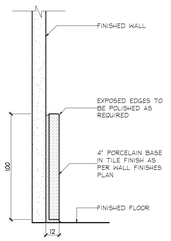

BASE #1

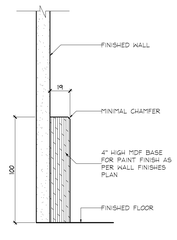

BASE #2

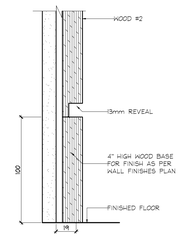

BASE #3

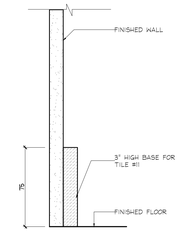

BASE #4

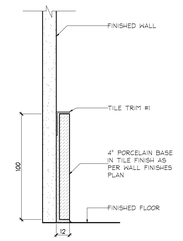

BASE #5

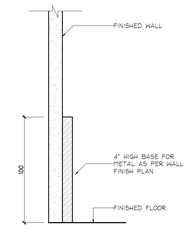

BASE #6

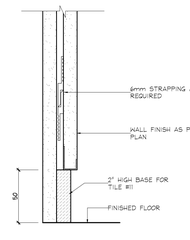

BASE #7

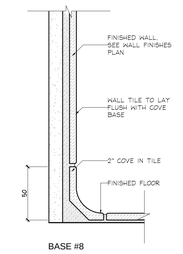

BASE #8

1 ID5.0.0 BASE DETAILS TYPICAL SCALE 1:2

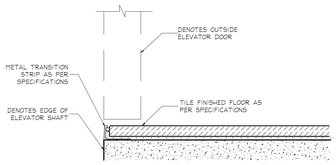

THRESHOLD #1
ELEVATOR TO TILE

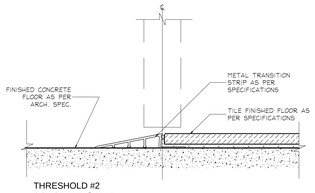

THRESHOLD #2
CONCRETE @ TILE

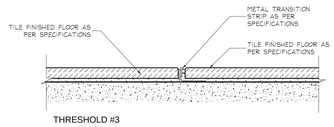

THRESHOLD #3
TILE @ TILE

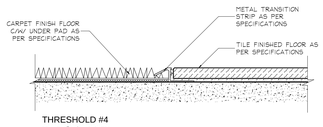

THRESHOLD #4
TILE @ CARPET

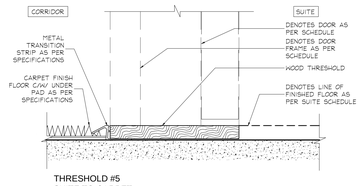

THRESHOLD #5
SUITE TO CARPET

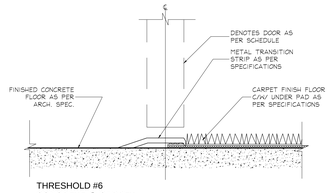

THRESHOLD #6
CONCRETE @ CARPET

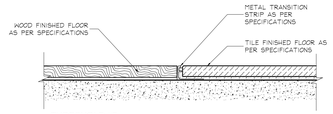

THRESHOLD #7
TILE @ WOOD

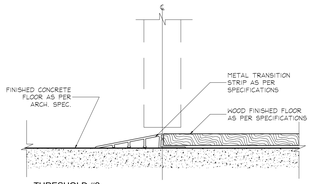

THRESHOLD #8
CONCRETE @ WOOD

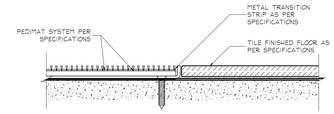

THRESHOLD #9
PEDIMAT @ TILE

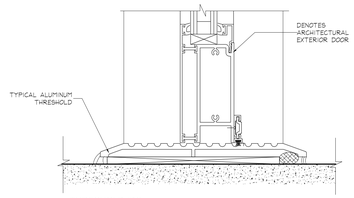

THRESHOLD #10
ARCHITECTURAL APPLICATIONS

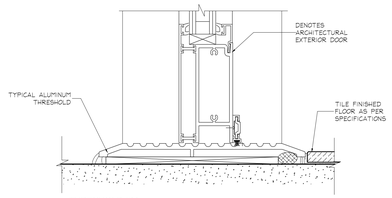

THRESHOLD #11
ARCHITECTURAL APPLICATIONS

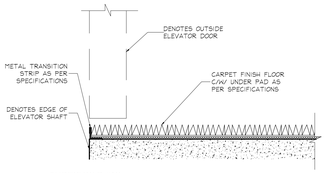

THRESHOLD #12
ELEVATOR TO CARPET

2 ID5.0.0 THRESHOLD DETAILS TYPICAL SCALE 1:2

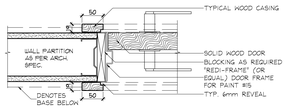

3 ID5.0.0 TYP. CASING HORIZONTAL SECTION - DETAIL SCALE 1:5

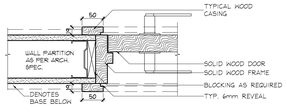

4 ID5.0.0 TYP. CASING HORIZONTAL SECTION - DETAIL SCALE 1:5

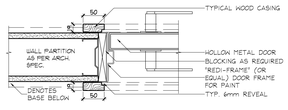

5 ID5.0.0 TYP. CASING HORIZONTAL SECTION - DETAIL SCALE 1:5

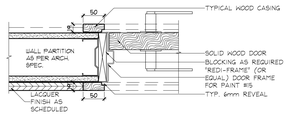

6 ID5.0.0 TYP. CASING @ TILE WALL HORIZONTAL SECTION - DETAIL SCALE 1:5

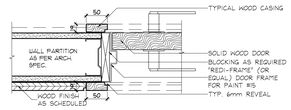

7 ID5.0.0 TYP. CASING @ WOOD HORIZONTAL SECTION - DETAIL SCALE 1:5

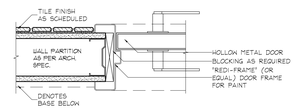

8 ID5.0.0 TYP. CASING @ TILE WALL HORIZONTAL SECTION - DETAIL SCALE 1:5

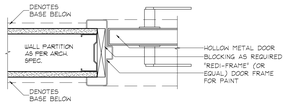

9 ID5.0.0 TYP. CASING HORIZONTAL SECTION - DETAIL SCALE 1:5

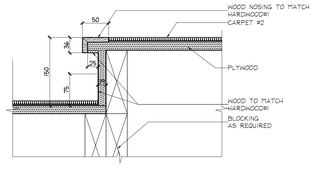

10 ID5.0.0 SECTION - STEP AMENITY - THEATRE ROOM GROUND FLOOR SCALE 1:5

DO NOT SCALE DRAWINGS.

CONTRACTOR MUST VERIFY ALL DRAWINGS, DIMENSIONS, DETAILS AND SPECIFICATIONS, AND REPORT ANY DISCREPANCIES TO *UNION 31 INC.* BEFORE PROCEEDING WITH WORK. MATERIALS MAY NOT BE SUBSTITUTED WITHOUT WRITTEN APPROVAL FROM *UNION 31 INC.*

ALL DRAWINGS AND SPECIFICATIONS ARE INSTRUMENTS OF SERVICE AND THE PROPERTY OF *UNION 31 INC.* WHICH MUST BE RETURNED AT THE COMPLETION OF THE WORK.

PRINTED: 30-May-17

ISSUED FOR AS-BUILT

NO.	DATE	COMMENTS	INI
01	31 MAY / 17	ISSUED FOR AS-BUILT	SV

REVISIONS:

UNION31

UNION31 INC.
183 BATHURST STREET, STE 201
TORONTO, ON, M5T 2R7, CANADA
TEL: 416-597-1576 FAX: 416-597-2139

PROJECT NAME:
ALEXANDRA PARK
MAIN BUILDING
BLOCK 11
ON, Canada

PROJECT NO.: 13-949

DRAWING/S:
TYPICAL DETAILS
BASES, THRESHOLDS & CASINGS

DATE STARTED:	07 AUG / 13	DRAWING NO.:	ID 5.0.0
SCALE:	AS NOTED		
DRAWN BY:	GG		
APPROVED BY:	KC		

36 x 48