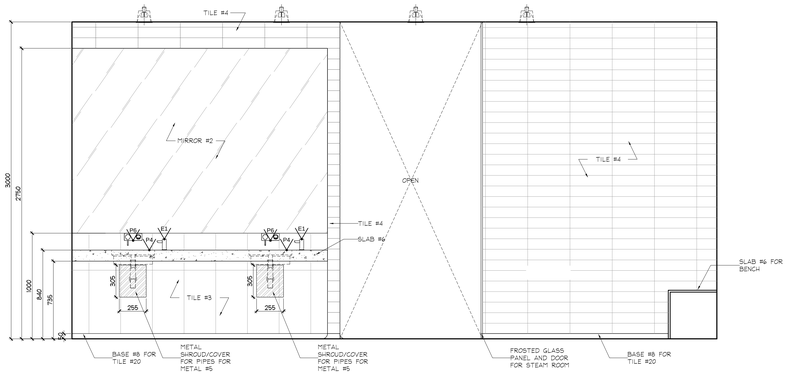

1 ID2.1.9 ELEVATION
GROUND FLOOR
MEN'S CHANGE ROOM
SCALE 1:20

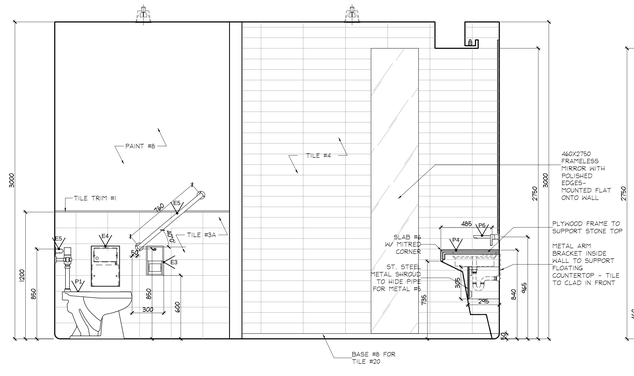

2 ID2.1.9 ELEVATION
GROUND FLOOR
MEN'S CHANGE ROOM
SCALE 1:20

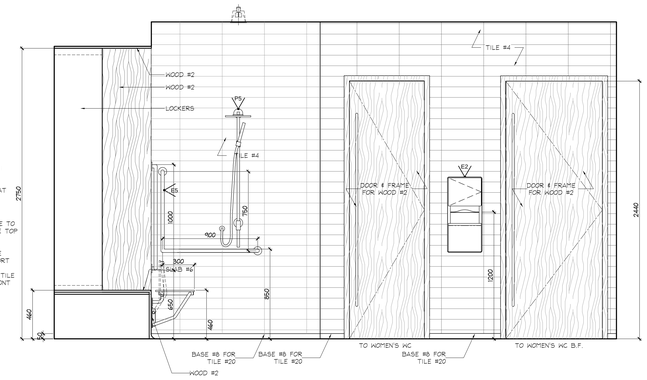

3 ID2.1.9 ELEVATION
GROUND FLOOR
MEN'S CHANGE ROOM
SCALE 1:20

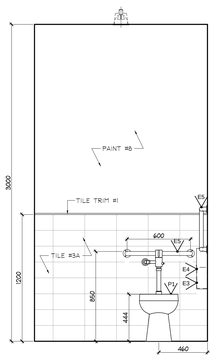

4 ID2.1.9 ELEVATION
GROUND FLOOR
MEN'S CHANGE ROOM
SCALE 1:20

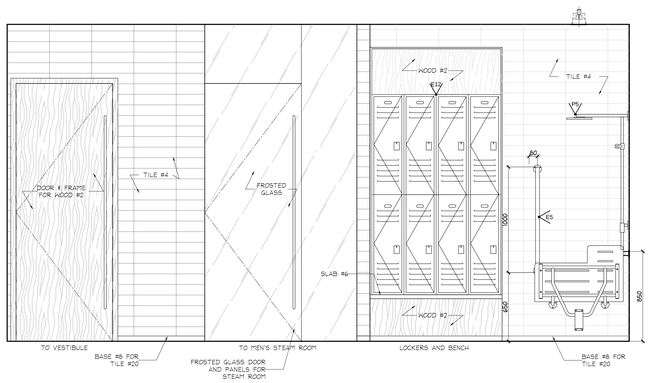

5 ID2.1.9 ELEVATION
GROUND FLOOR
MEN'S CHANGE ROOM
SCALE 1:20

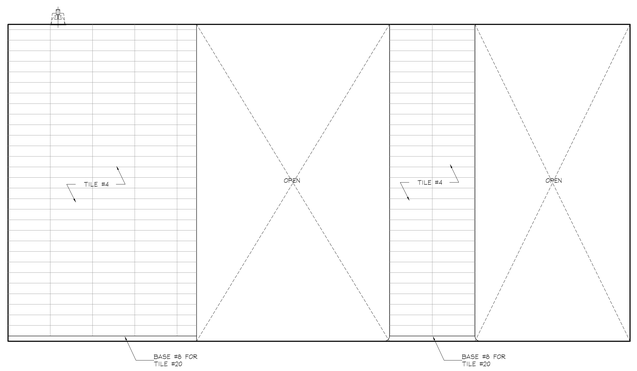

6 ID2.1.9 ELEVATION
GROUND FLOOR
MEN'S CHANGE ROOM
SCALE 1:20

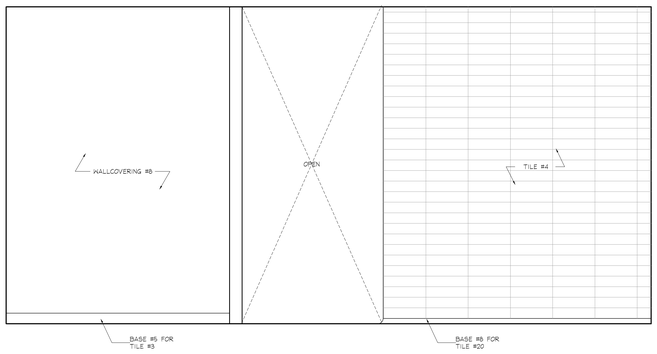

7 ID2.1.9 ELEVATION
GROUND FLOOR
MEN'S CHANGE ROOM
SCALE 1:20

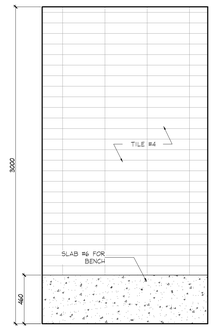

8 ID2.1.9 ELEVATION
GROUND FLOOR
MEN'S CHANGE ROOM
SCALE 1:20

DO NOT SCALE DRAWINGS.

CONTRACTOR MUST VERIFY ALL DRAWINGS, DIMENSIONS, DETAILS AND SPECIFICATIONS, AND REPORT ANY DISCREPANCIES TO *UNION 31 INC.* BEFORE PROCEEDING WITH WORK. MATERIALS MAY NOT BE SUBSTITUTED WITHOUT WRITTEN APPROVAL FROM *UNION 31 INC.*

ALL DRAWINGS AND SPECIFICATIONS ARE INSTRUMENTS OF SERVICE AND THE PROPERTY OF *UNION 31 INC.* WHICH MUST BE RETURNED AT THE COMPLETION OF THE WORK.

PRINTED: 30-May-17

ISSUED FOR AS-BUILT

NO.	DATE	COMMENTS	INI
01	31 MAY / 17	ISSUED FOR AS-BUILT	SV

REVISIONS:

UNION31

UNION31 INC.
183 BATHURST STREET, STE 201
TORONTO, ON, M5T 2R7, CANADA
TEL: 416-597-1576 FAX: 416-597-2139

PROJECT NAME:
ALEXANDRA PARK
MAIN BUILDING
BLOCK 11
ON, Canada

PROJECT NO.: 13-949

DRAWING/S:
GROUND FLOOR ELEVATIONS

DATE STARTED:	07 AUG / 13	DRAWING NO.:	ID 2.1.9
SCALE:	1 : 20		
DRAWN BY:	AP		
APPROVED BY:	KC		

34 x 48